

---

# **COMMON LOGIC PTY LTD**

ACN. 011 029 262

**Electrical Contractors**

***Contract No: BW.60095-05/06  
PS292 Wirriboot Ct***

## ***Electrical Manual***

ISSUE NO 1  
AS BUILT  
15/11/2006

Unit 9/58 Wecker Road, Mansfield, Queensland 4122  
Telephone (07) 3849 7449 Fax (07) 3343 5210  
JH86

---

JH86Mj08

**COMMON LOGIC Pty Ltd**  
**Specialist Electrical Contractors**
**Electrical Manual**

Subject: Wirriboot Crt SP292

Sheet: 1  
Of: 10Section  
1

Page Revision No:

Date: 17/11/06

Manual Issue No: 1

Date: 17/11/06

<b><u>1.0</u></b>	<b><u>GENERAL</u></b>	<b><u>2</u></b>
<b><u>2.0</u></b>	<b><u>OPERATIONAL DESCRIPTION</u></b>	<b><u>3</u></b>
<b><u>2.1</u></b>	<b>GENERATOR</b>	<b><u>3</u></b>
<b><u>2.2</u></b>	<b>RTU</b>	<b><u>3</u></b>
<b><u>2.3</u></b>	<b>PUMP STARTER MCC</b>	<b><u>3</u></b>
<b><u>2.3.1.</u></b>	MCC MAIN SWITCH	<b><u>3</u></b>
<b><u>2.3.2.</u></b>	MAINS AVAILABLE INDICATOR	<b><u>4</u></b>
<b><u>2.3.3.</u></b>	MAINS FAIL IN MCC	<b><u>4</u></b>
<b><u>2.3.4.</u></b>	GENERATOR RUNNING.	<b><u>4</u></b>
<b><u>2.4</u></b>	<b>ATS CUBICLE</b>	<b><u>4</u></b>
<b><u>2.4.1.</u></b>	GENERATOR INTERFACE	<b><u>4</u></b>
<b><u>2.4.2.</u></b>	RTU INTERFACE	<b><u>5</u></b>
<b><u>2.4.3.</u></b>	ATS AND CONTROL	<b><u>5</u></b>
<b><u>3.0</u></b>	<b><u>DRAWINGS</u></b>	<b><u>7</u></b>
<b><u>4.0</u></b>	<b><u>PART LIST</u></b>	<b><u>8</u></b>
<b><u>5.0</u></b>	<b><u>TEST SHEETS</u></b>	<b><u>9</u></b>
<b><u>6.0</u></b>	<b><u>TECHNICAL INFORMATION</u></b>	<b><u>10</u></b>

Authorised By: Grant Kerr

**COMMON LOGIC Pty Ltd**  
**Specialist Electrical Contractors****Electrical Manual**

Subject: Wirriboot Crt SP292

Sheet: 2  
Of: 10Section  
1

Page Revision No:

Date: 17/11/06

Manual Issue No: 1 Date: 17/11/06

**1.0 GENERAL**

The following document describes the operation of the switchgear and relays installed into the change over switchgear cubicle.

The document does NOT describe the detailed operation of the generator PLC or the operation of the pump starters on the site.

The generator is a plug in device and can be removed from site by BW at their discretion.

Authorised By: Grant Kerr

Subject: Wirriboot Crt SP292

Sheet: 3  
Of: 10Section  
1

Page Revision No:

Date: 17/11/06

Manual Issue No: 1 Date: 17/11/06

**2.0****OPERATIONAL DESCRIPTION**

There are four components to the system. These are the Generator, RTU, Pump MCC, and the Generator change over switchgear. The last component will be described within this document in detail. The remaining devices will be described in the BW manual.

**2.1****GENERATOR**

The generator and associated PLC controls all automatic aspects of the change over switchgear, in affect making the basic transfer switch into an Automatic Transfer switch (ATS). The ATS will only operate if the generator PLC is fully operational.

The operation of the ATS is NOT fail safe and will NOT return to a predetermined condition on failure of the generator PLC or associated wiring.

The transfer switch is a solenoid operated load break switch. The switch has Two positions only being "A" Mains and "B" Generator. There is NO "OFF" position.

Mains fail timing and return to mains timing is all controlled within the generator PLC.

**2.2****RTU**

The RTU monitors several generator alarm conditions and will report these conditions to the system as required.

The RTU can remotely start and stop the generator. The remote start will initiate a change over of the station to the generator. Stopping the generator will initiate a return to mains if available.

**2.3****PUMP STARTER MCC**

The pump starter MCC automatically starts and stops the pumps on demand determined by the wet well levels.

The starter has not been modified in any way to accommodate the generator ATS with the exception of the re-routing of the sub-mains cabling.

**2.3.1.****MCC MAIN SWITCH**

The Main Switch in all cases refers to the Energex supply point of isolation.

The existing main switch in the pump starter MCC, when labelled as the "Main Switch", will isolate the incoming Energex Mains Supply.

For complete isolation of the switchboards where an automatic generator system is supplied the generator must also be isolated.

Authorised By: Grant Kerr

**COMMON LOGIC Pty Ltd**  
**Specialist Electrical Contractors**
**Electrical Manual**

Subject: Wirriboot Crt SP292

Sheet: 4  
Of: 10Section  
1

Page Revision No:

Date: 17/11/06

Manual Issue No: 1 Date: 17/11/06

This must be carried out at the generator CB in the generator canopy as well as switching the control to the "OFF" position.

**2.3.2. MAINS AVAILABLE INDICATOR**

The mains available indicator mounted on the common control escutcheon is supplied by 24VDC originating from the RTU control supply.

The signal will be "ON" when the mains are healthy.

The mains available relay does indicate availability and correct rotation after 10 seconds.

**2.3.3. MAINS FAIL IN MCC**

The mains fail relay in the MCC is the device that assures the system has the correct rotation and supply available for the pumps to operate.

When re-connecting the generator to a site it is necessary to check the generator voltage rotation is also correct.

**2.3.4. GENERATOR RUNNING.**

The generator running indicator is supplied by 24VDC originating from the RTU control supply.

The indicator will be "ON" when the generator is running as determined by the generator PLC. IE GRR relay is on.

**2.4 ATS CUBICLE**

The ATS cubicle comprises sections as described below.

**2.4.1. GENERATOR INTERFACE**

The generator interface is via a Clipsal 27 Pin plug and socket.

The multicore cable is connected core 1 to pin 1 and 2-2 etc.

The Multicore cable is labelled wire No. G01 for core 1 to pin 1 and No.G02 –Core2- Pin2 etc.

This enables simple and quick reference to all wiring between the plug and the hardware within the ATS cubicle.

All signals received from the generator are arranged to switch a relay powered from the generator 24VDC system.

The exceptio to this is the "Generator Not On Site" signal, which wires directly to the RTU via the interface terminals.

All control signals to the Generator are via clean contacts. Both sides of the contact are issued to the generator. These contacts switch relays in the generator panel and are powered via the generator 24VDC system.

Authorised By: Grant Kerr

**COMMON LOGIC Pty Ltd**  
**Specialist Electrical Contractors**
**Electrical Manual**

Subject: Wirriboot Crt SP292

Sheet: 5  
Of: 10Section  
1

Page Revision No:

Date: 17/11/06

Manual Issue No: 1 Date: 17/11/06

**2.4.2. RTU INTERFACE**

The RTU interface is via a hard wired loom or multicore cable and terminals.  
 The Loom cable is numbered with the terminal RTU IO numbers.  
 The RTU connections are different for each site and may also have different polarities for each site according to the site hardware.

All signals received from the RTU are arranged to switch a relay powered from the RTU 24VDC system. IE Remote Exercise Generator only.  
 All signals to the RTU are via clean contacts. Both sides of the contact are issued to the RTU system. These contacts switch directly into the RTU Input cards. The voltage on these signal cables is 24VDC supplied from the RTU power supply.

**2.4.3. ATS AND CONTROL**

The transfer switch is a MAC-DT Solenoid operated Transfer switch.  
 The control of this switch is only achieved from the generator PLC. The PLC controls the relays CTSN and CTSG within the ATS panel.

Energising CTSN if the Mains Volts are available will open the Generator CB and Close the Mains CB.

Energising CTSG if the Generator Volts are available will open the Mains CB and Close the Generator CB.

If volts are not available the motors in the BTS will not operate. (IE stay in the last condition.

If the BTS does not operate the PLC will remove the transfer signal and assume a fault condition. This condition required manual operator intervention.

**Manual Operation:**

**If manual operation is desired then the following steps must be carried out.  
 Please note that it is not necessary to remove any covers when manually operating the CB's.**

If the PLC is issuing an undesirable status then the operation of the CB solenoids must first be isolated. This is best achieved by switching the CB's QM1 and QG1 to the off position. This removes the motor charge and open close commands to the operators. If the PLC is not affecting the transfer switch these CB's may be left in the ON state.

**Manual Open Mains and Close Generator:**

Turn off the CB's QM1 & QG1. To change state a suitably qualified operator must open the escutcheon door and using the Yellow handled operator, place the operator on the left side square shaft and pull the handle towards the bottom of the switch. This will change the state of the switch as indicated by the windows marked "A" and "B".

**Manual Open Generator and Close Mains:**

Turn off the CB's QM1 & QG1. To change state a suitably qualified operator must open the escutcheon door and using the Yellow handled operator, place the operator

Authorised By: Grant Kerr

**COMMON LOGIC Pty Ltd**  
**Specialist Electrical Contractors**
**Electrical Manual**

Subject: Wirriboot Crt SP292

Sheet: 6  
Of: 10Section  
1

Page Revision No:

Date: 17/11/06

Manual Issue No: 1 Date: 17/11/06

on the left side square shaft and pull the handle towards the bottom of the switch. This will change the state of the switch as indicated by the windows marked "A" and "B".

**Mains Fail detection:**

The mains fail relay detects the condition of the mains and issues a mains fail start signal to the PLC.

The mains fail relay also operates the mains available indicator on the MCC common control panel.

The mains fail signal also issues a condition to the RTU to indicate mains failed when the relay is de-energised.

Authorised By: Grant Kerr

**COMMON LOGIC Pty Ltd**  
**Specialist Electrical Contractors****Electrical Manual**

Subject: Wirriboot Crt SP292

Sheet: 7  
Of: 10Section  
2

Page Revision No:      Date: 17/11/06

Manual Issue No: 1    Date: 17/11/06

**3.0      DRAWINGS**

Authorised By: Grant Kerr





*Solenoid Operated*

# SEWAGE SYSTEM IMPROVEMENT 2005

## MOTORISED TRANSFER SWITCH INSTALLATION

### SP292 - WIRRIBOOT COURT, KARANA DOWNS

#### ELECTRICAL DRAWING INDEX

ELECTRICAL DRAWINGS INDEX									
DWG N°.	TITLE	ISSUE	REVISIONS						
	<del>MOTOR OPERATED</del> - AUTOMATIC TRANSFER SWITCH - SITE SPECIFIC INSTALLATION								
486/5/7-FK700	WIRRIBOOT COURT, KARANA DOWNS - GENSET A.T.S. INSTALLATION - ELECTRICAL DRAWING INDEX	06.2006	A	B	C	D			E
486/5/7-FK701	POWER DISTRIBUTION SCHEMATIC DIAGRAM	03.2006	A	B	C	D			
486/5/7-FK702	PUMP 01 SCHEMATIC DIAGRAM	10.2003	A	B	C				
486/5/7-FK703	PUMP 02 SCHEMATIC DIAGRAM	10.2003	A	B	C				
486/5/7-FK704	COMMON CONTROL & ALARMS SCHEMATIC DIAGRAM	06.2006	A	B	C				
486/5/7-FK705	PLC/RTU SCHEMATIC DIAGRAM	06.2006	A	B	C				
486/5/7-FK706	PLC/RTU TERMINATION DIAGRAM	06.2006	B	C	D	E			F
486/5/7-FK707	EQUIPMENT LIST	03.2006	A	B	C	D			
486/5/7-FK708	CABLE SCHEDULE	03.2006	A	B	C	D			
486/5/7-FK709	SWITCHBOARD LABEL SCHEDULE	11.2003	A	B					
486/5/7-FK710	SWITCHBOARD GENERAL ARRANGEMENT	03.2006	A	B	C	D			
486/5/7-FK711	SWITCHBOARD CONSTRUCTION NOTES	03.2006	A	B	C	D			
486/5/7-FK712	SWITCHBOARD CONSTRUCTION DETAILS	03.2003	A						
486/5/7-FK713	RAG REDUCTION TUBE FOR THE VEGA LEVEL PROBE	11.2003	A	B					
486/5/7-FK714	SITE LAYOUT	03.2006	A	B	C	D			E
486/5/7-PS000	DRAWING INDEX - ELECTRICAL INSTALLATION	05.2006	B	A	2				
486/5/7-PS003	TYPICAL <del>MOTOR OPERATED</del> - AUTOMATIC TRANSFER SWITCH - WIRING SCHEMATIC DIAGRAM	05.2006	B	A	2				
486/5/7-PS004	TYPICAL <del>MOTOR OPERATED</del> - AUTOMATIC TRANSFER SWITCH - CUBICLE ARRANGEMENT	05.2006	B	A	2				
486/5/7-PS006	TYPICAL <del>MOTOR OPERATED</del> - AUTOMATIC TRANSFER SWITCH - INTERCONNECTION DIAGRAM	05.2006	B	1					
486/5/7-PS007	AUTOMATIC TRANSFER SWITCH - ATS EXTENSION CUBICLE - TYPICAL CONCRETE BASE ARRANGEMENT	05.2006	B	1					

# = ISSUED FOR: EMERG'Y. GENERATOR  
TRANSFER SWITCH INSTALLATION

E

*Revised*

E	06.06	NEW BORDER. RE-DRAWN & RE-ISSUED FOR CONSTR	M.J.L.
D	03.06	APPROVED FOR CONSTRUCTION	M.J.L.
C	05.05	2005 GENSET UPGRADE	
No	DATE	AMENDMENT	DRN. APD.

Reference Drawings

DRAFTED	H.T.	10/3/03	C.J.	10/3/03
DRAFTING CHECK	A.M.	--/4/03	DESIGN	R.P.E.Q. No. DATE
CAD FILE	57FK700_E		DESIGN CHECK	R.P.E.Q. No. DATE
B.C.C. FILE No.			CLIENT DELEGATE	DATE

DESIGN	R.P.E.Q. No. DATE
CLIENT DELEGATE	DATE



PROJECT  
SUBMERSIBLE SEWAGE PUMP STATION  
SP292 - WIRRIBOOT CT., KARANA DOWNS  
SEWAGE SYSTEM IMPROVEMENT 2005

TITLE  
MOTORISED TRANSFER SWITCH  
ELECTRICAL INSTALLATION  
ELECTRICAL DRAWING INDEX


FOR CONSTRUCTION

SHEET No. 18	AMEND.
BRISBANE WATER DRAWING No.	
486/5/7-FK700	E









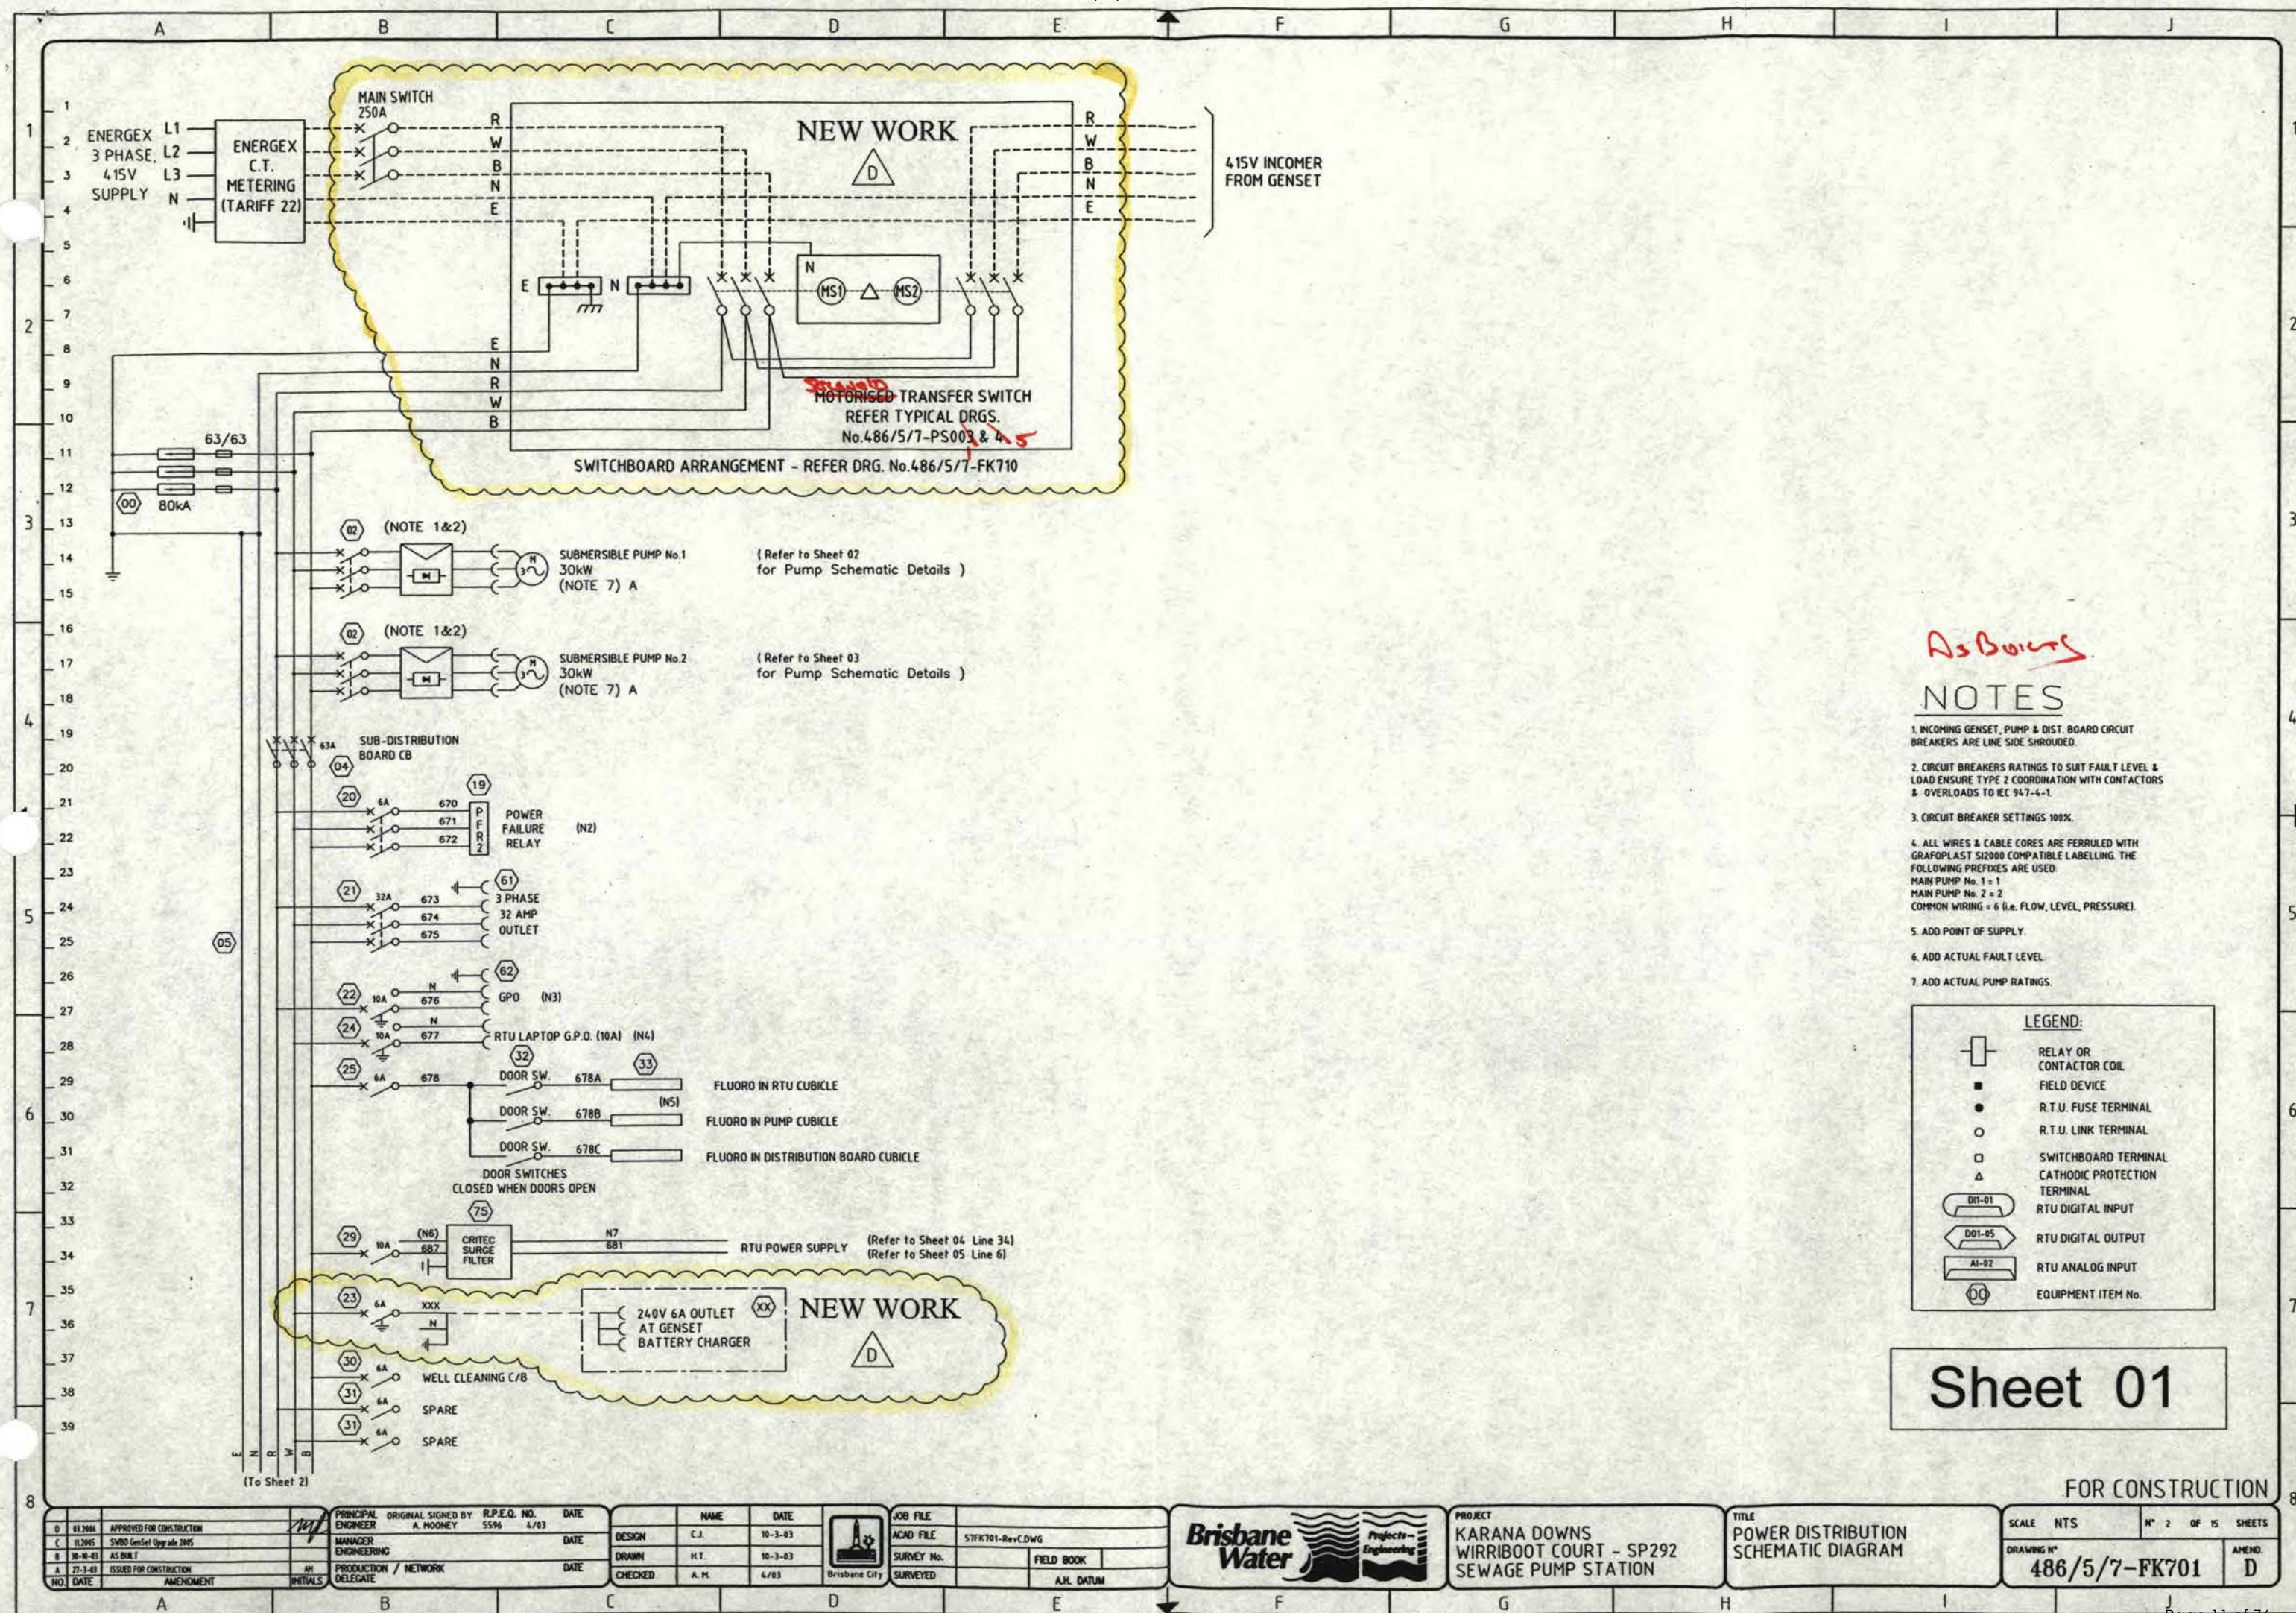










# ELV CONTROL

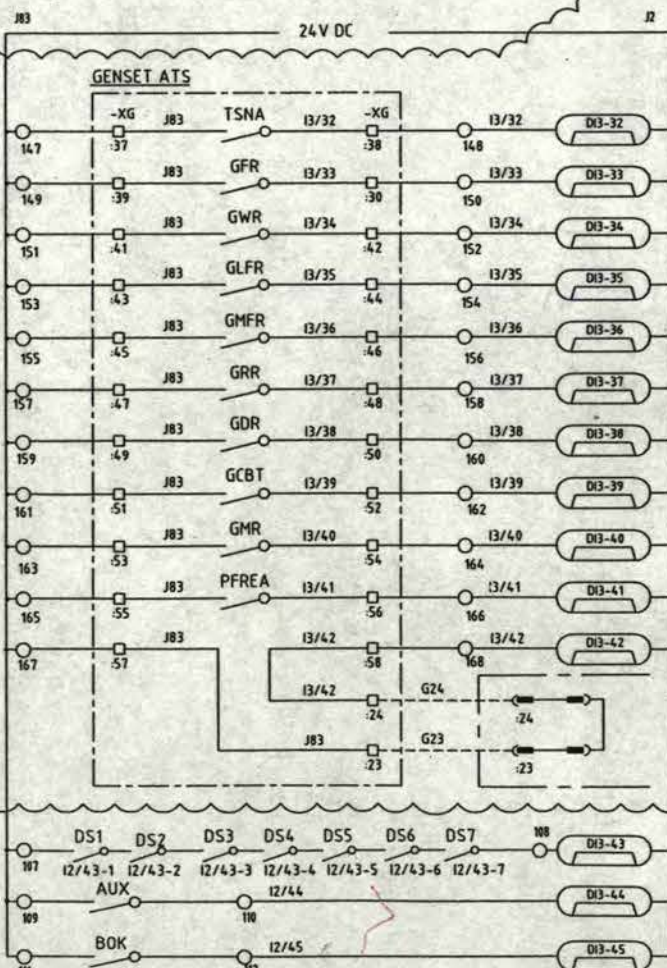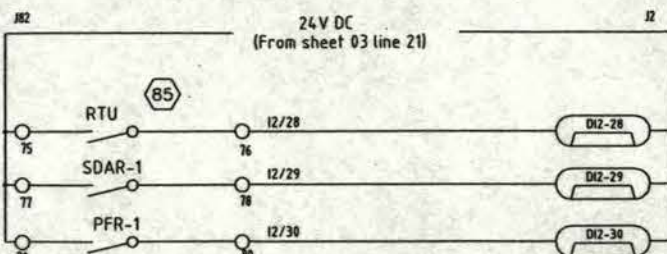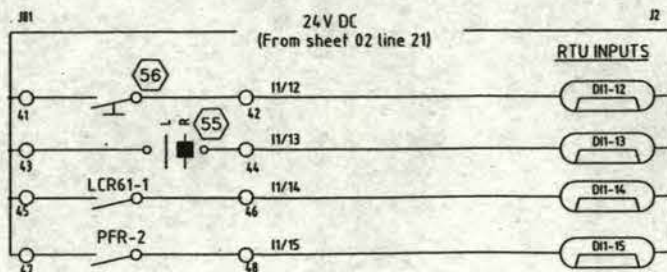

## NEW WORK

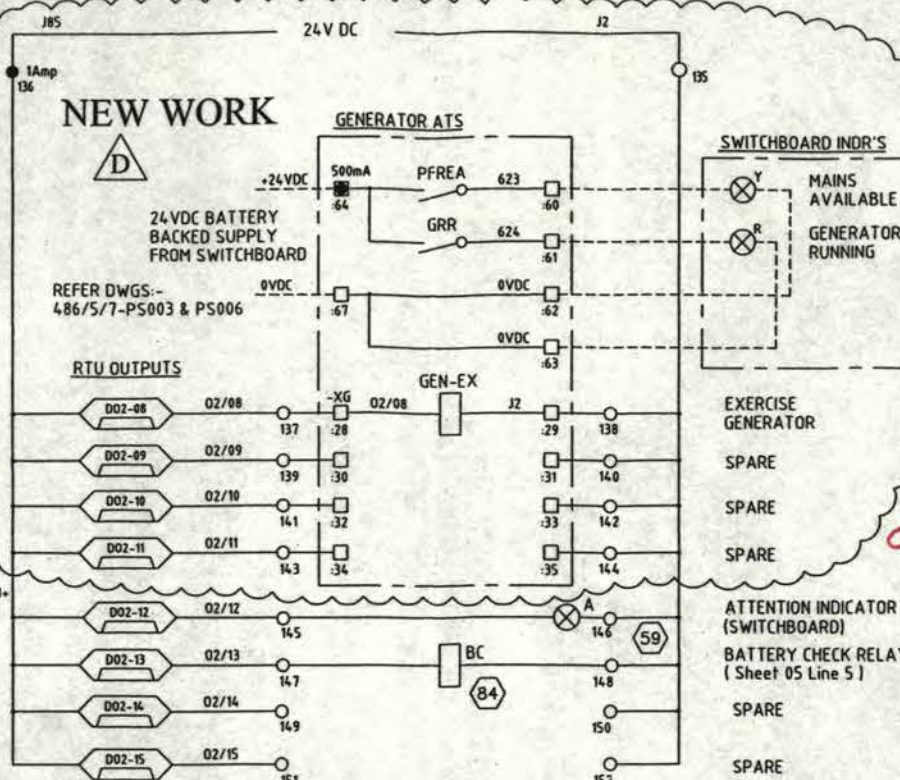


## LEGEND:

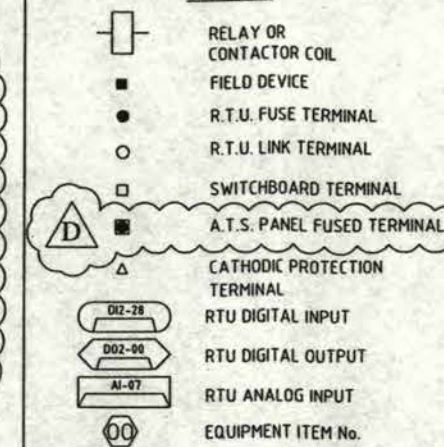


## NOTES

- ALL WIRES & CABLE CORES ARE FERRULED WITH GRAFOPLAST S12000 COMPATIBLE LABELLING. THE FOLLOWING PREFIXES ARE USED:  
MAIN PUMP No. 1 = 1  
MAIN PUMP No. 2 = 2  
COMMON WIRING = 6 (i.e. FLOW, LEVEL, PRESSURE)
- TERMINAL NUMBER SHOWN EITHER IMMEDIATELY BELOW, RIGHT OR LEFT OF TERMINAL.
- FUSE TERMINALS ARE TO BE FITTED WITH 100mA FUSE TERMINALS UNLESS OTHERWISE SHOWN.
- DOOR SWITCHES TO BE INSTALLED ON ALL DOORS.


## 24 V DC CONTROL

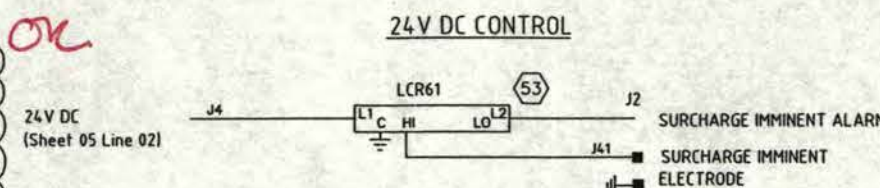


## RTU ANALOG INPUTS FOR INSTRUMENTS

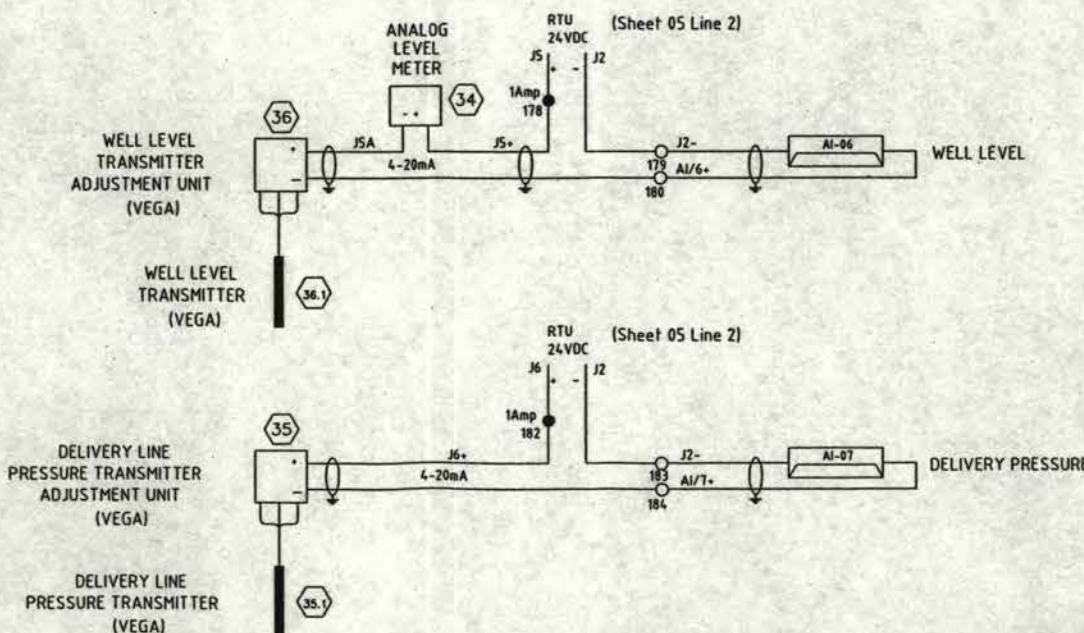

## RTU ANALOG INPUTS (NOTE 2&3)

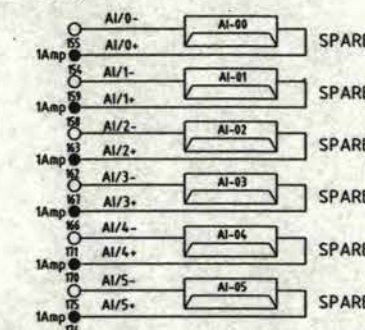

## SURGE DIVERTERS

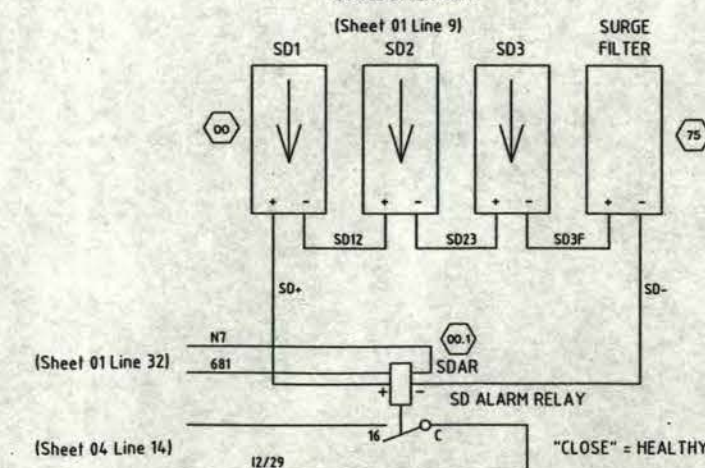

Sheet 04

FOR CONSTRUCTION

D 14-2006 C 03-2006 B 28-10-03 A 27-3-03 NO. DATE	RE-ASSIGNED FOR CONSTRUCTION APPROVED FOR CONSTRUCTION AS BUILT ISSUED FOR CONSTRUCTION AMENDMENT	PRINCIPAL ENGINEER MANAGER ENGINEERING PRODUCTION / NETWORK DELEGATE	ORIGINAL SIGNED BY A. MOONEY DATE 4/03	R.P.E.Q. NO. 5596 DATE 4/03	NAME C.J. DATE 11-3-03	DESIGN H.T. DATE 11-3-03	CHECKED A.H. DATE 4/03	JOB FILE ACAD FILE SURVEY No. SURVEYED	57FK704.DWG FIELD BOOK A.H. DATUM	PROJECT KARANA DOWNS WIRRIBOOT COURT - SP292 SEWAGE PUMP STATION	TITLE COMMON CONTROLS AND ALARMS SCHEMATIC DIAGRAM	SCALE NTS	N° 5 OF 15 SHEETS	DRAWING N° 486/5/7-FK704	AMEND. D
---	---	--	---	--------------------------------------	---------------------------------	-----------------------------------	---------------------------------	---	---	---	---	--------------	-------------------	-----------------------------	-------------







## NOTES

1. TERMINAL NUMBER SHOWN EITHER IMMEDIATELY BELOW, RIGHT OR LEFT OF TERMINAL.

## LEGEND:

- RELAY OR CONTACTOR COIL
- FIELD DEVICE
- R.T.U. FUSE TERMINAL
- R.T.U. LINK TERMINAL
- SWITCHBOARD TERMINAL
- CATHODIC PROTECTION TERMINAL
- RTU DIGITAL INPUT
- RTU DIGITAL OUTPUT
- RTU ANALOG INPUT
- EQUIPMENT ITEM No.

NEW WORK

EXTENSION BOARD

NEW WORK

Sheet 05


APPROVED FOR CONSTRUCTION

D 16/2004 C 03/2006 B 30-09-03 A 27-3-03 NO. DATE AMENDMENT	RE-ISSUED FOR CONSTRUCTION APPROVED FOR CONSTRUCTION AS BUILT ISSUED FOR CONSTRUCTION AMENDMENT	PRINCIPAL ORIGINAL SIGNED BY: R.P.E.Q. NO. DATE ENGINEER A. HOONEY 5594 4/03 MANAGER ENGINEERING PRODUCTION / NETWORK DELEGATE	NAME DATE DESIGN C.J. 11-3-03 DRAWN H.T. 11-3-03 CHECKED A.M. 4/03	JOB FILE ACAD FILE 57FK705_C.DWG SURVEY No. FIELD BOOK SURVEYED A.H. DATUM		PROJECT KARANA DOWNS WIRRIBOOT COURT - SP292 SEWAGE PUMP STATION	TITLE PLC/RTU SCHEMATIC DIAGRAM	SCALE NTS DRAWING N° 486/5/7-FK705 N° 6 OF 15 SHEETS AMEND. D
--	---	---	---	---	--	---	---------------------------------------	--







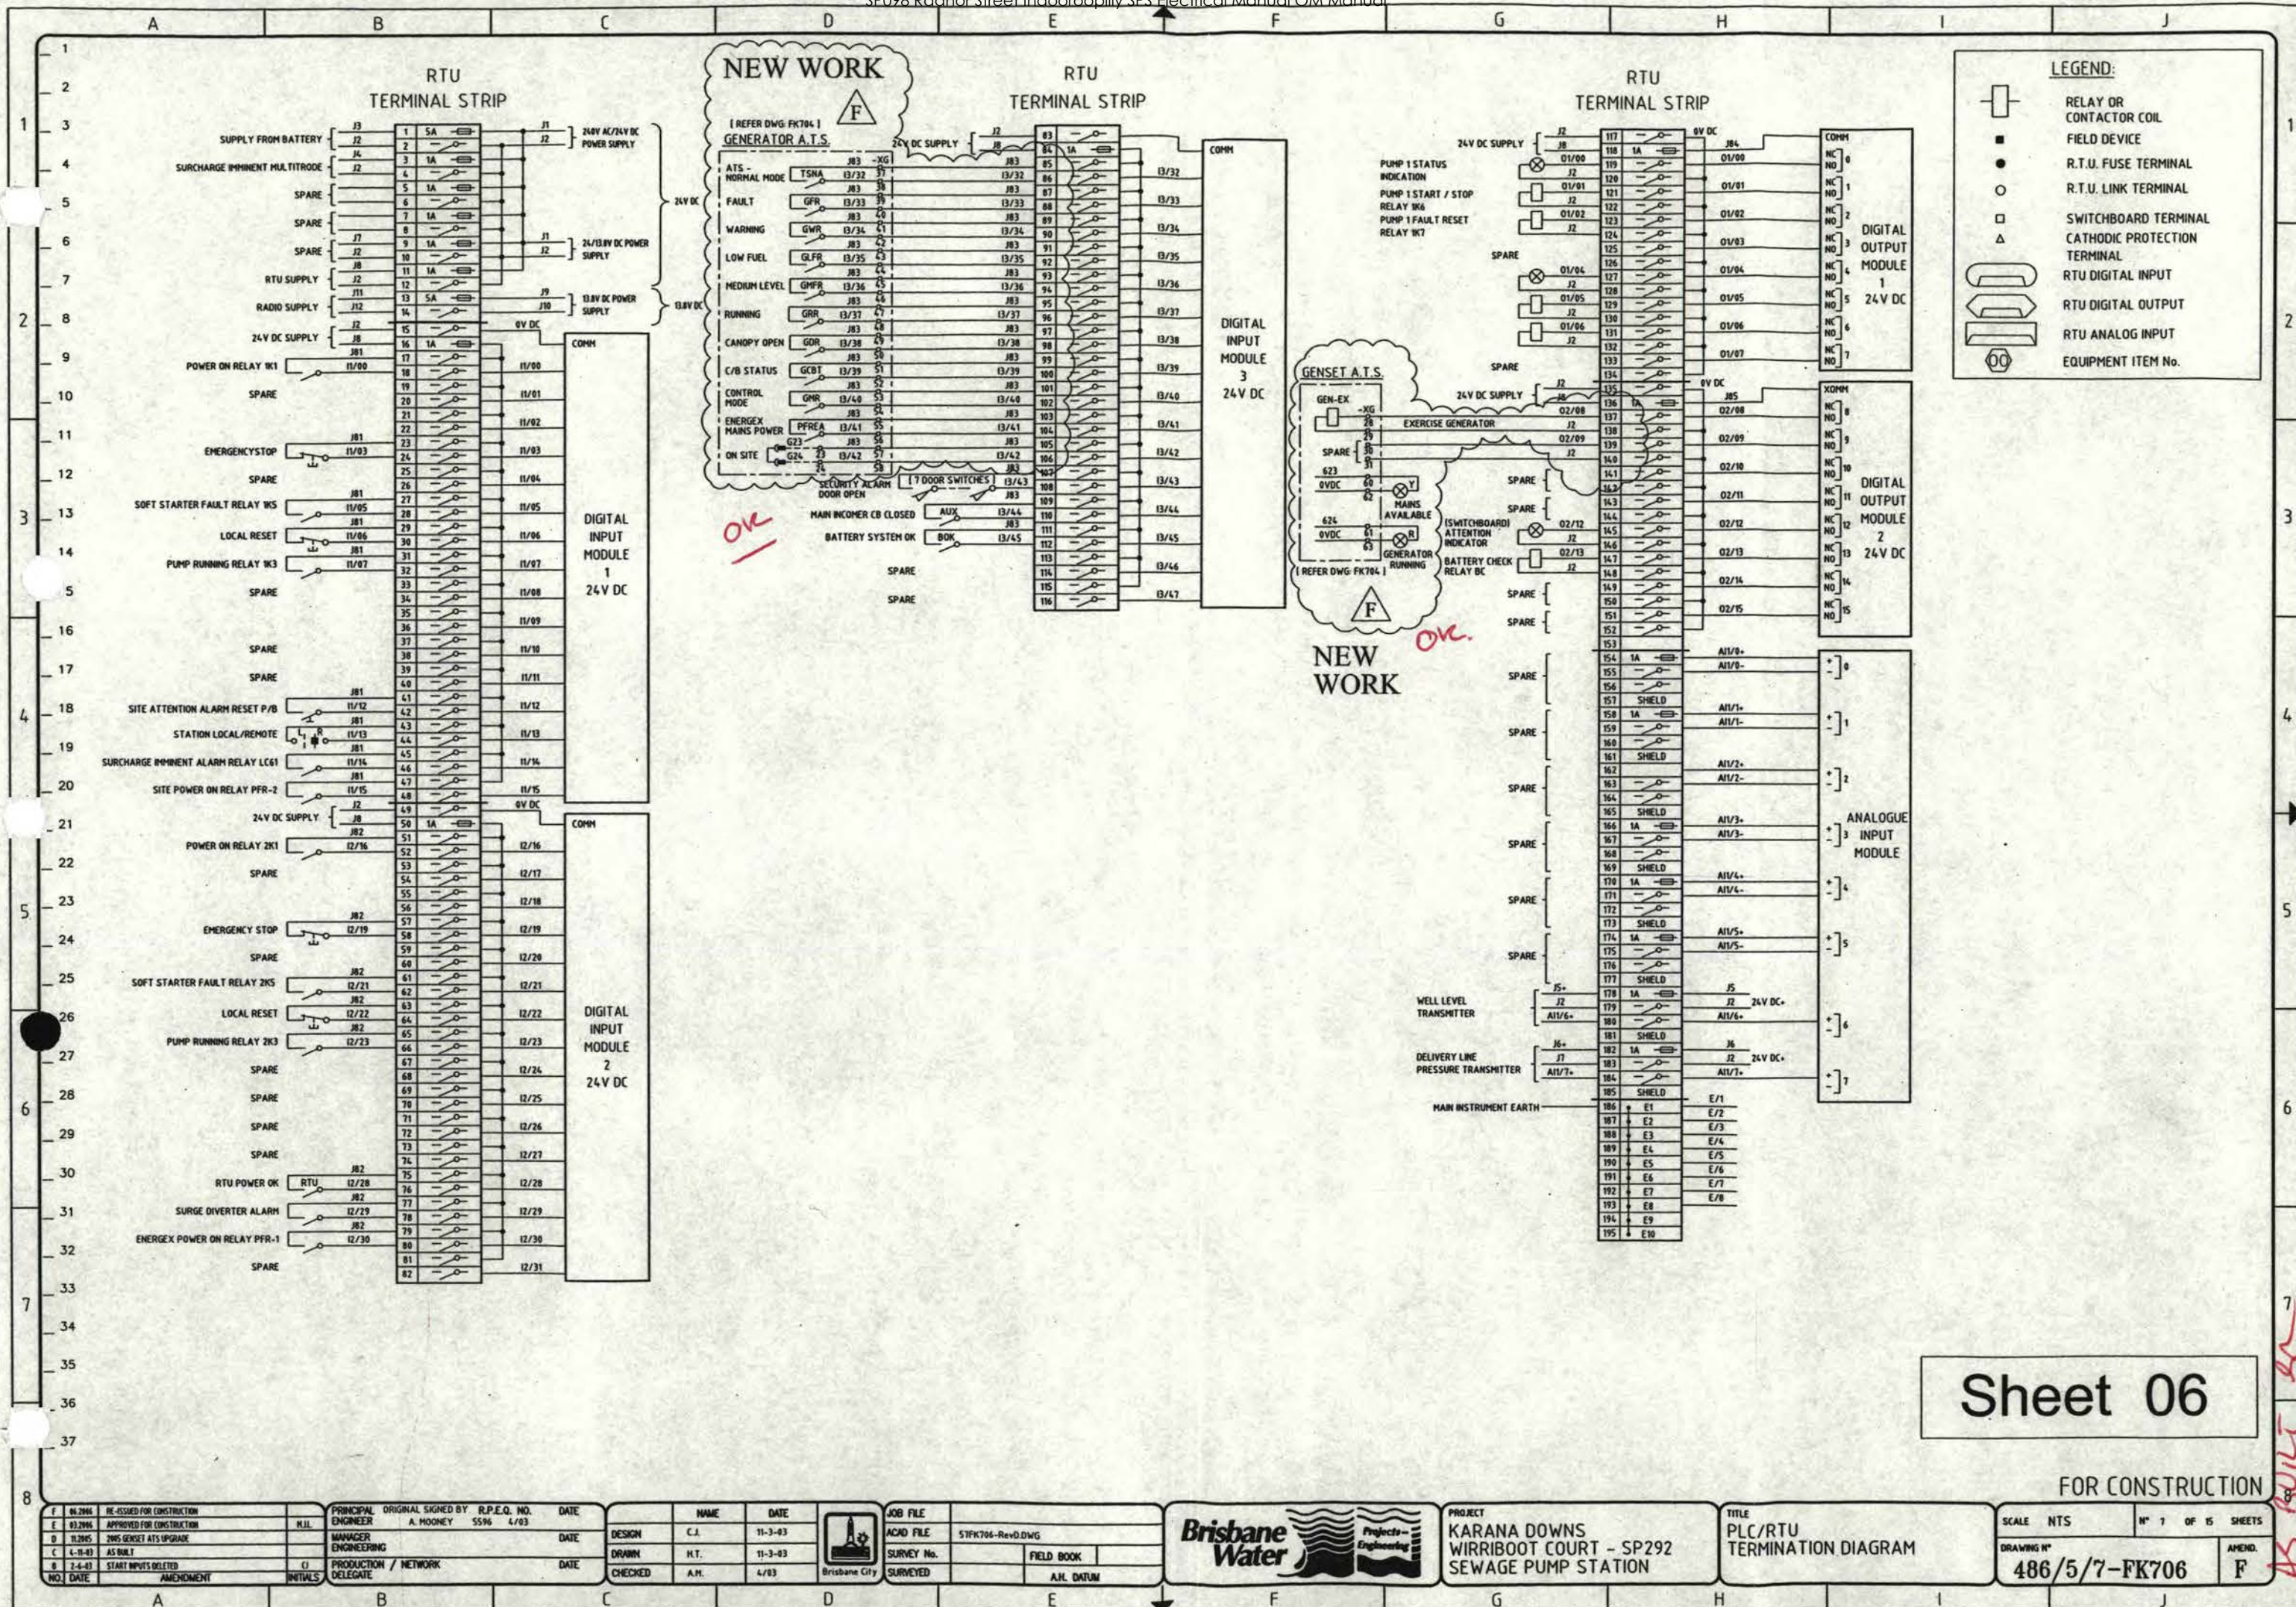







2. CATALOG No. TO SUIT RATING OF PUMP FOR NORMAL SOFT STARTED DUTY

NEW  
WORK

Sales D.D. created  
A/T/S

NEW  
WORK

NEW WORK

As Bunt

Sheet 07

FOR CONSTRUCTION

EQUIPMENT LIST

SCALE	NTS	N°	8	OF	15	SHEETS
DRAWING N°						AMEND.
486/5/7-FK707						D

Q-Pulse Id TMS1053

Active 10/12/2014

Page 19 of 76








1	
2	
3	
4	
5	
6	
7	

A vertical number line with tick marks labeled 1 through 8. An arrow points to the tick mark labeled 4.

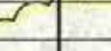

**NEW  
WORK**

**△  
D**


**GENSET CABLES  
TO BE INSTALLED**

Page 21 of 76









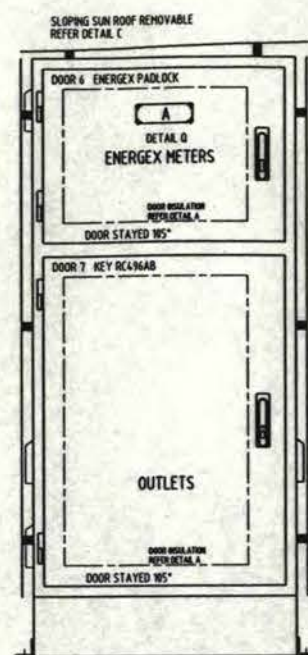


LEFT HAND VIEW

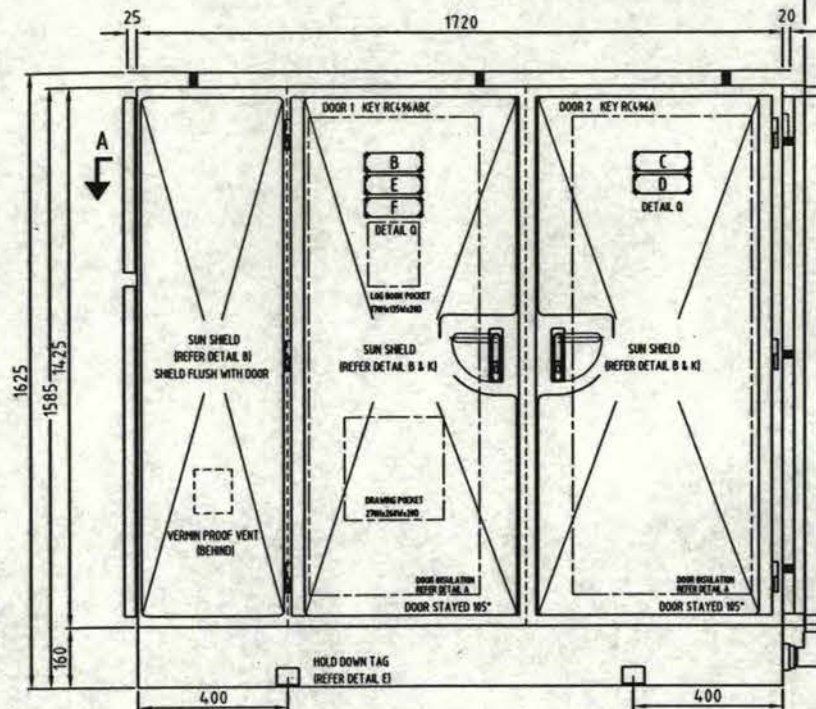





FRONT VIEW

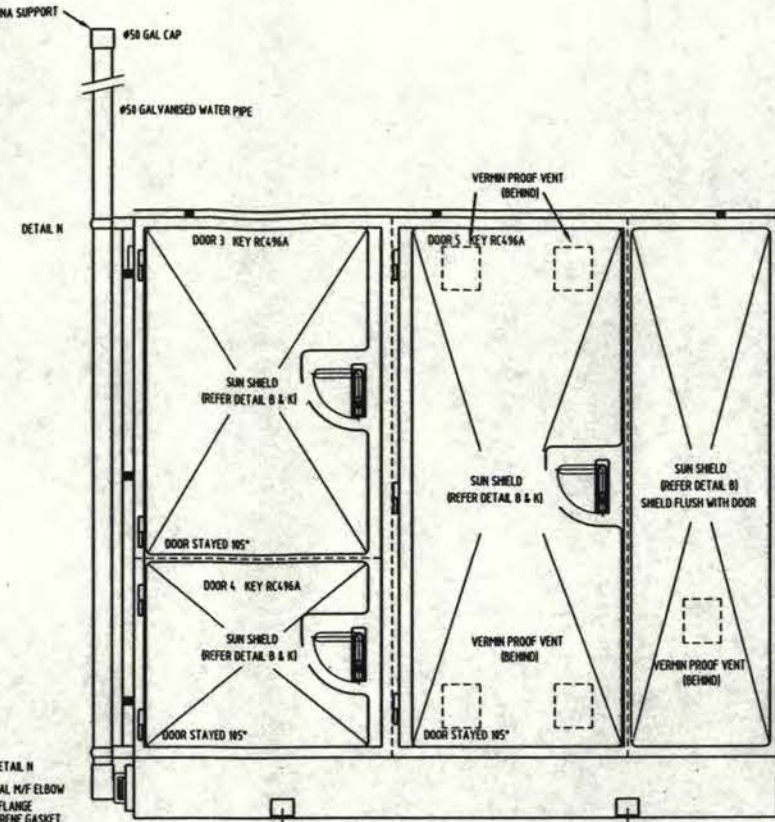

REAR VIEW

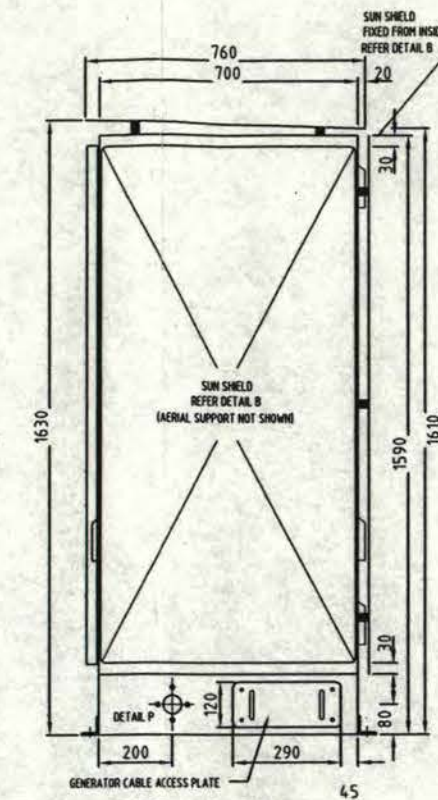

RIGHT HAND VIEW

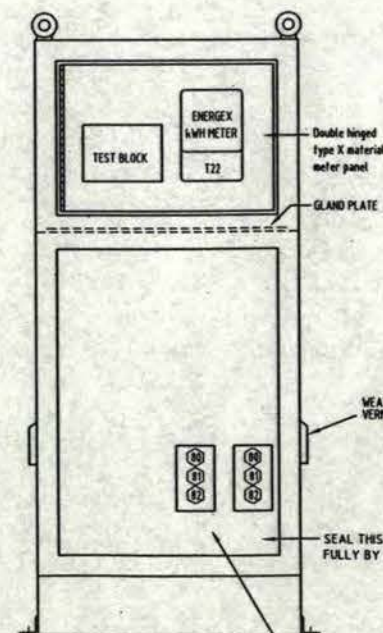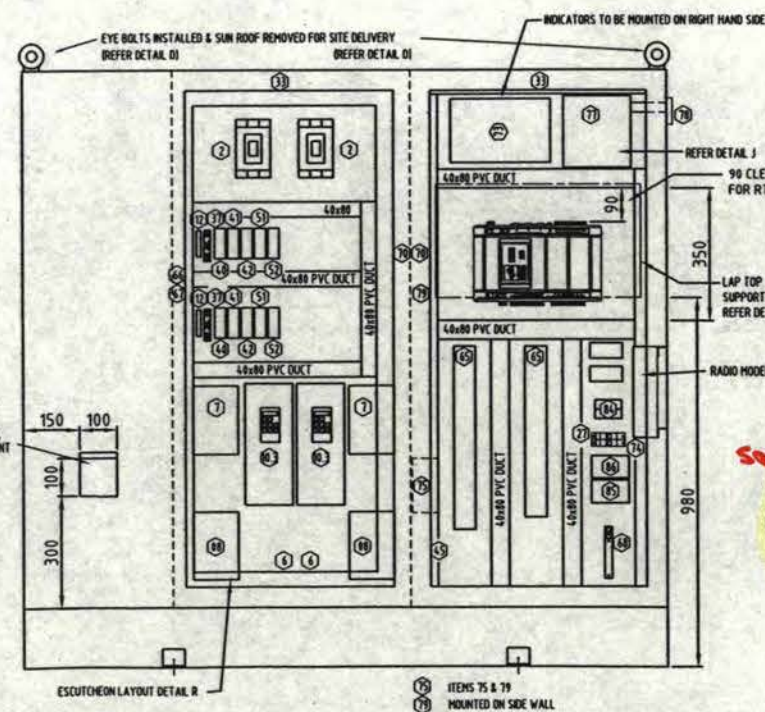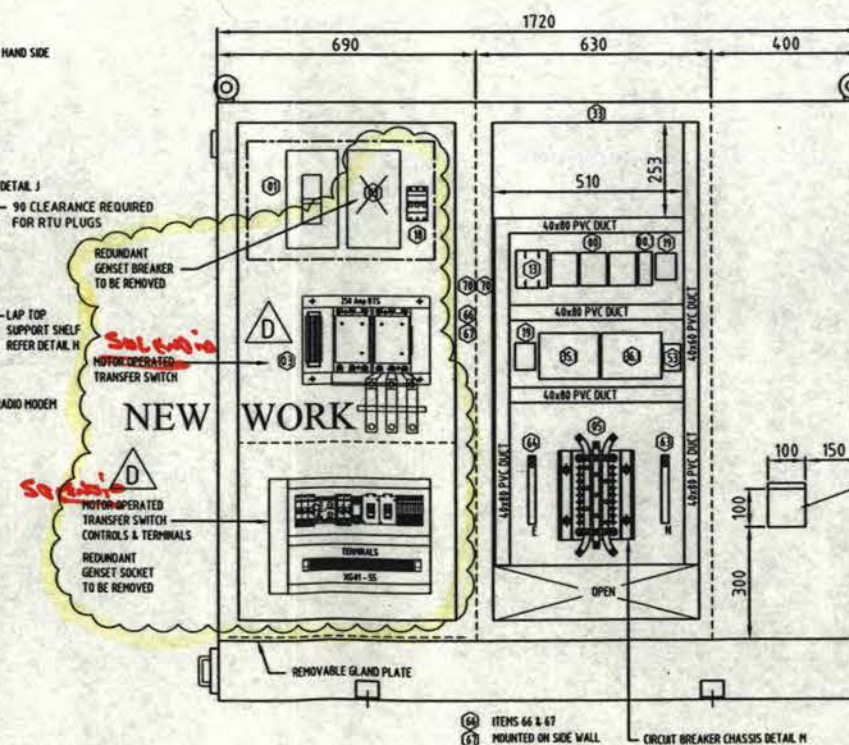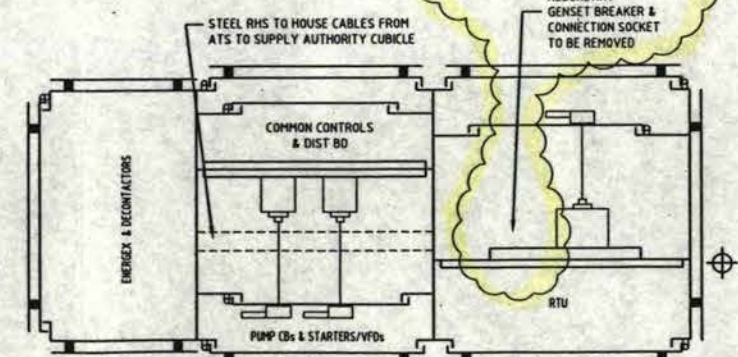LEFT HAND ELEVATION  
DOORS & SHIELDS REMOVEDFRONT ELEVATION  
DOORS & SHIELDS REMOVEDREAR ELEVATION  
DOORS & SHIELDS REMOVED

SECTION A-A

NEW WORK

As Bored

Sheet 10

NO.	DATE	AMENDMENT	INITIALS	PRINCIPAL ENGINEER	R.P.E.Q. NO.	DATE	NAME	DATE	JOB FILE	ACAD FILE	SURVEY No.	FIELD BOOK	PROJECT	TITLE	SCALE	N° 11 OF 15 SHEETS	AMEND.
0	03/2006	APPROVED FOR CONSTRUCTION		A. MOONEY	5596	4/03	DESIGN	C.J.	11-3-03	STFK710-RevC.DWG			KARANA DOWNS WIRRIBOOT COURT - SP292 SEWAGE PUMP STATION	SWITCHBOARD GENERAL ARRANGEMENT	1:10		D
1	11/2005	2005 GENSET UPGRADE					DRAWN	H.T.	11-3-03								
2	28-4-03	LAYOUT REVISED					CHECKED	A.M.	4/03								
3	27-3-03	ISSUED FOR CONSTRUCTION															







**CONSTRUCTION**

Cubicle construction 3mm Marine grade Aluminium (5251).  
Plinth construction 160x60 channel 6061 T6 Grade Aluminium.  
Folded, "Pulse MIG" & "TIG" welded with all visible seams and joints fully welded, free from splatter and ground smooth where needed.  
External doors and covers fitted with Emka 1011-207 self grip seal.  
"D" Handles fitted where indicated on the drawings.  
M6 Earth studs fixed to the interior of all doors and hinged escutcheons and on adjacent cubicle interior surfaces.  
Door stiffeners, door stays, cable straps, and document holders etc fitted where shown on the drawings.  
Lift-off covers and mounting panels fixed with M6 studs & chrome acorn nuts.  
Gland plates manufactured from 6mm Bakelite.  
Gland plate openings reinforced with 25x6mm flat aluminium bar.  
Gland plate seals attached to cubicle not gland plate.  
Gland plate fixings are NOT more than 150 mm apart (refer Detail F).  
Hinges Selectrix HI-B659.  
Star washers fitted under all hinge screws.  
Locks Doors 1-5, 7  
Selectrix 1107 - PSCU1 handle  
Selectrix 1107-U123 3pt cam  
Lockwood 71 Barrel Lock  
Emka 1049-U3 roller rod  
Key Codes RC496A, RC496AB, RC496ABC refer to each door for clarification.

**Lock Door 6**

Selectrix 1107-PSC01 handle  
Selectrix 1107-U123 3pt cam  
Emka 1049-U3 roller rod  
ENERGEX Lockwood No234B brass pin tumbler padlock.  
Hinged escutcheons fixed with Emka 1/4 turn 1000-U147.

**OPERATING PARAMETERS**

Standard	AS 3439.1
Current & Frequency	AC 50Hz
Rated Operational Voltage	415 VAC
Rated Insulation Voltage	660 V
Rated Auxiliary Voltage	24 VDC / 240 VAC
Rated Current (Main Bus)	400 AMPs
Short Circuit Current	35 kA
Duration of Isc	1 sec
Degree of Protection	IP 55 to AS 1939
Measure of Protection by barriers and enclosures	
Service Conditions	Outdoors
Mass	Not exceeding 2000kg
Forms of Segregation	Form 1
Earthing System	TN-S

**PAINING**

Aluminium Surface Preparation.  
Finish smooth all exposed welds, clean, descale, and degrease all surfaces.  
Surfaces pretreatment in accordance with AS 1580 & AS 3715 using Novox LF acid etch cleaner, Novacoat 12 conversion coating, & clean water rinses.  
Apply DULUX ALPHATECH 3000 powder coat to manufacturer's recommendations.  
INTERNAL & EXTERNAL COMPONENTS -- DULUX Mist Green (3664B) matt finish.  
SUPERIOR ITEMS (mounting panels, escutcheons, etc) -- DULUX Bright White (32966).  
Minimum Dry Film Thickness all surfaces 50 microns.

**WIRING**

All wiring to be PVC V90 HT 0.6/1kV Grade with tinned conductor.  
Control and instrumentation wiring has flexible copper conductors, and is colour coded as detailed below, numbered each end, and terminated by the use of appropriate pre-insulated crimp lugs.  
Power wiring to be minimum 2.5sqmm stranded copper conductors, phase colour coded as detailed below.  
Low level instrumentation signals & 4-20mA signals wired in shielded pair minimum size 0.5sqmm. Earthed at one end only.  
Earth cables minimum 2.5sqmm flexible.  
Doors and hinged escutcheons bonded with 4sqmm flexible earth strap.  
Wire numbering will be equal to Grafoplast SI2000 system.  
Wire numbers are readable left to right, bottom to top as shown.

2111

**COLOUR CODE**

Phase wiring (A,B & C)	Red, White, Blue	2.5sqmm (min)
Potential Metering (240/415 VAC)	Red, White, Blue, Black	1.5sqmm
Current Metering (Secondary)	Red, White, Blue, Grey	2.5sqmm
240 VAC Control Active	Red	1.5sqmm
240 VAC Neutral	Black	1.5sqmm
24 V ELV Positive	Orange	1.5sqmm
24 V ELV Negative	Violet	1.5sqmm
24 V RTU Positive	Orange	0.5sqmm
24 V RTU Negative	Violet	0.5sqmm
RTU Wiring	Grey	0.5sqmm
Intrinsically safe wiring	Blue	1.5sqmm
Earth	Green/Yellow	2.5sqmm (min)
Door & Escutcheon Earth Bonds	Green/Yellow	4 sqmm

**LABELS**

Internal labels W/B/W engraved traillotype to label schedule.  
Warning labels R/W/R engraved traillotype.


Main switch labels	MAIN SWITCH 400A	10mm	6mm	Material B/W/B
Compartment labels	RTU	10mm		Material W/B/W
Warning labels	DANGER 415V ISOLATE ELSE WHERE	7mm	5mm	Material R/W/R
Other labels	PUMP STATUS ON - RUNNING SLOW FLASH - FAULT FAST FLASH - START INHIBITED		4mm	Material W/B/W

Internal labels secured by M3 chrome plated metal threads.  
Labels obstructed by switchboard wiring are relocated to adjacent duct lid.  
The duct lid is secured by a single cable tie at one corner.  
External labels secured by M3 316 stainless steel metal threads.



LABEL	TEXT	TEXT HEIGHT	FONT FILL LETTERING	DIMENSIONS	QUANTITY
A	SUPPLY AUTHORITY METER PANEL	10mm	Black	300x20	1
B	SPINLOCK	20mm	Black	150x25	1
C	WARNING THIS SITE IS MONITORED BY NETWORK CONTROL PLEASE INFORM THE OPERATOR BEFORE ISOLATING PUMPS OR STATION	8mm	Black	250x100	1
D	PLEASE CHECK THAT THE PUMPS ARE IN REMOTE MODE BEFORE LEAVING SITE	8mm	Black	200x40	1
E	DANGER 415V	8mm	Red	100x15	1
F	ELECTRONIC SOFT STARTERS No.1 & No.2	10mm	Black	300x25	1

External labels 3mm 316 grade stainless steel.  
Fixed with M3 316 stainless steel metal threads.


DETAIL Q  
(EXTERNAL STAINLESS STEEL LABEL DETAIL)

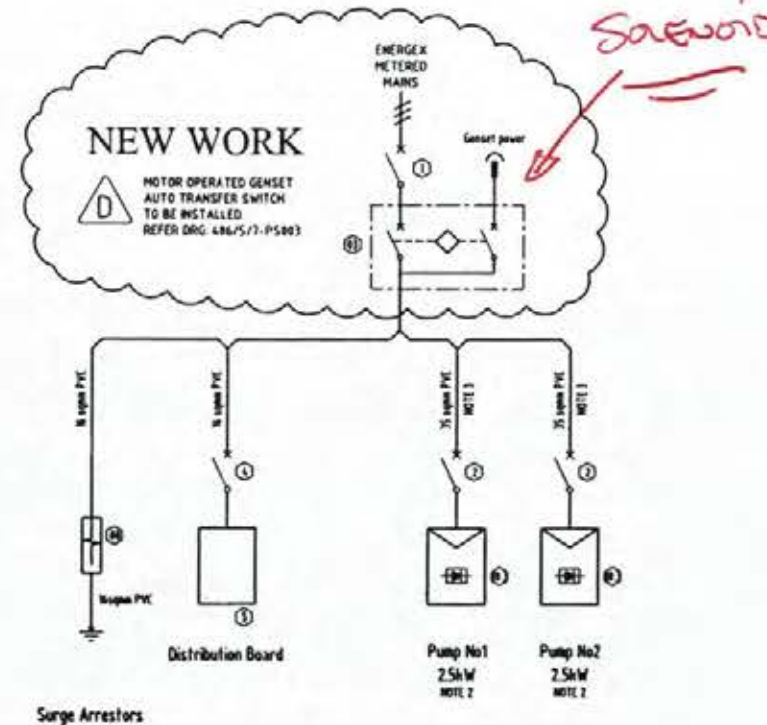

POWER WIRING DETAIL

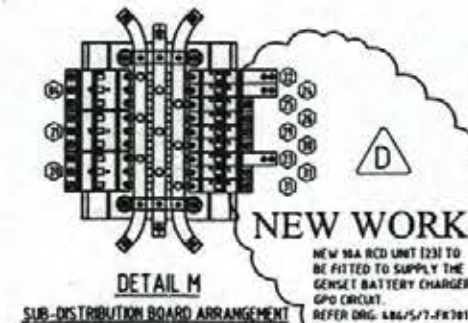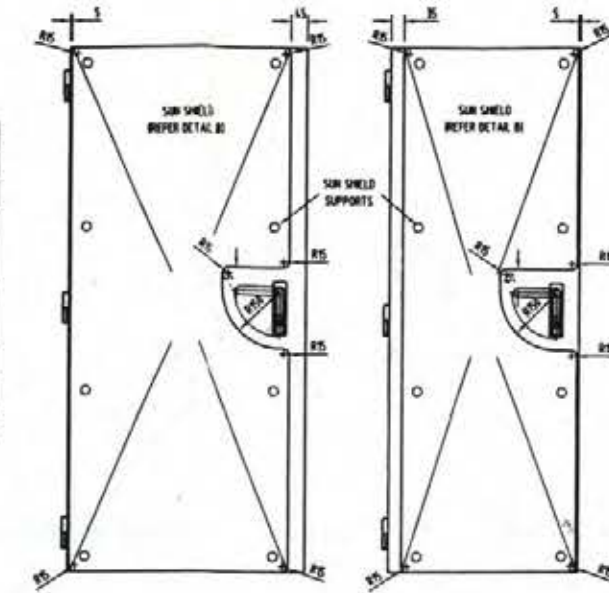DETAIL M  
SUB-DISTRIBUTION BOARD ARRANGEMENT

DETAIL K  
(DOOR SUN SHIELD DETAIL)

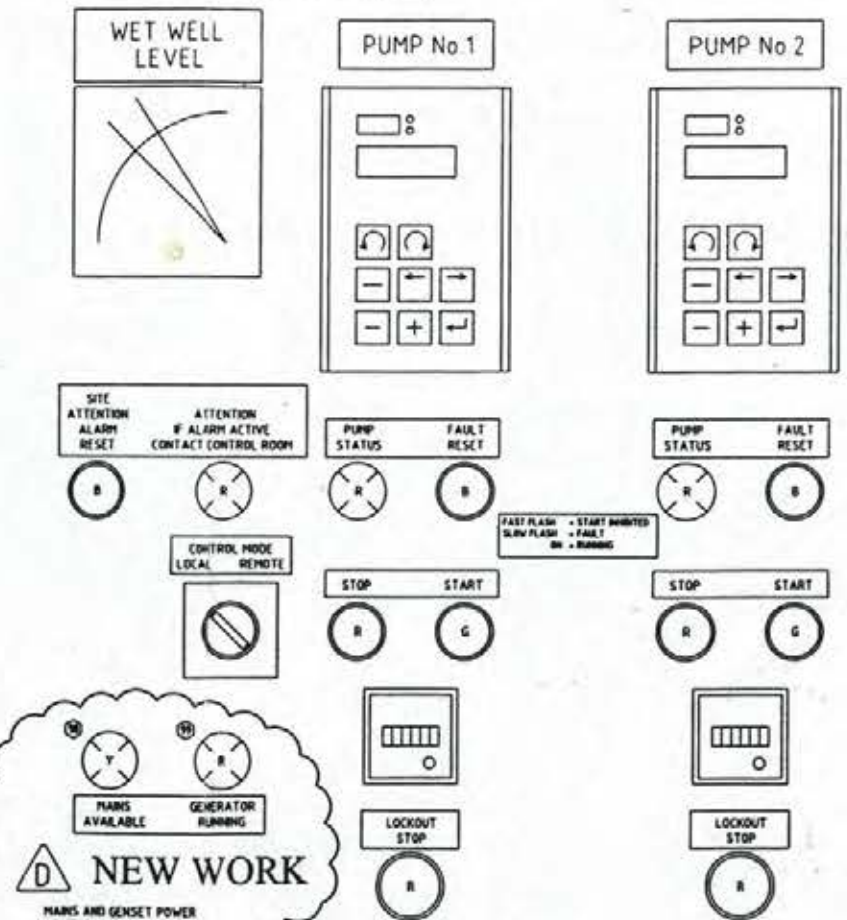

TYPICAL ESCUTCHEON LAYOUT



PUMPS INTERLOCKED

WIRRIBOOT COURT	
ACTUAL SURCHARGE	77%
SURCHARGE INHIBIT	77%
START DUTY PUMP	77%
STOP DUTY PUMP	77%
LEVEL PROBE LENGTH	77%
LEVEL PROBE RANGE	77%

# Sheet 11

FOR CONSTRUCTION

NO.	DATE	REVISION	DESCRIPTION	DESIGNED BY	CHECKED BY	DATE	PROJECT	TITLE	SCALE	NTS	Nº 11 OF 15 SHEETS	APPROVED BY
1	11/12/2014		APPROVED FOR CONSTRUCTION	A. MOONEY	A. MOONEY	11/12/2014	KARANA DOWNS WIRRIBOOT COURT - SP292 SEWAGE PUMP STATION	SWITCHBOARD CONSTRUCTION NOTES				
2	11/12/2014		DESIGN	C. J.	C. J.	11/12/2014						
3	11/12/2014		DRAWN	H. T.	H. T.	11/12/2014						
4	11/12/2014		CHECKED	A. M.	A. M.	11/12/2014						

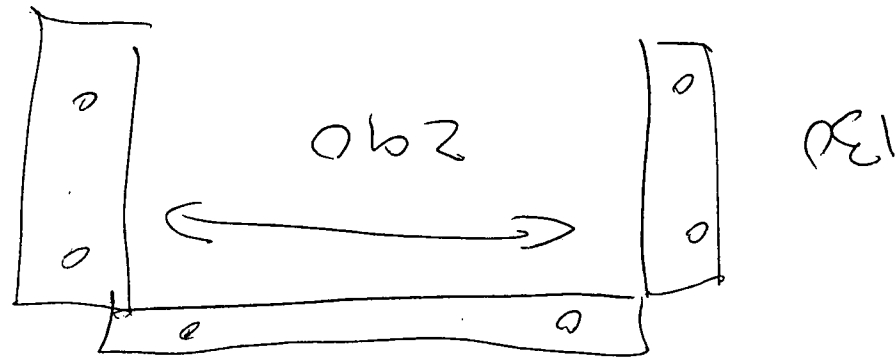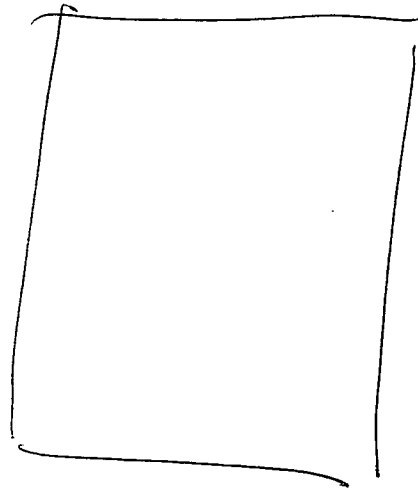



FOR CONSTRUCTION

[illegible]







ELECTRICAL DRAWINGS INDEX									
DWG N°.	TITLE	ISSUE	REVISIONS						
486/5/7-PS000	DRAWING INDEX - ELECTRICAL INSTALLATION	05.2006	0	1	2	3			
486/5/7-PS001	TYPICAL SOLENOID OPERATED - AUTOMATIC TRANSFER SWITCH - WIRING SCHEMATIC DIAGRAM	05.2006	0	1	2				
486/5/7-PS002	TYPICAL SOLENOID OPERATED - AUTOMATIC TRANSFER SWITCH - CUBICLE ARRANGEMENT	05.2006	0	1	2				
486/5/7-PS003	TYPICAL MOTOR OPERATED - AUTOMATIC TRANSFER SWITCH - WIRING SCHEMATIC DIAGRAM	05.2006	0	1	2				
486/5/7-PS004	TYPICAL MOTOR OPERATED - AUTOMATIC TRANSFER SWITCH - CUBICLE ARRANGEMENT	05.2006	0	1	2				
486/5/7-PS005	TYPICAL SOLENOID OPERATED - AUTOMATIC TRANSFER SWITCH - INTERCONNECTION DIAGRAM	05.2006	0	1					
486/5/7-PS006	TYPICAL MOTOR OPERATED - AUTOMATIC TRANSFER SWITCH - INTERCONNECTION DIAGRAM	05.2006	0	1					
486/5/7-PS007	AUTOMATIC TRANSFER SWITCH - ATS EXTENSION CUBICLE - TYPICAL CONCRETE BASE ARRANGEMENT	05.2006	0	1					
	SOLENOID OPERATED - AUTOMATIC TRANSFER SWITCH - SITE SPECIFIC INSTALLATIONS								
486/5/7-KI440	RADNOR STREET INDOOROPILLY - GENSET A.T.S. INSTALLATION - ELECTRICAL DRAWING INDEX	03.2006	A	B	C	D			
486/7/85-KJT070	BRISBANE STREET TOOWONG - GENSET A.T.S. INSTALLATION - ELECTRICAL DRAWING INDEX	03.2006	A	B	C				
486/5/7-QT200	RAUBERS ROAD NORTHGATE - GENSET A.T.S. INSTALLATION - ELECTRICAL DRAWING INDEX	03.2006	A	B	C				
486/5/7-TQ035	SUGARMILL ROAD MEEANDAH - GENSET A.T.S. INSTALLATION - ELECTRICAL DRAWING INDEX	03.2006	A	B	C	D			
486/5/7-FD015	LAGOON CRESCENT BELLBOWRIE - GENSET A.T.S. INSTALLATION - ELECTRICAL DRAWING INDEX	03.2006	A	B	C				
	MOTOR OPERATED - AUTOMATIC TRANSFER SWITCH - SITE SPECIFIC INSTALLATIONS								
486/5/7-FD410	BIRKIN ROAD BELLBOWRIE - GENSET A.T.S. INSTALLATION - ELECTRICAL DRAWING INDEX	03.2006	C	D	E	F			
486/5/7-FD135	PIONEER CRESCENT BELLBOWRIE - GENSET A.T.S. INSTALLATION - ELECTRICAL DRAWING INDEX	03.2006	A	B	C	D			
486/5/7-FK700	WIRRIBOOT COURT KARANA DOWNS - GENSET A.T.S. INSTALLATION - ELECTRICAL DRAWING INDEX	03.2006	A	B	C	D			

SOLAR-OPERATED

As Boiler  
FOR CONSTRUCTION

3	06.06	RE-ISSUED FOR CONSTRUCTION. REVISION UPDATES			DRAFTED	M.J. LIGHTBODY					PROJECT SEWAGE SYSTEM IMPROVEMENT 2005 STANDBY GENERATORS	TITLE AUTOMATIC TRANSFER SWITCH ELECTRICAL INSTALLATION ELECTRICAL DRAWING INDEX	SHEET No. 18 BRISBANE WATER DRAWING No. <b>486/5/7-PS000</b>	AMEND. <b>3</b>		
2	05.06	NEW BORDER. RE-ISSUED FOR CONSTRUCTION	MJL		DRAFTING CHECK		DESIGN	R.P.E.Q. No.	DATE						PRINCIPAL DESIGN MANAGER	DATE
1	04.06	DRAWINGS PS005, 6 AND 7 ADDED	MJL		CAD FILE	57PS000_3										
No.	DATE	AMENDMENT	DRN.	APD.	Reference Drawings	B.C.C. FILE No.	DESIGN CHECK	R.P.E.Q. No.	DATE						CLIENT DELEGATE	DATE












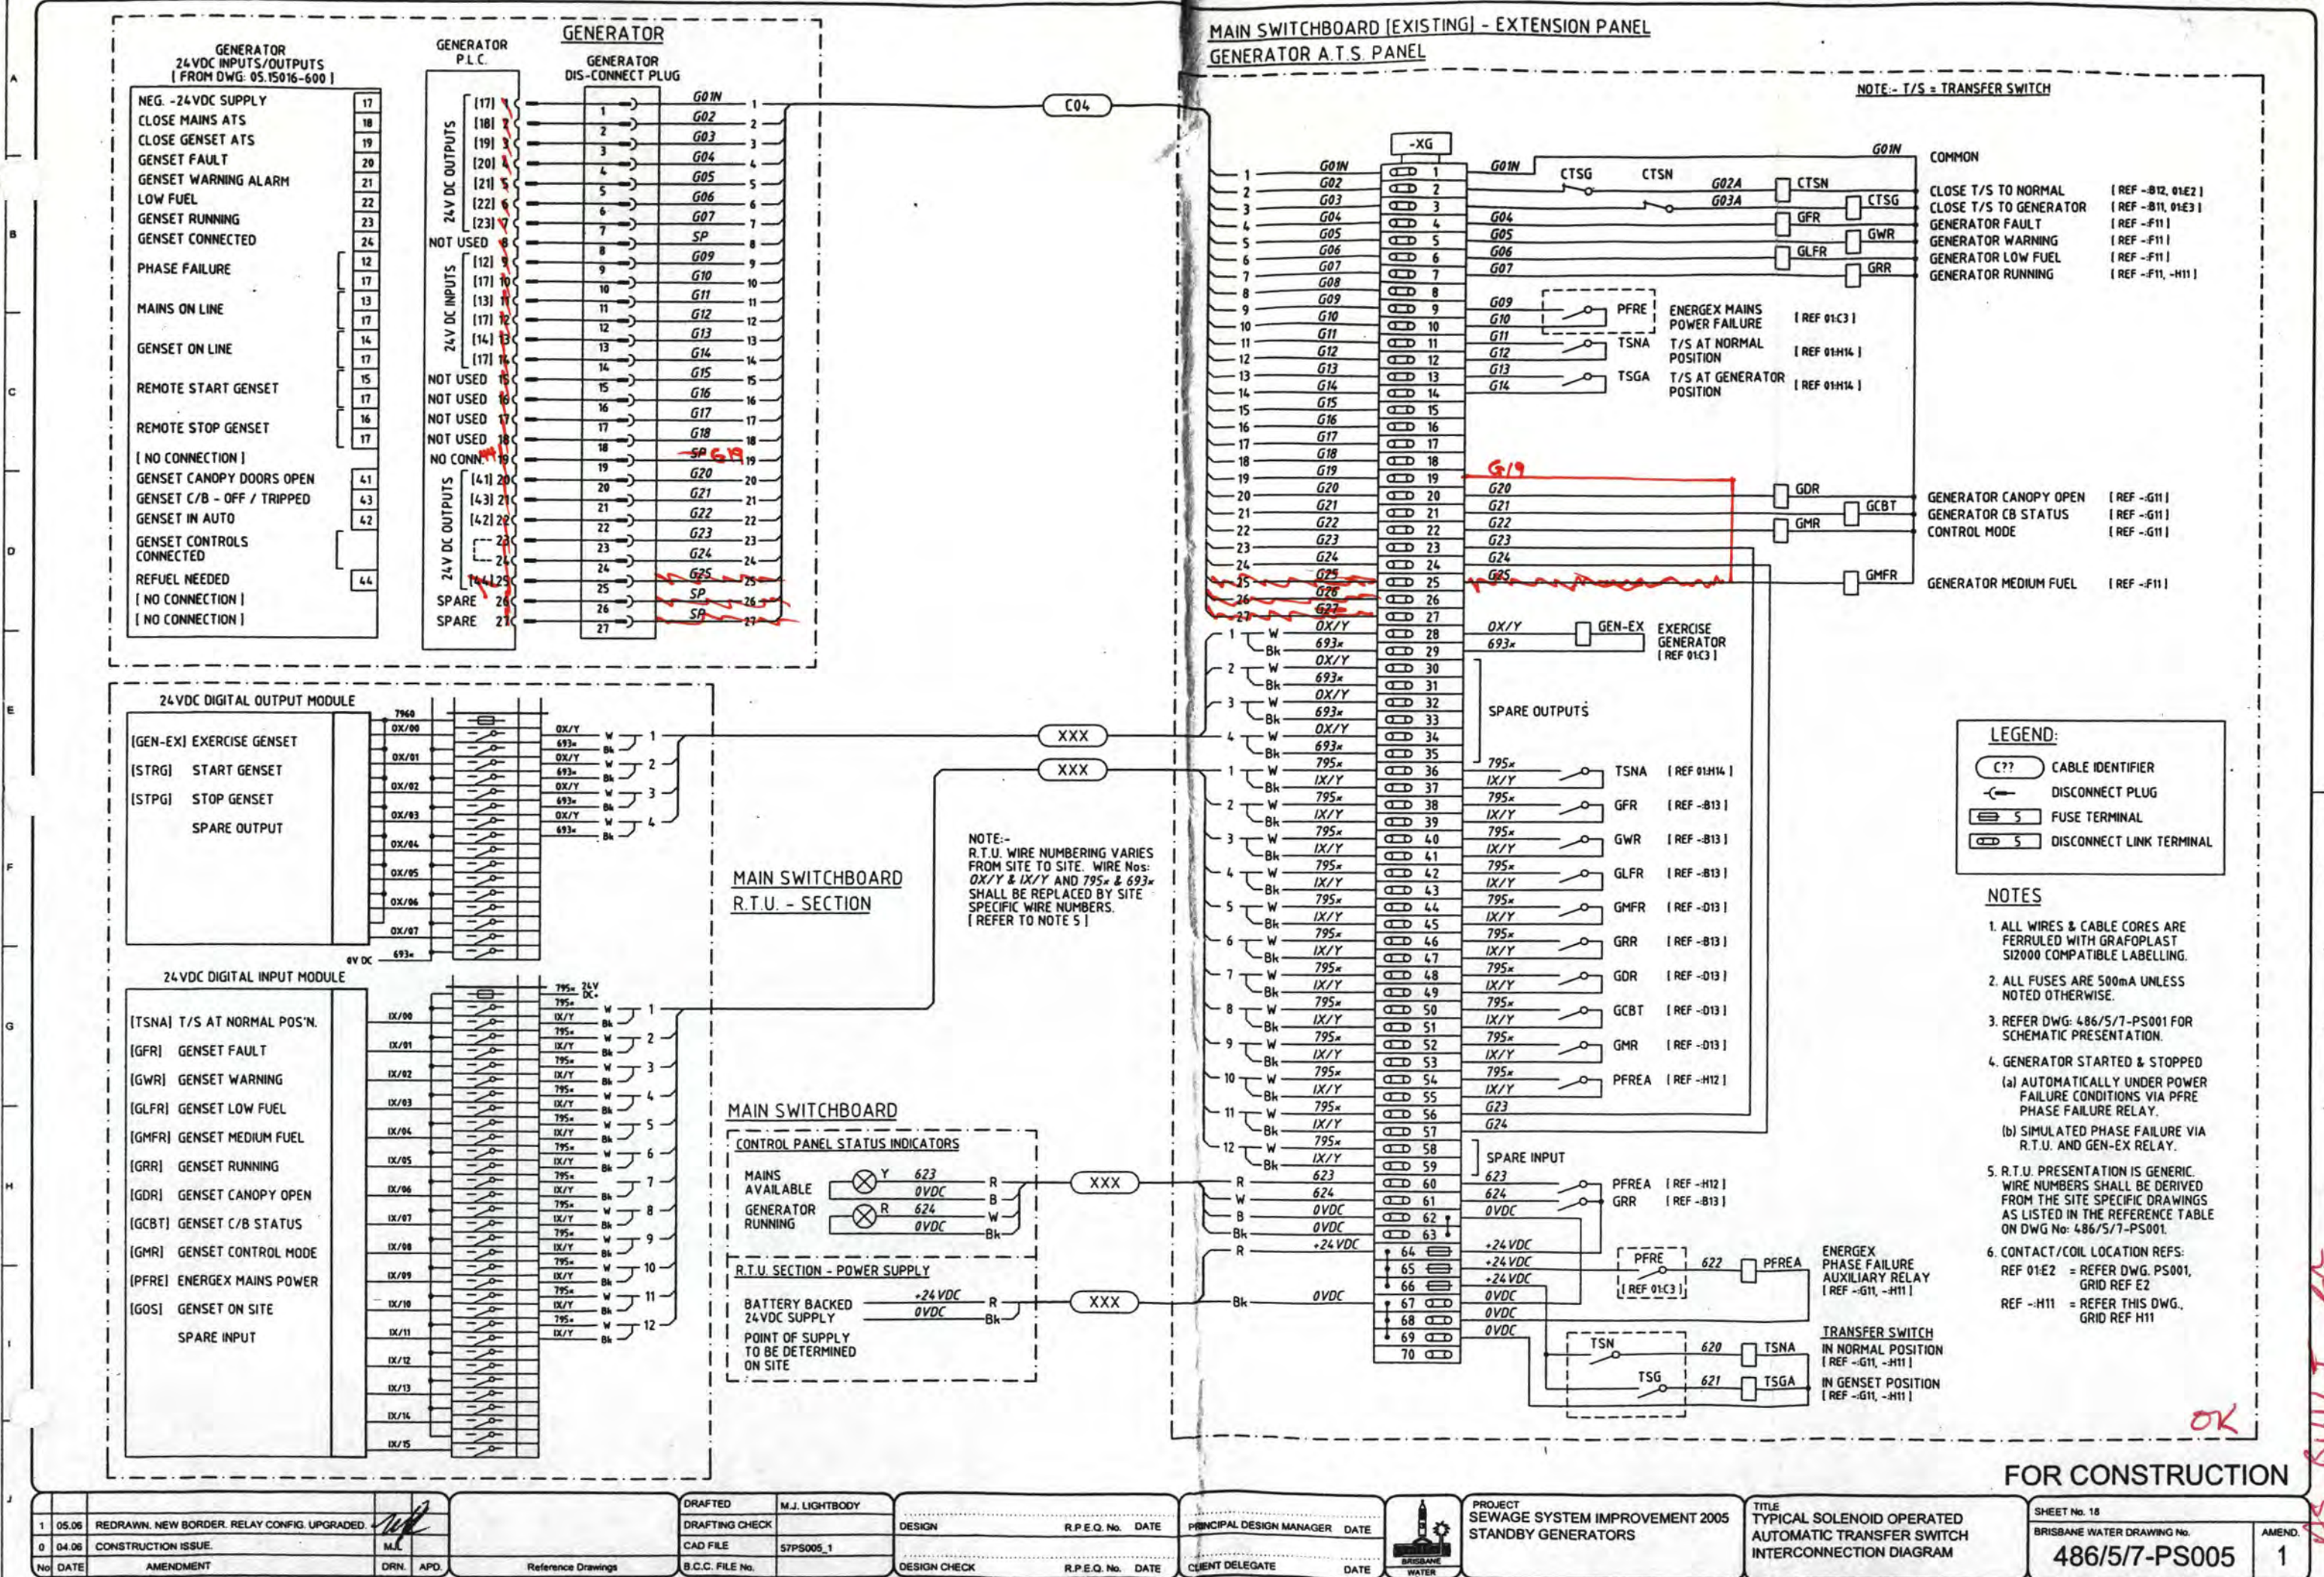



**COMMON LOGIC Pty Ltd  
Specialist Electrical Contractors****Electrical Manual**

Subject: Wirriboot Crt SP292

Sheet: 8  
Of: 10Section  
3

Page Revision No:

Date: 17/11/06

Manual Issue No: 1 Date: 17/11/06

**4.0 PART LIST**

Authorised By: Grant Kerr

**Electrical Manual**

17/11/2006

<b>Supplier Name</b>	<b>Part No</b>	<b>Item Description</b>	<b>Quant</b>
ABK Electrical Wholesale	CLIWIPM27	27 CONTROL PIN W/P INSUL PLUG HI-IMPACT	1
Crompton Instruments	252-PSGW	415V NOMINAL VOLTAGE SENSING RELAY	1
NHP Electrical Engineering	96.72	2P 12AMP RELAY BASE FOR 56.32 RLY	2
NHP Electrical Engineering	38.51 24VDC	24V DC RELAY 1CO 6A	8
NHP Electrical Engineering	56.32 0074 24VDC	RELAY FPIN 2CO 12A 24VDC	2
NHP Electrical Engineering	62W3FD240VAC	SOLENOID OPERATED TRANSFER SWITCH NC	1
NHP Electrical Engineering	D5PP43NL3R	KIT D5 INT LED RED IND 24VAC/DC	1
NHP Electrical Engineering	D5PP53DLO	YELLOW PILOT LIGHT ROUND MAX 130V	1
NHP Electrical Engineering	D5PP53NL3A	KIT D5 INT LED YELLOW IND 24VAC/DC	1
NHP Electrical Engineering	DSRCBH1030A	DINT MCB/RCD 1P 10A 30MA 10KA	1
NHP Electrical Engineering	DTCB6106C	DINT 6KA 1P 6A CB	1
NHP Electrical Engineering	DTCB6306C	DINT 6KA 3P 6A CB	1
Phoenix Contact Pty Ltd	PH0441504	USLKG5 EARTH TERMINAL 4MM	2
Phoenix Contact Pty Ltd	PH3004100	UK5-HESI FUSE TERMINAL M205	4
Phoenix Contact Pty Ltd	PH3004362	UK5N 4MM FEEDTHRU TERMINAL GREY	40
Ramelec Pty Ltd	017216-0000	SAKR/35 LINK TERMINAL	32
Ramelec Pty Ltd	047456-0000	ASK1 FUSE TERMINAL	2

**COMMON LOGIC Pty Ltd**  
**Specialist Electrical Contractors****Electrical Manual**

Subject: Wirriboot Crt SP292

Sheet: 9  
Of: 10Section  
4

Page Revision No:      Date: 17/11/06

Manual Issue No: 1      Date: 17/11/06

**5.0      TEST SHEETS**

Authorised By: Grant Kerr

**COMMON LOGIC Pty Ltd**

A.C.N. 011 029 262

Job Card Number:

**0447****ELECTRICAL CONTRACTORS LICENCE No: 9564****Variation To Fixed Price Proj****Cost Plus Labour Proj.****Call Out****Service**CUSTOMER: **Brisbane Water**Project No: **SP292**Representative Name: **RALPH BERRY**Position: **SUPERINTENDENT**Date: **16/10/06**

Signature on Completion:

Power Authority Forms

Pre-Start Safety Mtg.

Risk Assessment

C/L Representative

**Jeff Allan**Position: **Electrician**Date: **16/10/06**Mobile Phone No: **0419 585 660**

START	FINISH	DETAILS	Hrs.	No MEN	TOTAL	RATE	CHARGED
		TRAVEL TO SITE					
		Wirraboot Street					
		Moved extra ATS panel					
		Cut in Submain to ATS					
		Connected Generator &					
		Control cabling					
		Installed RTD fuses &					
		wiring					

PLEASE SEE ATTACHED FORM FOR ADDITIONAL ☐

TOTAL LABOUR CHARGED:

ITEM No:	PART No:	ITEM DESCRIPTION.	No. ITEM	COST ITEM	TOTAL COST	%	CHARGED
1.		Switchboard kit					
2.		as supplied					
3.							
4.							
5.							
6.							
7.							
8.							
9.							

PLEASE SEE ATTACHED FORM FOR ADDITIONAL ☐

TOTAL MATERIALS:

PROGRESS CLAIM

WORKS NOT COMPLETED  
AND NOT TESTED ☐

FURTHER WORK

REQUIRED TO  
COMPLETE PROJECT. ☒

PROJECT COMPLETED

NO FURTHER ACTION  
REQUIRED ☐

WHITE COPY - CUSTOMER

YELLOW COPY - OFFICE

Certify that the Electrical work listed above  
as been tested in accordance with the  
prescribed procedure and that such work  
complies with the requirements of the State  
Electricity Act.

Signature: .....

**ELECTRICAL  
LICENCE No.****40134**☐ POLARITY TEST.☐ INSULATION RES. TEST.☐ ETH CONTINUITY TEST☐ FUNCTIONAL TEST

FIGURE 10  
ELECTRICITY



**COMMON LOGIC Pty Ltd**  
**Specialist Electrical Contractors**

# Site Acceptance Tests

Subject: SAT for BW Generator Change Over Panels

Sheet: 1  
Of: 7

Section

Page Revision No: 0 Date: 29/08/06

Manual Issue No: 0 Date: 29/08/06

<b>1.0</b>	<b>SITE ACCEPTANCE TEST.....</b>	<b>2</b>
1.1	INTRODUCTION .....	2
1.2	PRODUCTION UNIT INFORMATION.....	2
1.3	SAFETY PRECAUTIONS .....	2
<b>2.0</b>	<b>ELECTRICAL EARTHING SYSTEM .....</b>	<b>3</b>
2.1	ELECTRICAL CONTINUITY AND RESISTANCE OF EARTHING SYSTEM .....	3
2.2	CONTINUITY TEST SHEET .....	3
<b>3.0</b>	<b>INSULATION RESISTANCE/ HIGH POT TEST.....</b>	<b>3</b>
3.1	INSULATION RESISTANCE TEST.....	3
3.2	LOW VOLTAGE SWITCHBOARDS INSULATION TEST .....	3
<b>4.0</b>	<b>GENERAL WIRING AND VISUAL INSPECTION.....</b>	<b>4</b>
4.1	GENERAL WIRING AND VISUAL INSPECTION .....	4
4.2	SWITCHGEAR VISUAL CHECKLIST .....	4
4.3	TERMINAL VISUAL CHECKLIST .....	5
4.4	RELAY VISUAL CHECKLIST .....	5
<b>5.0</b>	<b>CONTINUITY &amp; PRE-COMMISSIONING TEST .....</b>	<b>6</b>
5.1	CONTINUITY TEST.....	6
<b>6.0</b>	<b>COMPONENT OPERATIONAL TEST .....</b>	<b>7</b>
6.1	COMPONENT OPERATION TEST .....	7
6.2	AC CONTROL SYSTEMS.....	7

Test Carried out by.....

Signed...

Date...

Test witnessed by.....

Signed...

Date...

Authorised By:

JH86QT01

29 August, 2006

COMMON LOGIC Pty Ltd  
Specialist Electrical Contractors

# Site Acceptance Tests

Subject: SAT for BW Generator Change Over Panels

Sheet: 2  
Of: 7

Section

Page Revision No: 0 Date: 29/08/06

Manual Issue No: 0 Date: 29/08/06

## 1.0 SITE ACCEPTANCE TEST

### 1.1 Introduction

Complete EVERY box below; if items are not applicable indicate by a N/A in the check box, any comments can be completed at the end of the checklist.


**Aim:** This Commissioning list is to be completed by the person/s who are undertaking the commissioning and testing of the switchboard in question. The commissioning list is designed to check the fundamental wiring of the switchboard.

**Scope:** This Commissioning list is designed to test the operation of the MSB and Controls only. Building wiring is subject to test by building services qualified personnel.

### Legend of Symbols

☐ Check Box, ☒ Setting to be recorded, → and Action to take

### 1.2 Production Unit Information

Job Number	JH86	Site Name	8P292 WIRRIBOOT CRT
	Name	Signature	Date
Testing Officer	GRANT KERR		16/10/06
Witness			

### 1.3 Safety precautions

Outlined below are some common safety procedures and First Aid Instruction.

## SAFETY FIRST

- 1) Never test live boards alone. Always inform others of your actions and intentions.
- 2) Isolate mains or REMOVE TEST PLUG and locate close to testing area under your control.
- 3) Isolate the switchboard main switch and all circuitbreakers and fuses to completely remove all possibility of switching a live conductor when not deliberately required.
- 4) Tag all Distribution as DO NOT OPERATE removing only after tested and safe.
- 5) Insure NO LIVE WIRES are exposed at any time and a CLEAR TESTING AREA and escape route at all times.
- 6) PROTECTIVE CLOTHING and eyewear should be worn at all times when working within Live board or when appropriate.

Test Carried out by.....

Signed...

Date... 16/10/06.

Test witnessed by.....

Signed...

Date...

Authorised By:

JH86QT01

29 August, 2006

COMMON LOGIC Pty Ltd  
Specialist Electrical Contractors

# Site Acceptance Tests

Subject: SAT for BW Generator Change Over Panels

Sheet: 3  
Of: 7

Section

Page Revision No: 0 Date: 29/08/06

Manual Issue No: 0 Date: 29/08/06

## 2.0 ELECTRICAL EARTHING SYSTEM

### 2.1 Electrical continuity and resistance of earthing system

☐ Maximum resistance of the Earthing system within the switchboard is 0.5 ohms (AS/NZS 3000:2000)

☒ Test resistance of the Earthing system < 5  $\Omega$  ohms

### 2.2 Continuity Test Sheet

ITEM	DETAIL	COMPARTMENT DESIGNATION AND TEST RESULT		
		Extension	Main Eth Bar	Generator
	Test resistance of Earthing system to compartment Answer in Ohms			
1	All Earth's wired and continuous	✓		✓
2	All metal work earthed where required	✓		
3	Isolate Individual Earth Systems and check continuity.	✓		

## 3.0 INSULATION RESISTANCE/ HIGH POT TEST

### 3.1 Insulation Resistance Test

Insulation resistance of whole or part of an installation must be a minimum of 1 Meg/ohm (AS/NZS 3000:2000)

☐ Insulation test conducted on all internal circuits

→ All Selector Switches, Isolators and CB's are in the off position

→ All electronic equipment susceptible to high voltage damage to be isolated.

### 3.2 Low Voltage Switchboards Insulation Test


MEGGAR VOLTAGE 1000 VOLTS

INSTRUMENT DETAILS \_\_\_\_\_

GENERATOR  
LEADS.

ACROSS	RESULT (MOHM)	High Pot
Join Red, White & Blue Phases and Neutral, Test to Earth	> 200 m $\Omega$	
Red Phase to White, Blue & N	> 200 m $\Omega$	
White Phase to Red, Blue and N	> 200 m $\Omega$	
Blue Phase to Red, White & N	> 200 m $\Omega$	
N to Red, White & Blue	> 200 m $\Omega$	

Test Carried out by..... Grant Kerr

Signed...  Date... 16/10/06

Test witnessed by.....

Signed... Date...

Authorised By:

JH86QT01

29 August, 2006



COMMON LOGIC Pty Ltd  
Specialist Electrical Contractors

# Site Acceptance Tests

Subject: SAT for BW Generator Change Over Panels

Sheet: 4  
Of: 7

Section

Page Revision No: 0 Date: 29/08/06

Manual Issue No: 0 Date: 29/08/06

## 4.0 GENERAL WIRING AND VISUAL INSPECTION

### 4.1 General Wiring and Visual Inspection

☐ Electrical Construction Coversheet Completed and correct.

### 4.2 Switchgear Visual Checklist

→ Carry out visual and mechanical checks to Switchgear

ITEM NO:	DETAIL	Switchboard compartments		
		Transfer switch compartment	Main switch area	Generator in general
1	Main Switch totally isolates SWBD	✓	—	✓
	Mains transfer switch device isolates mains from load. (IE switchboard)	✓	—	—
2	Generator transfer switch operates and isolates generator from the load. And mechanical interlock works	✓	—	✓
3	Cables tight and correct phase rotation. Colour match.	✓	✓	✓
4	Main Switch Correct Rating/Label	✓	—	✓
5	Neutral cable connected and continuous and tight.	✓	—	—

ITEM	DETAIL	COMPARTMENT DESIGNATION AND TEST RESULT	
		Switchboard extension	Existing Switchboard. Where modified.
1	All CBs operate correctly	✓	—
2	All incoming terminal numbers as per drawings	✓	✓
3	Check wire numbers to core numbers. Random selection.	✓	✓
4	All wires numbered as per drawings (random inspection)	✓	—
5	Cables loomed and bushed correctly to all compartments.	✓	—
6			
7			

Test Carried out by... *Grant Kerr*

Signed... *[Signature]* Date... 16/10/06

Test witnessed by.....

Signed... Date...

Authorised By:

JH86QT01

29 August, 2006

COMMON LOGIC Pty Ltd  
Specialist Electrical Contractors

# Site Acceptance Tests

Subject: SAT for BW Generator Change Over Panels

Sheet: 5

Section

Of: 7

Page Revision No: 0 Date: 29/08/06

Manual Issue No: 0 Date: 29/08/06

## 4.3 Terminal Visual Checklist

→ Carry out visual and mechanical checks on Site terminals

ITEM	DETAIL	COMPARTMENT AND TEST RESULT	
		Switchboard extension	Existing Board
1	All Terminals tight ( Randomly check )	✓	✓
2	Secure by End Clamps (Check All)	✓	✓
3	Labelled correctly	✓	✓
4			

## 4.4 Relay Visual Checklist

→ Carry out visual and mechanical checks on Relays

ITEM	DETAIL	COMPARTMENT AND TEST RESULT
1	Relays labelled correctly as per Drns	✓
2	All relay coils correct voltage	✓
3	Does relay require Diode fitted?	NO
4	Common Bus Link on relays fitted	✓
5	All numbering correct	✓

Test Carried out by... *Grant Kerr*

Signed... *[Signature]* Date... *16/10/06*

Test witnessed by.....

Signed...

Date...

Authorised By:

JH86QT01

29 August, 2006

COMMON LOGIC Pty Ltd  
Specialist Electrical Contractors

# Site Acceptance Tests

Subject: SAT for BW Generator Change Over Panels

Sheet: 6  
Of: 7

Section

Page Revision No: 0 Date: 29/08/06

Manual Issue No: 0 Date: 29/08/06

## 5.0 CONTINUITY & PRE-COMMISSIONING TEST

### 5.1 Continuity Test

- ☒ Wiring of circuits and connections are correct to constructed wiring schematics.
- ☒ Random Continuity Test using Buzzer.
- ☒ Visual Check of all wiring.

- Open all Circuit breakers and remove all fuse links
- Bridge each interface and test each output.
- Install RTU terminal Plugs into terminals
- By bridging the relevant pins and observing the relevant RTU IO feedback all circuits will be checked.
- Test each circuit in turn with corresponding drawings

ITEM NO	Test description			
		Action	Observation	Result of test
1	Transfer to Mains	Bridge	Observe Relay GTSM	✓
2	Transfer to Gen		Observe Relay GTSG	✓
3	Generator Failed		Observe Relay GF	✓
4	Generator Fault		Observe Relay GFR	✓
5	Gen Running		Observe Relay GRUN	✓
			Check Door Indicator is on when relay is ON	✓
6	Generator Connected		Observe Relay GCONN	✓
7	Doors Opened		Observe Relay GOPEN	✓
8	CB Tripped		Observe Relay GCBT	✓
9	Not in Auto		Observe Relay GNAUTO	✓
10	Generator Not On Site		Observe Indicator	✓
11	Spare			
15	Remote Start		Observe Relay GSTART	Exercise GEN ✓
16	Remote Stop		Observe Relay GSTOP	Exercise GEN ✓
1	Mains Failed	Close QM1	Indicator ON when PFR is ON	✓
			Check Door Indicator is ON when PFR is ON	✓
2	ATS to Mains	Manual Change to Mains	Indicator ON when TXS in Mains	✓
3	ATS To Gen	Manual change to Gen	Indicator ON when TSX in GEN	✓
4	Remote Start		Indicator is on when PB is ON	NA
5	Remote Stop		Indicator is on When PB is ON	NA
6	Generator is missing		Indicator is on when PB is ON	✓

Test Carried out by... *Grant Kerr*

Signed... *[Signature]* Date... 16/10/06

Test witnessed by.....

Signed... Date...

Authorised By:

JH86QT01

29 August, 2006

COMMON LOGIC Pty Ltd  
Specialist Electrical Contractors

# Site Acceptance Tests

Subject: SAT for BW Generator Change Over Panels

Sheet: 7  
Of: 7

Section

Page Revision No: 0 Date: 29/08/06

Manual Issue No: 0 Date: 29/08/06

## 6.0 COMPONENT OPERATIONAL TEST

### 6.1 Component Operation Test

- ☒ Correct Operation and Voltages  
☒ All set points and parameters set to test values if required.

### 6.2 AC Control Systems

- Open all circuit breakers and remove all fuse links
- Test each circuit individually, replacing fuses and closing circuit breakers in turn.

#### AFTER VOLTAGE APPLIED

- Apply mains supply
- Carry out voltage and operational checks (ie switch operation etc)
- Bridge control points to check operation as per BW generator commissioning Sheet
- Apply generator voltage and check operation
- Return to normal and fail the mains
- Return the mains
- Carry out a manual transfer

ITEM NO:	DETAIL	New Extension	
		Test Result	
1	Mains Incoming Voltage Measured OK	OK	
2	Unplug set and check alarm	OK	
3	Open doors	OK	
4	Trip CB	OK	
5	Engine temperature/Alarm	NA	
6	Turn set to Auto and Manual	OK	
7	Low fuel alarm	OK	
8	Fuel empty alarm	OK	
9			
10	Manually initiate generator start	OK	
11	Manually restore to mains	OK	
12	Remote start	OK	
13	Remote stop	NA	
14	Mains fail Start	OK	
15	Return to mains	OK	
16	Mains fail and then fail generator	OK	(RETURNS TO MAINS)
17	Check return to to mains if gen fails	OK	
18			
19			
20			

Test Carried out by..... *Grant Kerr*

Signed... *[Signature]* Date... 16/10/06

Test witnessed by.....

Signed... Date...

Authorised By:

JH86QT01

29 August, 2006



# **BRISBANE WATER**

**Network Control Systems**

## **IDTS POINT COMMISSIONING SHEET AND GENERATOR SUPPLY OPERATIONAL CHECKS**

### **Pump Station Generator Connection**

**SITE TYPE & No. SP292**

**Site Name. Wirriboot.**



**NOTE:** Some (or all) of the Generator associated IDTS points may be Scan Inhibited in the IDTS system. Remove the Scan Inhibit from these points before proceeding with these tests

**IDTS Point : Generator Offsite**

Action	Observation	Result
Connect the Control interface lead to the station	Confirm that GENERATOR OFFSITE alarm is returned to normal by IDTS	<input checked="" type="checkbox"/> Yes
Disconnect the Control interface lead to the station	Confirm that GENERATOR OFFSITE alarm is received by IDTS	<input type="checkbox"/> <input checked="" type="checkbox"/> Yes
Reconnect the Control interface lead to the station		<input type="checkbox"/> <input checked="" type="checkbox"/> OK

**IDTS Point : Generator Unsecured**

Action	Observation	Result
Open a canopy door on the Generator	Confirm that GENERATOR UNSECURED alarm is received by IDTS	<input type="checkbox"/> <input checked="" type="checkbox"/> Yes
Close the canopy door	Confirm that GENERATOR UNSECURED alarm return to normal is received by IDTS	<input type="checkbox"/> <input checked="" type="checkbox"/> Yes

**IDTS Point : Generator Low\_fuel**

Action	Observation	Result
Make the Generator low fuel warning alarm active	Confirm that GENERATOR LOW_FUEL alarm is received by IDTS	<input type="checkbox"/> <input checked="" type="checkbox"/> Yes
Deactivate the Generator low fuel warning alarm	Confirm that GENERATOR LOW_FUEL alarm return to normal is received by IDTS	<input type="checkbox"/> <input checked="" type="checkbox"/> Yes

**IDTS Point : Generator Med\_fuel**

Action	Observation	Result
Make the Generator medium fuel warning alarm active	Confirm that GENERATOR MED_FUEL alarm is received by IDTS	<input type="checkbox"/> <input checked="" type="checkbox"/> Yes
Deactivate the Generator medium fuel warning alarm	Confirm that GENERATOR MED_FUEL alarm return to normal is received by IDTS	<input type="checkbox"/> <input checked="" type="checkbox"/> Yes

**IDTS Point : Generator Warning**

Action	Observation	Result
Make the Generator warning alarm active (except by low fuel)	Confirm that GENERATOR WARNING alarm is received by IDTS	<input type="checkbox"/> <input checked="" type="checkbox"/> Yes
Deactivate the Generator warning alarm	Confirm that GENERATOR WARNING alarm return to normal is received by IDTS	<input type="checkbox"/> <input checked="" type="checkbox"/> Yes

**IDTS Point : Generator Common\_fault**

Action	Observation	Result
Make the Generator common fault alarm active	Confirm that GENERATOR COMMON_FAULT alarm is received by IDTS	<input type="checkbox"/> <input checked="" type="checkbox"/> Yes
Deactivate the Generator common fault alarm	Confirm that GENERATOR COMMON_FAULT alarm return to normal is received by IDTS	<input type="checkbox"/> <input checked="" type="checkbox"/> Yes





**IDTS Point : Generator Automatic**

Action	Observation	Result
Turn the generator to local mode	Confirm that GENERATOR AUTOMATIC alarm is RETURNED TO NORMAL by IDTS	<input type="checkbox"/> ✓ Yes
Return the generator to automatic mode	Confirm that GENERATOR AUTOMATIC alarm is received by IDTS	<input type="checkbox"/> ✓ Yes

**IDTS Point : Generator CB\_tripped**

Action	Observation	Result
Trip the Generator circuit breaker	Confirm that GENERATOR CB_TRIPPED alarm is received by IDTS	<input type="checkbox"/> ✓ Yes
Reset the Generator circuit breaker	Confirm that GENERATOR CB_TRIPPED alarm return to normal is received by IDTS	<input type="checkbox"/> ✓ Yes

**IDTS Point : Generator Running**

Action	Observation	Result
Start the Generator (off line only)	Confirm that GENERATOR RUNNING alarm is received by IDTS	<input type="checkbox"/> ✓ Yes
Stop the Generator	Confirm that GENERATOR RUNNING alarm return to normal is received by IDTS	<input type="checkbox"/> ✓ Yes

**IDTS Control Points : Generator Exercise**

Action	Observation	Result
Confirm the Generator is available to run, but not running		<input type="checkbox"/> ✓ OK
Set the IDTS control point GENERATOR START EXERCISE and send to the site	Confirm that the Generator starts and runs off-line	<input type="checkbox"/> ✓ Yes
	Confirm that GENERATOR RUNNING alarm is received by IDTS	<input type="checkbox"/> ✓ Yes
Set the IDTS control point GENERATOR STOP EXERCISE and send to the site	Confirm that the Generator stops	<input type="checkbox"/> ✓ Yes
	Confirm that GENERATOR RUNNING alarm return to normal is received by IDTS	<input type="checkbox"/> ✓ Yes

**IDTS Point : Power\_supply Energex\_power**

Action	Observation	Result
Turn the generator to local mode		<input type="checkbox"/> ✓ OK
Fail the Energex power	Confirm that POWER_SUPPLY ENERGEX POWER alarm is received by IDTS	<input type="checkbox"/> ✓ Yes
Restore the Energex power	Confirm that POWER_SUPPLY ENERGEX POWER alarm return to normal is received by IDTS	<input type="checkbox"/> ✓ Yes



**IDTS Point : ATS Closed , and Generator supply operational checks**

**NOTE:** The purpose of these operational checks is;

- To confirm the pumps are interlocked under Generator supply (where required)
- To confirm the code changes have not interfered with the operation of the Surcharge Imminent probe.

Action	Observation	Result
Ensure the Generator is in Automatic mode		<input checked="" type="checkbox"/> OK
Ensure the pumps are selected for local mode		<input checked="" type="checkbox"/> OK
Ensure there is enough sewage in the well for the pumps to run continuously for one minute		<input checked="" type="checkbox"/> OK
Fail the Energex power to the Generator	Confirm that the Generator starts and supplies power to the station	<input checked="" type="checkbox"/> Yes
	Confirm that ATS CLOSED alarm is received by IDTS	<input checked="" type="checkbox"/> Yes
Generator Interlocking	Confirm the RTU will run a maximum of one pump under generator supply.	<input type="checkbox"/> Yes
Restore Energex power and record the time taken for the Generator controller to return the station power to Energex supply	Time for station power to return to Energex supply	...300..... Secs
	Confirm that ATS CLOSED alarm return to normal is received by IDTS	<input checked="" type="checkbox"/> Yes
Record time taken for the Generator to stop after station power to returns to Energex supply	Time for Generator to stop after station power to returns to Energex supply	...300..... Secs





## Brisbane Water – Network Control Systems Section

***Pump Automatic operation, and******Surcharge Imminent operation under Generator supply***

Action	Observation	Result
Fail the Energex power to the Generator	Confirm that the Generator starts and supplies power to the station	<input type="checkbox"/> ✓ Yes
Ensure the pumps are selected for remote mode	<u>Fixed speed pump sites:</u> Confirm that the duty pump lowers the well to the Duty A stop level and stops	<input type="checkbox"/> Yes
	<u>Variable speed pump sites:</u> Confirm that the duty pump operates on variable speed control satisfactorily	<input type="checkbox"/> ✓ Yes
Ensure the well level is below the Duty A start level using pump local control as required		<input type="checkbox"/> ✓ OK
Ensure the pumps are selected for remote mode and are stopped		<input type="checkbox"/> ✓ OK
Activate the surcharge imminent probe for at least 10 sec	Confirm that WET_WELL SURCHARGE_IMMINENT alarm is received by IDTS	<input type="checkbox"/> ✓ Yes
	Confirm that all pumps (available under Generator supply) start	<input type="checkbox"/> ✓ Yes
Ensure the well does not fall below the Duty A stop level by selecting local mode for the pumps as required		<input type="checkbox"/> ✓ OK
Return the surcharge imminent probe to normal	Confirm that WET_WELL SURCHARGE_IMMINENT alarm return to normal is received by IDTS	<input type="checkbox"/> ✓ Yes
Restore Energex power indication to the Generator and allow the Generator controller to return the station power to Energex supply		<input type="checkbox"/> ✓ OK

IDTS Points and Generator Supply

Operational Checks commissioned by ..... Dan Vowles ..... 30/10/2006 ..... Date

.....



**COMMON LOGIC Pty Ltd**  
**Specialist Electrical Contractors****Electrical Manual**

Subject: Wirriboot Crt SP292

Sheet: 10  
Of: 10Section  
5

Page Revision No:

Date: 17/11/06


Manual Issue No: 1

Date: 17/11/06


**6.0 TECHNICAL INFORMATION**

Authorised By: Grant Kerr


## Catalogue No. WIPM27

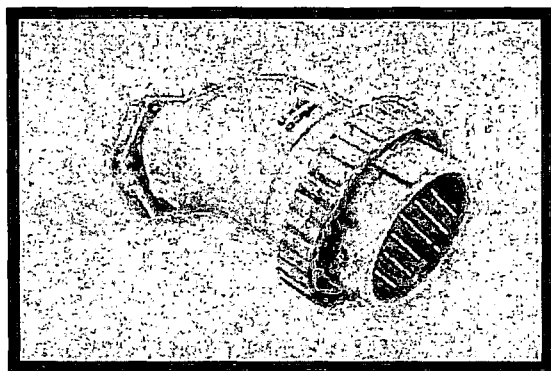

### Colour Options

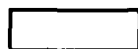

No colour options

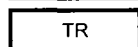

Transparent

More colour options may be available. Please check with your nearest Clipsal office.

### Description:

Low Voltage Multipin - 27 Pin Maximum. Wilco Industrial Hi-Impact Insulated Angle Plug. Wilco Industrial Hi-Impact Insulated Plugs One Piece Angle With Screw Ring - IP56

### Item Type

02 Industrial Products

### Business Area

40 Industrial Switchgear

### Product Group

403 Wilco Hi-Impact Industrial Switchgear

### Item Group

40303 Plugs & Extension Sockets

### Brochures Available:

*A Specifiers guide to Clipsal Industrial*

*A Specifiers guide to Clipsal Industrial*

*A Specifiers guide to Clipsal Industrial*



**tyco**

Electronics

Energy Division

**INSTALLATION INSTRUCTIONS****Page 1 of 2**

Ref: IW250PMSH – Rev 6 – Sept 02

**Models Covered**

252-PMM	252-PMT	252-PSF	252-PSG
253-PH3	252-PMM	252-PMT	

**Introduction****Thermistor Trip Relay (252-PMM & 252-PMT)**

The trip inputs are monitored within settable limits. In the event of the input moving outside these limits, the unit will initiate a trip signal via a double pole changeover relay. An illuminated green LED indicates when the thermistor temperature is within normal working limits. The unit is designed such that the alarm relay is energised when normal temperatures are reached.

Model 252-PMM has the facility for manual resetting, so that the trip condition remains after normal operating temperature is reached, until manual intervention occurs.

**Phase Balance Relay (252-PSF & 252-PSG)**

Trip inputs are monitored within settable limits. In the event of the input moving outside these limits, the unit will initiate a trip signal via a double pole changeover relay. An illuminated red LED indicates that the supply is within limits.

**Speed Sensing Relay (253-PH3)**

Trip inputs are monitored within settable limits. In the event of the input moving outside these limits, the unit will initiate a trip signal. The illuminated red LED's indicates that the single pole output relays are in an energised state and at normal running speed all three relays should be energised. Units are factory adjusted for normal running speed = 0.75mA output. The meter adjust pot on the product front is used for this requirement, which also ensures the trip levels are set to the calibrated values. Terminal 8 is connected to terminal 5 internally. Terminals 15 and 16 give a 0/1mA signal proportional to speed.

No.1 Relay energises on rising speed

No.2 Relay energises on rising speed

No.3 Relay de-energises on rising speed

This product is designed for use only with magnetic coil inductive sensors.

**Warning**

- During normal operation, voltages hazardous to life may be present at some of the terminals of this unit. Installation and servicing should be performed only by qualified, properly trained personnel abiding by local regulations. Ensure all supplies are de-energised before attempting connection or other procedures.
- It is recommended adjustments be made with the supplies de-energised, but if this is not possible, then extreme caution should be exercised.
- Terminals should not be user accessible after installation and external installation provisions must be sufficient to prevent hazards under fault conditions.
- This unit is not intended to function as part of a system providing the sole means of fault protection - good engineering practice dictates that any critical function be protected by at least two independent and diverse means.

Never open circuit the secondary winding of an energised current transformer.

**Protector Trip Relays****DIN Rail & Wall Mounted 250 Series****Thermistor Trip, Speed Sensing & Phase Angle****Installation**

The Protector should be installed in a dry position, not in direct sunlight and where the ambient temperature is reasonably stable and will not be outside the range 0 to 60 degrees Celsius. Mounting will normally be on a vertical surface but other positions will not affect the operation.

Vibration should be kept to a minimum. The Protectors are designed for mounting on a 35mm rail to DIN 46277.

Alternatively they may be screw fixed; a special adaptor is supplied to mount 252 types.

To mount a protector on a DIN rail, the top edge of the cutout on the back is hooked over one edge of the rail and the bottom edge carrying the release clip clicked into place. Check that the unit is firmly fixed. Removal or repositioning may be achieved by levering down the release clip and lifting the unit up and off the rail.

Connection diagrams should be carefully followed to ensure correct polarity and phase rotation where applicable. External voltage transformers may be used on 252-PSF and 252-PSG to extend the range.

**252-PMM, 252-PMT & 253-PH3**

Pick up, input and output leads should be kept separate from any other wiring.

**Setting Controls (252-PSF, 252-PSG)**

These products have two calibration facilities that can be set to suit operating requirements and they are factory calibrated as follows:-

- % unbalance set points  
Voltages of and below 380 volts L-L are calibrated to 1.0% class index of rated voltage. Voltages above 380 volts L-L are calibrated to 1.5% class index of rated voltage.
- Time Delay  
For all voltage ranges 10% maximum delay.
- Voltage Withstand  
Continuous overload = 1.35 x rated voltage

**Setting Up (all other models)**

The calibration marks around the controls are provided as a guide if the installer does not have access to accurate equipment. The maximum error of the calibration marks is typically 10% of the span of the control concerned.

**Maintenance**

The unit should be inspected to normal standards for this class of equipment. For example remove accumulations of dust and check all connections for tightness and corrosion. In the unlikely event of a repair being necessary it is recommended that the unit be returned to the factory or to the nearest Crompton Instruments Service Centre.

**Electromagnetic Compatibility**

This unit has been designed to provide protection against EM (electro-magnetic) interference in line with requirements of EU and other regulations. Precautions necessary to provide proper operation of this and adjacent equipment will be installation dependent and so the following can only be general guidance:-

- Avoid routing wiring to this unit alongside cables and products that are, or could be, a source of interference.





# INSTALLATION INSTRUCTIONS




## Protector Trip Relays DIN Rail & Wall Mounted 250 Series Thermistor Trip, Speed Sensing & Phase Angle

- The auxiliary supply to the unit should not be subject to excessive interference. In some cases, a supply line filter may be required.
- To protect the product against incorrect operation or permanent damage, surge transients must be controlled. It is good EMC practice to suppress differential surges to 2kV or less at the source. The unit has been designed to automatically recover from typical transients, however in extreme circumstances it may be necessary to temporarily disconnect the auxiliary supply for a period of greater than 5 seconds to restore correct operation.




- Screened communication and small signal leads are recommended and may be required. These and other connecting leads may require the fitting of RF suppression components, such as ferrite absorbers, line filters etc., if RF fields cause problems.
- It is good practice to install sensitive electronic instruments that are performing critical functions in EMC enclosures that protect against electrical interference causing a disturbance in function.

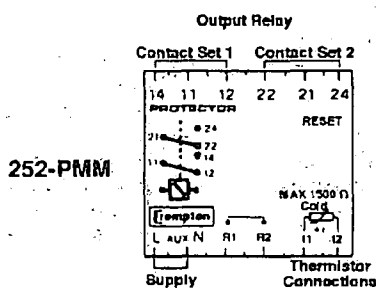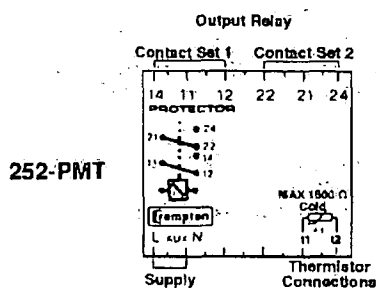




252-PMM can operate in either an automatic or a manual reset mode. For automatic the reset link R1-R2 is to be disconnected. For manual the reset link R1-R2 must be inserted.

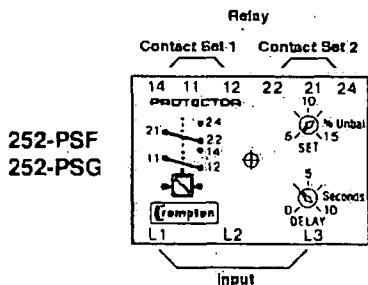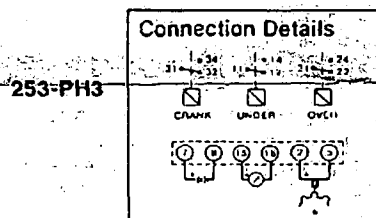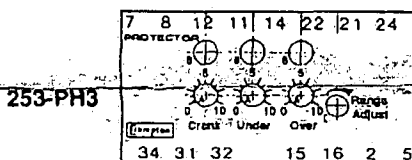

### Model 252

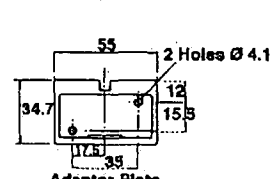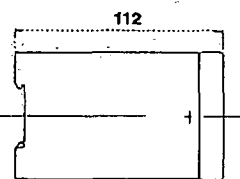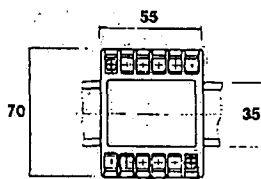

### Model 253

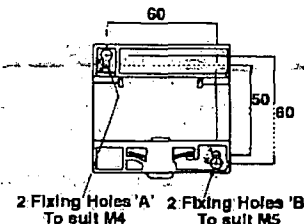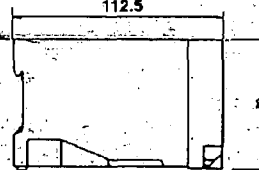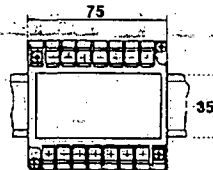

The information contained in these installation instructions is for use only by installers trained to make electrical power installations and is intended to describe the correct method of installation for this product. However, Tyco Electronics has no control over the field conditions, which influence product installation. It is the user's responsibility to determine the suitability of the installation method in the user's field conditions. Tyco Electronics' only obligations are those in Tyco Electronics' standard Conditions of Sale for this product and in no case will Tyco Electronics be liable for any other incidental, indirect or consequential damages arising from the use or misuse of the products. Crompton is a trade mark.




### Tyco Electronics UK Limited

#### Crompton Instruments

Freebournes Road, Witham, Essex, CM8 3AH, UK  
Phone: +44 1376 509 509 Fax: +44 1376 509 511

<http://energy.tycoelectronics.com>

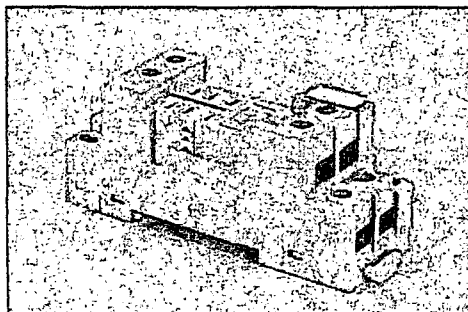

Representative Image Only

**Catalogue Number:** 96.72

**Description:** SKT FOR 56.32 RLY + LED MOD

**List Price:** Refer to our eCatalogue

**Unit Of Measure:** EA

**Price Schedule:** B2

All prices are exclusive of GST

## Relays / Accessories

**Brand:** Finder


**Accessory type:** Plug-in base

## Features

- DIN rail mounting socket with open terminals, to suit miniature power relays, flat pin 2 C/O (8 pin), eg 56.32.
- This socket also accepts the 99 series LED modules.

## Benefits

- The 96.72 series sockets are designed for DIN rail mounting, with the added benefit of incorporating an LED indicator in the same socket as the relay.
- Provides a space saving relay / indicator combination.
- Relay retaining clips also available.

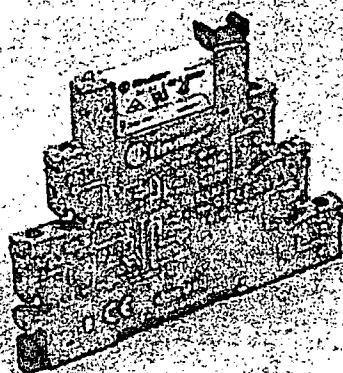

Catalogue Number:

**38.51 24VDC**

Description:

**PLEASE ORDER 385124VACDC**

List Price \$ (Not including GST):

**46.55**

Unit of Measure:

**EA**

Price Schedule:

**B2**

## Relays Interface Module

### Relays Interface Module

#### Contact arrangement

1 C/O 6A AC1 250VAC

#### Voltage

24V DC

#### Number of pins

3


#### Features

- Miniature Din rail mounting type Relay interface module
- Supply voltage: 24V DC
- 1 C/O contact, 6A. 250V AC 1

#### Benefits

- Compact Din mount presentation
- Low coil consumption



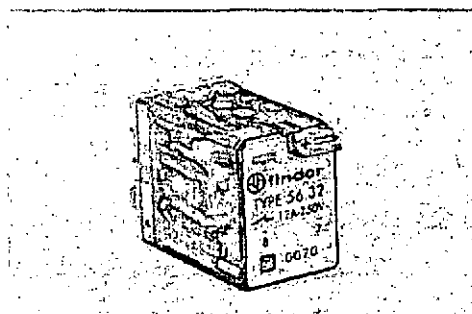

Representative Image Only

Catalogue Number: 56.32.0074 24VDC

Description: RLY W/PB+LED+FLG FPIN 2CO 12A

List Price: Refer to our eCatalogue

Unit Of Measure: EA

Price Schedule: B2

All prices are exclusive of GST

### Relays-plug-in type / Flat pin

Brand: Finder

Contact arrangement: 2 C/O

Voltage: 24V DC

Number of pins: 8


### Features

- 24VDC, 12A.
- 2 C/O contacts.
- Flat pins.

### Benefits

- Lockable test button.
- Mechanical flag indicator and LED.

# Aichi

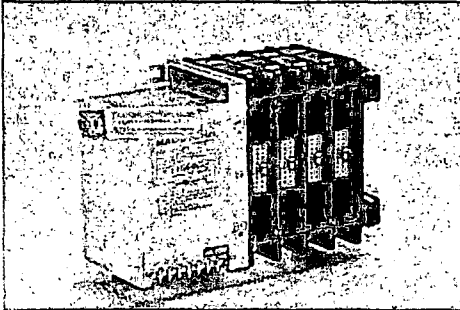

Representative Image Only

Catalogue Number: 62W-3FD 240VAC

Description: TRANS.SW.NO OFF 200A3POLE240VA

List Price:  Refer to our eCatalogue

Unit Of Measure: EA

Price Schedule: A4

All prices are exclusive of GST

## Transfer switches / Basic (BTS)

**Brand:** Aichi

**Amp rating:** 200

**kA rating:** 25


## Features

- Single coil operation "W" series.
- Simple mechanical operation.
- 100A to 5000A switch range.
- Pulsed DC coil system.
- Load terminals common.
- Manual operating handle supplied for use in the event of control voltage failure.
- 125V DC 1 ratings to 2000A (each pole).
- All terminal covers provided.
- Control circuit "MOVs" provided, protects control circuit from 'spikes'.
- Can be used with Terasaki logic panel.
- 2 C / O Auxiliaries fitted as standard (extra on request).

## Benefits

- External mechanical interlock unnecessary.
- Maintained coil supply not required.
- Additional load connections not required.
- DC switching capability.

**sprecher +  
schuh**

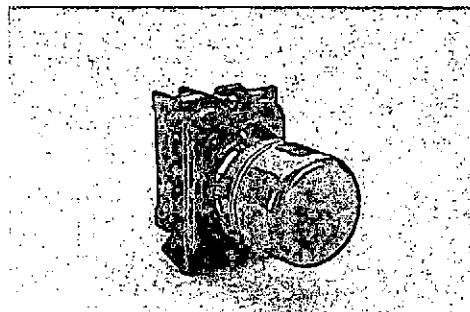

Representative Image Only

**Catalogue Number:** D5P-P43NL3R

**Description:** KIT D5 INT LED RED IND 24VAC

**List Price:**  Refer to our eCatalogue

**Unit Of Measure:** EA

**Price Schedule:** A2

All prices are exclusive of GST

#### Pushbutton Products / Pilot Light and Buzzer

**Brand:** Sprecher + Schuh

**Mounting Size:** 22.5mm

**Specification:** Complete

**Shape:** Round

**Style / Frame:** Standard

**Colour:** Red

**Lamp Block:** Full Voltage


#### Features

- Part of the vast D5 range of matching 22.5 mm. control and signalling units providing IP 66 front protection.
- Assembled round plastic pilot light fitted with coupling plate and clip-on LED.
- Easy to mount.
- Wide range of legends available to complete the assembly.
- Individually packaged component.

#### Benefits

- The D5 range combines aesthetic appeal with robust flexibility to suit heavy-duty industrial control applications.
- Readily visible.
- Pre-assembly saves time.
- When fixing pilot light it will hold in place without a notched panel hole.
- Saves time and allows fitting by one person only.
- Simplified ordering and spares holding.



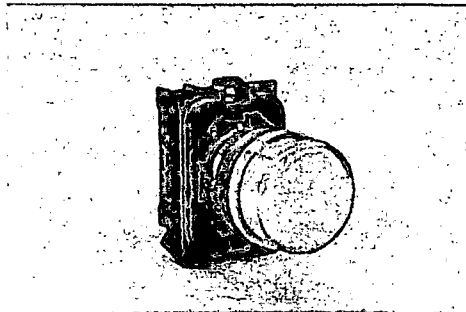

Representative Image Only

**Catalogue Number:** D5P-P53NL3A

**Description:** KIT D5 INT LED YLW IND 24VAC

**List Price:**  Refer to our eCatalogue

**Unit Of Measure:** EA

**Price Schedule:** A2

All prices are exclusive of GST

#### Pushbutton Products / Pilot Light and Buzzer

**Brand:** Sprecher + Schuh

**Mounting Size:** 22.5mm

**Specification:** Complete

**Shape:** Round

**Style / Frame:** Standard

**Colour:** Yellow


**Lamp Block:** Full Voltage

#### Features

- Part of the vast D5 range of matching 22.5 mm. control and signalling units providing IP 66 front protection.
- Assembled round plastic pilot light fitted with coupling plate and clip-on LED.
- Easy to mount.
- Wide range of legends available to complete the assembly.
- Individually packaged component.

#### Benefits

- The D5 range combines aesthetic appeal with robust flexibility to suit heavy-duty industrial control applications.
- Readily visible.
- Pre-assembly saves time.
- When fixing pilot light it will hold in place without a notched panel hole.
- Saves time and allows fitting by one person only.
- Simplified ordering and spares holding.

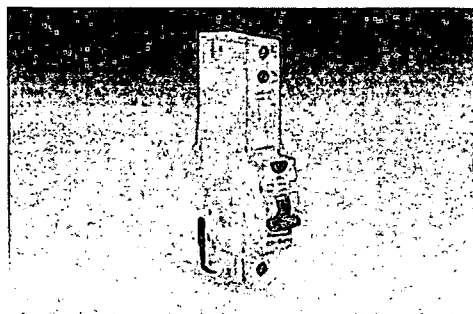

Representative Image Only

**Catalogue Number:** DSRCBH1030A

**Description:** MCB/RCD 1P 10A 30MA 10KA DIN-T

**List Price:** Refer to our eCatalogue

**Unit Of Measure:** EA

**Price Schedule:** T3

All prices are exclusive of GST

### Circuit breakers - Earth Leakage / ELCB Din

**Brand:** Terasaki

**Current rating:** 10A

**Number of poles:** 1P + N

**Modules:** 1 (18)

**Trip sensitivity:** 30mA

**Voltage:** 240V AC


### Features

- Short circuit protection 10kA.
- 50kA and 65kA fuse back up.
- Sensitivities 10mA and 30mA.
- 6A, 10A, 16A, 20A, 25A, 32A & 40A Current ratings.
- Type A RCD.
- On and Off indication with colour coding.
- Handle can be sealed and locked in "on" or "off" position.
- IP20 finger protection.
- Wide range of accessories.
- Information clearly labeled on front of RCD.
- Flexible 1.2m long neutral pigtail.

### Benefits

- Space saving, same width Din-T MCB.
- Can be directly retrofitted replacing a Din-T MCB.
- High level of short circuit protection.
- Wide range of current settings.
- Approved for use in Australia and New Zealand.
- Conforms to international standards.
- Terminals clearly labeled for easy connection.



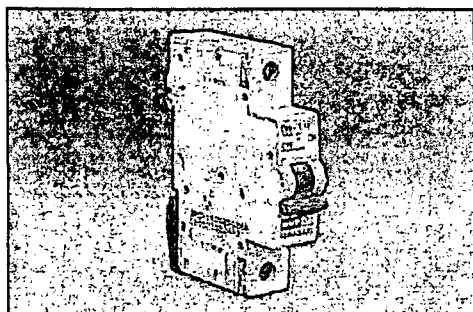

Representative Image Only

Catalogue Number: DTCB6106C

Description: MCB 6KA 1P 6A C CURVE DIN

List Price: Refer to our eCatalogue

Unit Of Measure: EA

Price Schedule: T1

All prices are exclusive of GST

#### Circuit breakers-miniature / MCB DIN 6 kA


**Brand:** Terasaki  
**Current rating:** 6A  
**Number of poles:** 1 Pole  
**Curve type:** C Curve

#### Features

- 6kA, 10kA & 15kA short circuit breaking capacities available.
- 50kA and 65kA fuse backup.
- On and Off indication with colour coding.
- Handle can be sealed and locked in "on" or "off" position.
- High speed operation and rapid arc quenching.
- Consistant line and load terminal height for Din-T 6, 10 & 15 MCB's.
- IP20 finger protection.
- 35mm<sup>2</sup> capacity terminals.
- Wide range of accessories.
- Conformity to Australian and International standards.
- Versatility in mounting, distribution boards, switchgear panels and consumer units.
- High selectivity figures.
- Information clearly labeled on front of breaker.

#### Benefits

- Eliminates confusion regarding the operating state of the MCB.
- Increased protection as contacts open through overload or short circuit even when handle is sealed in the "on" position.
- Saves cost, allows for a fuseless system and confines power outages to the effected circuit preventing wide spread loss of power.
- Can fit larger cables.
- Provides greater flexiblity of use.
- Security on conformitiy.
- Special data very accessible.

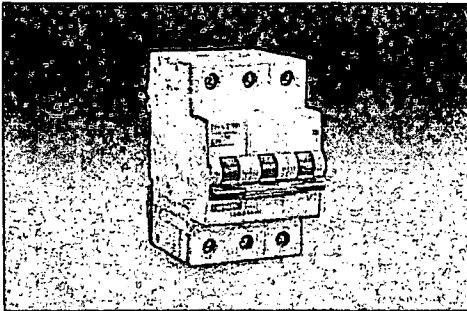

Representative Image Only

Catalogue Number: DTCB6306C

Description: MCB 6KA 3P 6A C CURVE DIN

List Price:  Refer to our eCatalogue

Unit Of Measure: EA

Price Schedule: T1

All prices are exclusive of GST

**Circuit breakers-miniature / MCB DIN 6 kA****Brand:** Terasaki**Current rating:** 6A**Number of poles:** 3 Pole**Curve type:** C Curve**Features**

- 6kA, 10kA & 15kA short circuit breaking capacities available
- 50kA and 65kA fuse backup
- On and Off indication with colour coding
- Handle can be sealed and locked in "on" or "off" position
- High speed operation and rapid arc quenching
- Consistent line and load terminal height for Din-T 6, 10 & 15 MCB's
- IP20 finger protection
- 35mm<sup>2</sup> capacity terminals
- Wide range of accessories
- Conformity to Australian and International standards
- Versatility in mounting, distribution boards, switchgear panels and consumer units
- High selectivity figures
- Information clearly labeled on front of breaker


**Benefits**

- Eliminates confusion regarding the operating state of the MCB
- Increased protection as contacts open through overload or short circuit even when handle is sealed in the "on" position
- Saves cost, allows for a fuseless system and confines power outages to the effected circuit preventing wide spread loss of power
- Can fit larger cables
- Provides greater flexibility of use
- Security on conformity
- Special data very accessible



## Universal Ground Terminal Block USLKG

Article description	USLKG 5
Order No.	0441504 USLKG 5 0441517 USLKG 5-1
EC Prototype certificate no.	KEMA 99ATEX4487U

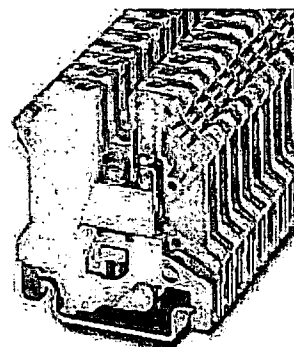

Assembly on mounting rails	NS 32 acc. to EN 60715-G 32 NS 35 acc. to EN 60715-TH 35
Assembly instructions	See page 2
Temperature range of use	-40 °C to +90 °C



## Technical data according to EN 50019 (Increased Safety "e")

### Connection capacity

Rated cross section	4 mm <sup>2</sup>	AWG 12
Max. conductor cross section	4 mm <sup>2</sup>	AWG 12
Connectable conductor cross sections	0.2 - 4 mm <sup>2</sup> rigid and flexible	AWG 24 - 12

### Explosion protection data

Max. operating voltage	550 V on NS 32 750 V on NS 35	Mounted in rows with UK 5 N
------------------------	----------------------------------	--------------------------------


### Data of insulation material

Description	PA 6.6	
Creep resistance acc. to IEC 60112 / material group	CTI 600 / I	



**Important assembly instructions – increased safety "e"**

When adding other series and sizes of terminal blocks and using additional accessories, the required air and creepage distances have to be observed.

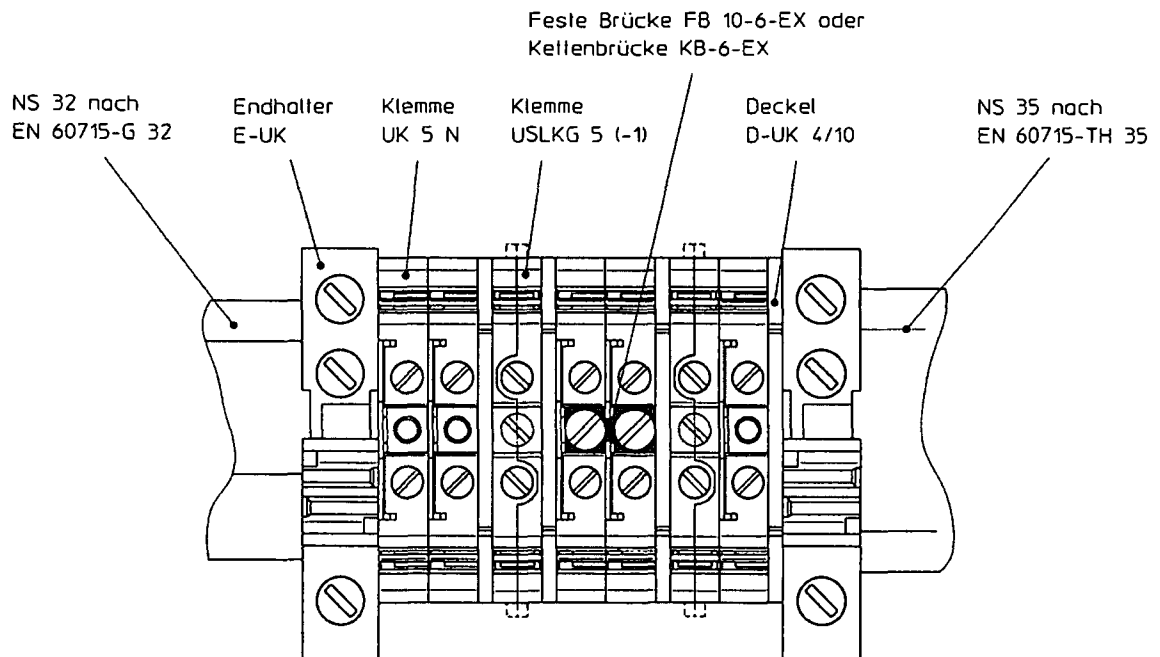

Phoenix Contact GmbH & Co. KG  
 Flachsmarktstrasse 8  
 D-32825 Blomberg, Germany  
 Germany

+49 – (0) 52 35 – 3-00

+49 – (0) 52 35 – 3-4 12 00

[www.phoenixcontact.com](http://www.phoenixcontact.com)

15.07.02  
 Rev. 00  
 Technical modifications reserved




Page 2 of 2

## UK 5-HESI



Please note that the data given here has been taken from the online catalog. For comprehensive information and data, please refer to the user documentation at <http://www.download.phoenixcontact.com>. The General Terms and Conditions of Use apply to Internet downloads.

### ► Extract from the online catalog

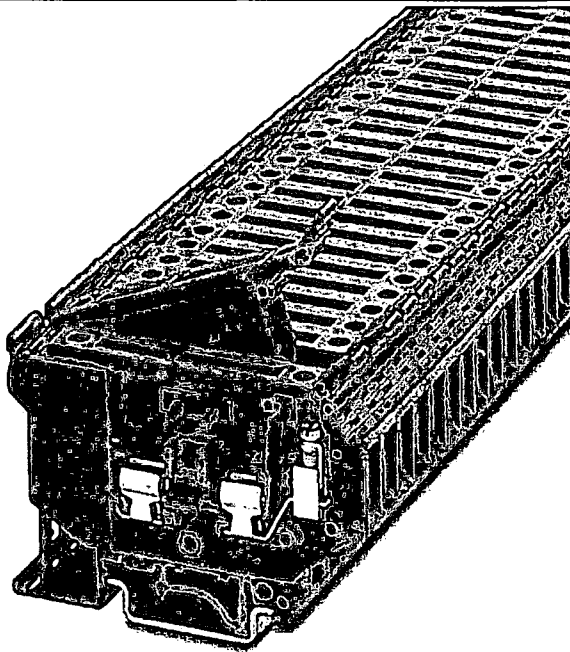

Fuse terminal block for cartridge fuse insert, cross section: 0.2 - 4 mm<sup>2</sup>, AWG: 26 - 10, width: 8.2 mm, color: black

Order No.	3004100
Ord designation	UK 5-HESI
EAN	4017918090623
Pack	50 Pcs.
Customs tariff	85363010
Weight/Piece	0,018509 KG
Catalog page information	Page 266 (CL-2005)

### ► Product notes

WEEE/RoHS-compliant since: 01/01/2003




**IMPORTANT :** This date is valid for Customers in Germany only. Date Format is MM/DD/YYYY. Please contact your local in-country Phoenix Contact location or designated business partner for a Logistics Compliant date in your area. In order to guarantee delivery of RoHS-Compliant product, please purchase Phoenix Contact parts from authorized Phoenix Contact representatives and distributors.



## Feed-Through Modular Terminal Block

Article description	UK 5 N
Order No.	3004362
EC Prototype certificate no.	KEMA 98ATEX1651U
Identification	0344 Ⓢ II 2 GD EEx e II KEMA 98ATEX1651U
Assembly on mounting rails	NS 32 acc. to EN 60715-G 32 NS 35 acc. to EN 60715-TH 35
Assembly instructions	See page 2
Temperature range of use	-40 °C to +80 °C

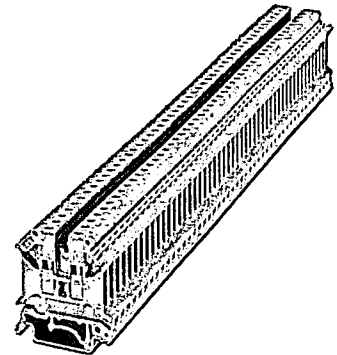

### Technical data according to EN 50019 / EN 50020

Max. operating voltage	750 V 60 V	550 V on NS 32
Increased safety "e"		
Intrinsic safety "i"		
Nominal current	30 A	
Max. load current	38 A	
<b>Connection capacity</b>		
Rated cross section	4 mm <sup>2</sup>	AWG 12
Max. conductor cross section	6 mm <sup>2</sup>	AWG 10
Connectable conductor cross sections	0.2 – 6 mm <sup>2</sup> V	AWG 24 – 10

### Multi-conductor connection (two conductors with same cross section)

Rigid / flexible	0.2 – 1.5 mm <sup>2</sup> V	AWG 24 – 16
------------------	-----------------------------	-------------

### Data of insulation material

Description	PA 6.6	
Creep resistance acc. to IEC 60112 / material group	CTI 600 / I	

### Accessories

Accessories	Description	Order No.	
Cover	D-UK 4/10	3003020	
Cover	D-UK 16	3006027	
Partition plate	ATP-UK	3003224	
Fixed bridge	FBI 10-6-EX	0203519	Max. 37 A acc. to EN 50019
Chain bridge	KBI-6-EX	0711849	Max. 37 A acc. to EN 50019
Bridge rail	FB 150	0201595	Max. 27 A acc. to EN 50019





### Important assembly instructions – increased safety "e"

When adding other series and sizes of terminal blocks and using additional accessories, the required air and creepage distances have to be observed.

If fixed bridges and chain bridges are used, a cover is necessary between bridges which make direct contact, as well as at the beginning and end of each bridge, in order to maintain the insulation distances.

If the fixed bridges are used for creating bridging between non-adjacent terminals, the max. working voltage is reduced to 175 V.

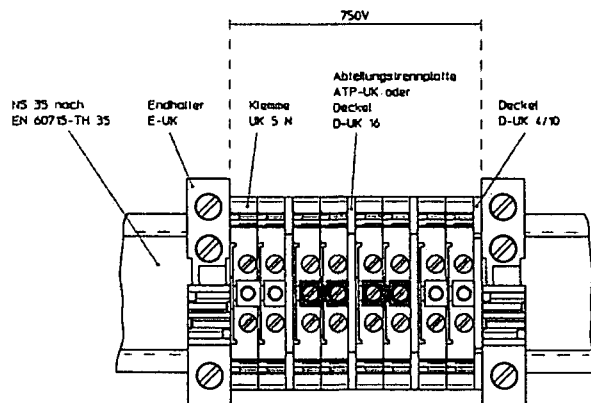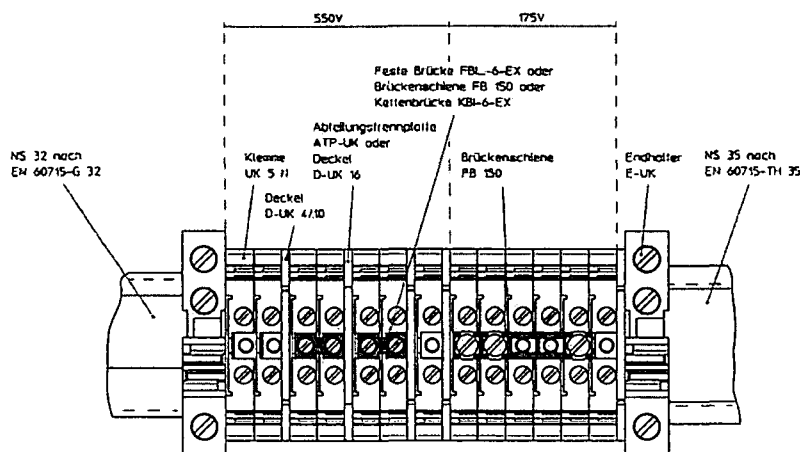

Phoenix Contact GmbH & Co. KG  
 Flachmarktstrasse 8  
 D-32825 Blomberg, Germany  
 Germany




+49 – (0) 52 35 – 3-00



+49 – (0) 52 35 – 3-4 12 00



[www.phoenixcontact.com](http://www.phoenixcontact.com)

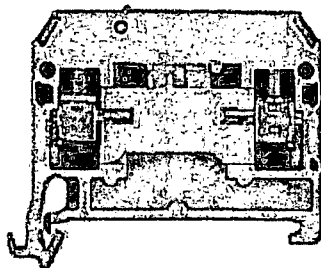**General ordering data**

<b>Order No.</b>	0172160000
<b>Short text for material</b>	SAKR/35
<b>EAN</b>	4008190030445
<b>Qty</b>	100

**Product notes**

<b>Note, ordering data</b>	SAKR/35 2 StB order No. 0183360000
<b>Note, technical data</b>	Tightening torque for the test sockets 0.5 -0.7 Nm

**Additional technical data**

<b>Type of connection</b>	screwed
<b>No. of identical terminals</b>	1
<b>Version</b>	Disconnect terminal
<b>Type of mouting</b>	clipped
<b>JL 94 flammability rating of insulation material</b>	V2
<b>Installation advice</b>	TS 35
<b>Colour of insulating material</b>	beige
<b>Insulating material</b>	PA 66
<b>Open sides</b>	right
<b>Operating temperature range</b>	- 50 °C, + 100 °C
<b>Connection direction</b>	on side
<b>Product range</b>	SAK Series
<b>No. of levels</b>	1
<b>Levels cross-connected internally</b>	No
<b>No. of terminal strips per level</b>	2
<b>End plate required</b>	Yes

**CSA rating data**


<b>Max. cross-section (CSA)</b>	AWG 12
<b>Min. cross-section (CSA)</b>	AWG 22
<b>Voltage CSA</b>	300 V
<b>CSA current</b>	10 A

**Conductors for clamping (rated connection)**

<b>Stripping length</b>	8 mm
<b>Type of connection</b>	Screw connection

<b>No. of connections</b>	2
<b>Torque level with DMS electric screwdriver</b>	2
<b>Tightening torque range</b>	0.5...1.0 Nm
<b>Solid, max.</b>	4 mm <sup>2</sup>
<b>Flexible, max.</b>	4 mm <sup>2</sup>
<b>flexible w. ferrule AEH, max. DIN 46228-1</b>	2.5 mm <sup>2</sup>
<b>flexible w. ferrule AEH, min. DIN 46228-1</b>	0.5 mm <sup>2</sup>
<b>Clamping range, max.</b>	4 mm <sup>2</sup>
<b>Clamping range, min.</b>	0.13 mm <sup>2</sup>
<b>Clamping screw</b>	M 3
<b>Blade size</b>	0.6 x 3.5 mm
<b>Gauge to IEC 60947-1</b>	A3
<b>AWG conductor size, max.</b>	3.31 mm <sup>2</sup>
<b>AWG conductor size, max.</b>	AWG 12
<b>Stranded, max.</b>	4 mm <sup>2</sup>
<b>Stranded, min.</b>	1.5 mm <sup>2</sup>
<b>AWG conductor size, min.</b>	0.13 mm <sup>2</sup>
<b>AWG conductor size, min.</b>	AWG 26
<b>Connection direction</b>	on side
<b>Flexible, min.</b>	0.5 mm <sup>2</sup>
<b>2nd type of connection</b>	screwed
<b>Solid, min.</b>	0.5 mm <sup>2</sup>
<b>Twin wire-end ferrule, min.</b>	0.50 mm <sup>2</sup>
<b>Zwillings-AEH, max.</b>	1.50 mm <sup>2</sup>
<b>Dimensions</b>	
<b>Width</b>	6.5 mm
<b>Height of lowest version</b>	40.5 mm
<b>Length</b>	42 mm
<b>TS 32 offset</b>	4 mm
<b>Disconnect terminals</b>	
<b>Torque level with DMS electric screwdriver</b>	2
<b>Slitting</b>	pivoting
<b>Integral test socket</b>	No
<b>EN 60079-7 rating data</b>	
<b>Current Ex e</b>	10 A
<b>Rating data</b>	
<b>Rated cross-section</b>	4 mm <sup>2</sup>
<b>Rated voltage</b>	400 V
<b>Rated impulse withstand voltage</b>	6 kV
<b>Rated current</b>	10 A

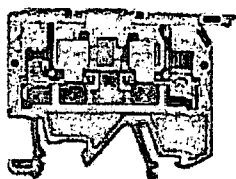

**General ordering data**

<b>Order No.</b>	0474560000
<b>Short text for material</b>	ASK 1/EN
<b>EAN</b>	4008190020880
<b>Qty</b>	100

**Product notes**

<b>Note, technical data</b>	The rated cross-section is reduced to max. 2.5 mm <sup>2</sup> when using cross-connection bridges.
-----------------------------	---

**Additional technical data**

<b>Type of connection</b>	screwed
<b>No. of identical terminals</b>	1
<b>Version</b>	Fuse terminal
<b>Type of mounting</b>	clipped
<b>UL 94 flammability rating of insulation material</b>	V2
<b>Installation advice</b>	TS 35 + TS 32
<b>Colour of insulating material</b>	beige
<b>Insulating material</b>	PA 66
<b>Open sides</b>	right
<b>Operating temperature range</b>	- 50 °C, + 100 °C
<b>Connection direction</b>	on side
<b>Product range</b>	SAK Series
<b>No. of levels</b>	1
<b>Levels cross-connected internally</b>	No
<b>No. of terminal strips per level</b>	2
<b>End plate required</b>	Yes

**CSA rating data**

<b>Max. cross-section (CSA)</b>	AWG 12
<b>Min. cross-section (CSA)</b>	AWG 26
<b>Voltage CSA</b>	300 V
<b>CSA current</b>	6.3 A

**Conductors for clamping (rated connection)**

<b>Stripping length</b>	9 mm
<b>Type of connection</b>	Screw connection
<b>No. of connections</b>	2
<b>Torque level with DMS electric screwdriver</b>	2

## Weidmüller Interface

<b>Tightening torque range</b>	0.6...0.8 Nm
<b>Solid, max.</b>	4 mm <sup>2</sup>
<b>Flexible, max.</b>	4 mm <sup>2</sup>
<b>flexible w. ferrule AEH, max. DIN 46228-1</b>	4 mm <sup>2</sup>
<b>Flexible, max., ferrule with plastic collar (DIN 46228 pt 4)</b>	2.5 mm <sup>2</sup>
<b>flexible w. ferrule AEH, min. DIN 46228-1</b>	0.5 mm <sup>2</sup>
<b>Flexible, min., ferrule with plastic collar (DIN 46228 pt 4)</b>	0.5 mm <sup>2</sup>
<b>Clamping range, max.</b>	4 mm <sup>2</sup>
<b>Clamping range, min.</b>	0.13 mm <sup>2</sup>
<b>Clamping screw</b>	M 3
<b>Blade size</b>	0.6 x 3.5 mm
<b>Gauge to IEC 60947-1</b>	A3
<b>AWG conductor size, max.</b>	3.31 mm <sup>2</sup>
<b>AWG conductor size, max.</b>	AWG 12
<b>Stranded, max.</b>	4 mm <sup>2</sup>
<b>Stranded, min.</b>	0.5 mm <sup>2</sup>
<b>AWG conductor size, min.</b>	0.13 mm <sup>2</sup>
<b>AWG conductor size, min.</b>	AWG 26
<b>Connection direction</b>	on side
<b>Flexible, min.</b>	0.5 mm <sup>2</sup>
<b>2nd type of connection</b>	screwed
<b>Solid, min.</b>	0.5 mm <sup>2</sup>
<b>Twin wire-end ferrule, min.</b>	0.50 mm <sup>2</sup>
<b>Zwillings-AEH, max.</b>	1.50 mm <sup>2</sup>
<b>Dimensions</b>	
<b>Width</b>	8 mm
<b>Height of lowest version</b>	34 mm
<b>Length</b>	58 mm
<b>TS 32 offset</b>	11 mm
<b>TS 35 offset</b>	9 mm
<b>Disconnect terminals</b>	
<b>Torque level with DMS electric screwdriver</b>	2
<b>Display element</b>	
<b>Type of voltage for indicator</b>	AC/DC
<b>Operating voltage for indicator, max.</b>	500 V
<b>Fuse terminals</b>	
<b>Display</b>	without LED
<b>Operating voltage, max.</b>	500
<b>Fuse holder (cartridge holder)</b>	detachable