



OPERATIONS AND MAINTENANCE MANUALS

Regional Lagoons Manuals > ST53 Laidley > Sheds

Builder
Thomas Coffey

Compiled
Feb 03, 2015

Table of Contents

Regional Lagoons Manuals	1
ST53 Laidley	2
Electrical	3
Introduction	4
Assets	5
Maintenance	6
Operations & Tech Data	7
Warranties	8
Commissioning Information	9
Help & Contact	10
As Built Drawings	11
Hydraulic	12
Introduction	13
Assets	14
Maintenance	15
Operations & Tech Data	16
Warranties	17
Certificates	18
Commissioning Information	19
Help & Contact	20
As Built Drawings	21
Formwork/ Reinforcement and Concrete (T & C)	22
Certificates	23
Sheds	24
Introduction	25
Maintenance	26
Operations & Tech Data	27
Warranties	28
Certificates	29
Help & Contact	30
As Built Drawings	31
Thomas Coffey Finalisation documents	32
Introduction	33
Warranties	34
Commissioning Information	35
Help & Contact	36
As Built Drawings	37

Introduction

Introduction

This manual has been prepared by Ausfab for the purpose of Operation and maintenance of the Laidley portion of work of the Regional Lagoons Project. The work has been completed as per the Contract and Construction Drawings Supplied by Thomas Coffey.

Please find complete as-built Drawings in the Drawing Section of this manual.

The Following is a brief description of the scope of work.

1. Design and construction of the MF building.

Maintenance

Colorbond Maintenance

6 - Monthly

Simple maintenance of COLORBOND® steel and ZINCALUME® steel by regular washing with water, will not only enhance its life but maintain its attractiveness for longer periods thus protecting your asset. Applications where the paint finish is automatically washed by rainwater do not usually require this maintenance, e.g. roof cladding. Examples of applications requiring maintenance cleaning include wall cladding under eaves, garage doors and the underside of eave gutters.

Areas not regularly washed by rainwater should be hosed down at least every six months and more frequently in coastal areas where marine salt spray is prevalent, and in areas where high levels of industrial fallout occur.

In cases where the regular maintenance referred to above does not remove all dirt which may have adhered to the surface of the paint, the following procedure should be carried out:

Wash the surface with a mild solution of pure soap or mild non-abrasive kitchen detergent in warm water. Application should be with a sponge, soft cloth or soft bristle nylon brush, and should be gentle to prevent shiny spots.

The COLORBOND® steel and ZINCALUME® steel should be thoroughly rinsed with clean water immediately after cleaning to remove traces of detergent.

Never use abrasive or solvent type cleaners (turps, petrol, kerosene, paint thinners) on COLORBOND® steel and ZINCALUME® steel.

If cared for in accordance with these instructions, your building components made from COLORBOND® prepainted steel and ZINCALUME® steel will give many years of low maintenance life.

Leaf Beater Rain Water Head

1 - Monthly

The Clean Shield™ screen is mostly self cleaning. If cleaning is required simply lift the Clean Shield™ screen out by taking hold of the quick release tabs and pull the Clean Shield™ screen upwards and outwards, then hose or brush off.

Operations & Tech Data

Leaf Beater Rainwater Head

Linked Documents

 [Leaf_Beater_Original_Spec and Maintenance_Sheet.pdf](#)

Colorbond Techincal Data

Linked Documents

 [flow meter operating instructions.pdf](#)



Products: Leaf Beater® Original with Clean Shield™

Code: RHLB01 – 90mm
RHLB02 – 100mm

The Original Compact Rain Head - now
with Enhanced Performance

Product Description

Keeps your Rain Harvesting system free of mosquitoes, vermin and debris.

The Leaf Beater® Original + Clean Shield™ is the practical and versatile Rain Head, featuring the new patented Clean Shield™ (single screen) technology. The Leaf Beater® Original + Clean Shield™ Rain Head prevents debris from entering the Rain Harvesting system, improves water quality and reduces tank maintenance. The single screen incorporates Clean Shield™ technology which deflects leaves and debris away from the flow of water. This minimises maintenance and enhances catchment efficiency.

Features and Benefits

- Upgraded with new debris shedding single screen technology (Clean Shield™)
- Enhanced catchment efficiency – collect more rainwater
- Minimal maintenance – screen automatically sheds debris
- Higher flow rate performance
- Compact design suits smaller spaces
- A single mosquito proof stainless steel mesh screen with 0.955mm aperture
- Available in 90mm or 100mm outlet

Compliance





- Queensland Development Code MP 4.2 – Water Saving Targets
- AS/NZS 3500.3:2003 Plumbing and Drainage – Stormwater Drainage
- HB230:2008 Rainwater Tank Design and Installation Handbook
- enHealth Council – Guidance on the Use of Rainwater Tanks – Preventing Mosquitoes Breeding
- Queensland Health Regulations 1996 (Part 8 – Mosquito Prevention)

Installation

Gutter Installation

1. Remove the existing Gutter Outlet from the roof guttering system.
2. Hold the new Gutter Outlet #3 against the fascia and the bottom of the gutter where the new outlet hole is to be, then using the gutter outlet as a template, draw around the inside of the outlet to mark the underside of the gutter for the new hole and cut out with tin snips.
3. Refit the Gutter Outlet #3 to the main body #1 and place a small amount of sealant in the sealant groove in #3.
4. Remove the Clean Shield™ screen #2 whilst fitting the Leaf Beater® Original. Simply lift the Clean Shield™ screen out (figure 4) by taking hold of the quick release tabs (red) and pull them outwards and upwards.
5. Slide the Leaf Beater® Original up against the fascia and position the Outlet #3 over the gutter outlet hole. Fasten the unit to the fascia with two rivets or screws through the back of the body #1 and into the fascia.
6. Insert the Clean Shield™ screen #2 into the rain head at approx 45 degrees (figure 1) until the front rubber channel is nearly over the front lip of the body. TIP : Wetting the rubber seal will help the screen slide into place.
7. Fix the front of the Clean Shield™ screen #2 into place (figure 2) by sliding the rubber channel (red) over the front lip (green) of the body.
8. Reaching towards the back of the screen push down on the plastic frame (figure 3) so that the rear edge (red) is below the lowest notch (green) and firmly against the back wall of the Leaf Beater® Original.
9. The Leaf Beater® Original is now ready for connection to the downpipe. Do NOT glue the Leaf Beater® Original to the downpipe. SECURE with a screw for easy replacement.

NOTE: Where gutters are stretched out or out of square it may be necessary to rivet the Outlet #4 to the gutter. Take care to ensure the Outlet #4 is sealed to the gutter in all situations.

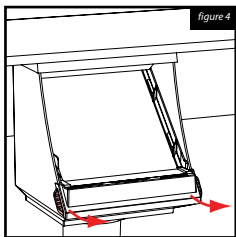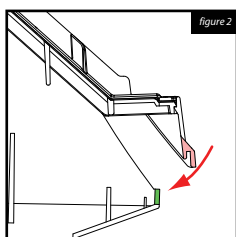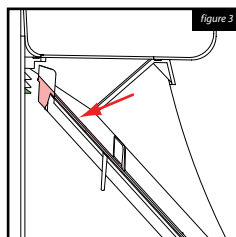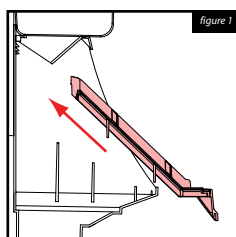



Mid-Mount Installation

To improve access for cleaning the Leaf Beater® Original Rain Head can be mounted down the wall at a convenient height.

It is important to note that when mid-mounting, the flow directional benefits of the rectangular gutter outlet supplied with the Leaf Beater® Original will be lost. However this is to be balanced with the benefits gained from easier access for maintenance.

For mid-mounting, discard the top flow-directional gutter outlet. Cut the entry downpipe and install so that the downpipe sits approximately 5mm below the inside top edge of the Leaf Beater® Original body. This ensures the end of the pipe is within the Leaf Beater® Original and water is directed onto the face of the screen.

Recommendation: When mounting the Leaf Beater® Original, make sure that it is mounted minimum of 1.2m above the discharge point when pushing water underground and then up into a tank. Long runs may require more than a 1.2m head depending on the pipe length and size of the pipe and the volume required to be moved.

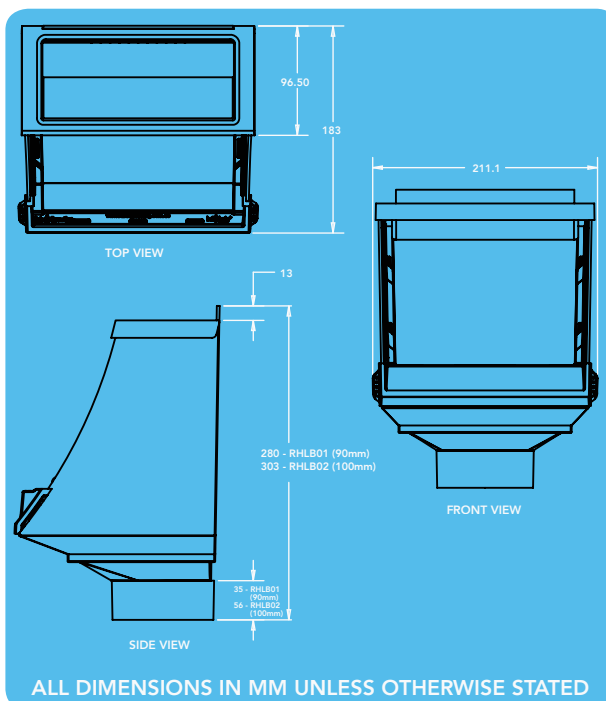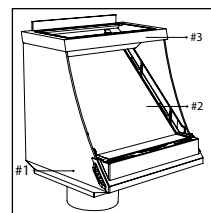

Maintenance

The Clean Shield™ screen is mostly self cleaning. If cleaning is required simply lift the Clean Shield™ screen out by taking hold of the quick release tabs and pull the Clean Shield™ screen upwards and outwards, then hose or brush off.

PO237 DISCLAIMER This product specification is not a complete guide to product usage. Further information is available from Rain Harvesting Pty Ltd and from the Installation and Operating Instructions. This specification sheet must be read in conjunction with the Installation and Operating Instructions and all applicable statutory requirement. Product specifications may change without notice. © Rain Harvesting Pty Ltd



Level



Pressure



Flow



Temperature



Liquid
Analysis



Registration



Systems
Components



Services







Solutions

Operating Instructions

Proline Promag 50

Electromagnetic flow measuring system

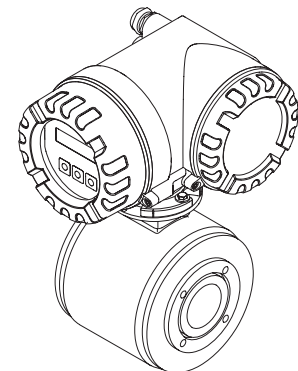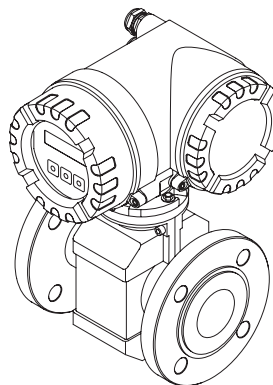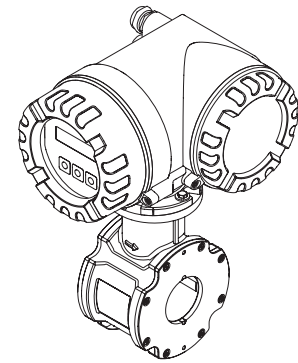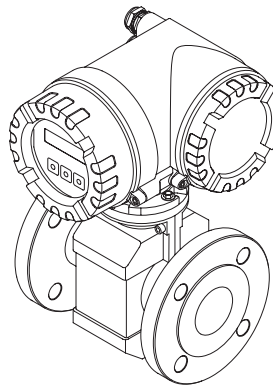

BA046D/06/en/12.09
71106181

Valid as of version
V 2.03.XX (device software)

Endress+Hauser 
People for Process Automation

Table of contents

1	Safety instructions	5		
1.1	Designated use	5		
1.2	Installation, commissioning and operation	5		
1.3	Operational safety	5		
1.4	Return	6		
1.5	Notes on safety conventions and icons	6		
2	Identification	7		
2.1	Device designation	7		
2.1.1	Nameplate of the transmitter	7		
2.1.2	Nameplate of the sensor	8		
2.1.3	Nameplate, connections	9		
2.2	Certificates and approvals	9		
2.3	Registered trademarks	10		
3	Installation	11		
3.1	Incoming acceptance, transport and storage	11		
3.1.1	Incoming acceptance	11		
3.1.2	Transport	11		
3.1.3	Storage	12		
3.2	Installation conditions	13		
3.2.1	Dimensions	13		
3.2.2	Mounting location	13		
3.2.3	Orientation	15		
3.2.4	Vibrations	16		
3.2.5	Foundations, supports	17		
3.2.6	Adapters	17		
3.2.7	Nominal diameter and flow rate	18		
3.2.8	Length of connecting cable	20		
3.3	Installation instructions	21		
3.3.1	Installing the Promag D sensor	21		
3.3.2	Installing the Promag L sensor	24		
3.3.3	Installing the Promag W sensor	26		
3.3.4	Installing the Promag P sensor	31		
3.3.5	Installing the Promag H sensor	36		
3.3.6	Turning the transmitter housing	39		
3.3.7	Turning the onsite display	40		
3.3.8	Installing the wall-mount housing	41		
3.4	Post-installation check	43		
4	Wiring	44		
4.1	Connecting the remote version	44		
4.1.1	Connecting Promag D, L, W, P, H	44		
4.1.2	Cable specifications	49		
4.2	Connecting the measuring unit	50		
4.2.1	Connecting the transmitter	50		
4.2.2	Terminal assignment	52		
4.2.3	HART connection	53		
4.3	Potential equalization	54		
4.3.1	Potential equalization for Promag D	54		
4.3.2	Potential equalization for Promag W, P, L	54		
4.3.3	Potential equalization for Promag H	54		
4.3.4	Exampels for potential equalization connections for Promag D	54		
4.3.5	Exampels for potential equalization connections for Promag L, W, P	55		
4.4	Degree of protection	57		
4.5	Post-connection check	58		
5	Operation	59		
5.1	Display and operating elements	59		
5.2	Brief operating instructions on the function matrix	60		
5.2.1	General notes	61		
5.2.2	Enabling the programming mode	61		
5.2.3	Disabling the programming mode	61		
5.3	Displaying error messages	62		
5.3.1	Type of error	62		
5.3.2	Error message types	62		
5.4	Communication	63		
5.4.1	Operating options	63		
5.4.2	Current device description files	64		
5.4.3	Device variables	64		
5.4.4	Switching HART write protection on/off	64		
5.4.5	Universal and common practice HART commands	65		
5.4.6	Device status and error messages	69		
6	Commissioning	71		
6.1	Function check	71		
6.2	Switching on the measuring device	71		
6.3	Quick Setup	72		
6.3.1	"Commissioning" Quick Setup menu	72		
6.4	Configuration	73		
6.4.1	Current output: active/passive	73		
6.5	Adjustment	74		
6.5.1	Empty-pipe/full-pipe adjustment	74		
6.6	Data storage device (HistoROM)	75		
6.6.1	HistoROM/S-DAT (sensor-DAT)	75		
7	Maintenance	76		
7.1	Exterior cleaning	76		
7.2	Seals	76		
8	Accessories	77		
8.1	Device-specific accessories	77		
8.2	Measuring principle-specific accessories	77		
8.3	Communication-specific accessories	78		
8.4	Service-specific accessories	79		
9	Troubleshooting	80		
9.1	Troubleshooting instructions	80		
9.2	System error messages	81		
9.3	Process error messages	83		
9.4	Process errors without messages	84		
9.5	Response of outputs to errors	85		
9.6	Spare parts	87		

9.6.1	Removing and installing printed circuit boards	88
9.6.2	Replacing the device fuse	92
9.6.3	Replacing the exchangeable electrode	93
9.7	Return	95
9.8	Disposal	95
9.9	Software history	95
10	Technical data	97
10.1	Technical data at a glance	97
10.1.1	Application	97
10.1.2	Function and system design	97
10.1.3	Input	97
10.1.4	Output	97
10.1.5	Power supply	99
10.1.6	Performance characteristics	100
10.1.7	Operating conditions: Installation	100
10.1.8	Operating conditions: Environment	101
10.1.9	Operating conditions: Process	102
10.1.10	Mechanical construction	107
10.1.11	Human interface	115
10.1.12	Certificates and approvals	115
10.1.13	Ordering information	116
10.1.14	Accessories	116
10.1.15	Documentation	116
Index	117

1 Safety instructions

1.1 Designated use

The measuring device described in this Operating Manual is to be used only for measuring the flow rate of conductive fluids in closed pipes.

A minimum conductivity of 20 $\mu\text{S}/\text{cm}$ is required for measuring demineralized water. Most liquids can be measured as of a minimum conductivity of 5 $\mu\text{S}/\text{cm}$.

Examples:

- Acids, alkalis,
- Drinking water, wastewater, sewage sludge,
- Milk, beer, wine, mineral water, etc.

Resulting from incorrect use or from use other than that designated the operational safety of the measuring devices can be suspended. The manufacturer accepts no liability for damages being produced from this.




1.2 Installation, commissioning and operation

Please note the following:

- Installation, connection to the electricity supply, commissioning and maintenance of the device must be carried out by trained, qualified specialists authorized to perform such work by the facility's owner-operator. The specialist must have read and understood this Operating Manual and must follow the instructions it contains.
- The device must be operated by persons authorized and trained by the facility's owner-operator. Strict compliance with the instructions in the Operating Manual is mandatory.
- With regard to special fluids, including fluids used for cleaning, Endress+Hauser will be happy to assist in clarifying the corrosion-resistant properties of wetted materials. However, minor changes in temperature, concentration or in the degree of contamination in the process may result in variations in corrosion resistance. For this reason, Endress+Hauser does not accept any responsibility with regard to the corrosion resistance of wetted materials in a specific application.
The user is responsible for the choice of suitable wetted materials in the process.
- If welding work is performed on the piping system, do not ground the welding appliance through the Promag flowmeter.
- The installer must ensure that the measuring system is correctly wired in accordance with the wiring diagrams. The transmitter must be grounded apart from when special protective measures are taken (e.g. galvanically isolated SELV or PELV power supply)
- Invariably, local regulations governing the opening and repair of electrical devices apply.

1.3 Operational safety

Please note the following:

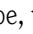- Measuring systems for use in hazardous environments are accompanied by separate Ex documentation, which is an integral part of this Operating Manual. Strict compliance with the installation instructions and ratings as stated in this supplementary documentation is mandatory. The symbol on the front of this Ex documentation indicates the approval and the certification body (e.g.  Europe,  USA,  Canada).
- The measuring device complies with the general safety requirements in accordance with EN 61010-1, the EMC requirements of IEC/EN 61326 and NAMUR Recommendations NE 21 and NE 43.
- Depending on the application, the seals of the process connections of the Promag H sensor require periodic replacement.

- When hot fluid passes through the measuring tube, the surface temperature of the housing increases. In the case of the sensor, in particular, users should expect temperatures that can be close to the fluid temperature. If the temperature of the fluid is high, implement sufficient measures to prevent burning or scalding.
- The manufacturer reserves the right to modify technical data without prior notice. Your Endress+Hauser distributor will supply you with current information and updates to these Operating Instructions.

1.4 Return

- Do not return a measuring device if you are not absolutely certain that all traces of hazardous substances have been removed, e.g. substances which have penetrated crevices or diffused through plastic.
- Costs incurred for waste disposal and injury (burns, etc.) due to inadequate cleaning will be charged to the owner-operator.

1.5 Notes on safety conventions and icons

The devices are designed to meet state-of-the-art safety requirements, have been tested, and left the factory in a condition in which they are safe to operate. The devices comply with the applicable standards and regulations in accordance with EN 61010-1 "Safety requirements for electrical equipment for measurement, control and laboratory use".

The devices can, however, be a source of danger if used incorrectly or for anything other than the designated use. Consequently, always pay particular attention to the safety instructions indicated in this Operating Manual by the following icons:



Warning!

"Warning" indicates an action or procedure which, if not performed correctly, can result in injury or a safety hazard. Comply strictly with the instructions and proceed with care.



Caution!

"Caution" indicates an action or procedure which, if not performed correctly, can result in incorrect operation or destruction of the device. Comply strictly with the instructions.



Note!

"Note" indicates an action or procedure which, if not performed correctly, can have an indirect effect on operation or trigger an unexpected response on the part of the device.

2 Identification

2.1 Device designation

The flow measuring system consists of the following components:

- Promag 50 transmitter
- Promag D, Promag L, Promag W, Promag P or Promag H sensor

In the *compact version*, the transmitter and sensor form a single mechanical unit; in the *remote version* they are installed separately.

2.1.1 Nameplate of the transmitter

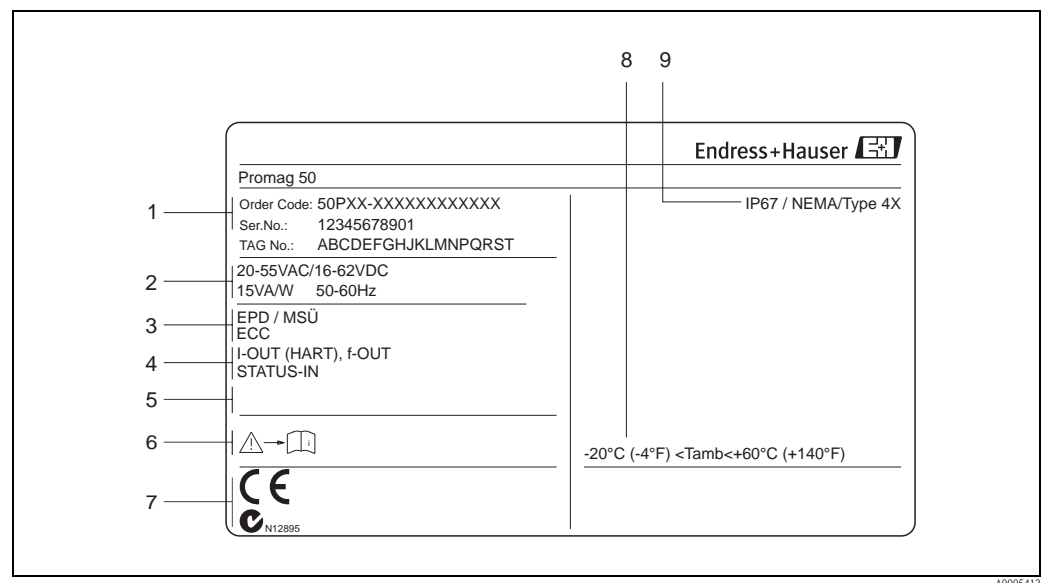


Fig. 1: Nameplate specifications for the "Promag 50" transmitter (example)

- 1 Ordering code/serial number: See the specifications on the order confirmation for the meanings of the individual letters and digits.
- 2 Power supply, frequency, power consumption
- 3 Additional information:
EPD/MSÜ: with Empty Pipe Detection
ECC: with electrode cleaning
- 4 Outputs available:
I-OUT (HART): with current output (HART)
f-OUT (HART): with frequency output
STATUS-IN: with status input (power supply)
- 5 Reserved for information on special products
- 6 Observe device documentation
- 7 Reserved for additional information on device version (approvals, certificates)
- 8 Permitted ambient temperature range
- 9 Degree of protection

2.1.2 Nameplate of the sensor

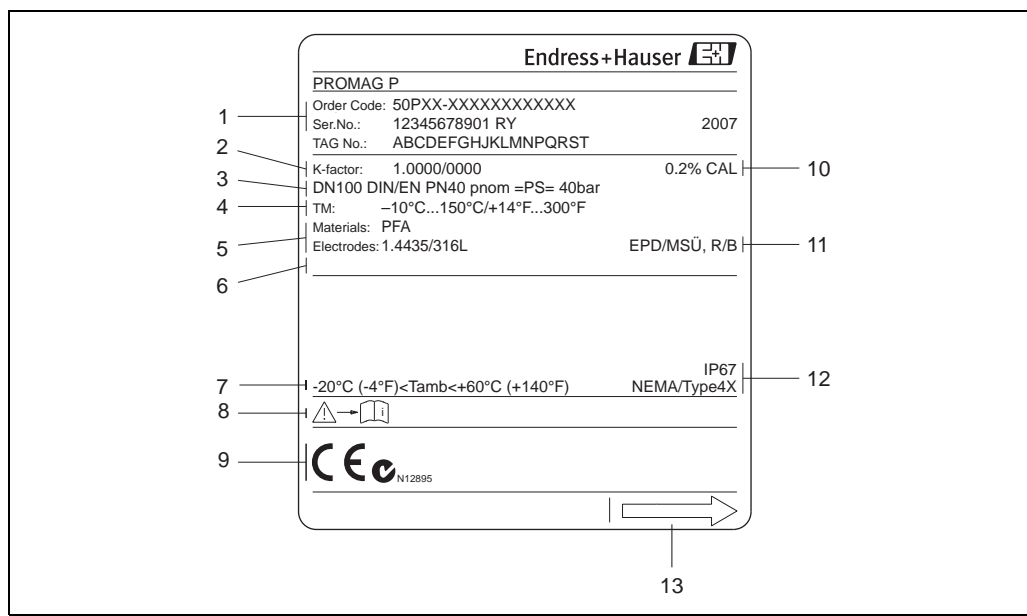


Fig. 2: Nameplate specifications for the "Promag" sensor (example)

- 1 Ordering code/serial number: See the specifications on the order confirmation for the meanings of the individual letters and digits.
- 2 Calibration factor with zero point
- 3 Nominal diameter / Pressure rating
- 4 Fluid temperature range
- 5 Materials: lining/measuring electrodes
- 6 Reserved for information on special products
- 7 Permitted ambient temperature range
- 8 Observe device documentation
- 9 Reserved for additional information on device version (approvals, certificates)
- 10 Calibration tolerance
- 11 Additional information (examples):
 - EPD/MSÜ: with Empty Pipe Detection electrode
 - R/B: with reference electrode
- 12 Degree of protection
- 13 Flow direction

2.1.3 Nameplate, connections

See operating manual
Betriebsanleitung beachten
Observer manuel d'instruction

A: active
P: passive
NO: normally open contact
NC: normally closed contact

1 Ser.No.: 12345678912

4 Supply / Versorgung / Tension d'alimentation

5 Active: 0/4...20mA, RL max. = 700 Ohm
Passive: 4...20mA, max. 30VDC
(HART: RL.min. = 250 OHM)
fmax = 1kHz
Active: 24VDC/25mA (max. 250mA/20ms)
Passive: 30VDC, 250mA
Passive: 30VDC, 250mA
3...30VDC, Ri = 5kOhm

I-OUT (HART)
I-OUT
STATUS-OUT
STATUS-IN

6 Ex-works / ab-Werk / réglages usine
Device SW: XX.XX.XX (WEA)
Communication: XXXXXXXXXX
Drivers: ID xxxx (HEX)
Date: DD.MMM.YYYY

Update 1
Update 2
319475-00XX

10

Fig. 3: Nameplate specifications for transmitter (example)

- 1 Serial number
- 2 Possible configuration of current output
- 3 Possible configuration of relay contacts
- 4 Terminal assignment, cable for power supply: 85 to 260 V AC, 20 to 55 V AC, 16 to 62 V DC
Terminal No. 1: L1 for AC, L+ for DC
Terminal No. 2: N for AC, L- for DC
- 5 Signals present at inputs and outputs, possible configuration and terminal assignment (20 to 27), see also "Electrical values of inputs/outputs"
- 6 Version of device software currently installed
- 7 Installed communication type, e.g.: HART, PROFIBUS PA, etc.
- 8 Information on current communication software (Device Revision and Device Description), e.g.: Dev. 01 / DD 01 for HART
- 9 Date of installation
- 10 Current updates to data specified in points 6 to 9

2.2 Certificates and approvals

The devices are designed to meet state-of-the-art safety requirements in accordance with sound engineering practice. They have been tested and left the factory in a condition in which they are safe to operate.

The devices comply with the applicable standards and regulations in accordance with EN 61010-1 "Safety requirements for electrical equipment for measurement, control and laboratory use" and with the EMC requirements of IEC/EN 61326/A1.

The measuring system described in this Operating Manual is therefore in conformity with the statutory requirements of the EC Directives. Endress+Hauser confirms successful testing of the device by affixing to it the CE mark.

The measuring system meets the EMC requirements of the Australian Communications and Media Authority (ACMA)

2.3 Registered trademarks

KALREZ® and VITON®

Registered trademarks of E.I. Du Pont de Nemours & Co., Wilmington, USA

TRI-CLAMP®

Registered trademark of Ladish & Co., Inc., Kenosha, USA

HART®

Registered trademark of the HART Communication Foundation, Austin, USA

HistoROM™, S-DAT®, Field Xpert™, FieldCare®, Fieldcheck®, Applicator®

Registered or registration-pending trademarks of Endress+Hauser Flowtec AG, Reinach, CH

3 Installation

3.1 Incoming acceptance, transport and storage

3.1.1 Incoming acceptance

On receipt of the goods, check the following:

- Check the packaging and the contents for damage.
- Check the shipment, make sure nothing is missing and that the scope of supply matches your order.

3.1.2 Transport

The following instructions apply to unpacking and to transporting the device to its final location:

- Transport the devices in the containers in which they are delivered.
- Do not remove the protective plates or caps on the process connections until you are ready to install the device. This is particularly important in the case of sensors with PTFE linings.

Special notes on flanged devices



Caution!

- The wooden covers mounted on the flanges from the factory protect the linings on the flanges during storage and transportation. In case of Promag L they are additionally used to hold the lap joint flanges in place. Do not remove these covers until **immediately before** the device in the pipe.
- Do not lift flanged devices by the transmitter housing, or the connection housing in the case of the remote version.

Transporting flanged devices $DN \leq 300$ ($\leq 12''$)

Use webbing slings slung round the two process connections. Do not use chains, as they could damage the housing.



Warning!

Risk of injury if the measuring device slips. The center of gravity of the assembled measuring device might be higher than the points around which the slings are slung.

At all times, therefore, make sure that the device does not unexpectedly turn around its axis or slip.

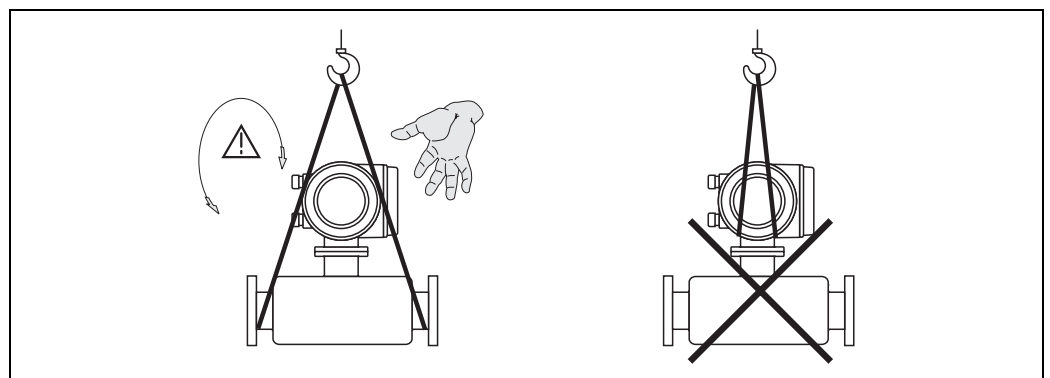


Fig. 4: Transporting sensors with $DN \leq 300$ ($\leq 12''$)

a0004294

Transporting flanged devices DN > 300 (> 12")

Use only the metal eyes on the flanges for transporting the device, lifting it and positioning the sensor in the piping.

**Caution!**

Do not attempt to lift the sensor with the tines of a fork-lift truck beneath the metal casing. This would buckle the casing and damage the internal magnetic coils.

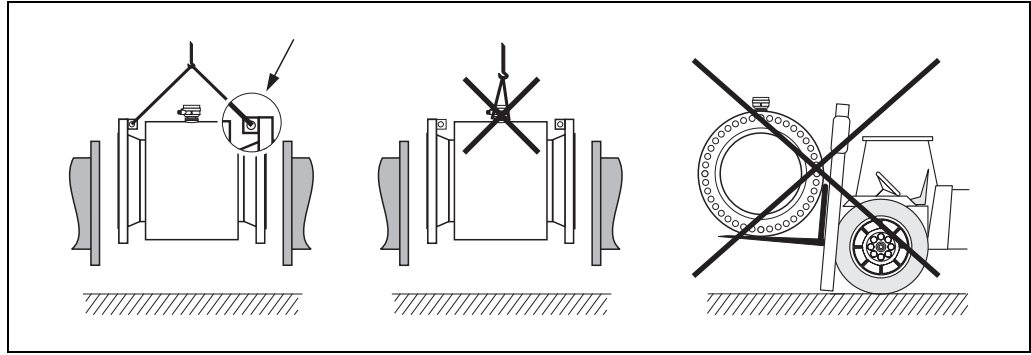


Fig. 5: Transporting sensors with DN > 300 (> 12")

3.1.3 Storage

Please note the following:

- Pack the measuring device in such a way as to protect it reliably against impact for storage (and transportation). The original packaging provides optimum protection.
- The storage temperature corresponds to the operating temperature range of the measuring transmitter and the appropriate measuring sensors → 101.
- Do not remove the protective plates or caps on the process connections until you are ready to install the device. This is particularly important in the case of sensors with PTFE linings.
- The measuring device must be protected against direct sunlight during storage in order to avoid unacceptably high surface temperatures.
- Choose a storage location where moisture does not collect in the measuring device. This will help prevent fungus and bacteria infestation which can damage the liner.

3.2 Installation conditions

3.2.1 Dimensions

The dimensions and installation lengths of the sensor and transmitter can be found in the "Technical Information" for the device in question. This document can be downloaded as a PDF file from www.endress.com. A list of the "Technical Information" documents available is provided in the "Documentation" section on → 116.

3.2.2 Mounting location

Entrained air or gas bubble formation in the measuring tube can result in an increase in measuring errors.

Avoid the following locations:

- Highest point of a pipeline. Risk of air accumulating!
- Directly upstream from a free pipe outlet in a vertical pipeline.

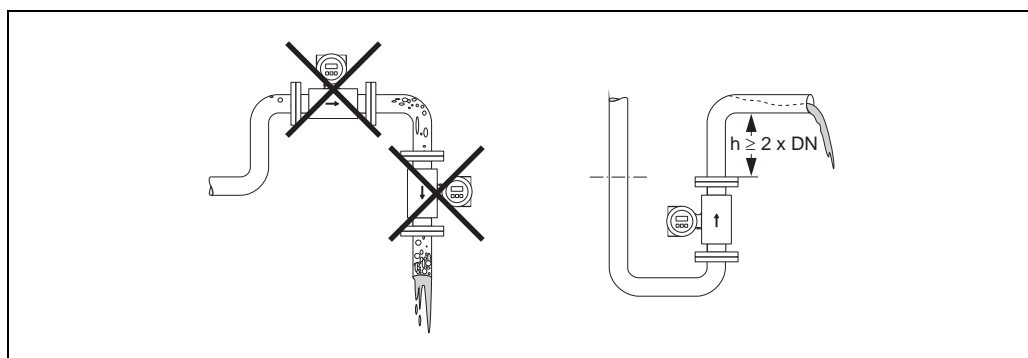


Fig. 6: Mounting location

Installation of pumps

Do **not** install the sensor on the intake side of a pump. This precaution is to avoid low pressure and the consequent risk of damage to the lining of the measuring tube. Information on the lining's resistance to partial vacuum can be found on → 105.

It might be necessary to install pulse dampers in systems incorporating reciprocating, diaphragm or peristaltic pumps. Information on the measuring system's resistance to vibration and shock can be found on → 101.

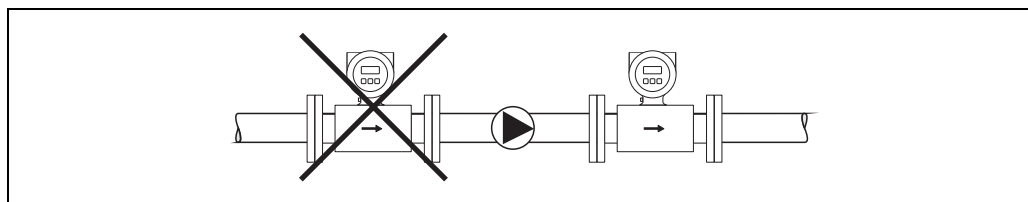


Fig. 7: Installation of pumps

Partially filled pipes

Partially filled pipes with gradients necessitate a drain-type configuration.

The Empty Pipe Detection function (EPD → 74) offers additional protection by detecting empty or partially filled pipes.



Caution!

Risk of solids accumulating. Do not install the sensor at the lowest point in the drain. It is advisable to install a cleaning valve.

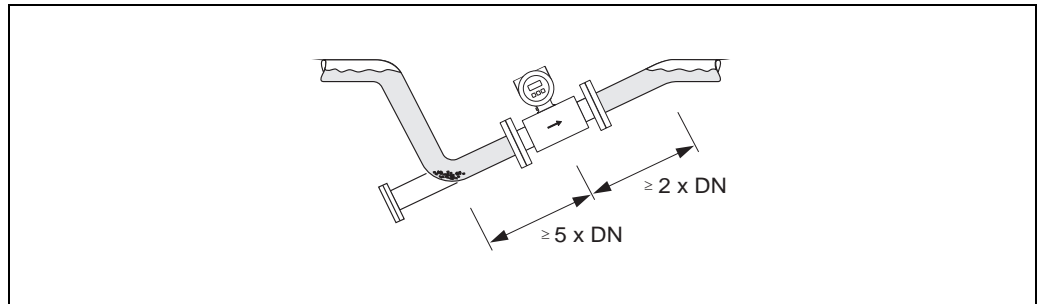


Fig. 8: Installation in a partially filled pipe

Down pipes

Install a siphon or a vent valve downstream of the sensor in down pipes whose length $h \geq 5$ m (16.4 ft). This precaution is to avoid low pressure and the consequent risk of damage to the lining of the measuring tube.

This measure also prevents the system losing prime, which could cause air pockets. Information on the lining's resistance to partial vacuum can be found on → 105.

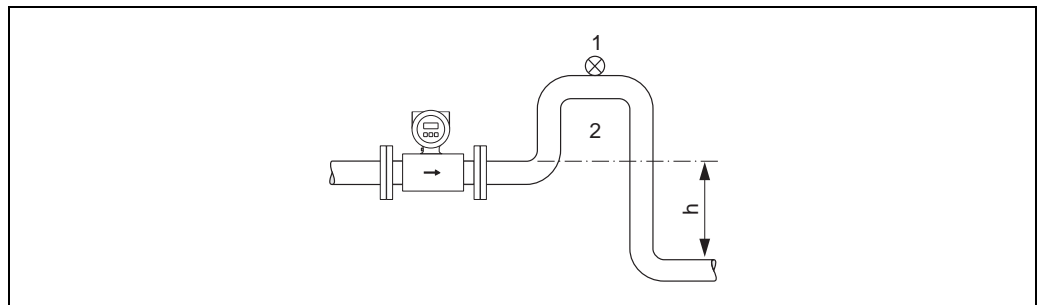


Fig. 9: Measures for installation in a down pipe

- 1 Vent valve
- 2 Pipe siphon
- h Length of down pipe

3.2.3 Orientation

An optimum orientation position helps avoid gas and air accumulations and deposits in the measuring tube. However, Promag offers the additional Empty Pipe Detection (EPD) function to ensure the detection of partially filled measuring tubes, e.g. in the case of degassing fluids or varying process pressure:

- Electrode Cleaning Circuit (ECC) for applications with accretive fluids, e.g. electrically conductive deposits (→ "Description of Device Functions" manual).
- Empty Pipe Detection (EPD) ensures the detection of partially filled measuring tubes, e.g. in the case of degassing fluids (→ 74)
- Exchangeable Measuring Electrodes for abrasive fluids (→ 93)

Vertical orientation

This is the ideal orientation for self-emptying piping systems and for use in conjunction with Empty Pipe Detection.

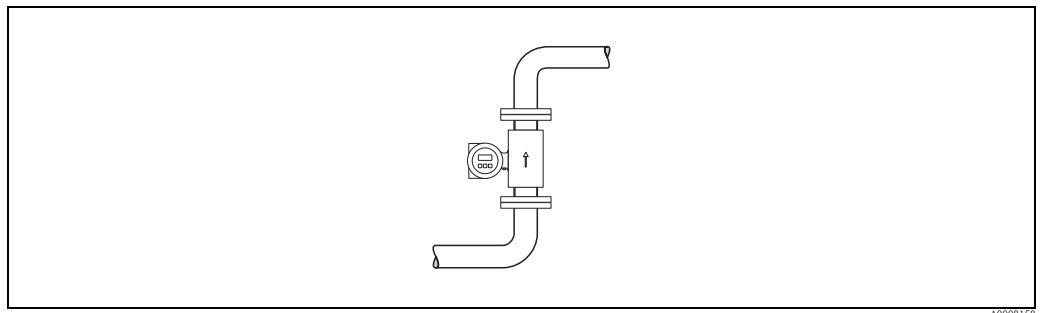


Fig. 10: Vertical orientation

Horizontal orientation

The measuring electrode plane should be horizontal. This prevents brief insulation of the two measuring electrodes by entrained air bubbles.



Caution!

Empty Pipe Detection functions correctly only when the measuring device is installed horizontally and the transmitter housing is facing upward (→ 10). Otherwise there is no guarantee that Empty Pipe Detection will respond if the measuring tube is only partially filled or empty.

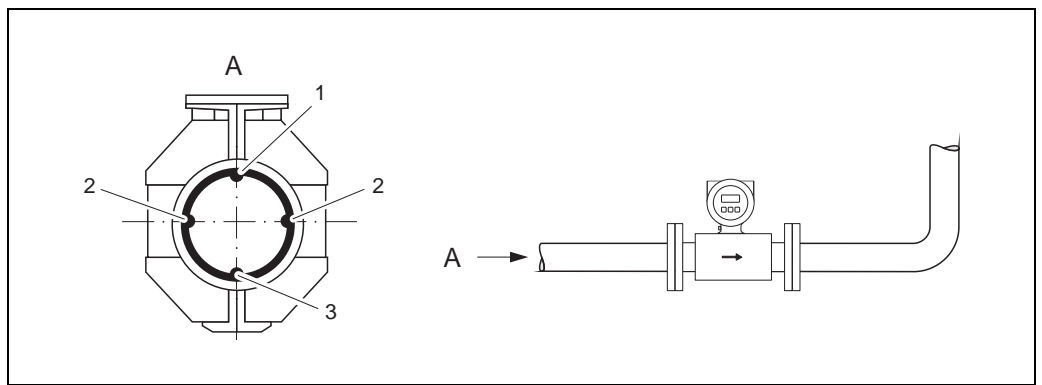


Fig. 11: Horizontal orientation

- 1 EPD electrode for the detection of empty pipes (not with Promag D and Promag H (DN 2 to 15; 1/12" to 1/2"))
- 2 Measuring electrodes for signal detection
- 3 Reference electrode for the potential equalization (not with Promag D and H)

Inlet and outlet run

If possible, install the sensor upstream from fittings such as valves, T-pieces, elbows, etc. The following inlet and outlet runs must be observed in order to meet accuracy specifications:

- Inlet run: $\geq 5 \times \text{DN}$
- Outlet run: $\geq 2 \times \text{DN}$

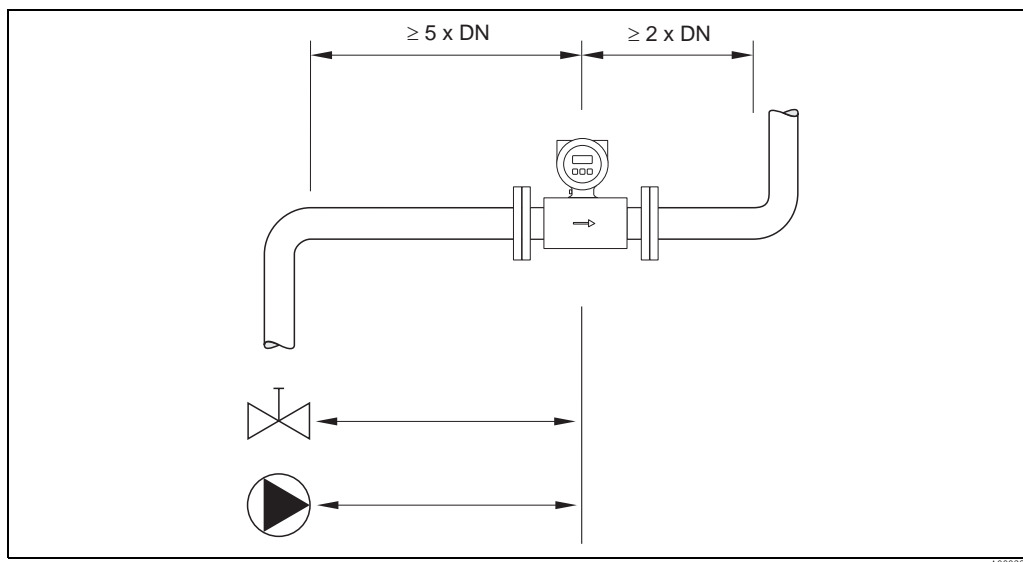


Fig. 12: Inlet and outlet runs

3.2.4 Vibrations

Secure the piping and the sensor if vibration is severe.



Caution!

If vibrations are too severe, we recommend the sensor and transmitter be mounted separately. Information on resistance to vibration and shock can be found on → 101.

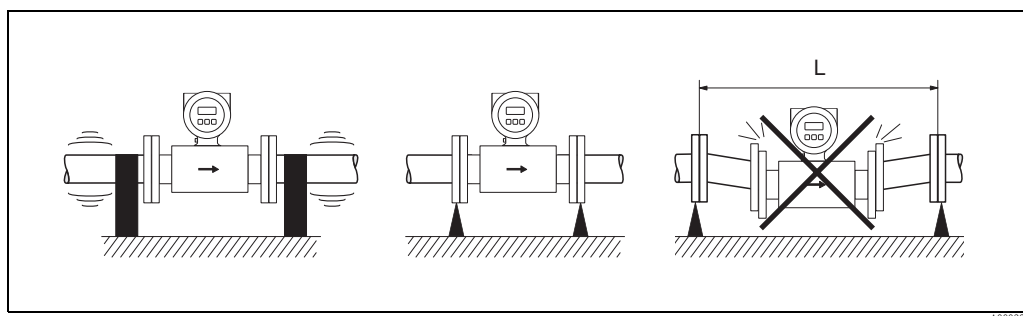


Fig. 13: Measures to prevent vibration of the device ($L > 10 \text{ m (32.8 ft)}$)

3.2.5 Foundations, supports

If the nominal diameter is $DN \geq 350$, mount the sensor on a foundation of adequate load-bearing strength.



Caution!

Risk of damage.

Do not support the weight of the sensor on the metal casing; the casing would buckle and damage the internal magnetic coils.

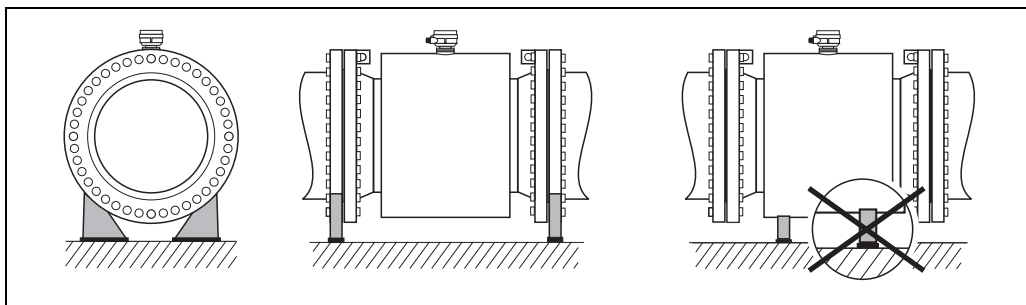


Fig. 14: Correct support for large nominal diameters ($DN \geq 350$)

3.2.6 Adapters

Suitable adapters to DIN EN 545 (double-flange reducers) can be used to install the sensor in larger-diameter pipes.

The resultant increase in the rate of flow improves measuring accuracy with very slow-moving fluids. The nomogram shown here can be used to calculate the pressure loss caused by reducers and expanders.



Note!

The nomogram only applies to liquids of viscosity similar to water.

1. Calculate the ratio of the diameters d/D .
2. From the nomogram read off the pressure loss as a function of flow velocity (*downstream* from the reduction) and the d/D ratio.

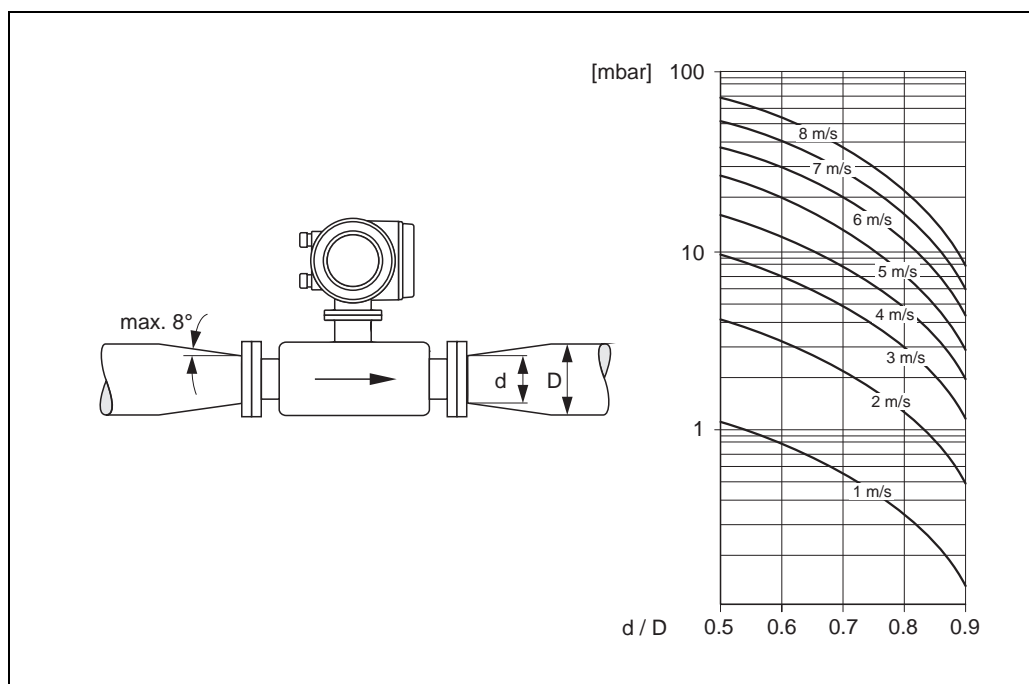


Fig. 15: Pressure loss due to adapters

3.2.7 Nominal diameter and flow rate

The diameter of the pipe and the flow rate determine the nominal diameter of the sensor. The optimum velocity of flow is between 2 and 3 m/s (6.5 to 9.8 ft/s)

The velocity of flow (v), moreover, has to be matched to the physical properties of the fluid:

- $v < 2$ m/s ($v < 6.5$ ft/s): for abrasive fluids
- $v > 2$ m/s ($v > 6.5$ ft/s): for fluids producing buildup



Note!

Flow velocity can be increased, if necessary, by reducing the nominal diameter of the sensor (→ 17).

Recommended flow (SI units)

Nominal diameter	Promag D	Promag L	Promag W	Promag P	Promag H
[mm]	Min./max. full scale value ($v \approx 0.3$ or 10 m/s) in [dm ³ /min]				
2	–	–	–	–	0.06 to 1.8
4	–	–	–	–	0.25 to 7
8	–	–	–	–	1 to 30
15	–	–	–	4 to 100	4 to 100
25	9 to 300	–	9 to 300	9 to 300	9 to 300
32	–	–	15 to 500	15 to 500	–
40	25 to 700	–	25 to 700	25 to 700	25 to 700
50	35 to 1100	35 to 1100	35 to 1100	35 to 1100	35 to 1100
65	60 to 2000	60 to 2000	60 to 2000	60 to 2000	60 to 2000
80	90 to 3000	90 to 3000	90 to 3000	90 to 3000	90 to 3000
100	145 to 4700	145 to 4700	145 to 4700	145 to 4700	145 to 4700
125	–	220 to 7500	220 to 7500	220 to 7500	–
[mm]	Min./max. full scale value ($v \approx 0.3$ or 10 m/s) in [m ³ /h]				
150	–	20 to 600	20 to 600	20 to 600	–
200	–	35 to 1100	35 to 1100	35 to 1100	–
250	–	55 to 1700	55 to 1700	55 to 1700	–
300	–	80 to 2400	80 to 2400	80 to 2400	–
350	–	–	110 to 3300	110 to 3300	–
375	–	–	140 to 4200	–	–
400	–	–	140 to 4200	140 to 4200	–
450	–	–	180 to 5400	180 to 5400	–
500	–	–	220 to 6600	220 to 6600	–
600	–	–	310 to 9600	310 to 9600	–
700	–	–	420 to 13500	–	–
800	–	–	550 to 18000	–	–
900	–	–	690 to 22500	–	–
1000	–	–	850 to 28000	–	–
1200	–	–	1250 to 40000	–	–
1400	–	–	1700 to 55000	–	–
1600	–	–	2200 to 70000	–	–
1800	–	–	2800 to 90000	–	–
2000	–	–	3400 to 110000	–	–

Recommended flow (US units)

Nominal diameter [inch]	Promag D	Promag L	Promag W	Promag P	Promag H
Min./max. full scale value ($v \approx 0.3$ or 10 m/s) in [gal/min]					
1 $\frac{1}{12}$ "	–	–	–	–	0.015 to 0.5
$\frac{5}{32}$ "	–	–	–	–	0.07 to 2
$\frac{5}{16}$ "	–	–	–	–	0.25 to 8
$\frac{1}{2}$ "	–	–	–	1.0 to 27	1.0 to 27
1"	2.5 to 80	–	2.5 to 80	2.5 to 80	2.5 to 80
1 $\frac{1}{4}$ "	–	–	4 to 130	4 to 130	–
1 $\frac{1}{2}$ "	7 to 190	7 to 190	7 to 190	7 to 190	7 to 190
2"	10 to 300	10 to 300	10 to 300	10 to 300	10 to 300
2 $\frac{1}{2}$ "	16 to 500	16 to 500	16 to 500	16 to 500	16 to 500
3"	24 to 800	24 to 800	24 to 800	24 to 800	24 to 800
4"	40 to 1250	40 to 1250	40 to 1250	40 to 1250	40 to 1250
5"	–	60 to 1950	60 to 1950	60 to 1950	–
6"	–	90 to 2650	90 to 2650	90 to 2650	–
8"	–	155 to 4850	155 to 4850	155 to 4850	–
10"	–	250 to 7500	250 to 7500	250 to 7500	–
12"	–	350 to 10600	350 to 10600	350 to 10600	–
14"	–	–	500 to 15000	500 to 15000	–
15"	–	–	600 to 19000	–	–
16"	–	–	600 to 19000	600 to 19000	–
18"	–	–	800 to 24000	800 to 24000	–
20"	–	–	1000 to 30000	1000 to 30000	–
24"	–	–	1400 to 44000	1400 to 44000	–
28"	–	–	1900 to 60000	–	–
30"	–	–	2150 to 67000	–	–
32"	–	–	2450 to 80000	–	–
36"	–	–	3100 to 100000	–	–
40"	–	–	3800 to 125000	–	–
42"	–	–	4200 to 135000	–	–
48"	–	–	5500 to 175000	–	–
Min./max. full scale value ($v \approx 0.3$ or 10 m/s) in [Mgal/d]					
54"	–	–	9 to 300	–	–
60"	–	–	12 to 380	–	–
66"	–	–	14 to 500	–	–
72"	–	–	16 to 570	–	–
78"	–	–	18 to 650	–	–

3.2.8 Length of connecting cable

In order to ensure measuring accuracy, comply with the following instructions when installing the remote version:

- Fix cable run or lay in armored conduit. Cable movements can falsify the measuring signal especially in the case of low fluid conductivities.
- Route the cable well clear of electrical machines and switching elements.
- Ensure potential equalization between sensor and transmitter, if necessary.
- The permitted connecting cable length L_{\max} is determined by the fluid conductivity (\rightarrow 16). A minimum conductivity of $20 \mu\text{S}/\text{cm}$ is required for measuring demineralized water. Most liquids can be measured as of a minimum conductivity of $5 \mu\text{S}/\text{cm}$.
- The maximum connecting cable length is 10 m (32.8 ft) when empty pipe detection (EPD \rightarrow 74) is switched on.

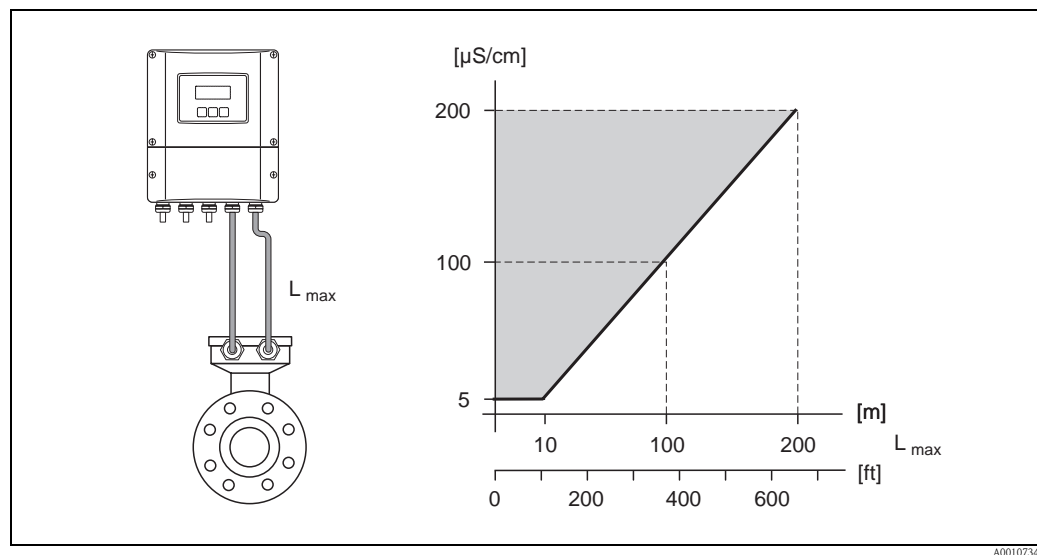


Fig. 16: Permissible cable length for the remote version

Area shaded gray = permitted range
 L_{\max} = connecting cable length in [m]
 Fluid conductivity in $[\mu\text{S}/\text{cm}]$

3.3 Installation instructions

3.3.1 Installing the Promag D sensor

The sensor is installed between the pipe flanges with a mounting kit. The device is centered using recesses on the sensor (→ 22).



Note!

A mounting kit consisting of mounting bolts, seals, nuts and washers can be ordered separately (→ 77). Centering sleeves are provided with the device if they are required for the installation.



Caution!

When installing the transmitter in the pipe, observe the necessary torques (→ 23).

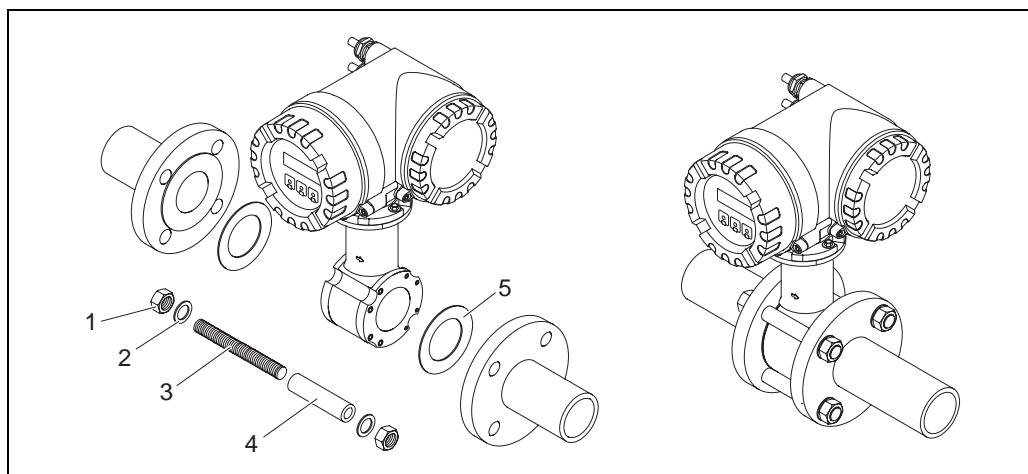


Fig. 17: Mounting the sensor

- 1 Nut
- 2 Washer
- 3 Mounting bolt
- 4 Centering sleeve
- 5 Seal

Seals

When installing the sensor, make sure that the seals used do not project into the pipe cross-section.



Caution!

Risk of short circuit! Do not use electrically conductive sealing compounds such as graphite! An electrically conductive layer could form on the inside of the measuring tube and short-circuit the measuring signal.









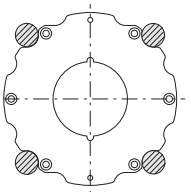
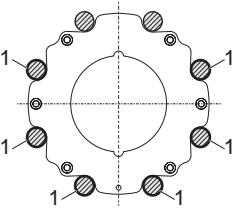
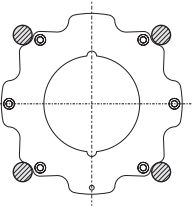
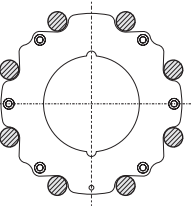
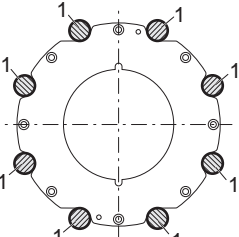
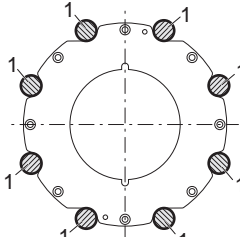
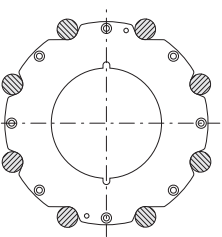


Note!

Use seals with a hardness rating of 70° Shore.

Arrangement of the mounting bolts and centering sleeves

The device is centered using recesses on the sensor. The arrangement of the mounting bolts and the use of the centering sleeves supplied depend on the nominal diameter, the flange standard and the pitch circle diameter.

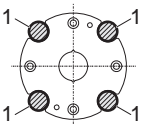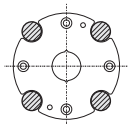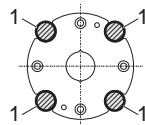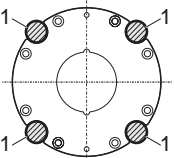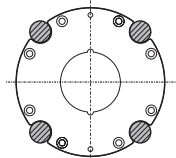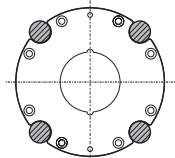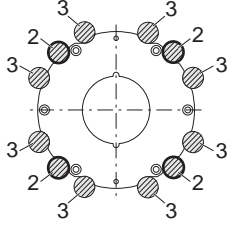	Process connection		
	EN (DIN)	ANSI	JIS
DN 25 to 40 (DN 1" to 1 ½")	 A0010896	 A0010824	 A0010896
DN 50 (DN 2")	 A0010897	 A0010825	 A0010825
DN 65	 A0012170	 A0010825	 A0012171
DN 80 (DN 3")	 A0010898	 A0010827	 A0010826
DN 100 (DN 4")	 A0012168	 A0012168	 A0012169
1 = Mounting bolts with centering sleeves 2 = EN (DIN) flanges: 4-hole → with centering sleeves 3 = EN (DIN) flanges: 8-hole → without centering sleeves			

Screw tightening torques (Promag D)

Please note the following:

- The tightening torques listed below are for lubricated threads only.
- Always tighten the screws uniformly and in diagonally opposite sequence.
- Overtightening the screws will deform the sealing faces or damage the seals.
- The tightening torques listed below apply only to pipes not subjected to tensile stress.

The tightening torques apply to situations where an EPDM soft material flat seal (e.g. 70 Shore) is used.

Tightening torques, mounting bolts and centering sleeves for EN (DIN) PN 16

Nominal diameter [mm]	Mounting bolts [mm]	Centering sleeve length [mm]	Tightening torque [Nm] with a process flange with a	
			smooth seal face	raised face
25	4 × M12 × 145	54	19	19
40	4 × M16 × 170	68	33	33
50	4 × M16 × 185	82	41	41
65 ¹⁾	4 × M16 × 200	92	44	44
65 ²⁾	8 × M16 × 200	– ³⁾	29	29
80	8 × M16 × 225	116	36	36
100	8 × M16 × 260	147	40	40

¹⁾ EN (DIN) flanges: 4-hole → with centering sleeves
²⁾ EN (DIN) flanges: 8-hole → without centering sleeves
³⁾ A centering sleeve is not required. The device is centered directly via the sensor housing.

Tightening torques, mounting bolts and centering sleeves for JIS 10 K

Nominal diameter [mm]	Mounting bolts [mm]	Centering sleeve length [mm]	Tightening torque [Nm] with a process flange with a	
			smooth seal face	raised face
25	4 × M16 × 170	54	24	24
40	4 × M16 × 170	68	32	25
50	4 × M16 × 185	– *	38	30
65	4 × M16 × 200	– *	42	42
80	8 × M16 × 225	– *	36	28
100	8 × M16 × 260	– *	39	37

* A centering sleeve is not required. The device is centered directly via the sensor housing.

Tightening torques, mounting bolts and centering sleeves for ANSI Class 150

Nominal diameter [inch]	Mounting bolts [inch]	Centering sleeve length [inch]	Tightening torque [lbf · ft] with a process flange with a	
			smooth seal face	raised face
1"	4 × UNC 1/2" × 5.70"	– *	14	7
1 1/2"	4 × UNC 1/2" × 6.50"	– *	21	14
2"	4 × UNC 5/8" × 7.50"	– *	30	27
3"	4 × UNC 5/8" × 9.25"	– *	31	31
4"	8 × UNC 5/8" × 10.4"	5.79	28	28

* A centering sleeve is not required. The device is centered directly via the sensor housing.

3.3.2 Installing the Promag L sensor



Caution!

- The protective covers mounted on the two sensor flanges are used to hold the lap joint flanges in place and to protect the PTFE liner during transportation. Consequently, do not remove these covers until immediately before the sensor is installed in the pipe.
- The covers must remain in place while the device is in storage.
- Make sure that the lining is not damaged or removed from the flanges.



Note!

Bolts, nuts, seals, etc. are not included in the scope of supply and must be supplied by the customer.

The sensor is designed for installation between the two piping flanges.

- Observe in any case the necessary screw tightening torques on → 25
- If grounding disks are used, follow the mounting instructions which will be enclosed with the shipment
- To comply with the device specification, a concentric installation in the measuring section is required

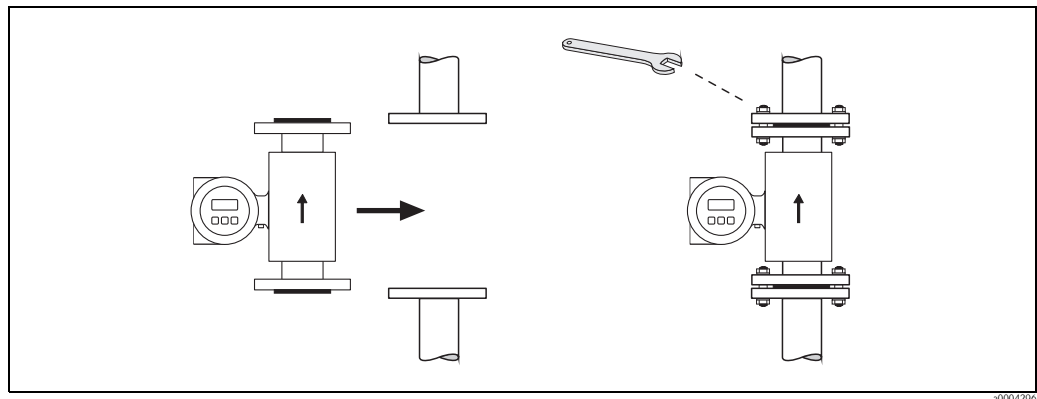


Fig. 18: Installing the Promag L sensor

Seals

Comply with the following instructions when installing seals:

- **No** seals are required.
- For DIN flanges, use only seals according to EN 1514-1.
- Make sure that the seals do not protrude into the piping cross-section.



Caution!

Risk of short circuit!

Do not use electrically conductive sealing compounds such as graphite! An electrically conductive layer could form on the inside of the measuring tube and short-circuit the measuring signal.

Ground cable

- If necessary, special ground cables for potential equalization can be ordered as an accessory (→ 77).
- Information on potential equalization and detailed mounting instructions for the use of ground cables can be found on → 55.

Screw tightening torques (Promag L)

Please note the following:

- The tightening torques listed below are for lubricated threads only.
- Always tighten the screws uniformly and in diagonally opposite sequence.
- Overtightening the screws will deform the sealing faces or damage the seals.
- The tightening torques listed below apply only to pipes not subjected to tensile stress.

Promag L tightening torques for EN (DIN)

Nominal diameter [mm]	EN (DIN) Pressure rating [bar]	Threaded fasteners	Max. tightening torque	
			Polyurethan [Nm]	PTFE [Nm]
50	PN 10/16	4 × M 16	15	40
65*	PN 10/16	8 × M 16	10	22
80	PN 10/16	8 × M 16	15	30
100	PN 10/16	8 × M 16	20	42
125	PN 10/16	8 × M 16	30	55
150	PN 10/16	8 × M 20	50	90
200	PN 10	8 × M 20	65	130
250	PN 10	12 × M 20	50	90
300	PN 10	12 × M 20	55	100
* Designed acc. to EN 1092-1 (not to DIN 2501)				

Promag L tightening torques for ANSI

Nominal diameter		ANSI Pressure rating [lbs]	Threaded fasteners	Max. tightening torque			
[mm]	[inch]			Polyurethane		PTFE	
				[Nm]	[lbf · ft]	[Nm]	[lbf · ft]
50	2"	Class 150	4 × 5/8"	15	11	40	29
80	3"	Class 150	4 × 5/8"	25	18	65	48
100	4"	Class 150	8 × 5/8"	20	15	44	32
150	6"	Class 150	8 × 3/4"	45	33	90	66
200	8"	Class 150	8 × 3/4"	65	48	125	92
250	10"	Class 150	12 × 7/8"	55	41	100	74
300	12"	Class 150	12 × 7/8"	68	56	115	85

3.3.3 Installing the Promag W sensor



Note!

Bolts, nuts, seals, etc. are not included in the scope of supply and must be supplied by the customer.

The sensor is designed for installation between the two piping flanges.

- Observe in any case the necessary screw tightening torques on → 26
- If grounding disks are used, follow the mounting instructions which will be enclosed with the shipment

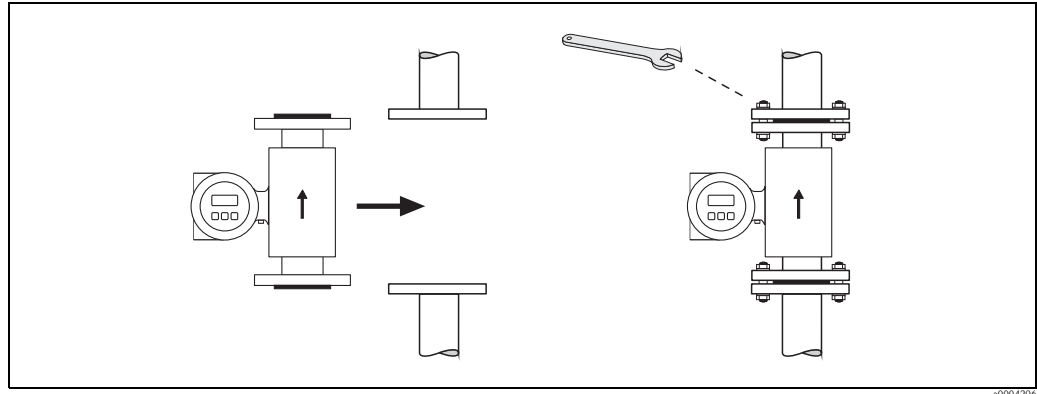


Fig. 19: Installing the Promag W sensor

Seals

Comply with the following instructions when installing seals:

- Hard rubber lining → additional seals are **always** necessary.
- Polyurethane lining → **no** seals are required.
- For DIN flanges, use only seals according to EN 1514-1.
- Make sure that the seals do not protrude into the piping cross-section.



Caution!

Risk of short circuit!

Do not use electrically conductive sealing compounds such as graphite! An electrically conductive layer could form on the inside of the measuring tube and short-circuit the measuring signal.

Ground cable

- If necessary, special ground cables for potential equalization can be ordered as an accessory (→ 77).
- Information on potential equalization and detailed mounting instructions for the use of ground cables can be found on → 55

Screw tightening torques (Promag W)

Please note the following:

- The tightening torques listed below are for lubricated threads only.
- Always tighten the screws uniformly and in diagonally opposite sequence.
- Overtightening the screws will deform the sealing faces or damage the seals.
- The tightening torques listed below apply only to pipes not subjected to tensile stress.

Tightening torques for:

- EN (DIN) → 27
- JIS → 29
- ANSI → 28
- AWWA → 29
- AS 2129 → 30
- AS 4087 → 30

Promag W tightening torques for EN (DIN)

Nominal diameter [mm]	EN (DIN)	Threaded fasteners	Max. tightening torque [Nm]	
	Pressure rating [bar]		Hard rubber	Polyurethane
25	PN 40	4 × M 12	-	15
32	PN 40	4 × M 16	-	24
40	PN 40	4 × M 16	-	31
50	PN 40	4 × M 16	-	40
65*	PN 16	8 × M 16	32	27
65	PN 40	8 × M 16	32	27
80	PN 16	8 × M 16	40	34
80	PN 40	8 × M 16	40	34
100	PN 16	8 × M 16	43	36
100	PN 40	8 × M 20	59	50
125	PN 16	8 × M 16	56	48
125	PN 40	8 × M 24	83	71
150	PN 16	8 × M 20	74	63
150	PN 40	8 × M 24	104	88
200	PN 10	8 × M 20	106	91
200	PN 16	12 × M 20	70	61
200	PN 25	12 × M 24	104	92
250	PN 10	12 × M 20	82	71
250	PN 16	12 × M 24	98	85
250	PN 25	12 × M 27	150	134
300	PN 10	12 × M 20	94	81
300	PN 16	12 × M 24	134	118
300	PN 25	16 × M 27	153	138
350	PN 6	12 × M 20	111	120
350	PN 10	16 × M 20	112	118
350	PN 16	16 × M 24	152	165
350	PN 25	16 × M 30	227	252
400	PN 6	16 × M 20	90	98
400	PN 10	16 × M 24	151	167
400	PN 16	16 × M 27	193	215
400	PN 25	16 × M 33	289	326
450	PN 6	16 × M 20	112	126
450	PN 10	20 × M 24	153	133
450	PN 16	20 × M 27	198	196
450	PN 25	20 × M 33	256	253
500	PN 6	20 × M 20	119	123
500	PN 10	20 × M 24	155	171
500	PN 16	20 × M 30	275	300
500	PN 25	20 × M 33	317	360
600	PN 6	20 × M 24	139	147
600	PN 10	20 × M 27	206	219
600 *	PN 16	20 × M 33	415	443
600	PN 25	20 × M 36	431	516
700	PN 6	24 × M 24	148	139
700	PN 10	24 × M 27	246	246
700	PN 16	24 × M 33	278	318

Nominal diameter [mm]	EN (DIN) Pressure rating [bar]	Threaded fasteners	Max. tightening torque [Nm]	
			Hard rubber	Polyurethane
700	PN 25	24 × M 39	449	507
800	PN 6	24 × M 27	206	182
800	PN 10	24 × M 30	331	316
800	PN 16	24 × M 36	369	385
800	PN 25	24 × M 45	664	721
900	PN 6	24 × M 27	230	637
900	PN 10	28 × M 30	316	307
900	PN 16	28 × M 36	353	398
900	PN 25	28 × M 45	690	716
1000	PN 6	28 × M 27	218	208
1000	PN 10	28 × M 33	402	405
1000	PN 16	28 × M 39	502	518
1000	PN 25	28 × M 52	970	971
1200	PN 6	32 × M 30	319	299
1200	PN 10	32 × M 36	564	568
1200	PN 16	32 × M 45	701	753
1400	PN 6	36 × M 33	430	398
1400	PN 10	36 × M 39	654	618
1400	PN 16	36 × M 45	729	762
1600	PN 6	40 × M 33	440	417
1600	PN 10	40 × M 45	946	893
1600	PN 16	40 × M 52	1007	1100
1800	PN 6	44 × M 36	547	521
1800	PN 10	44 × M 45	961	895
1800	PN 16	44 × M 52	1108	1003
2000	PN 6	48 × M 39	629	605
2000	PN 10	48 × M 45	1047	1092
2000	PN 16	48 × M 56	1324	1261
* Designed acc. to EN 1092-1 (not to DIN 2501)				

Promag W tightening torques for ANSI

Nominal diameter		ANSI Pressure rating [lbs]	Threaded fasteners	Max. tightening torque			
				Hard rubber		Polyurethane	
[mm]	[inch]			[Nm]	[lbf · ft]	[Nm]	[lbf · ft]
25	1"	Class 150	4 × ½"	–	–	7	5
25	1"	Class 300	4 × 5/8"	–	–	8	6
40	1 ½"	Class 150	4 × ½"	–	–	10	7
40	1 ½"	Class 300	4 × ¾"	–	–	15	11
50	2"	Class 150	4 × 5/8"	–	–	22	16
50	2"	Class 300	8 × 5/8"	–	–	11	8
80	3"	Class 150	4 × 5/8"	60	44	43	32
80	3"	Class 300	8 × ¾"	38	28	26	19
100	4"	Class 150	8 × 5/8"	42	31	31	23
100	4"	Class 300	8 × ¾"	58	43	40	30
150	6"	Class 150	8 × ¾"	79	58	59	44
150	6"	Class 300	12 × ¾"	70	52	51	38
200	8"	Class 150	8 × ¾"	107	79	80	59
250	10"	Class 150	12 × 7/8"	101	74	75	55
300	12"	Class 150	12 × 7/8"	133	98	103	76
350	14"	Class 150	12 × 1"	135	100	158	117
400	16"	Class 150	16 × 1"	128	94	150	111
450	18"	Class 150	16 × 1 1/8"	204	150	234	173
500	20"	Class 150	20 × 1 1/8"	183	135	217	160
600	24"	Class 150	20 × 1 ¼"	268	198	307	226

Promag W tightening torques for JIS

Nominal diameter [mm]	JIS Pressure rating	Threaded fasteners	Max. tightening torque [Nm]	
			Hard rubber	Polyurethane
25	10K	4 × M 16	–	19
25	20K	4 × M 16	–	19
32	10K	4 × M 16	–	22
32	20K	4 × M 16	–	22
40	10K	4 × M 16	–	24
40	20K	4 × M 16	–	24
50	10K	4 × M 16	–	33
50	20K	8 × M 16	–	17
65	10K	4 × M 16	55	45
65	20K	8 × M 16	28	23
80	10K	8 × M 16	29	23
80	20K	8 × M 20	42	35
100	10K	8 × M 16	35	29
100	20K	8 × M 20	56	48
125	10K	8 × M 20	60	51
125	20K	8 × M 22	91	79
150	10K	8 × M 20	75	63
150	20K	12 × M 22	81	72
200	10K	12 × M 20	61	52
200	20K	12 × M 22	91	80
250	10K	12 × M 22	100	87
250	20K	12 × M 24	159	144
300	10K	16 × M 22	74	63
300	20K	16 × M 24	138	124

Promag W tightening torques for AWWA

Nominal diameter		AWWA Pressure rating	Threaded fasteners	Max. tightening torque			
				Hard rubber		Polyurethane	
[mm]	[inch]			[Nm]	[lbf · ft]	[Nm]	[lbf · ft]
700	28"	Class D	28 × 1 ¼"	247	182	292	215
750	30"	Class D	28 × 1 ¼"	287	212	302	223
800	32"	Class D	28 × 1 ½"	394	291	422	311
900	36"	Class D	32 × 1 ½"	419	309	430	317
1000	40"	Class D	36 × 1 ½"	420	310	477	352
1050	42"	Class D	36 × 1 ½"	528	389	518	382
1200	48"	Class D	44 × 1 ½"	552	407	531	392
1350	54"	Class D	44 × 1 ¾"	730	538	633	467
1500	60"	Class D	52 × 1 ¾"	758	559	832	614
1650	66"	Class D	52 × 1 ¾"	946	698	955	704
1800	72"	Class D	60 × 1 ¾"	975	719	1087	802
2000	78"	Class D	64 × 2"	853	629	786	580

Promag W tightening torques for AS 2129

Nominal diameter [mm]	AS 2129 Pressure rating	Threaded fasteners	Max. tightening torque [Nm] Hard rubber
80	Table E	4 × M 16	49
100	Table E	8 × M 16	38
150	Table E	8 × M 20	64
200	Table E	8 × M 20	96
250	Table E	12 × M 20	98
300	Table E	12 × M 24	123
350	Table E	12 × M 24	203
400	Table E	12 × M 24	226
450	Table E	16 × M 24	226
500	Table E	16 × M 24	271
600	Table E	16 × M 30	439
700	Table E	20 × M 30	355
750	Table E	20 × M 30	559
800	Table E	20 × M 30	631
900	Table E	24 × M 30	627
1000	Table E	24 × M 30	634
1200	Table E	32 × M 30	727

Promag W tightening torques for AS 4087

Nominal diameter [mm]	AS 4087 Pressure rating	Threaded fasteners	Max. tightening torque [Nm] Hard rubber
80	PN 16	4 × M 16	49
100	PN 16	4 × M 16	76
150	PN 16	8 × M 20	52
200	PN 16	8 × M 20	77
250	PN 16	8 × M 20	147
300	PN 16	12 × M 24	103
350	PN 16	12 × M 24	203
375	PN 16	12 × M 24	137
400	PN 16	12 × M 24	226
450	PN 16	12 × M 24	301
500	PN 16	16 × M 24	271
600	PN 16	16 × M 27	393
700	PN 16	20 × M 27	330
750	PN 16	20 × M 30	529
800	PN 16	20 × M 33	631
900	PN 16	24 × M 33	627
1000	PN 16	24 × M 33	595
1200	PN 16	32 × M 33	703

3.3.4 Installing the Promag P sensor



Caution!

- The protective covers mounted on the two sensor flanges guard the PTFE, which is turned over the flanges. Consequently, do not remove these covers until **immediately before** the sensor is installed in the pipe.
- The covers must remain in place while the device is in storage.
- Make sure that the lining is not damaged or removed from the flanges.



Note!

Bolts, nuts, seals, etc. are not included in the scope of supply and must be supplied by the customer.

The sensor is designed for installation between the two piping flanges.

- Observe in any case the necessary screw tightening torques on → 32
- If grounding disks are used, follow the mounting instructions which will be enclosed with the shipment

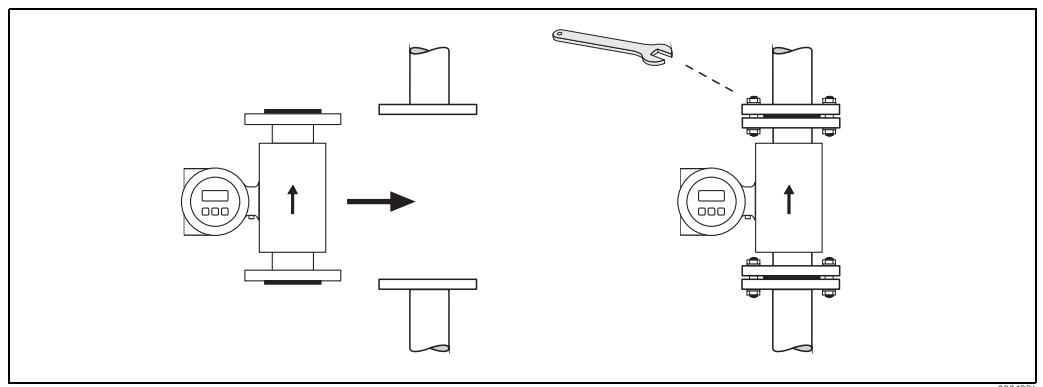


Fig. 20: Installing the Promag P sensor

Seals

Comply with the following instructions when installing seals:

- PFA or PTFE lining → **No** seals are required!
- For DIN flanges, use only seals according to EN 1514-1.
- Make sure that the seals do not protrude into the piping cross-section.



Caution!

Risk of short circuit! Do not use electrically conductive sealing compounds such as graphite! An electrically conductive layer could form on the inside of the measuring tube and short-circuit the measuring signal.

Ground cable

- If necessary, special ground cables for potential equalization can be ordered as an accessory (→ 77).
- Information on potential equalization and detailed mounting instructions for the use of ground cables can be found on → 55

Installing the high-temperature version (with PFA lining)

The high-temperature version has a housing support for the thermal separation of sensor and transmitter. The high-temperature version is always used for applications in which high ambient temperatures are encountered **in conjunction with** high fluid temperatures. The high-temperature version is obligatory if the fluid temperature exceeds $+150\text{ }^{\circ}\text{C}$.



Note!

You will find information on permissible temperature ranges on → [102](#)

Insulation

Pipes generally have to be insulated if they carry very hot fluids, in order to avoid energy losses and to prevent accidental contact with pipes at temperatures that could cause injury. Guidelines regulating the insulation of pipes have to be taken into account.



Caution!

Risk of measuring electronics overheating. The housing support dissipates heat and its entire surface area must remain uncovered. Make sure that the sensor insulation does not extend past the top of the two sensor shells.

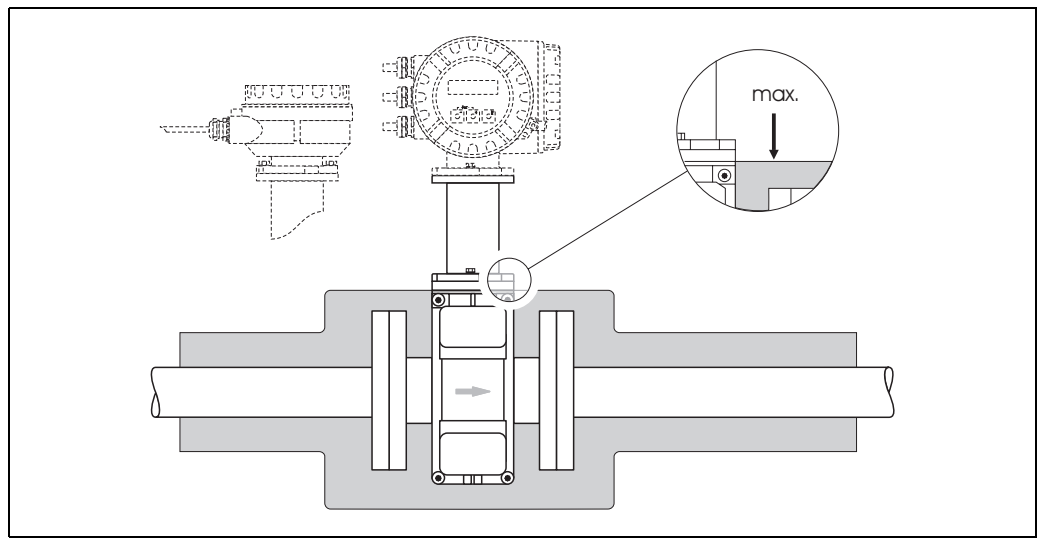


Fig. 21: Promag P (high-temperature version): Insulating the pipe

Tightening torques for threaded fasteners (Promag P)

Please note the following:

- The tightening torques listed below are for lubricated threads only.
- Always tighten the screws uniformly and in diagonally opposite sequence.
- Overtightening the screws will deform the sealing faces or damage the seals.
- The tightening torques listed below apply only to pipes not subjected to tensile stress.

Tightening torques for:

- EN (DIN) → [33](#)
- ANSI → [34](#)
- JIS → [34](#)
- AS 2129 → [35](#)
- AS 4087 → [35](#)

Promag P tightening torques for EN (DIN)

Nominal diameter [mm]	EN (DIN) Pressure rating [bar]	Threaded fasteners	Max. tightening torque [Nm]	
			PTFE	PFA
15	PN 40	4 × M 12	11	–
25	PN 40	4 × M 12	26	20
32	PN 40	4 × M 16	41	35
40	PN 40	4 × M 16	52	47
50	PN 40	4 × M 16	65	59
65 *	PN 16	8 × M 16	43	40
65	PN 40	8 × M 16	43	40
80	PN 16	8 × M 16	53	48
80	PN 40	8 × M 16	53	48
100	PN 16	8 × M 16	57	51
100	PN 40	8 × M 20	78	70
125	PN 16	8 × M 16	75	67
125	PN 40	8 × M 24	111	99
150	PN 16	8 × M 20	99	85
150	PN 40	8 × M 24	136	120
200	PN 10	8 × M 20	141	101
200	PN 16	12 × M 20	94	67
200	PN 25	12 × M 24	138	105
250	PN 10	12 × M 20	110	–
250	PN 16	12 × M 24	131	–
250	PN 25	12 × M 27	200	–
300	PN 10	12 × M 20	125	–
300	PN 16	12 × M 24	179	–
300	PN 25	16 × M 27	204	–
350	PN 10	16 × M 20	188	–
350	PN 16	16 × M 24	254	–
350	PN 25	16 × M 30	380	–
400	PN 10	16 × M 24	260	–
400	PN 16	16 × M 27	330	–
400	PN 25	16 × M 33	488	–
450	PN 10	20 × M 24	235	–
450	PN 16	20 × M 27	300	–
450	PN 25	20 × M 33	385	–
500	PN 10	20 × M 24	265	–
500	PN 16	20 × M 30	448	–
500	PN 25	20 × M 33	533	–
600	PN 10	20 × M 27	345	–
600 *	PN 16	20 × M 33	658	–
600	PN 25	20 × M 36	731	–
* Designed acc. to EN 1092-1 (not to DIN 2501)				

Promag P tightening torques for ANSI

Nominal diameter		ANSI Pressure rating [lbs]	Threaded fasteners	Max. tightening torque			
[mm]	[inch]			PTFE [Nm]	[lbf · ft]	PFA [Nm]	[lbf · ft]
15	½"	Class 150	4 × ½"	6	4	–	–
15	½"	Class 300	4 × ½"	6	4	–	–
25	1"	Class 150	4 × ½"	11	8	10	7
25	1"	Class 300	4 × 5/8"	14	10	12	9
40	1 ½"	Class 150	4 × ½"	24	18	21	15
40	1 ½"	Class 300	4 × ¾"	34	25	31	23
50	2"	Class 150	4 × 5/8"	47	35	44	32
50	2"	Class 300	8 × 5/8"	23	17	22	16
80	3"	Class 150	4 × 5/8"	79	58	67	49
80	3"	Class 300	8 × ¾"	47	35	42	31
100	4"	Class 150	8 × 5/8"	56	41	50	37
100	4"	Class 300	8 × ¾"	67	49	59	44
150	6"	Class 150	8 × ¾"	106	78	86	63
150	6"	Class 300	12 × ¾"	73	54	67	49
200	8"	Class 150	8 × ¾"	143	105	109	80
250	10"	Class 150	12 × 7/8"	135	100	–	–
300	12"	Class 150	12 × 7/8"	178	131	–	–
350	14"	Class 150	12 × 1"	260	192	–	–
400	16"	Class 150	16 × 1"	246	181	–	–
450	18"	Class 150	16 × 1 1/8"	371	274	–	–
500	20"	Class 150	20 × 1 1/8"	341	252	–	–
600	24"	Class 150	20 × 1 ¼"	477	352	–	–

Promag P tightening torques for JIS

Nominal diameter [mm]	JIS Pressure rating	Threaded fasteners	Max. tightening torque [Nm]	
			PTFE	PFA
25	10K	4 × M 16	32	27
25	20K	4 × M 16	32	27
32	10K	4 × M 16	38	–
32	20K	4 × M 16	38	–
40	10K	4 × M 16	41	37
40	20K	4 × M 16	41	37
50	10K	4 × M 16	54	46
50	20K	8 × M 16	27	23
65	10K	4 × M 16	74	63
65	20K	8 × M 16	37	31
80	10K	8 × M 16	38	32
80	20K	8 × M 20	57	46
100	10K	8 × M 16	47	38
100	20K	8 × M 20	75	58
125	10K	8 × M 20	80	66
125	20K	8 × M 22	121	103
150	10K	8 × M 20	99	81
150	20K	12 × M 22	108	72
200	10K	12 × M 20	82	54
200	20K	12 × M 22	121	88
250	10K	12 × M 22	133	–
250	20K	12 × M 24	212	–
300	10K	16 × M 22	99	–
300	20K	16 × M 24	183	–

Promag P tightening torques for AS 2129

Nominal diameter [mm]	AS 2129 Pressure rating	Threaded fasteners	Max. tightening torque [Nm] PTFE
25	Table E	4 × M 12	21
50	Table E	4 × M 16	42

Promag P tightening torques for AS 4087

Nominal diameter [mm]	AS 4087 Pressure rating	Threaded fasteners	Max. tightening torque [Nm] PTFE
50	PN 16	4 × M 16	42

3.3.5 Installing the Promag H sensor

The sensor is supplied to order, with or without pre-installed process connections. Pre-installed process connections are secured to the sensor with 4 or 6 hex-head threaded fasteners.



Caution!

The sensor might require support or additional attachments, depending on the application and the length of the piping run. When plastic process connections are used, the sensor must be additionally supported mechanically. A wall-mounting kit can be ordered separately from Endress+Hauser as an accessory (→ 77).

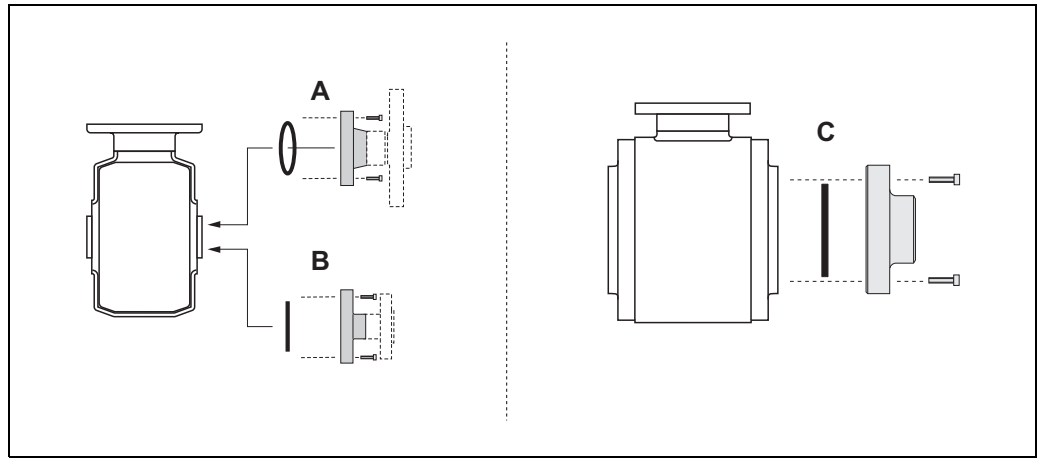


Abb. 22: Promag H process connections (DN 2...25 / DN 40...100, 1/12"...1" / DN 1½"...4")

A = DN 2...25, 1/12"...1" / process connections with O-ring

- welding flanges (DIN EN ISO 1127, ODT / SMS),
- flange (EN (DIN), ANSI, JIS), flange PVDF (EN (DIN), ANSI, JIS)
- external and internal thread, hose connection, PVC adhesive fitting

B = DN 2...25, 1/12"...1" / process connections with aseptic gasket vseat

- weld nipples (DIN 11850, ODT/SMS)
- Clamp (ISO 2852, DIN 32676, L14 AM7)
- coupling (DIN 11851, DIN 11864-1, SMS 1145)
- flange DIN 11864-2

C = DN 40...100, 1½"...4" / process connections with aseptic gasket seal

- weld nipples (DIN 11850, ODT/SMS)
- Clamp (ISO 2852, DIN 32676, L14 AM7)
- coupling (DIN 11851, DIN 11864-1, ISO 2853, SMS 1145)
- flange DIN 11864-2

Seals

When installing the process connections, make sure that the seals are clean and correctly centered.



Caution!

- With metal process connections, you must fully tighten the screws. The process connection forms a metallic connection with the sensor, which ensures a defined compression of the seal.
- With plastic process connections, note the max. torques for lubricated threads (7 Nm / 5.2 lbf ft). With plastic flanges, always use seals between connection and counter flange.
- The seals must be replaced periodically, depending on the application, particularly in the case of gasket seals (aseptic version)!

The period between changes depends on the frequency of cleaning cycles, the cleaning temperature and the fluid temperature. Replacement seals can be ordered as accessories → 77.

Usage and assembly of ground rings (DN 2 to 25, 1/12" to 1")

In case the process connections are made of plastic (e.g. flanges or adhesive fittings), the potential between the sensor and the fluid must be equalized using additional ground rings.

If the ground rings are not installed this can affect the accuracy of the measurements or cause the destruction of the sensor through the electrochemical erosion of the electrodes.



Caution!

- Depending on the option ordered, plastic disks may be installed at the process connections instead of ground rings. These plastic disks serve only as spacers and have no potential equalization function. In addition, they provide a sealing function at the interface between the sensor and process connection. For this reason, with process connections without ground rings, these plastic disks/seals must not be removed, or must always be installed.
- Ground rings can be ordered separately from Endress+Hauser as accessories (→ 77). When placing the order, make certain that the ground ring is compatible with the material used for the electrodes. Otherwise, there is a risk that the electrodes may be destroyed by electrochemical corrosion! Information about the materials can be found on → 112.
- Ground rings, including the seals, are mounted within the process connections. Therefore, the fitting length is not affected.

1. Loosen the four or six hexagonal headed bolts (1) and remove the process connection from the sensor (4).
2. Remove the plastic disk (3), including the two O-ring seals (2).
3. Place one seal (2) in the groove of the process connection.
4. Place the metal ground ring (3) on the process connection.
5. Now place the second seal (2) in the groove of the ground ring.
6. Finally, mount the process connection on the sensor again.
With plastic process connections, note the max. torques for lubricated threads (7 Nm / 5.2 lbf ft).

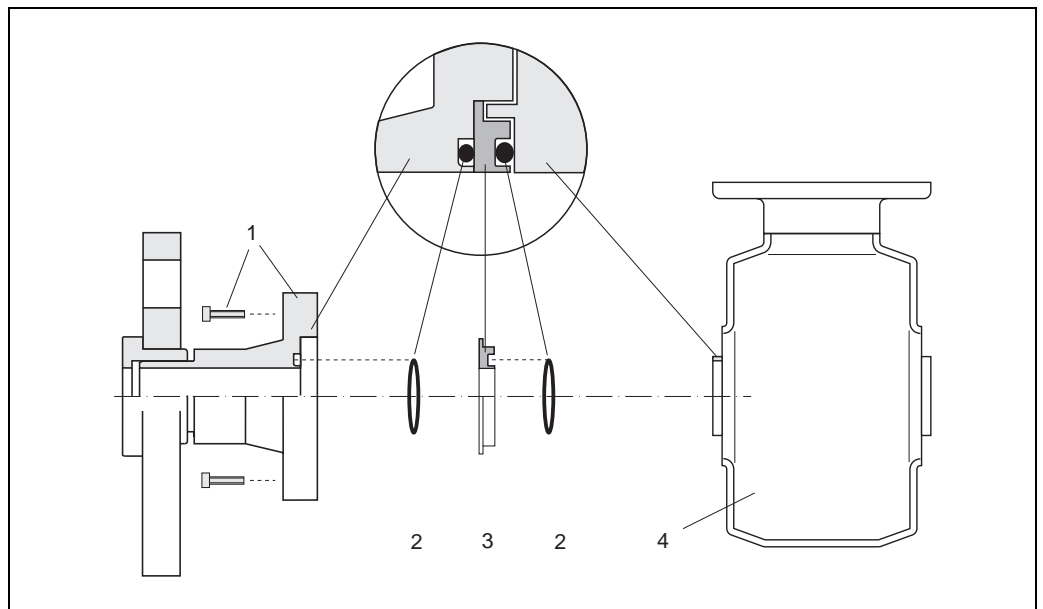


Fig. 23: Installing ground rings with Promag H (DN 2 to 25, 1/12" to 1")

1 = Hexagonal-headed bolt (process connection)


2 = O-ring seals

3 = Ground ring or plastic disk (spacer)

4 = Sensor

Welding the transmitter into the piping (weld nipples)**Caution!**


Risk of destroying the measuring electronics. Make sure that the welding machine is *not* grounded via the sensor or the transmitter.

1. Tack-weld the sensor into the pipe. A suitable welding jig can be ordered separately as an accessory (→  77).
2. Loosen the screws on the process connection flange and remove the sensor, complete with the seal, from the pipe.
3. Weld the process connection to the pipe.
4. Reinstall the sensor in the pipe. Make sure that everything is clean and that the seal is correctly seated.

**Note!**

- If thin-walled foodstuffs pipes are not welded correctly, the heat could damage the installed seal. It is therefore advisable to remove the sensor and the seal prior to welding.
- The pipe has to be spread approximately 8 mm to permit disassembly.

Cleaning with pigs

If pigs are used for cleaning, it is essential to take the inside diameters of the measuring tube and process connection into account. All the dimensions and lengths of the sensor and transmitter are provided in the separate documentation "Technical Documentation" →  116.

3.3.6 Turning the transmitter housing

Turning the aluminum field housing



Warning!

The turning mechanism in devices with Ex d/de or FM/CSA Cl. I Div. 1 classification is not the same as that described here. The procedure for turning these housings is described in the Ex-specific documentation.

1. Loosen the two securing screws.
2. Turn the bayonet catch as far as it will go.
3. Carefully lift the transmitter housing:
 - Promag D: approx. 10 mm (0.39 inch) above the securing screws
 - Promag L, W, P, H: to the stop
4. Turn the transmitter housing to the desired position:
 - Promag D: max. 180° clockwise or max. 180° counterclockwise
 - Promag L, W, P, H: max. 280° clockwise or max. 20° counterclockwise
5. Lower the housing into position and re-engage the bayonet catch.
6. Retighten the two securing screws.

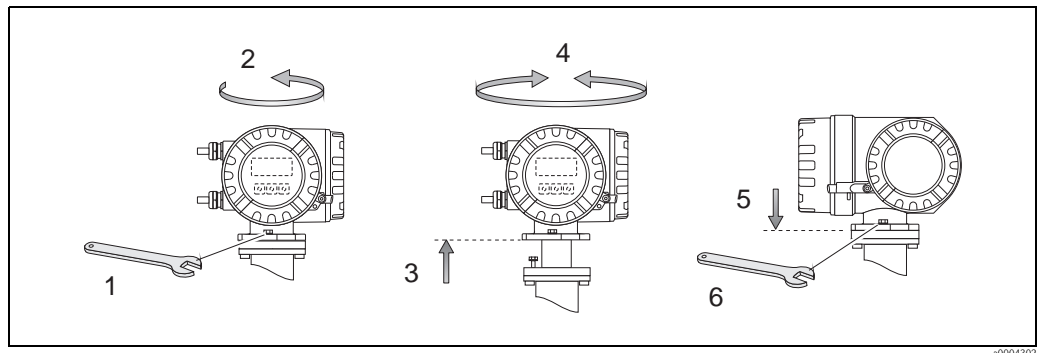


Fig. 24: Turning the transmitter housing (aluminum field housing)

Turning the stainless-steel field housing

1. Loosen the two securing screws.
2. Carefully lift the transmitter housing as far as it will go.
3. Turn the transmitter housing to the desired position (max. $2 \times 90^\circ$ in either direction).
4. Lower the housing into position.
5. Retighten the two securing screws.

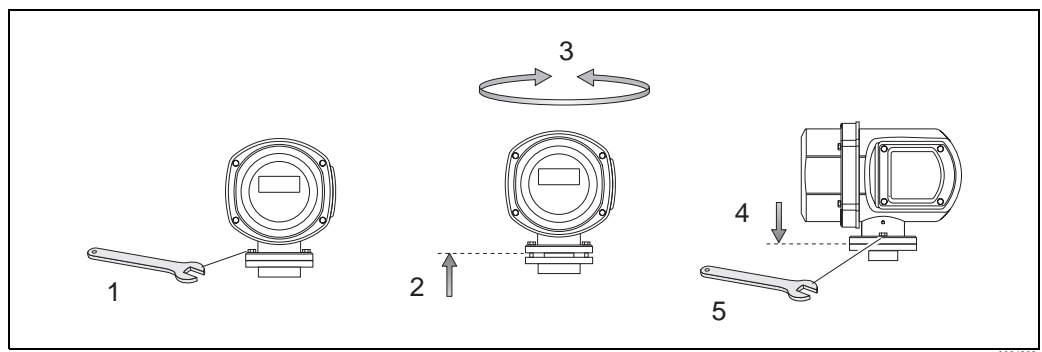


Fig. 25: Turning the transmitter housing (stainless-steel field housing)

3.3.7 Turning the onsite display

1. Unscrew the cover of the electronics compartment from the transmitter housing.
2. Press the side latches on the display module and remove it from the electronics compartment cover plate.
3. Turn the display to the desired position (max. $4 \times 45^\circ$ in both directions) and reset it onto the cover plate of the electronics compartment.
4. Screw the cover of the electronics compartment firmly back onto the transmitter housing.

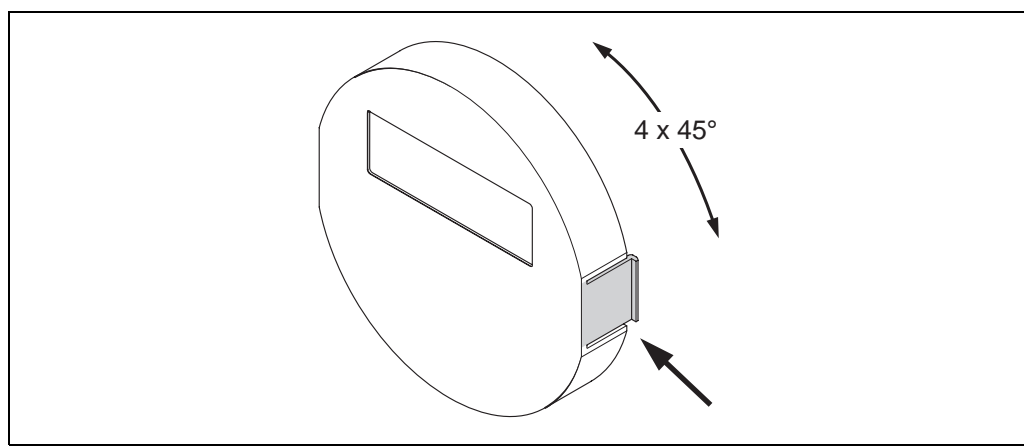


Fig. 26: Turning the local display (field housing)

3.3.8 Installing the wall-mount housing

There are various ways of installing the wall-mount transmitter housing:

- Direct wall mounting
- Installation in control panel (with separate mounting kit, accessories) → 42
- Pipe mounting (with separate mounting kit, accessories) → 42



Caution!

- Make sure that the ambient temperature does not exceed the permissible range at the mounting location, -20 to $+60$ °C (-4 to $+140$ °F), optional -40 to $+60$ °C (-40 to $+140$ °F). Install the device at a shady location. Avoid direct sunlight.
- Always install the wall-mount housing in such a way that the cable entries are pointing down.

Direct wall mounting

1. Drill the holes as illustrated in the graphic.
2. Remove the cover of the connection compartment (a).
3. Push the two securing screws (b) through the appropriate bores (c) in the housing.
 - Securing screws (M6): max. Ø 6.5 mm (0.26")
 - Screw head: max. Ø 10.5 mm (0.41")
4. Secure the transmitter housing to the wall as indicated.
5. Screw the cover of the connection compartment (a) firmly onto the housing.

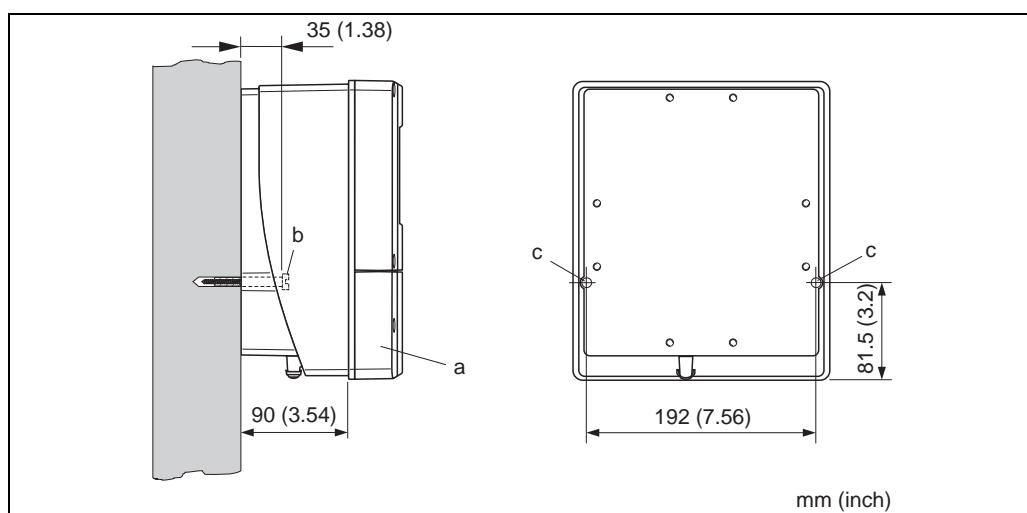


Fig. 27: Mounted directly on the wall

a0001130-ae

Panel-mounted installation

1. Prepare the opening in the panel as illustrated in the graphic.
2. Slide the housing into the opening in the panel from the front.
3. Screw the fasteners onto the wall-mount housing.
4. Place the threaded rods in the fasteners and screw them down until the housing is seated tightly against the panel. Afterwards, tighten the locking nuts. Additional support is not necessary.

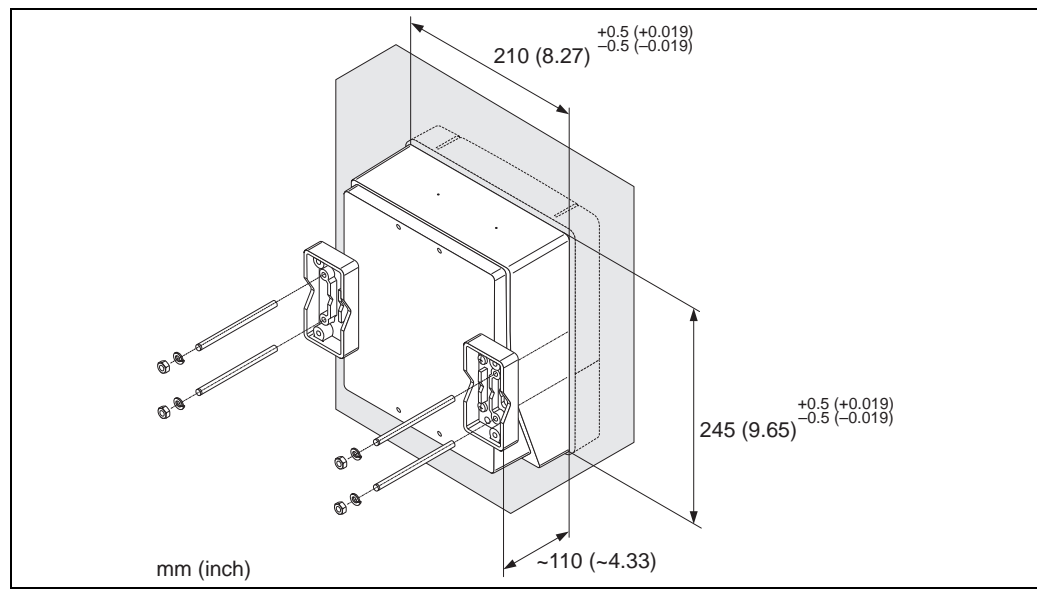


Fig. 28: Panel installation (wall-mount housing)

Pipe mounting

The assembly should be performed by following the instructions in the graphic.



Caution!

If the device is mounted to a warm pipe, make certain that the housing temperature does not exceed +60 °C (+140 °F), which is the maximum permissible temperature.

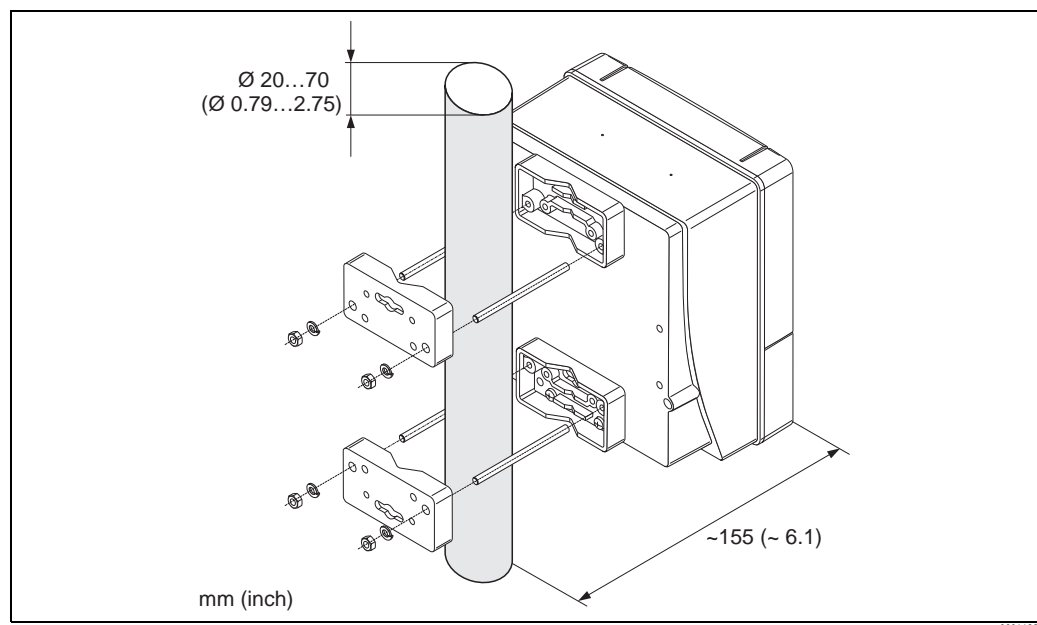


Fig. 29: Pipe mounting (wall-mount housing)

3.4 Post-installation check

Perform the following checks after installing the measuring device in the pipe:

Device condition and specifications	Notes
Is the device damaged (visual inspection)?	-
Does the device correspond to specifications at the measuring point, including process temperature and pressure, ambient temperature, minimum fluid conductivity, measuring range, etc.?	→ 100
Installation	Notes
Does the arrow on the sensor nameplate match the actual direction of flow through the pipe?	-
Is the position of the measuring electrode plane correct?	→ 15
Is the position of the empty pipe detection electrode correct?	→ 15
Were all screws tightened to the specified torques when the sensor was installed?	Promag D → 23 Promag L → 25 Promag W → 26 Promag P → 32
Were the correct seals used (type, material, installation)?	Promag D → 21 Promag L → 24 Promag W → 26 Promag P → 31 Promag H → 36
Are the measuring point number and labeling correct (visual inspection)?	-
Process environment / process conditions	Notes
Were the inlet and outlet runs respected?	Inlet run $\geq 5 \times \text{DN}$ Outlet run $\geq 2 \times \text{DN}$
Is the measuring device protected against moisture and direct sunlight?	-
Is the sensor adequately protected against vibration (attachment, support)?	Acceleration up to 2 g by analogy with IEC 600 68-2-8

4 Wiring



Warning!

When connecting Ex-certified devices, see the notes and diagrams in the Ex-specific supplement to these Operating Instructions.

Please do not hesitate to contact your Endress+Hauser representative if you have any questions.



Note!

The device does not have an internal circuit breaker. For this reason, assign the device a switch or power-breaker switch capable of disconnecting the power supply line from the mains.

4.1 Connecting the remote version

4.1.1 Connecting Promag D, L, W, P, H



Warning!

- Risk of electric shock! Switch off the power supply before opening the device. Do **not** install or wire the device while it is connected to the power supply. Failure to comply with this precaution can result in irreparable damage to the electronics.

- Risk of electric shock! Connect the protective conductor to the ground terminal on the housing before the power supply is applied.



Caution!

- Only sensors and transmitters with the same serial number can be connected to one another. Communication problems can occur if the devices are not connected in this way.

- Risk of damaging the coil driver. Always switch off the power supply before connecting or disconnecting the coil cable.

Procedure

1. Transmitter: Remove the cover from the connection compartment (a).
2. Sensor: Remove the cover from the connection housing (b).
3. Feed the signal cable (c) and the coil cable (d) through the appropriate cable entries.



Caution!

Route the connecting cables securely (see "Connecting cable length" → 44).

4. Terminate the signal and coil current cable as indicated in the table:

Promag D, L, W, P → Refer to the table → 47

Promag H → Refer to the "Cable termination" table → 48

5. Establish the wiring between the sensor and the transmitter.

The electrical wiring diagram that applies to your device can be found:

- In the corresponding graphic:

→ 30 (Promag D) → 31 (Promag L, W, P); → 32 (Promag H)

- In the cover of the sensor and transmitter



Note!

The cable shields of the Promag H sensor are grounded by means of the strain relief terminals (see also the "Cable termination" table → 48)



Caution!

Insulate the shields of cables that are not connected to eliminate the risk of short-circuits with neighboring cable shields inside the connection housing.

6. Transmitter: Screw the cover on the connection compartment (a).
7. Sensor: Secure the cover on the connection housing (b).

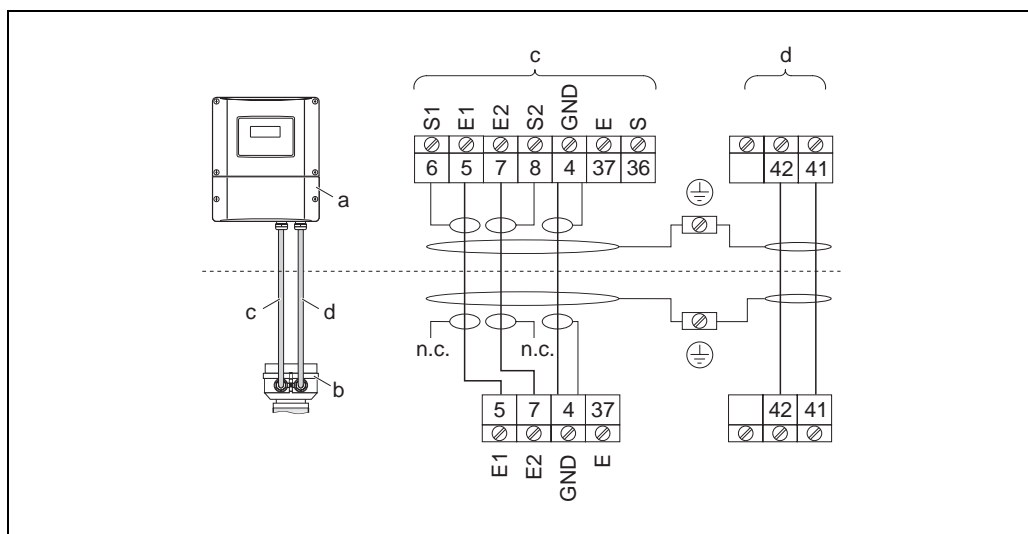
Promag D

Fig. 30: Connecting the remote version of Promag D

- a Wall-mount housing connection compartment
- b Cover of the sensor connection housing
- c Signal cable
- d Coil current cable
- n.c. Not connected, insulated cable shields

Wire colors/Terminal No.:

5/6 = braun, 7/8 = white, 4 = green, 37/36 = yellow

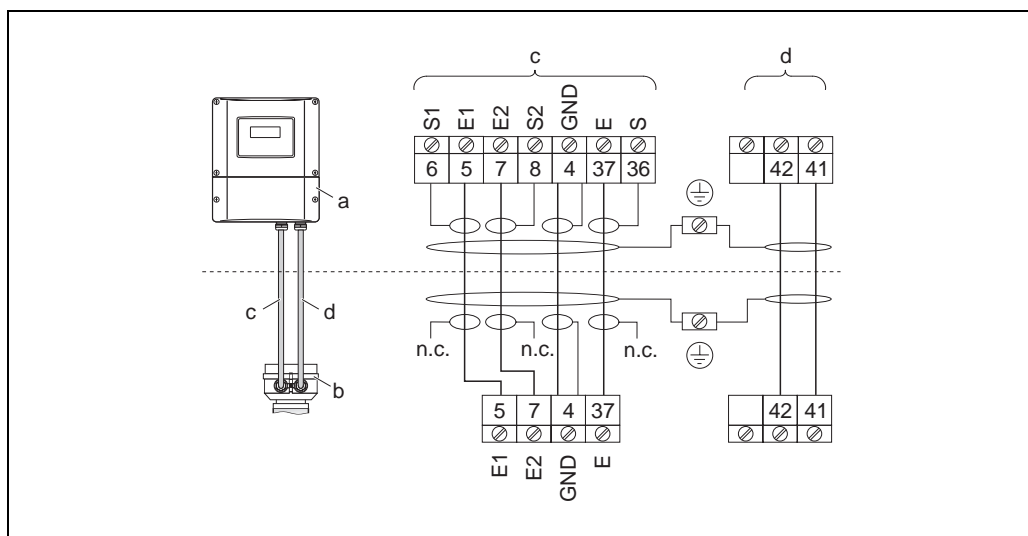
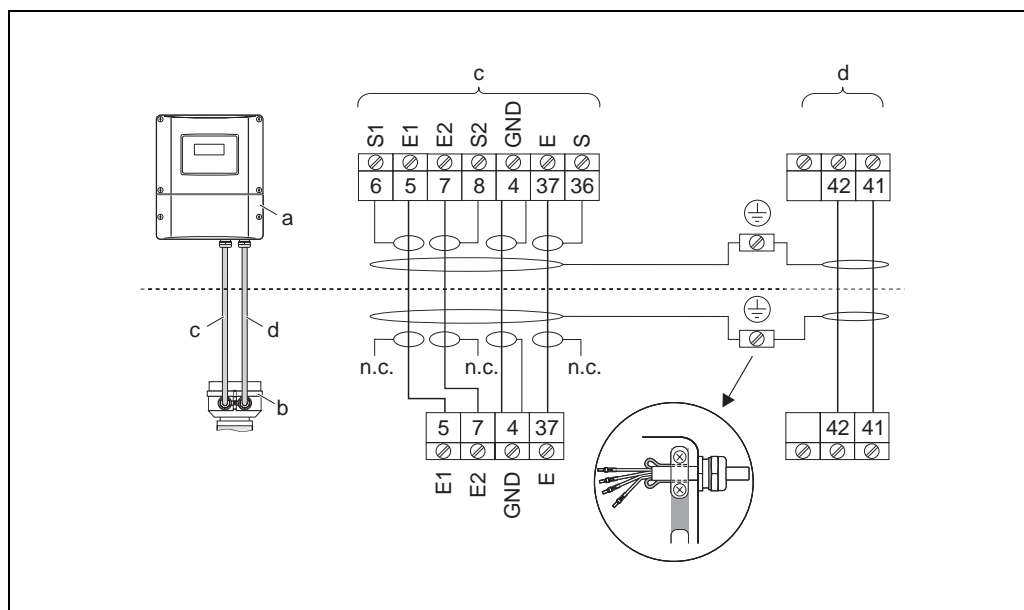
Promag L, W, P

Fig. 31: Connecting the remote version of Promag L, W, P

- a Wall-mount housing connection compartment
- b Cover of the sensor connection housing
- c Signal cable
- d Coil current cable
- n.c. Not connected, insulated cable shields

Wire colors/Terminal No.:

5/6 = braun, 7/8 = white, 4 = green, 37/36 = yellow

Promag H

A0011747

Fig. 32: Connecting the remote version of Promag H

- a Wall-mount housing connection compartment
- b Cover of the sensor connection housing
- c Signal cable
- d Coil current cable
- n.c. Not connected, insulated cable shields

Wire colors/Terminal No.:

5/6 = braun, 7/8 = white, 4 = green, 37/36 = yellow

Cable termination for the remote version Promag D / Promag L / Promag W / Promag P

Terminate the signal and coil current cables as shown in the figure below (Detail A).

Ferrules must be provided on the fine-wire cores (Detail B: ① = red ferrules, Ø 1.0 mm; ② = white ferrules, Ø 0.5 mm).

* Stripping only for reinforced cables

 Caution!


When fitting the connectors, pay attention to the following points:

- *Signal cable* → Make sure that the ferrules do not touch the wire shield on the sensor side.
Minimum distance = 1 mm (exception "GND" = green cable)
- *Coil current cable* → Insulate one core of the three-core wire at the level of the core reinforcement; you only require two cores for the connection.


TRANSMITTER

Signal cable

Coil current cable

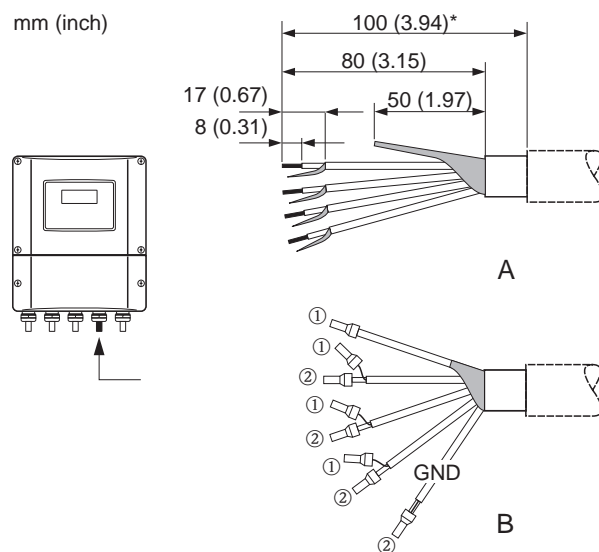

A0002687-ac

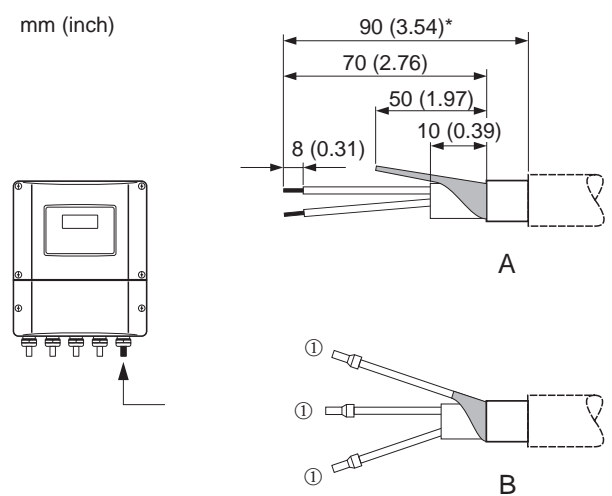


A0002688-ae


SENSOR

Signal cable

Coil current cable

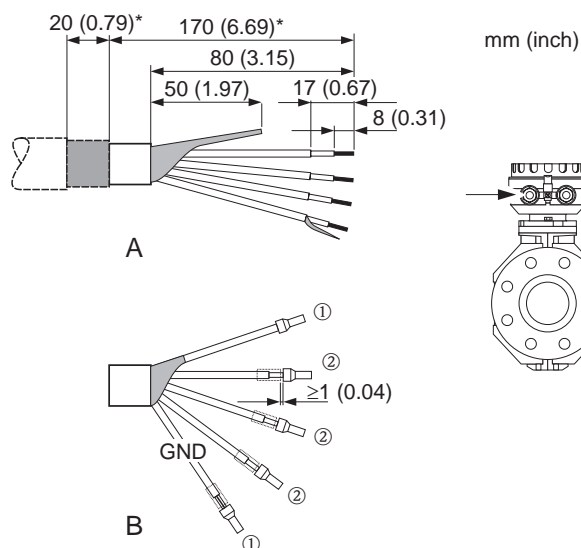

A000264-AE

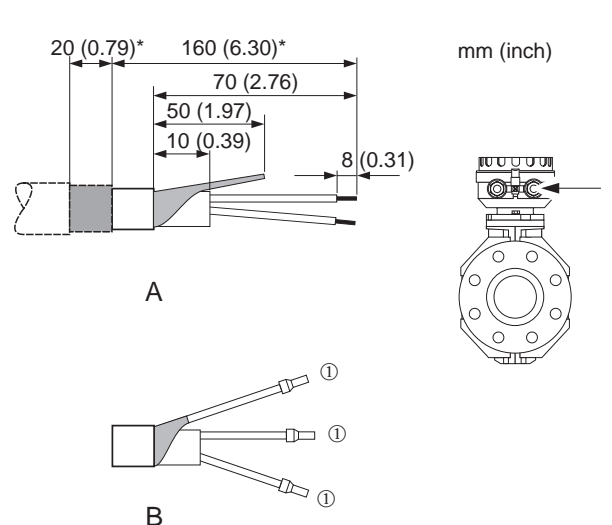

A0002650-2e

Cable termination for the remote version**Promag H**

Terminate the signal and coil current cables as shown in the figure below (Detail A).

Ferrules must be provided on the fine-wire cores (Detail B: ① = red ferrules, Ø 1.0 mm; ② = white ferrules, Ø 0.5 mm).


 **Caution!**

When fitting the connectors, pay attention to the following points:

- **Signal cable** → Make sure that the ferrules do not touch the wire shield on the sensor side.
Minimum distance = 1 mm (exception "GND" = green cable).
- **Coil current cable** → Insulate one core of the three-core wire at the level of the core reinforcement; you only require two cores for the connection.
- On the sensor side, reverse both cable shields approx. 15 mm over the outer jacket. The strain relief ensures an electrical connection with the connection housing.


TRANSMITTER

Signal cable

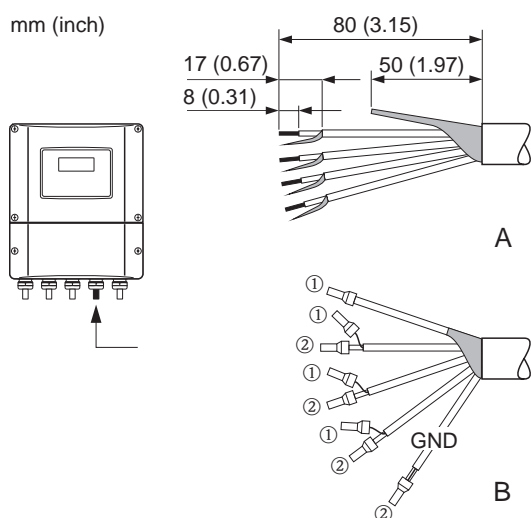

A0002680-ae


Coil current cable

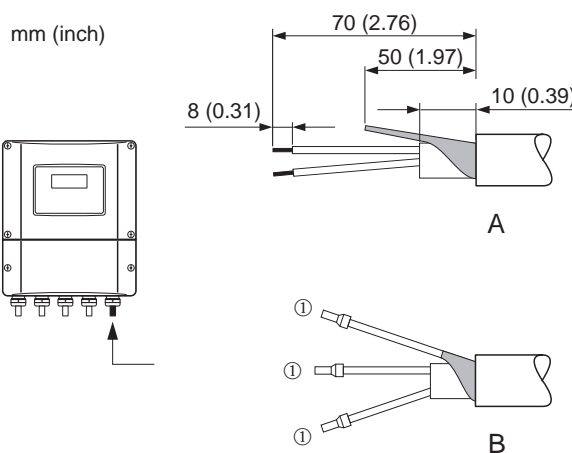

A0002684-ae


SENSOR

Signal cable

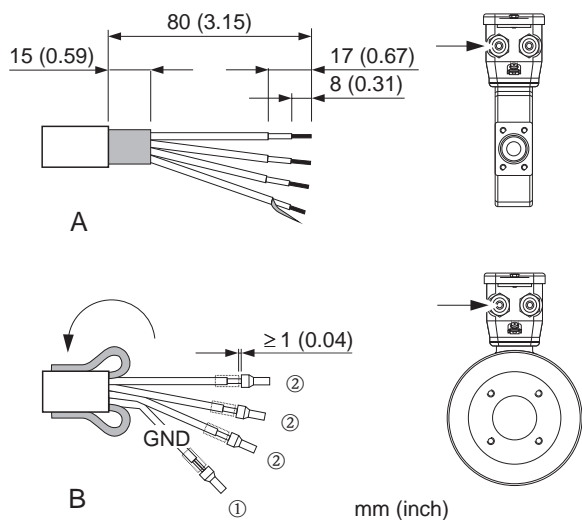

A0002647-ae

Coil current cable

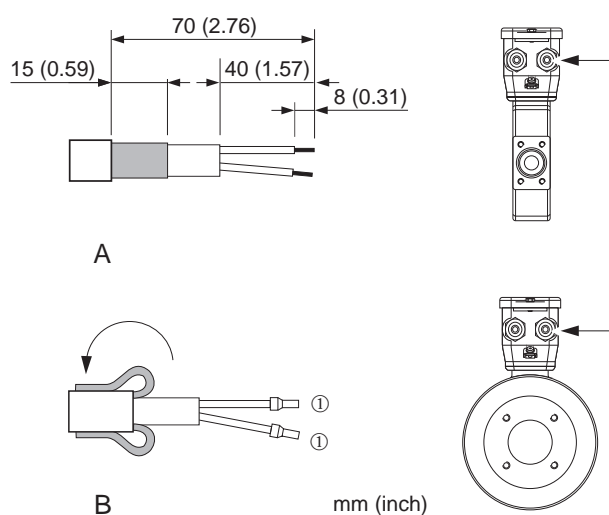

A0002648-ae

4.1.2 Cable specifications

Signal cable

- $3 \times 0.38 \text{ mm}^2$ PVC cable with common, braided copper shield ($\varnothing \sim 7 \text{ mm}$) and individually shielded cores
- With Empty Pipe Detection (EPD): $4 \times 0.38 \text{ mm}^2$ PVC cable with common, braided copper shield ($\varnothing \sim 7 \text{ mm}$) and individually shielded cores
- Conductor resistance: $\leq 50 \text{ } \Omega/\text{km}$
- Capacitance: core/shield: $\leq 420 \text{ pF/m}$
- Permanent operating temperature: -20 to $+80 \text{ } ^\circ\text{C}$
- Cable cross-section: max. 2.5 mm^2

Coil cable

- $2 \times 0.75 \text{ mm}^2$ PVC cable with common, braided copper shield ($\varnothing \sim 7 \text{ mm}$)
- Conductor resistance: $\leq 37 \text{ } \Omega/\text{km}$
- Capacitance: core/core, shield grounded: $\leq 120 \text{ pF/m}$
- Operating temperature: -20 to $+80 \text{ } ^\circ\text{C}$
- Cable cross-section: max. 2.5 mm^2
- Test voltage for cable insulation: $\geq 1433 \text{ V AC r.m.s. } 50/60 \text{ Hz}$ or $\geq 2026 \text{ V DC}$

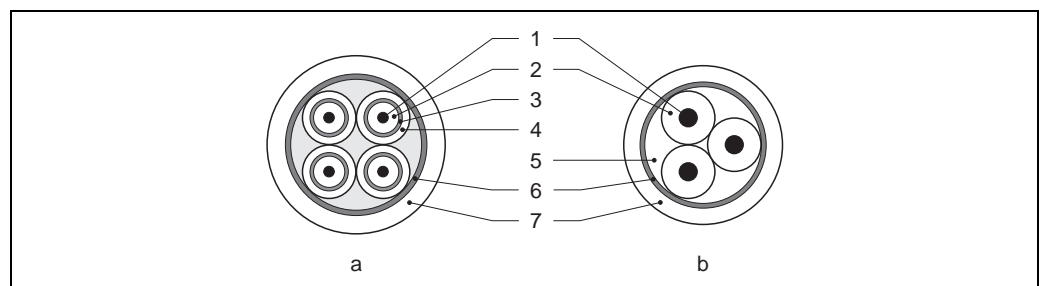


Fig. 33: Cable cross-section

- a Signal cable
- b Coil current cable
- 1 Core
- 2 Core insulation
- 3 Core shield
- 4 Core jacket
- 5 Core reinforcement
- 6 Cable shield
- 7 Outer jacket

Reinforced connecting cables

As an option, Endress+Hauser can also deliver reinforced connecting cables with an additional, reinforcing metal braid. Reinforced connecting cables should be used when laying the cable directly in the ground, if there is a risk of damage from rodents or if using the measuring device below IP 68 degree of protection.

Operation in zones of severe electrical interference:

The measuring device complies with the general safety requirements in accordance with EN 61010 and the EMC requirements of IEC/EN 61326.



Caution!

Grounding is by means of the ground terminals provided for the purpose inside the connection housing. Ensure that the stripped and twisted lengths of cable shield to the ground terminal are as short as possible.

4.2 Connecting the measuring unit

4.2.1 Connecting the transmitter



Warning!

- Risk of electric shock! Switch off the power supply before opening the device. Do not install or wire the device while it is energized. Failure to comply with this precaution can result in irreparable damage to the electronics.
- Risk of electric shock! Connect the protective conductor to the ground terminal on the housing before the power supply is applied (not necessary if the power supply is galvanically isolated).
- Compare the specifications on the nameplate with the local voltage supply and frequency. Also comply with national regulations governing the installation of electrical equipment.

1. Remove the cover of the connection compartment (f) from the transmitter housing.
2. Feed the power supply cable (a) and the signal cable (b) through the appropriate cable entries.
3. Perform the wiring:
 - Wiring diagram (aluminum housing) → 34
 - Wiring diagram (stainless steel housing) → 35
 - Wiring diagram (wall-mount housing) → 36
 - Terminal assignment → 52
4. Screw the cover of the connection compartment (f) firmly onto the transmitter housing.

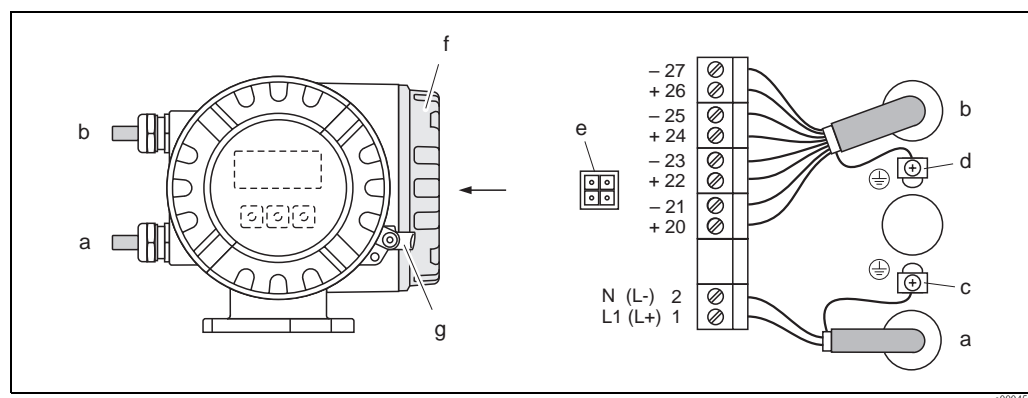


Fig. 34: Connecting the transmitter (aluminum field housing). Cable cross-section: max. 2.5 mm²

- a Cable for power supply: 85 to 260 V AC, 20 to 55 V AC, 16 to 62 V DC
 Terminal **No. 1**: L1 for AC, L+ for DC
 Terminal **No. 2**: N for AC, L- for DC
- b Signal cable: Terminals **Nos. 20–27** → 52
- c Ground terminal for protective ground
- d Ground terminal for signal cable shield
- e Service connector for connecting service interface FXA193 (Fieldcheck, FieldCare)
- f Cover of the connection compartment
- g Securing clamp

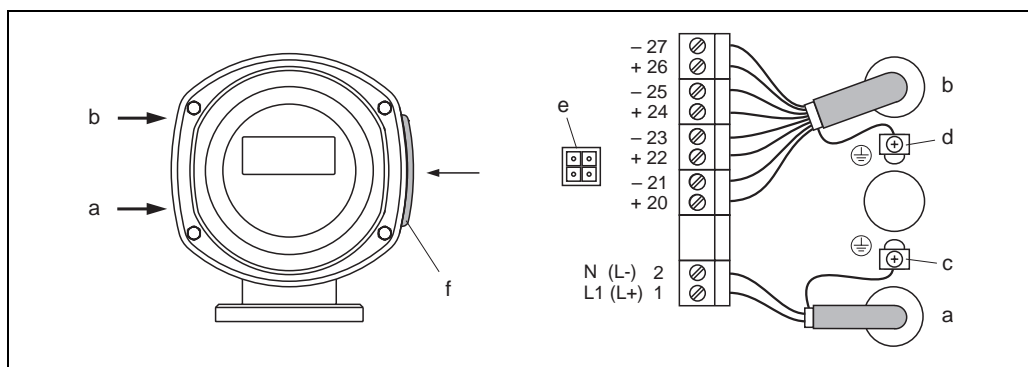


Fig. 35: Connecting the transmitter (stainless steel field housing); cable cross-section: max. 2.5 mm²

- a Cable for power supply: 85 to 260 V AC, 20 to 55 V AC, 16 to 62 V DC
Terminal **No. 1**: L1 for AC, L+ for DC
Terminal **No. 2**: N for AC, L- for DC
- b Signal cable: Terminals **Nos. 20–27** → 52
- c Ground terminal for protective ground
- d Ground terminal for signal cable shield
- e Service connector for connecting service interface FXA193 (Fieldcheck, FieldCare)
- f Cover of the connection compartment

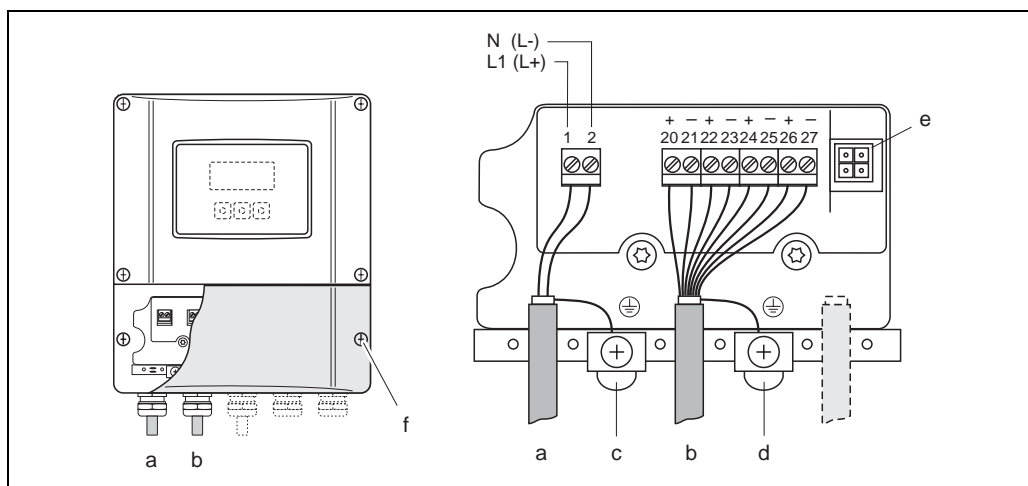


Fig. 36: Connecting the transmitter (wall-mount housing); cable cross-section: max. 2.5 mm²

- a Cable for power supply: 85 to 260 V AC, 20 to 55 V AC, 16 to 62 V DC
Terminal **No. 1**: L1 for AC, L+ for DC
Terminal **No. 2**: N for AC, L- for DC
- b Signal cable: Terminals **Nos. 20–27** → 52
- c Ground terminal for protective ground
- d Ground terminal for signal cable shield
- e Service connector for connecting service interface FXA193 (Fieldcheck, FieldCare)
- f Cover of the connection compartment

4.2.2 Terminal assignment

Order version	Terminal No. (inputs / outputs)			
	20 (+) / 21 (-)	22 (+) / 23 (-)	24 (+) / 25 (-)	26 (+) / 27 (-)
50***_*****W	-	-	-	Current output HART
50***_*****A	-	-	Frequency output	Current output HART
50***_*****D	Status input	Status output	Frequency output	Current output HART
50***_*****S	-	-	Frequency output Ex i	Current output, Ex i, active, HART
50***_*****T	-	-	Frequency output Ex i	Current output, Ex i, passive, HART



Note!

Functional values of the inputs and outputs → 97

4.2.3 HART connection

Users have the following connection options at their disposal:

- Direct connection to transmitter by means of terminals 26(+) and 27 (–)
- Connection by means of the 4 to 20 mA circuit.
- The measuring loop's minimum load must be at least 250 Ω .
- After commissioning, make the following settings:
 - CURRENT SPAN function → "4–20 mA HART"
 - Switch HART write protection on or off → 64

Connection of the HART handheld communicator

See also the documentation issued by the HART Communication Foundation, and in particular HCF LIT 20: "HART, a technical summary".

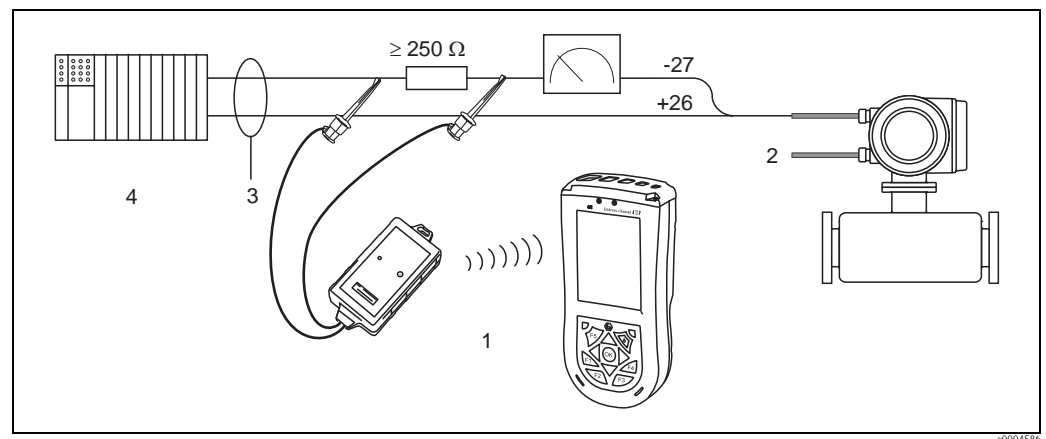


Fig. 37: Electrical connection of HART handheld Field Xpert SFX100

- 1 HART handheld Field Xpert SFX100
- 2 Auxiliary energy
- 3 Shielding
- 4 Other devices or PLC with passive input

Connection of a PC with an operating software

In order to connect a PC with operating software (e.g. "FieldCare"), a HART modem (e.g. "Commubox FXA195") is needed.

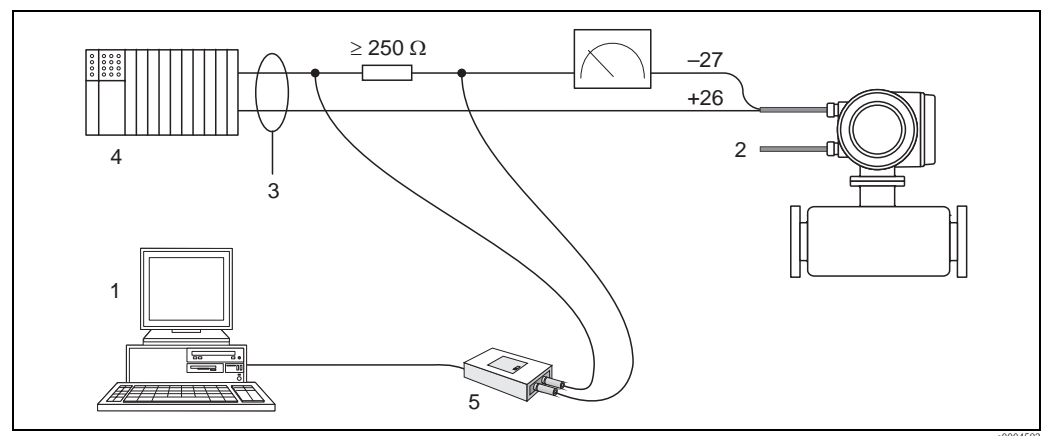


Fig. 38: Electrical connection of a PC with operating software

- 1 PC with operating software
- 2 Auxiliary energy
- 3 Shielding
- 4 Other devices or PLC with passive input
- 5 HART modem, e.g. Commubox FXA195

4.3 Potential equalization



Warning!

The measuring system must be included in the potential equalization.

Perfect measurement is only ensured when the fluid and the sensor have the same electrical potential. This is ensured by the reference electrode integrated in the sensor as standard.

The following should also be taken into consideration for potential equalization:

- Internal grounding concepts in the company
- Operating conditions, such as the material/grounding of the pipes (see Table)

4.3.1 Potential equalization for Promag D

- No reference electrode is integrated!

For the two ground disks of the sensor an electrical connection to the fluid is always ensured.

- Exampels for connections → 54

4.3.2 Potential equalization for Promag W, P, L

- Reference electrode integrated in the sensor as standard
- Exampels for connections → 55

4.3.3 Potential equalization for Promag H

No reference electrode is integrated!

For the metal process connections of the sensor an electrical connection to the fluid is always ensured.




Caution!



If using process connections made of a synthetic material, ground rings have to be used to ensure that potential is equalized (→ 37). The necessary ground rings can be ordered separately from Endress+Hauser as accessories (→ 77).

4.3.4 Exampels for potential equalization connections for Promag D

Standard case

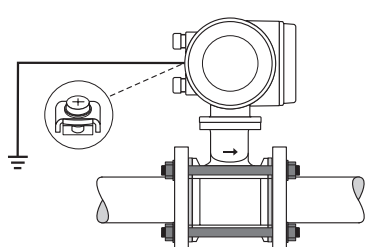
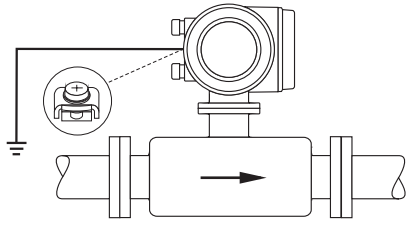
Operating conditions	Potential equalization
<p>When using the measuring device in a:</p> <ul style="list-style-type: none"> ■ Metal, grounded pipe ■ Plastic pipe ■ Pipe with insulating lining <p>Potential equalization takes place via the ground terminal of the transmitter (standard situation).</p> <p> Note! When installing in metal pipes, we recommend you connect the ground terminal of the transmitter housing with the piping.</p>	 <p><i>Fig. 39: Via the ground terminal of the transmitter</i></p> <p style="text-align: right;">a00012172</p>

Special cases

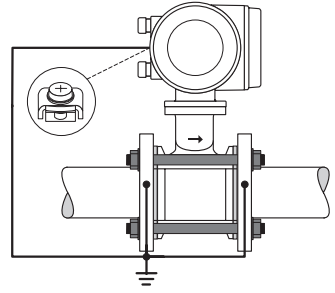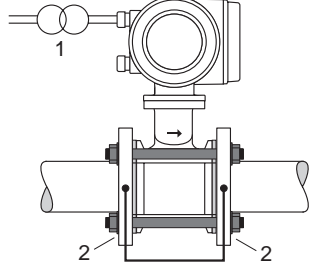
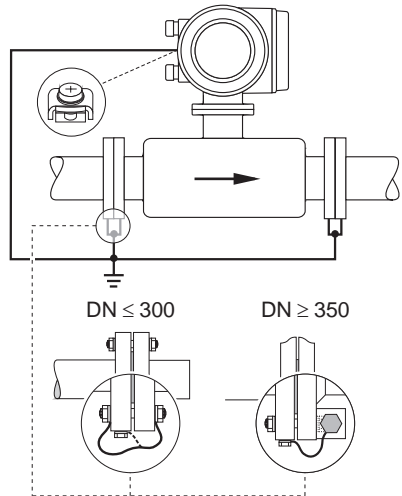
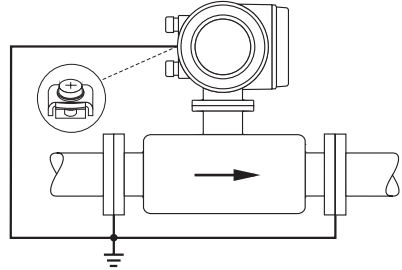
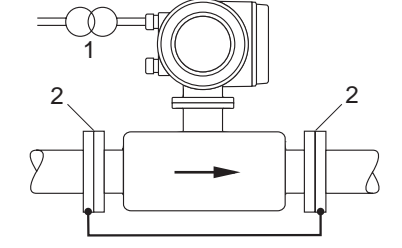
Operating conditions	Potential equalization
<p>When using the measuring device in a:</p> <ul style="list-style-type: none"> ■ Metal pipe that is not grounded <p>This connection method also applies in situations where:</p> <ul style="list-style-type: none"> ■ Customary potential equalization cannot be ensured ■ Excessively high equalizing currents can be expected <p>Potential equalization takes place via the ground terminal of the transmitter and the two pipe flanges.</p> <p>Here, the ground cable (copper wire, 6 mm² (0.0093 in²)) is mounted directly on the conductive flange coating with flange screws.</p>	 <p><i>Fig. 40: Via the ground terminal of the transmitter and the flanges of the pipe .</i></p> <p style="text-align: right;">a00012173</p>
<p>When using the measuring device in a:</p> <ul style="list-style-type: none"> ■ Pipe with a cathodic protection unit <p>The device is installed potential-free in the pipe.</p> <p>Only the two flanges of the pipe are connected with a ground cable (copper wire, 6 mm² (0.0093 in²)). Here, the ground cable is mounted directly on the conductive flange coating with flange screws.</p> <p>Note the following when installing:</p> <ul style="list-style-type: none"> ■ The applicable regulations regarding potential-free installation must be observed. ■ There should be no electrically conductive connection between the pipe and the device. ■ The mounting material must withstand the applicable torques. 	 <p><i>Fig. 41: Potential equalization and cathodic protection</i></p> <p>1 Power supply isolation transformer 2 Electrically isolated</p> <p style="text-align: right;">a00012174</p>

4.3.5 Exampels for potential equalization connections for Promag L, W, P

Standard case

Operating conditions	Potential equalization
<p>When using the measuring device in a:</p> <ul style="list-style-type: none"> ■ Metal, grounded pipe <p>Potential equalization takes place via the ground terminal of the transmitter (standard situation).</p> <p> Note! When installing in metal pipes, we recommend you connect the ground terminal of the transmitter housing with the piping.</p>	 <p><i>Fig. 42: Via the ground terminal of the transmitter</i></p> <p style="text-align: right;">A0011892</p>

Special cases

Operating conditions	Potential equalization
<p>When using the measuring device in a:</p> <ul style="list-style-type: none"> ■ Metal pipe that is not grounded <p>This connection method also applies in situations where:</p> <ul style="list-style-type: none"> ■ Customary potential equalization cannot be ensured ■ Excessively high equalizing currents can be expected <p>Both sensor flanges are connected to the pipe flange by means of a ground cable (copper wire, 6 mm² (0.0093 in²)) and grounded. Connect the transmitter or sensor connection housing, as applicable, to ground potential by means of the ground terminal provided for the purpose.</p> <p>Ground cable installation depends on the nominal diameter:</p> <ul style="list-style-type: none"> ■ DN ≤ 300: The ground cable is mounted directly on the conductive flange coating with the flange screws. ■ DN ≥ 350: The ground cable is mounted directly on the metal transport bracket. <p> Note! The ground cable for flange-to-flange connections can be ordered separately as an accessory from Endress+Hauser.</p>	 <p>DN ≤ 300 DN ≥ 350</p> <p style="text-align: right;">A0011893</p> <p><i>Fig. 43: Via the ground terminal of the transmitter and the flanges of the pipe</i></p>
<p>When using the measuring device in a:</p> <ul style="list-style-type: none"> ■ Plastic pipe ■ Pipe with insulating lining <p>This connection method also applies in situations where:</p> <ul style="list-style-type: none"> ■ Customary potential equalization cannot be ensured ■ Excessively high equalizing currents can be expected <p>Potential equalization takes place using additional ground disks, which are connected to the ground terminal via a ground cable (copper wire, min. 6 mm² (0.0093 in²)). When installing the ground disks, please comply with the enclosed Installation Instructions.</p>	 <p style="text-align: right;">A0011895</p> <p><i>Fig. 44: Via the ground terminal of the transmitter</i></p>
<p>When using the measuring device in a:</p> <ul style="list-style-type: none"> ■ Pipe with a cathodic protection unit <p>The device is installed potential-free in the pipe. Only the two flanges of the pipe are connected with a ground cable (copper wire, 6 mm² (0.0093 in²)). Here, the ground cable is mounted directly on the conductive flange coating with flange screws.</p> <p>Note the following when installing:</p> <ul style="list-style-type: none"> ■ The applicable regulations regarding potential-free installation must be observed. ■ There should be no electrically conductive connection between the pipe and the device. ■ The mounting material must withstand the applicable torques. 	 <p style="text-align: right;">A0011896</p> <p><i>Fig. 45: Potential equalization and cathodic protection</i></p> <p>1 Power supply isolation transformer 2 Electrically isolated</p>

4.4 Degree of protection

The devices meet all the requirements of IP 67 degree of protection.

Compliance with the following points is mandatory following installation in the field or servicing in order to ensure that IP 67 protection is maintained:

- The housing seals must be clean and undamaged when inserted into their grooves. The seals must be dried, cleaned or replaced if necessary.
- All threaded fasteners and screw covers must be firmly tightened.
- The cables used for connection must be of the specified outside diameter → 49.
- Firmly tighten the cable entries.
- The cables must loop down before they enter the cable entries ("water trap"). This arrangement prevents moisture penetrating the entry. Always install the measuring device in such a way that the cable entries do not point up.
- Remove all unused cable entries and insert plugs instead.
- Do not remove the grommet from the cable entry.

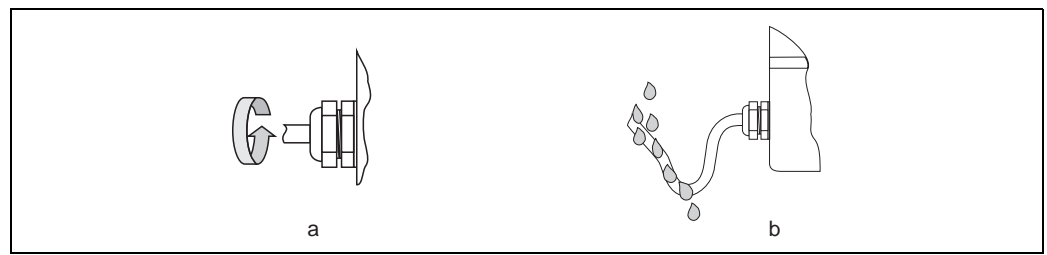


Fig. 46: Installation instructions, cable entries



Caution!

Do not loosen the threaded fasteners of the sensor housing, as otherwise the degree of protection guaranteed by Endress+Hauser no longer applies.






Note!

The Promag L, Promag W and Promag P sensors can be supplied with IP 68 rating (permanent immersion in water to a depth of 3 meters (10 ft)). In this case the transmitter must be installed remote from the sensor.

The Promag L sensors with IP 68 rating are only available with stainless steel flanges.

4.5 Post-connection check

Perform the following checks after completing electrical installation of the measuring device:

Device condition and specifications	Notes
Are cables or the device damaged (visual inspection)?	-
Electrical connection	Notes
Does the supply voltage match the specifications on the nameplate?	<ul style="list-style-type: none"> ■ 85 to 250 V AC (50 to 60 Hz) ■ 20 to 28 V AC (50 to 60 Hz) 11 to 40 V DC
Do the cables used comply with the necessary specifications?	→  49
Do the cables have adequate strain relief?	-
Is the cable type route completely isolated? Without loops and crossovers?	-
Are the power-supply and signal cables correctly connected?	See the wiring diagram inside the cover of the terminal compartment
Are all screw terminals firmly tightened?	-
Have the measures for grounding/potential equalization been correctly implemented?	→  54
Are all cable entries installed, firmly tightened and correctly sealed? Cables looped as "water traps"?	→  57
Are all housing covers installed and firmly tightened?	-

5 Operation

5.1 Display and operating elements

The local display enables you to read all important parameters directly at the measuring point and configure the device.

The display area consists of two lines; this is where measured values are displayed, and/or status variables (direction of flow, partially filled pipe, bar graph, etc.). You can change the assignment of display lines to variables at will in order to customize the display to suit your needs and preferences (→ "Description of Device Functions" manual).

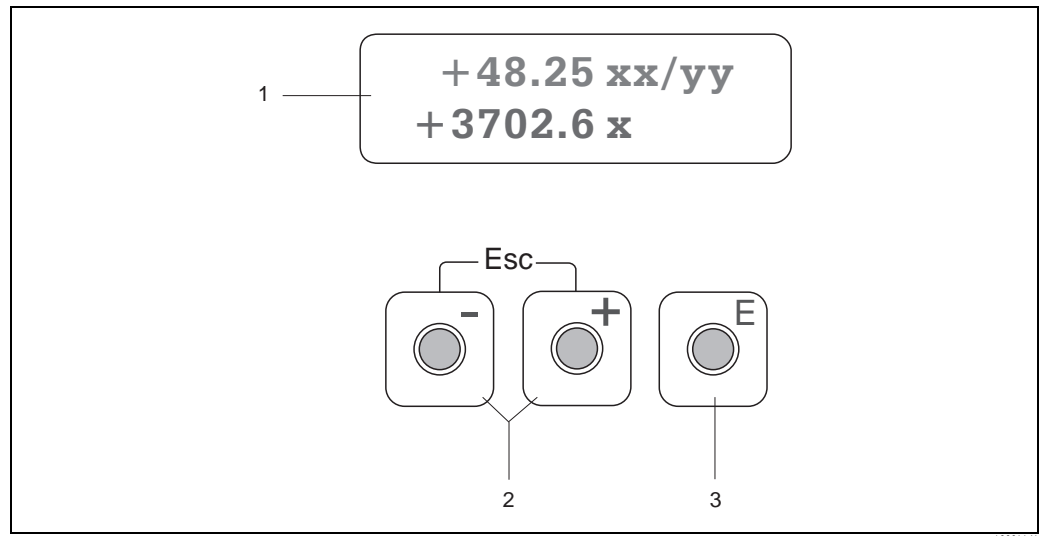


Fig. 47: Display and operating elements

1 Liquid crystal display

The two-line liquid-crystal display shows measured values, dialog texts, error messages and information messages. The display as it appears when normal measuring is in progress is known as the HOME position (operating mode).

- Upper display line: Shows primary measured values, e.g. volume flow in [ml/min] or in [%].
- Lower display line: Shows supplementary measured variables and status variables, e.g. totalizer reading in [m3], bar graph, measuring point designation

2 Plus/minus keys

- Enter numerical values, select parameters
- Select different function groups within the function matrix

Press the +/- keys simultaneously to trigger the following functions:

- Exit the function matrix step by step → HOME position
- Press and hold down +/- keys for longer than 3 seconds → Return directly to HOME position
- Cancel data entry

3 Enter key

- HOME position → Entry into the function matrix
- Save the numerical values you input or settings you change

5.2 Brief operating instructions on the function matrix



Note!

- See the general notes on → 61.
- Detailed description of all the functions → "Description of Device Functions" manual

The function matrix comprises two levels, namely the function groups and the functions of the function groups.

The groups are the highest-level grouping of the control options for the device. A number of functions is assigned to each group. You select a group in order to access the individual functions for operating and configuring the device.

1. HOME position → **E** → Enter the function matrix
2. Select a function group (e.g. OPERATION)
3. Select a function (e.g. LANGUAGE)
Change parameter/enter numerical values:
 ▢ → select or enter enable code, parameters, numerical values
E → save your entries
4. Exit the function matrix:
 - Press and hold down Esc key (**Esc**) for longer than 3 seconds → HOME position
 - Repeatedly press Esc key (**Esc**) → return step by step to HOME position





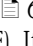

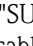
Fig. 48: Selecting functions and configuring parameters (function matrix)

A0001142

5.2.1 General notes

The Quick Setup menu (→  71) is adequate for commissioning in most instances. Complex measuring operations on the other hand necessitate additional functions that you can configure as necessary and customize to suit your process parameters. The function matrix, therefore, comprises a multiplicity of additional functions which, for the sake of clarity, are arranged in a number of function groups.

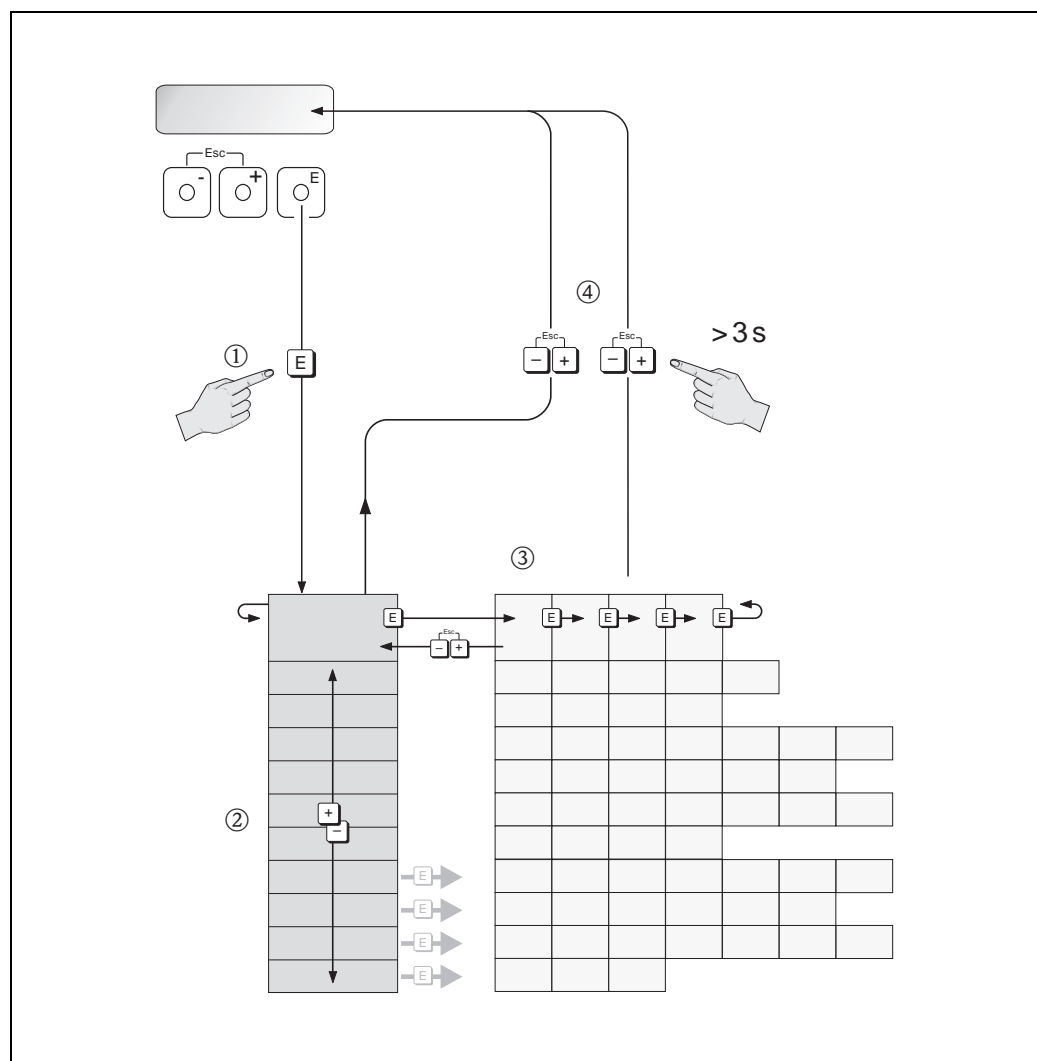Comply with the following instructions when configuring functions:

- You select functions as described on →  60.
- You can switch off certain functions (OFF). If you do so, related functions in other function groups will no longer be displayed.
- Certain functions prompt you to confirm your data entries.
Press  to select "SURE [YES]" and press  again to confirm. This saves your setting or starts a function, as applicable.
- Return to the HOME position is automatic if no key is pressed for 5 minutes.



Note!

- The transmitter continues to measure while data entry is in progress, i.e. the current measured values are output via the signal outputs in the normal way.
- If the power supply fails, all preset and configured values remain safely stored in the EEPROM.



Caution!


All functions are described in detail, including the function matrix itself, in the "Description of Device Functions" manual, which is a separate part of these Operating Instructions.

5.2.2 Enabling the programming mode

The function matrix can be disabled. Disabling the function matrix rules out the possibility of inadvertent changes to device functions, numerical values or factory settings. A numerical code (factory setting = 50) has to be entered before settings can be changed.

If you use a code number of your choice, you exclude the possibility of unauthorized persons accessing data (→ see the "Description of Device Functions" manual).

Comply with the following instructions when entering codes:

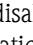- If programming is disabled and the  operating elements are pressed in any function, a prompt for the code automatically appears on the display.
- If "0" is specified as the customer's code, programming is always enabled.
- The Endress+Hauser service organization can be of assistance if you mislay your personal code.



Caution!

Changing certain parameters such as all sensor characteristics, for example, influences numerous functions of the entire measuring system, particularly measuring accuracy.

There is no need to change these parameters under normal circumstances and consequently, they are protected by a special code known only to the Endress+Hauser service organization.

Please contact Endress+Hauser if you have any questions.

5.2.3 Disabling the programming mode

Programming is disabled if you do not press the operating elements within 60 seconds following automatic return to the HOME position.

You can also disable programming in the "ACCESS CODE" function by entering any number (other than the customer's code).

5.3 Displaying error messages

5.3.1 Type of error

Errors which occur during commissioning or measuring operation are displayed immediately. If two or more system or process errors occur, the error with the highest priority is the one shown on the display.

The measuring system distinguishes between two types of error:

■ **System errors** → 81:

This group comprises all device errors, e.g. communication errors, hardware faults, etc.

■ **Process errors** → 83:

This group comprises all application errors, e.g. empty pipe, etc.

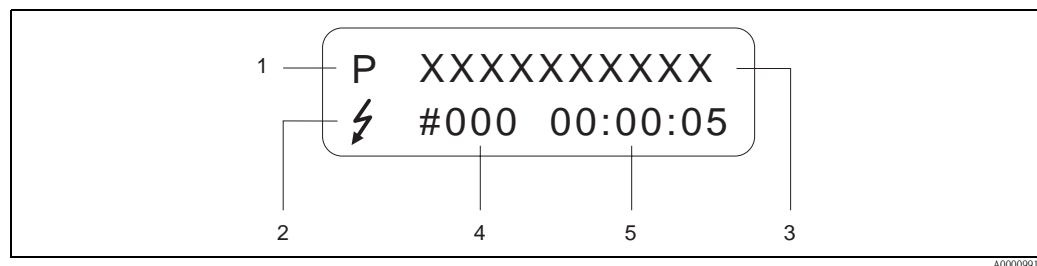


Fig. 49: Error messages on the display (example)

1 Error type:

- P = process error
- S = system error

2 Error message type:

- ⚡ = fault message
- ! = notice message

3 Error designation: e.g. EMPTY PIPE = measuring tube is only partly filled or completely empty

4 Error number: e.g. #401

5 Duration of most recent error occurrence (in hours, minutes and seconds)

5.3.2 Error message types

Users have the option of weighting certain errors differently, in other words having them classed as "Fault messages" or "Notice messages". You can define messages in this way with the aid of the function matrix (→ "Description of Device Functions" manual).

Serious system errors, e.g. module defects, are always identified and classed as "fault messages" by the measuring device.

Notice message (!)

- Displayed as → Exclamation mark (!), error type (S: system error, P: process error)
- The error in question has no effect on the outputs of the measuring device.

Fault message (⚡)

- Displayed as → Lightning flash (⚡), error type (S: system error, P: process error).
- The error in question has a direct effect on the outputs.

The response of the individual outputs (failsafe mode) can be defined in the function matrix using the "FAILSAFE MODE" function (→ "Description of Device Functions" manual).



Note!

For security reasons, error messages should be output via the status output.

5.4 Communication

In addition to local operation, the measuring device can be configured and measured values can be obtained by means of the HART protocol. Digital communication takes place using the 4–20 mA current output HART → 53.

The HART protocol allows the transfer of measuring and device data between the HART master and the field devices for configuration and diagnostics purposes.

The HART master, e.g. a handheld terminal or PC-based operating programs (such as FieldCare), require device description (DD) files which are used to access all the information in a HART device. Information is exclusively transferred using so-called "commands". There are three different command classes:

- **Universal commands:**

All HART device support and use universal commands.

The following functionalities are linked to them:

- Identify HART devices
- Reading digital measured values (volume flow, totalizer, etc.)

- **Common practice commands:**

Common practice commands offer functions which are supported and can be executed by most but not all field devices.

- **Device-specific commands:**

These commands allow access to device-specific functions which are not HART standard. Such commands access individual field device information, amongst other things, such as empty/full pipe calibration values, low flow cutoff settings, etc.



Note!

The device has access to all three command classes. A list of all the "Universal commands" and "Common practice commands" is provided on → 65.

5.4.1 Operating options

For the complete operation of the measuring device, including device-specific commands, there are DD files available to the user to provide the following operating aids and programs:

Field Xpert HART Communicator

Selecting device functions with a HART Communicator is a process involving a number of menu levels and a special HART function matrix.

The HART manual in the carrying case of the HART Communicator contains more detailed information on the device.

Operating program "FieldCare"

FieldCare is Endress+Hauser's FDT-based plant Asset Management Tool and allows the configuration and diagnosis of intelligent field devices. By using status information, you also have a simple but effective tool for monitoring devices. The Proline flow measuring devices are accessed via a service interface or via the service interface FXA193.

Operating program "SIMATIC PDM" (Siemens)

SIMATIC PDM is a standardized, manufacturer-independent tool for the operation, configuration, maintenance and diagnosis of intelligent field devices.

Operating program "AMS" (Emerson Process Management)

AMS (Asset Management Solutions): program for operating and configuring devices.

5.4.2 Current device description files

The following table illustrates the suitable device description file for the operating tool in question and then indicates where these can be obtained.

HART protocol:

Valid for device software:	2.03.XX	→ Function DEVICE SOFTWARE
Device data HART		
Manufacturer ID:	11 _{hex} (ENDRESS+HAUSER)	→ Function MANUFACTURER ID
Device ID:	41 _{hex}	→ Function DEVICE ID
HART version data:	Device Revision 6/ DD Revision 1	
Software release:	07.2009	
Operating program:	Sources for obtaining device descriptions:	
Handheld Field Xpert SFX100	Use update function of handheld terminal	
FieldCare / DTM	<ul style="list-style-type: none"> ■ www.endress.com → Download ■ CD-ROM (Endress+Hauser order number 56004088) ■ DVD (Endress+Hauser order number 70100690) 	
AMS	www.endress.com → Download	
SIMATIC PDM	www.endress.com → Download	

Tester/simulator:	Sources for obtaining device descriptions:
Fieldcheck	Update by means of FieldCare with the flow device FXA193/291 DTM in the Fieldflash module



Note!

The "Fieldcheck" tester/simulator is used for testing flowmeters in the field. When used in conjunction with the "FieldCare" software package, test results can be imported into a database, printed out and used for official certification. Contact your Endress+Hauser representative for more information.

5.4.3 Device variables

The following device variables are available using the HART protocol:

Code (decimal)	Device variable
0	OFF (not assigned)
1	Volume flow
250	Totalizer 1
251	Totalizer 2

At the factory, the process variables are assigned to the following device variables:

- Primary process variable (PV) → Volume flow
- Second process variable (SV) → Totalizer 1
- Third process variable (TV) → not assigned
- Fourth process variable (FV) → not assigned



Note!




You can set or change the assignment of device variables to process variables using Command 51.






5.4.4 Switching HART write protection on/off

The HART write protection can be switched on and off using the HART WRITE PROTECT device function (→ "Description of Device Functions" manual).

5.4.5 Universal and common practice HART commands





The following table contains all the universal commands supported by the device.







Command No. HART command / Access type		Command data (numeric data in decimal form)	Response data (numeric data in decimal form)
Universal commands			
0	Read unique device identifier Access type = read	none	<p>Device identification delivers information on the device and the manufacturer. It cannot be changed.</p> <p>The response consists of a 12 byte device ID:</p> <ul style="list-style-type: none"> – Byte 0: fixed value 254 – Byte 1: Manufacturer ID, 17 = E+H – Byte 2: Device type ID, 65 = Promag 50 – Byte 3: Number of preambles – Byte 4: Universal commands rev. no. – Byte 5: Device-specific commands rev. no. – Byte 6: Software revision – Byte 7: Hardware revision – Byte 8: Additional device information – Bytes 9-11: Device identification
1	Read primary process variable Access type = read	none	<ul style="list-style-type: none"> – Byte 0: HART unit code of the primary process variable – Bytes 1-4: Primary process variable <p>Factory setting: Primary process variable = Volume flow</p> <p> Note!</p> <ul style="list-style-type: none"> ■ Manufacturer-specific units are represented using the HART unit code "240". ■ You can change the assignment of device variables to process variables using Command 51.
2	Read the primary process variable as current in mA and percentage of the set measuring range Access type = read	none	<ul style="list-style-type: none"> – Bytes 0-3: actual current of the primary process variable in mA – Bytes 4-7: % value of the set measuring range <p>Factory setting: Primary process variable = Volume flow</p> <p> Note!</p> <p>You can change the assignment of device variables to process variables using Command 51.</p>
3	Read the primary process variable as current in mA and four dynamic process variables Access type = read	none	<p>24 bytes are sent as a response:</p> <ul style="list-style-type: none"> – Bytes 0-3: primary process variable current in mA – Byte 4: HART unit code of the primary process variable – Bytes 5-8: Primary process variable – Byte 9: HART unit code of the second process variable – Bytes 10-13: Second process variable – Byte 14: HART unit code of the third process variable – Bytes 15-18: Third process variable – Byte 19: HART unit code of the fourth process variable – Bytes 20-23: Fourth process variable <p><i>Factory setting:</i></p> <ul style="list-style-type: none"> ■ Primary process variable = Volume flow ■ Second process variable = Totalizer 1 ■ Third process variable = OFF (not assigned) ■ Fourth process variable = OFF (not assigned) <p> Note!</p> <ul style="list-style-type: none"> ■ Manufacturer-specific units are represented using the HART unit code "240". ■ You can change the assignment of device variables to process variables using Command 51.

Command No. HART command / Access type		Command data (numeric data in decimal form)	Response data (numeric data in decimal form)
6	Set HART shortform address Access type = write	Byte 0: desired address (0 to 15) Factory setting: 0  Note! With an address >0 (multidrop mode), the current output of the primary process variable is set to 4 mA.	Byte 0: active address
11	Read unique device identification using the TAG (measuring point designation) Access type = read	Bytes 0-5: TAG	Device identification delivers information on the device and the manufacturer. It cannot be changed. The response consists of a 12 byte device ID if the given TAG agrees with the one saved in the device: <ul style="list-style-type: none"> – Byte 0: fixed value 254 – Byte 1: Manufacturer ID, 17 = E+H – Byte 2: Device type ID, 65 = Promag 50 – Byte 3: Number of preambles – Byte 4: Universal commands rev. no. – Byte 5: Device-specific commands rev. no. – Byte 6: Software revision – Byte 7: Hardware revision – Byte 8: Additional device information – Bytes 9-11: Device identification
12	Read user message Access type = read	none	Bytes 0-24: User message  Note! You can write the user message using Command 17.
13	Read TAG, descriptor and date Access type = read	none	<ul style="list-style-type: none"> – Bytes 0-5: TAG – Bytes 6-17: descriptor – Bytes 18-20: Date  Note! You can write the TAG, descriptor and date using Command 18.
14	Read sensor information on primary process variable	none	<ul style="list-style-type: none"> – Bytes 0-2: Sensor serial number – Byte 3: HART unit code of sensor limits and measuring range of the primary process variable – Bytes 4-7: Upper sensor limit – Bytes 8-11: Lower sensor limit – Bytes 12-15: Minimum span  Note! <ul style="list-style-type: none"> ■ The data relate to the primary process variable (= volume flow). ■ Manufacturer-specific units are represented using the HART unit code "240".
15	Read output information of primary process variable Access type = read	none	<ul style="list-style-type: none"> – Byte 0: Alarm selection ID – Byte 1: Transfer function ID – Byte 2: HART unit code for the set measuring range of the primary process variable – Bytes 3-6: upper range, value for 20 mA – Bytes 7-10: lower range, value for 4 mA – Bytes 11-14: Damping constant in [s] – Byte 15: Write protection ID – Byte 16: OEM dealer ID, 17 = E+H Factory setting: Primary process variable = Volume flow  Note! <ul style="list-style-type: none"> ■ Manufacturer-specific units are represented using the HART unit code "240". ■ You can change the assignment of device variables to process variables using Command 51.

Command No. HART command / Access type		Command data (numeric data in decimal form)	Response data (numeric data in decimal form)
16	Read the device production number Access type = read	none	Bytes 0-2: Production number
17	Write user message Access = write	You can save any 32-character long text in the device under this parameter: Bytes 0-23: Desired user message	Displays the current user message in the device: Bytes 0-23: Current user message in the device
18	Write TAG, descriptor and date Access = write	With this parameter, you can store an 8 character TAG, a 16 character descriptor and a date: – Bytes 0-5: TAG – Bytes 6-17: descriptor – Bytes 18-20: Date	Displays the current information in the device: – Bytes 0-5: TAG – Bytes 6-17: descriptor – Bytes 18-20: Date
19	Write the device production number Access = write	Bytes 0-2: Production number	Bytes 0-2: Production number

The following table contains all the common practice commands supported by the device.

Command No. HART command / Access type		Command data (numeric data in decimal form)	Response data (numeric data in decimal form)
Common practice commands			
34	Write damping value for primary process variable Access = write	Bytes 0-3: Damping value of the primary process variable "volume flow" in seconds <i>Factory setting:</i> Primary process variable = Current output damping	Displays the current damping value in the device: Bytes 0-3: Damping value in seconds
35	Write measuring range of primary process variable Access = write	Write the desired measuring range: – Byte 0: HART unit code of the primary process variable – Bytes 1-4: upper range, value for 20 mA – Bytes 5-8: lower range, value for 4 mA <i>Factory setting:</i> Primary process variable = Volume flow  Note! ■ The start of the measuring range (4 mA) must correspond to the zero flow. ■ If the HART unit code is not the correct one for the process variable, the device will continue with the last valid unit.	The currently set measuring range is displayed as a response: – Byte 0: HART unit code for the set measuring range of the primary process variable – Bytes 1-4: upper range, value for 20 mA – Bytes 5-8: lower range, value for 4 mA  Note! ■ Manufacturer-specific units are represented using the HART unit code "240". ■ You can change the assignment of device variables to process variables using Command 51.
38	Device status reset (configuration changed) Access = write	none	none  Note! It is also possible to execute this HART command when write protection is activated (= ON)!
40	Simulate input current of primary process variable Access = write	Simulation of the desired output current of the primary process variable. An entry value of 0 exits the simulation mode: Bytes 0-3: Output current in mA <i>Factory setting:</i> Primary process variable = Volume flow  Note! You can set the assignment of device variables to process variables using Command 51.	The momentary output current of the primary process variable is displayed as a response: Bytes 0-3: Output current in mA
42	Perform master reset Access = write	none	none

Command No. HART command / Access type		Command data (numeric data in decimal form)	Response data (numeric data in decimal form)
44	Write unit of primary process variable Access = write	Set unit of primary process variable. Only units which are suitable for the process variable are transferred to the device: Byte 0: HART unit code <i>Factory setting:</i> Primary process variable = Volume flow  Note! <ul style="list-style-type: none"> ■ If the written HART unit code is not the correct one for the process variable, the device will continue with the last valid unit. ■ If you change the unit of the primary process variable, this has a direct impact on the system units. 	The current unit code of the primary process variable is displayed as a response: Byte 0: HART unit code  Note! Manufacturer-specific units are represented using the HART unit code "240".
48	Read additional device status Access = read	none	The device status is displayed in extended form as the response: Coding: see table →  69
50	Read assignment of the device variables to the four process variables Access = read	none	Display of the current variable assignment of the process variables: <ul style="list-style-type: none"> – Byte 0: Device variable code to the primary process variable – Byte 1: Device variable code to the second process variable – Byte 2: Device variable code to the third process variable – Byte 3: Device variable code to the fourth process variable <i>Factory setting:</i> <ul style="list-style-type: none"> ■ Primary process variable: Code 1 for volume flow ■ Second process variable: Code 250 for totalizer ■ Third process variable: Code 0 for OFF (not assigned) ■ Fourth process variable: Code 0 for OFF (not assigned)
51	Write assignment of the device variables to the four process variables Access = write	Setting of the device variables to the four process variables: <ul style="list-style-type: none"> – Byte 0: Device variable code to the primary process variable – Byte 1: Device variable code to the second process variable – Byte 2: Device variable code to the third process variable – Byte 3: Device variable code to the fourth process variable <i>Factory setting:</i> <ul style="list-style-type: none"> ■ Primary process variable: Volume flow ■ Second process variable: Totalizer 1 ■ Third process variable: OFF (not assigned) ■ Fourth process variable: OFF (not assigned) 	The variable assignment of the process variables is displayed as a response: <ul style="list-style-type: none"> – Byte 0: Device variable code to the primary process variable – Byte 1: Device variable code to the second process variable – Byte 2: Device variable code to the third process variable – Byte 3: Device variable code to the fourth process variable
53	Write device variable unit Access = write	This command sets the unit of the given device variables. Only those units which suit the device variable are transferred: <ul style="list-style-type: none"> – Byte 0: Device variable code – Byte 1: HART unit code Code of the supported device variables: See information →  64  Note! <ul style="list-style-type: none"> ■ If the written unit is not the correct one for the device variable, the device will continue with the last valid unit. ■ If you change the unit of the device variable, this has a direct impact on the system units. 	The current unit of the device variables is displayed in the device as a response: <ul style="list-style-type: none"> – Byte 0: Device variable code – Byte 1: HART unit code  Note! Manufacturer-specific units are represented using the HART unit code "240".
59	Write number of preambles in response message Access = write	This parameter sets the number of preambles which are inserted in the response messages: Byte 0: Number of preambles (4 to 20)	The current number of preambles is displayed in the response telegram: Byte 0: Number of preambles

5.4.6 Device status and error messages

You can read the extended device status, in this case, current error messages, via Command "48". The command delivers information which is partly coded in bits (see table below).



Note!

- You can find a detailed explanation of the device status and error messages and their elimination on → 69
- Bits and bytes not listed are not assigned.

Byte	Bit	Error No.	Short error description
0	0	001	Serious device error
	1	011	Measuring amplifier has faulty EEPROM
	2	012	Error when accessing data of the measuring amplifier EEPROM
1	1	031	S-DAT: defective or missing
	2	032	S-DAT: Error accessing saved values
	5	051	I/O and the amplifier are not compatible.
3	3	111	Totalizer checksum error
	4	121	I/O board and amplifier not compatible.
4	3	251	Internal communication fault on the amplifier board.
	4	261	No data reception between amplifier and I/O board
5	0	321	Coil current of the sensor is outside the tolerance.
	7	339	Flow buffer: The temporarily buffered flow portions (measuring mode for pulsating flow) could not be cleared or output within 60 seconds.
6	0	340	
	1	341	
	2	342	
	3	343	Frequency buffer: The temporarily buffered flow portions (measuring mode for pulsating flow) could not be cleared or output within 60 seconds.
	4	344	
	5	345	
	6	346	
7	7	347	Pulse buffer: The temporarily buffered flow portions (measuring mode for pulsating flow) could not be cleared or output within 60 seconds.
	0	348	
	1	349	
	2	350	
	3	351	Current output: Flow is out of range.
	4	352	
	5	353	
	6	354	
8	7	355	Frequency output: Flow is out of range.
	0	356	
	1	357	
	2	358	

Byte	Bit	Error No.	Short error description
8	3	359	Pulse output: Flow is out of range.
	4	360	
	5	361	
	6	362	
10	7	401	Measuring tube partially filled or empty
11	2	461	EPD calibration not possible because the fluid's conductivity is either too low or too high.
	4	463	The EPD calibration values for empty pipe and full pipe are identical, and therefore incorrect.
12	1	474	Maximum flow value entered is overshoot
	7	501	Amplifier software version is loaded. Currently no other commands are possible.
13	0	502	Upload/download of device files. Currently no other commands are possible.
14	3	601	Positive zero return active
	7	611	Simulation current output active
15	0	612	
	1	613	
	2	614	Simulation frequency output active
	3	621	
	4	622	
	5	623	
	6	624	
	7	631	Simulation pulse output active
16	0	632	
	1	633	Simulation status output active
	2	634	
	3	641	
	4	642	
	5	643	
	6	644	
17	7	671	Simulation of the status input active
18	0	672	
	1	673	
	2	674	Simulation of response to error (outputs) active
	3	691	
	4	692	Simulation of volume flow active

6 Commissioning


6.1 Function check

Make sure that all final checks have been completed before you start up your measuring point:

- Checklist for "Post-installation check" → 43
- Checklist for "Post-connection check" → 58

6.2 Switching on the measuring device

Once the connection checks have been successfully completed, it is time to switch on the power supply. The device is now operational. The measuring device performs a number of post switch-on self-tests. As this procedure progresses the following sequence of messages appears on the local display:

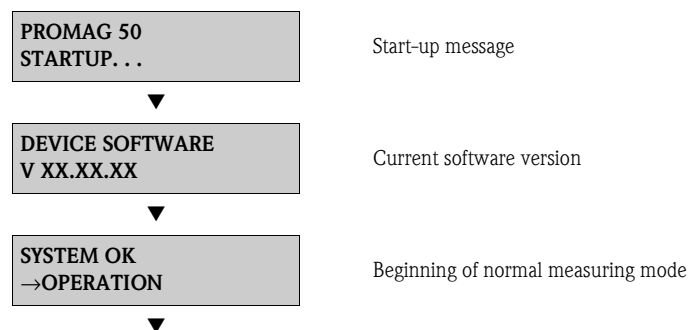

Normal measuring mode commences as soon as start-up completes.

Various measured-value and/or status variables (HOME position) appear on the display.



Note!

If start-up fails, an error message indicating the cause is displayed.


6.3 Quick Setup

In the case of measuring devices without a local display, the individual parameters and functions must be configured via the operating program, e.g. FieldCare.

If the measuring device is equipped with a local display, all the important device parameters for standard operation, as well as additional functions, can be configured quickly and easily by means of the following Quick Setup menu.

6.3.1 "Commissioning" Quick Setup menu

This Quick Setup menu guides you systematically through the setup procedure for all the major device functions that have to be configured for standard measuring operation.

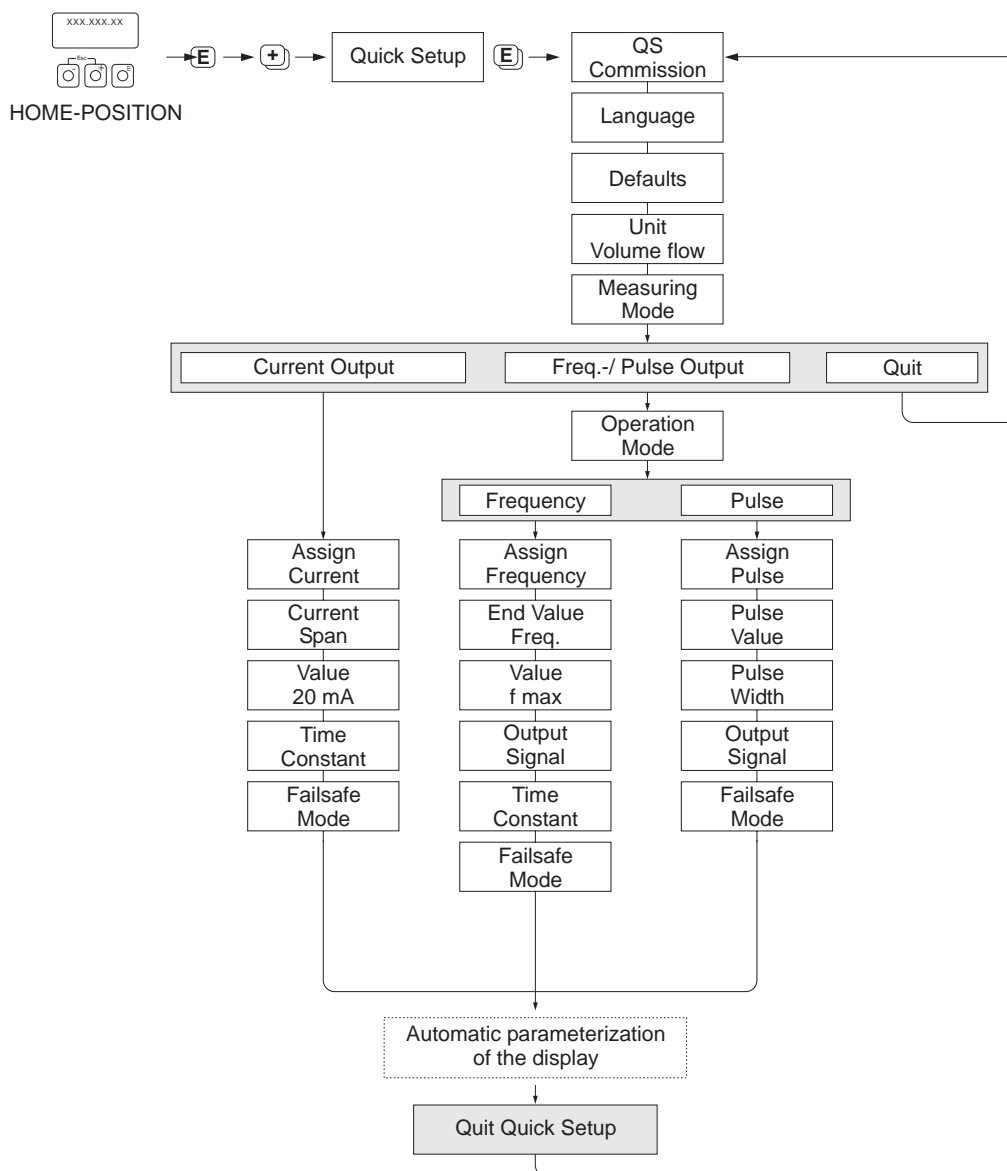

A0005413-EN

Fig. 50: "QUICK SETUP COMMISSIONING" menu for the rapid configuration of important device functions

6.4 Configuration

6.4.1 Current output: active/passive

The current output is configured as "active" or "passive" by means of various jumpers on the I/O board.



Warning!

Risk of electric shock! Exposed components carry dangerous voltages. Make sure that the power supply is switched off before you remove the cover of the electronics compartment.

1. Switch off power supply.
2. Remove the I/O board → 88
3. Position the jumper → 51



Caution!

Risk of destroying the measuring device. Set the jumpers exactly as shown in the graphic. Pay strict attention to the position of the jumpers as indicated in the graphic.

4. Installation of the I/O board is the reverse of the removal procedure.

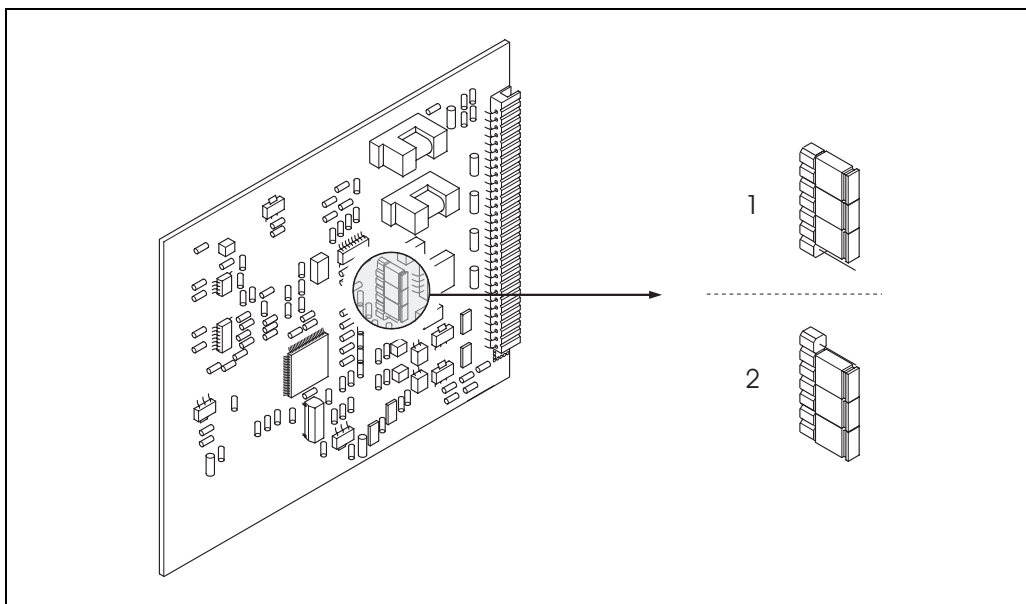


Fig. 51: Configuring current outputs using jumpers (I/O board)

- 1 Active current output (factory setting)
- 2 Passive current output

6.5 Adjustment

6.5.1 Empty-pipe/full-pipe adjustment

Flow cannot be measured correctly unless the measuring tube is completely full. This status can be permanently monitored using the Empty Pipe Detection:

- EPD = Empty Pipe Detection (with the help of an EPD electrode)
- OED = Open Electrode Detection (Empty Pipe Detection with the help of the measuring electrodes, if the sensor is not equipped with an EPD electrode or the orientation is not suitable for using EPD).



Caution!

Detailed information on the empty-pipe/full-pipe adjustment procedure can be found in the "Description of Device Functions" manual:

- EPD/OED ADJUSTMENT (carrying out the adjustment).
- EPD (switching on and off EPD/OED).
- EPD RESPONSE TIME (input of the response time for EPD/OED).



Note!

- The EPD function is not available unless the sensor is fitted with an EPD electrode.
- The devices are already calibrated at the factory with water (approx. 500 µS/cm).
If the fluid conductivity differs from this reference, empty-pipe/full-pipe adjustment has to be performed again on site.
- The default setting for EPD when the devices are delivered is OFF; the function has to be activated if required.
- The EPD process error can be output by means of the configurable relay output.

Performing empty-pipe and full-pipe adjustment (EPD)

1. Select the appropriate function in the function matrix:
HOME → [E] → [+] → PROCESS PARAMETER → [E] → [E] → EPD ADJUSTMENT
2. Empty the piping:
 - The wall of the measuring tube should still be wet with fluid during EPD empty pipe adjustment
 - The wall of the measuring tube/the measuring electrodes should **no longer** be wet with fluid during OED empty pipe adjustment
3. Start empty-pipe adjustment: Select "EMPTY PIPE ADJUST" or "OED EMPTY ADJUST" and press [E] to confirm.
4. After empty-pipe adjustment, fill the piping with fluid.
5. Start full-pipe adjustment: Select "FULL PIPE ADJUST" or "OED FULL ADJUST" and press [E] to confirm.
6. Having completed the adjustment, select the setting "OFF" and exit the function by pressing [E].
7. Switch on empty pipe detection in the EPD function:
 - EPD empty pipe adjustment: Select ON STANDARD or ON SPECIAL and press [E] to confirm
 - OED empty pipe adjustment: Select OED and confirm with [E].



Caution!

The adjustment coefficients must be valid before you can activate the EPD function. If adjustment is incorrect the following messages might appear on the display:

- FULL = EMPTY
The adjustment values for empty pipe and full pipe are identical. In cases of this nature you must repeat empty-pipe or full-pipe adjustment!
- ADJUSTMENT NOT OK
Adjustment is not possible because the fluid's conductivity is out of range.

6.6 Data storage device (HistoROM)

At Endress+Hauser, the term HistoROM refers to various types of data storage modules on which process and measuring device data are stored. It is possible to plug these modules into other devices to copy device configurations from one device to another, for example.

6.6.1 HistoROM/S-DAT (sensor-DAT)

The S-DAT is an exchangeable data storage device in which all sensor relevant parameters are stored, i.e., diameter, serial number, calibration factor, zero point.

7 Maintenance

No special maintenance work is required.


7.1 Exterior cleaning

When cleaning the exterior of measuring devices, always use cleaning agents that do not attack the surface of the housing and the seals.

7.2 Seals

The seals of the Promag H sensor must be replaced periodically, particularly in the case of gasket seals (aseptic version).

The period between changes depends on the frequency of cleaning cycles, the cleaning temperature and the fluid temperature.

Replacement seals (accessories) →  77.

8 Accessories

Various accessories, which can be ordered separately from Endress+Hauser, are available for the transmitter and the sensor. Your Endress+Hauser service organization can provide detailed information on the specific order codes on request.

8.1 Device-specific accessories

Accessory	Description	Order code
Proline Promag 50 transmitter	Transmitter for replacement or storage. Use the order code to define the following specifications: <ul style="list-style-type: none"> ■ Approvals ■ Degree of protection/version ■ Cable for remote version ■ Cable entry ■ Display/power supply/operation ■ Software ■ Outputs/inputs 	50XXX – XXXXX*****

8.2 Measuring principle-specific accessories

Accessory	Description	Order code
Mounting set for Promag 50 transmitter	Mounting set for the transmitter (remote version). Suitable for: <ul style="list-style-type: none"> ■ Wall mounting ■ Pipe mounting ■ Panel-mounted installation Mounting set for aluminum field housing. Suitable for: <ul style="list-style-type: none"> ■ Pipe mounting 	DK5WM – *
Wall-mounting kit for Promag H	Wall-mounting kit for the Promag H sensor.	DK5HM – **
Cable for remote version	Coil and signal cables, various lengths.	DK5CA – **
Mounting kit for Promag D, wafer version	Mounting kit consisting of: <ul style="list-style-type: none"> ■ Mounting bolts ■ Nuts incl. washers ■ Flange seals ■ Centering sleeves (if required for the flange) 	DKD** – **
Set of seals for Promag D	Set of seals consisting of two flange seals.	DK5DD – ***
Mounting kit for Promag H	Mounting kit consisting of: <ul style="list-style-type: none"> ■ 2 process connections ■ Threaded fasteners ■ Seals 	DKH** – ****
Set of seals for Promag H	For regular replacement of the seals of the Promag H sensor.	DK5HS – ***
Welding jig for Promag H	Weld nipple as process connection: welding jig for installation in pipe.	DK5HW – ***
Adapter connection for Promag A, H	Adapter connections for installing a Promag 10 H instead of a Promag 30/33 A or Promag 30/33 H DN 25.	DK5HA – *****
Ground rings for Promag H	Ground rings for potential equalization.	DK5HR – ***
Ground cable for Promag L, W, P	Ground cable for potential equalization.	DK5GC – ***
Ground disk for Promag L, W, P	Ground disk for potential equalization.	DK5GD – * * * *

Accessory	Description	Order code
Process display RIA45	Multifunctional 1-channel display unit: <ul style="list-style-type: none"> ■ Universal input ■ Transmitter power supply ■ Limit relay ■ Analog output 	RIA45 – *****
Process display RIA251	Digital display device for looping into the 4 to 20 mA current loop.	RIA251 – **
Field display unit RIA16	Digital field display device for looping into the 4 to 20 mA current loop.	RIA16 – ***
Application Manager RMM621	Electronic recording, display, balancing, control, saving and event and alarm monitoring of analog and digital input signals. Values and conditions determined are output by means of analog and digital output signals. Remote transmission of alarms, input values and calculated values using a PSTN or GSM modem.	RMM621 – *****

8.3 Communication-specific accessories

Accessory	Description	Order code
HART Communicator Field Xpert SFX 100	Handheld terminal for remote configuration and for obtaining measured values via the HART current output (4 to 20 mA) and FOUNDATION Fieldbus. Contact your Endress+Hauser representative for more information.	SFX100 – *****
Fieldgate FXA320	Gateway for remote interrogation of HART sensors and actuators via Web browser: <ul style="list-style-type: none"> ■ 2-channel analog input (4 to 20 mA) ■ 4 binary inputs with event counter function and frequency measurement ■ Communication via modem, Ethernet or GSM ■ Visualization via Internet/Intranet in Web browser and/or WAP cellular phone ■ Limit value monitoring with alarm by e-mail or SMS ■ Synchronized time stamping of all measured values. 	FXA320 – *****
Fieldgate FXA520	Gateway for remote interrogation of HART sensors and actuators via Web browser: <ul style="list-style-type: none"> ■ Web server for remote monitoring of up to 30 measuring points ■ Intrinsically safe version [Ex ia] IIC for applications in hazardous areas ■ Communication via modem, Ethernet or GSM ■ Visualization via Internet/Intranet in Web browser and/or WAP cellular phone ■ Limit value monitoring with alarm by e-mail or SMS ■ Synchronized time stamping of all measured values ■ Remote diagnosis and remote configuration of connected HART devices 	FXA520 – ****
FXA195	The Commubox FXA195 connects intrinsically safe Smart transmitters with HART protocol to the USB port of a personal computer. This makes the remote operation of the transmitters possible with the aid of configuration programs (e.g. FieldCare). Power is supplied to the Commubox by means of the USB port	FXA195 – *

 
 

 
 

 





8.4 Service-specific accessories

Accessory	Description	Order code
Applicator	Software for selecting and planning flowmeters. The Applicator software can be downloaded from the Internet or ordered on CD-ROM for installation on a local PC. Contact your Endress+Hauser representative for more information.	DXA80 – *
Fieldcheck	Tester/simulator for testing flowmeters in the field. When used in conjunction with the "FieldCare" software package, test results can be imported into a database, printed out and used for official certification. Contact your Endress+Hauser representative for more information.	50098801
FieldCare	FieldCare is Endress+Hauser's FDT-based asset management tool. It can configure all intelligent field units in your system and helps you manage them. By using status information, it is also a simple but effective way of checking their status and condition.	See the product page on the Endress+Hauser Web site: www.endress.com
Memograph M graphic display recorder	The Memograph M graphic display recorder provides information on all the relevant process variables. Measured values are recorded correctly, limit values are monitored and measuring points analyzed. The data are stored in the 256 MB internal memory and also on a DSD card or USB stick. Memograph M boasts a modular design, intuitive operation and a comprehensive security concept. The ReadWin® 2000 PC software is part of the standard package and is used for configuring, visualizing and archiving the data captured. The mathematics channels which are optionally available enable continuous monitoring of specific power consumption, boiler efficiency and other parameters which are important for efficient energy management.	RSG40 – *****
FXA193	Service interface from the device to the PC for operation via FieldCare.	FXA193 – *

9 Troubleshooting

9.1 Troubleshooting instructions

Always start troubleshooting with the checklist below if faults occur after start-up or during operation. The routine takes you directly to the cause of the problem and the appropriate remedial measures.

Check the display	
No display visible and no output signals present.	<ol style="list-style-type: none"> 1. Check the supply voltage → terminals 1, 2 2. Check the power line fuse →  92 85 to 260 V AC: 0.8 A slow-blow / 250 V 20 to 55 V AC / 16 to 62 V DC: 2 A slow-blow / 250 V 3. Measuring electronics defective → order spare parts →  77
No display visible, but output signals are present.	<ol style="list-style-type: none"> 1. Check whether the ribbon-cable connector of the display module is correctly plugged into the amplifier board →  88 2. Display module defective → order spare parts →  77 3. Measuring electronics defective → order spare parts →  77
Display texts are in a foreign language.	Switch off power supply. Press and hold down both the  buttons and switch on the measuring device. The display text will appear in English (default) and is displayed at maximum contrast.
Measured value indicated, but no signal at the current or pulse output.	Electronics board defective → order spare parts →  77
↓	
Error messages on display	
<p>Errors which occur during commissioning or measuring operation are displayed immediately. Error messages consist of a variety of icons: the meanings of these icons are as follows (example):</p> <ul style="list-style-type: none"> – Error type: S = system error, P = process error – Error message type: f = fault message, ! = notice message – EMPTY PIPE = Type of error, e.g. measuring tube is only partly filled or completely empty – 03:00:05 = duration of error occurrence (in hours, minutes and seconds) – #401 = error number <p> Caution!</p> <ul style="list-style-type: none"> ■ See the information on →  62! ■ The measuring system interprets simulations and positive zero return as system errors, but displays them as notice message only. 	
Error number: No. 001 – 399 No. 501 – 699	System error (device error) has occurred →  81
Error number: No. 401 – 499	Process error (application error) has occurred →  83
↓	
Other error (without error message)	
Some other error has occurred.	Diagnosis and rectification →  84

9.2 System error messages

Serious system errors are **always** recognized by the device as "Fault message", and are shown as a lightning flash (⚡) on the display. Fault messages immediately affect the outputs.



 


Caution!


In the event of a serious fault, a flowmeter might have to be returned to the manufacturer for repair. The necessary procedures on → 6 must be carried out before you return a flowmeter to Endress+Hauser. Always enclose a duly completed "Declaration of Contamination" form. You will find a master copy of this form at the back of this manual.




Note!

Also observe the information on → 62.

No.	Error message / Type	Cause	Remedy (spare part →  87)
S = System error ⚡ = Fault message (with an effect on the outputs) ! = Notice message (without an effect on the outputs)			
No. # 0xx → Hardware error			
001	S: CRITICAL FAILURE ⚡: # 001	Serious device error	Replace the amplifier board.
011	S: AMP HW EEPROM ⚡: # 011	Amplifier: Defective EEPROM	Replace the amplifier board.
012	S: AMP SW EEPROM ⚡: # 012	Amplifier: Error accessing EEPROM data	The EEPROM data blocks in which an error has occurred are displayed in the TROUBLESHOOTING function. Press Enter to acknowledge the errors in question; default values are automatically inserted instead of the errored parameter values.  Note! The measuring device has to be restarted if an error has occurred in a totalizer block (see error No. 111 / CHECKSUM TOTAL).
031	S: SENSOR HW DAT ⚡: # 031	1. S-DAT is not plugged into the amplifier board correctly (or is missing). 2. S-DAT is defective.	1. Check whether the S-DAT is correctly plugged into the amplifier board. 2. Replace the S-DAT if it is defective. Check that the new replacement DAT is compatible with the measuring electronics. Check the: – Spare part set number – Hardware revision code
032	S: SENSOR SW DAT ⚡: # 032		3. Replace measuring electronics boards if necessary. 4. Plug the S-DAT into the amplifier board.
No. # 1xx → Software error			
101	S: GAIN ERROR AMP ⚡: # 101	Gain deviation compared to reference gain > 25%.	Replace the amplifier board.
111	S: CHECKSUM TOTAL ⚡: # 111	Totalizer checksum error.	1. Restart the measuring device. 2. Replace the amplifier board if necessary.
121	S: A / C COMPATIB. !: # 121	Due to different software versions, I/O board and amplifier board are only partially compatible (possibly restricted functionality).  Note! – This message is only listed in the error history. – Nothing is shown on the display.	Module with lower software version has either to be updated by FieldCare with the required software version or the module has to be replaced.
No. # 2xx → Error in DAT / no communication			
251	S: COMMUNICATION I/O ⚡: # 251	Internal communication fault on the amplifier board.	Replace the amplifier board.
261	S: COMMUNICATION I/O ⚡: # 261	No data reception between amplifier and I/O board or faulty internal data transfer.	Check the BUS contacts.

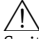No.	Error message / Type	Cause	Remedy (spare part → 87)
No. # 3xx → System limits exceeded			
321	S: TOL. COIL CURR. !: # 321	Sensor: Coil current is out of tolerance.	 Warning! Switch off power supply before manipulating the coil current cable, coil current cable connector or measuring electronics boards! Remote version: <ol style="list-style-type: none"> 1. Check wiring of terminals 41/42 → 44 2. Check coil current cable connector. Compact and remote version: Replace measuring electronics boards if necessary
339 to 342	S: STACK CUR OUT n !: # 339 to 342	The temporarily buffered flow portions (measuring mode for pulsating flow) could not be cleared or output within 60 seconds.	<ol style="list-style-type: none"> 1. Change the upper or lower limit setting, as applicable. 2. Increase or reduce flow, as applicable. Recommendations in the event of fault category = FAULT MESSAGE (!) <ul style="list-style-type: none"> ■ Configure the fault response of the output to "ACTUAL VALUE" so that the temporary buffer can be cleared. ■ Clear the temporary buffer by the measures described under Item 1.
343 to 346	S: STACK FREQ. OUT n !: # 343 to 346		
347 to 350	S: STACK PULSE OUT n !: # 343 to 346	The temporarily buffered flow portions (measuring mode for pulsating flow) could not be cleared or output within 60 seconds.	<ol style="list-style-type: none"> 1. Increase the setting for pulse weighting 2. Increase the max. pulse frequency if the totalizer can handle a higher number of pulses. 3. Increase or reduce flow, as applicable. Recommendations in the event of fault category = FAULT MESSAGE (!) <ul style="list-style-type: none"> ■ Configure the fault response of the output to "ACTUAL VALUE" so that the temporary buffer can be cleared. ■ Clear the temporary buffer by the measures described under Item 1.
351 to 354	S: CURRENT RANGE n !: # 351 to 354	Current output: flow is out of range.	<ol style="list-style-type: none"> 1. Change the upper or lower limit setting, as applicable. 2. Increase or reduce flow, as applicable.
355 to 358	S: FREQ. RANGE n !: # 355 to 358	Frequency output: flow is out of range.	<ol style="list-style-type: none"> 1. Change the upper or lower limit setting, as applicable. 2. Increase or reduce flow, as applicable.
359 to 362	S: PULSE RANGE !: # 359 to 362	Pulse output: the pulse output frequency is out of range.	<ol style="list-style-type: none"> 1. Increase the setting for pulse weighting 2. When selecting the pulse width, choose a value that can still be processed by a connected counter (e.g. mechanical counter, PLC etc.). <i>Determine the pulse width:</i> <ul style="list-style-type: none"> – Variant 1: Enter the minimum duration that a pulse must be present at the connected counter to ensure its registration. – Variant 2: Enter the maximum (pulse) frequency as the half "reciprocal value" that a pulse must be present at the connected counter to ensure its registration. Example: The maximum input frequency of the connected counter is 10 Hz. The pulse width to be entered is: $\frac{1}{2 \cdot 10 \text{ Hz}} = 50 \text{ ms}$ 3. Reduce flow.

a0004437

No.	Error message / Type	Cause	Remedy (spare part → 87)
No. # 5xx → Application error			
501	S: SW.-UPDATE ACT. !: # 501	New amplifier or communication (I/O module) software version is loaded. Currently no other functions are possible.	Wait until the procedure is finished. The device will restart automatically.
502	S: UP-/DOWNLOAD ACT !: # 502	Uploading or downloading the device data via operating program. Currently no other functions are possible.	Wait until the procedure is finished.
No. # 6xx → Simulation mode active			
601	S: POS. ZERO-RETURN !: # 601	Positive zero return active  Caution! This message has the highest display priority!	Switch off positive zero return
611 to 614	S: SIM. CURR. OUT. n !: # 611 to 614	Simulation current output active	
621 to 624	S: SIM. FREQ. OUT. n !: # 621 to 624	Simulation frequency output active	Switch off simulation
631 to 634	S: SIM. PULSE n !: # 631 to 634	Simulation pulse output active	Switch off simulation
641 to 644	S: SIM. STAT. OUT n !: # 641 to 644	Simulation status output active	Switch off simulation
671 to 674	S: SIM. STATUS IN n !: # 671 to 674	Simulation status input active	Switch off simulation
691	S: SIM. FAILSAFE !: # 691	Simulation of response to error (outputs) active	Switch off simulation
692	S: SIM. MEASURAND !: # 692	Simulation of a measured variable active (e.g. mass flow).	Switch off simulation
698	S: DEV. TEST ACT. !: # 698	The measuring device is being checked on site via the test and simulation device.	–

9.3 Process error messages



Note!

Also observe the information on → 62.

No.	Error message / Type	Cause	Remedy (spare part → 87)
P = Process error ⚡ = Fault message (with an effect on the outputs) ! = Notice message (without an effect on the outputs)			
401	EMPTY PIPE ⚡: # 401	Measuring tube partially filled or empty	1. Check the process conditions of the plant 2. Fill the measuring tube
461	ADJ. NOT OK !: # 461	EPD calibration not possible because the fluid's conductivity is either too low or too high.	The EPD function cannot be used with fluids of this nature.
463	FULL = EMPTY ⚡: # 463	The EPD calibration values for empty pipe and full pipe are identical, therefore incorrect.	Repeat calibration, making sure procedure is correct → 74.

9.4 Process errors without messages

Symptoms	Rectification
Remark: You may have to change or correct certain settings in functions in the function matrix in order to rectify the fault.	
Flow values are negative, even though the fluid is flowing forwards through the pipe.	<ol style="list-style-type: none"> Remote version: <ul style="list-style-type: none"> Switch off the power supply and check the wiring → 44 If necessary, reverse the connections at terminals 41 and 42 Change the setting in the "INSTALLATION DIRECTION SENSOR" function accordingly
Measured-value reading fluctuates even though flow is steady.	<ol style="list-style-type: none"> Check grounding and potential equalization → 54 Check the fluid for presence of gas bubbles. In the "SYSTEM DAMPING" function → increase the value
Measured-value reading shown on display, even though the fluid is at a standstill and the measuring tube is full.	<ol style="list-style-type: none"> Check grounding and potential equalization → 54 Check the fluid for presence of gas bubbles. Activate the "LOW FLOW CUTOFF" function, i.e. enter or increase the value for the switching point.
Measured-value reading on display, even though measuring tube is empty.	<ol style="list-style-type: none"> Perform empty-pipe/full-pipe adjustment and then switch on Empty Pipe detection → 74 Remote version: Check the terminals of the EPD cable → 44 Fill the measuring tube.
The current output signal is always 4 mA, irrespective of the flow signal at any given time.	<ol style="list-style-type: none"> Select the "BUS ADDRESS" function and change the setting to "0". Value for creepage too high. Reduce the value in the "LOW FLOW CUTOFF" function.
<p>The fault cannot be rectified or some other fault not described above has arisen.</p> <p>In these instances, please contact your Endress+Hauser service organization.</p>	<p>The following options are available for tackling problems of this nature:</p> <p>Request the services of an Endress+Hauser service technician If you contact our service organization to have a service technician sent out, please be ready to quote the following information:</p> <ul style="list-style-type: none"> Brief description of the fault Nameplate specifications (→ 7): order code, serial number <p>Returning devices to Endress+Hauser The necessary procedures (→ 6) must be carried out before you return a flowmeter requiring repair or calibration to Endress+Hauser. Always enclose a duly completed "Declaration of Conformity" form with the flowmeter. You will find a master copy of this form at the back of this manual.</p> <p>Replace transmitter electronics Components in the measuring electronics defective → order spare parts → 77</p>


9.5 Response of outputs to errors



Note!

The failsafe mode of totalizers, current, pulse and frequency outputs can be customized by means of various functions in the function matrix. You will find detailed information on these procedures in the "Description of Device Functions" manual.

You can use positive zero return to set the signals of the current, pulse and status outputs to their fallback value, for example when measuring has to be interrupted while a pipe is being cleaned. This function takes priority over all other device functions: simulations, for example, are suppressed.

Failsafe mode of outputs and totalizers		
	Process/system error is current	Positive zero return is activated
 Caution! System or process errors defined as "Notice messages" have no effect whatsoever on the inputs and outputs. See the information on → 65		
Current output	MINIMUM VALUE 0–20 mA → 0 mA 4–20 mA → 2 mA 4–20 mA HART → 2 mA 4–20 mA NAMUR → 3.5 mA 4–20 mA HART NAMUR → 3.5 mA 4–20 mA US → 3.75 mA 4–20 mA HART US → 3.75 mA 0–20 mA (25 mA) → 0 mA 4–20 mA (25 mA) → 2 mA 4–20 mA (25 mA) HART → 2 mA MAXIMUM VALUE 0–20 mA → 22 mA 4–20 mA → 22 mA 4–20 mA HART → 22 mA 4–20 mA NAMUR → 22.6 mA 4–20 mA HART NAMUR → 22.6 mA 4–20 mA US → 22.6 mA 4–20 mA HART US → 22.6 mA 0–20 mA (25 mA) → 25 mA 4–20 mA (25 mA) → 25 mA 4–20 mA (25 mA) HART → 25 mA HOLD VALUE Last valid value (preceding occurrence of the fault) is output. ACTUAL VALUE Measured value display on the basis of the current flow measurement. The fault is ignored.	Output signal corresponds to "zero flow"
Pulse output	MIN/MAX VALUE → FALLBACK VALUE Signal output → no pulses HOLD VALUE Last valid value (preceding occurrence of the fault) is output. ACTUAL VALUE Fault is ignored, i.e. normal measured-value output on the basis of ongoing flow measurement.	Output signal corresponds to "zero flow"

Failsafe mode of outputs and totalizers		
	Process/system error is current	Positive zero return is activated
Frequency output	<p><i>FALLBACK VALUE</i> Signal output → 0 Hz</p> <p><i>FAILSAFE LEVEL</i> Output of the frequency specified in the FAILSAFE VALUE function.</p> <p><i>HOLD VALUE</i> Measured value display on the basis of the last saved value preceding occurrence of the fault.</p> <p><i>ACTUAL VALUE</i> Measured value display on the basis of the current flow measurement. The fault is ignored.</p>	Output signal corresponds to "zero flow"
Totalizer	<p><i>STOP</i> The totalizers are paused until the error is rectified.</p> <p><i>ACTUAL VALUE</i> The fault is ignored. The totalizer continues to count in accordance with the current flow value.</p> <p><i>HOLD VALUE</i> The totalizer continues to count the flow in accordance with the last valid flow value (before the error occurred).</p>	Totalizer stops
Status output	In the event of a fault or power supply failure: Status output → non-conductive	No effect on status output

9.6 Spare parts

Detailed troubleshooting instructions are provided in the previous sections → 80

The measuring device, moreover, provides additional support in the form of continuous self-diagnosis and error messages.

Fault rectification can entail replacing defective components with tested spare parts. The illustration below shows the available scope of spare parts.



Note!

You can order spare parts directly from your Endress+Hauser service organization by providing the serial number printed on the transmitter's nameplate → 7

Spare parts are shipped as sets comprising the following parts:

- Spare part
- Additional parts, small items (threaded fasteners, etc.)
- Mounting instructions
- Packaging

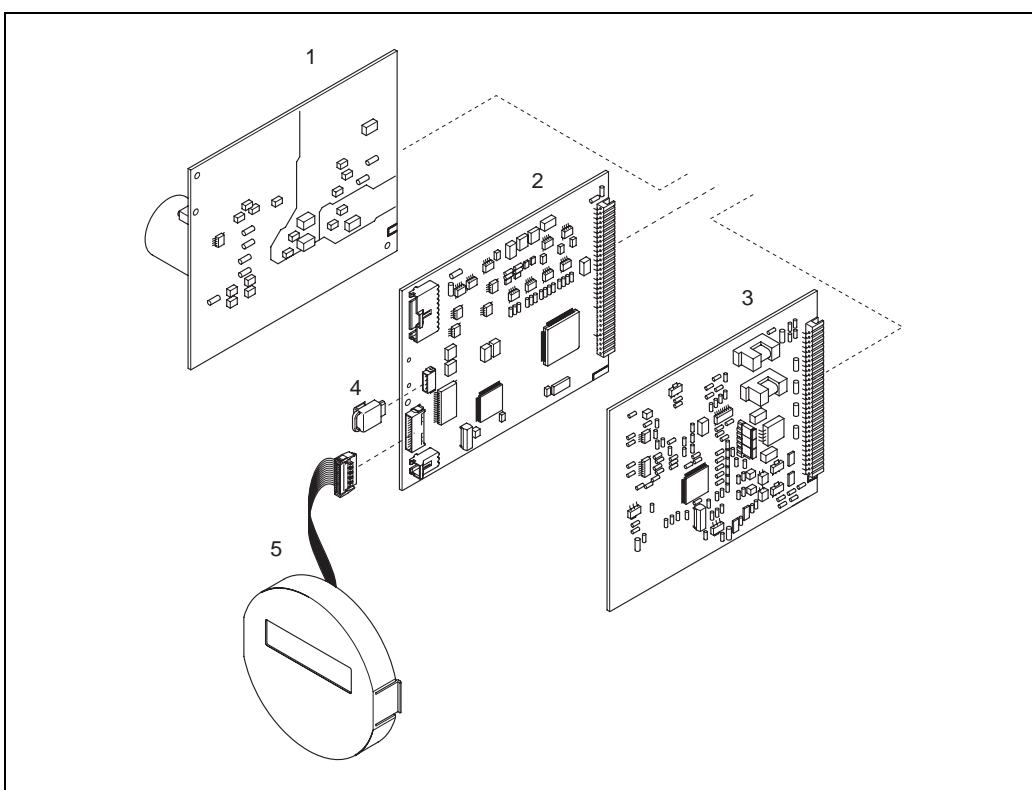


Fig. 52: Spare parts for Promag 50 transmitter (field and wall-mounted housings)

- 1 Power unit board (85 to 260 V AC, 20 to 55 V AC, 16 to 62 V DC)
- 2 Amplifier board
- 3 I/O board (COM module)
- 4 HistoROM / S-DAT (sensor data memory)
- 5 Display module

9.6.1 Removing and installing printed circuit boards

Field housing: removing and installing printed circuit boards → 53



Warning!

■ Risk of electric shock!

Exposed components carry dangerous voltages. Make sure that the power supply is switched off before you remove the cover of the electronics compartment.

■ Risk of damaging electronic components (ESD protection). Static electricity can damage electronic components or impair their operability. Use a workplace with a grounded working surface purpose-built for electrostatically sensitive devices!

■ If you cannot guarantee that the dielectric strength of the device is maintained in the following steps, then an appropriate inspection must be carried out in accordance with the manufacturer's specifications.

■ When connecting Ex-certified devices, see the notes and diagrams in the Ex-specific supplement to these Operating Instructions.



Caution!

Use only original Endress+Hauser parts.

1. Switch off power supply.
2. Unscrew cover of the electronics compartment from the transmitter housing.
3. Remove the local display (1) as follows:
 - Press in the latches (1.1) at the side and remove the display module.
 - Disconnect the ribbon cable (1.2) of the display module from the amplifier board.
4. Remove the screws and remove the cover (2) from the electronics compartment.
5. Remove the boards (4, 6): Insert a suitable tool into the hole (3) provided for the purpose and pull the board clear of its holder.
6. Remove amplifier board (5):
 - Disconnect the plug of the electrode signal cable (5.1) including S-DAT (5.3) from the board.
 - Loosen the plug locking of the coil current cable (5.2) and gently disconnect the plug from the board, i.e. without moving it to and fro.
 - Insert a thin pin into the hole (3) provided for the purpose and pull the board clear of its holder.
7. Installation is the reverse of the removal procedure.

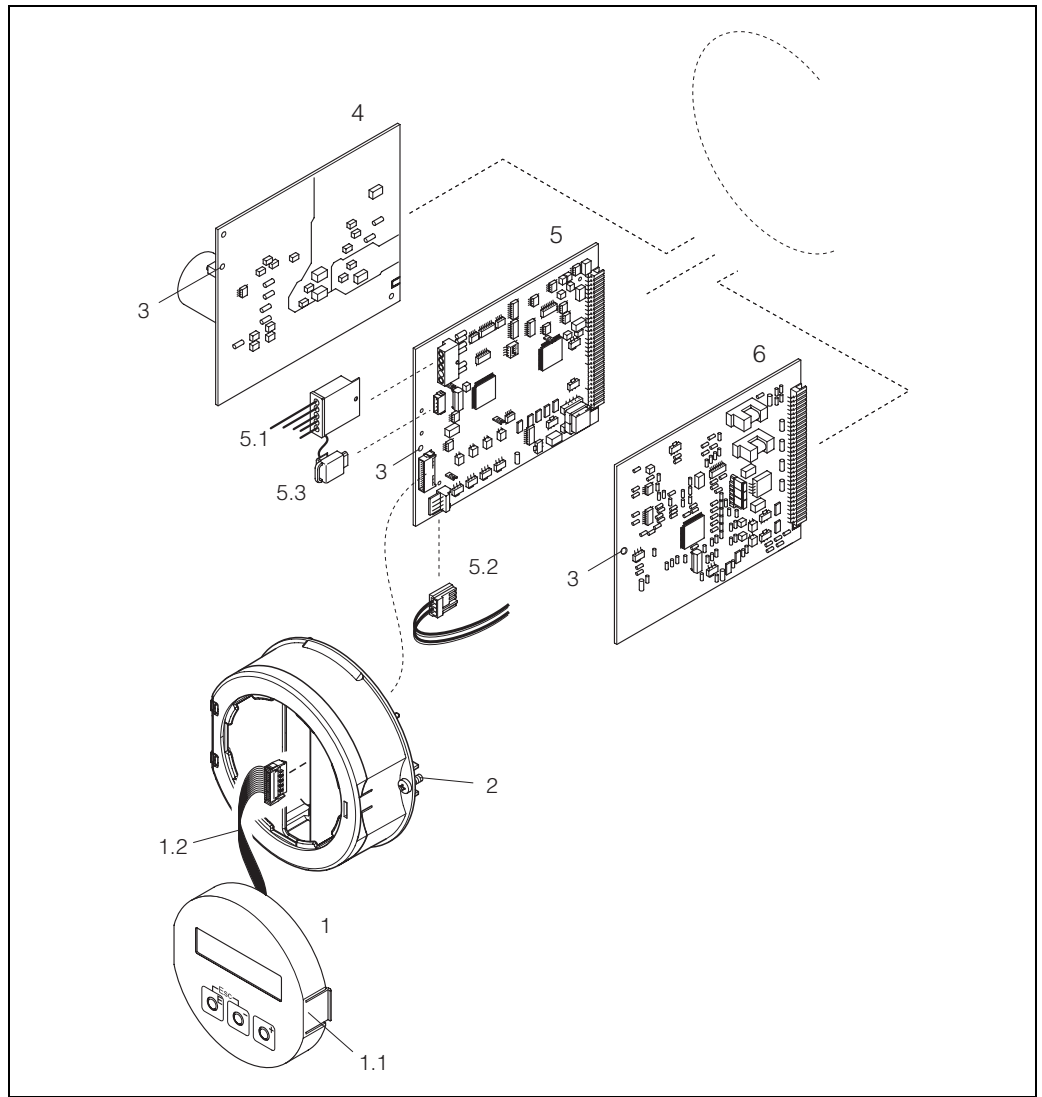


Fig. 53: Field housing: removing and installing printed circuit boards

- 1 Local display
- 1.1 Latch
- 1.2 Ribbon cable (display module)
- 2 Screws of electronics compartment cover
- 3 Aperture for installing/removing boards
- 4 Power supply board
- 5 Amplifier board
- 5.1 Electrode signal cable (sensor)
- 5.2 Coil current cable (sensor)
- 5.3 Histo-ROM / S-DAT (sensor data memory)
- 6 I/O board

Wall-mount housing: removing and installing printed circuit boards → 91**Warning!**

■ Risk of electric shock!

Exposed components carry dangerous voltages. Make sure that the power supply is switched off before you remove the cover of the electronics compartment.

■ Risk of damaging electronic components (ESD protection). Static electricity can damage electronic components or impair their operability. Use a workplace with a grounded working surface purpose-built for electrostatically sensitive devices!

■ If you cannot guarantee that the dielectric strength of the device is maintained in the following steps, then an appropriate inspection must be carried out in accordance with the manufacturer's specifications.

■ When connecting Ex-certified devices, see the notes and diagrams in the Ex-specific supplement to these Operating Instructions.

**Caution!**

Use only original Endress+Hauser parts.

1. Switch off power supply.
2. Remove the screws and open the hinged cover (1) of the housing. Remove screws of the electronics module (2).
3. Then push up electronics module and pull it as far as possible out of the wall-mounted housing.
4. Disconnect the following cable plugs from amplifier board (7):
 - Electrode signal cable plug (7.1) including S-DAT (7.3).
 - Plug of coil current cable (7.2). To do so, loosen the plug locking of the coil current cable and gently disconnect the plug from the board, i.e. without moving it to and fro.
 - Ribbon cable plug (3) of the display module.
5. Remove the screws and remove the cover (4) from the electronics compartment.
6. Remove the boards (6, 7, 8): Insert a suitable tool into the hole (5) provided for the purpose and pull the board clear of its holder.
7. Installation is the reverse of the removal procedure.

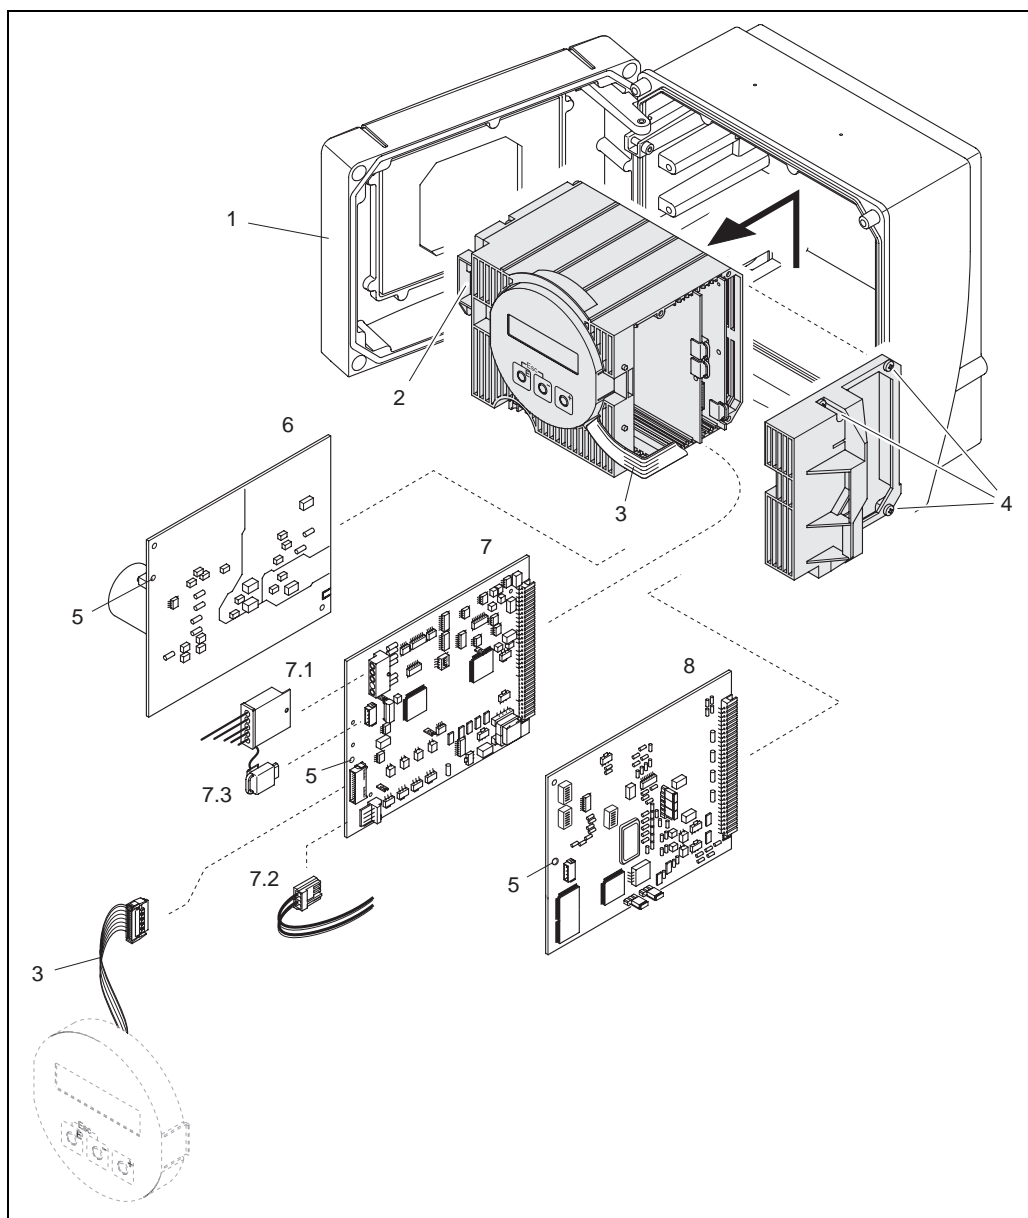


Fig. 54: Wall-mount housing: removing and installing printed circuit boards

- 1 Housing cover
- 2 Electronics module
- 3 Ribbon cable (display module)
- 4 Cover of electronics compartment (3 screws)
- 5 Aperture for installing/removing boards
- 6 Power supply board
- 7 Amplifier board
- 7.1 Electrode signal cable (sensor)
- 7.2 Coil current cable (sensor)
- 7.3 Histo-ROM / S-DAT (sensor data memory)
- 8 I/O board

9.6.2 Replacing the device fuse



Warning!

Risk of electric shock! Exposed components carry dangerous voltages. Make sure that the power supply is switched off before you remove the cover of the electronics compartment.

The main fuse is on the power supply board (→ 92).

The procedure for replacing the fuse is as follows:

1. Switch off power supply.
2. Remove the power supply board: field housing → 88, wall-mount housing → 90
3. Remove cap (1) and replace the device fuse (2).
Use only fuses of the following type:
 - Power supply 20 to 55 V AC / 16 to 62 V DC → 2.0 A slow-blow / 250 V; 5.2 × 20 mm
 - Power supply 85 to 260 V AC → 0.8 A slow-blow / 250 V; 5.2 × 20 mm
 - Ex-rated devices → see the Ex documentation.
4. Installation is the reverse of the removal procedure.



Caution!

Use only original Endress+Hauser parts.

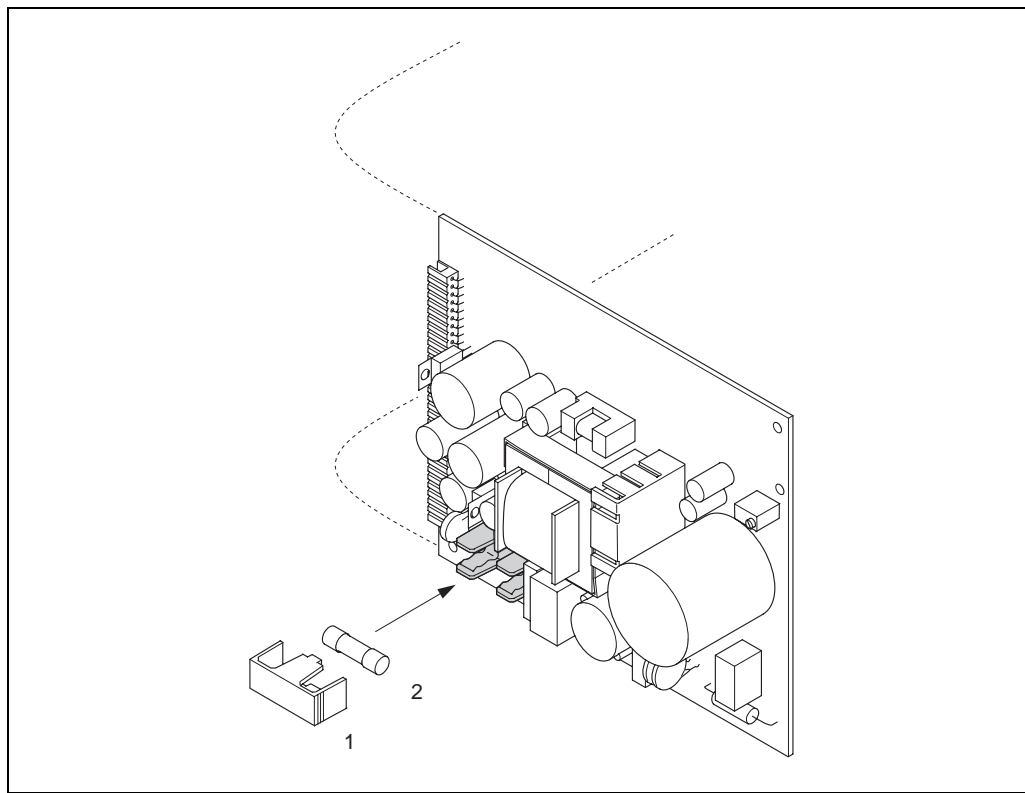


Fig. 55: Replacing the device fuse on the power supply board

- 1 Protective cap
2 Device fuse

9.6.3 Replacing the exchangeable electrode

The Promag W sensor (DN 350 to 2000; 14" to 78") is available with exchangeable measuring electrodes as an option. This design permits the measuring electrodes to be replaced or cleaned under process conditions.

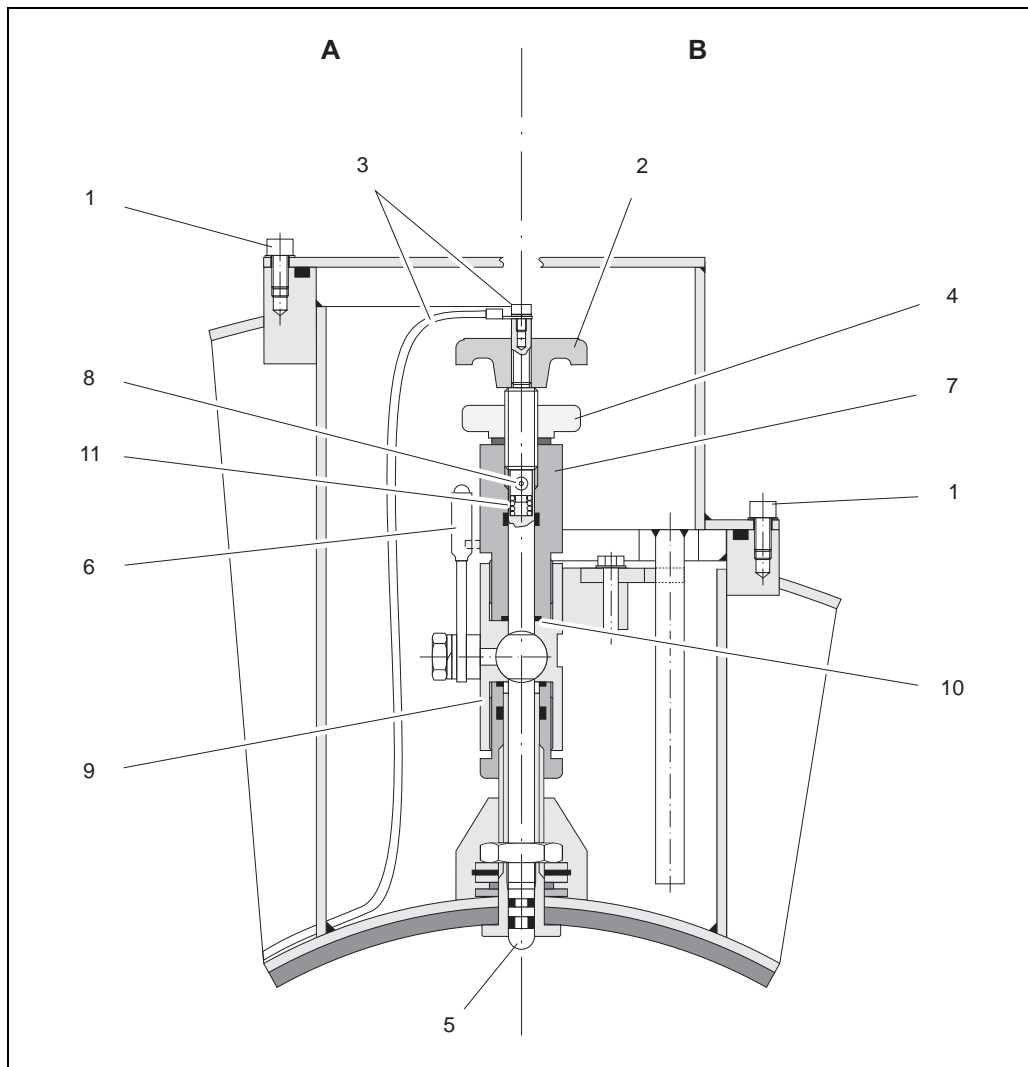

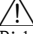





Fig. 56: Apparatus for replacing exchangeable measuring electrodes

View A = DN 1200 to 2000 (48" to 78")

View B = DN 350 to 1050 (14" to 42")

- 1 Allen screw
- 2 Handle
- 3 Electrode cable
- 4 Knurled nut (locknut)
- 5 Measuring electrode
- 6 Stop cock (ball valve)
- 7 Retaining cylinder
- 8 Locking pin (for handle)
- 9 Ball-valve housing
- 10 Seal (retaining cylinder)
- 11 Coil spring

Removing the electrode	Installing the electrode
1 Loosen Allen screw (1) and remove the cover.	1 Insert new electrode (5) into retaining cylinder (7) from below. Make sure that the seals at the tip of the electrode are clean.
2 Remove electrode cable (3) secured to handle (2).	2 Mount handle (2) on the electrode and insert locking pin (8) to secure it in position.  Caution! Make sure that coil spring (11) is inserted. This is essential to ensure correct electrical contact and correct measuring signals.
3 Loosen knurled nut (4) by hand. This knurled nut acts as a locknut.	3 Pull the electrode back until the tip of the electrode no longer protrudes from retaining cylinder (7).
4 Remove electrode (5) by turning handle (2). The electrode can now be pulled out of retaining cylinder (7) as far as a defined stop.  Warning! Risk of injury. Under process conditions (pressure in the piping system) the electrode can recoil suddenly against its stop. Apply counter-pressure while releasing the electrode.	4 Screw the retaining cylinder (7) onto ball-valve housing (9) and tighten it by hand. Seal (10) on the cylinder must be correctly seated and clean.  Note! Make sure that the rubber hoses on retaining cylinder (7) and stop cock (6) are of the same color (red or blue).
5 Close stop cock (6) after pulling out the electrode as far as it will go.  Warning! Do not subsequently open the stop cock, in order to prevent fluid escaping.	5 Open stop cock (6) and turn handle (2) to screw the electrode all the way into the retaining cylinder.
6 Remove the electrode complete with retaining cylinder (7).	6 Screw knurled nut (4) onto the retaining cylinder. This firmly locates the electrode in position.
7 Remove handle (2) from electrode (5) by pressing out locking pin (8). Take care not to lose coil spring (11).	7 Use the Allen screw to secure electrode cable (3) to handle (2).  Caution! Make sure that the machine screw securing the electrode cable is firmly tightened. This is essential to ensure correct electrical contact and correct measuring signals.
8 Remove the old electrode and insert the new electrode. Replacement electrodes can be ordered separately from Endress+Hauser.	8 Reinstall the cover and tighten Allen screw (a).

9.7 Return



Caution!

Do not return a measuring device if you are not absolutely certain that all traces of hazardous substances have been removed, e.g. substances which have penetrated crevices or diffused through plastic.

Costs incurred for waste disposal and injury (burns, etc.) due to inadequate cleaning will be charged to the owner-operator.

The following steps must be taken before returning a flow measuring device to Endress+Hauser, e.g. for repair or calibration:

- Always enclose a duly completed "Declaration of contamination" form. Only then can Endress+Hauser transport, examine and repair a returned device.
- Enclose special handling instructions if necessary, for example a safety data sheet as per EC REACH Regulation No. 1907/2006.
- Remove all residues. Pay special attention to the grooves for seals and crevices which could contain residues. This is particularly important if the substance is hazardous to health, e.g. flammable, toxic, caustic, carcinogenic, etc.



Note!

You will find a preprinted "Declaration of contamination" form at the back of these Operating Instructions.

9.8 Disposal

Observe the regulations applicable in your country!

9.9 Software history

Date	Software version	Changes to software	Operating Instructions
11.2009	Amplifier: V 2.03.XX	Introduction of Calf history	71106181 / 12.09 71105332 / 11.09
06.2009	Amplifier: V 2.02.XX	Introduction of Promag L	71095684 / 06.09
03.2009	Amplifier: V 2.02.XX	Introduction of Promag D Introduction of new nominal diameter	71088677 / 03.09
11.2004	Amplifier: 1.06.01 Communication module: 1.04.00	Software update relevant only for production	50097089 / 10.03
10.2003	Amplifier: 1.06.00 Communication module: 1.03.00	Software expansion: <ul style="list-style-type: none"> ■ Language groups ■ Flow direction pulse output selectable New functionalities: <ul style="list-style-type: none"> ■ Second Totalizer ■ Adjustable backlight (display) ■ Operation hours counter ■ Simulation function for pulse output ■ Counter for access code ■ Reset function (fault history) ■ Up-/download with FieldTool 	50097089 / 10.03

Date	Software version	Changes to software	Operating Instructions
08.2003	Communication module: 1.02.01	Software expansion: <ul style="list-style-type: none"> ■ New / revised functionalities New functionalities: <ul style="list-style-type: none"> ■ Current span NAMUR NE 43 ■ Failsafe mode function ■ Troubleshooting function ■ System and process error messages ■ Response of status output 	50097089 / 08.03
08.2002	Amplifier: 1.04.00	Software expansion: <ul style="list-style-type: none"> ■ New / revised functionalities New functionalities: <ul style="list-style-type: none"> ■ Current span NAMUR NE 43 ■ EPD (new mode) ■ Failsafe mode function ■ Acknowledge fault function ■ Troubleshooting function ■ System and process error messages ■ Response of status output 	50097089 / 08.02
03.2002	Amplifier: 1.03.00	Software expansion: <ul style="list-style-type: none"> ■ Suitability for custody transfer measurement Promag 50/51 	none
06.2001	Amplifier: 1.02.00 Communication module: 1.02.00	Software expansion: <ul style="list-style-type: none"> ■ New functionalities: New functionalities: <ul style="list-style-type: none"> ■ General device functions ■ "OED" software function ■ "Pulse width" software function 	50097089 / 06.01
09.2000	Amplifier: 1.01.01 Communication module: 1.01.00	Software expansion: <ul style="list-style-type: none"> ■ Functional adaptations 	none
08.2000	Amplifier: 1.01.00	Software expansion: <ul style="list-style-type: none"> ■ Functional adaptations 	none
04.2000	Amplifier: 1.00.00 Communication module: 1.00.00	Original software Compatible with: <ul style="list-style-type: none"> ■ FieldTool ■ Commuwin II (version 2.05.03 and higher) ■ HART Communicator DXR 275 (from OS 4.6) with Rev. 1, DD1 	50097089 / 04.00

**Note!**

Uploads or downloads between the individual software versions are only possible with a special service software.

10 Technical data

10.1 Technical data at a glance

10.1.1 Application

→ 5

10.1.2 Function and system design

Measuring principle	Electromagnetic flow measurement on the basis of Faraday's Law.
---------------------	---

Measuring system	→ 7
------------------	-----

10.1.3 Input

Measured variable	Flow velocity (proportional to induced voltage)
-------------------	---

Measuring range	Typically $v = 0.01$ to 10 m/s (0.033 to 33 ft/s) with the specified accuracy
-----------------	--

Operable flow range	Over $1000 : 1$
---------------------	-----------------

Input signal	<i>Status input (auxiliary input)</i> <ul style="list-style-type: none"> ■ Galvanically isolated ■ $U = 3$ to 30 V DC ■ $R_i = 5$ kΩ ■ Can be configured for: totalizer reset, positive zero return, error message reset.
--------------	--

10.1.4 Output




Output signal	<i>Current output</i> <ul style="list-style-type: none"> ■ Galvanically isolated ■ Active/passive can be selected: <ul style="list-style-type: none"> – Active: $0/4$ to 20 mA, $R_L < 700$ Ω (HART: $R_L \geq 250$ Ω) – Passive: 4 to 20 mA, supply voltage V_S 18 to 30 V DC, $R_i \geq 150$ Ω) ■ Time constant can be selected (0.01 to 100s) ■ Full scale value adjustable ■ Temperature coefficient: typ. 0.005% o.f.s./$^{\circ}\text{C}$, resolution: 0.5 μA <p>o.f.s. = of full scale value</p>
---------------	--

Pulse/frequency output

- Galvanically isolated
- Passive: 30 V DC / 250 mA
- Open collector
- Can be configured as:
 - Pulse output
 - Pulse value and pulse polarity can be selected, max. pulse width adjustable (0.5 to 2000 ms)
 - Frequency output
 - Full scale frequency 2 to 1000 Hz ($f_{\max} = 1.25$ Hz), on/off ratio $1:1$, pulse width max. 10 s.

Signal on alarm	<p><i>Current output</i></p> <p>Failsafe mode can be selected (e.g. in accordance with NAMUR Recommendation NE 43)</p> <p><i>Pulse/frequency output</i></p> <p>Failsafe mode can be selected</p> <p><i>Status output</i></p> <p>"Not conductive" in the event of fault or power supply failure</p>
Load	See "Output signal"
Switching output	<p><i>Status output</i></p> <ul style="list-style-type: none"> ■ Galvanically isolated ■ Max. 30 V DC/250 mA ■ Open collector ■ Can be configured for: error messages, empty pipe detection (EPD), flow direction, limit values
Low flow cut off	Low flow cut off, switch-on point can be selected as required
Galvanic isolation	All circuits for inputs, outputs, and power supply are galvanically isolated from each other.

10.1.5 Power supply

Electrical connections	→  44
Supply voltage (power supply)	<ul style="list-style-type: none"> ■ 85 to 260 V AC, 45 to 65 Hz ■ 20 to 55 V AC, 45 to 65 Hz ■ 16 to 62 V DC
Cable entry	<p><i>Power supply and signal cables (inputs/outputs):</i></p> <ul style="list-style-type: none"> ■ Cable entry M20 × 1.5 (8 to 12 mm/0.31 to 0.47 inch) ■ Sensor cable entry for armored cables M20 × 1.5 (9.5 to 16 mm / 0.37 to 0.63 inch) ■ Threads for cable entries ½" NPT, G ½" <p><i>Connecting cable for remote version:</i></p> <ul style="list-style-type: none"> ■ Cable entry M20 × 1.5 (8 to 12 mm/0.31 to 0.47 inch) ■ Sensor cable entry for armored cables M20 × 1.5 (9.5 to 16 mm / 0.37 to 0.63 inch) ■ Threads for cable entries ½" NPT, G ½"
Cable specifications	→  50
Power consumption	<p><i>Power consumption</i></p> <ul style="list-style-type: none"> ■ AC: <15 VA (incl. sensor) ■ DC: <15 W (incl. sensor) <p><i>Switch-on current</i></p> <ul style="list-style-type: none"> ■ Max 3 A (<5 ms) for 260 V AC ■ Max. 13.5 A (<5 ms) for 24 V DC
Power supply failure	<ul style="list-style-type: none"> ■ Lasting min. 1 cycle frequency: ■ EEPROM saves measuring system data ■ S-DAT: exchangeable data storage chip which stores the data of the sensor (nominal diameter, serial number, calibration factor, zero point etc.)
Potential equalization	→  54

10.1.6 Performance characteristics

Reference operating conditions

To DIN EN 29104 and VDI/VDE 2641:

- Fluid temperature: $+28\text{ °C} \pm 2\text{ K}$
- Ambient temperature: $+22\text{ °C} \pm 2\text{ K}$
- Warm-up period: 30 minutes

Installation:

- Inlet run $>10 \times \text{DN}$
- Outlet run $> 5 \times \text{DN}$
- Sensor and transmitter grounded.
- The sensor is centered in the pipe.

Maximum measured error

- Current output: plus typically $\pm 5\text{ }\mu\text{A}$
- Pulse output: $\pm 0.5\%$ o.r. $\pm 1\text{ mm/s}$
Option: $\pm 0.2\%$ o.r. $\pm 2\text{ mm/s}$ (o.r. = of reading)

Fluctuations in the supply voltage do not have any effect within the specified range.

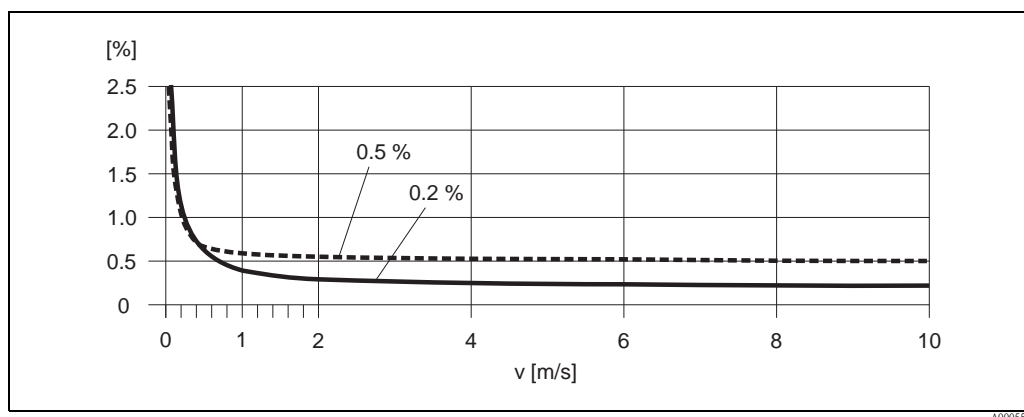


Fig. 57: Max. measured error in % of reading

Repeatability

Max. $\pm 0.1\%$ o.r. $\pm 0.5\text{ mm/s}$ (o.r. = of reading)

10.1.7 Operating conditions: Installation

Installation instructions

Any orientation (vertical, horizontal), restrictions and installation instructions → 13

Inlet and outlet run

If possible, install the sensor upstream from fittings such as valves, T-pieces, elbows, etc. The following inlet and outlet runs must be observed in order to meet accuracy specifications (→ 16, → 12):

- Inlet run: $\geq 5 \times \text{DN}$
- Outlet run: $\geq 2 \times \text{DN}$






Adapters

→ 17

Length of connecting cable

→ 20

10.1.8 Operating conditions: Environment

Ambient temperature range	<ul style="list-style-type: none"> ■ Transmitter: <ul style="list-style-type: none"> – Standard: –20 to +60 °C (–4 to +140 °F) – Optional: –40 to +60 °C (–40 to +140 °F)  Note! At ambient temperatures below –20 (–4 °F) the readability of the display may be impaired. ■ Sensor: <ul style="list-style-type: none"> – Flange material carbon steel: –10 to +60 °C (+14 to +140 °F) – Flange material stainless steel: –40 to +60 °C (–40 to +140 °F)  Caution! <ul style="list-style-type: none"> ■ The permitted temperature range of the measuring tube lining may not be undershot or overshoot (→ "Operating conditions: Process" → "Medium temperature range"). ■ Install the device in a shady location. Avoid direct sunlight, particularly in warm climatic regions. ■ The transmitter must be mounted separate from the sensor if both the ambient and fluid temperatures are high.
Storage temperature	<p>The storage temperature corresponds to the operating temperature range of the measuring transmitter and the appropriate measuring sensors.</p> <p> Caution!</p> <ul style="list-style-type: none"> ■ The measuring device must be protected against direct sunlight during storage in order to avoid unacceptably high surface temperatures. ■ A storage location must be selected where moisture does not collect in the measuring device. This will help prevent fungus and bacteria infestation which can damage the liner.
Degree of protection	<ul style="list-style-type: none"> ■ Standard: IP 67 (NEMA 4X) for transmitter and sensor ■ Optional: IP 68 (NEMA 6P) for remote version of Promag L, W and P sensor. Promag L only with stainless steel flanges.
Shock and vibration resistance	<p>Acceleration up to 2 g following IEC 60068-2-6 (high-temperature version: no data available)</p>
CIP cleaning	<p> Caution! The maximum fluid temperature permitted for the device may not be exceeded.</p> <p><i>CIP cleaning is possible:</i> Promag P, Promag H</p> <p><i>CIP cleaning is not possible:</i> Promag D, Promag L, Promag W</p>
SIP cleaning	<p> Caution! The maximum fluid temperature permitted for the device may not be exceeded.</p> <p><i>SIP cleaning is possible:</i> Promag H</p> <p><i>SIP cleaning is not possible:</i> Promag D, Promag L, Promag W, Promag P</p>
Electromagnetic compatibility (EMC)	<ul style="list-style-type: none"> ■ As per IEC/EN 61326 and NAMUR Recommendation NE 21 ■ Emission: to limit value for industry EN 55011

10.1.9 Operating conditions: Process

Medium temperature range

The permissible temperature depends on the lining of the measuring tube

Promag D

0 to +60 °C (+32 to +140 °F) for polyamide

Promag L

- -20 to +50 °C (-4 to +122 °F) for polyurethane (DN 50 to 300)
- -20 to +90 °C (-4 to +194 °F) for PTFE (DN 50 to 300)

Promag W

- 0 to +80 °C (+32 to +176 °F) for hard rubber (DN 65 to 2000)
- -20 to +50 °C (-4 to +122 °F) for polyurethane (DN 25 to 1200)

Promag P

Standard

- -40 to +130 °C (-40 to +266 °F) for PTFE (DN 15 to 600 / 1/2" to 24"),
Restrictions → see the following diagrams
- -20 to +130 °C (-4 to +266 °F) for PFA/HE (DN 25 to 200 / 1" to 8"),
Restrictions → see the following diagrams
- -20 to +150 °C (-4 to +302 °F) for PFA (DN 25 to 200 / 1" to 8"),
Restrictions → see the following diagrams

Optional

High-temperature version (HT): -20 to +180 °C (-4 to +356 °F) for PFA (DN 25 to 200 / 1" to 8")

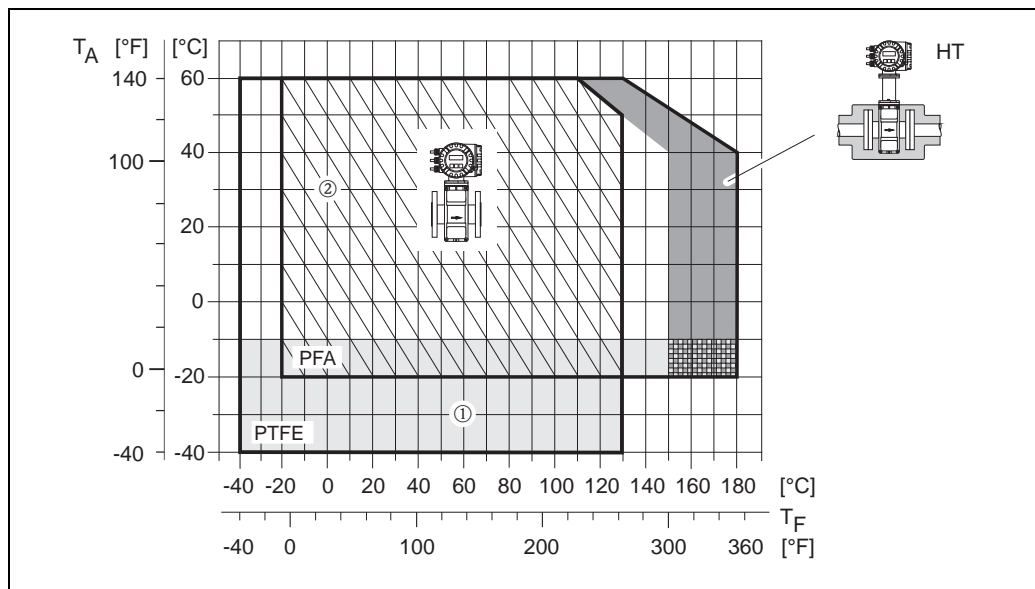


Abb. 58: Compact version Promag P (with PFA- or PTFE-lining)

T_A = ambient temperature; T_F = fluid temperature; HT = high-temperature version with insulation

① = light gray area → temperature range from -10 to -40 °C (-14 to -40 °F) is valid for stainless steel version only

② = diagonal hatched area → foam lining (HE) and degree of protection IP 68 = fluid temperature max. 130°C / 266 °F

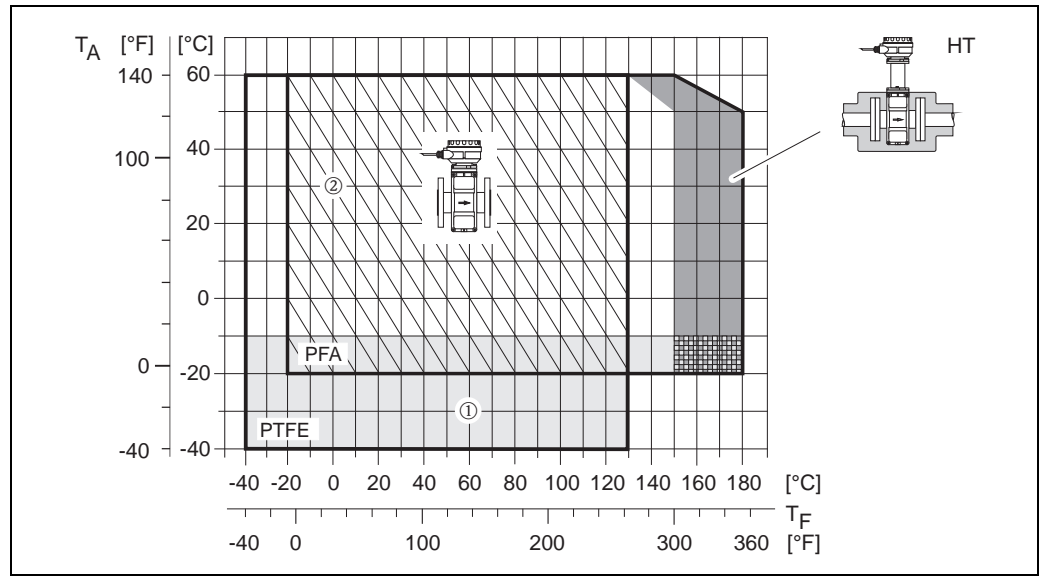


Abb. 59: Remote version Promag P (with PFA- or PTFE-lining)

T_A = ambient temperature; T_F = fluid temperature; HT = high-temperature version with insulation

① = light gray area → temperature range from -10 to -40 °C (-14 to -40 °F) is valid for stainless steel version only

② = diagonal hatched area → foam lining (HE) and degree of protection IP68 = fluid temperature max. 130 °C / 266 °F

Promag H

Sensor:

- DN 2 to 25: -20 to +150 °C (-4 to +302 °F)
- DN 40 to 100: -20 to +150 °C (-4 to +302 °F)

Seals:

- EPDM: -20 to +150 °C (-4 to +302 °F)
- Silicone: -20 to +150 °C (-4 to +302 °F)
- Viton: -20 to +150 °C (-4 to +302 °F)
- Kalrez: -20 to +150 °C (-4 to +302 °F)

Conductivity



The minimum conductivity is $\geq 5 \mu\text{S}/\text{cm}$ ($\geq 20 \mu\text{S}/\text{cm}$ for demineralized water)

Note!

Note that in the case of the remote version, the requisite minimum conductivity is also influenced by the length of the connecting cable → 20

Medium pressure range (nominal pressure)

Promag D

- EN 1092-1 (DIN 2501)
 - PN 16
- ANSI B 16.5
 - Class 150
- JIS B2220
 - 10 K

Promag L

- EN 1092-1 (DIN 2501)
 - PN 10 (DN 50 to 300)
 - PN 16 (DN 50 to 150)
- EN 1092-1, lap joint flange, stampel plate
 - PN 10 (DN 50 to 300)
- ANSI B 16.5
 - Class 150 (2" to 12")

Promag W

- EN 1092-1 (DIN 2501)
 - PN 6 (DN 350 to 2000)
 - PN 10 (DN 200 to 2000)
 - PN 16 (DN 65 to 2000)
 - PN 25 (DN 200 to 1000)
 - PN 40 (DN 25 to 150)
- ANSI B 16.5
 - Class 150 (1" to 24")
 - Class 300 (1" to 6")
- AWWA
 - Class D (28" to 78")
- JIS B2220
 - 10 K (DN 50 to 300)
 - 20 K (DN 25 to 300)
- AS 2129
 - Table E (DN 80, 100, 150 to 1200)
- AS 4087
 - PN 16 (DN 80, 100, 150 to 1200)

Promag P

- EN 1092-1 (DIN 2501)
 - PN 10 (DN 200 to 600)
 - PN 16 (DN 65 to 600)
 - PN 25 (DN 200 to 600)
 - PN 40 (DN 15 to 150)
- ANSI B 16.5
 - Class 150 (½" to 24")
 - Class 300 (½" to 6")
- JIS B2220
 - 10 K (DN 50 to 300)
 - 20 K (DN 15 to 300)
- AS 2129
 - Table E (DN 25, 50)
- AS 4087
 - PN 16 (DN 50)

Promag H

The permissible nominal pressure depends on the process connection and the seal:

- 40 bar → flange, weld nipple (with O-ring seal)
- 16 bar → all other process connections

Pressure tightness

Promag D

Measuring tube: 0 mbar abs (0 psi abs) with a fluid temperature of $\leq 60\text{ °C}$ ($\leq 140\text{ °F}$)

Promag L (Measuring tube lining: Polyurethane)

Promag L Nominal diameter		Resistance of measuring tube lining to partial vacuum Limit values for abs. pressure [mbar] ([psi]) at various fluid temperatures		
[mm]	[inch]	25 °C	50 °C	80 °C
		77 °F	122 °F	176 °F
50 to 300	2 to 12"	0	0	-

Promag L

Measuring tube lining: PTFE

Promag L Nominal diameter		Resistance of measuring tube lining to partial vacuum Limit values for abs. pressure [mbar] ([psi]) at various fluid temperatures			
[mm]	[inch]	25 °C		90 °C	
		77 °F		194 °F	
		[mbar]	[psi]	[mbar]	[psi]
50	2"	0	0	0	0
65	-	0	0	40	0.58
80	3"	0	0	40	0.58
100	4"	0	0	135	1.96
125	-	135	1.96	240	3.48
150	6"	135	1.96	240	3.48
200	8"	200	2.90	290	4.21
250	10"	330	4.79	400	5.80
300	12"	400	5.80	500	7.25

Promag W

Promag W Nominal diameter		Measuring tube lining	Resistance of measuring tube lining to partial vacuum Limit values for abs. pressure [mbar] ([psi]) at various fluid temperatures						
[mm]	[inch]		25 °C	50 °C	80 °C	100 °C	130 °C	150 °C	180 °C
			77 °F	122 °F	176 °F	212 °F	266 °F	302 °F	356 °F
25 to 1200	1 to 48"	Polyurethane	0	0	-	-	-	-	-
65 to 2000	3 to 78"	Hard rubber	0	0	0	-	-	-	-

Promag P

Measuring tube lining: PFA

Promag P Nominal diameter		Resistance of measuring tube lining to partial vacuum Limit values for abs. pressure [mbar] ([psi]) at various fluid temperatures					
[mm]	[inch]	25 °C	80 °C	100 °C	130 °C	150 °C	180 °C
		77 °F	176 °F	212 °F	266 °F	302 °F	356 °F
25	1"	0	0	0	0	0	0
32	-	0	0	0	0	0	0
40	1 ½"	0	0	0	0	0	0
50	2"	0	0	0	0	0	0
65	-	0	*	0	0	0	0
80	3"	0	*	0	0	0	0
100	4"	0	*	0	0	0	0

Promag P Nominal diameter		Resistance of measuring tube lining to partial vacuum Limit values for abs. pressure [mbar] ([psi]) at various fluid temperatures					
[mm]	[inch]	25 °C	80 °C	100 °C	130 °C	150 °C	180 °C
		77 °F	176 °F	212 °F	266 °F	302 °F	356 °F
125	–	0	*	0	0	0	0
150	6"	0	*	0	0	0	0
200	8"	0	*	0	0	0	0
* No value can be quoted.							

Promag P
Measuring tube lining: PTFE

Promag P		Resistance of measuring tube lining to partial vacuum								
Nominal diameter		Limit values for abs. pressure [mbar] ([psi]) at various fluid temperatures								
[mm]	[inch]	25 °C		80° C	100 °C		130 °C		150 °C	180 °C
		77 °F		176° F	212 °F		266 °F		302 °F	356 °F
		[mbar]	[psi]		[mbar]	[psi]	[mbar]	[psi]		
15	½"	0	0	0	0	0	100	1.45	–	–
25	1"	0	0	0	0	0	100	1.45	–	–
32	–	0	0	0	0	0	100	1.45	–	–
40	1 ½"	0	0	0	0	0	100	1.45	–	–
50	2"	0	0	0	0	0	100	1.45	–	–
65	–	0	0	*	40	0.58	130	1.89	–	–
80	3"	0	0	*	40	0.58	130	1.89	–	–
100	4"	0	0	*	135	1.96	170	2.47	–	–
125	–	135	1.96	*	240	3.48	385	5.58	–	–
150	6"	135	1.96	*	240	3.48	385	5.58	–	–
200	8"	200	2.90	*	290	4.21	410	5.95	–	–
250	10"	330	4.79	*	400	5.80	530	7.69	–	–
300	12"	400	5.80	*	500	7.25	630	9.14	–	–
350	14"	470	6.82	*	600	8.70	730	10.59	–	–
400	16"	540	7.83	*	670	9.72	800	11.60	–	–
450	18"	Partial vacuum is impermissible!								
500	20"									
600	24"									
* No value can be quoted.										

Promag H (Measuring tube lining: PFA)

Promag H Nominal diameter		Resistance of measuring tube lining to partial vacuum Limit values for abs. pressure [mbar] ([psi]) at various fluid temperatures					
[mm]	[inch]	25 °C	80 °C	100 °C	130 °C	150 °C	180 °C
		77 °F	176 °F	212 °F	266 °F	302 °F	356 °F
2 to 100	1/12 to 4"	0	0	0	0	0	0

Limiting flow

→ 18

Pressure loss

- No pressure loss if the sensor is installed in a pipe of the same nominal diameter (Promag H: only DN 8 and larger).
- Pressure losses for configurations incorporating adapters according to DIN EN 545 (see "Adapters" → 17)

10.1.10 Mechanical construction

Design, dimensions

The dimensions and installation lengths of the sensor and transmitter can be found in the "Technical Information" for the device in question. This document can be downloaded as a PDF file from www.endress.com. A list of the "Technical Information" documents available is provided in the "Documentation" section on → 116.

Weight (SI units)

Promag D

Weight data of Promag D in kg				
Nominal diameter		Compact version	Remote version (without cable)	
[mm]	[inch]		Sensor	Transmitter
25	1"	4.5	2.5	6.0
40	1 ½"	5.1	3.1	6.0
50	2"	5.9	3.9	6.0
65	2 ½"	6.7	4.7	6.0
80	3"	7.7	5.7	6.0
100	4"	10.4	8.4	6.0
Transmitter Promag (compact version): 3.4 kg (Weight data valid without packaging material)				

Promag L (lap joint flanges)

Weight data of Promag L in kg										
Nominal diameter		Compact version				Remote version (without cable)				
						Sensor				Transmitter
[mm]	[inch]	EN (DIN)		ANSI		EN (DIN)		ANSI		
50	2"	PN 16	10.6	Class 150	10.6	PN 16	8.6	Class 150	8.6	6.0
65	2 ½"		12.0		–		10.0		–	6.0
80	3"		14.0		14.0		12.0		12.0	6.0
100	4"		16.0		16.0		14.0		14.0	6.0
125	5"		21.5		–		19.5		–	6.0
150	6"		25.5		25.5		23.5		23.5	6.0
200	8"	PN 10	45		45	PN 10	43		43	6.0
250	10"		65		65		63		73	6.0
300	12"		70		–		68		–	6.0
Transmitter Promag (compact version): 3.4 kg (Weight data valid for standard pressure ratings and without packaging material)										

Promag L (lap joint flanges, stamped plate)

Weight data of Promag L in kg						
Nominal diameter		Compact version		Remote version (without cable)		
[mm]	[inch]	EN (DIN)		Sensor EN (DIN)		Transmitter
50	2"	PN 10	7.2	PN 10	5.2	6.0
65	2 ½"		8.0		6.0	6.0
80	3"		9.0		7.0	6.0
100	4"		11.5		9.5	6.0
125	5"		15.0		13.0	6.0
150	6"		19.0		17.0	6.0
200	8"		37.5		35.5	6.0
250	10"		56.0		54.0	6.0
300	12"		57.0		55.0	6.0
Transmitter Promag (compact version): 3.4 kg (Weight data valid for standard pressure ratings and without packaging material)						

Promag W

Weight data of Promag W in kg															
Nominal diameter		Compact version				Remote version (without cable)									
[mm]	[inch]	EN (DIN) / AS*		JIS		ANSI / AWWA		EN (DIN) / AS*		Sensor		ANSI / AWWA	Transmitter		
25	1"	PN 40	7.3	10K	7.3	7.3	PN 40	5.3	10K	5.3	150	5.3	6.0		
32	1 ¼"		8.0		7.3			–		6.0		5.3	–	6.0	
40	1 ½"		9.4		8.3			9.4		7.4		6.3	7.4	6.0	
50	2"		10.6		9.3			10.6		8.6		7.3	8.6	6.0	
65	2 ½"	PN 16	12.0	10K	11.1	Class 150	PN 16	10.0	10K	9.1	150	–	6.0		
80	3"		14.0		12.5			14.0		12.0		10.5	12.0	6.0	
100	4"		16.0		14.7			16.0		14.0		12.7	14.0	6.0	
125	5"		21.5		21.0			–		19.5		19.0	–	6.0	
150	6"	PN 10	25.5	10K	24.5	Class 150	PN 10	23.5	10K	22.5	150	23.5	6.0		
200	8"		45		41.9			45		43		39.9	43	6.0	
250	10"		65		69.4			65		63		67.4	73	6.0	
300	12"		70		72.3			110		68		70.3	108	6.0	
350	14"	PN 10	115	10K	Class 150	Class 150	PN 10	113	10K	150	150	173	6.0		
400	16"		135					135				205	133	203	6.0
450	18"		175					175				255	173	253	6.0
500	20"		175					175				285	173	283	6.0
600	24"	PN 6	235	10K	Class D	Class D	PN 6	233	10K	150	150	403	6.0		
700	28"		355					400				353	698	898	6.0
–	30"		–					460				–	–	–	6.0
800	32"		435					550				433	573	798	6.0
900	36"	PN 6	575	10K	Class D	Class D	PN 6	573	10K	150	150	798	6.0		
1000	40"		700					900				698	898	6.0	
–	42"		–					1100				–	1098	6.0	
1200	48"		850					1400				848	1398	6.0	
–	54"	PN 6	–	10K	Class D	Class D	PN 6	–	10K	150	150	2198	6.0		
1400	–		1300					–				–	–	6.0	
–	60"		–					2700				–	2698	6.0	
1600	–		1700					–				1698	–	6.0	
–	66"	PN 6	–	10K	Class D	Class D	PN 6	–	10K	150	150	3698	6.0		
1800	72"		2200					4100				2198	4098	6.0	
–	78"		–					4600				–	4598	6.0	
2000	–		2800					–				2798	–	6.0	
Transmitter Promag (compact version): 3.4 kg (Weight data valid for standard pressure ratings and without packaging material) *Flanges according to AS are only available for DN 80, 100, 150 to 400, 500 and 600															

Promag P

Weight data of Promag P in kg											
Nominal diameter		Compact version				Remote version (without cable)					
		EN (DIN) / AS*		JIS	ANSI / AWWA	EN (DIN) / AS*		Sensor		ANSI / AWWA	Transmitter
[mm]	[inch]										
15	½"	PN 40	6.5	6.5	6.5	PN 40	4.5	4.5	4.5	4.5	6.0
25	1"		7.3	7.3	7.3		5.3	5.3	5.3	5.3	6.0
32	1 ¼"		8.0	7.3	–		6.0	5.3	–	–	6.0
40	1 ½"		9.4	8.3	9.4		7.4	6.3	7.4	7.4	6.0
50	2"		10.6	9.3	10.6		8.6	7.3	8.6	8.6	6.0
65	2 ½"	PN 16	12.0	11.1	–	PN 16	10.0	9.1	–	–	6.0
80	3"		14.0	12.5	14.0		12.0	10.5	12.0	12.0	6.0
100	4"		14.4	14.7	16.0		14.0	12.7	14.0	14.0	6.0
125	5"		16.0	21.0	–		19.5	19.0	–	–	6.0
150	6"		21.5	24.5	25.5		23.5	22.5	23.5	23.5	6.0
200	8"	PN 10	45	41.9	45	PN 10	43	39.9	43	43	6.0
250	10"		65	69.4	75		63	67.4	73	73	6.0
300	12"		70	72.3	110		68	70.3	108	108	6.0
350	14"		115		175		113		173	173	6.0
400	16"		135		205		133		203	203	6.0
450	18"	PN 10	175		255	PN 10	173		253	253	6.0
500	20"		175		285		173		283	283	6.0
600	24"		235		405		233		403	403	6.0

Transmitter Promag (compact version): 3.4 kg
 High-temperature version: + 1.5 kg
 (Weight data valid for standard pressure ratings and without packaging material)
 * Flanges according to AS are only available for DN 25 and 50.

Promag H

Weight data of Promag H in kg				
Nominal diameter		Compact version	Remote version (without cable)	
[mm]	[inch]	DIN	Sensor	Transmitter
2	1/12"	5.2	2	6.0
4	5/32"	5.2	2	6.0
8	5/16"	5.3	2	6.0
15	½"	5.4	1.9	6.0
25	1"	5.5	2.8	6.0
40	1 ½"	6.5	4.5	6.0
50	2"	9.0	7.0	6.0
65	2 ½"	9.5	7.5	6.0
80	3"	19.0	17.0	6.0
100	4"	18.5	16.5	6.0

Transmitter Promag (compact version): 3.4 kg
 (Weight data valid for standard pressure ratings and without packaging material)

Weight (US units)

Promag D

Weight data of Promag D in lbs				
Nominal diameter		Compact version	Remote version (without cable)	
[mm]	[inch]		Sensor	Transmitter
25	1"	10	6	13
40	1 ½"	11	7	13
50	2"	13	9	13
80	3"	17	13	13
100	4"	23	19	13
Transmitter Promag (compact version): 7.5 lbs (Weight data valid without packaging material)				

Promag L (ANSI)

Weight data of Promag L in lbs						
Nominal diameter		Compact version		Remote version (without cable)		
[mm]	[inch]			Sensor		Transmitter
50	2"	Class 150	23	Class 150	19	13
80	3"		31		26	13
100	4"		35		31	13
150	6"		56		52	13
200	8"		99		95	13
250	10"		143		161	13
Transmitter Promag (compact version): 7.5 lbs (Weight data valid for standard pressure ratings and without packaging material)						

Promag P (ANSI/AWWA)

Weight data of Promag P in lbs						
Nominal diameter		Compact version		Remote version (without cable)		
[mm]	[inch]			Sensor		Transmitter
15	½"	Class 150	14	Class 150	10	13
25	1"		16		12	13
40	1 ½"		21		16	13
50	2"		23		19	13
80	3"		31		26	13
100	4"		35		31	13
150	6"		56		52	13
200	8"		99		95	13
250	10"		165		161	13
300	12"		243		238	13
350	14"		386		381	13
400	16"		452		448	13
450	18"		562		558	13
500	20"		628		624	13
600	24"		893		889	13
Transmitter Promag (compact version): 7.5 lbs High-temperature version: 3.3 lbs (Weight data valid for standard pressure ratings and without packaging material)						

Promag W (ANSI/AWWA)

Weight data of Promag W in lbs						
Nominal diameter		Compact version		Remote version (without cable)		
[mm]	[inch]			Sensor		Transmitter
25	1"	Class 150	16	Class 150	12	13
40	1 ½"		21		16	13
50	2"		23		19	13
80	3"		31		26	13
100	4"		35		31	13
150	6"		56		52	13
200	8"		99		95	13
250	10"		143		161	13
300	12"		243		238	13
350	14"		386		381	13
400	16"		452		448	13
450	18"		562		558	13
500	20"		628		624	13
600	24"		893		889	13
700	28"	Class D	882	Class D	878	13
–	30"		1014		1010	13
800	32"		1213		1208	13
900	36"		1764		1760	13
1000	40"		1985		1980	13
–	42"		2426		2421	13
1200	48"		3087		3083	13
–	54"		4851		4847	13
–	60"		5954		5949	13
–	66"		8159		8154	13
1800	72"		9041		9036	13
–	78"		10143		10139	13
Transmitter Promag (compact version): 7.5 lbs (Weight data valid for standard pressure ratings and without packaging material)						

Promag H

Weight data of Promag H in lbs				
Nominal diameter		Compact version	Remote version (without cable)	
[mm]	[inch]		Sensor	Transmitter
2	1/12"	11	4	13
4	5/32"	11	4	13
8	5/16"	12	4	13
15	½"	12	4	13
25	1"	12	6	13
40	1 ½"	14	10	13
50	2"	20	15	13
65	2 ½"	21	17	13
80	3"	42	37	13
100	4"	41	36	13
Transmitter Promag (compact version): 7.5 lbs (Weight data valid for standard pressure ratings and without packaging material)				

Material

Promag D

- Transmitter housing: powder-coated die-cast aluminum
- Sensor housing: powder-coated die-cast aluminum
- Measuring tube: polyamide, O-rings EPDM
(Drinking water approvals: WRAS BS 6920, ACS, NSF 61, KTW/W270)
- Electrodes: 1.4435/316L
- Ground disks: 1.4301/304

Promag L

- Transmitter housing:
 - Compact housing: powder-coated die-cast aluminum
 - Wall-mounted housing: powder-coated die-cast aluminum
- Sensor housing: powder-coated die-cast aluminum
- Measuring tube: stainless steel 1.4301 or 1.4306/304L
- Electrodes: 1.4435, Alloy C-22
- Flange
 - EN 1092-1 (DIN 2501): 1.4306; 1.4307; 1.4301; RSt37-2 (S235JRG2)
 - ANSI: A105; F316L
- Seals: to DIN EN 1514-1
- Ground disks: 1.4435/316L or Alloy C-22

Promag W

- Transmitter housing:
 - Compact housing: powder-coated die-cast aluminum
 - Wall-mounted housing: powder-coated die-cast aluminum
- Sensor housing
 - DN 25 to 300: powder-coated die-cast aluminum
 - DN 350 to 2000: with protective lacquering
- Measuring tube
 - DN ≤ 300: stainless steel 1.4301 or 1.4306/304L
(for flanges made of carbon steel with Al/Zn protective coating)
 - DN ≥ 350: stainless steel 1.4301 or 1.4306/304
(for flanges made of carbon steel with protective lacquering)
- Electrodes: 1.4435 or Alloy C-22, Tantalum
- Flange
 - EN 1092-1 (DIN2501): 1.4571/316L; RSt37-2 (S235JRG2); C22; FE 410W B
(DN ≤ 300 with Al/Zn protective coating; DN ≥ 350 with protective lacquering)
 - ANSI: A105; F316L
(DN ≤ 300 with Al/Zn protective coating; DN ≥ 350 with protective lacquering)
 - AWWA: 1.0425
 - JIS: RSt37-2 (S235JRG2); HII; 1.0425/316L
(DN ≤ 300 with Al/Zn protective coating; DN ≥ 350 with protective lacquering)
 - AS 2129
 - (DN 150, 200, 250, 300, 600) A105 or RSt37-2 (S235JRG2)
 - (DN 80, 100, 350, 400, 500) A105 or St44-2 (S275JR)
 - AS 4087: A105 or St44-2 (S275JR)
- Seals: to DIN EN 1514-1
- Ground disks: 1.4435/316L, Alloy C-22, Titanium, Tantalum

Promag P

- Transmitter housing:
 - Compact housing: powder-coated die-cast aluminum
 - Wall-mounted housing: powder-coated die-cast aluminum
- Sensor housing
 - DN 15 to 300: powder-coated die-cast aluminum
 - DN 350 to 2000: with protective lacquering
- Measuring tube
 - $DN \leq 300$: stainless steel 1.4301 or 1.4306/304L; for flanges made of carbon steel with Al/Zn protective coating
 - $DN \geq 350$: stainless steel 1.4301 or 1.4306/304L; for flanges made of carbon steel with Al/Zn protective coating
- Electrodes: 1.4435, Platinum, Alloy C-22, Tantalum, Titanium
- Flange
 - EN 1092-1 (DIN2501): 1.4571/316L; RSt37-2 (S235JRG2); C22; FE 410W B ($DN \leq 300$: with Al/Zn protective coating; $DN \geq 350$ with protective lacquering)
 - ANSI: A105; F316L ($DN \leq 300$ with Al/Zn protective coating; $DN \geq 350$ with protective lacquering)
 - AWWA: 1.0425
 - JIS: RSt37-2 (S235JRG2); HII; 1.0425/316L ($DN \leq 300$ with Al/Zn protective coating; $DN \geq 350$ with protective lacquering)
 - AS 2129
 - (DN 25) A105 or RSt37-2 (S235JRG2)
 - (DN 40) A105 or St44-2 (S275JR)
 - AS 4087: A105 or St44-2 (S275JR)
- Seals: to DIN EN 1514-1
- Ground disks: 1.4435/316L or Alloy C-22

Promag H

- Transmitter housing:
 - Compact housing: powder-coated die-cast aluminum or stainless steel field housing (1.4301/316L)
 - Wall-mounted housing: powder-coated die-cast aluminum
 - Window material: glass or polycarbonate
- Sensor housing: stainless steel 1.4301
- Wall mounting kit: stainless steel 1.4301
- Measuring tube: stainless steel 1.4301
- Electrodes:
 - Standard: 1.4435
 - Option: Alloy C-22, Tantalum, Platinum
- Flange:
 - All connections stainless-steel 1.4404/316L
 - EN (DIN), ANSI, JIS made of PVDF
 - Adhesive fitting made of PVC
- Seals
 - DN 2 to 25: O-ring (EPDM, Viton, Kalrez), gasket seal (EPDM, Viton, silicone)
 - DN 40 to 100: gasket seal (EPDM, Viton, silicone)
- Ground rings: 1.4435/316L (optional: Tantalum, Alloy C-22)

Material load diagram

The material load diagrams (pressure-temperature graphs) for the process connections are to be found in the "Technical Information" documents of the device in question:
List of supplementary documentation → 116.

Fitted electrodes

Promag D

- 2 measuring electrodes for signal detection

Promag L, W and P

- 2 measuring electrodes for signal detection
- 1 EPD electrode for empty pipe detection
- 1 reference electrode for potential equalization

Promag H

- 2 measuring electrodes for signal detection
- 1 EPD electrode for empty pipe detection (apart from DN 2 to 15)

Process connections

Promag D

Wafer version → without process connections

Promag L

Flange connections:

- EN 1092-1 (DIN 2501)
- ANSI

Promag W and P

Flange connections:

- EN 1092-1 (DIN 2501)
 - DN ≤ 300 = form A
 - DN ≥ 350 = flat face
 - DN 65 PN 16 and DN 600 PN 16 only as per EN 1092-1
- ANSI
- AWWA (only Promag W)
- JIS
- AS

Promag H

With O-ring:

- Weld nipple DIN (EN), ISO 1127, ODT/SMS
- Flange EN (DIN), ANSI, JIS
- Flange made of PVDF EN (DIN), ANSI, JIS
- External thread
- Internal thread
- Hose connection
- PVC adhesive fitting

With gasket seal:



- Weld nipple DIN 11850, ODT/SMS
- Clamp ISO 2852, DIN 32676, L14 AM7
- Threaded joint DIN 11851, DIN 11864-1, ISO 2853, SMS 1145
- Flange DIN 11864-2

Surface roughness

All data relate to parts in contact with fluid.

- Liner → PFA: ≤ 0.4 µm (15 µin)
- Electrodes: 0.3 to 0.5 µm (12 to 20 µin)
- Process connection made of stainless-steel (Promag H): ≤ 0.8 µm (31 µin)

10.1.11 Human interface

Display elements	<ul style="list-style-type: none"> ■ Liquid crystal display: illuminated, two-line, 16 characters per line ■ Custom configurations for presenting different measured-value and status variables ■ 2 totalizers
	<p>Note!</p> <p>At ambient temperatures below –20 (–4 °F) the readability of the display may be impaired.</p>
Operating elements	<ul style="list-style-type: none"> ■ Local operation with three keys (◀, ▶, ⏏) ■ "Quick Setup" menus for straightforward commissioning
Language groups	<p>Language groups available for operation in different countries:</p> <ul style="list-style-type: none"> ■ Western Europe and America (WEA): English, German, Spanish, Italian, French, Dutch and Portuguese ■ Eastern Europe/Scandinavia (EES): English, Russian, Polish, Norwegian, Finnish, Swedish and Czech ■ Southeast Asia (SEA): English, Japanese, Indonesian
	<p>Note!</p> <p>You can change the language group via the operating program "FieldCare".</p>
Remote operation	Operation via HART protocol and Fieldtool

10.1.12 Certificates and approvals

CE mark	The measuring system is in conformity with the statutory requirements of the EC Directives. Endress+Hauser confirms successful testing of the device by affixing to it the CE mark.
C-tick mark	The measuring system meets the EMC requirements of the Australian Communications and Media Authority (ACMA)
Ex approval	Information about currently available Ex versions (ATEX, FM, CSA, IECEx, NEPSI etc.) can be supplied by your Endress+Hauser Sales Center on request. All explosion protection data are given in a separate documentation which is available upon request.
Sanitary compatibility	<p><i>Promag D, L, W and P</i></p> <p>No applicable approvals or certification</p> <p><i>Promag H</i></p> <ul style="list-style-type: none"> ■ 3A authorization and EHEDG-tested ■ Seals: in conformity with FDA (except Kalrez seals)
Drinking water approval	<p><i>Promag D, L and W</i></p> <ul style="list-style-type: none"> ■ WRAS BS 6920 ■ ACS ■ NSF 61 ■ KTW/W270 <p><i>Promag P and H</i></p> <p>No drinking water approval</p>

Pressure Equipment Directive *Promag D and L*

No pressure measuring device approval

Promag W, P and H

Measuring devices with a nominal diameter smaller than or equal to DN 25 correspond to Article 3 (3) of the EC Directive 97/23/EC (Pressure Equipment Directive) and have been designed and manufactured according to good engineering practice. Where necessary (depending on the fluid and process pressure), there are additional optional approvals to Category II/III for larger nominal diameters.

Other standards and guidelines

- EN 60529
Degrees of protection by housing (IP code).
- EN 61010-1
Safety requirements for electrical equipment for measurement, control and laboratory use
- IEC/EN 61326
Electromagnetic compatibility (EMC requirements)
- ANSI/ISA-S82.01
Safety Standard for Electrical and Electronic Test, Measuring, Controlling and related Equipment – General Requirements. Pollution degree 2, Installation Category II.
- CAN/CSA-C22.2 (No. 1010.1-92)
Safety requirements for Electrical Equipment for Measurement and Control and Laboratory Use. Pollution degree 2, Installation Category I.
- NAMUR NE 21
Electromagnetic compatibility (EMC) of industrial process and laboratory control equipment.
- NAMUR NE 43
Standardization of the signal level for the breakdown information of digital transmitters with analog output signal.

10.1.13 Ordering information

Your Endress+Hauser service organization can provide detailed ordering information and information on the order codes on request.

10.1.14 Accessories

Various accessories, which can be ordered separately from Endress+Hauser, are available for the transmitter and the sensor →  77.

Your Endress+Hauser service organization can provide detailed information on the specific order codes on request.

10.1.15 Documentation

- Flow measuring technology (FA005D/06)
- Technical Information Promag 50D (TI082D/06)
- Technical Information Promag 50L (TI097D/06)
- Technical Information Promag 50W, 53W (TI046D/06)
- Technical Information Promag 50P, 53P (TI047D/06)
- Technical Information Promag 50H, 53H (TI048D/06)
- Description of Device Functions Promag 50 HART (BA049D/06)
- Supplementary documentation on Ex-ratings: ATEX, FM, CSA, etc.

Index

A

Accessories	77
Adapters	17
Ambient temperature range	101
Applicator (selection and configuration software)	79
Approvals	9, 115

C

Cable entry	99
Cable specifications	49
Calibration factor	8–9
CE mark	115
CE mark (Declaration of Conformity)	9
Centering sleeve	
Promag D	22
Certificates	9, 115
CIP cleaning	101
Cleaning (exterior cleaning)	76
Code entry (function matrix)	61
Commissioning	
General	71
Two current outputs	73
Commissioning Quick Setup menu	72
Commubox FXA 195 (electrical connection)	53, 78
Communication	63
Conductivity of fluid	103
Connecting cable	20
Connection	
Check	58
HART	53
Remote version	44
C-tick mark	115
Current output	
Configuration (active/passive)	73

D

Declaration of Conformity (CE mark)	9
Degree of protection	57, 101
Design	107
Device description files	64
Device variable via HART protocol	64
Display	
Elements	59, 115
Turning the display	40
Documentation	116
Drinking water approval	115

E

Electrical connection	
Commubox FXA 191	53
HART handheld terminal	53
Electrical connections	99
Electrodes	
EPD electrode	15
EMC (electromagnetic compatibility)	49, 101
Empty-pipe/full-pipe adjustment	74
Error message types	62

Error messages

Process error (application error)	83
System errors (device errors)	81
European Pressure Equipment Directive	116
Ex approval	115
Exterior cleaning	76

F

Field Xpert SFX100	53
FieldCare	63, 79
Fieldcheck (tester and simulator)	79
Fitted electrodes	114
Flow rate/limits	18
Function matrix	
Brief operating instructions	60
Fuse, replacing	92
FXA193	79
FXA195	78

G

Galvanic isolation	98
Gewicht	110
Ground cable	
Promag L	24
Promag P	31
Promag W	26
Grounding rings	
Promag H	37

H

HART	
Command classes	63
Commands	65
Communicator DXR 375	63
Device description files	64
Device status / Error messages	69
Write protection	64
Hazardous substances	95
High-temperature version	32
HOME position (operating mode)	59

I

Incoming acceptance	11
Inlet/outlet run	16
Installation	
Promag D	21
Promag H	36
Promag L	24
Promag P	31
Promag W	26
Installation conditions	
Adapters	17
Dimensions	13
Down pipe	14
EPD electrode	15
Foundations, supports	17
Inlet/outlet run	16

Installation of pumps	13
Mounting location	13
Orientation	15
Partially filled pipes	14
Vibrations	16
Installing the wall-mount housing	41

L

Language groups	115
Load	98
Local display	
See Display	
Low flow cut off	98

M

Maintenance	76
Material	112
Material load diagram	113
Maximum measured error	100
Measured variable	97
Measuring principle	97
Measuring range	97
Measuring system	97
Mechanical construction	107
Medium pressure range	103
Medium temperature range	102
Mounting bolts	
Promag D	22
Mounting the sensor	
See Installing the sensor	

N

Nameplate specifications	
Connections	9
Sensor	8
Transmitter	7
Nominal diameter and flow rate	
Promag W	18

O

Operable flow range	97
Operating conditions	
Environment	101
Process	102
Operating elements	59, 115
Operation	59
Device description files	64
FieldCare	63
Operating programs	63
Operational safety	5
Order code	
Accessories	77
Sensor	9
Ordering code	
Sensor	8
Transmitter	7
Ordering information	116
Output	97

P

Performance characteristics	100
Pig (cleaning)	38
Post-installation	
Check	43
Potential equalization	54
Power consumption	99
Power supply	99
Power supply failure	99
Pressure Equipment Directive	116
Pressure loss	
Adapters (reducers, expanders)	17
Pressure tightness	105
Process connections	114
Process error messages	83
Process errors (definition)	62
Programming mode	
Disable	61
Enable	61
Promag D	
Centering sleeve	22
Installation	21
Mounting bolts	22
Seals	21
Tightening torques	23
Promag D mounting kit	21
Promag H	
Cleaning with pigs	38
Grounding ring	37
Installation	36
Seals	36
Weld nipple	38
Promag L	
Ground cable	24
Installation	24
Seals	24
Tightening torques	25
Promag P	
Ground cable	31
High-temperature version	32
Installation	31
Seals	31
Tightening torques	32
Promag W	
Ground cable	26
Installation	26
Seals	26
Tightening torques	26

Q

Quick Setup	72
-------------------	----

R

Reference operating conditions	100
Registered trademarks	10
Remote operation	115
Remote version	
Connection	44
Repair	95

Repeatability	100
Replacing	
Exchangeable electrode	93
Response to errors	85
Returning devices	95

S

Safety icons	6
Safety instructions	5
Sanitary compatibility	115
S-DAT (HistoROM)	75
Seals	76
Promag D	21
Promag H	36
Promag L	24
Promag P	31
Promag W	26
Serial number	
Sensor	8–9
Transmitter	7
Service interface FXA 193	79
Shock resistance	101
Signal on alarm	98
SIP cleaning	101
Software	
Amplifier display	71
Spare parts	87
Standards, guidelines	116
Storage temperature	101
Supply voltage	99
Surface roughness	114
Switching on (measuring device)	71
System error messages	81
System errors (definition)	62

T

Technical data	97
Temperature	
Ambient	101
Medium	102
Storage	101
Tightening torques	
Promag D	23
Promag L	25
Promag P	32
Promag W	26
Transmitter	
Electrical connection	50
Installing the wall-mount housing	41
Turning the field housing (aluminum)	39
Turning the field housing (stainless steel)	39
Troubleshooting	80
Types of error (system and process errors)	62

V

Vibration resistance	101
Vibrations	16

W

Wall-mount housing, installing	41
Weight	107
Wiring	44

Declaration of Hazardous Material and De-Contamination

Erklärung zur Kontamination und Reinigung

RA No.

Please reference the Return Authorization Number (RA#), obtained from Endress+Hauser, on all paperwork and mark the RA# clearly on the outside of the box. If this procedure is not followed, it may result in the refusal of the package at our facility.
 Bitte geben Sie die von E+H mitgeteilte Rücklieferungsnummer (RA#) auf allen Lieferpapieren an und vermerken Sie diese auch außen auf der Verpackung. Nichtbeachtung dieser Anweisung führt zur Ablehnung ihrer Lieferung.

Because of legal regulations and for the safety of our employees and operating equipment, we need the "Declaration of Hazardous Material and De-Contamination", with your signature, before your order can be handled. Please make absolutely sure to attach it to the outside of the packaging.

Aufgrund der gesetzlichen Vorschriften und zum Schutz unserer Mitarbeiter und Betriebseinrichtungen, benötigen wir die unterschriebene "Erklärung zur Kontamination und Reinigung", bevor Ihr Auftrag bearbeitet werden kann. Bringen Sie diese unbedingt außen an der Verpackung an.

Type of instrument / sensor

Geräte-/Sensortyp

Serial number

Seriennummer

☐ **Used as SIL device in a Safety Instrumented System / Einsatz als SIL Gerät in Schutzanlagen**
Process data / Prozessdaten

Temperature / Temperatur _____ [°F] _____ [°C]

Pressure / Druck _____ [psi] _____ [Pa]

Conductivity / Leitfähigkeit _____ [µS/cm]

 Viscosity / Viskosität _____ [cp] _____ [mm²/s]

Medium and warnings

Warnhinweise zum Medium



	Medium /concentration Medium /Konzentration	Identification CAS No.	flammable entzündlich	toxic giftig	corrosive ätzend	harmful/ irritant gesundheitsschädlich/ reizend	other * sonstiges *	harmless unbedenklich
Process medium Medium im Prozess								
Medium for process cleaning Medium zur Prozessreinigung								
Returned part cleaned with Medium zur Endreinigung								

* explosive; oxidising; dangerous for the environment; biological risk; radioactive

* explosiv; brandfördernd; umweltgefährlich; biogefährlich; radioaktiv

Please tick should one of the above be applicable, include safety data sheet and, if necessary, special handling instructions.

Zutreffendes ankreuzen; trifft einer der Warnhinweise zu, Sicherheitsdatenblatt und ggf. spezielle Handhabungsvorschriften beilegen.

Description of failure / Fehlerbeschreibung
Company data / Angaben zum Absender

Company / Firma _____	Phone number of contact person / Telefon-Nr. Ansprechpartner: _____
Address / Adresse _____	Fax / E-Mail _____
Your order No. / Ihre Auftragsnr. _____	

"We hereby certify that this declaration is filled out truthfully and completely to the best of our knowledge. We further certify that the returned parts have been carefully cleaned. To the best of our knowledge they are free of any residues in dangerous quantities."

"Wir bestätigen, die vorliegende Erklärung nach unserem besten Wissen wahrheitsgetreu und vollständig ausgefüllt zu haben. Wir bestätigen weiter, dass die zurückgesandten Teile sorgfältig gereinigt wurden und nach unserem besten Wissen frei von Rückständen in gefährlichen Mengen sind."

(place, date / Ort, Datum)

Name, dept./ Abt. (please print / bitte Druckschrift)

Signature / Unterschrift

www.endress.com/worldwide

Endress+Hauser 
People for Process Automation

Warranties

Colorbond Warranty

Linked Documents

 [bslwarranty-RFG-CB-130718-1225 - Laidley.pdf](#)

AusFab Workmanship Warranty

Ausfab warrant their works from the date of practical completion for 12 months as per the terms and conditions of their contract with Thomas & Coffey.

Thomas & Coffey will warrant the works until the end of the defect liability period.



BlueScope Steel Limited
 ABN 16 000 011 058
 Old Port Road,
 Port Kembla NSW 2505
 Locked Bag 8825
 Wollongong DC NSW 2500
 Telephone 1800 800 789
 Facsimile 1800 800 744
www.bluescopesteel.com

24 October 2013

Mr Will Campbell

janelle@ausfabconstructions.com.au

Ref: RFG-CB-130718-1225

Dear Mr Will Campbell,

BlueScope Steel Warranty Advice – 2 Cnr East Rd and Braham Rd, Laidley QLD 4341

The following information is provided in response to your submission of a "Pre-Approved Warranty". It is provided in reference to COLORBOND® steel, which is to be installed in a Roofing application at 2 Cnr East Rd and Braham Rd, Laidley QLD 4341.

To activate this warranty, please visit us at www.bluescopesteel.com.au/warranties and enter the activation code – 0D579DB2. Please check that all details are correct prior to finalising the activation process.

This offer is based upon information provided by you and is summarised below.

WARRANTY

7 year warranty against corrosion to perforation
 with 7 years against flake and peel

PROJECT ADDRESS

2 Cnr East Rd and Braham Rd, Laidley QLD 4341

BUILDING DETAILS

Building Name – Laidley STP
 Building Category – Heavy Industrial
 Building Type – Sewerage Treatment Plant
 Installation Date – 18 July 2013
 Application – Roofing

APPLICATION DETAILS

Material – COLORBOND® steel
 Colour – Wildemess®
 Supplier – your steel supplier
 Product Profile – Trapezoidal
 Roof Pitch – 5+°
 Is the roof design curved? –
 Roof Curve Radius – 0
 Unwashed Areas – No unwashed areas
 Fastener material – Aluminium
 Comply to Australian Standard AS3566? – N/A
 Heritage Application –

This message may contain information that is confidential and/or subject of legal privilege intended only for use by the intended recipient. If you are not the intended recipient and have received this message in error please notify the sender immediately and delete the message.



BlueScope Steel Limited
ABN 16 000 011 058
Old Port Road,
Port Kembla NSW 2505
Locked Bag 8825
Wollongong DC NSW 2500
Telephone 1800 800 789
Facsimile 1800 800 744
www.bluescopesteel.com

ENVIRONMENTAL DETAILS

Calm Marine – N/A

Exposed Marine – N/A

Surf – N/A

Industrial – N/A

COMMENTS

What is the observed performance of similar products and applications in your area?

Any other factors which may influence the warranty?

Describe the activities being carried out within the building.

Sewerage Treatment

This warranty advice remains valid until: 24 April 2015

Please note that this correspondence is not a warranty, but merely an indication of warranties that may be provided upon application at completion of construction of your project. Warranty offers are subject to change pending the final design and installation parameters of your project.

Should you have any further enquiries, please do not hesitate to contact your nearest BlueScope Steel sales office.

Regards,

BlueScope Steel Limited



BlueScope Steel Limited
ABN 16 000 011 058
Old Port Road,
Port Kembla NSW 2505
Locked Bag 8825
Wollongong DC NSW 2500
Telephone 1800 800 789
Facsimile 1800 800 744
www.bluescopesteel.com

BlueScope Steel Warranty Activation Notice

Dear Sir/Madam,

Congratulations on your purchase of a BlueScope Steel product. The COLORBOND® steel product you have selected is eligible for a 7 year warranty against corrosion to perforation.

To activate this warranty, please visit us at www.bluescopesteel.com.au/warranties and enter the activation code that is listed below.

Your activation code is:

0D579DB2

Please ensure that all of the details listed on screen are correct before submitting your warranty application.

Should you require any assistance, please contact us at Steel Direct on 1800 800 789 or by email at steel.direct@bluescopesteel.com.au

Regards,

BlueScope Steel Limited

Certificates

MF Shed Slab Design Form 15

Linked Documents

 [12687 Laidley STP-FORM 15.pdf](#)

MF Shed Form 16

Linked Documents

 [Laidley MF Building- Form 16.pdf](#)

Galvanizer Certificates

Linked Documents

 [Galvanizer Certificates.pdf](#)


MF Shed Structure Design Form 15

Linked Documents

 [Shed Design- Form 15.pdf](#)

Compliance Certificate for building Design or Specification

15

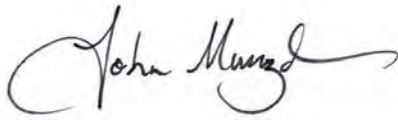NOTE	This is to be used for the purposes of section 10 of the <i>Building Act 1975</i> and/or section 46 of the <i>Building Regulation 2006</i> .
1. Property description This section need only be completed if details of street address and property description are applicable. EG. In the case of (standard/generic) pool design/shell manufacture and/or patio and carport systems this section may not be applicable. The description must identify all land the subject of the application.	Street address <i>(include no., street, suburb / locality & postcode)</i> <div style="border: 1px solid black; padding: 2px;">Laidley Sewage Treatment Plant</div> <div style="border: 1px solid black; padding: 2px;">Braham Road, Laidley, Qld</div> <div style="border: 1px solid black; padding: 2px; text-align: right;">Postcode 4341</div> Lot & plan details <i>(attach list if necessary)</i> <div style="border: 1px solid black; height: 20px;"></div> In which local government area is the land situated? <div style="border: 1px solid black; height: 20px;"></div>
2. Description of component/s certified Clearly describe the extent of work covered by this certificate, e.g. all structural aspects of the steel roof beams.	<div style="border: 1px solid black; padding: 2px;">Structural design of MF building slab on ground</div>
3. Basis of certification Detail the basis for giving the certificate and the extent to which tests, specifications, rules, standards, codes of practice and other publications, were relied upon.	<div style="border: 1px solid black; padding: 2px;">AS 1170.1; AS 1170.2; AS 1170.4; AS 2870; AS 3600; AS 3700; AS 4100</div>
4. Reference documentation Clearly identify any relevant documentation, e.g. numbered structural engineering plans.	<div style="border: 1px solid black; padding: 2px;">Structural Drawings by 'Henry & Hymas Consulting' Job No. 12687-S3.00</div> <div style="border: 1px solid black; padding: 2px;">Geotechnical Report by 'Douglas Partners' Project No. 79887.00 Document 4</div>
5. Building certifier reference number	Building certifier reference number <div style="border: 1px solid black; height: 20px;"></div>
6. Competent person details A competent person for building work, means a person who is assessed by the building certifier for the work as competent to practise in an aspect of the building and specification design, of the building work because of the individual's skill, experience and qualifications in the aspect. The competent person must also be registered or licensed under a law applying in the State to practice the aspect. If no relevant law requires the individual to be licensed or registered to be able to give the help, the certifier must assess the individual as having appropriate experience, qualifications or skills to be able to give the help. If the chief executive issues any guidelines for assessing a competent person, the building certifier must use the guidelines when assessing the person.	Name <i>(in full)</i> <div style="border: 1px solid black; padding: 2px;">John Murazak</div> <div style="display: flex; justify-content: space-between;"> <div> Company name <i>(if applicable)</i> <div style="border: 1px solid black; padding: 2px;">H&H Consulting Engineers Pty Ltd</div> </div> <div> Contact person <div style="border: 1px solid black; padding: 2px;">John Murazak</div> </div> </div> <div style="display: flex; justify-content: space-between;"> <div> Phone no. <i>business hours</i> <div style="border: 1px solid black; padding: 2px;">07 3262 7440</div> </div> <div> Mobile no. <div style="border: 1px solid black; padding: 2px;">0421 493118</div> </div> <div> Fax no. <div style="border: 1px solid black; padding: 2px;">07 3262 1168</div> </div> </div> Email address <div style="border: 1px solid black; padding: 2px;">jmurazak@hhconsult.com.au</div> Postal address <div style="border: 1px solid black; padding: 2px;">8 Immarna Street</div> <div style="border: 1px solid black; padding: 2px;">Albion, QLD</div> <div style="border: 1px solid black; padding: 2px; text-align: right;">Postcode 4010</div> Licence or registration number <i>(if applicable)</i> <div style="border: 1px solid black; padding: 2px;">RPEQ 10156</div>
7. Signature of competent person This certificate must be signed by the individual assessed by the building certifier as competent.	<div style="display: flex; justify-content: space-between;"> <div> Signature <div style="border: 1px solid black; padding: 2px;">  </div> </div> <div> Date <div style="border: 1px solid black; padding: 2px; text-align: center;">20-11-2012</div> </div> </div>

LOCAL GOVERNMENT USE ONLY

Date received		Reference Number/s		Approved form 15 Version 2 02/08
---------------	--	--------------------	--	-------------------------------------

Inspection Certificate / Aspect Certificate / QBSA Licensee Aspect Certificate

16

NOTE

This form is to be used for the purposes of section 10(c) and 239 of the *Building Act 1975* and/or sections 32, 35B, 43, 44 and 47 of the *Building Regulation 2006*.

1. Indicate the type of certificate

The stages of assessable building work are listed in section 24 of the *Building Regulation 2006* or as conditioned by the building certifier.

An aspect of building work is part of a stage (e.g. waterproofing).



Inspection Certificate for



Stage of building work (for single detached class 1a or class 10 building or structure)
(indicate the stage) _____



Aspect of building work
(indicate the aspect) _____

STRUCTURAL AND ROOFING LAIDLEY MF BUILDING



QBSA Licensee Aspect Certificate

Scope of the work

Scope of the work covered by the licence class under the *Queensland Building Services Authority Regulation 2003* for the aspect being certified, e.g. scope of work for a waterproofing licence is "installing waterproofing materials or systems for preventing moisture penetration". An aspect being certified may include "wet area sealing to showers".

THE SUPPLY AND INSTALL OF STRUCTURAL BEAMS AND ROOFING

2. Property description

The description must identify all land the subject of the application.

The lot & plan details (eg. SP / RP) are shown on title documents or a rates notice. If the plan is not registered by title, provide previous lot and plan details.

Street address (include no., street, suburb / locality & postcode)

Laidley STP lot 2 adjacent to Cnr East RD and Braham Rd off Boundary Road, LAIDLEY

Postcode 4341

Lot & plan details (Attach list if necessary)

In which local government area is the land situated?

3. Building/structure description

Building/structure description

CONTROL AND PROCESSING BUILDING

Class of building / structure

4. Description of component/s certified

Clearly describe the extent of work covered by this certificate, e.g. all structural aspects of the steel roof beams.

BEAMS AND ROOFING

LOCAL GOVERNMENT USE ONLY

DATE RECEIVED

REFERENCE NUMBER/S

Approved form 16
Version 3.1/1/1

Form 16 continued

5. Basis of certification

Detail the basis for giving the certificate and the extent to which tests, specifications, rules, standards, codes of practice and other publications, were relied upon.

ALL DRAWINGS AND WORK COMPLETED IN ACCORDANCE WITH AS1428, AS1554, AS1100, AS4100 & AS/NZS 4680

6. Reference documentation

Clearly identify any relevant documentation, e.g. numbered structural engineering plans.

AS BUILT DRAWINGS ATTACHED

7. Building certifier reference number and development approval number

Building certifier reference number

Development approval number

8. Building Certifier, competent person or QBSA licensee details

A **competent person** must be assessed as competent before carrying out the inspection.

The builder for the work cannot give a stage certificate of inspection.

A competent person is assessed by the building certifier for the work as competent to practice in an aspect of the building and specification design, because of the individual's skill, experience and qualifications. The competent person must be registered or licensed under a law applying in the State to practice the aspect.

If no relevant law requires the individual to be licensed or registered, the certifier must assess the individual as having appropriate experience, qualifications or skills to be able to give the help.

If the chief executive issues any guidelines for assessing a competent person, the building certifier must use the guidelines when assessing the person.

Name (in full)

NIGEL WEIS

Company name if applicable

AUSFAB CONSTRUCTIONS

Contact person

NIGEL WEIS

Phone no. business hours

1300 995 970

Mobile no.

0438 502 072

Fax no.

1300 998 983

Email address

nigel.weis@ausfabconstructions.com.au

Postal address

40 KENILWORTH STREET WARWICK

Postcode 4370

Licence class

STRUCTURAL STEEL

Licence number

1207479

Date approval to inspect received from building certifier

9. Signature of building certifier, competent person or QBSA licensee

Note: A building certifier must sign this form for temporary swimming pool fencing under section 4 of Schedule 1 of QDC MP 3.4.

Signature



Date

26/06/2013

INDUSTRIAL GALVANIZERS (BRIS.)

A division of Industrial Galvanizers Corporation Pty. Ltd.
ACN 000 545 415 ABN 40 000 545 415 010

You're better off with...

Telephone: (07) 3632 7700 Facsimile: (07) 3632 7797
Cnr. Boundary & Cobalt Streets, Carole Park, Queensland
Receiving/Despatch Office Facsimile: (07) 3718 2598
Cnr Holt St & Curtin Ave, Pinkenba, Queensland
Receiving/Despatch Office Facsimile: (07) 3632 7795
P O Box 1131
Eagle Farm Qld 4009



A valmont COMPANY

Q.A Compliance Status:

Dear Valued Customer,

Industrial Galvanizers (Brisbane) plants at Pinkenba and Carole Park are AS/ISO 9001: 2008 accredited.

All steel work received is processed for galvanizing as described within our Inspection Test Point (ITP) listed in our Quality Assurances System

Our quality plan is a visible inspection after galvanizing to determine that the coating is continuous and has adhered.

Weekly analysis of all chemical and zinc bath composition is undertaken to ensure our process are in accordance with AS/NZ 4680:2006.

Should you require any further information please contact the undersigned.

Yours Faithfully

A handwritten signature in blue ink, appearing to read 'G. C. Warner'.

Industrial Galvanizers (BRISBANE)
Gavin Warner
QA Coordinator QLD.



CERTIFICATE OF REGISTRATION

This is to certify that:

Industrial Galvanizers Corporation Pty Ltd

ABN 40 000 545 415

Trading As

Industrial Galvanizers (Brisbane)

Cnr Holt Street & Curtin Avenue Pinkenba QLD 4008 AUSTRALIA

Commercial Avenue Bohle QLD 4814 AUSTRALIA

Cnr Boundary Road & Cobalt Street Carole Park QLD 4300 AUSTRALIA

operates a

QUALITY MANAGEMENT SYSTEM

which complies with the requirements of

ISO 9001:2008

for the following scope

The hot dip and centrifuge galvanizing of steel products, including a pick-up and delivery, same day and 24 hour service by arrangement.

Certificate No: QEC0916

Issued: 4 October 2012

Expires: 22 November 2015

Originally Certified: 9 July 1991

Current Certification: 3 October 2012

Samer Chaouk
Policy, Risk and Certification Manager

Tony Scotton
Chief Executive Officer



Registered by:

SAI Global Certification Services Pty Ltd (ACN 108 716 669) 286 Sussex Street Sydney NSW 2000 Australia with SAI Global Limited 286 Sussex Street Sydney NSW 2000 Australia ("SAI Global") and subject to the SAI Global Terms and Conditions for Certification. While all due care and skill was exercised in carrying out this assessment, SAI Global accepts responsibility only for proven negligence. This certificate remains the property of SAI Global and must be returned to SAI Global upon its request. To verify that this certificate is current please refer to SAI Global On-Line Certification register at <http://www.saiglobal.com>



INFORM. INSPIRE. IMPROVE.

Compliance Certificate for building Design or Specification

15

NOTE	<p>This is to be used for the purposes of section 10 of the <i>Building Act 1975</i> and/or section 46 of the <i>Building Regulation 2006</i>.</p> <p>RESTRICTION: A building certifier (class B) can only give a compliance certificate about whether building work complies with the BCA or a provision of the QDC. A building certifier (Class B) can not give a certificate regarding QDC boundary clearance and site cover provisions.</p>
<p>1. Property description</p> <p>This section need only be completed if details of street address and property description are applicable. EG. In the case of (standard/generic) pool design/shell manufacture and/or patio and carport systems this section may not be applicable.</p> <p>The description must identify all land the subject of the application. The lot & plan details (eg. SP / RP) are shown on title documents or a rates notice. If the plan is not registered by title, provide previous lot and plan details.</p>	<p>Street address <i>(include no., street, suburb / locality & postcode)</i></p> <div style="border: 1px solid black; padding: 2px;">Wind Region B, TC 2 & 3</div> <div style="border: 1px solid black; padding: 2px; text-align: right;">Postcode</div> <p>Lot & plan details <i>(attach list if necessary)</i></p> <div style="border: 1px solid black; height: 20px;"></div> <p>In which local government area is the land situated?</p> <div style="border: 1px solid black; height: 20px;"></div>
<p>2. Description of component/s certified</p> <p>Clearly describe the extent of work covered by this certificate, e.g. all structural aspects of the steel roof beams.</p>	<div style="border: 1px solid black; padding: 2px;"> Roof & Wall Framing, Wind Bracing, Tie-Down & Connections </div> <div style="border: 1px solid black; height: 100px;"></div>
<p>3. Basis of certification</p> <p>Detail the basis for giving the certificate and the extent to which tests, specifications, rules, standards, codes of practice and other publications, were relied upon.</p>	<div style="border: 1px solid black; padding: 2px;"> AS 1170.1, AS 1170.2, AS 4100, AS 4600 </div> <div style="border: 1px solid black; padding: 2px;"> Structural Importance Level 3 </div> <div style="border: 1px solid black; height: 100px;"></div>

LOCAL GOVERNMENT USE ONLY

Date received		Reference Number/s		Approved form 15 Version 2 11/11
---------------	--	--------------------	--	-------------------------------------

Form 15 continued

4. Reference documentation

Clearly identify any relevant documentation, e.g. numbered structural engineering plans.

Drawing Nos: WK12-0541 / 1C, 2B
by Osborn Lane Consulting Engineers
5. Building certifier reference number

Building certifier reference number

6. Competent person details

A competent person for building work, means a person who is assessed by the building certifier for the work as competent to practise in an aspect of the building and specification design, of the building work because of the individual's skill, experience and qualifications in the aspect. The competent person must also be registered or licensed under a law applying in the State to practice the aspect.

If no relevant law requires the individual to be licensed or registered to be able to give the help, the certifier must assess the individual as having appropriate experience, qualifications or skills to be able to give the help.

If the chief executive issues any guidelines for assessing a competent person, the building certifier must use the guidelines when assessing the person.

Name (in full)

Robert K Lane

Company name (if applicable)

Osborn Lane Consulting Engineers

Contact person

Robert Lane

Phone no. business hours

07 4660 3300

Mobile no.

0417 644 039

Fax no.

07 4660 3310

Email address

warwick@osbornlane.com

Postal address

PO Box 495
Warwick Qld

 Postcode **4370**

Licence or registration number (if applicable)

RPEQ 4084
7. Signature of competent person

This certificate must be signed by the individual assessed by the building certifier as competent.

Signature



Date

07th January 2013

Help & Contact

AusFab Constructions

Trade or Product: Shed Design and Construction

Contact & Address Details:

Steve Bartlett | Procurement/ Project supervisor

Postal: PO Box 3558, Tingalpa QLD 4173

Production & Delivery: 40 Kenilworth Street, Warwick QLD 4370

P: 1300 995 970 | F: 1300 998 983 | 0437 930 343 | E: steve@ausfabconstructions.com.au

As Built Drawings

MF Shed Framing Plan

Site: (ST053) Laidley

Linked Documents

 [WK12-0541 1D.pdf](#)

MF Shed Shop Drawing As-builts

Site: (ST053) Laidley

Linked Documents


 [Laidley MF Building As-built.pdf](#)

Laidley MF Building Slab Design


Site: (ST053) Laidley

Linked Documents


 [12687-S3 - Laidley MF slab.pdf](#)

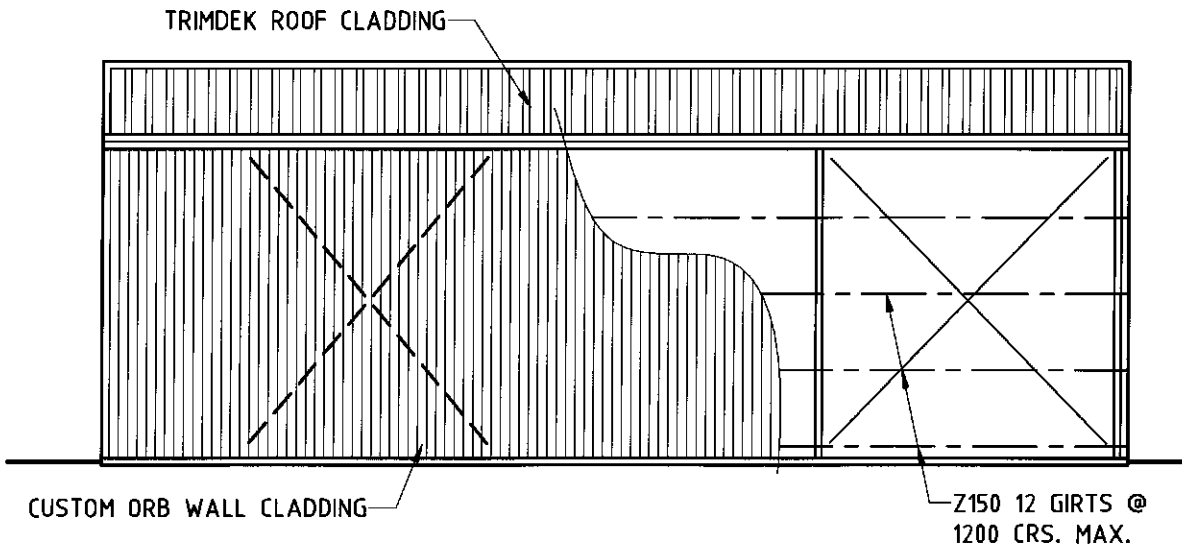


REAR ELEVATION
SCALE 1:100

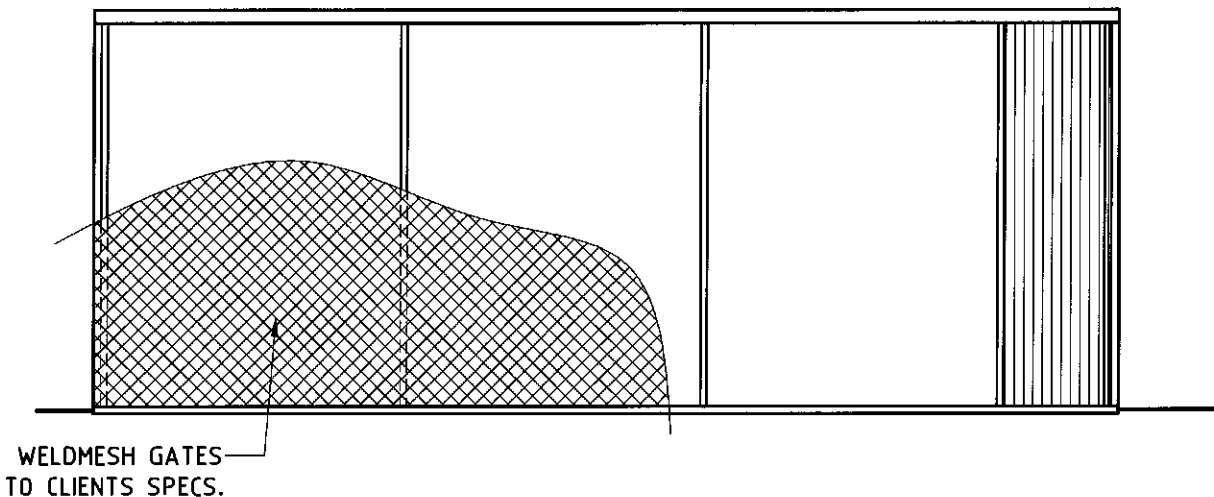

FRONT ELEVATION
SCALE 1:100

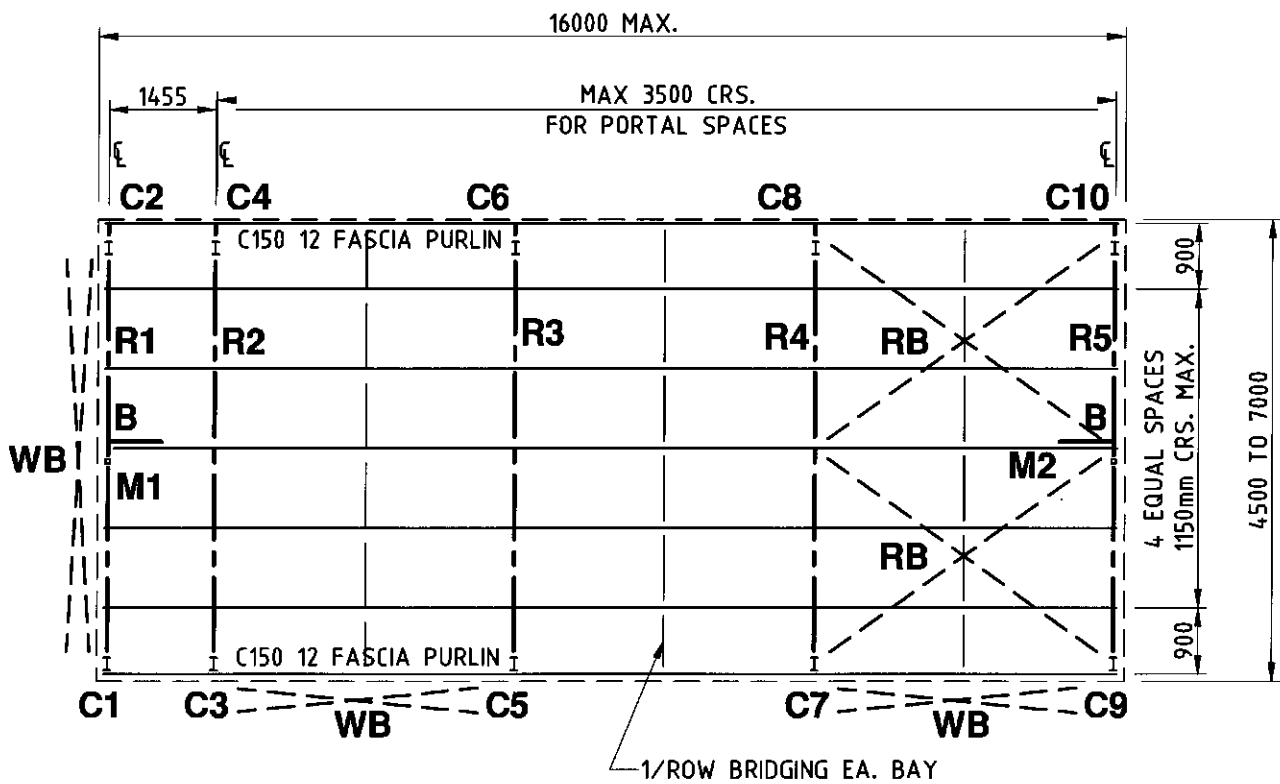

ROOF FRAMING PLAN
SCALE 1:100

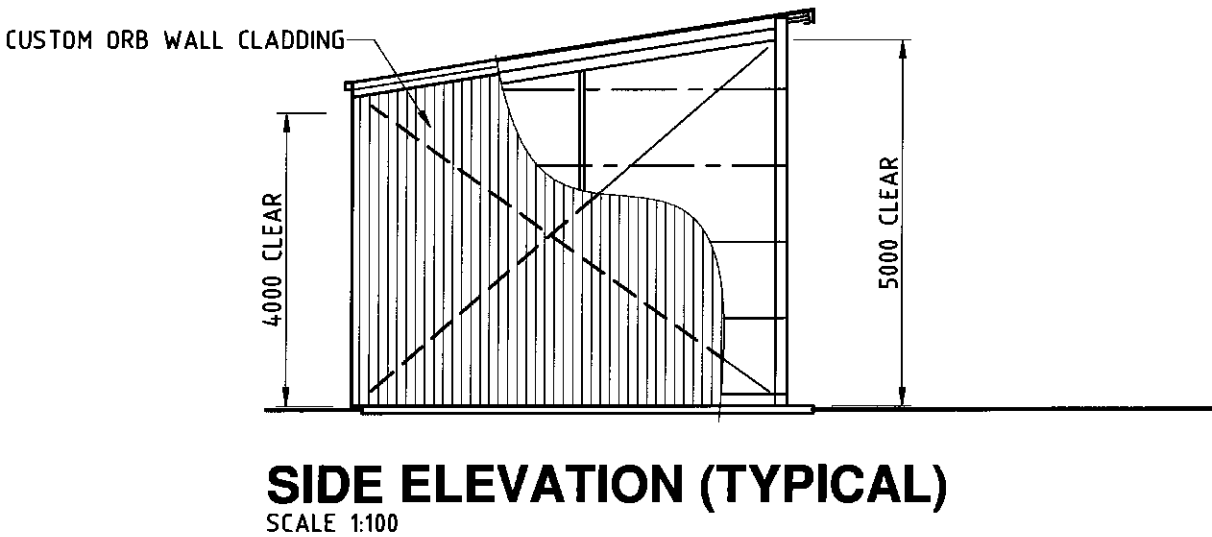

SIDE ELEVATION (TYPICAL)
SCALE 1:100

MEMBER SCHEDULE		
COLUMNS	(C1 - C10)	- 150 UB 18 (4500-6000)
		- 180 UB 16 (7000)
RAFTERS	(R1 - R5)	- 150 UB 18 (4500-6000)
		- 180 UB 16 (7000)
MULLIONS	(M1 - M2)	- 65x65x4.0 S.H.S. (NOT REQUIRED ON 3000)
PURLINS		- Z150 12 (CONTINUOUS)
ROOF BRACE (RB)		- R12 ROD SET MADE TAUT WITH TURNBUCKLES
WALL BRACE (WB)		- R12 ROD SET MADE TAUT WITH TURNBUCKLES
END WALL BRACE (B)		(REFER DETAIL - 1 PER END WALL)

STEELWORK NOTES

1. All work to be in accordance with current SAA codes and the Building Code of Australia.
2. Builder to verify all information and dimensions on site prior to commencement of construction.
3. Unless noted otherwise: Bolts to be M12 8.8/S. All fin, gusset & end plates to be 8 plate. Welds to be 6mm C.F.W. to mild steel and 3mm C.F.W. to cold-rolled steel.
4. Maintain stability of structure throughout erection.
5. All steel work to be power brushed & painted with two coats of red zinc oxide primer or hot dipped galvanized.
6. Design Wind Speed 54 m/s
7. Structural Importance Level 3

NOTE	1. Builder to verify all information & dimensions on site prior to commencement of construction.
	2. DO NOT SCALE DRAWINGS
	3. This drawing and the copyright thereof remains the property of OSBORN LANE Consulting Engineers A.B.N. 51 132 296 754

Revised wind speed	18/12/2012	C
Revised members	17/12/2012	B
Issued	4/12/2012	A
Drawing Revision		

OSBORN LANE


(Head Office)
148A Palmerin St.
Warwick Qld. 4370
Ph 07 4680 3300
Fax 07 4680 3310

25 Warwick Road
Ipswich Qld. 4305
Ph 07 3282 7770
Fax 07 3281 7237

99 Musgrave Road
Red Hill Qld. 4059
Ph 07 3510 8510
Fax 07 3876 3045

PROPOSED BUILDING FRAME TO DRAWING Nos. 5348-HD 1001 FOR AUSFAB CONSTRUCTIONS	
---	--


ROOF FRAMING PLAN		
drawn: C.F.R.	checked: C.F.R.	rev: D
checked: <i>[Signature]</i>	RPEQ. 4084	
scale: As Shown	job no.: WK12-0541	dwg no: -1
SHEET 1 of 2		

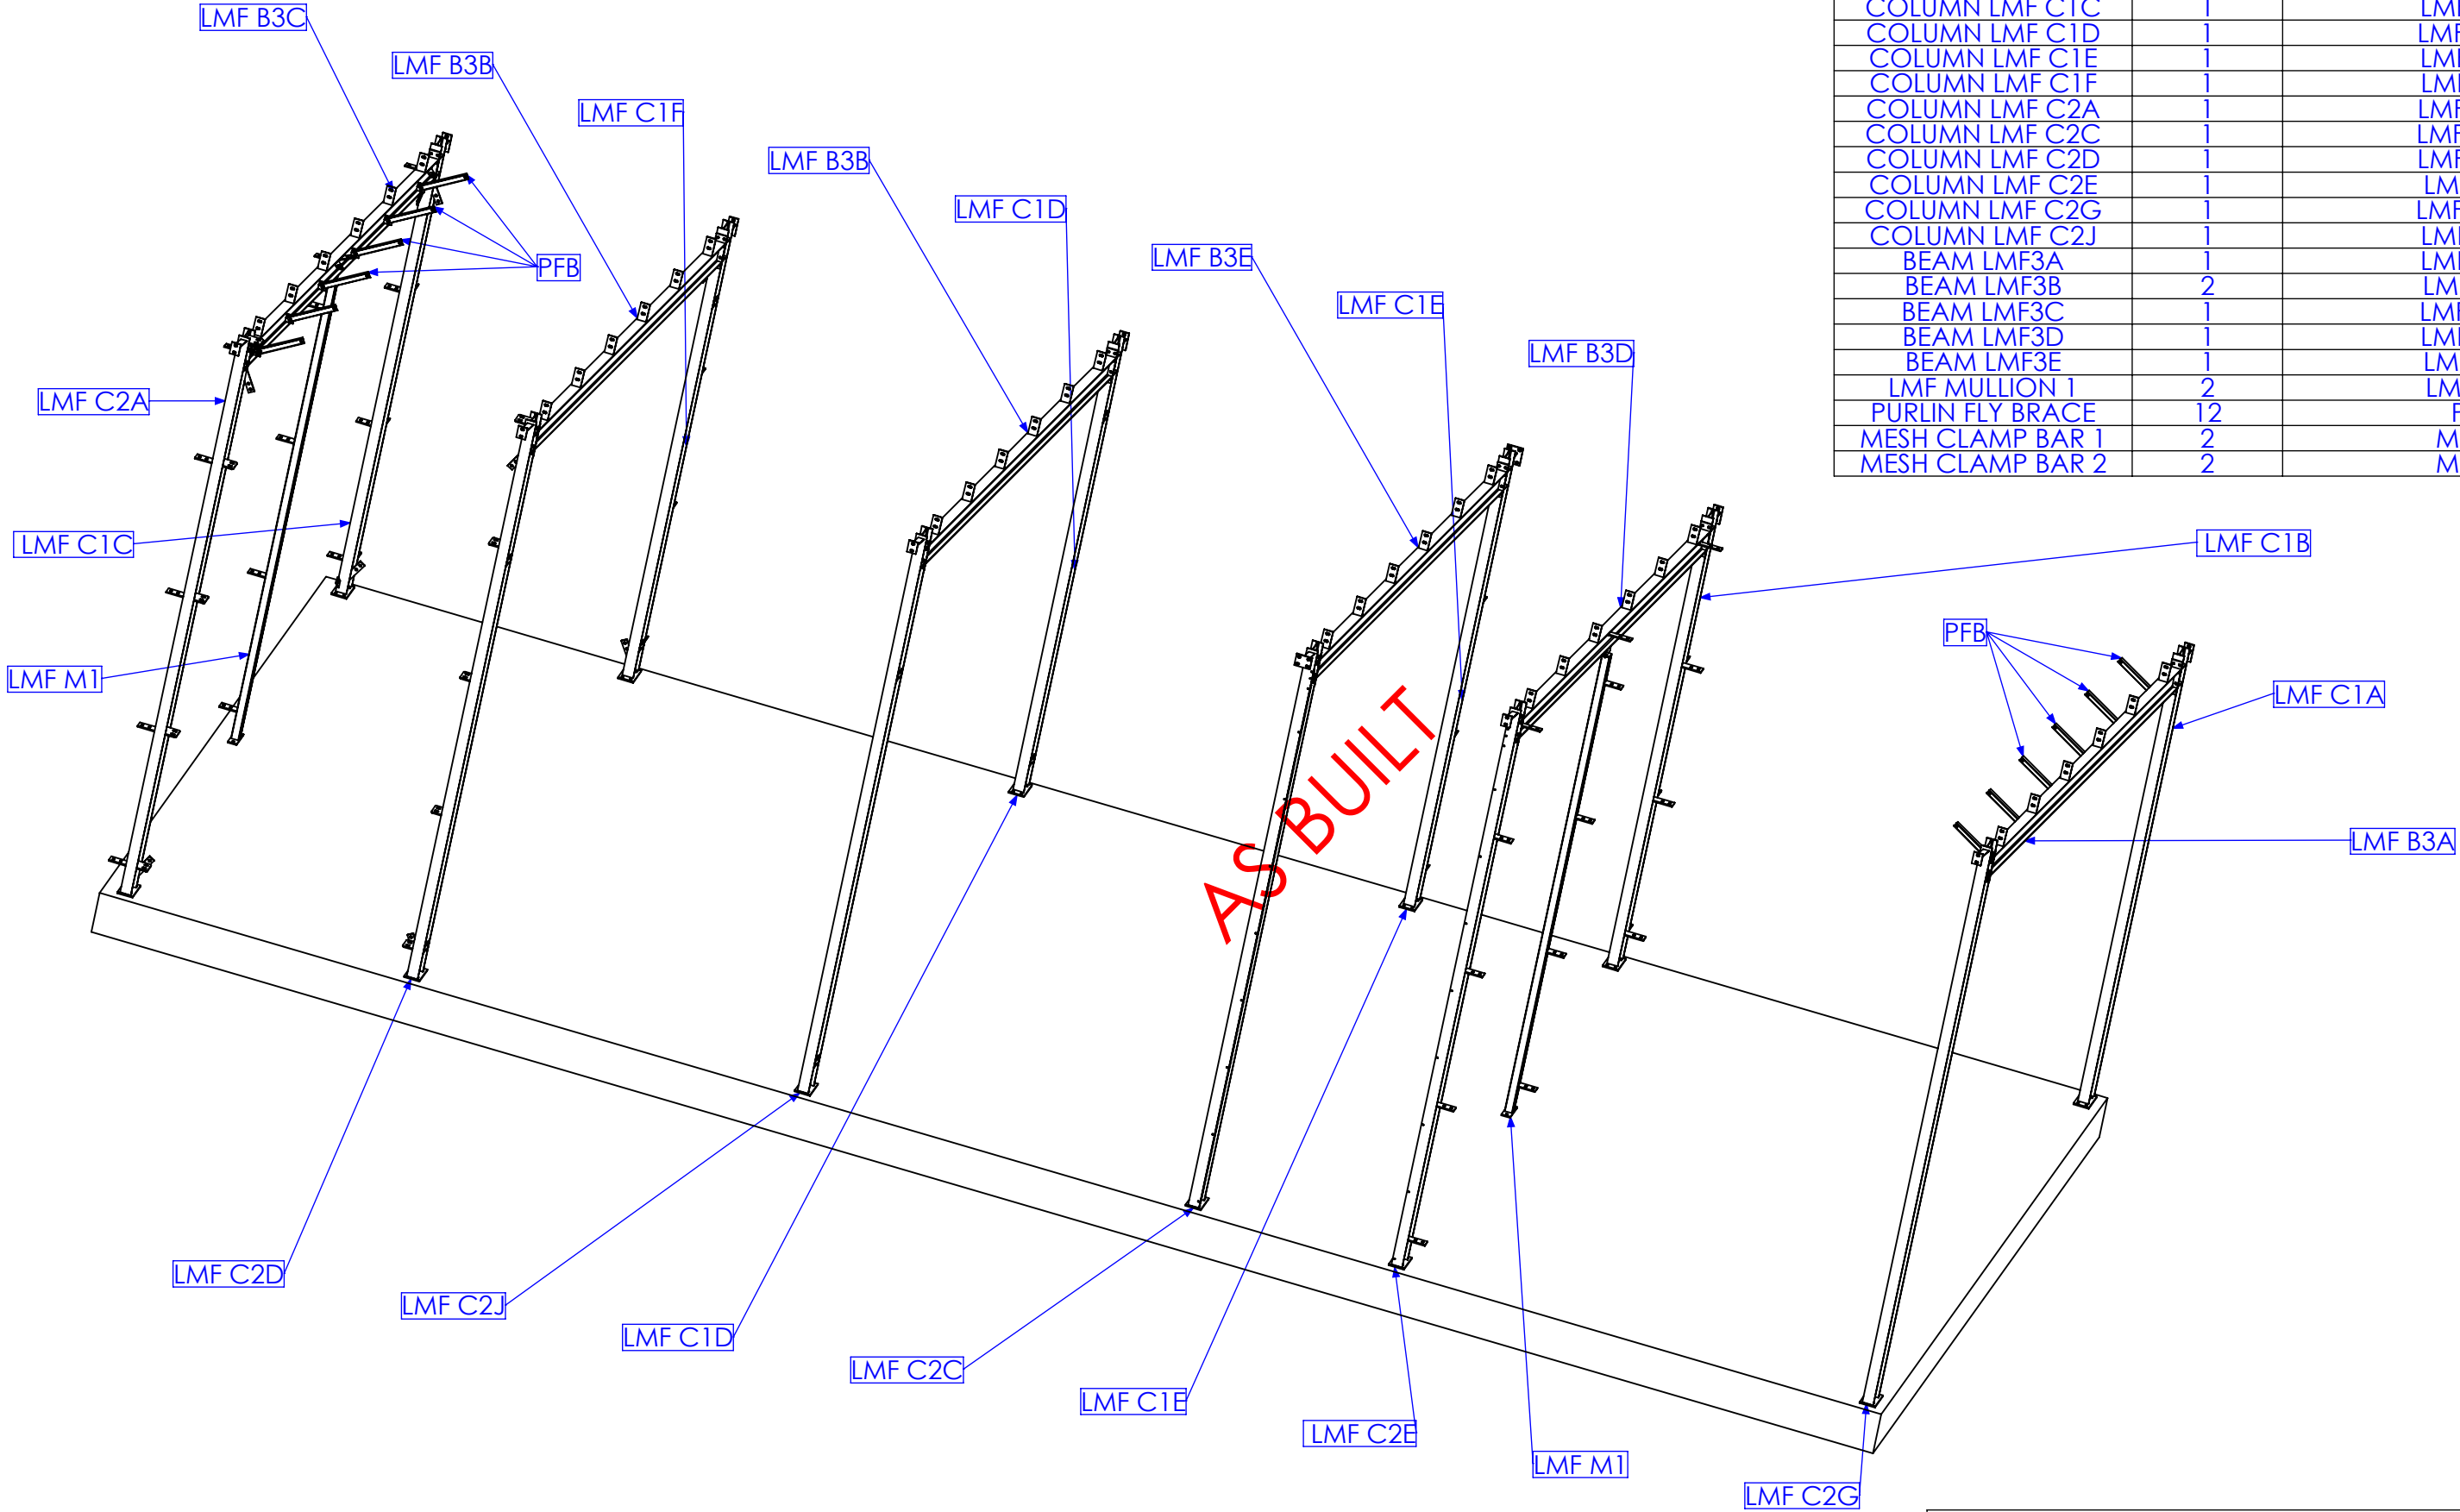


DESCRIPTION	QTY	Part No
COLUMN LMF C1A	1	LMF C1A
COLUMN LMF C1B	1	LMF C1B
COLUMN LMF C1C	1	LMF C1C
COLUMN LMF C1D	1	LMF C1D
COLUMN LMF C1E	1	LMF C1E
COLUMN LMF C1F	1	LMF C1F
COLUMN LMF C2A	1	LMF C2A
COLUMN LMF C2C	1	LMF C2C
COLUMN LMF C2D	1	LMF C2D
COLUMN LMF C2E	1	LMF C2E
COLUMN LMF C2G	1	LMF C2G
COLUMN LMF C2J	1	LMF C2J
BEAM LMF3A	1	LMF B3A
BEAM LMF3B	2	LMF B3B
BEAM LMF3C	1	LMF B3C
BEAM LMF3D	1	LMF B3D
BEAM LMF3E	1	LMF B3E
LMF MULLION 1	2	LMF M1
PURLIN FLY BRACE	12	PFB
MESH CLAMP BAR 1	2	MCB1
MESH CLAMP BAR 2	2	MCB2



RELEASED FOR MANUFACTURE

REV	DESCRIPTION	DATE	AMMENDED BY
01	INITIAL ISSUE	21/12/2012	SDB
02	ADD GATES TO REAR OF SHED	20/02/2013	SDB
03	AS BUILT DRGS	28/06/2013	SDB
04	AMMENDMENT		

FINISH REQUIREMENTS- HOT DIPPED GALVANISED (ALLOW FOR DRAINAGE WHERE APPLICABLE)	APPROX. MASS: kg	DO NOT SCALE IF IN DOUBT - ASK	JOB NUMBER: 5248	QTY: 1
PROPRIETARY NOTICE THIS DRAWING IS THE PROPERTY OF AUSFAB CONSTRUCTIONS. COPYRIGHT IS RESERVED. THIS DRAWING MAY NOT BE COPIED OR USED IN ANY MANNER EXCEPT AS AGREED TO BY AUSFAB CONSTRUCTIONS. THE DRAWINGS, IDEAS & INVENTIONS SHOWN SHALL NOT BE DISCLOSED TO OTHER PARTIES.	 40 Kenilworth Street, Warwick, Queensland, Australia 4011 Phone: 1300 995 970 Fax: 1300 998 983 15/05/2015	DRAWING NOTES: ALL WELDING TO BE IN ACCORDANCE WITH AS1554 PART 1. FOR UNTOLERANCED DIMENSIONS THE FOLLOWING LIMITS SHALL APPLY: FABRICATION ± 2.0mm MACHINING ± 0.25mm	SCALE: 1:50 UNO DRAWN: SB 21/12/12 CHECK: EG/DB/NW - APPROVED: - -	DESCRIPTION LAIDLEY MF BEAMS AND PORTALS FABRICATION DRAWING No. 5248-A-A1-A1
			AS1100 THIRD ANGLE PROJECTION SHEET 1 of 21 REV 03 PURPOSE OF DRAWING FABRICATION	

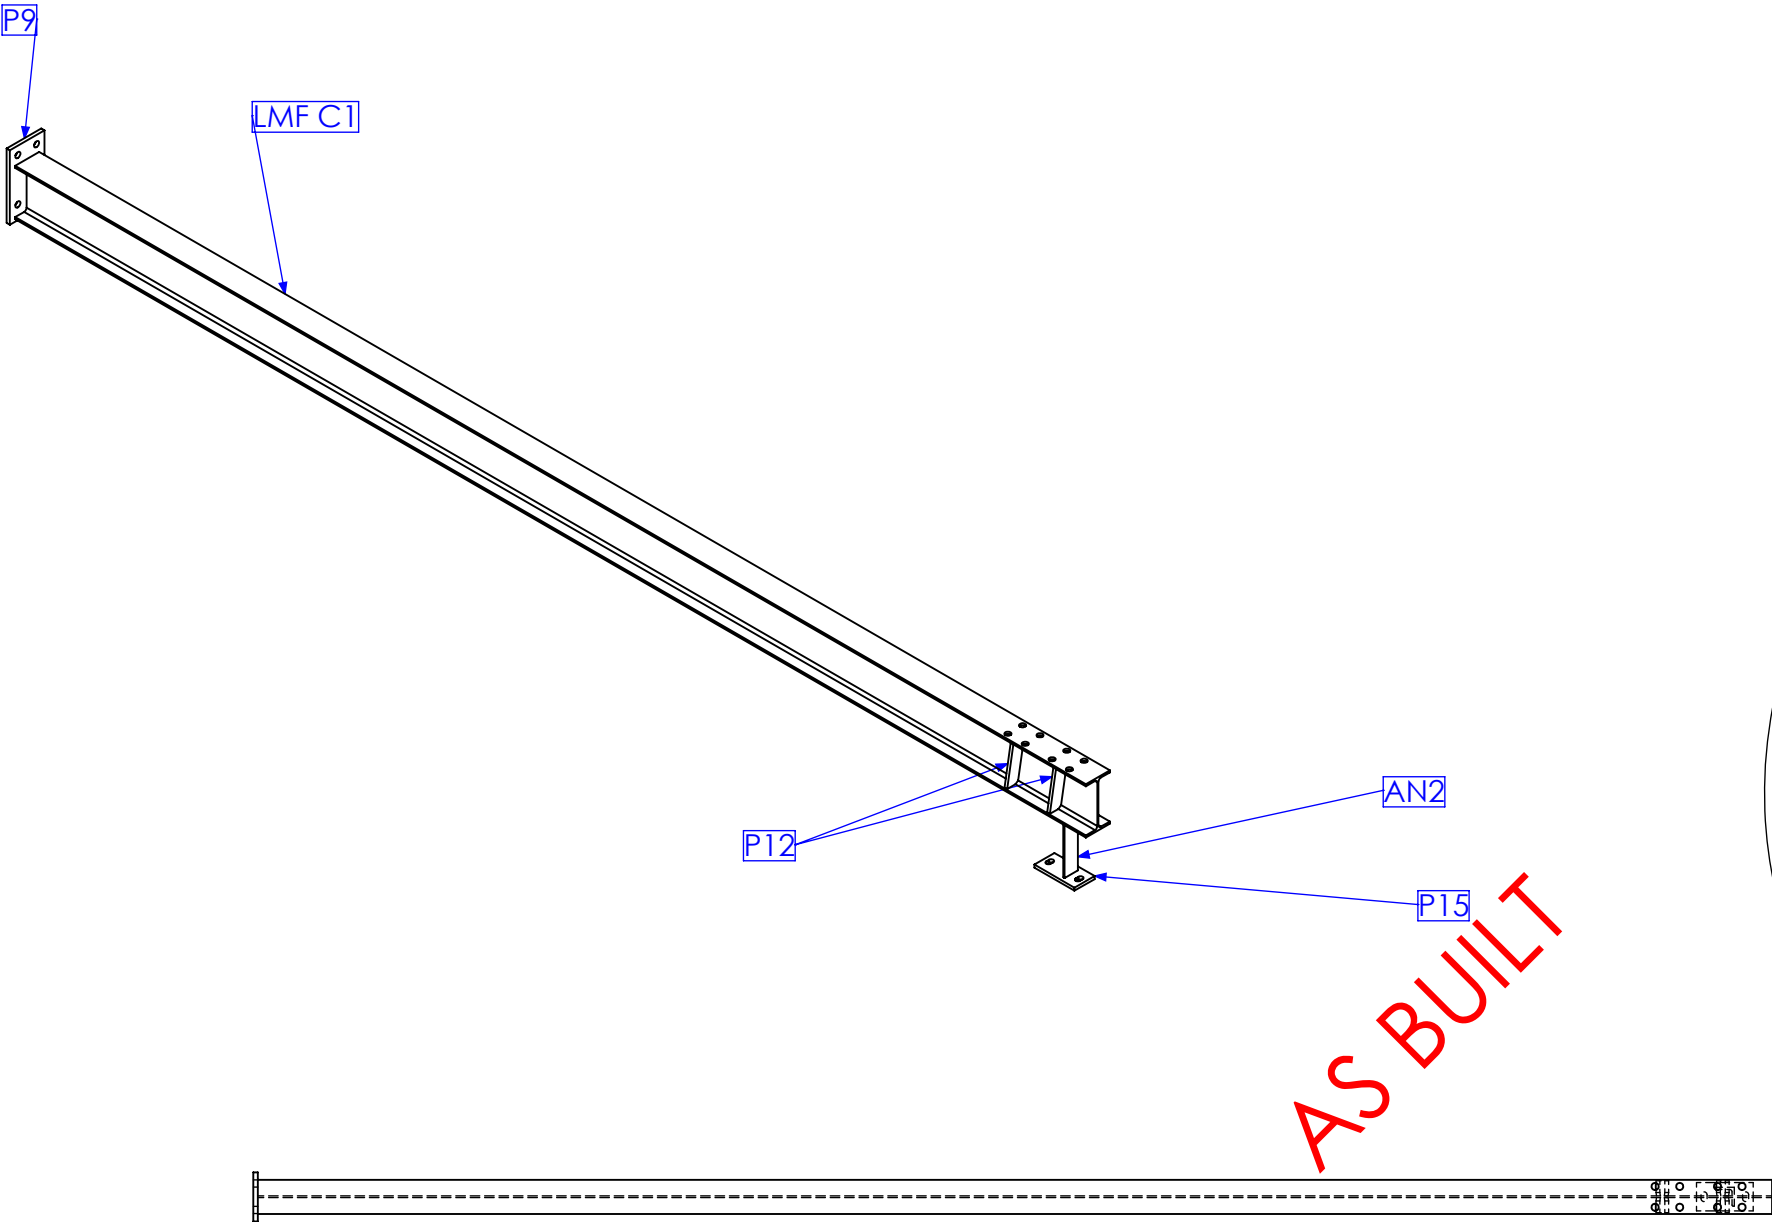


MARK NO.	QTY.	DESCRIPTION	LENGTH
P9	1	130x12 FL	241
LMF C1	1	180 UB 16.1	4006
AN2	1	50x50x6 EA	191
P15	1	75x10 FL	150
P12	4	40x10 FL	162.15

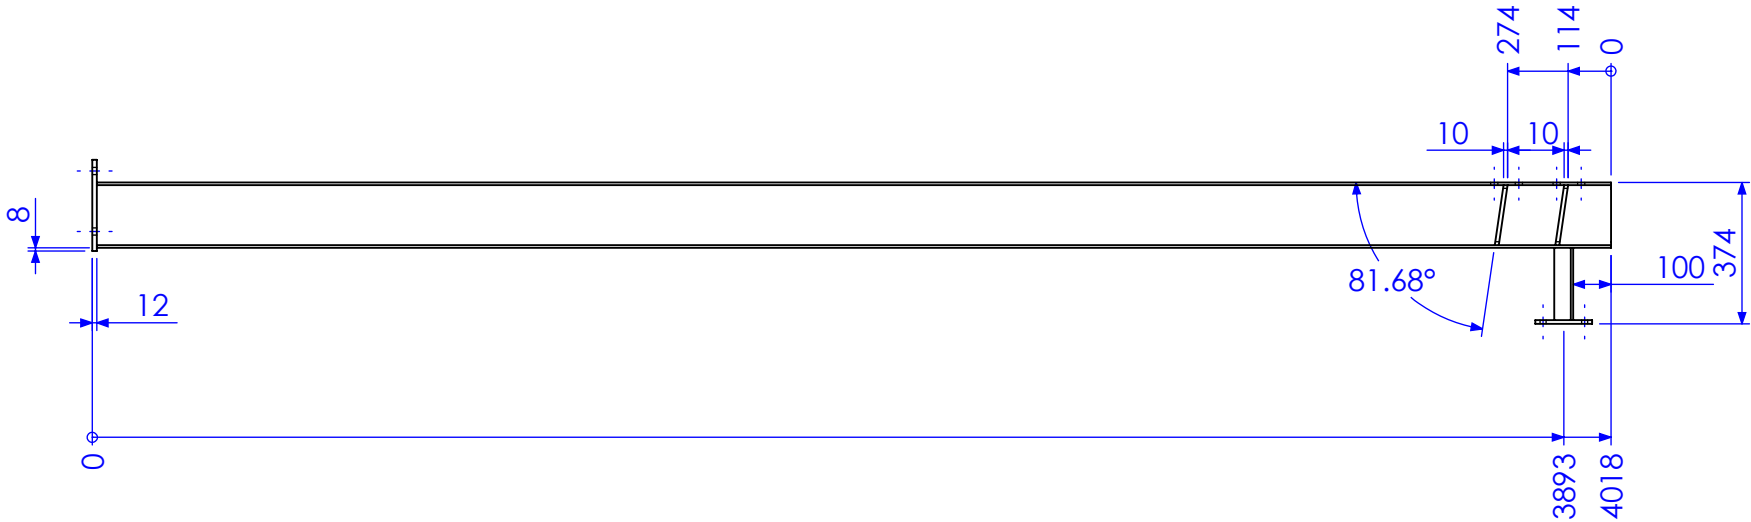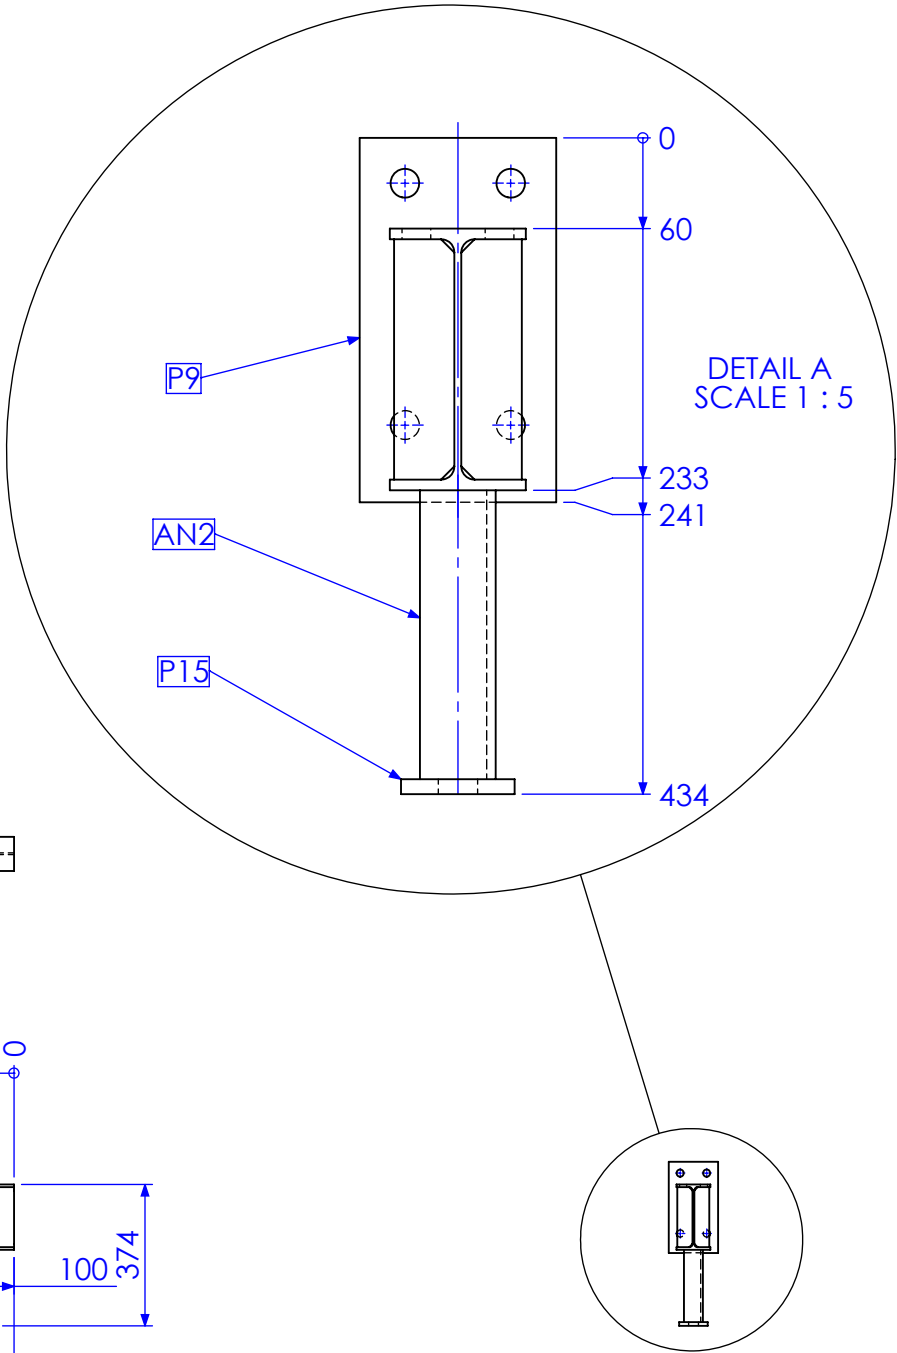


RELEASED FOR MANUFACTURE

REV	DESCRIPTION	DATE	AMMENDED BY
01	INITIAL ISSUE	21/12/2012	SDB
02	ADD GATES TO REAR OF SHED	20/02/2013	SDB
03	AS BUILT DRGS	28/06/2013	SDB
04	AMMENDMENT	15/05/2015	SDB

FINISH REQUIREMENTS- HOT DIPPED GALVANISED (ALLOW FOR DRAINAGE WHERE APPLICABLE)		APPROX. MASS: kg		DO NOT SCALE IF IN DOUBT - ASK		JOB NUMBER: 5248	QTY: 1	
PROPRIETARY NOTICE THIS DRAWING IS THE PROPERTY OF AUSFAB CONSTRUCTIONS. COPYRIGHT IS RESERVED. THIS DRAWING MAY NOT BE COPIED OR USED IN ANY MANNER EXCEPT AS AGREED TO BY AUSFAB CONSTRUCTIONS. THE DRAWINGS, IDEAS & INVENTIONS SHOWN SHALL NOT BE DISCLOSED TO OTHER PARTIES.		DRAWING NOTES: ALL WELDING TO BE IN ACCORDANCE WITH AS1554 PART 1. FOR UNTOLERANCED DIMENSIONS THE FOLLOWING LIMITS SHALL APPLY: FABRICATION ± 2.0mm MACHINING ± 0.25mm		SCALE 1:20 UNO		DESCRIPTION COLUMN LMFC1A		AS1100 THIRD ANGLE PROJECTION SHEET 2 of 21 REV 03 PURPOSE OF DRAWING FABRICATION
40 Kenilworth Street, Warwick, Queensland, Australia 4011 Phone: 1300 995 970 Fax: 1300 998 983		DRAFTING No. LMFC1A		Page 147 of 172				

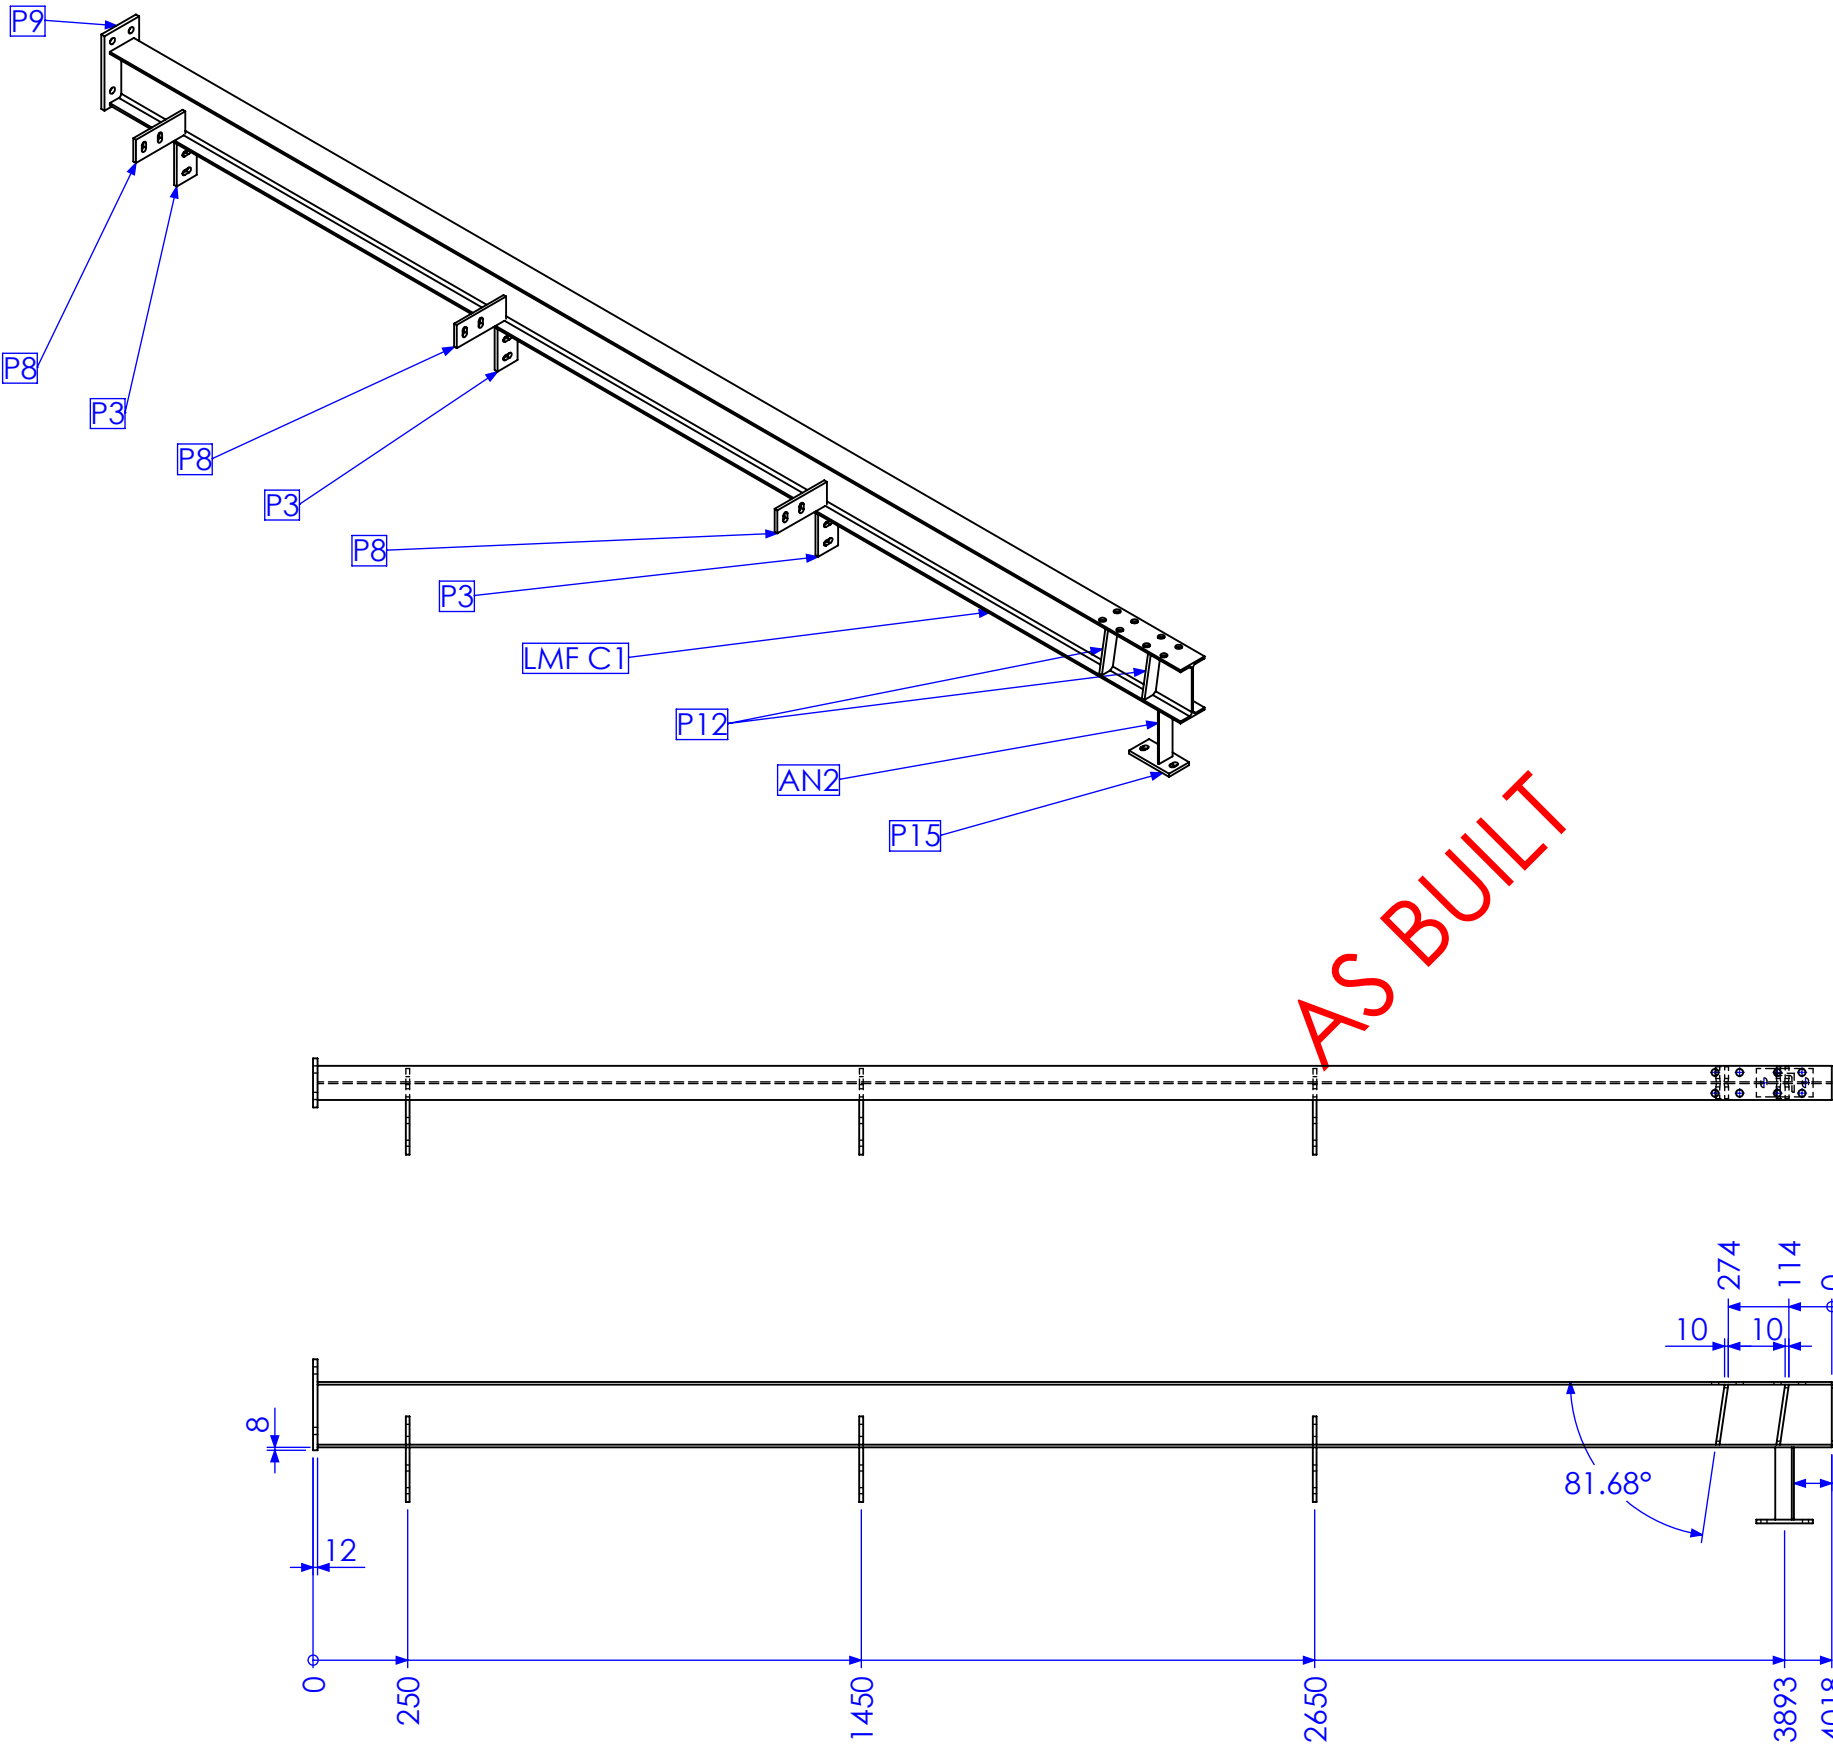


MARK NO.	QTY.	DESCRIPTION	LENGTH
P9	1	130x12 FL	241
LMF C1	1	180 UB 16.1	4006
P3	3	75x10 FL	145
P8	3	75x10 FL	185
AN2	1	50x50x6 EA	191
P15	1	75x10 FL	150
P12	4	40x10 FL	162.15

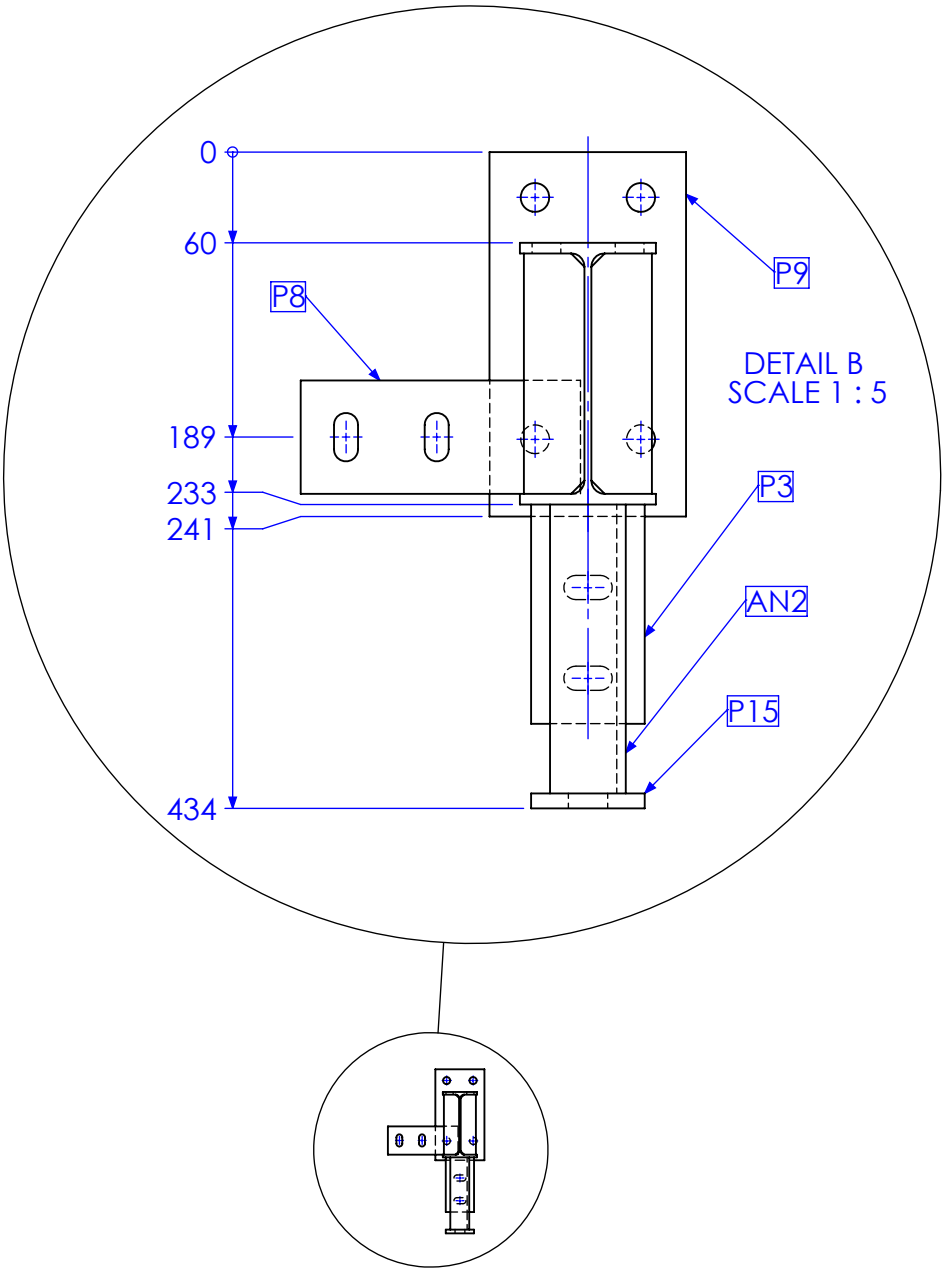


RELEASED FOR MANUFACTURE

REV	DESCRIPTION	DATE	AMMENDED BY
01	INITIAL ISSUE	21/12/2012	SDB
02	ADD GATES TO REAR OF SHED	20/02/2013	SDB
03	AS BUILT DRGS	28/06/2013	SDB
04	AMMENDMENT		

FINISH REQUIREMENTS- HOT DIPPED GALVANISED (ALLOW FOR DRAINAGE WHERE APPLICABLE)		APPROX. MASS: kg		DO NOT SCALE IF IN DOUBT - ASK		JOB NUMBER: 5248	QTY: 1	
PROPRIETARY NOTICE THIS DRAWING IS THE PROPERTY OF AUSFAB CONSTRUCTIONS. COPYRIGHT IS RESERVED. THIS DRAWING MAY NOT BE COPIED OR USED IN ANY MANNER EXCEPT AS AGREED TO BY AUSFAB CONSTRUCTIONS. THE DRAWINGS, IDEAS & INVENTIONS SHOWN SHALL NOT BE DISCLOSED TO OTHER PARTIES.		DRAWING NOTES: ALL WELDING TO BE IN ACCORDANCE WITH AS1554 PART 1. FOR UNTOLERANCED DIMENSIONS THE FOLLOWING LIMITS SHALL APPLY: FABRICATION ± 2.0mm MACHINING ± 0.25mm		SCALE 1:20 UNO		DESCRIPTION COLUMN LMF C1B		AS1100 THIRD ANGLE PROJECTION SHEET 3 of 21 REV 03 PURPOSE OF DRAWING FABRICATION
40 Kenilworth Street, Warwick, Queensland, Australia 4011 Phone: 1300 995 970 Fax: 1300 998 983		15/05/2015		EG/DB/NW -		DRAWING No. LMF C1B		Page 148 of 172

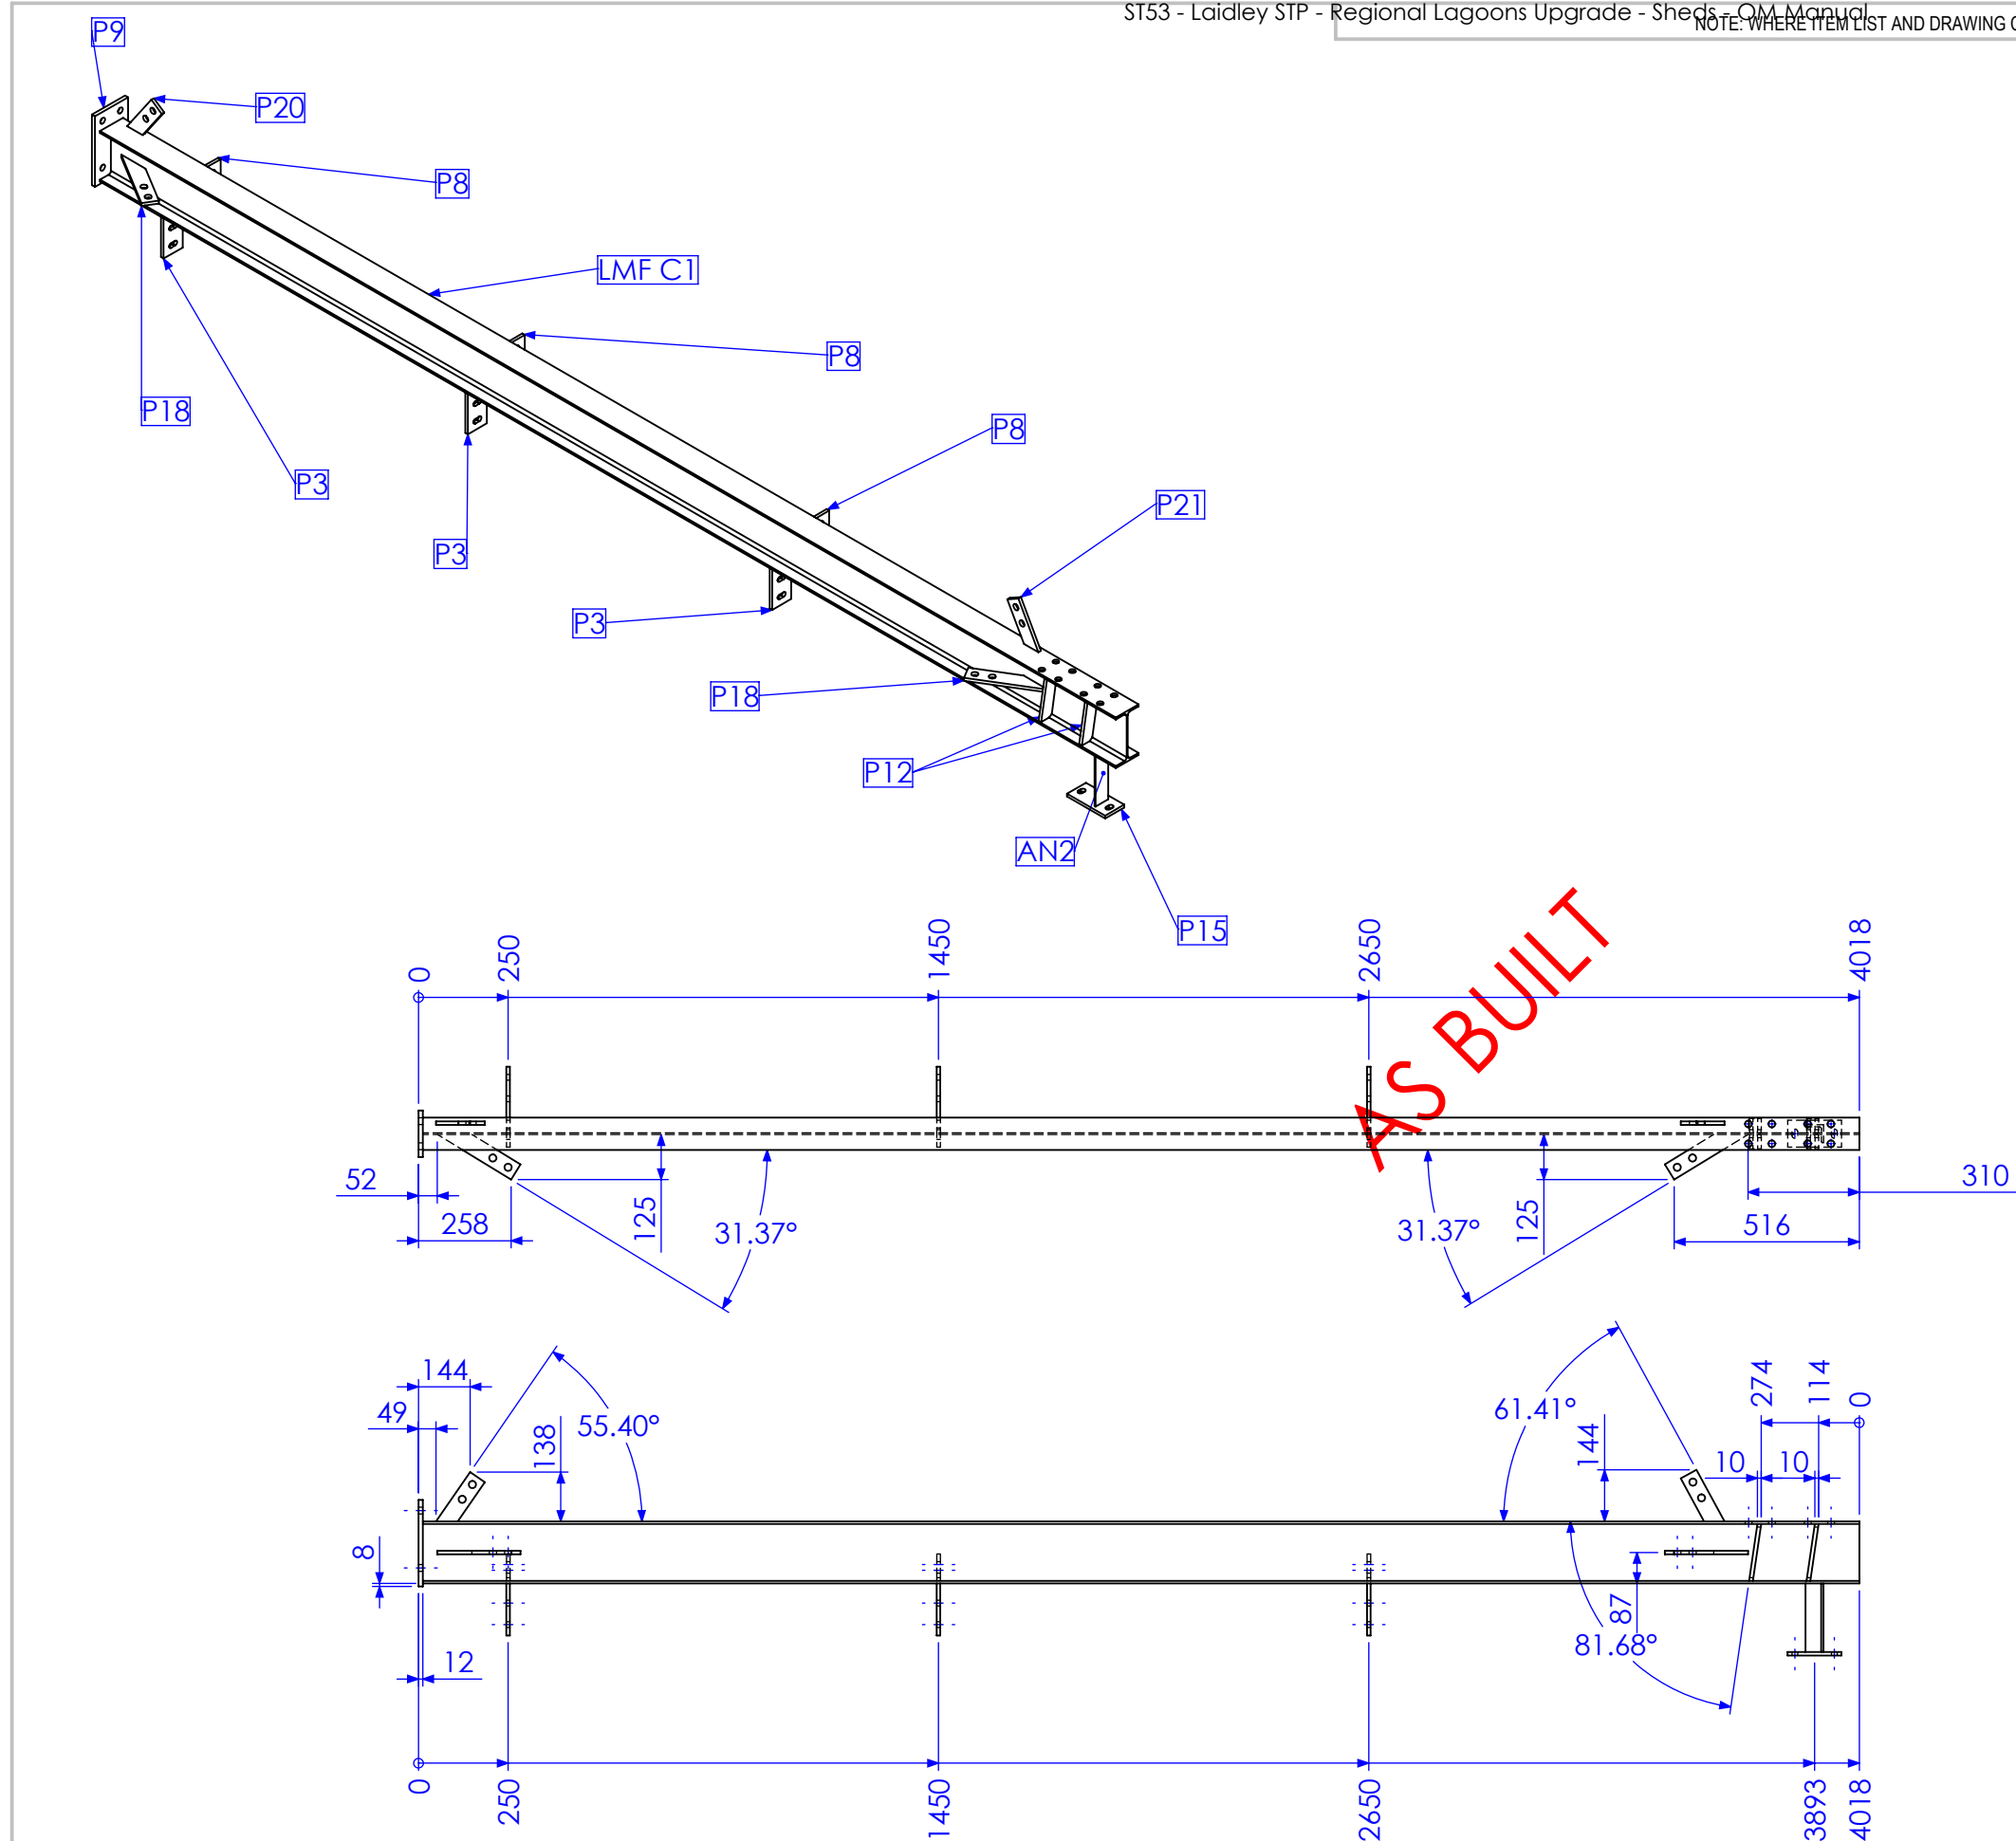


MARK NO.	QTY.	DESCRIPTION	LENGTH
P9	1	130x12 FL	241
LMF C1	1	180 UB 16.1	4006
P3	3	75x10 FL	145
P8	3	75x10 FL	185
P18	2	50x10 FL	241.01
AN2	1	50x50x6 EA	191
P15	1	75x10 FL	150
P20	1	50x10 FL	167.24
P21	1	50x10 FL	163.62
P12	4	40x10 FL	162.15

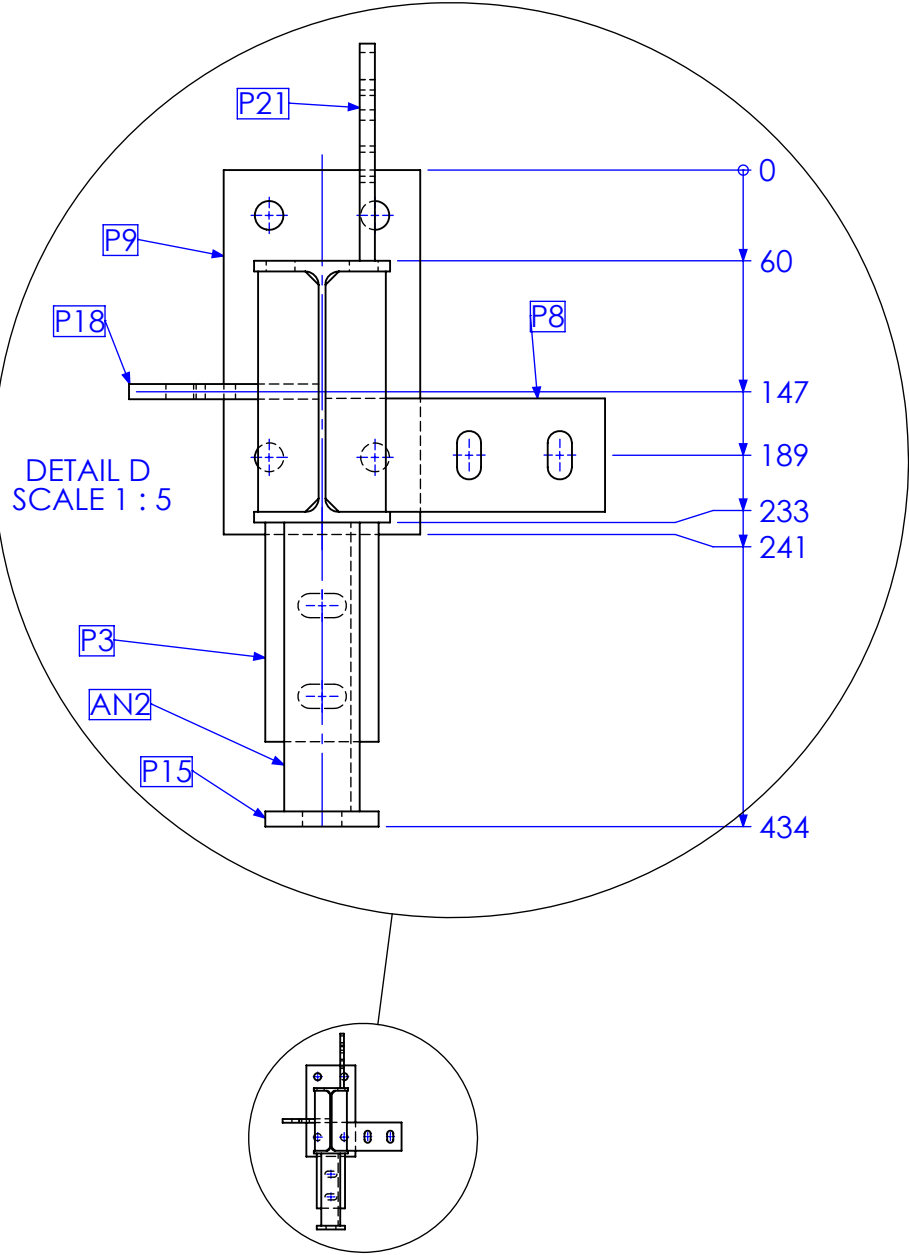


RELEASED FOR MANUFACTURE

REV	DESCRIPTION	DATE	AMMENDED BY
01	INITIAL ISSUE	21/12/2012	SDB
02	ADD GATES TO REAR OF SHED	20/02/2013	SDB
03	AS BUILT DRGS	28/06/2013	SDB
04	AMMENDMENT		

FINISH REQUIREMENTS- HOT DIPPED GALVANISED (ALLOW FOR DRAINAGE WHERE APPLICABLE)		APPROX. MASS: kg		DO NOT SCALE IF IN DOUBT - ASK		JOB NUMBER: 5248	QTY: 1	
PROPRIETARY NOTICE THIS DRAWING IS THE PROPERTY OF AUSFAB CONSTRUCTIONS. COPYRIGHT IS RESERVED. THIS DRAWING MAY NOT BE COPIED OR USED IN ANY MANNER EXCEPT AS AGREED TO BY AUSFAB CONSTRUCTIONS. THE DRAWINGS, IDEAS & INVENTIONS SHOWN SHALL NOT BE DISCLOSED TO OTHER PARTIES.		DRAWING NOTES: ALL WELDING TO BE IN ACCORDANCE WITH AS1554 PART 1. FOR UNTOLERANCED DIMENSIONS THE FOLLOWING LIMITS SHALL APPLY: FABRICATION ± 2.0mm MACHINING ± 0.25mm		SCALE 1:20 UNO		DESCRIPTION COLUMN LMF C1C		AS1100 THIRD ANGLE PROJECTION SHEET 4 of 21 REV 03 PURPOSE OF DRAWING FABRICATION
40 Kenilworth Street, Warwick, Queensland, Australia 4011 Phone: 1300 995 970 Fax: 1300 998 983		15/05/2015		DRAWING No. LMF C1C		Page 149 of 172		

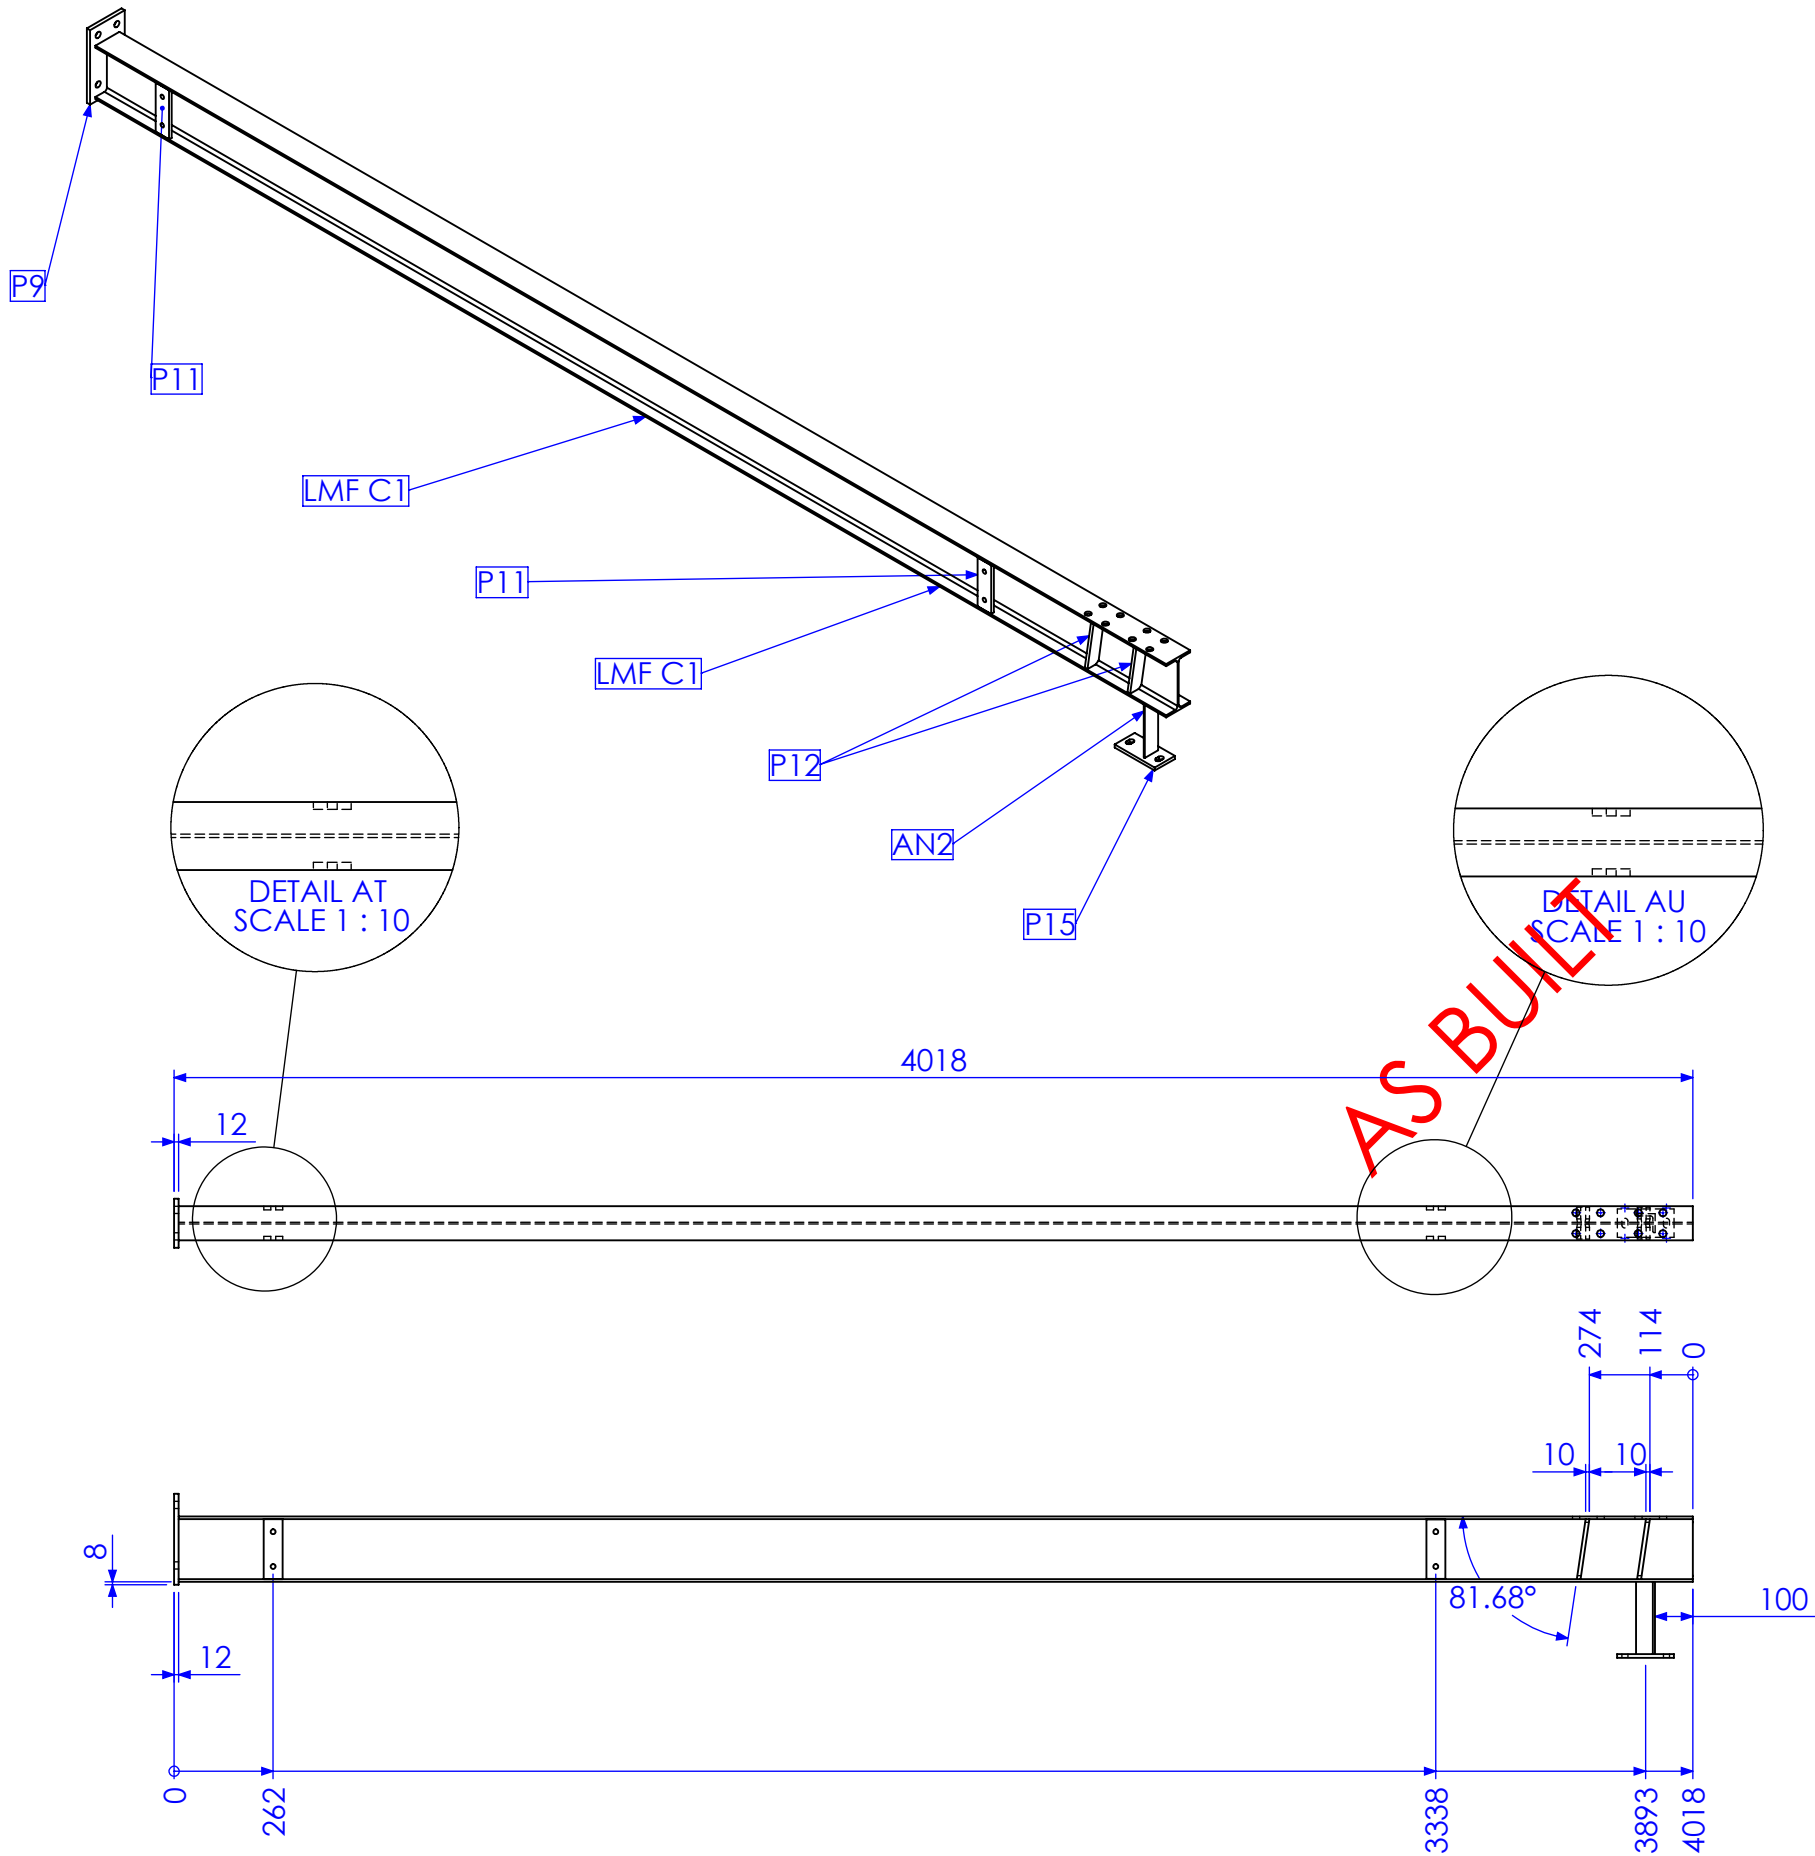


MARK NO.	QTY.	DESCRIPTION	LENGTH
P9	1	130x12 FL	241
LMF C1	1	180 UB 16.1	4006
P15	1	75x10 FL	150
AN2	1	50x50x6 EA	191
P12	4	40x10 FL	162.15
P11	4	50x10 FL	159

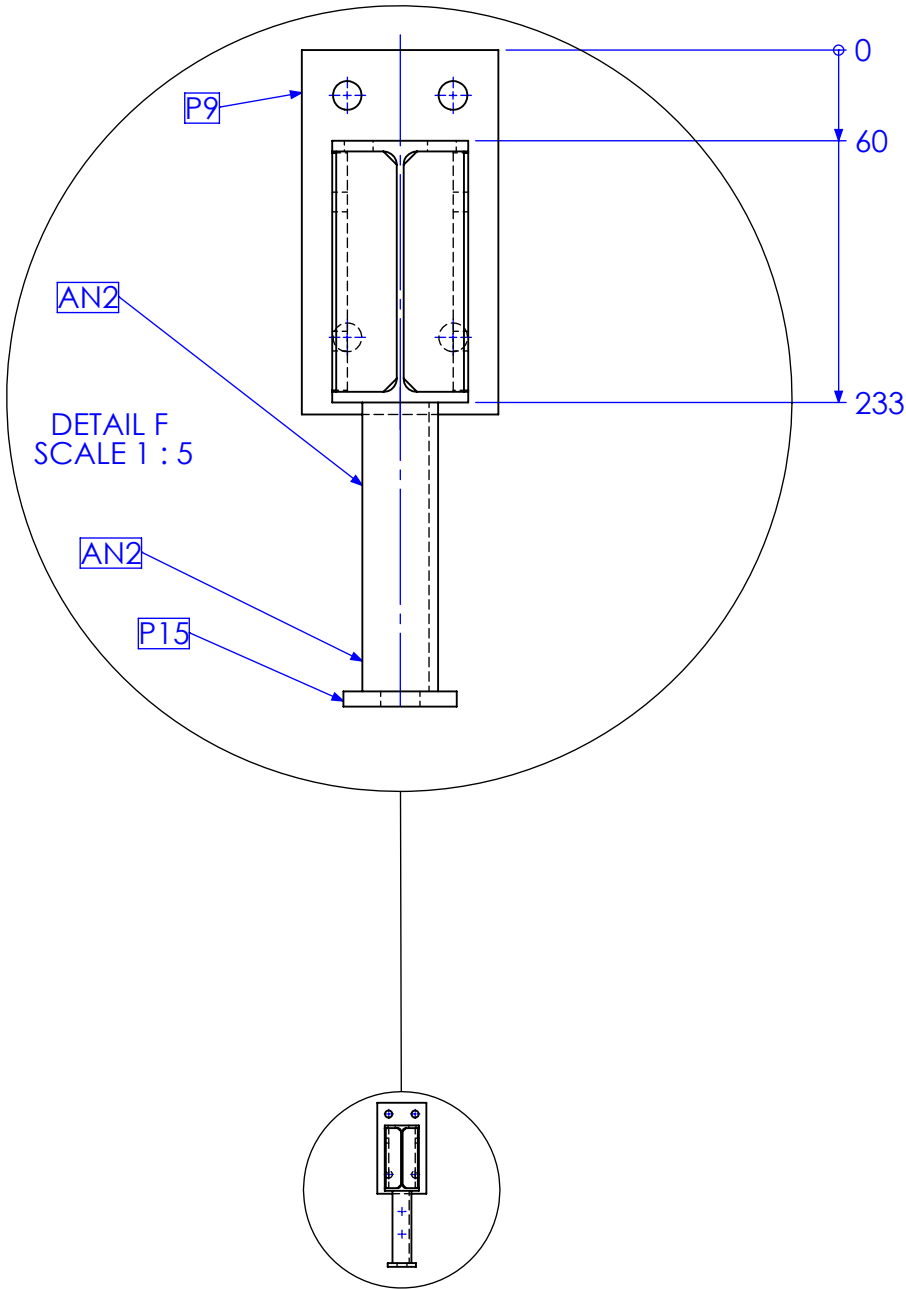


RELEASED FOR MANUFACTURE

REV	DESCRIPTION	DATE	AMMENDED BY
01	INITIAL ISSUE	21/12/2012	SDB
02	ADD GATES TO REAR OF SHED	20/02/2013	SDB
03	AS BUILT DRGS	28/06/2013	SDB
04	AMMENDMENT	15/05/2015	SDB

FINISH REQUIREMENTS- HOT DIPPED GALVANISED (ALLOW FOR DRAINAGE WHERE APPLICABLE)		APPROX. MASS: kg		DO NOT SCALE IF IN DOUBT - ASK		JOB NUMBER: 5248	QTY: 1	
PROPRIETARY NOTICE THIS DRAWING IS THE PROPERTY OF AUSFAB CONSTRUCTIONS. COPYRIGHT IS RESERVED. THIS DRAWING MAY NOT BE COPIED OR USED IN ANY MANNER EXCEPT AS AGREED TO BY AUSFAB CONSTRUCTIONS. THE DRAWINGS, IDEAS & INVENTIONS SHOWN SHALL NOT BE DISCLOSED TO OTHER PARTIES.		DRAWING NOTES: ALL WELDING TO BE IN ACCORDANCE WITH AS1554 PART 1. FOR UNTOLERANCED DIMENSIONS THE FOLLOWING LIMITS SHALL APPLY: FABRICATION ± 2.0mm MACHINING ± 0.25mm		SCALE 1:20 UNO		DESCRIPTION COLUMN LMF C1D		AS1100 THIRD ANGLE PROJECTION SHEET 5 of 21 REV 03 PURPOSE OF DRAWING FABRICATION
40 Kenilworth Street, Warwick, Queensland, Australia 4011 Phone: 1300 995 970 Fax: 1300 998 983		15/05/2015		EG/DB/NW -		DRAWING No. LMF C1D		Page 150 of 172

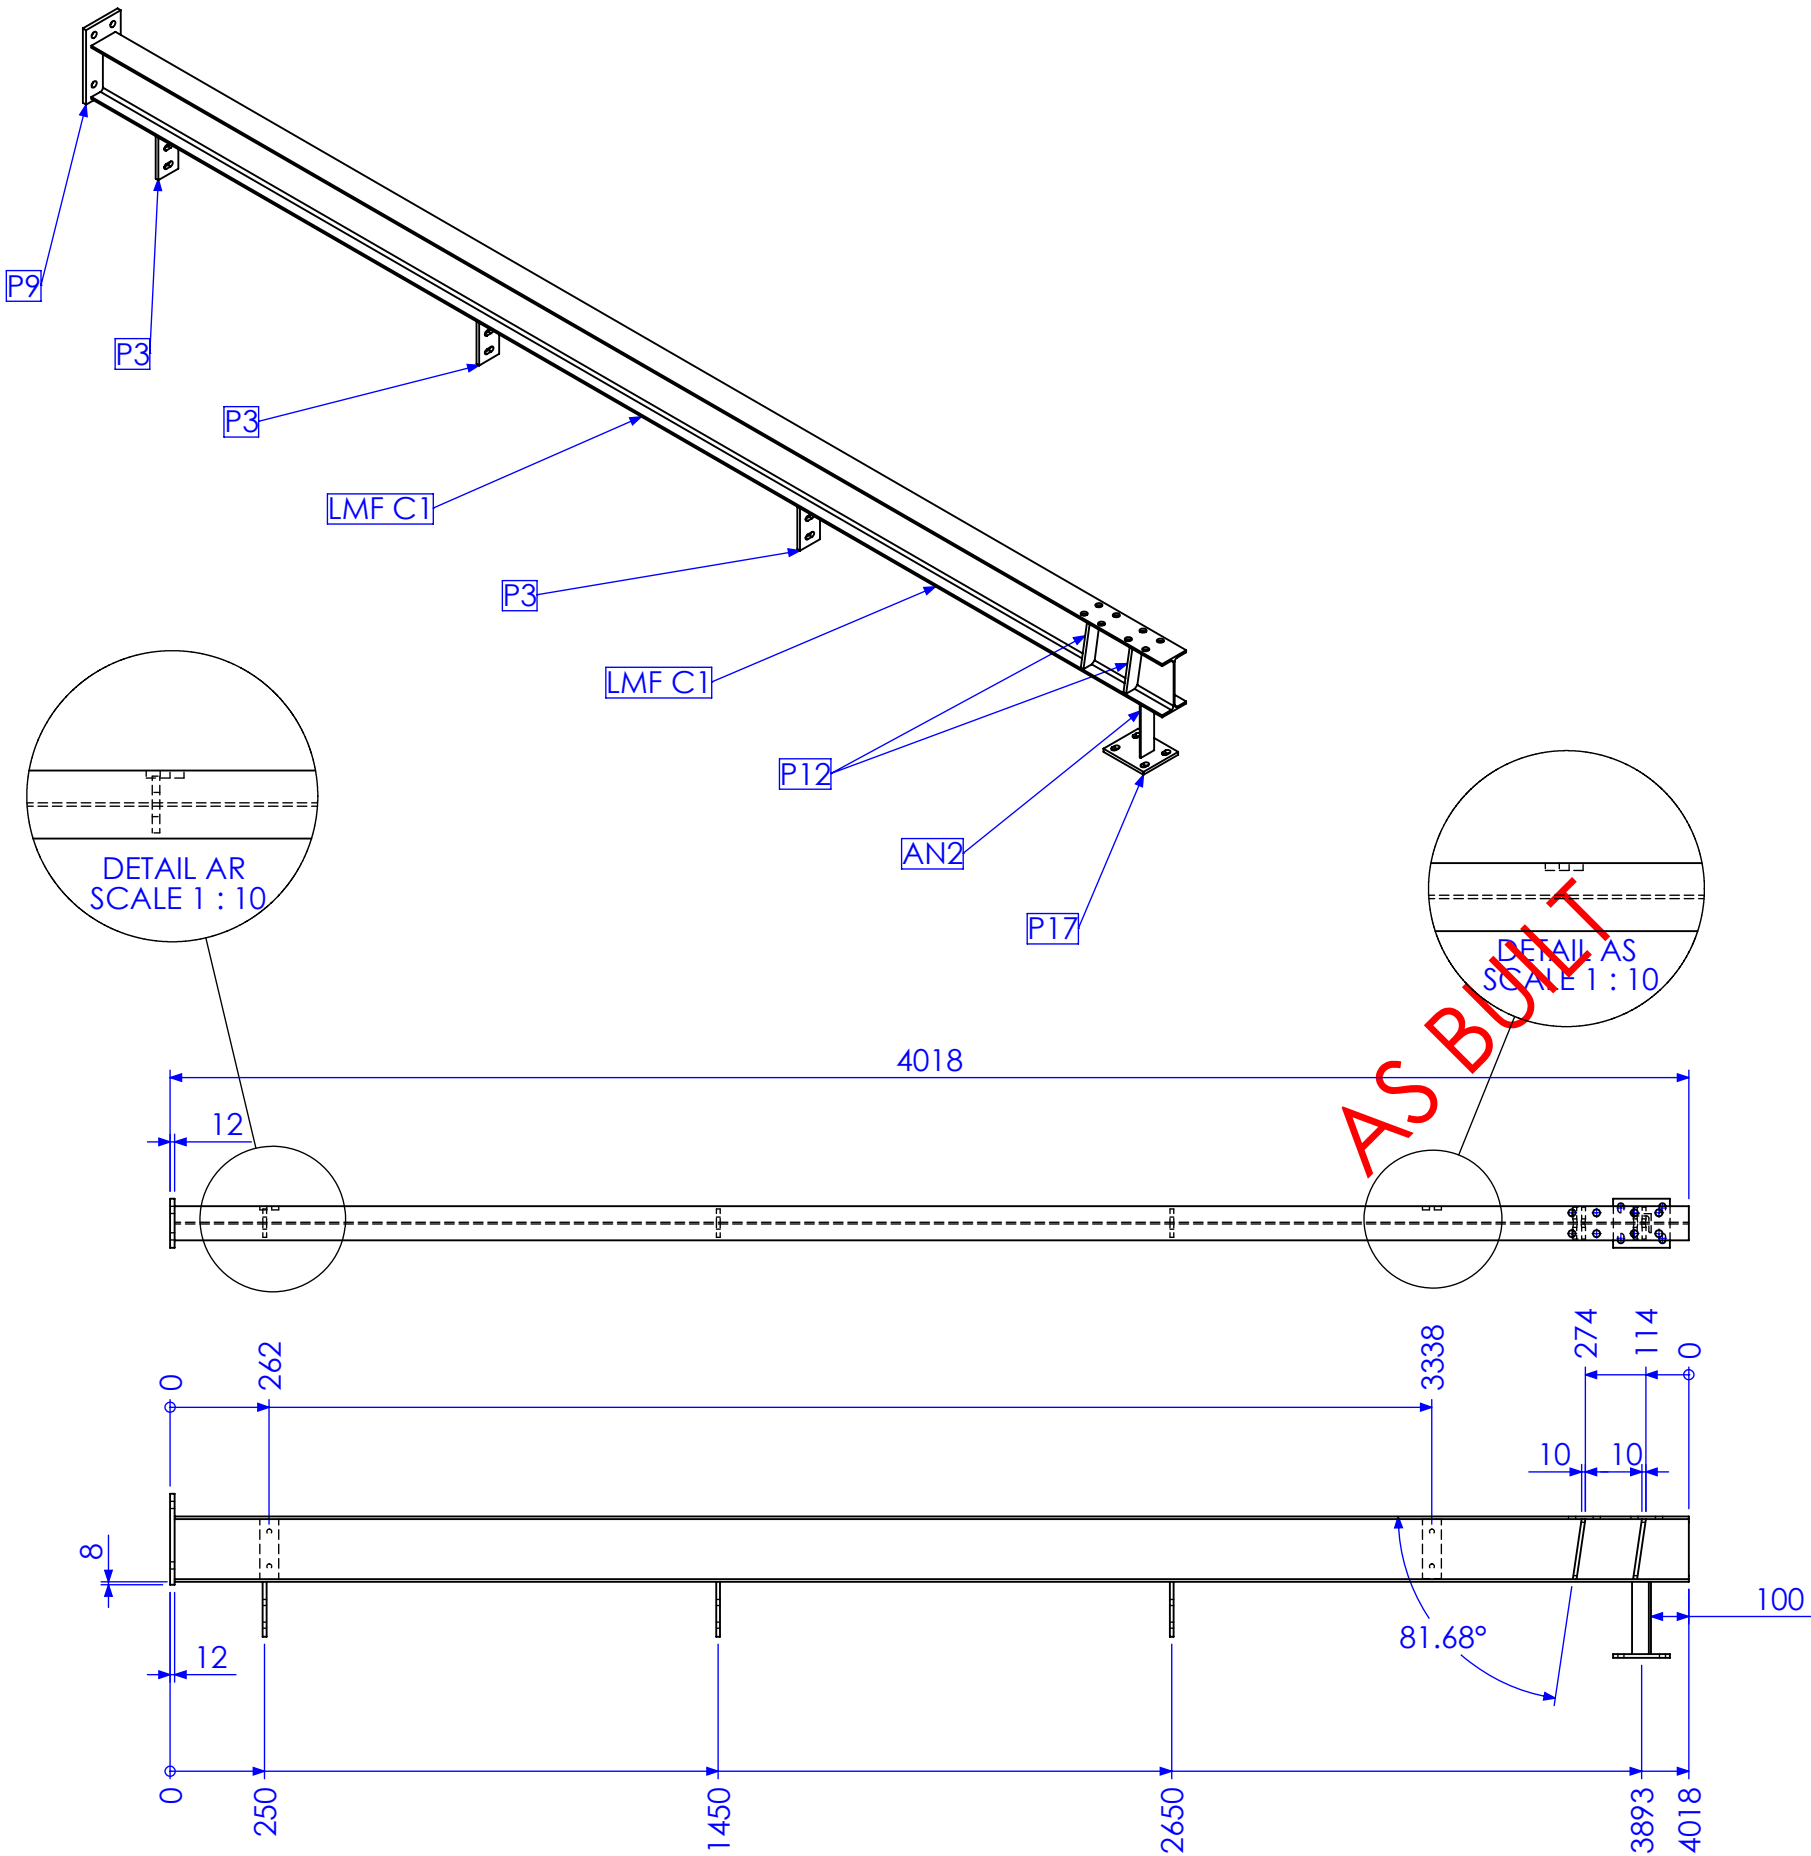

MARK NO.	QTY.	DESCRIPTION	LENGTH
P9	1	130x12 FL	241
LMF C1	1	180 UB 16.1	4006
P3	3	75x10 FL	145
AN2	1	50x50x6 EA	191
P17	1	130x10 FL	150
P12	4	40x10 FL	162.15
P11	2	50x10 FL	159

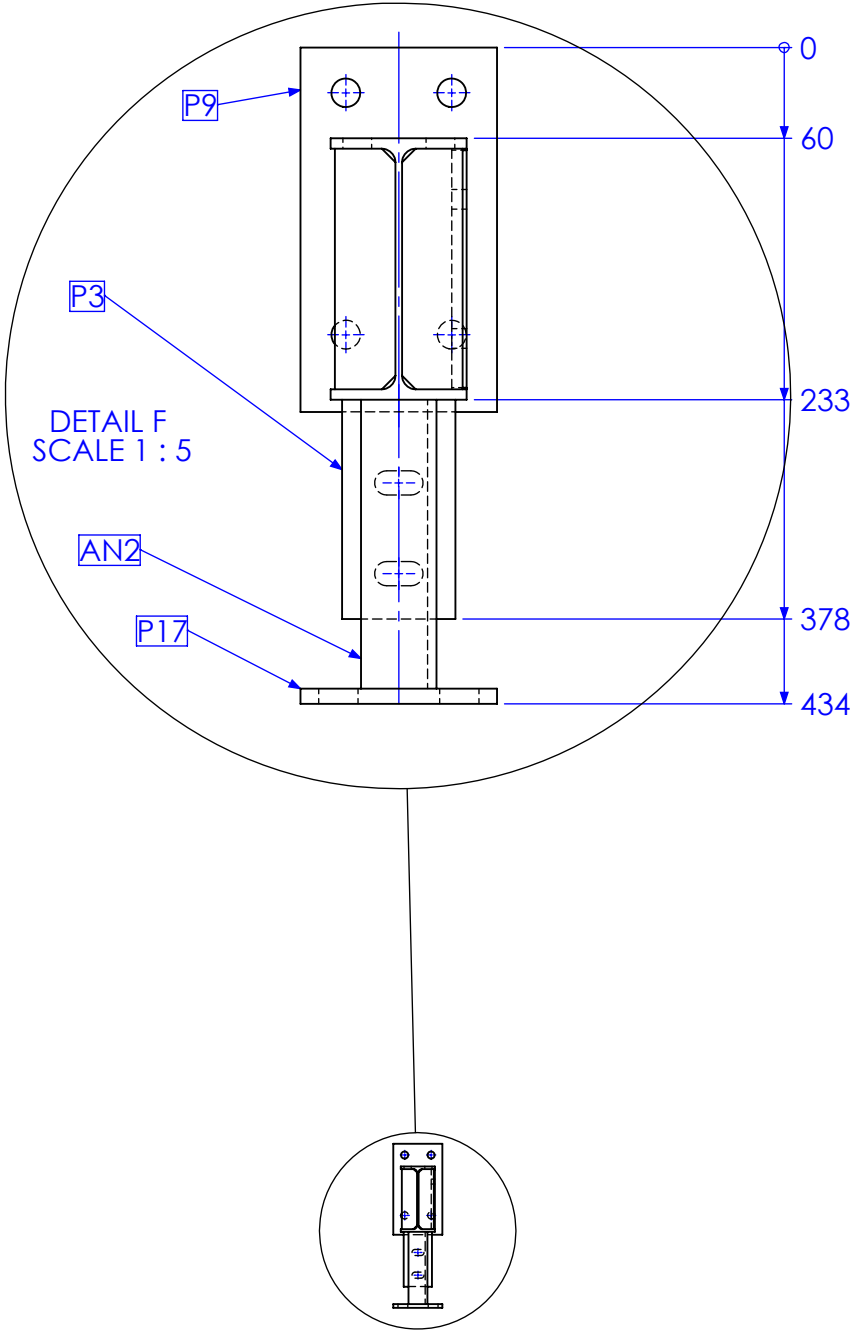


RELEASED FOR MANUFACTURE




REV	DESCRIPTION	DATE	AMMENDED BY
01	INITIAL ISSUE	21/12/2012	SDB
02	ADD GATES TO REAR OF SHED	20/02/2013	SDB
03	AS BUILT DRGS	28/06/2013	SDB
04	AMMENDMENT	DATE	AMMENDED BY

FINISH REQUIREMENTS- HOT DIPPED GALVANISED (ALLOW FOR DRAINAGE WHERE APPLICABLE)		APPROX. MASS: kg		DO NOT SCALE IF IN DOUBT - ASK		JOB NUMBER: 5248	QTY: 1	
PROPRIETARY NOTICE THIS DRAWING IS THE PROPERTY OF AUSFAB CONSTRUCTIONS. COPYRIGHT IS RESERVED. THIS DRAWING MAY NOT BE COPIED OR USED IN ANY MANNER EXCEPT AS AGREED TO BY AUSFAB CONSTRUCTIONS. THE DRAWINGS, IDEAS & INVENTIONS SHOWN SHALL NOT BE DISCLOSED TO OTHER PARTIES.		DRAWING NOTES: ALL WELDING TO BE IN ACCORDANCE WITH AS1554 PART 1. FOR UNTOLERANCED DIMENSIONS THE FOLLOWING LIMITS SHALL APPLY: FABRICATION ± 2.0mm MACHINING ± 0.25mm		SCALE 1:20 UNO		DESCRIPTION COLUMN LMF C1E		AS1100 THIRD ANGLE PROJECTION SHEET 6 of 21 REV 03 PURPOSE OF DRAWING FABRICATION
40 Kenilworth Street, Warwick, Queensland, Australia 4011 Phone: 1300 995 970 Fax: 1300 998 983		15/05/2015		DRAWING No. LMF C1E		Page 151 of 172		

MARK NO.	QTY.	DESCRIPTION	LENGTH
P9	1	130x12 FL	241
LMF C1	1	180 UB 16.1	4006
P3	3	75x10 FL	145
AN2	1	50x50x6 EA	191
P15	1	75x10 FL	150
P18	2	50x10 FL	241.01
P12	4	40x10 FL	162.15
P11	2	50x10 FL	159

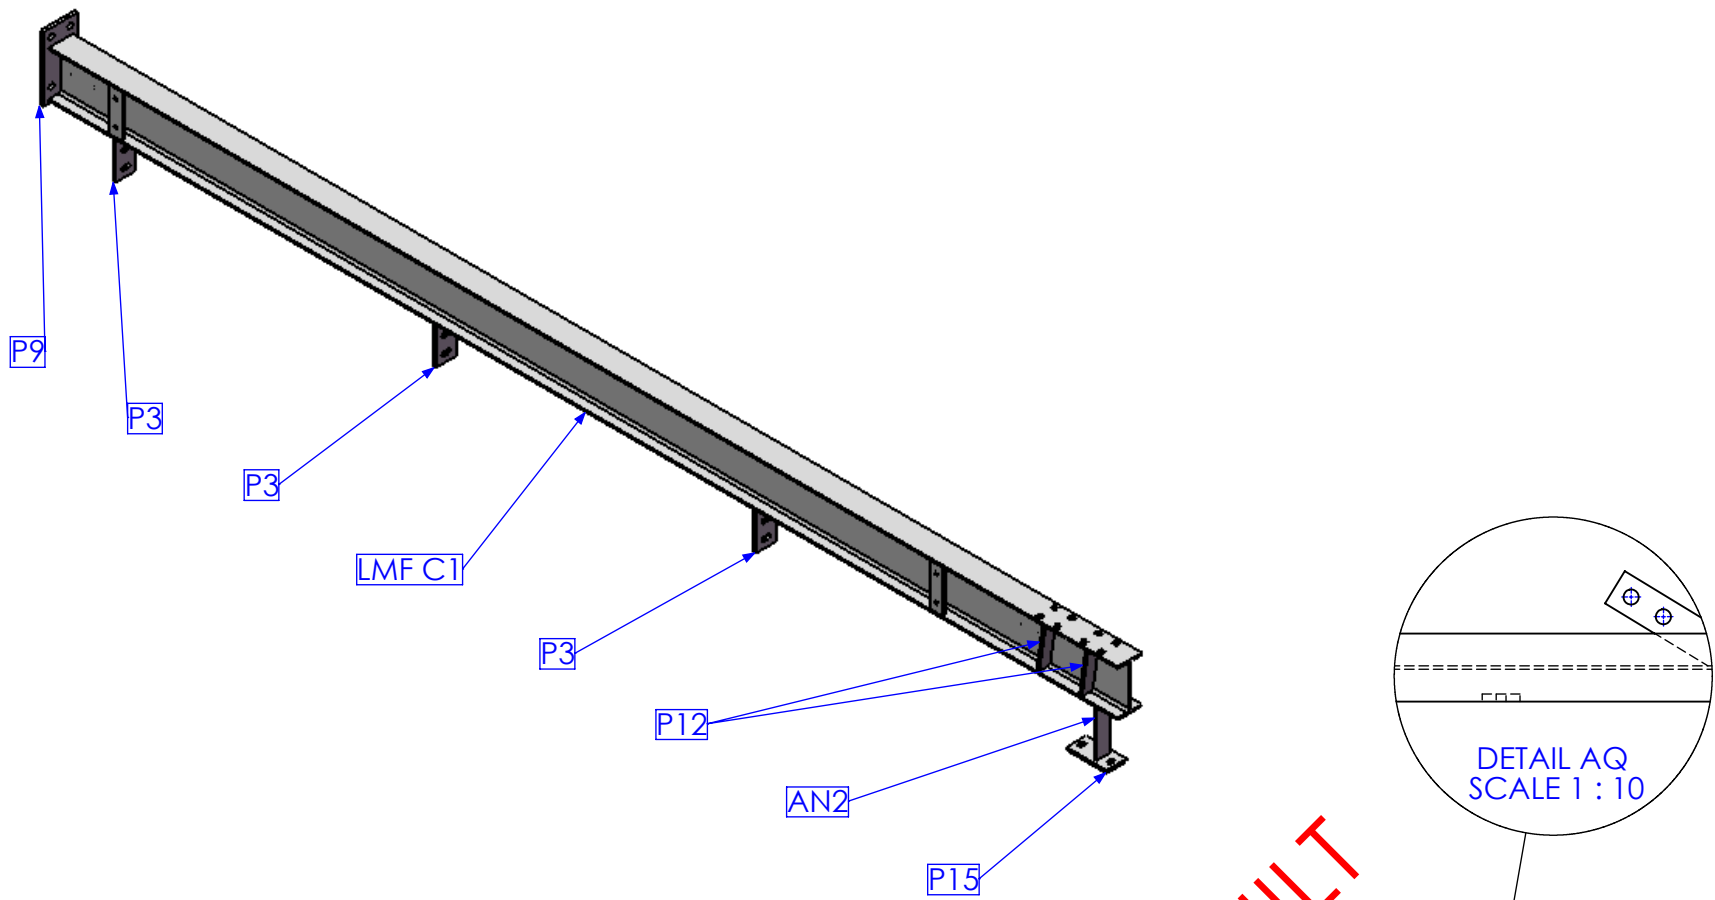

AS BUILT

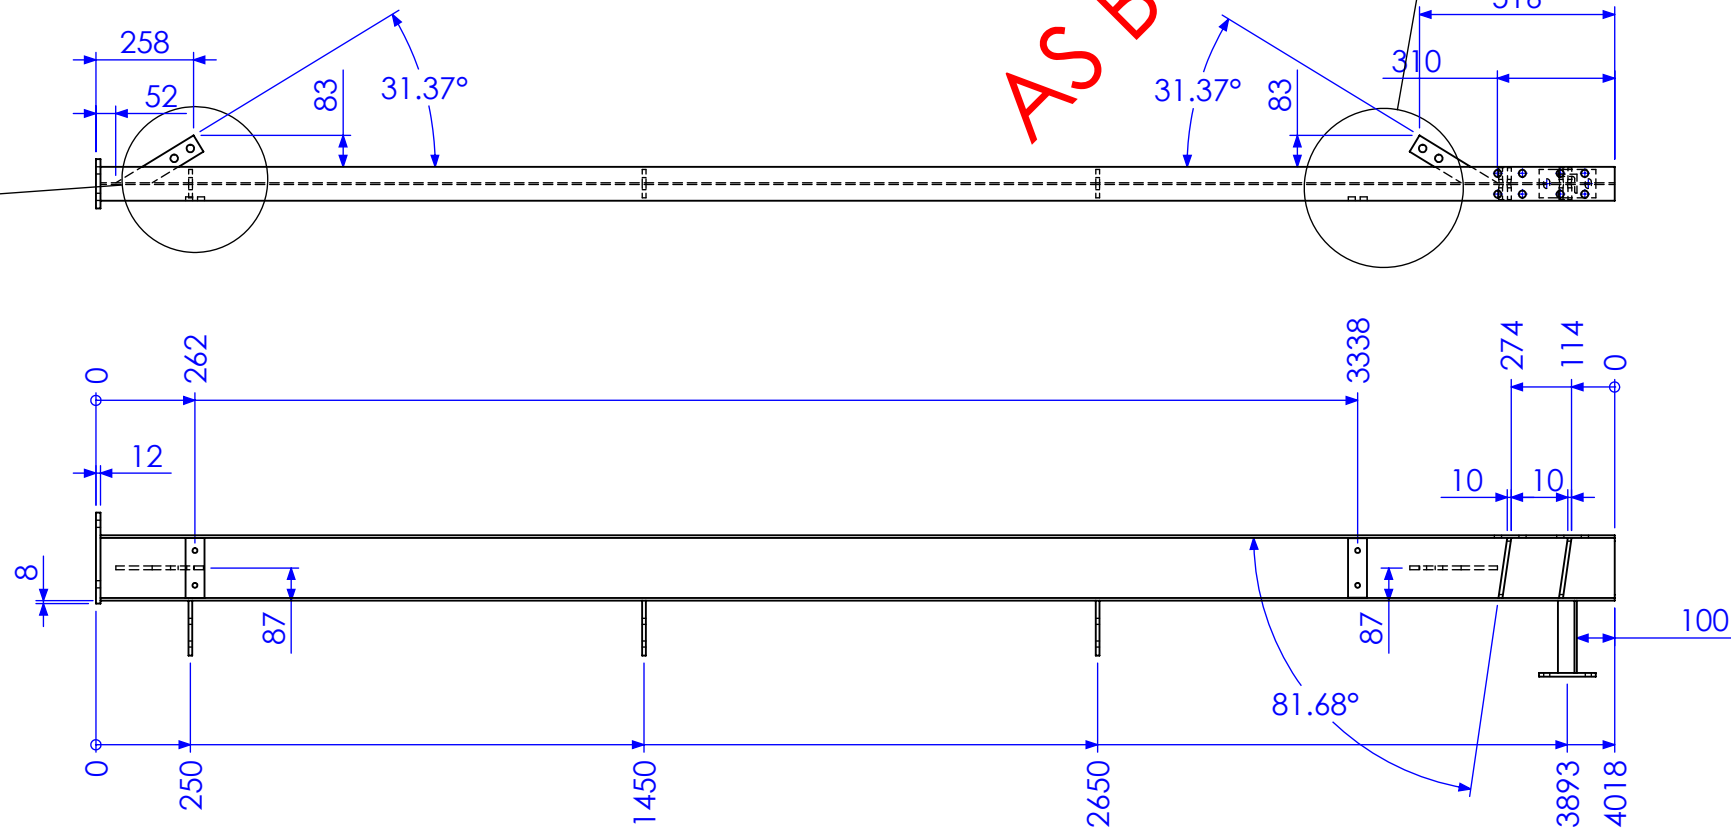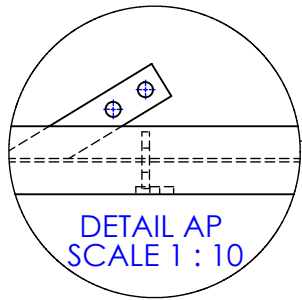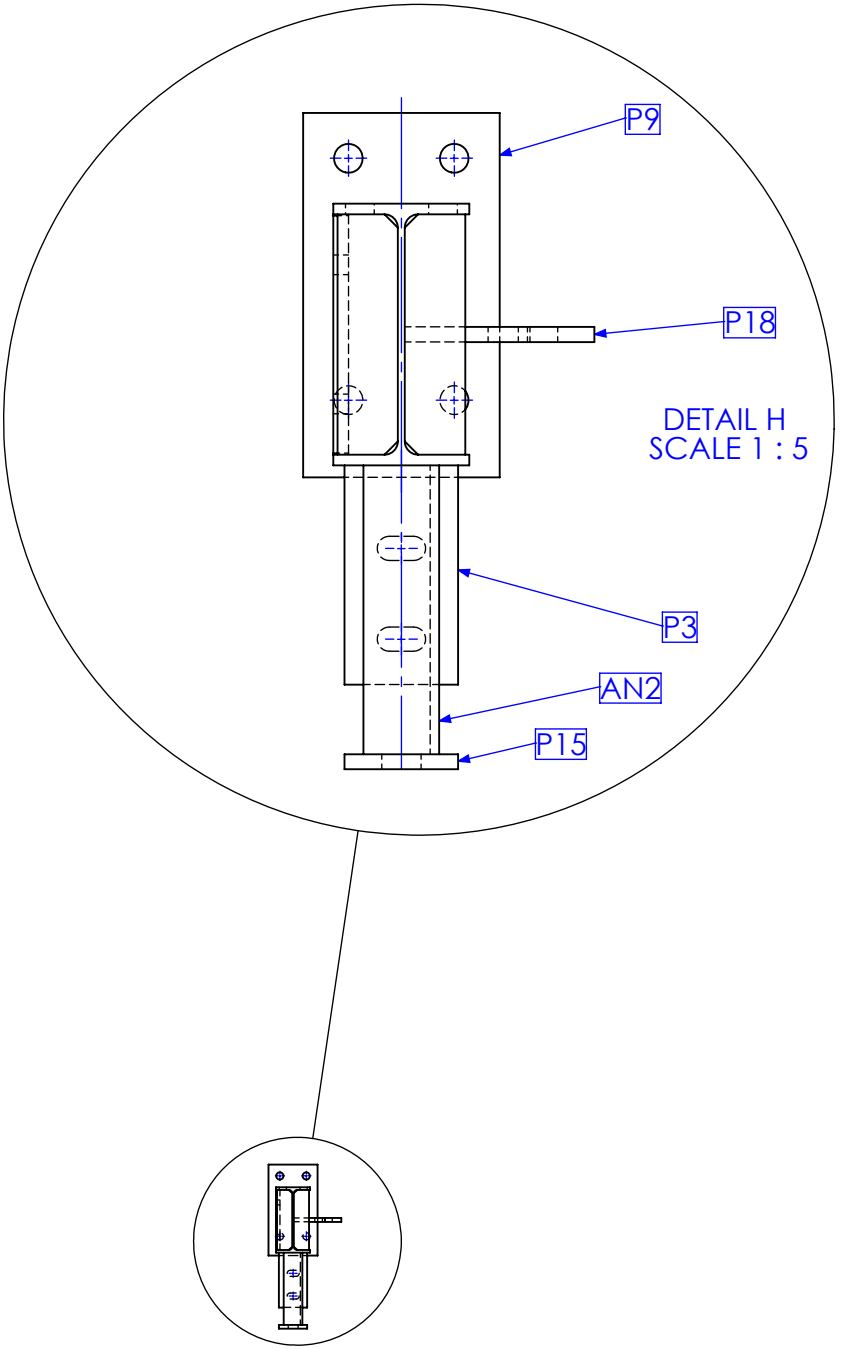



RELEASED FOR MANUFACTURE

REV	DESCRIPTION	DATE	AMMENDED BY
01	INITIAL ISSUE	21/12/2012	SDB
02	ADD GATES TO REAR OF SHED	20/02/2013	SDB
03	AS BUILT DRGS	28/06/2013	SDB
04	AMMENDMENT		

FINISH REQUIREMENTS- HOT DIPPED GALVANISED (ALLOW FOR DRAINAGE WHERE APPLICABLE)		APPROX. MASS: kg		DO NOT SCALE IF IN DOUBT - ASK		JOB NUMBER: 5248	QTY: 2	
PROPRIETARY NOTICE THIS DRAWING IS THE PROPERTY OF AUSFAB CONSTRUCTIONS. COPYRIGHT IS RESERVED. THIS DRAWING MAY NOT BE COPIED OR USED IN ANY MANNER EXCEPT AS AGREED TO BY AUSFAB CONSTRUCTIONS. THE DRAWINGS, IDEAS & INVENTIONS SHOWN SHALL NOT BE DISCLOSED TO OTHER PARTIES.		DRAWING NOTES: ALL WELDING TO BE IN ACCORDANCE WITH AS1554 PART 1. FOR UNTOLERANCED DIMENSIONS THE FOLLOWING LIMITS SHALL APPLY: FABRICATION ± 2.0mm MACHINING ± 0.25mm		SCALE 1:20 UNO		DESCRIPTION COLUMN LMF C1F		AS1100 THIRD ANGLE PROJECTION SHEET 7 of 21 REV 03 PURPOSE OF DRAWING FABRICATION
40 Kenilworth Street, Warwick, Queensland, Australia 4011 Phone: 1300 995 970 Fax: 1300 998 983		15/05/2015		EG/DB/NW -		DRAWING No. LMF C1F		Page 152 of 172

TYPE A

MARK NO.	QTY.	DESCRIPTION	LENGTH
P9	1	130x12 FL	241
LMF C2	1	180 UB 16.1	4983
AN4	1	50x50x6 EA	303.29
P10	1	75x10 FL	100
P21	1	50x10 FL	163.62
P20	1	50x10 FL	167.24
P8	4	75x10 FL	185
P23	5	130x10 FL	136
P26	2	50x10 FL	193.89
P12	4	40x10 FL	162.15

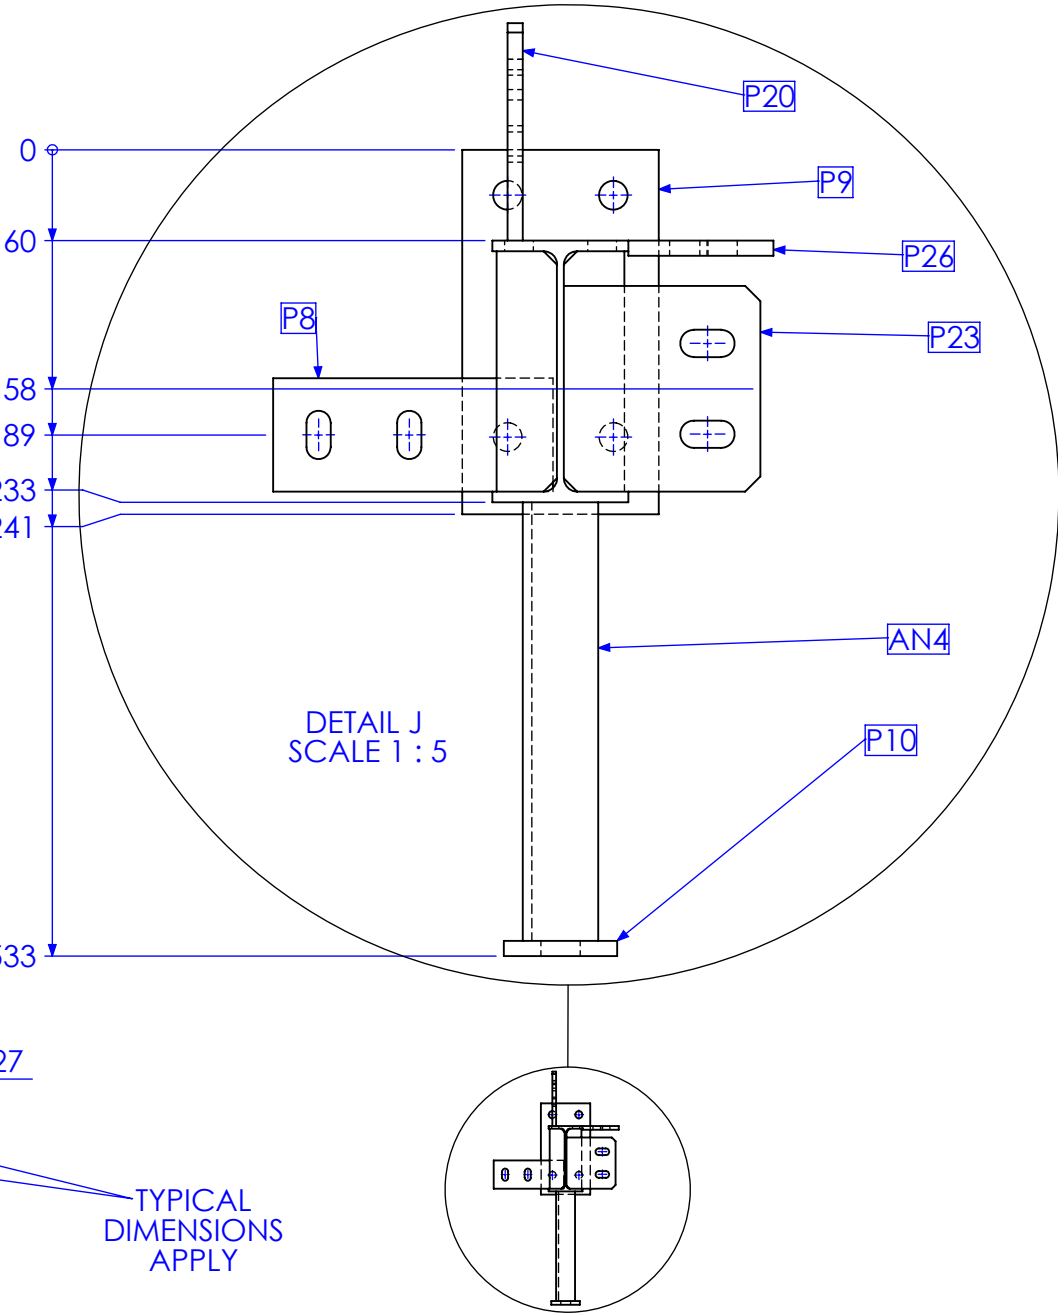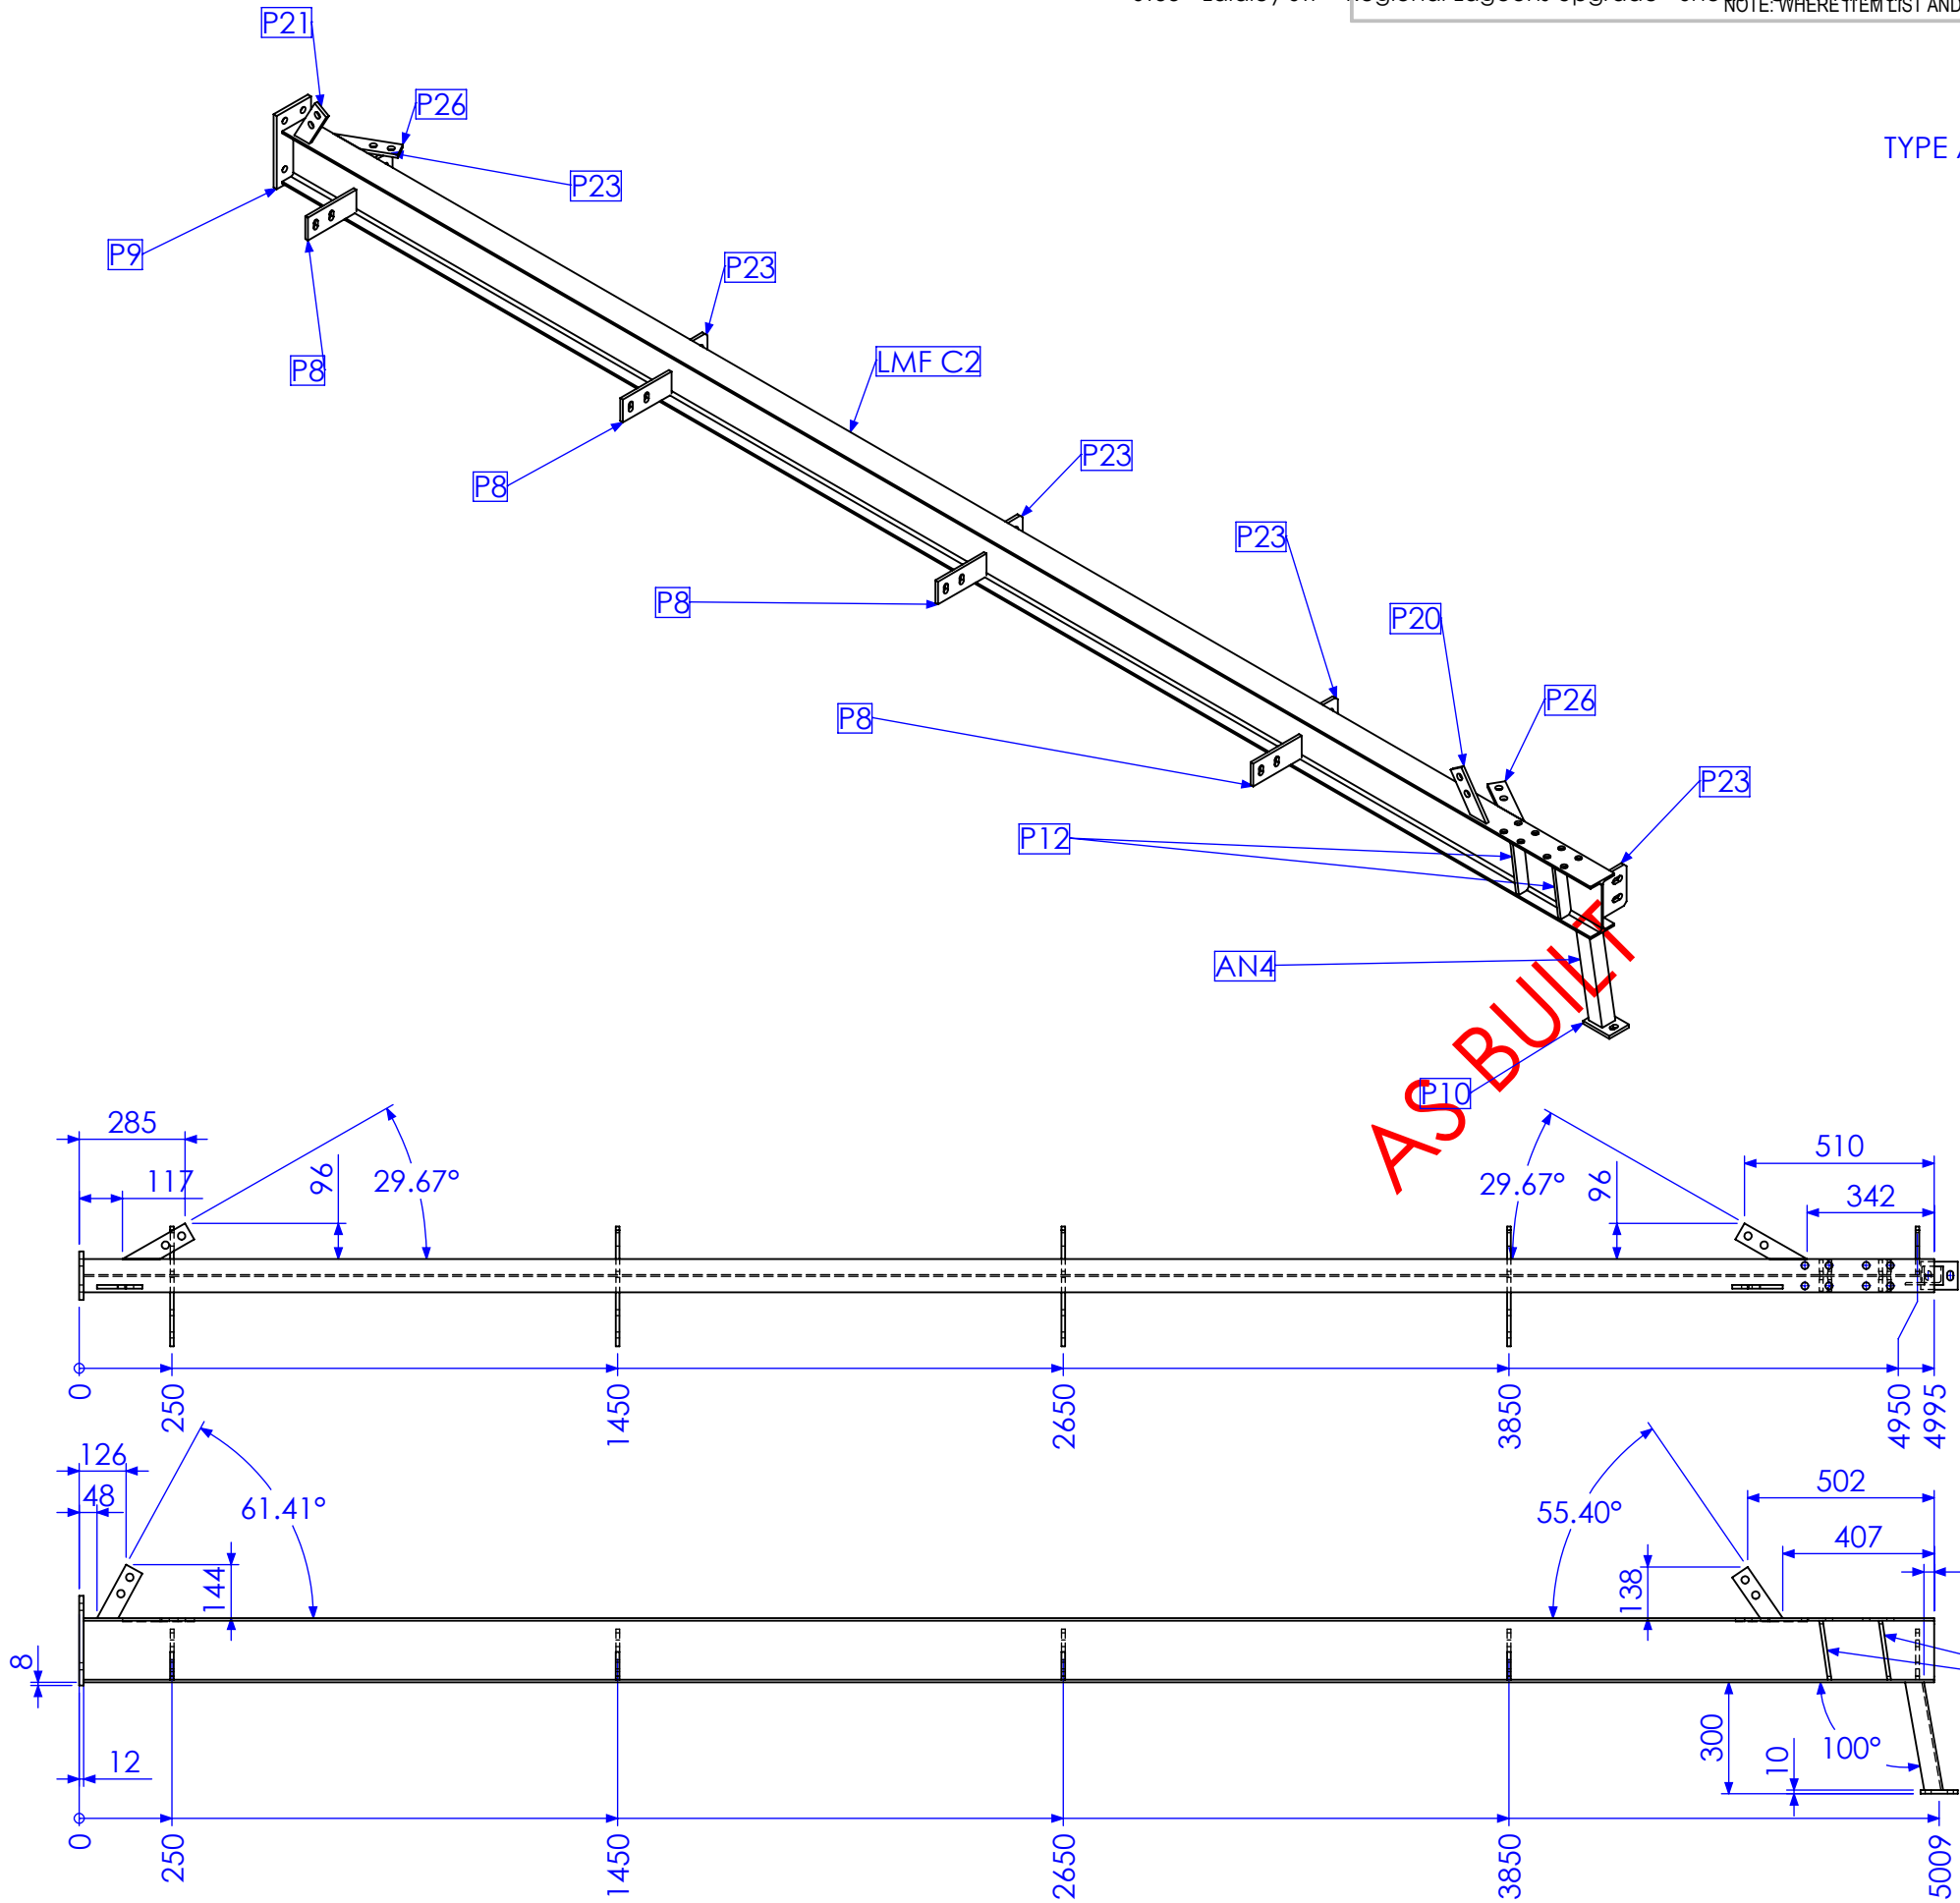



RELEASED FOR MANUFACTURE

REV	DESCRIPTION	DATE	AMMENDED BY
01	INITIAL ISSUE	21/12/2012	SDB
02	ADD GATES TO REAR OF SHED	20/02/2013	SDB
03	AS BUILT DRGS	28/06/2013	SDB
04	AMMENDMENT		

FINISH REQUIREMENTS- HOT DIPPED GALVANISED (ALLOW FOR DRAINAGE WHERE APPLICABLE)		APPROX. MASS: kg		DO NOT SCALE IF IN DOUBT - ASK		JOB NUMBER: 5248	QTY: 1	
PROPRIETARY NOTICE THIS DRAWING IS THE PROPERTY OF AUSFAB CONSTRUCTIONS. COPYRIGHT IS RESERVED. THIS DRAWING MAY NOT BE COPIED OR USED IN ANY MANNER EXCEPT AS AGREED TO BY AUSFAB CONSTRUCTIONS. THE DRAWINGS, IDEAS & INVENTIONS SHOWN SHALL NOT BE DISCLOSED TO OTHER PARTIES.		DRAWING NOTES: ALL WELDING TO BE IN ACCORDANCE WITH AS1554 PART 1. FOR UNTOLERANCED DIMENSIONS THE FOLLOWING LIMITS SHALL APPLY: FABRICATION ± 2.0mm MACHINING ± 0.25mm		SCALE 1:20 UNO		DESCRIPTION COLUMN LMF C2A		AS1100 THIRD ANGLE PROJECTION SHEET 8 of 21 REV 03 PURPOSE OF DRAWING FABRICATION
40 Kenilworth Street, Warwick, Queensland, Australia 4011 Phone: 1300 995 970 Fax: 1300 998 983		15/05/2015		DRAWN SB 21/12/12		CHECK EG/DB/NW -		DRAWING No. LMF C2A
				APPROVED -				Page 153 of 172


TYPE B


MARK NO.	QTY.	DESCRIPTION	LENGTH
P9	1	130x12 FL	241
LMF C2	1	180 UB 16.1	4983
P25	1	130x10 FL	100
AN4	2	50x50x6 EA	303.29
P12	4	40x10 FL	162.15
P11	2	50x10 FL	159

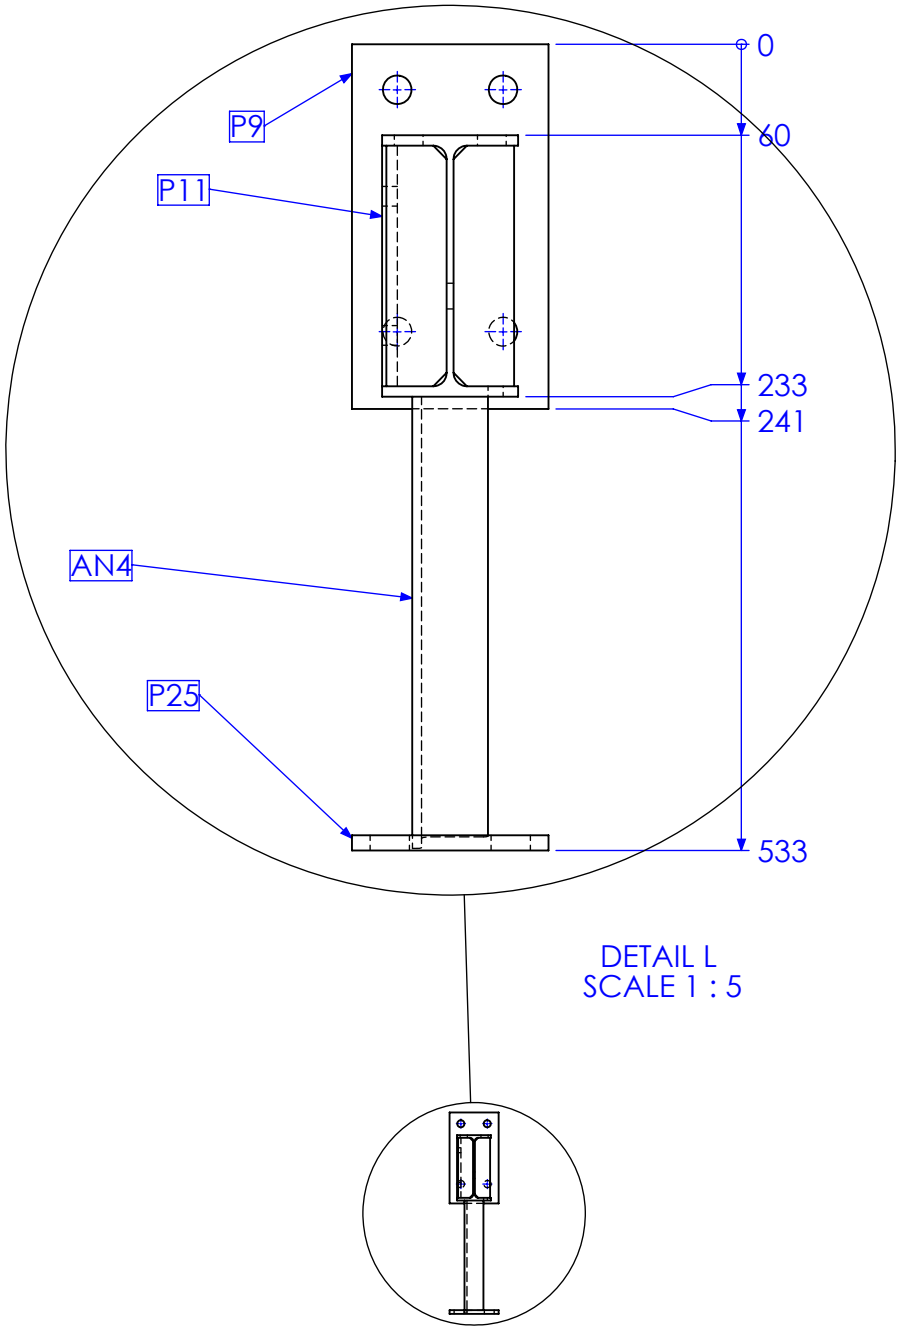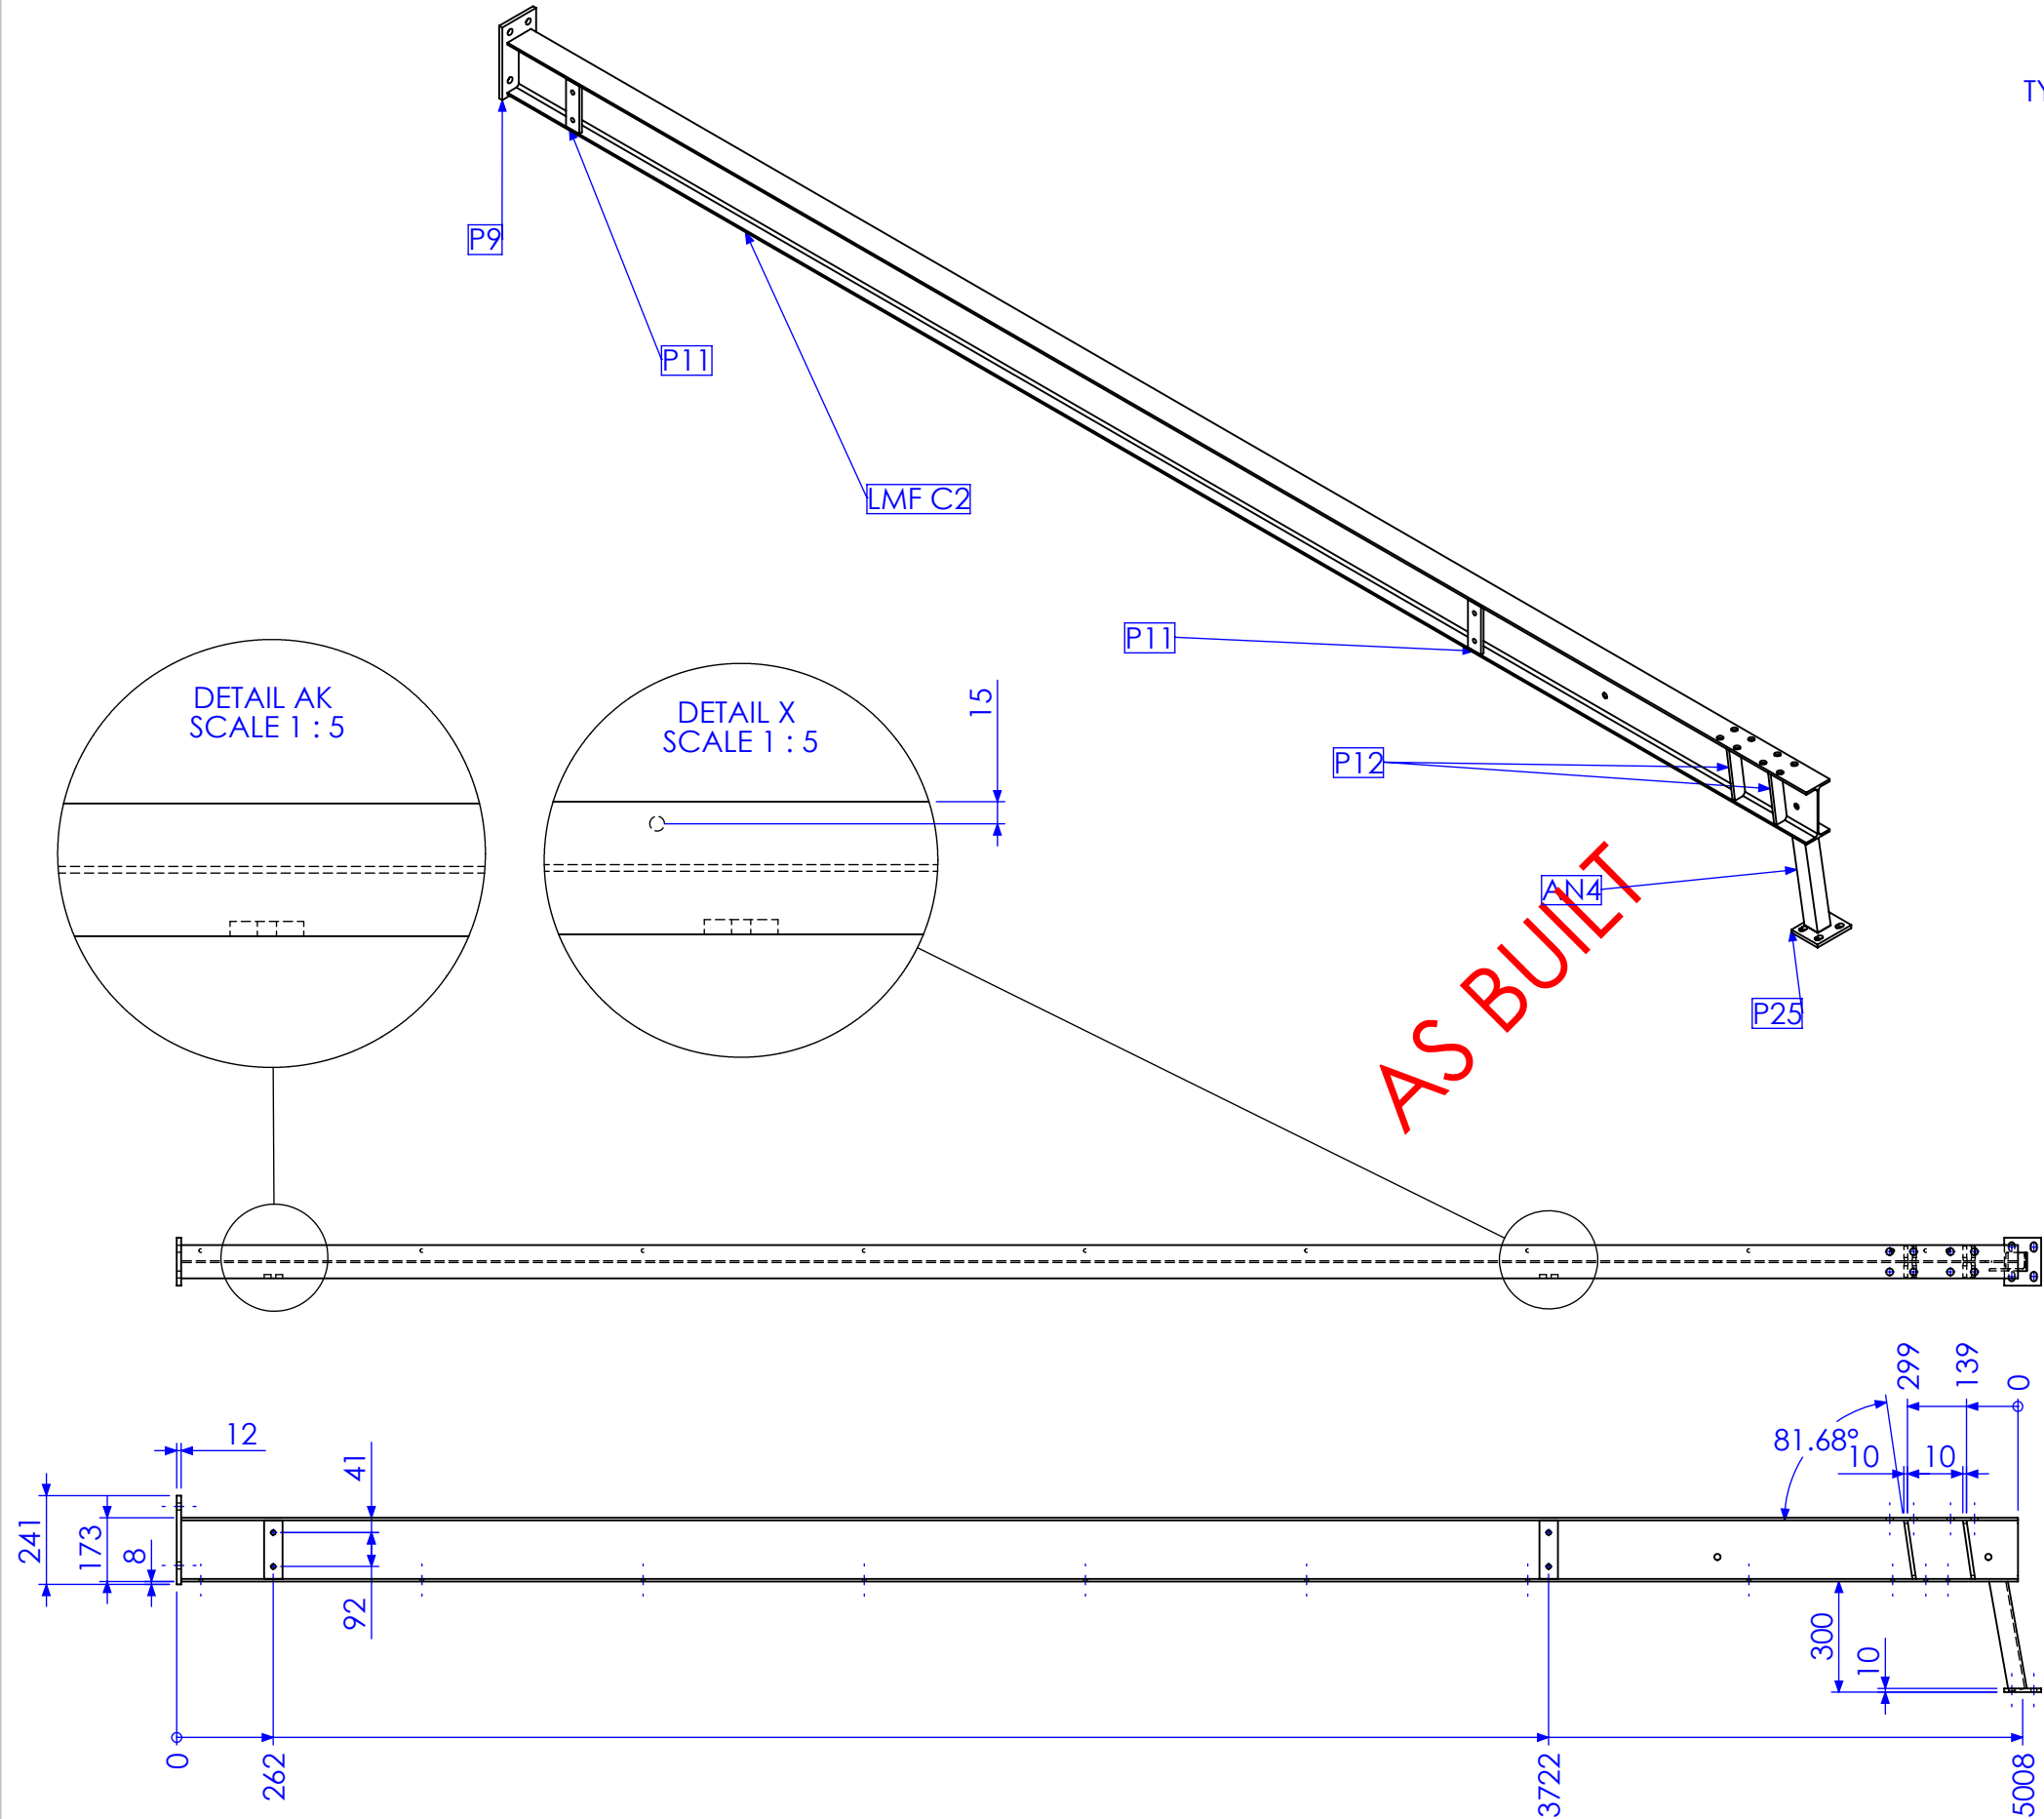

RELEASED FOR MANUFACTURE


REV	DESCRIPTION	DATE	AMMENDED BY
01	INITIAL ISSUE	21/12/2012	SDB
02	ADD GATES TO REAR OF SHED	20/02/2013	SDB
03	AS BUILT DRGS	28/06/2013	SDB
04	AMMENDMENT		

FINISH REQUIREMENTS- HOT DIPPED GALVANISED (ALLOW FOR DRAINAGE WHERE APPLICABLE)		APPROX. MASS: kg		DO NOT SCALE IF IN DOUBT - ASK		JOB NUMBER: 5248	QTY: 1	
PROPRIETARY NOTICE THIS DRAWING IS THE PROPERTY OF AUSFAB CONSTRUCTIONS. COPYRIGHT IS RESERVED. THIS DRAWING MAY NOT BE COPIED OR USED IN ANY MANNER EXCEPT AS AGREED TO BY AUSFAB CONSTRUCTIONS. THE DRAWINGS, IDEAS & INVENTIONS SHOWN SHALL NOT BE DISCLOSED TO OTHER PARTIES.		 40 Kenilworth Street, Warwick, Queensland, Australia 4011 Phone: 1300 995 970 Fax: 1300 998 983 15/05/2015		DRAWING NOTES: ALL WELDING TO BE IN ACCORDANCE WITH AS1554 PART 1. FOR UNTOLERANCED DIMENSIONS THE FOLLOWING LIMITS SHALL APPLY: FABRICATION ± 2.0mm MACHINING ± 0.25mm		DESCRIPTION COLUMN LMF C2C		AS1100 THIRD ANGLE PROJECTION SHEET 9 of 21 REV 03
				SCALE 1:20 UNO		DRAWN SB 21/12/12		PURPOSE OF DRAWING FABRICATION
				CHECK EG/DB/NW -		APPROVED -		
				DRAWING No. LMF C2C		Page 154 of 172		

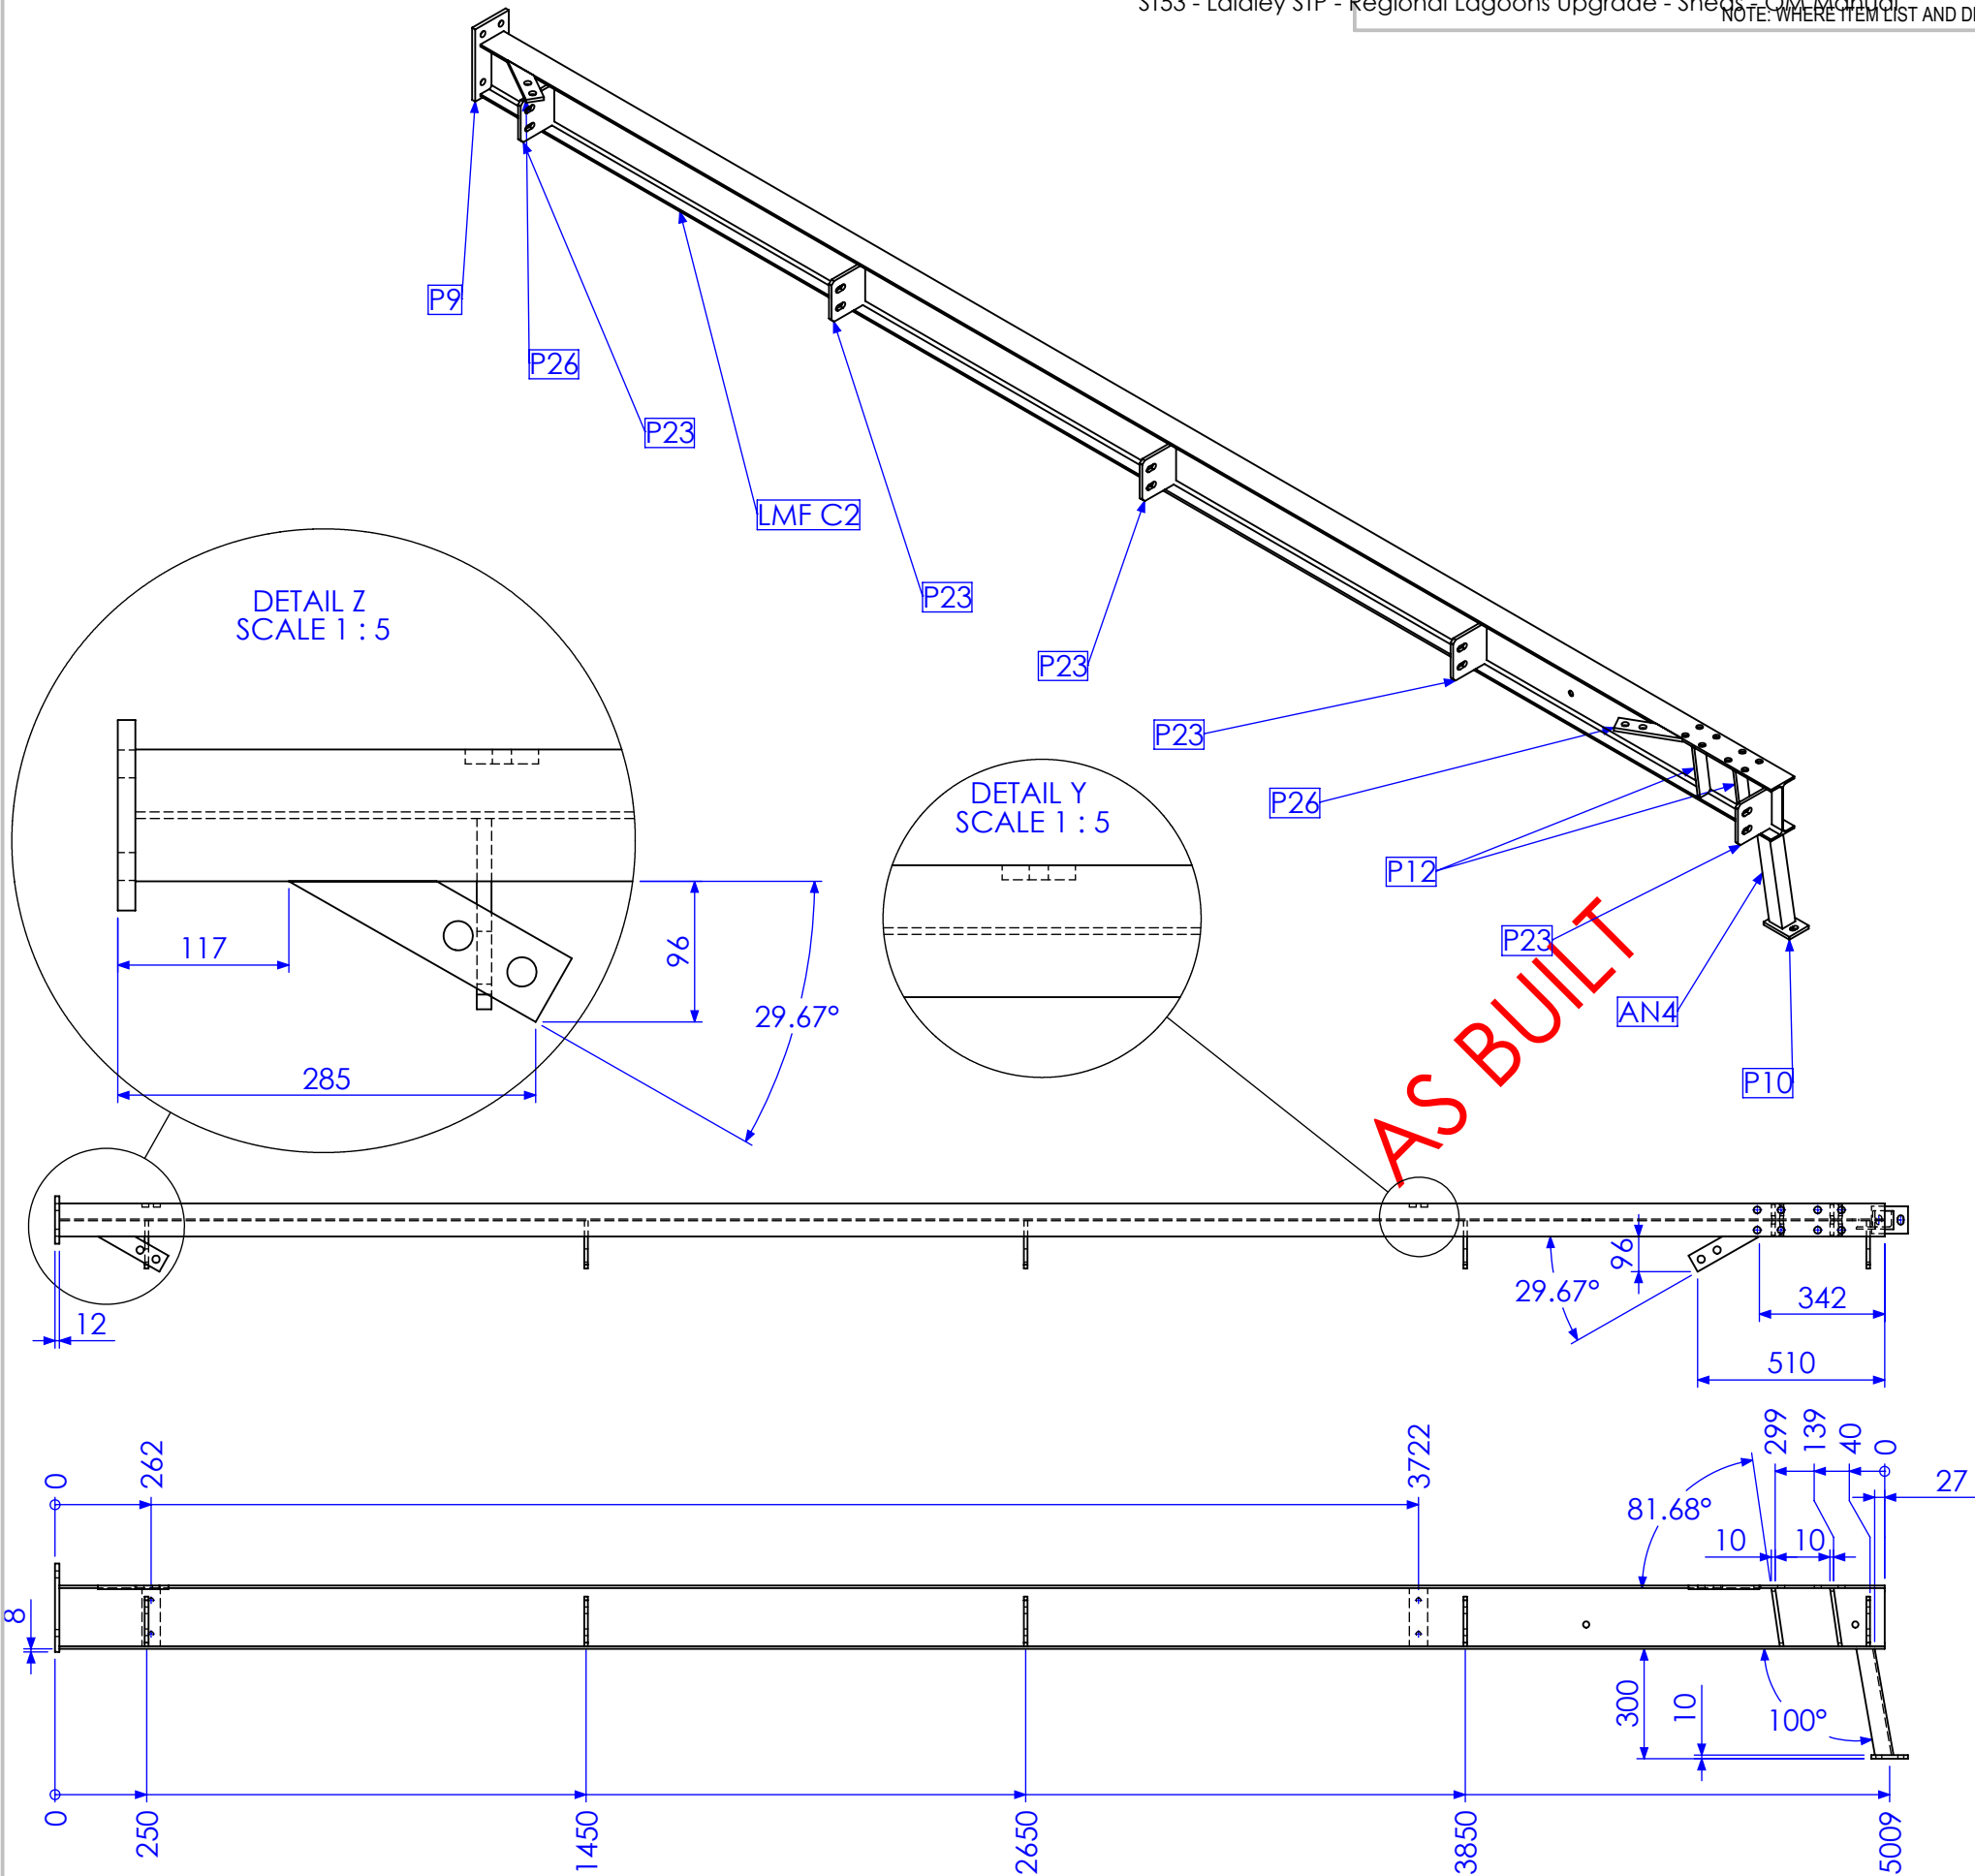

TYPE D

MARK NO.	QTY.	DESCRIPTION	LENGTH
P9	1	130x12 FL	241
LMF C2	1	180 UB 16.1	4983
AN4	1	50x50x6 EA	303.29
P10	1	75x10 FL	100
P23	5	130x10 FL	136
P11	2	50x10 FL	159
P26	2	50x10 FL	193.89
P12	4	40x10 FL	162.15

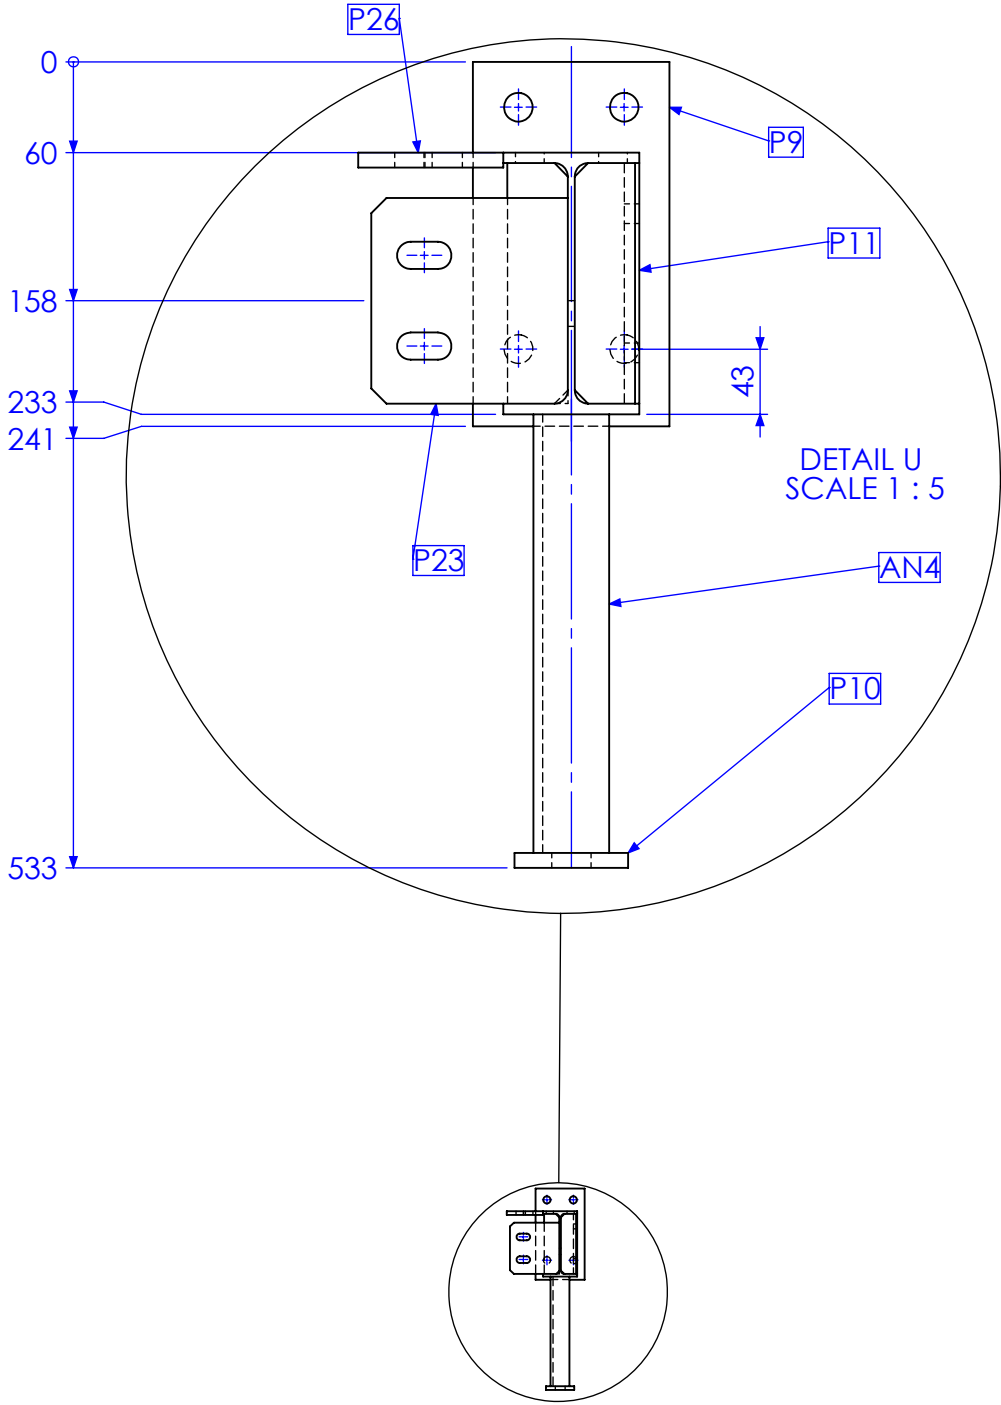

RELEASED FOR MANUFACTURE

REV	DESCRIPTION	DATE	AMMENDED BY
01	INITIAL ISSUE	21/12/2012	SDB
02	ADD GATES TO REAR OF SHED	20/02/2013	SDB
03	AS BUILT DRGS	28/06/2013	SDB
04	AMMENDMENT		

FINISH REQUIREMENTS-	HOT DIPPED GALVANISED (ALLOW FOR DRAINAGE WHERE APPLICABLE)
PROPRIETARY NOTICE	THIS DRAWING IS THE PROPERTY OF AUSFAB CONSTRUCTIONS. COPYRIGHT IS RESERVED. THIS DRAWING MAY NOT BE COPIED OR USED IN ANY MANNER EXCEPT AS AGREED TO BY AUSFAB CONSTRUCTIONS. THE DRAWINGS, IDEAS & INVENTIONS SHOWN SHALL NOT BE DISCLOSED TO OTHER PARTIES.
	
40 Kenilworth Street, Warwick, Queensland, Australia 4011 Phone: 1300 995 970 Fax: 1300 998 983	

APPROX. MASS: kg	DRAWING NOTES:
	ALL WELDING TO BE IN ACCORDANCE WITH AS1554 PART 1. FOR UNTOLERANCED DIMENSIONS THE FOLLOWING LIMITS SHALL APPLY: FABRICATION ± 2.0mm MACHINING ± 0.25mm



DO NOT SCALE IF IN DOUBT - ASK	SCALE	1:20 UNO
	DRAWN	SB 21/12/12
	CHECK	EG/DB/NW -
	APPROVED	- -

JOB NUMBER:	5248
DESCRIPTION	COLUMN LMF C2D
DRAWING No.	LMF C2D

QTY: 1	AS1100	A3
	THIRD ANGLE PROJECTION	
	SHEET 10 of 21	REV 03
	PURPOSE OF DRAWING	FABRICATION

MARK NO.	QTY.	DESCRIPTION	LENGTH
P9	1	130x12 FL	241
LMF C2	1	180 UB 16.1	4983
AN4	1	50x50x6 EA	303.29
P10	1	75x10 FL	100
P8	4	75x10 FL	185
P12	4	40x10 FL	162.15

TYPE C

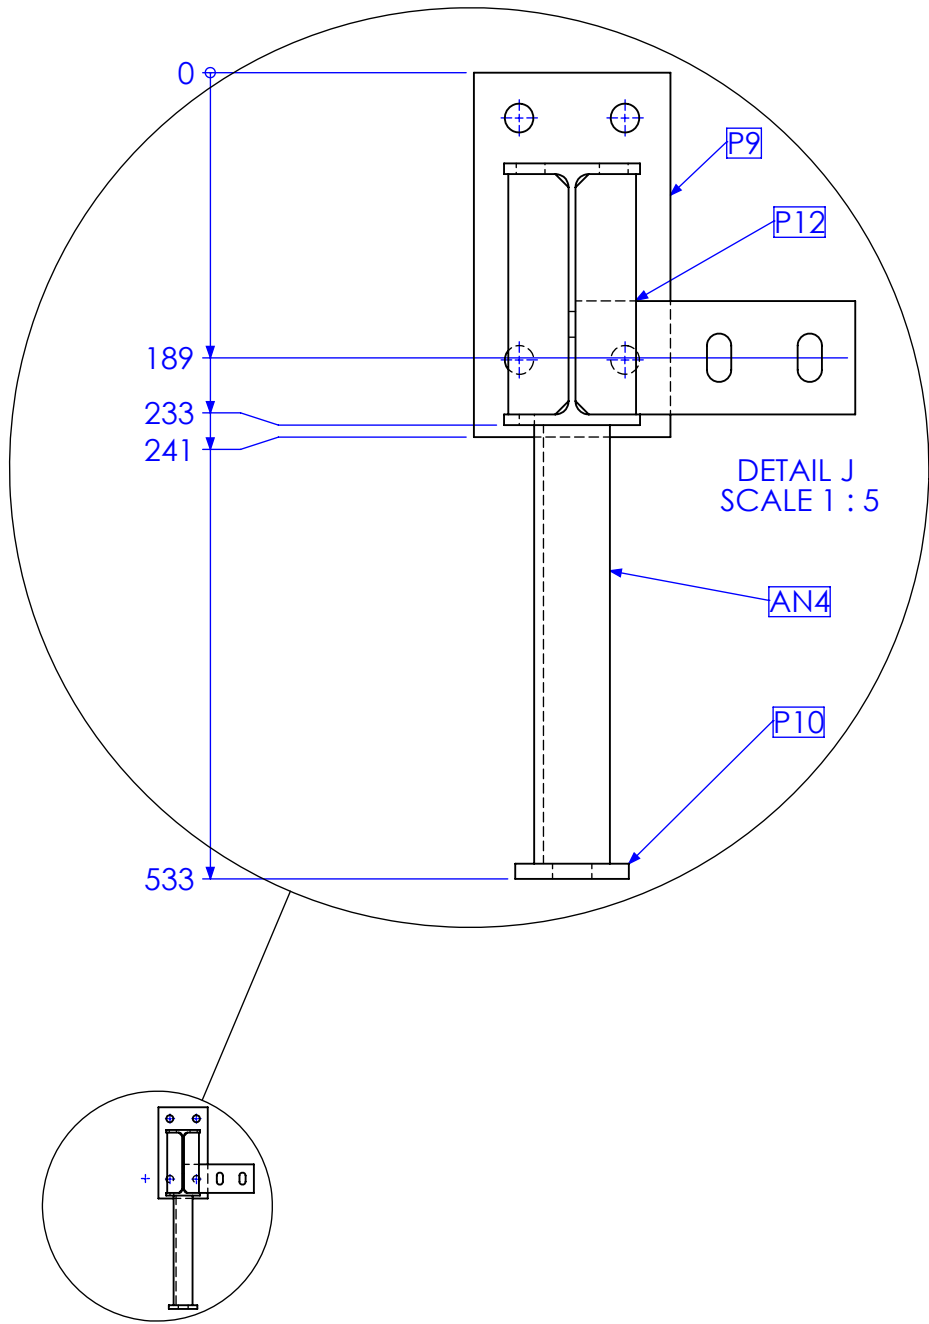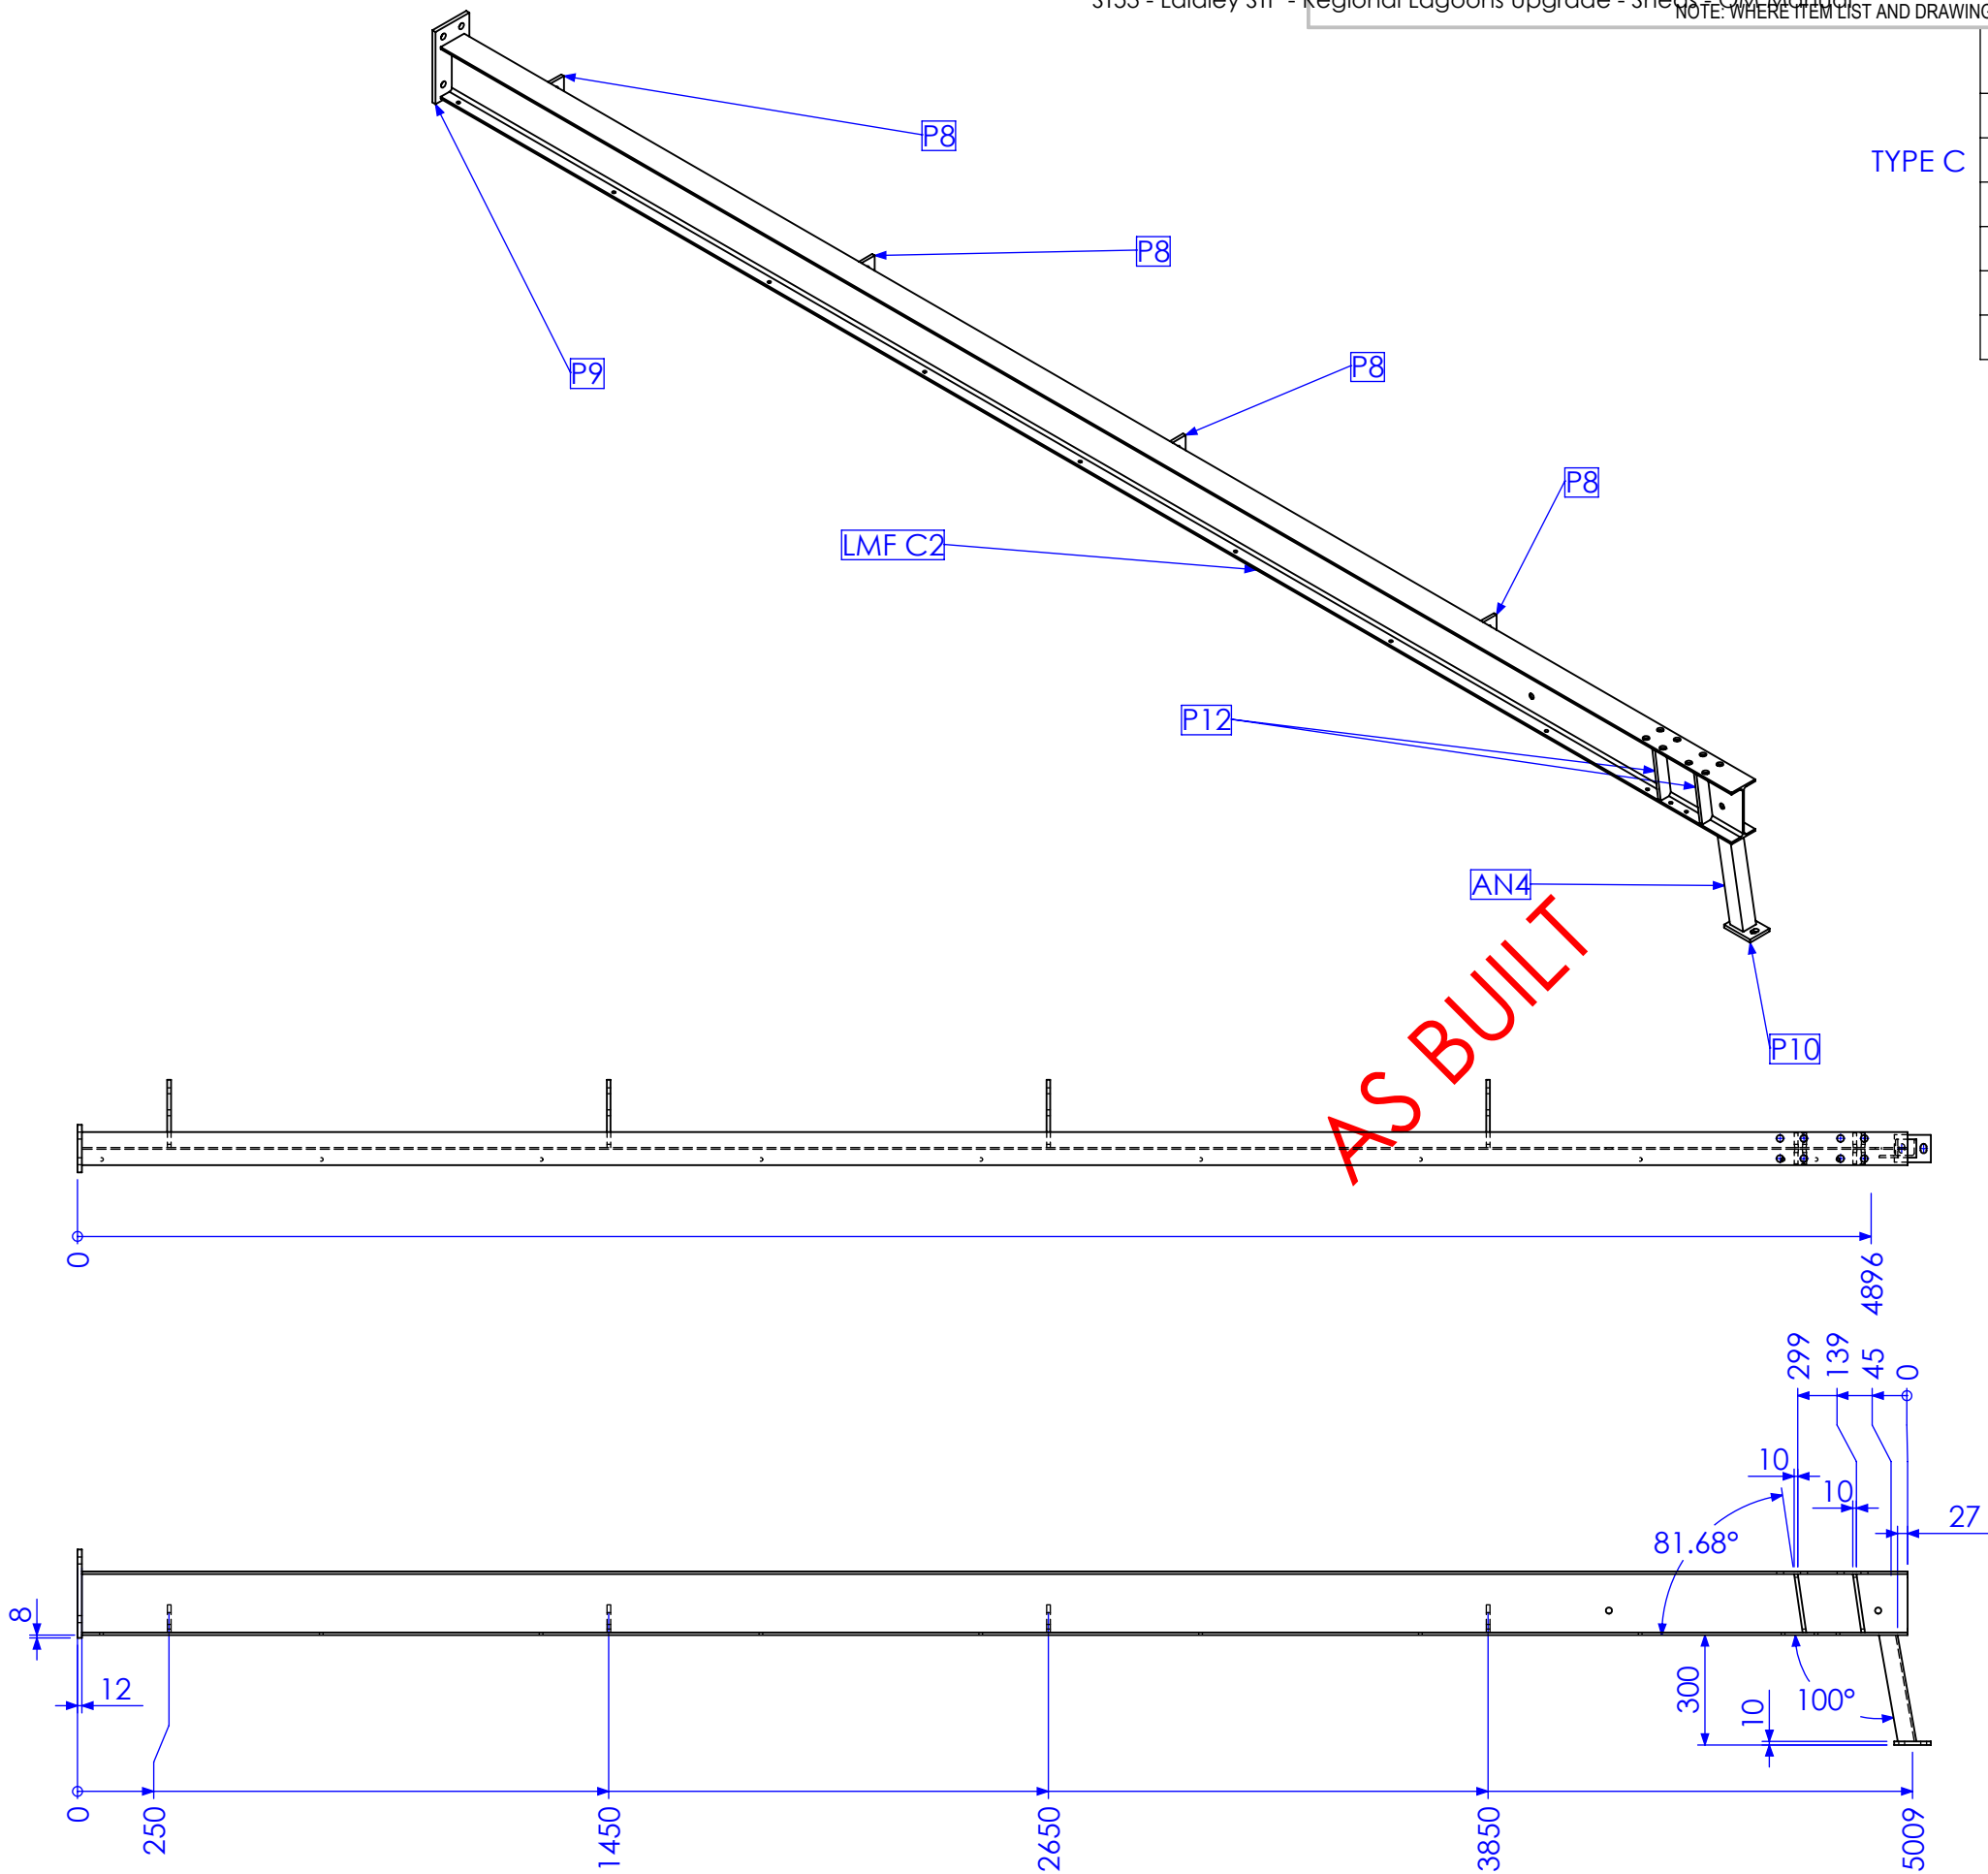




RELEASED FOR MANUFACTURE

REV	DESCRIPTION	DATE	AMMENDED BY
01	INITIAL ISSUE	21/12/2012	SDB
02	ADD GATES TO REAR OF SHED	20/02/2013	SDB
03	AS BUILT DRGS	28/06/2013	SDB
04	AMMENDMENT	DATE	AMMENDED BY

FINISH REQUIREMENTS- HOT DIPPED GALVANISED (ALLOW FOR DRAINAGE WHERE APPLICABLE)		APPROX. MASS: kg		DO NOT SCALE IF IN DOUBT - ASK		JOB NUMBER: 5248	QTY: 1	
PROPRIETARY NOTICE THIS DRAWING IS THE PROPERTY OF AUSFAB CONSTRUCTIONS. COPYRIGHT IS RESERVED. THIS DRAWING MAY NOT BE COPIED OR USED IN ANY MANNER EXCEPT AS AGREED TO BY AUSFAB CONSTRUCTIONS. THE DRAWINGS, IDEAS & INVENTIONS SHOWN SHALL NOT BE DISCLOSED TO OTHER PARTIES.		DRAWING NOTES: ALL WELDING TO BE IN ACCORDANCE WITH AS1554 PART 1. FOR UNTOLERANCED DIMENSIONS THE FOLLOWING LIMITS SHALL APPLY: FABRICATION ± 2.0mm MACHINING ± 0.25mm		SCALE 1:20 UNO	DESCRIPTION COLUMN LMF C2E		AS1100 THIRD ANGLE PROJECTION SHEET 11 of 21 REV 03	PURPOSE OF DRAWING FABRICATION
AUSFAB CONSTRUCTIONS 40 Kenilworth Street, Warwick, Queensland, Australia 4011 Phone: 1300 995 970 Fax: 1300 998 983 Date 15/05/2015		DRAWING No. LMF C2E		Page 156 of 172				


MARK NO.	QTY.	DESCRIPTION	LENGTH
P9	1	130x12 FL	241
LMF C2	1	180 UB 16.1	4983
AN4	1	50x50x6 EA	303.29
P10	1	75x10 FL	100
P12	4	40x10 FL	162.15


TYPE A

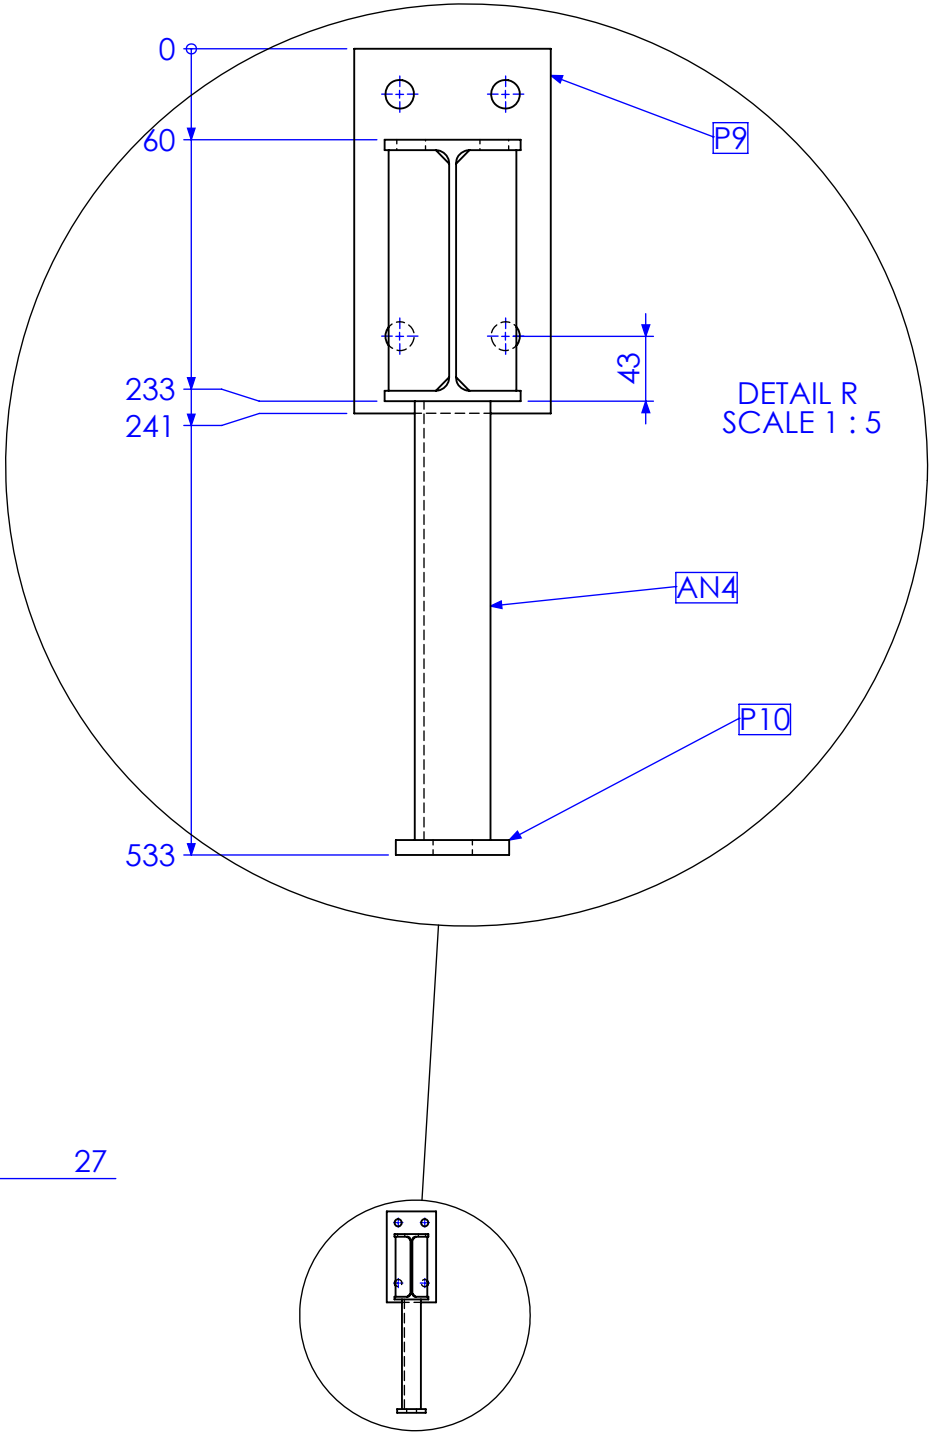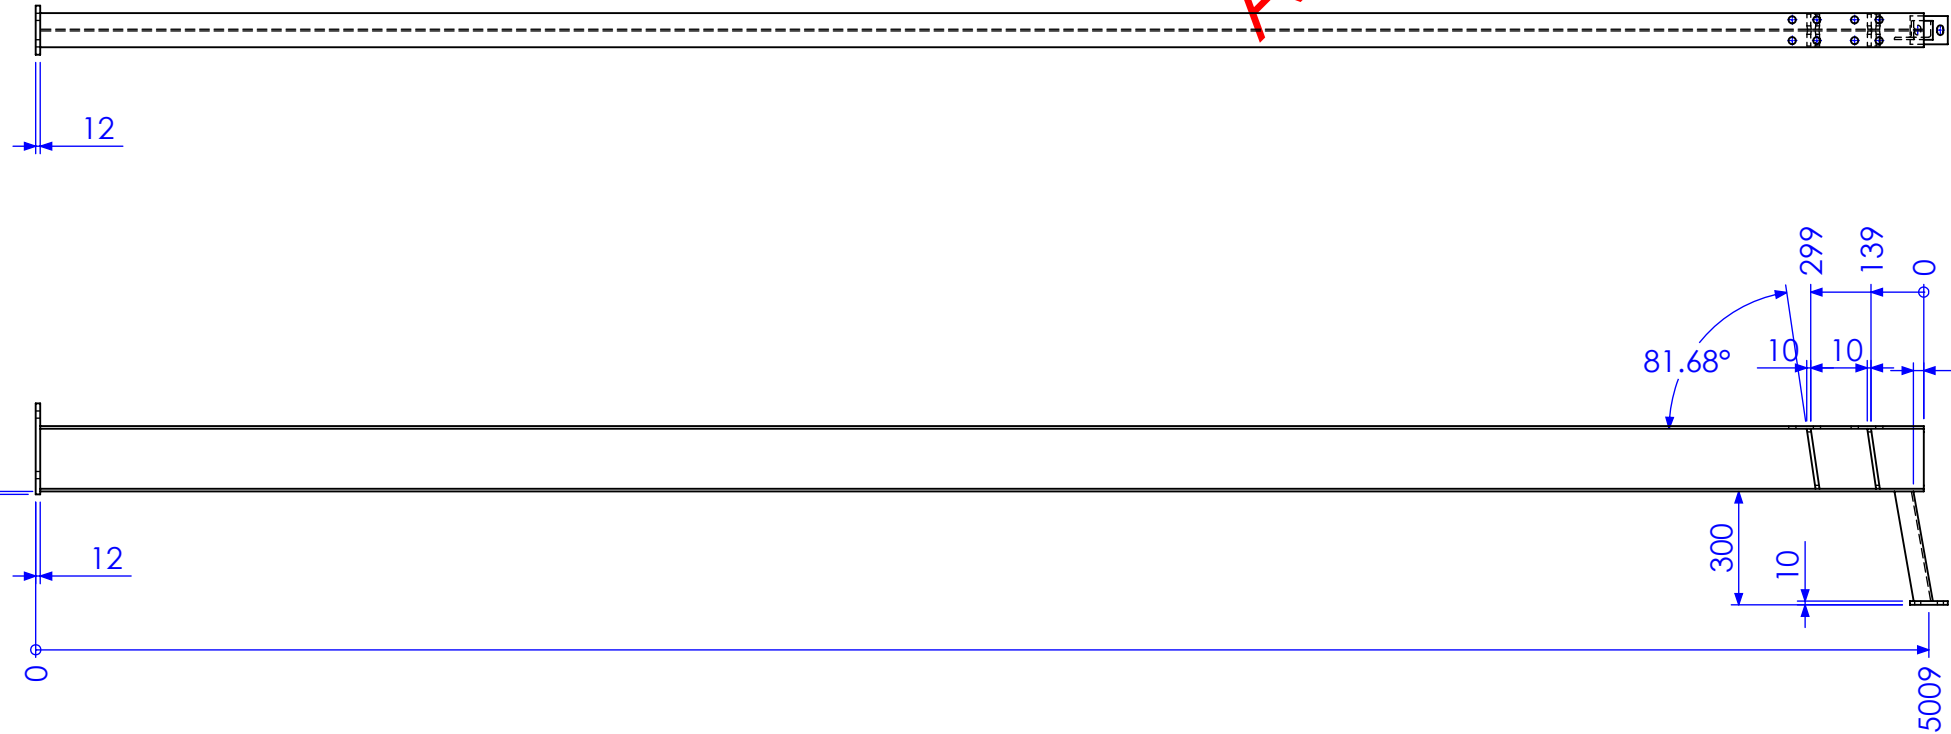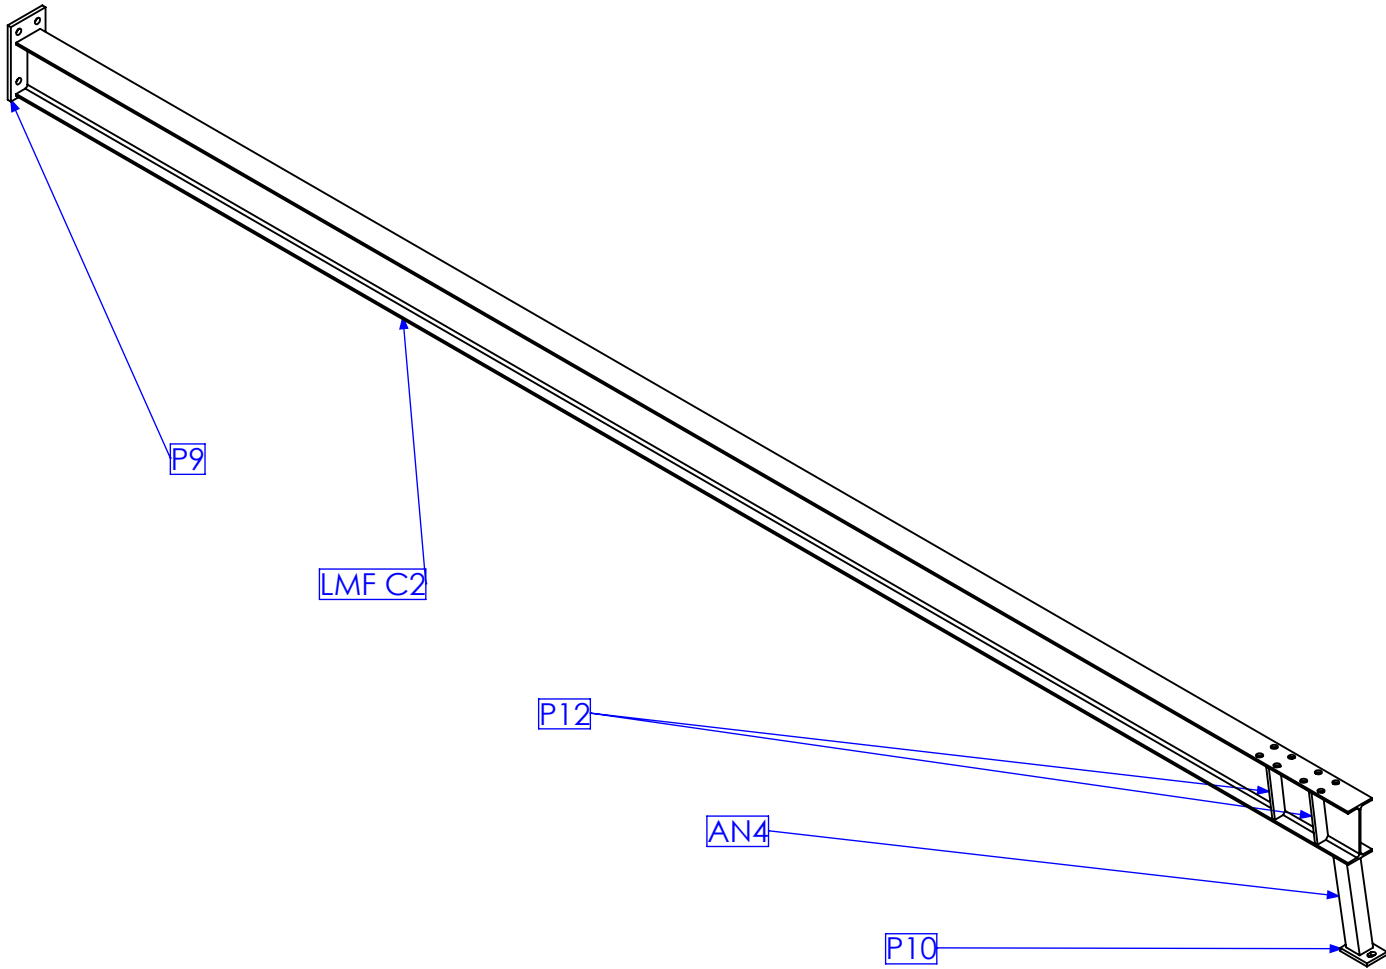

RELEASED FOR MANUFACTURE


REV	DESCRIPTION	DATE	AMMENDED BY
01	INITIAL ISSUE	21/12/2012	SDB
02	ADD GATES TO REAR OF SHED	20/02/2013	SDB
03	AS BUILT DRGS	28/06/2013	SDB
04	AMMENDMENT	DATE	AMMENDED BY

FINISH REQUIREMENTS-		HOT DIPPED GALVANISED (ALLOW FOR DRAINAGE WHERE APPLICABLE)		APPROX. MASS: kg		DO NOT SCALE IF IN DOUBT - ASK		JOB NUMBER:		5248		QTY: 1				
PROPRIETARY NOTICE		 <div>40 Kenilworth Street, Warwick, Queensland, Australia 4011 Phone: 1300 995 970 Fax: 1300 998 983</div>		DRAWING NOTES:		SCALE		1:20 UNO		DESCRIPTION COLUMN LMF C2G				AS1100		A3
THIS DRAWING IS THE PROPERTY OF AUSFAB CONSTRUCTIONS. COPYRIGHT IS RESERVED. THIS DRAWING MAY NOT BE COPIED OR USED IN ANY MANNER EXCEPT AS AGREED TO BY AUSFAB CONSTRUCTIONS. THE DRAWINGS, IDEAS & INVENTIONS SHOWN SHALL NOT BE DISCLOSED TO OTHER PARTIES.				ALL WELDING TO BE IN ACCORDANCE WITH AS1554 PART 1. FOR UNTOLERANCED DIMENSIONS THE FOLLOWING LIMITS SHALL APPLY:		DRAWN		SB 21/12/12						THIRD ANGLE PROJECTION		
				FABRICATION ± 2.0mm MACHINING ± 0.25mm		CHECK		EG/DB/NW -						SHEET 12 of 21		
				15/05/2015				APPROVED		-		-		PURPOSE OF DRAWING		03
										Page 157 of 172		FABRICATION				

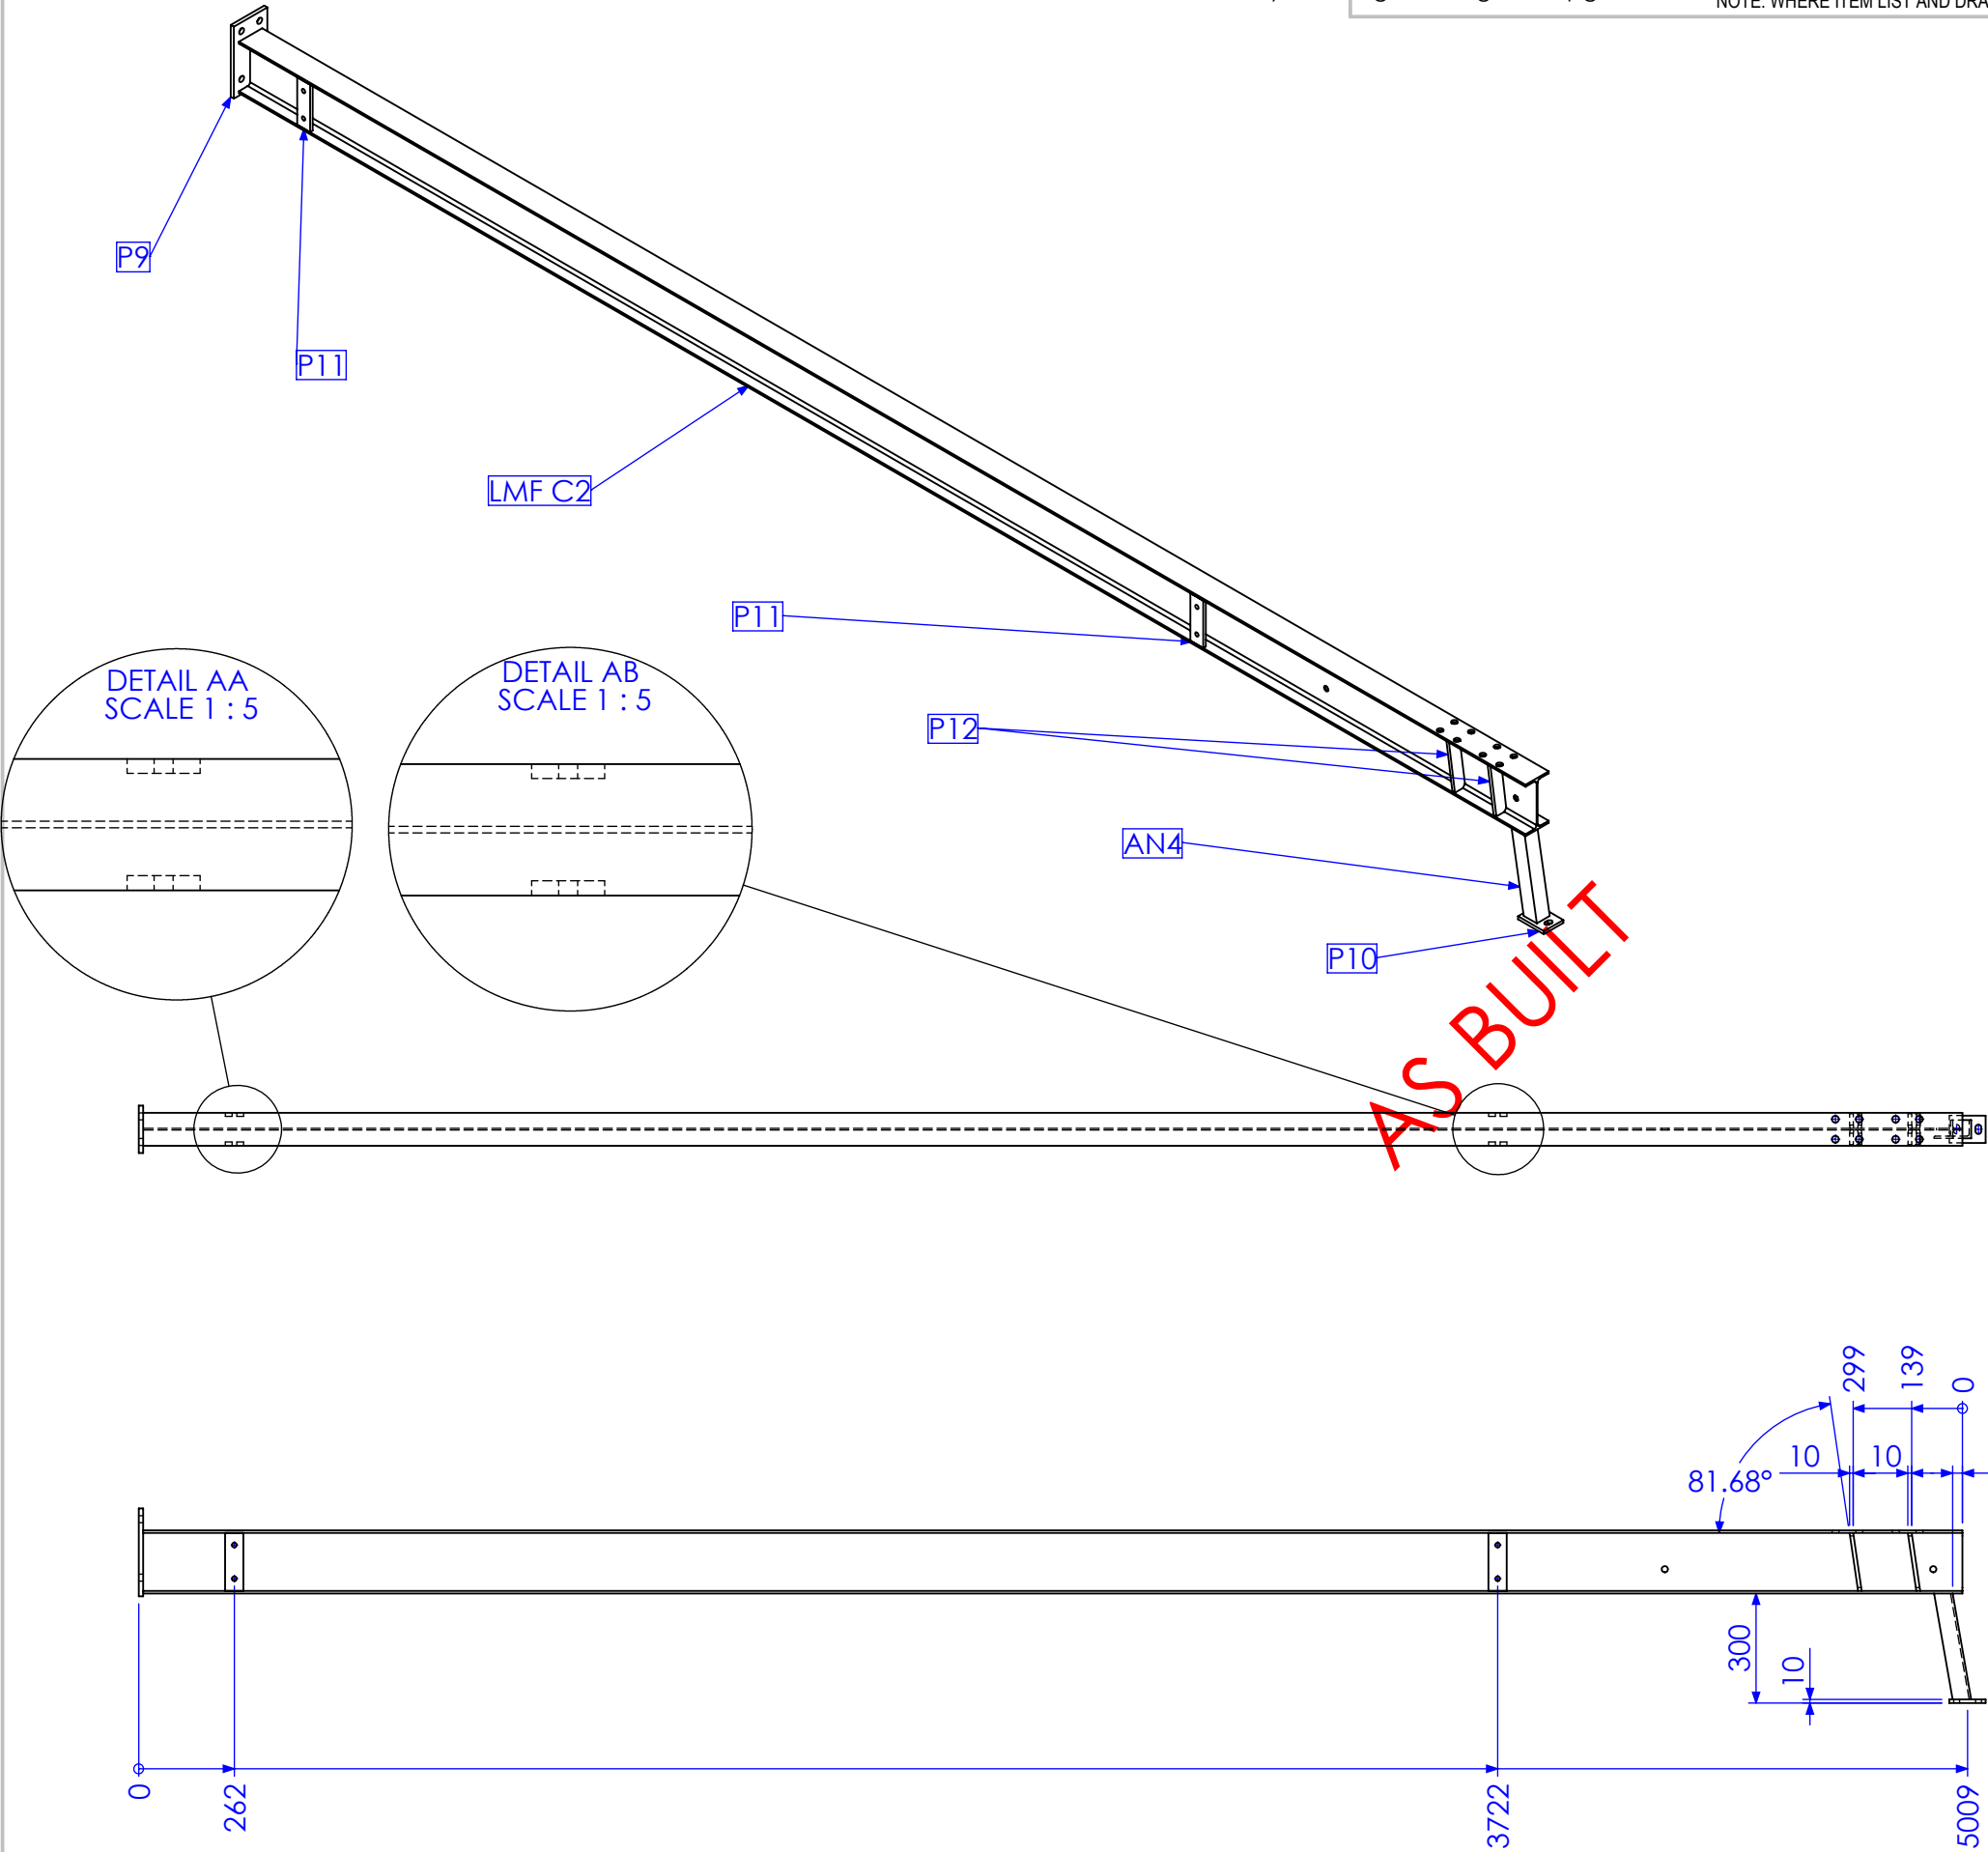

TYPE D

MARK NO.	QTY.	DESCRIPTION	LENGTH
P9	1	130x12 FL	241
LMF C2	1	180 UB 16.1	4983
AN4	1	50x50x6 EA	303.29
P10	1	75x10 FL	100
P11	4	50x10 FL	159
P12	4	40x10 FL	162.15



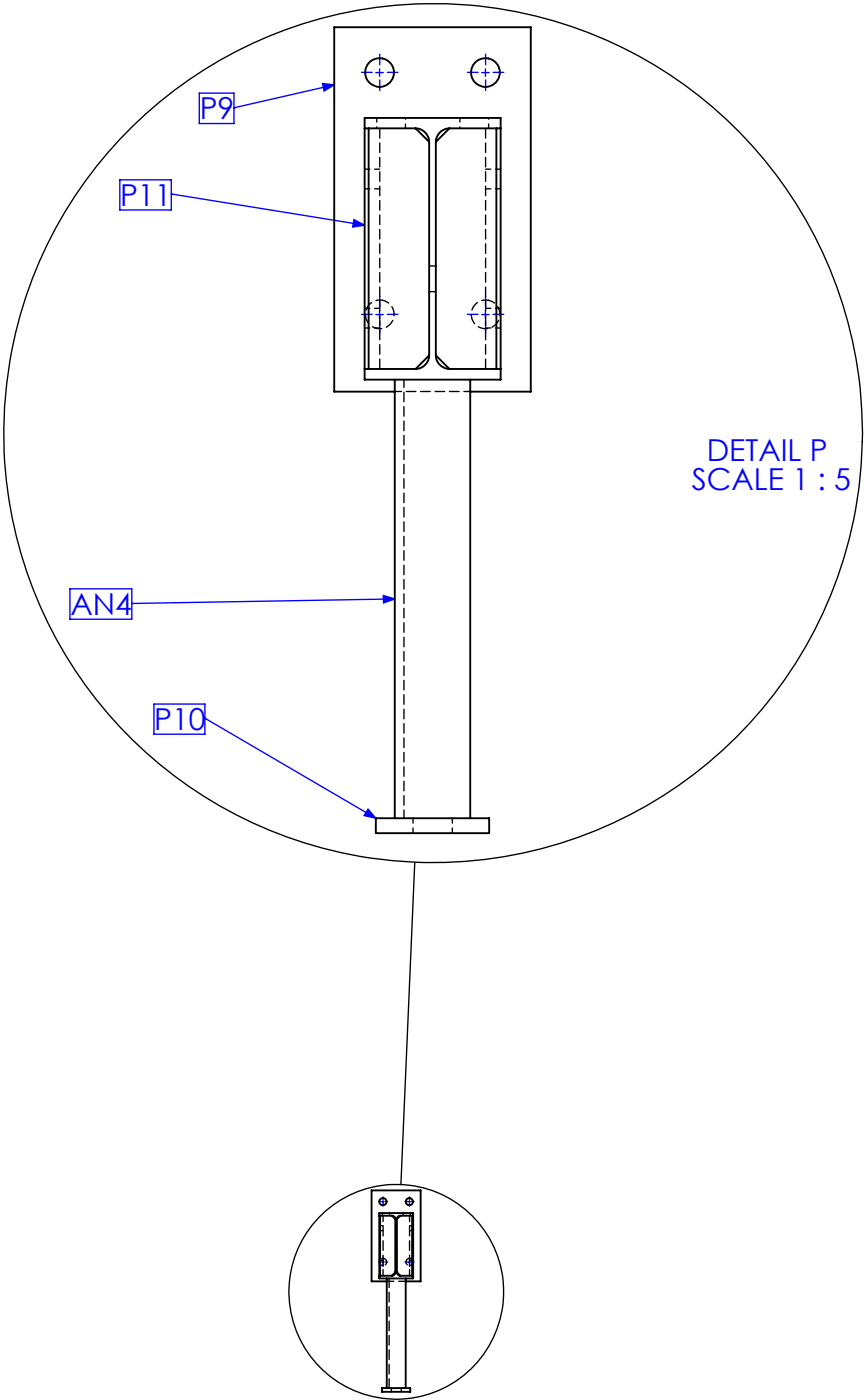


RELEASED FOR MANUFACTURE

REV	DESCRIPTION	DATE	AMMENDED BY
01	INITIAL ISSUE	21/12/2012	SDB
02	ADD GATES TO REAR OF SHED	20/02/2013	SDB
03	AS BUILT DRGS	28/06/2013	SDB
04	AMMENDMENT	DATE	AMMENDED BY

FINISH REQUIREMENTS- HOT DIPPED GALVANISED (ALLOW FOR DRAINAGE WHERE APPLICABLE)		APPROX. MASS: kg		DO NOT SCALE IF IN DOUBT - ASK		JOB NUMBER: 5248	QTY: 1	
PROPRIETARY NOTICE THIS DRAWING IS THE PROPERTY OF AUSFAB CONSTRUCTIONS. COPYRIGHT IS RESERVED. THIS DRAWING MAY NOT BE COPIED OR USED IN ANY MANNER EXCEPT AS AGREED TO BY AUSFAB CONSTRUCTIONS. THE DRAWINGS, IDEAS & INVENTIONS SHOWN SHALL NOT BE DISCLOSED TO OTHER PARTIES.		DRAWING NOTES: ALL WELDING TO BE IN ACCORDANCE WITH AS1554 PART 1. FOR UNTOLERANCED DIMENSIONS THE FOLLOWING LIMITS SHALL APPLY: FABRICATION ± 2.0mm MACHINING ± 0.25mm		SCALE 1:20 UNO		DESCRIPTION COLUMN LMF C2J		AS1100 THIRD ANGLE PROJECTION SHEET 13 of 21 REV 03 PURPOSE OF DRAWING FABRICATION
40 Kenilworth Street, Warwick, Queensland, Australia 4011 Phone: 1300 995 970 Fax: 1300 998 983		15/05/2015		DRAWING No. LMF C2J		Page 158 of 172		

MARK NO.	QTY.	DESCRIPTION	LENGTH
P5	2	90x12 FL	290
LMF B3	1	180 UB 16.1	6562.1
P3	6	75x10 FL	145
P31	4	65x10 FL	65

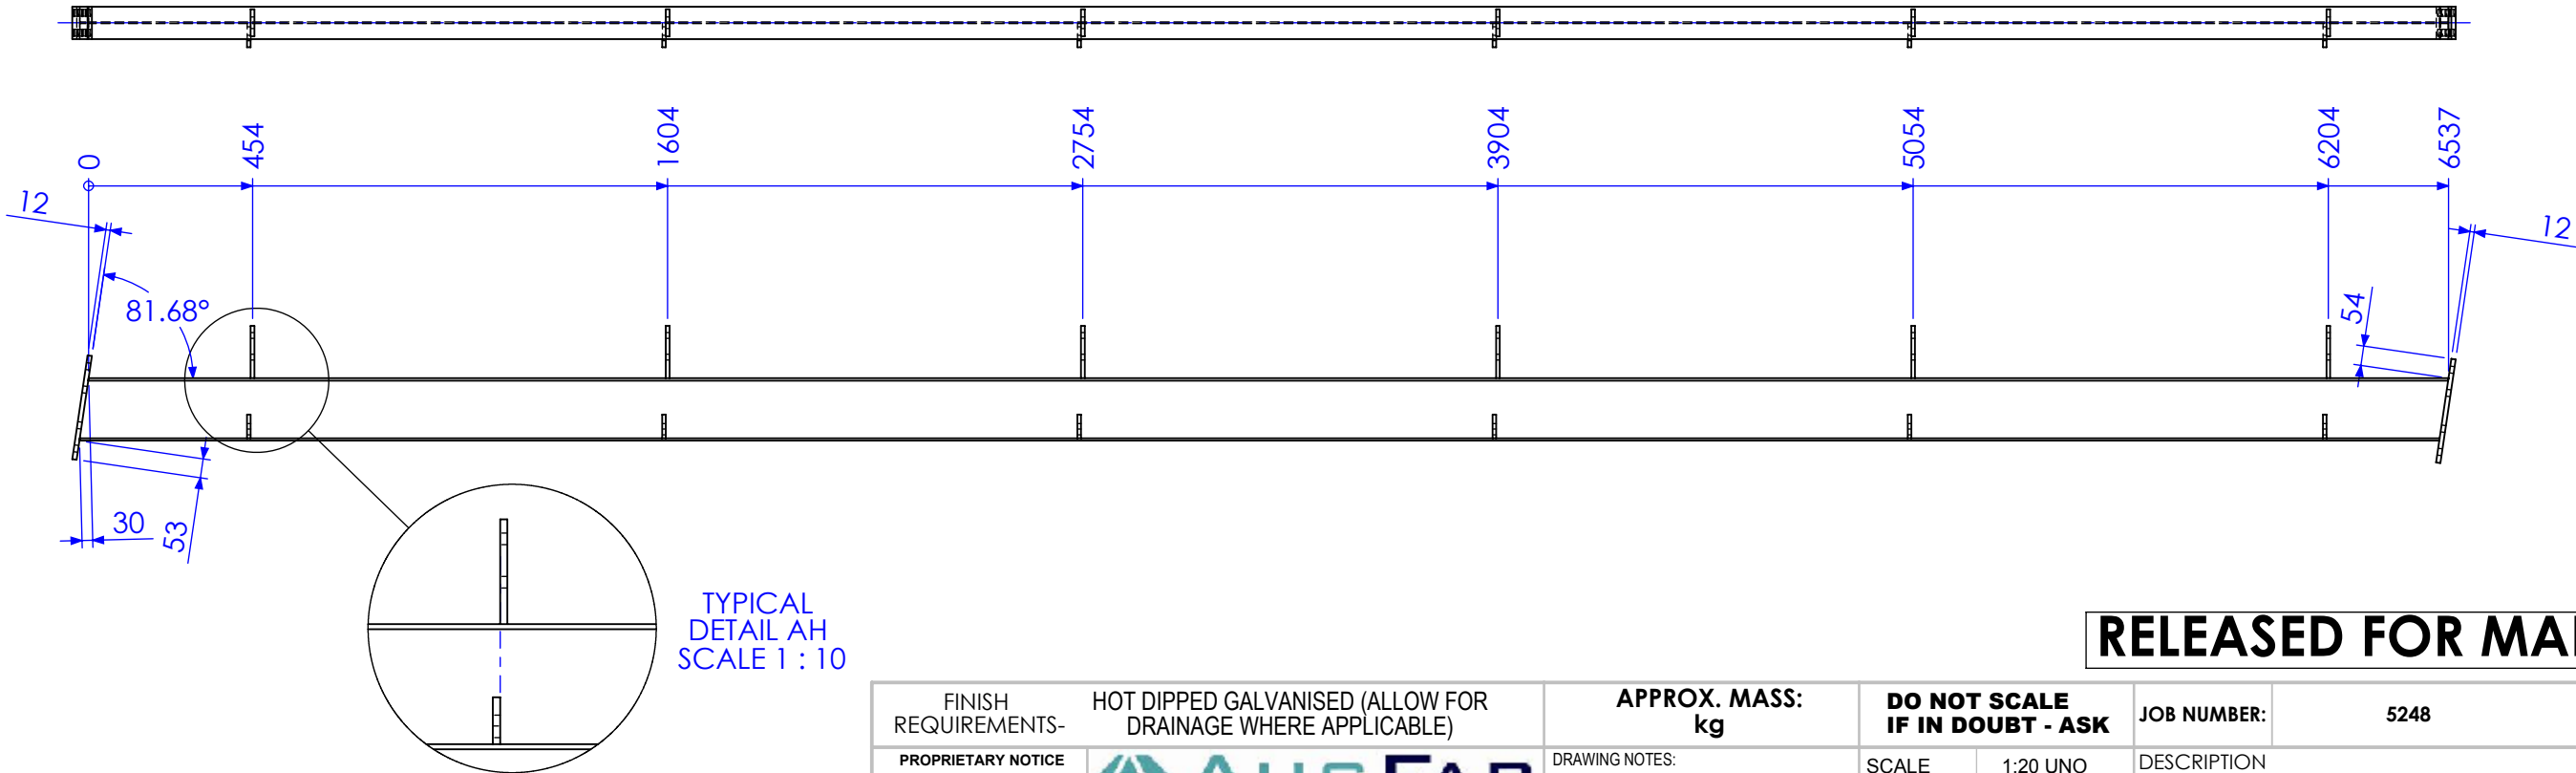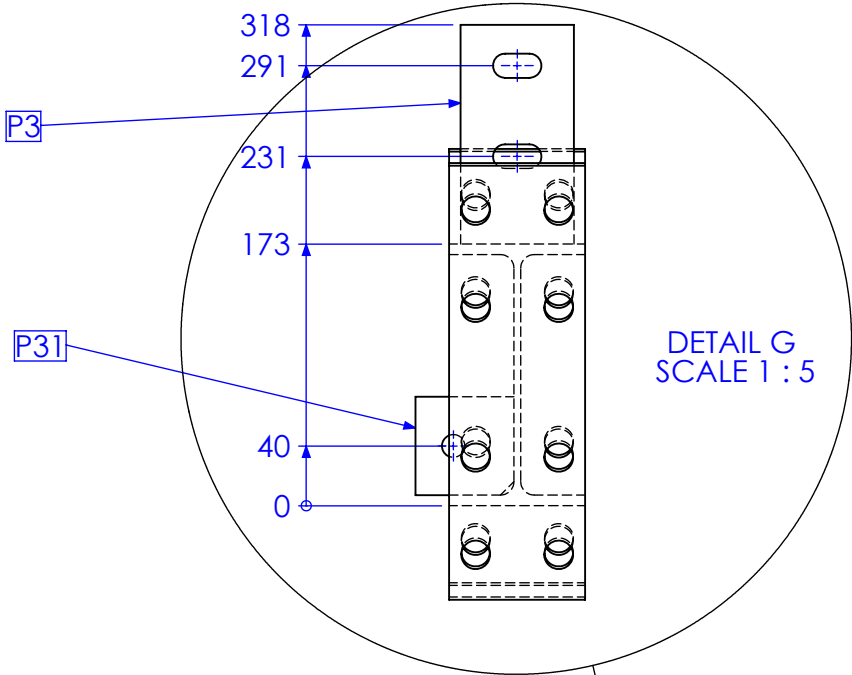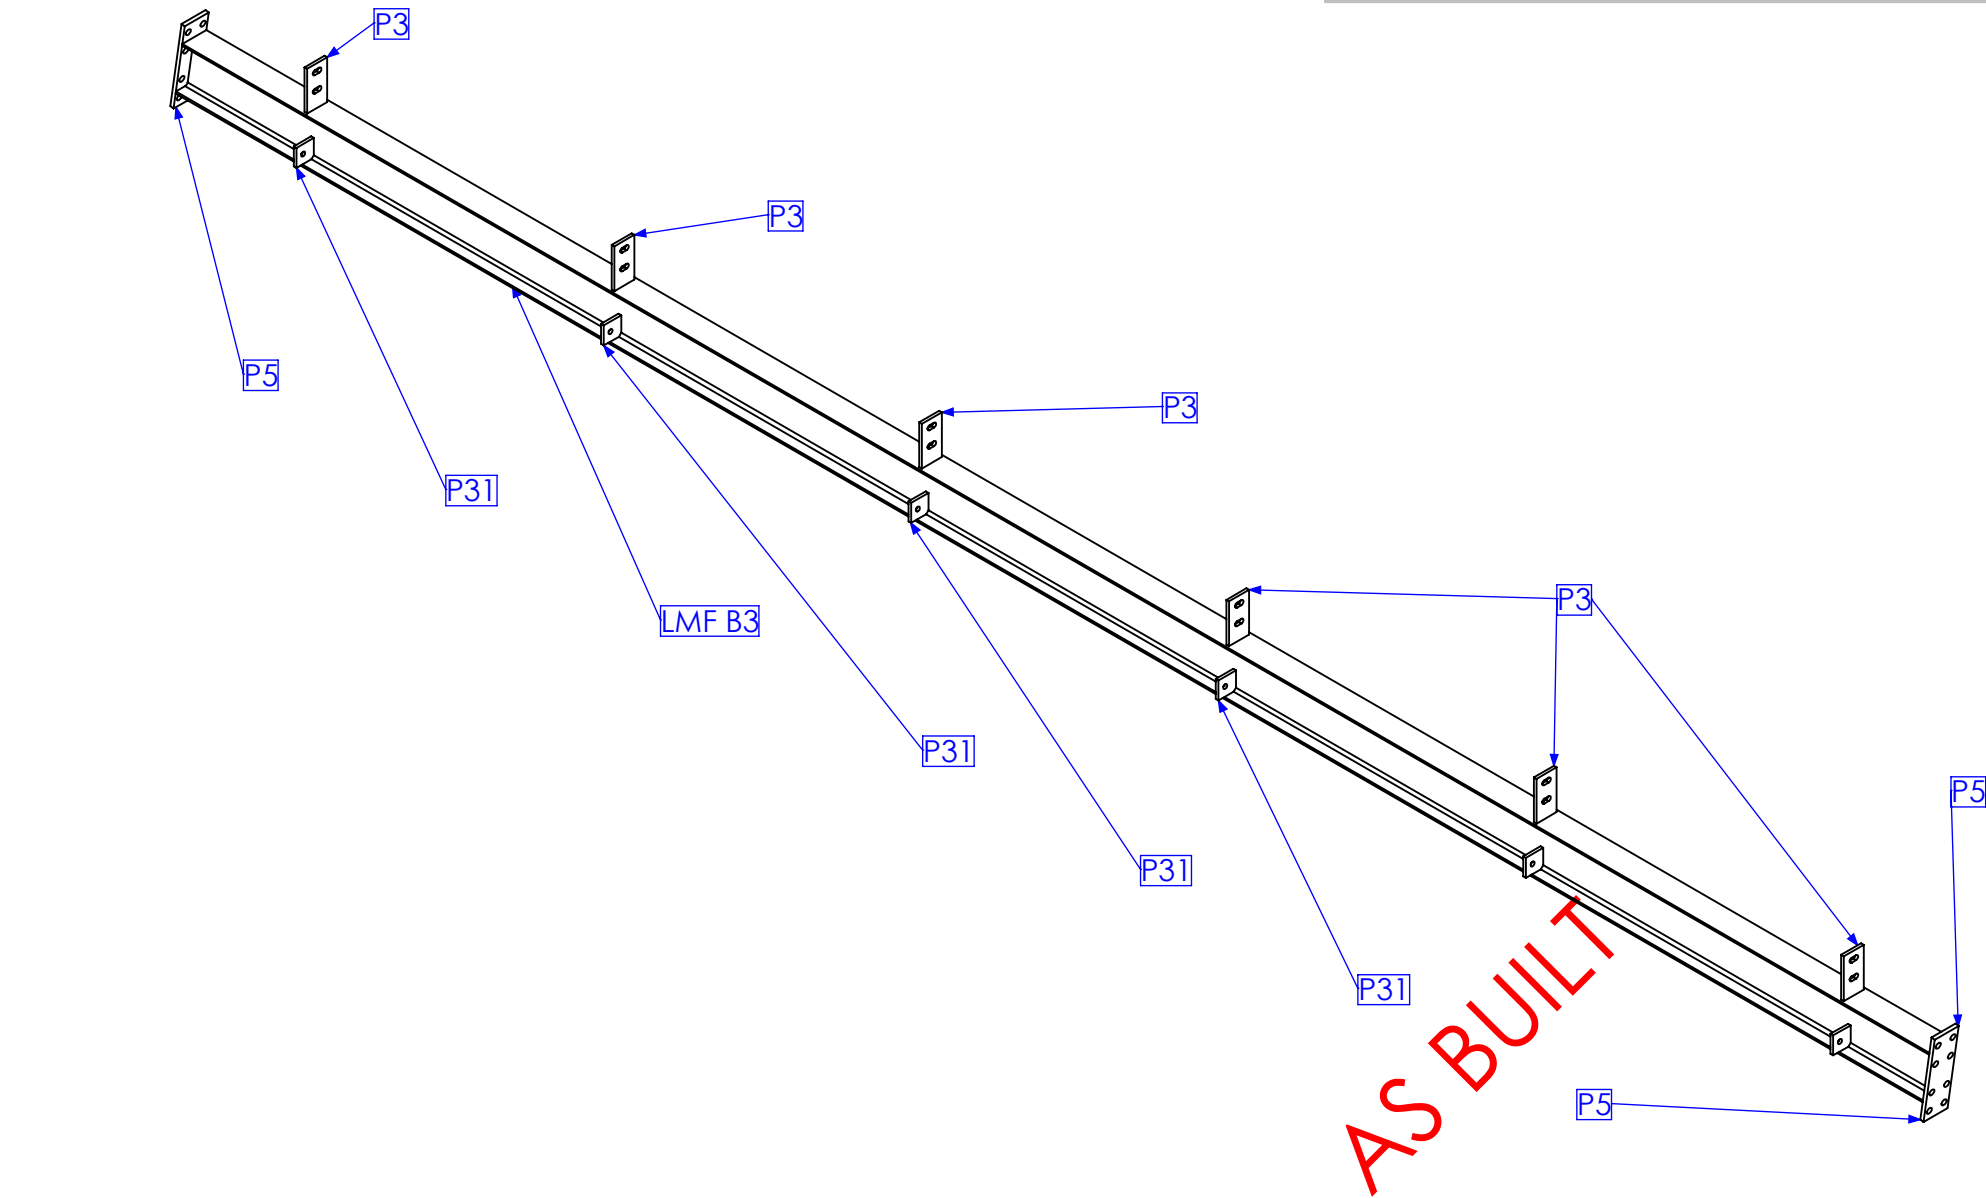

TYPICAL
DETAIL AH
SCALE 1 : 10

RELEASED FOR MANUFACTURE




REV	DESCRIPTION	DATE	AMMENDED BY
01	INITIAL ISSUE	21/12/2012	SDB
02	ADD GATES TO REAR OF SHED	20/02/2013	SDB
03	AS BUILT DRGS	28/06/2013	SDB
04	AMMENDMENT		

FINISH REQUIREMENTS-	HOT DIPPED GALVANISED (ALLOW FOR DRAINAGE WHERE APPLICABLE)
PROPRIETARY NOTICE	AUSFAB CONSTRUCTIONS
THIS DRAWING IS THE PROPERTY OF AUSFAB CONSTRUCTIONS. COPYRIGHT IS RESERVED. THIS DRAWING MAY NOT BE COPIED OR USED IN ANY MANNER EXCEPT AS AGREED TO BY AUSFAB CONSTRUCTIONS. THE DRAWINGS, IDEAS & INVENTIONS SHOWN SHALL NOT BE DISCLOSED TO OTHER PARTIES.	
40 Kenilworth Street, Warwick, Queensland, Australia 4011 Phone: 1300 995 970 Fax: 1300 998 983	

APPROX. MASS: kg	DO NOT SCALE IF IN DOUBT - ASK
DRAWING NOTES:	SCALE 1:20 UNO
ALL WELDING TO BE IN ACCORDANCE WITH AS1554 PART 1.	DRAWN SB 21/12/12
FOR UNTOLERANCED DIMENSIONS THE FOLLOWING LIMITS SHALL APPLY:	CHECK EG/DB/NW -
FABRICATION ± 2.0mm	APPROVED - -
MACHINING ± 0.25mm	

JOB NUMBER:	5248	QTY: 1
DESCRIPTION	BEAM LMF3A	AS1100 THIRD ANGLE PROJECTION A3
DRAWING No.	LMF B3A	SHEET 14 of 21 REV 03
PURPOSE OF DRAWING		FABRICATION


MARK NO.	QTY.	DESCRIPTION	LENGTH
P5	2	90x12 FL	290
LMF B3	1	180 UB 16.1	6562.1
P3	6	75x10 FL	145
P27	4	50x10 FL	200.89

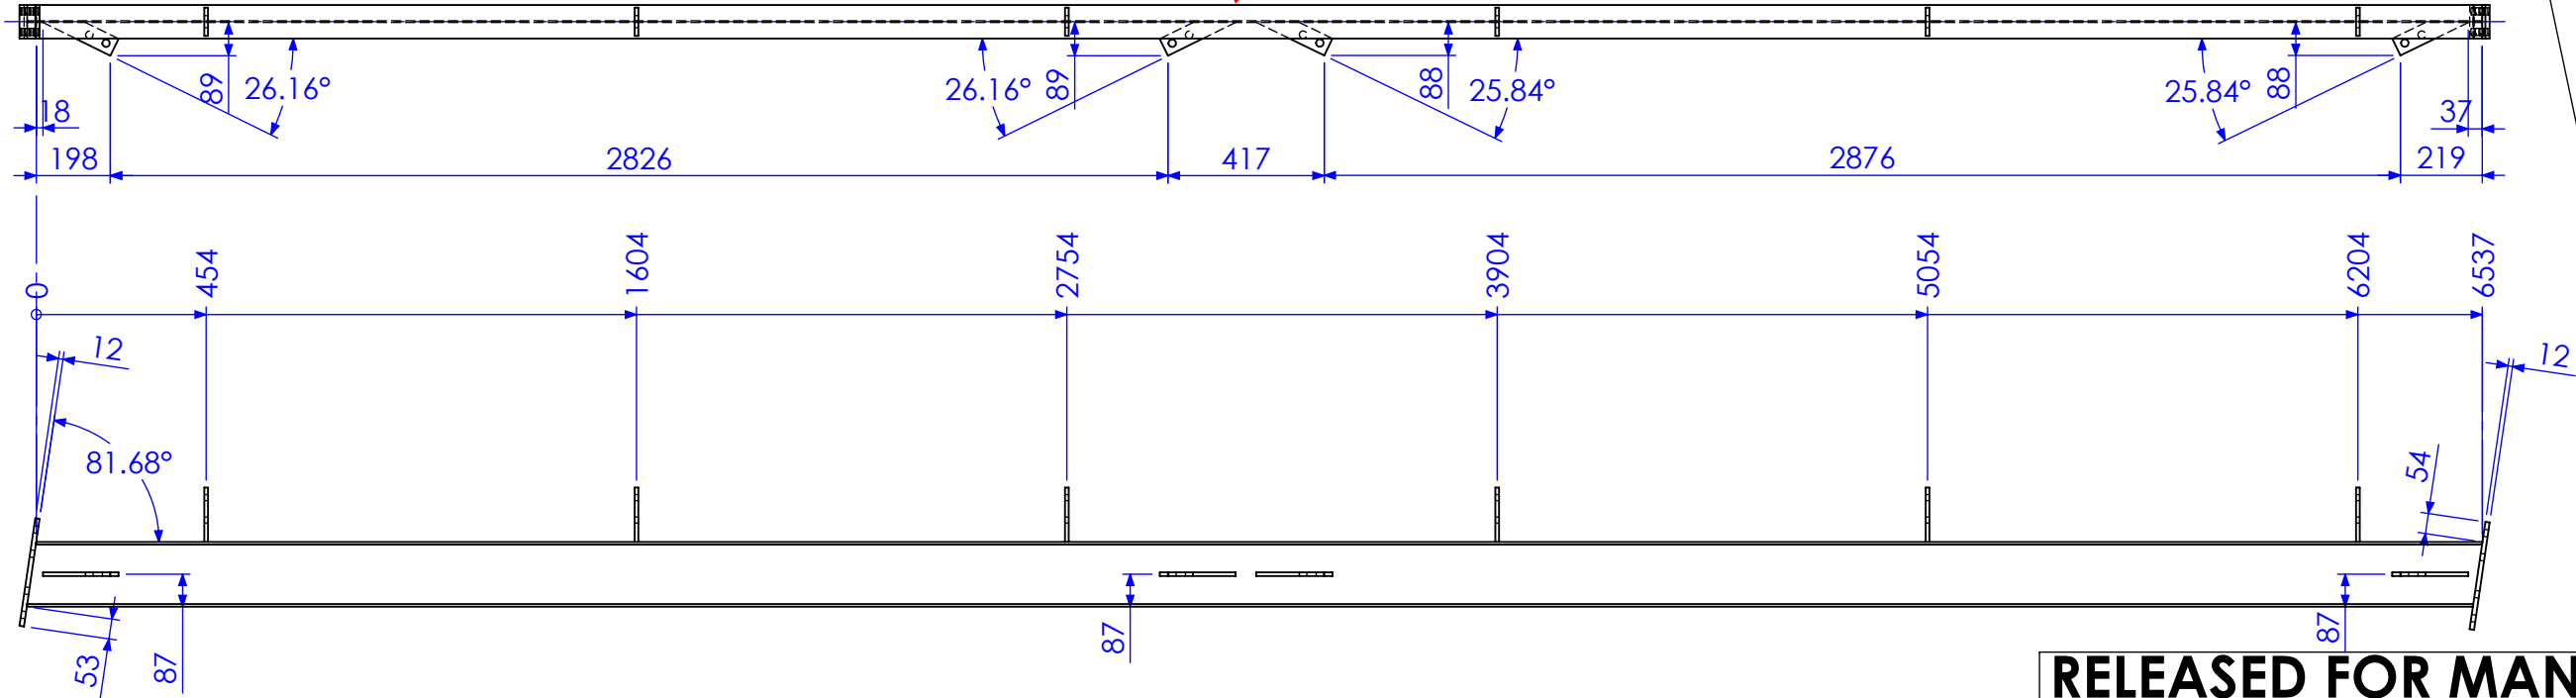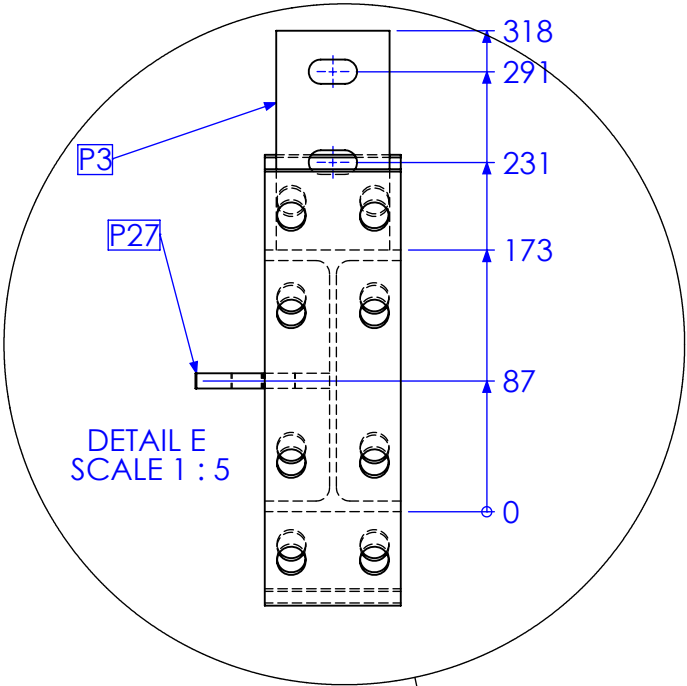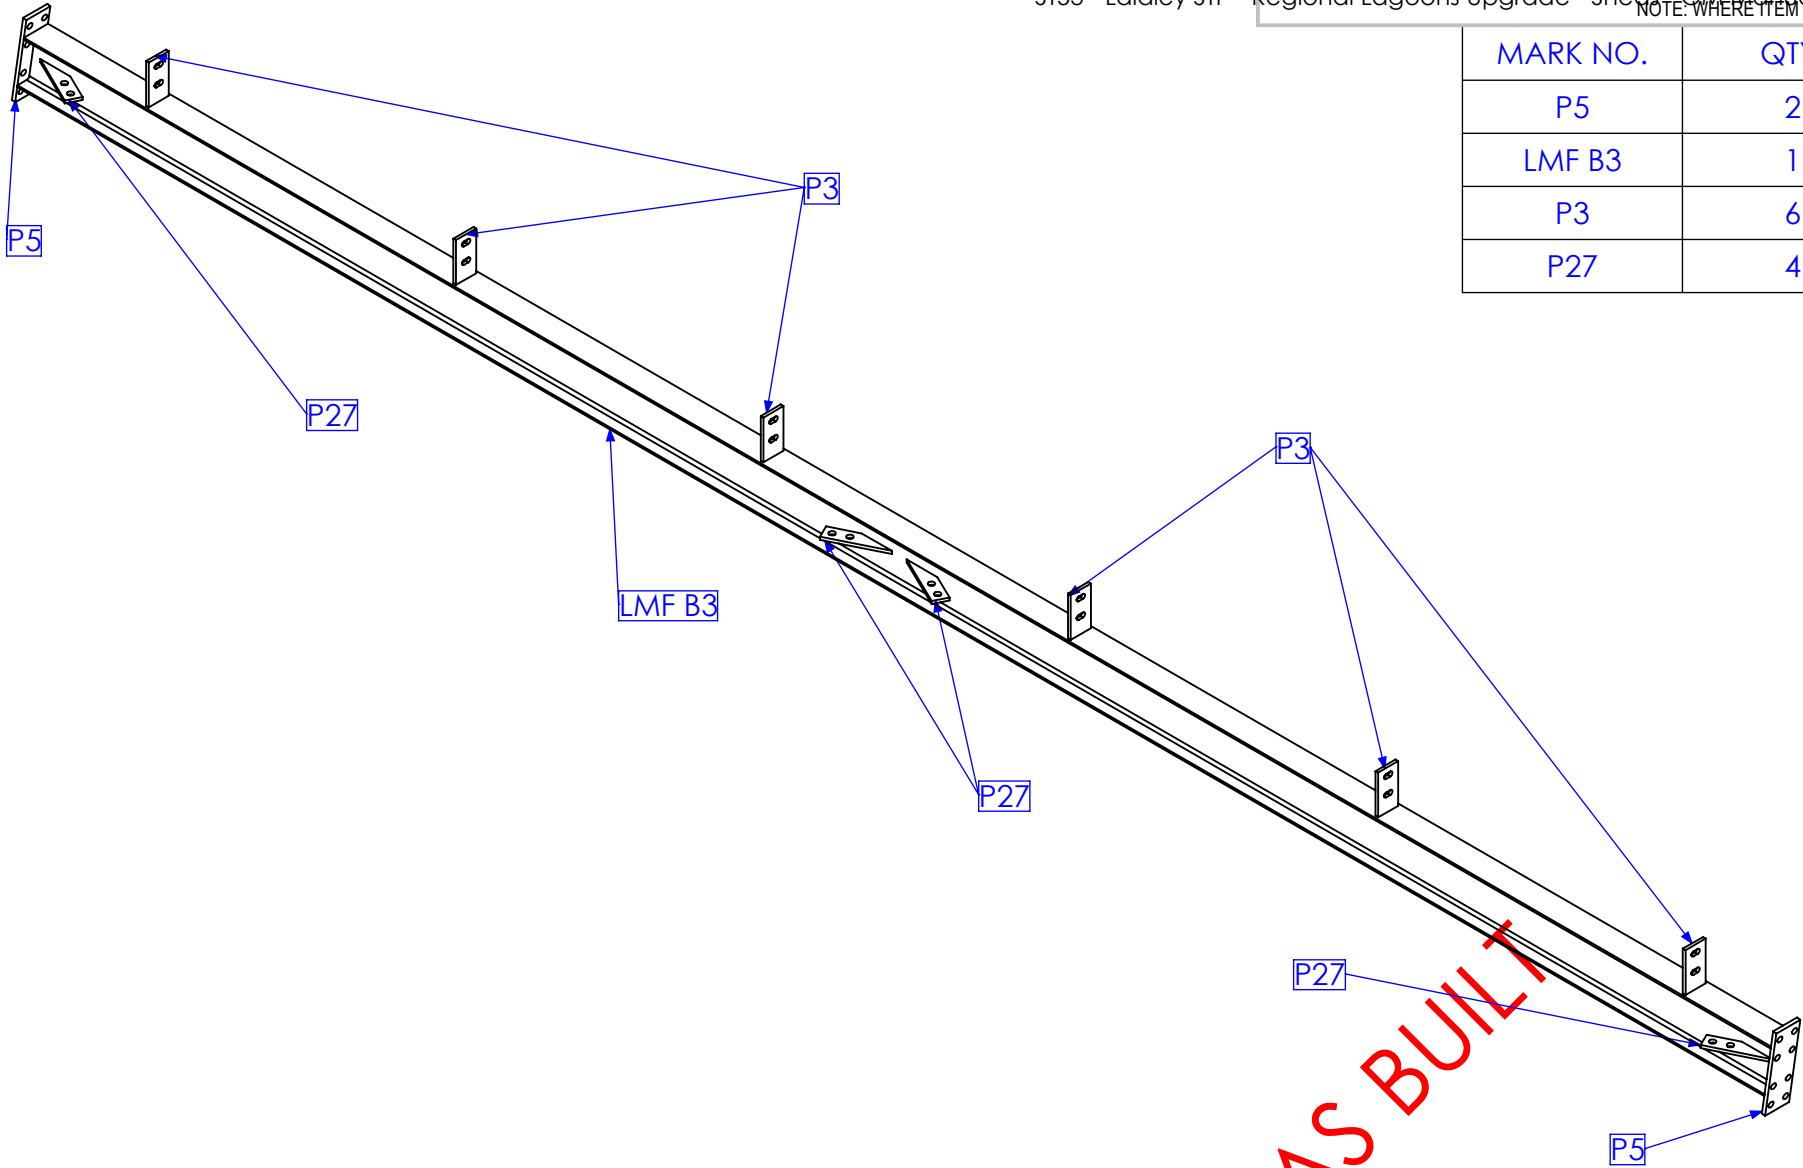



RELEASED FOR MANUFACTURE

REV	DESCRIPTION	DATE	AMMENDED BY
01	INITIAL ISSUE	21/12/2012	SDB
02	ADD GATES TO REAR OF SHED	20/02/2013	SDB
03	AS BUILT DRGS	28/06/2013	SDB
04	AMMENDMENT	DATE	AMMENDED BY

FINISH REQUIREMENTS- HOT DIPPED GALVANISED (ALLOW FOR DRAINAGE WHERE APPLICABLE)		APPROX. MASS: kg		DO NOT SCALE IF IN DOUBT - ASK		JOB NUMBER: 5248	QTY: 2	
PROPRIETARY NOTICE THIS DRAWING IS THE PROPERTY OF AUSFAB CONSTRUCTIONS. COPYRIGHT IS RESERVED. THIS DRAWING MAY NOT BE COPIED OR USED IN ANY MANNER EXCEPT AS AGREED TO BY AUSFAB CONSTRUCTIONS. THE DRAWINGS, IDEAS & INVENTIONS SHOWN SHALL NOT BE DISCLOSED TO OTHER PARTIES.		DRAWING NOTES: ALL WELDING TO BE IN ACCORDANCE WITH AS1554 PART 1. FOR UNTOLERANCED DIMENSIONS THE FOLLOWING LIMITS SHALL APPLY: FABRICATION ± 2.0mm MACHINING ± 0.25mm		SCALE 1:20 UNO		DESCRIPTION BEAM LMF3B		AS1100 THIRD ANGLE PROJECTION SHEET 15 of 21 REV 03 PURPOSE OF DRAWING FABRICATION
AUSFAB CONSTRUCTIONS 40 Kenilworth Street, Warwick, Queensland, Australia 4011 Phone: 1300 995 970 Fax: 1300 998 983 15/05/2015		DRAWING No. LMF B3B		APPROVED		Page 160 of 172		

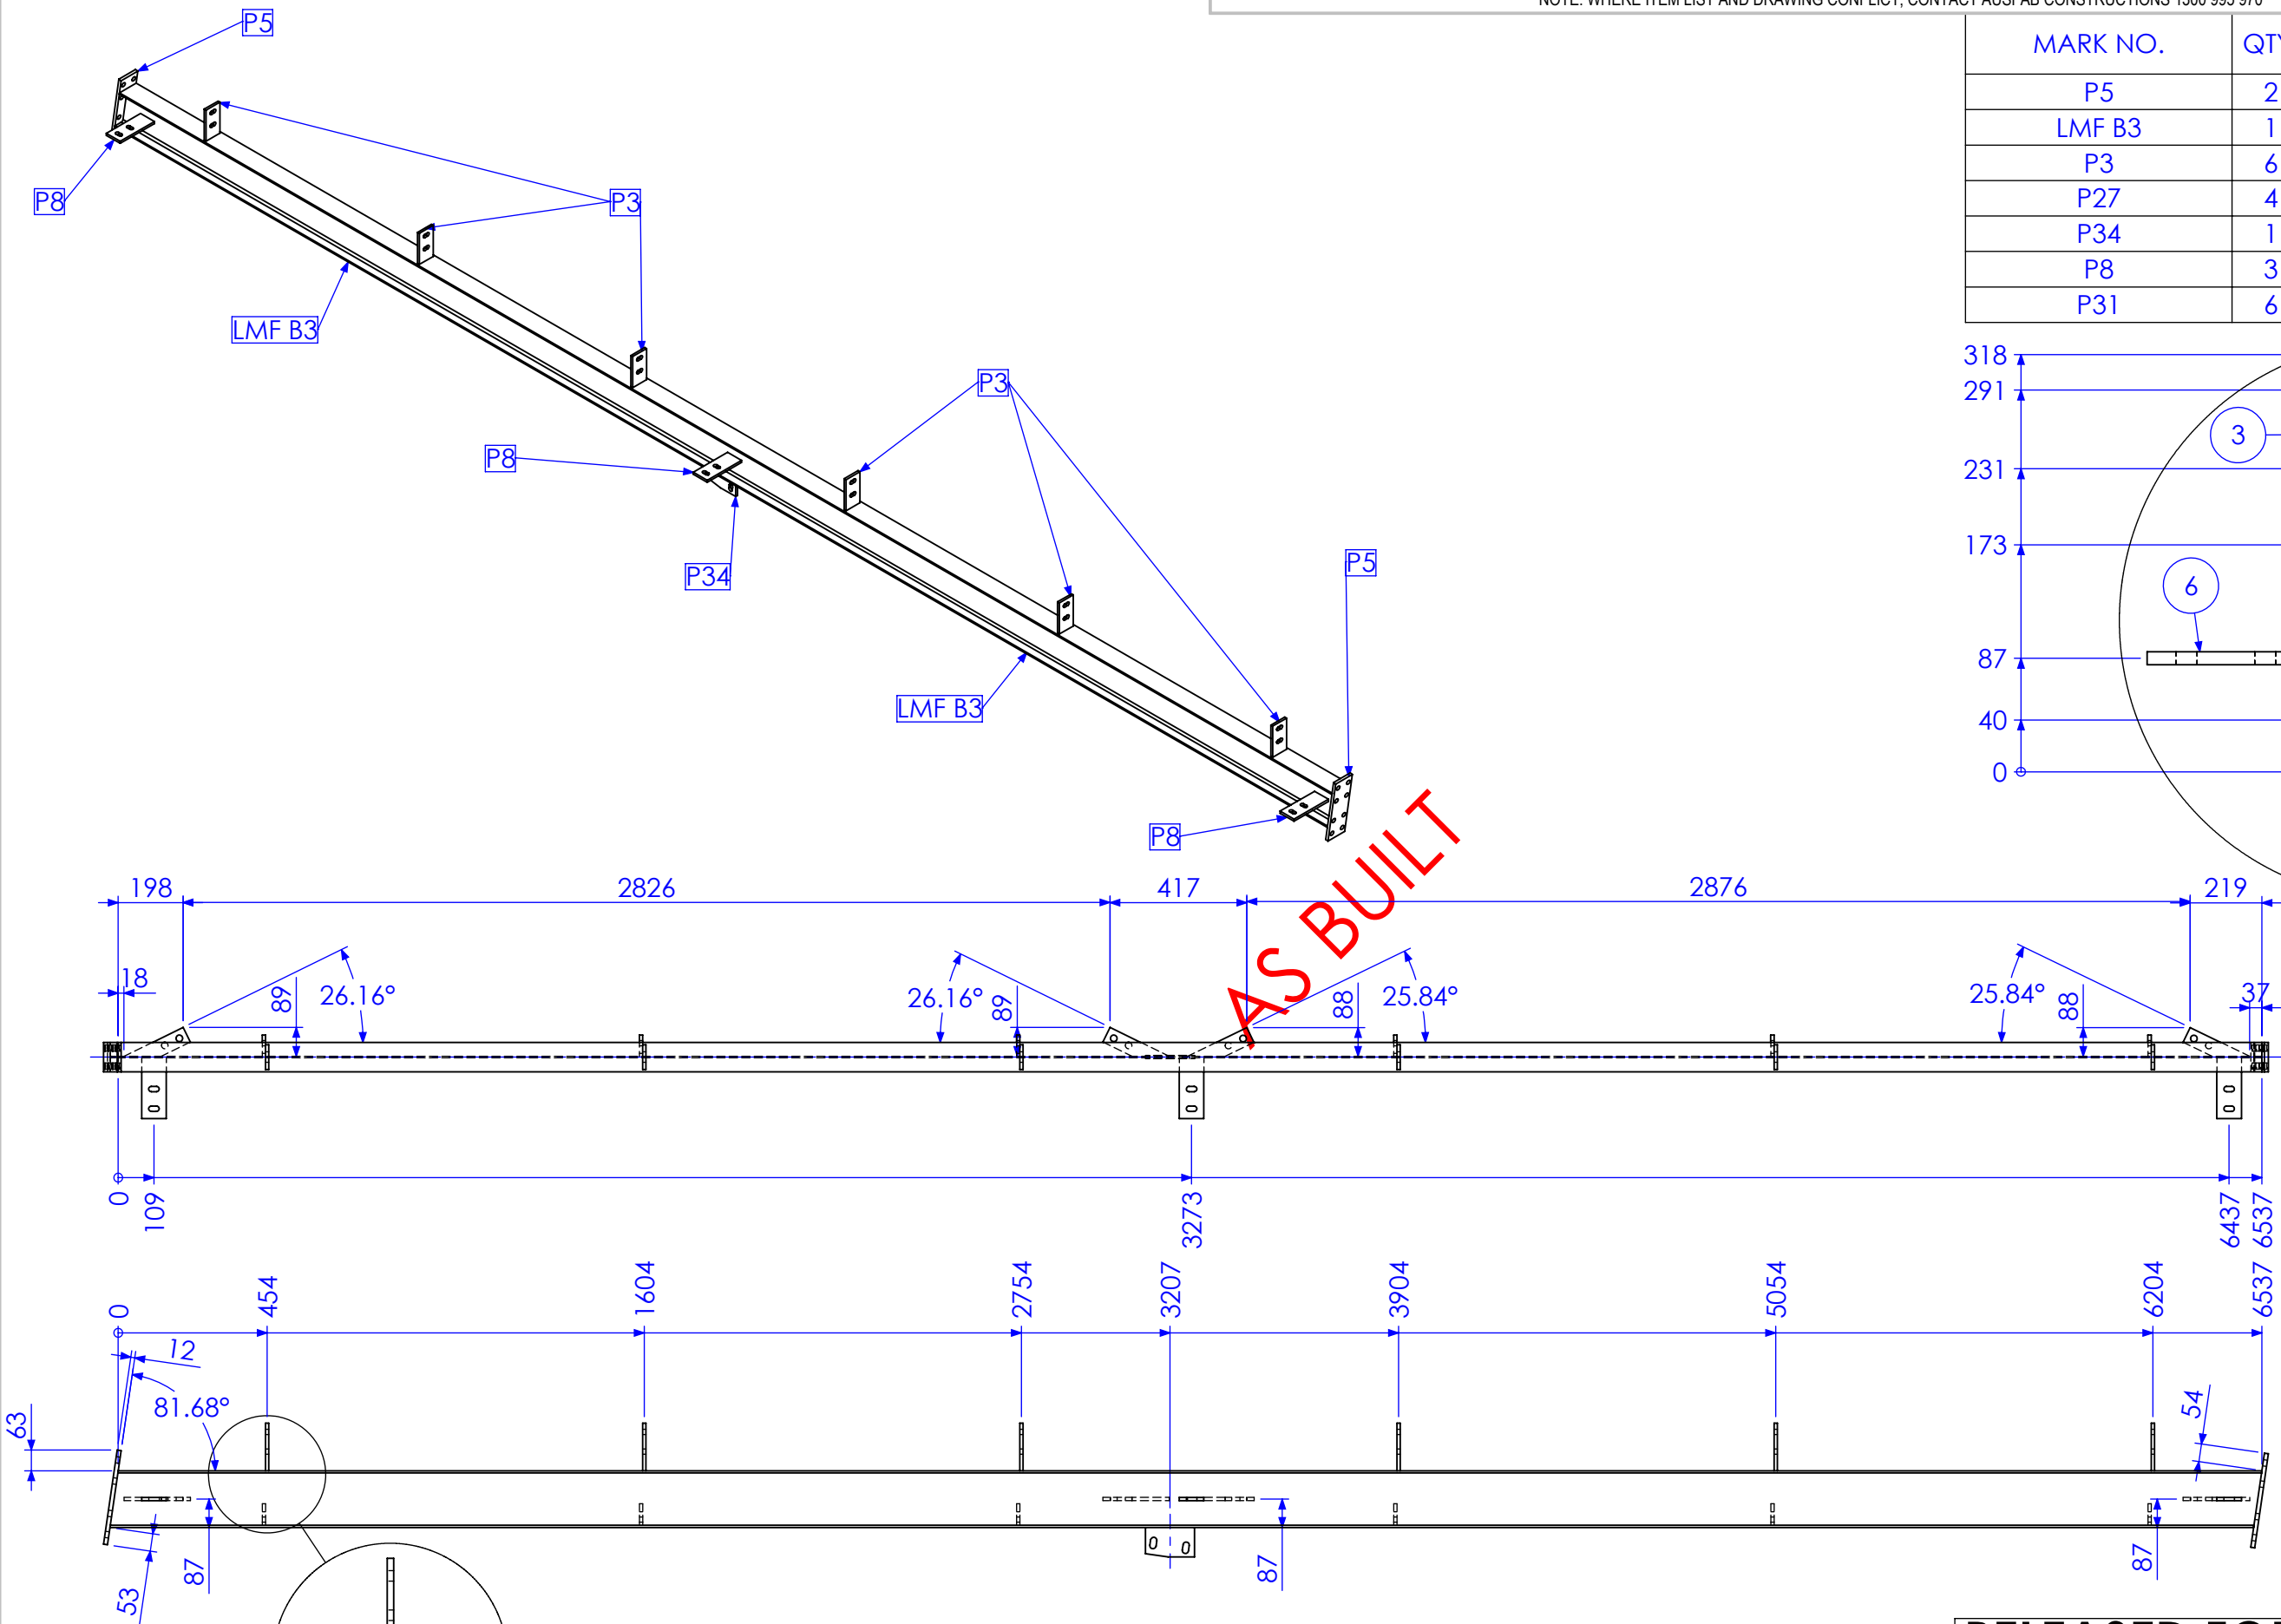

MARK NO.	QTY.	DESCRIPTION	LENGTH
P5	2	90x12 FL	290
LMF B3	1	180 UB 16.1	6562.1
P3	6	75x10 FL	145
P27	4	50x10 FL	201.63
P34	1	90x10 FL	150
P8	3	75x10 FL	185
P31	6	65x10 FL	65

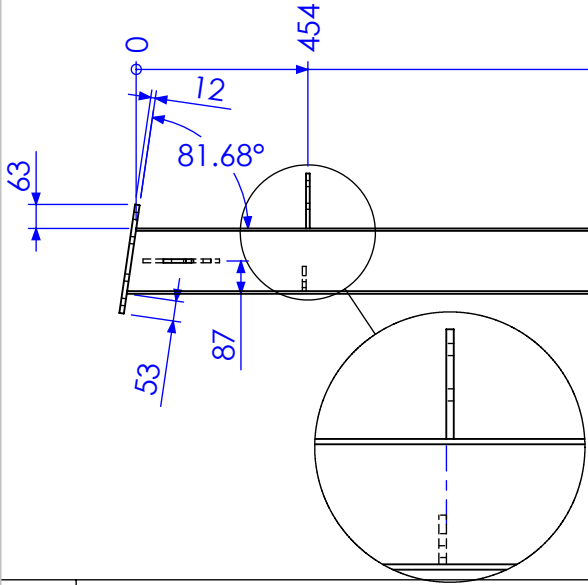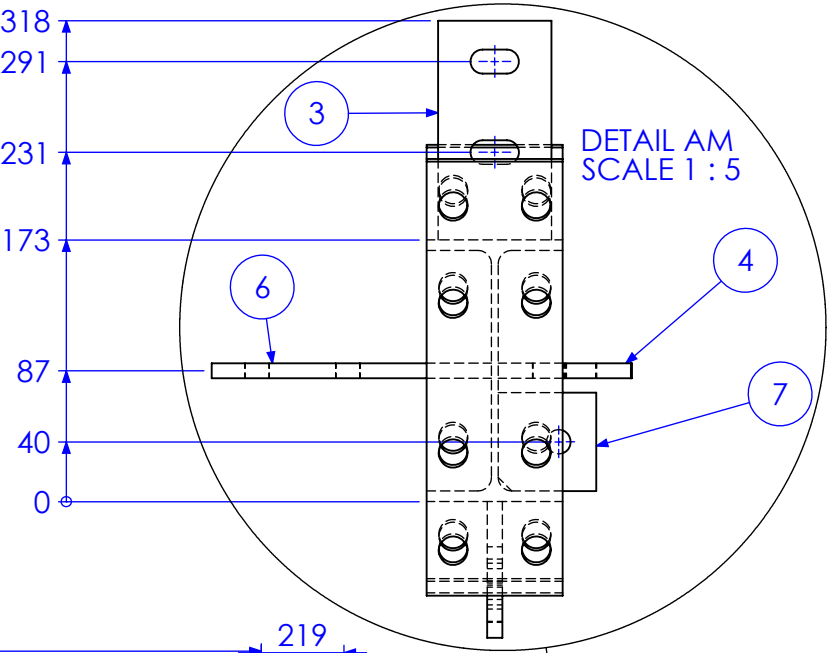

RELEASED FOR MANUFACTURE

REV	DESCRIPTION	DATE	AMENDED BY
01	INITIAL ISSUE	21/12/2012	SDB
02	ADD GATES TO REAR OF SHED	20/02/2013	SDB
03	AS BUILT DRGS	28/06/2013	SDB
04	AMMENDMENT		

FINISH REQUIREMENTS-
HOT DIPPED GALVANISED (ALLOW FOR DRAINAGE WHERE APPLICABLE)

PROPRIETARY NOTICE

THIS DRAWING IS THE PROPERTY OF AUSFAB CONSTRUCTIONS. COPYRIGHT IS RESERVED. THIS DRAWING MAY NOT BE COPIED OR USED IN ANY MANNER EXCEPT AS AGREED TO BY AUSFAB CONSTRUCTIONS. THE DRAWINGS, IDEAS & INVENTIONS SHOWN SHALL NOT BE DISCLOSED TO OTHER PARTIES.

AUSFAB CONSTRUCTIONS

40 Kenilworth Street,
Warwick, Queensland, Australia 4011
Phone: 1300 995 970
Fax: 1300 998 983



APPROX. MASS: kg		DO NOT SCALE IF IN DOUBT - ASK	
DRAWING NOTES: ALL WELDING TO BE IN ACCORDANCE WITH AS1554 PART 1. FOR UNTOLERANCED DIMENSIONS THE FOLLOWING LIMITS SHALL APPLY: FABRICATION ± 2.0mm MACHINING ± 0.25mm		SCALE 1:20 UNO	
DRAWN SB	21/12/12	CHECK EG/DB/NW	-
APPROVED	-		-

JOB NUMBER: 5248	QTY: 1
DESCRIPTION BEAM LMF3C	
DRAWING No. LMF B3C	
AS1100 THIRD ANGLE PROJECTION	A3
SHEET 16 of 21	REV 03
PURPOSE OF DRAWING FABRICATION	

Technical drawing of a mechanical assembly, likely a conveyor system, showing a long, angled track or guide. The drawing includes several callouts pointing to specific components:


- P3**: Points to the main track or guide structure.
- P5**: Points to the end support or mounting bracket.
- P8**: Points to the intermediate support or mounting bracket.
- LMF B3**: Points to a specific component, likely a bearing or roller, mounted on the track.

The drawing is a perspective view, showing the track extending from the foreground towards the background. The track is supported by a series of brackets (P8) and has a bearing (LMF B3) mounted on it. The end of the track is supported by a bracket (P5). The drawing is a technical illustration, likely for a patent or a technical manual.




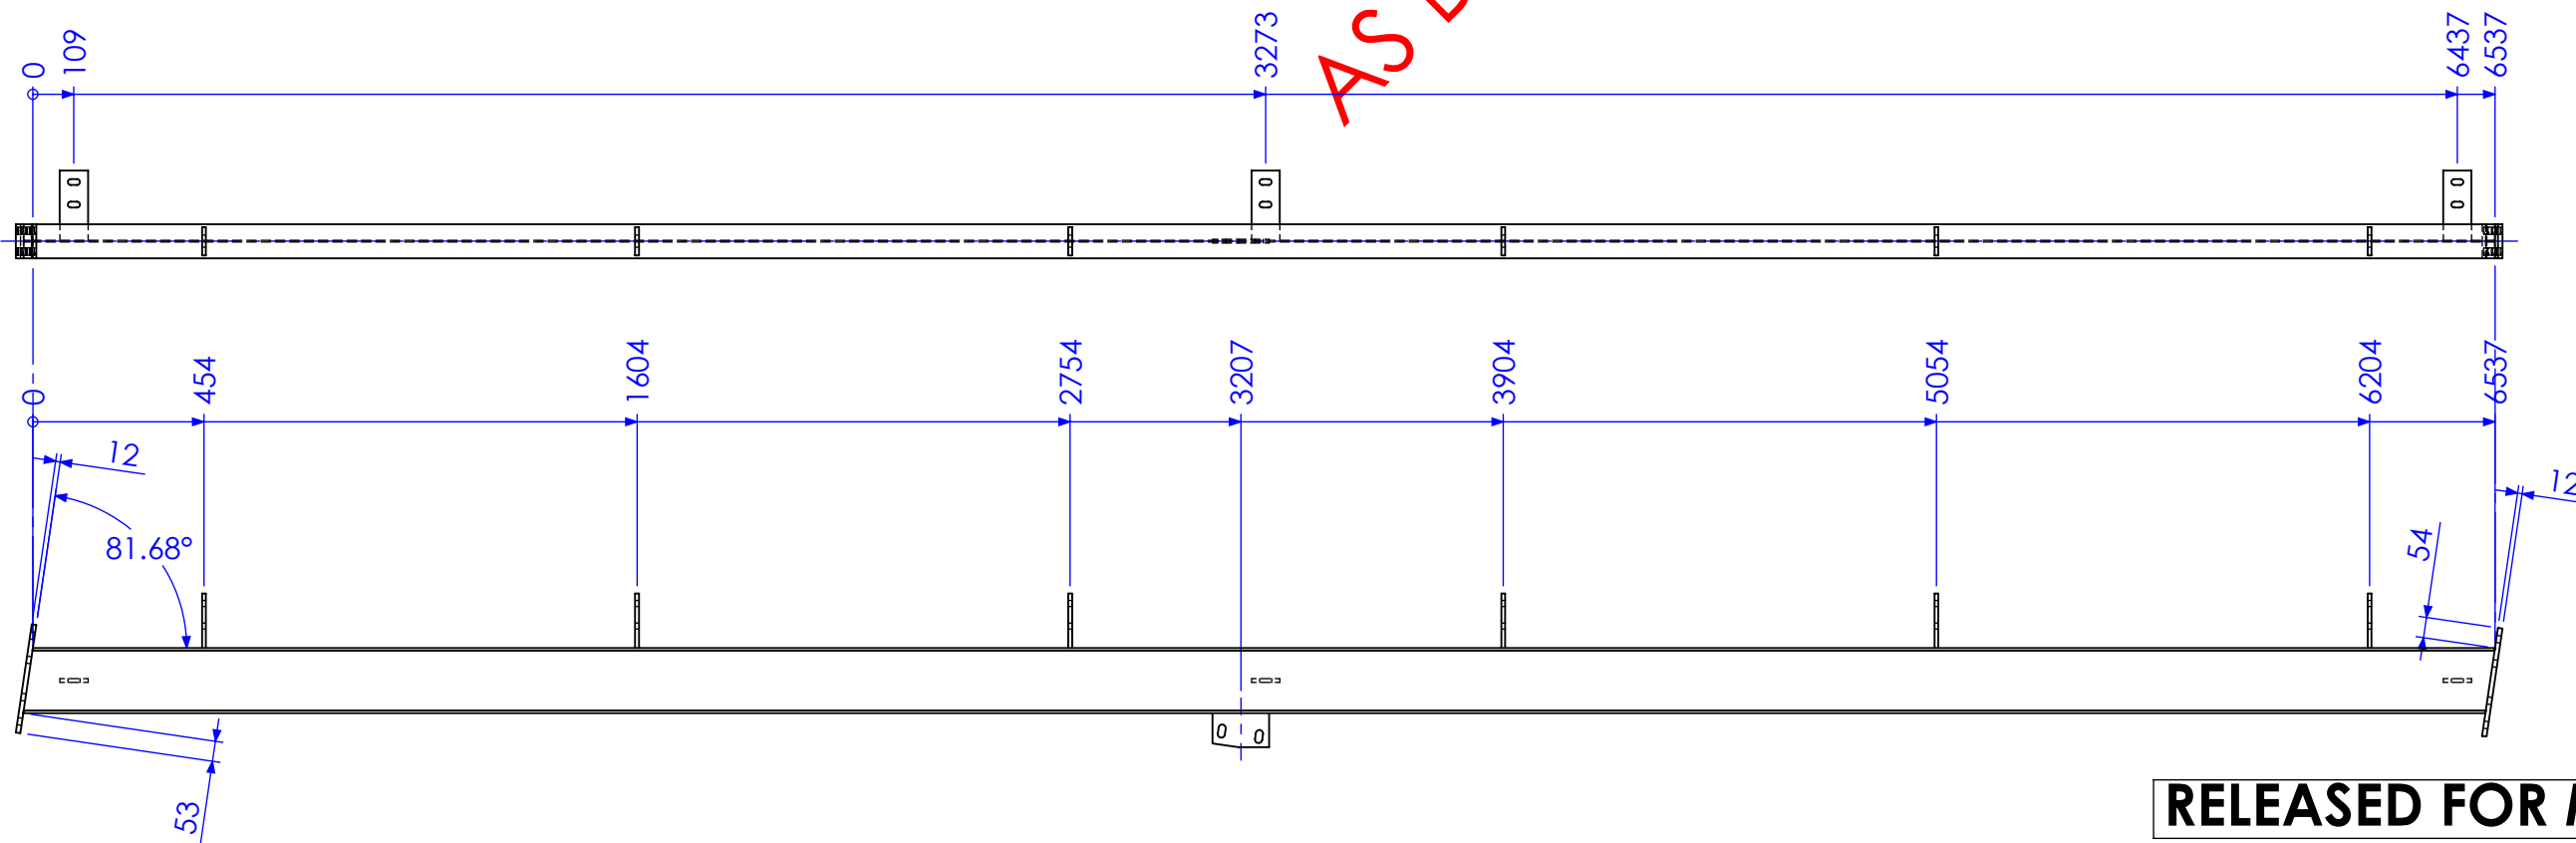
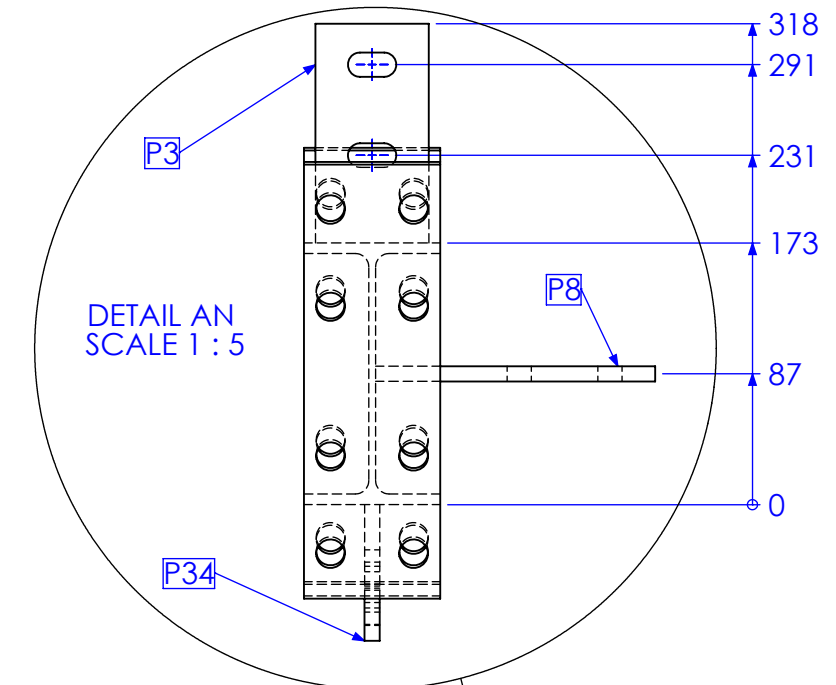


AS BUILT

RELEASED FOR MANUFACTURE

				FINISH REQUIREMENTS- HOT DIPPED GALVANISED (ALLOW FOR DRAINAGE WHERE APPLICABLE)		APPROX. MASS: kg		DO NOT SCALE IF IN DOUBT - ASK		JOB NUMBER: 5248		QTY: 1	
				PROPRIETARY NOTICE				DRAWING NOTES:		SCALE: 1:20 UNO		AS1100	
				THIS DRAWING IS THE PROPERTY OF AUSFAB CONSTRUCTIONS. COPYRIGHT IS RESERVED. THIS DRAWING MAY NOT BE COPIED OR USED IN ANY MANNER EXCEPT AS AGREED TO BY AUSFAB CONSTRUCTIONS. THE DRAWINGS, IDEAS & INVENTIONS SHOWN SHALL NOT BE DISCLOSED TO OTHER PARTIES.		40 Kenilworth Street, Warwick, Queensland, Australia 4011 Phone: 1300 998 983 Fax: 1300 998 983		ALL WELDING TO BE IN ACCORDANCE WITH AS1554 PART 1. FOR UNTOLERANCED DIMENSIONS THE FOLLOWING LIMITS SHALL APPLY: FABRICATION ± 2.0mm MACHINING ± 0.25mm		DRAWN: SB 21/12/12		A3	
										CHECK: EG/DB/NW -		SHEET 17 of 21 REV 03	
										APPROVED: - -		PURPOSE OF DRAWING: FABRICATION	
Q-Pulse Id TMS1177				DATE		15/05/2015				DRAWING No. LMF B3D		Page 162 of 177	
REVISIONS				AMMENDMENT									
01 INITIAL ISSUE				21/12/2012		SDB							
02 ADD GATES TO REAR OF SHED				20/02/2013		SDB							
03 AS BUILT DRGS				28/06/2013		SDB							
04 BEAM LMF3D													

MARK NO.	QTY.	DESCRIPTION	LENGTH
P5	2	90x12 FL	290
LMF B3	1	180 UB 16.1	6562.1
P3	6	75x10 FL	145

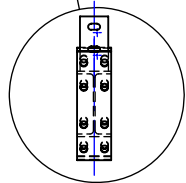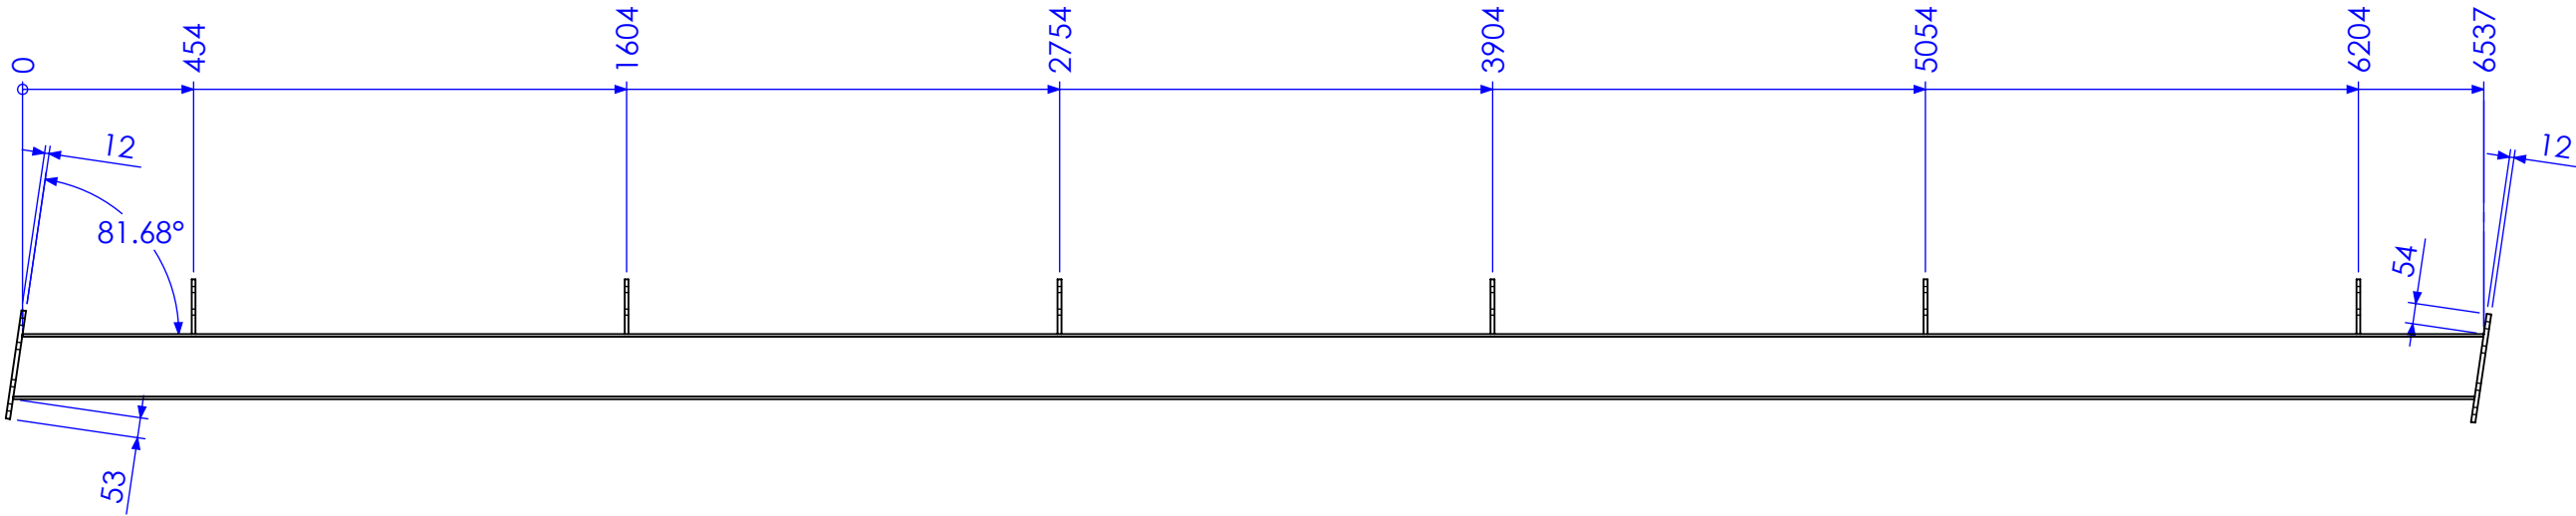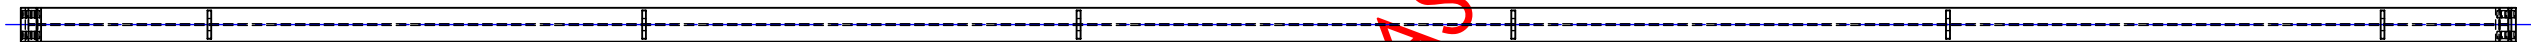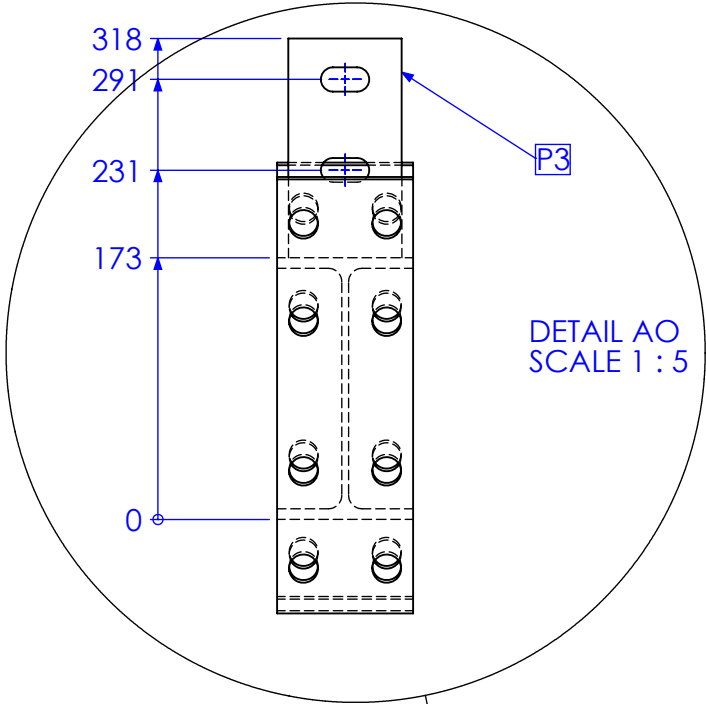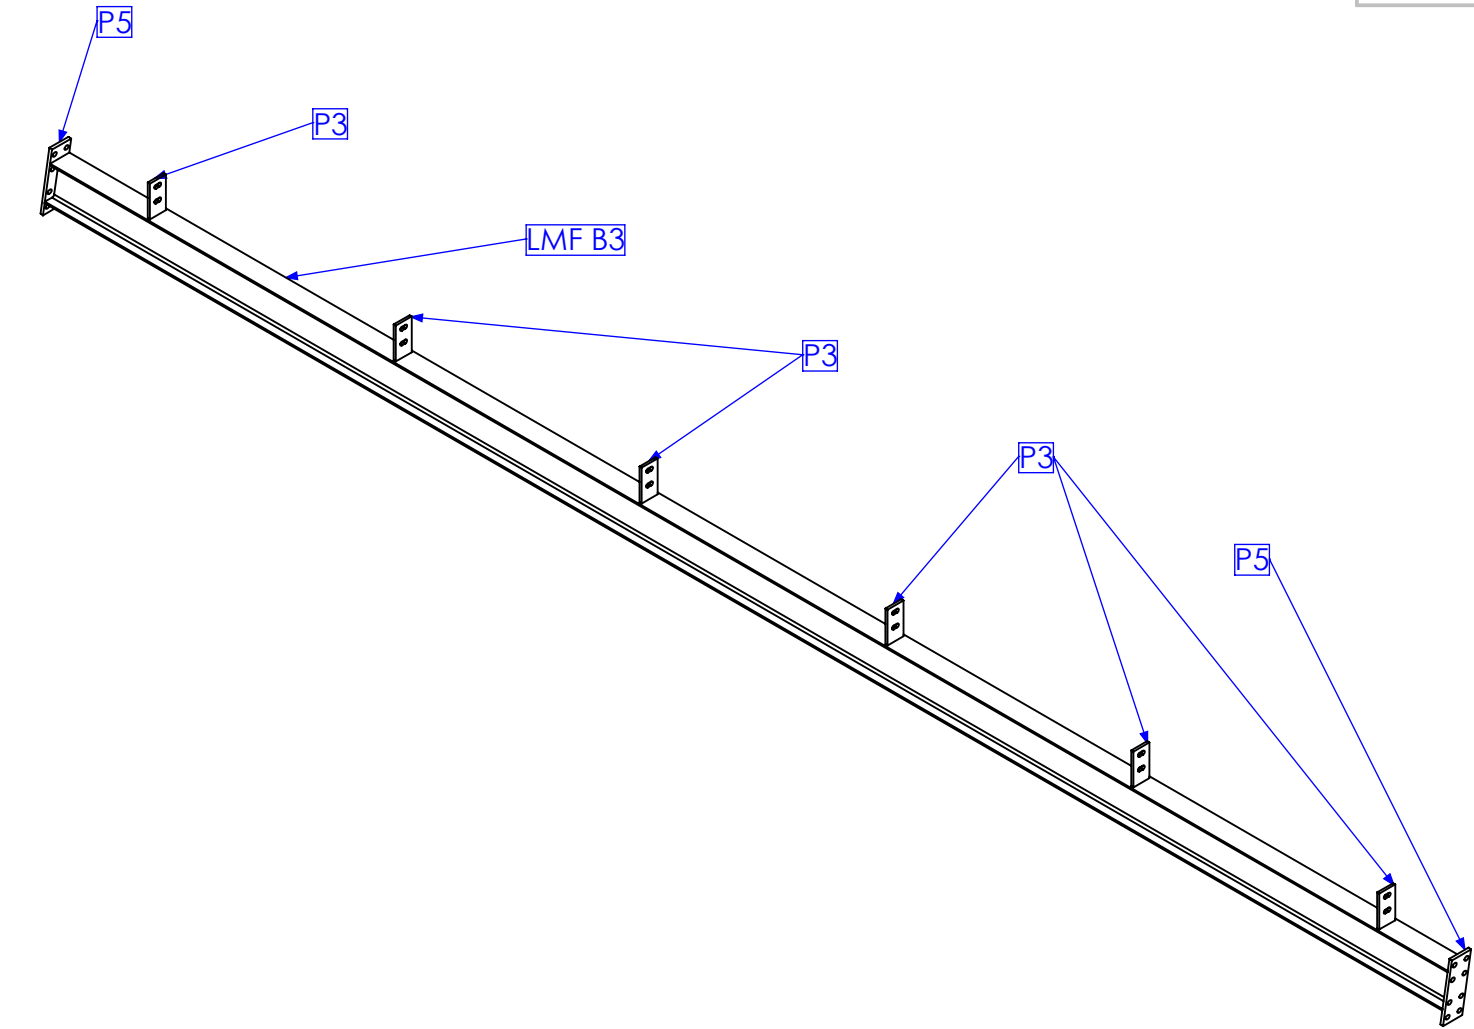


RELEASED FOR MANUFACTURE

REV	DESCRIPTION	DATE	AMMENDED BY
01	INITIAL ISSUE	21/12/2012	SDB
02	ADD GATES TO REAR OF SHED	20/02/2013	SDB
03	AS BUILT DRGS	28/06/2013	SDB
04	AMMENDMENT	DATE	AMMENDED BY


FINISH REQUIREMENTS- HOT DIPPED GALVANISED (ALLOW FOR DRAINAGE WHERE APPLICABLE)		APPROX. MASS: kg		DO NOT SCALE IF IN DOUBT - ASK		JOB NUMBER: 5248	QTY: 1	
PROPRIETARY NOTICE THIS DRAWING IS THE PROPERTY OF AUSFAB CONSTRUCTIONS. COPYRIGHT IS RESERVED. THIS DRAWING MAY NOT BE COPIED OR USED IN ANY MANNER EXCEPT AS AGREED TO BY AUSFAB CONSTRUCTIONS. THE DRAWINGS, IDEAS & INVENTIONS SHOWN SHALL NOT BE DISCLOSED TO OTHER PARTIES.		DRAWING NOTES: ALL WELDING TO BE IN ACCORDANCE WITH AS1554 PART 1. FOR UNTOLERANCED DIMENSIONS THE FOLLOWING LIMITS SHALL APPLY: FABRICATION ± 2.0mm MACHINING ± 0.25mm		SCALE 1:20 UNO		DESCRIPTION BEAM LMF3E		AS1100 THIRD ANGLE PROJECTION SHEET 18 of 21 REV 03 PURPOSE OF DRAWING FABRICATION
40 Kenilworth Street, Warwick, Queensland, Australia 4011 Phone: 1300 995 970 Fax: 1300 998 983		15/05/2015		DRAWING No. LMF B3E		Page 163 of 172		

MARK NO.	QTY.	DESCRIPTION	LENGTH
LMF M1	1	65x65x2 SHS	4075.76
P4	1	75x10 FL	215
P1	1	10MM CAP PLATE	63 X 63
P2	1	75x10 FL	150
P3	4	75x10 FL	145

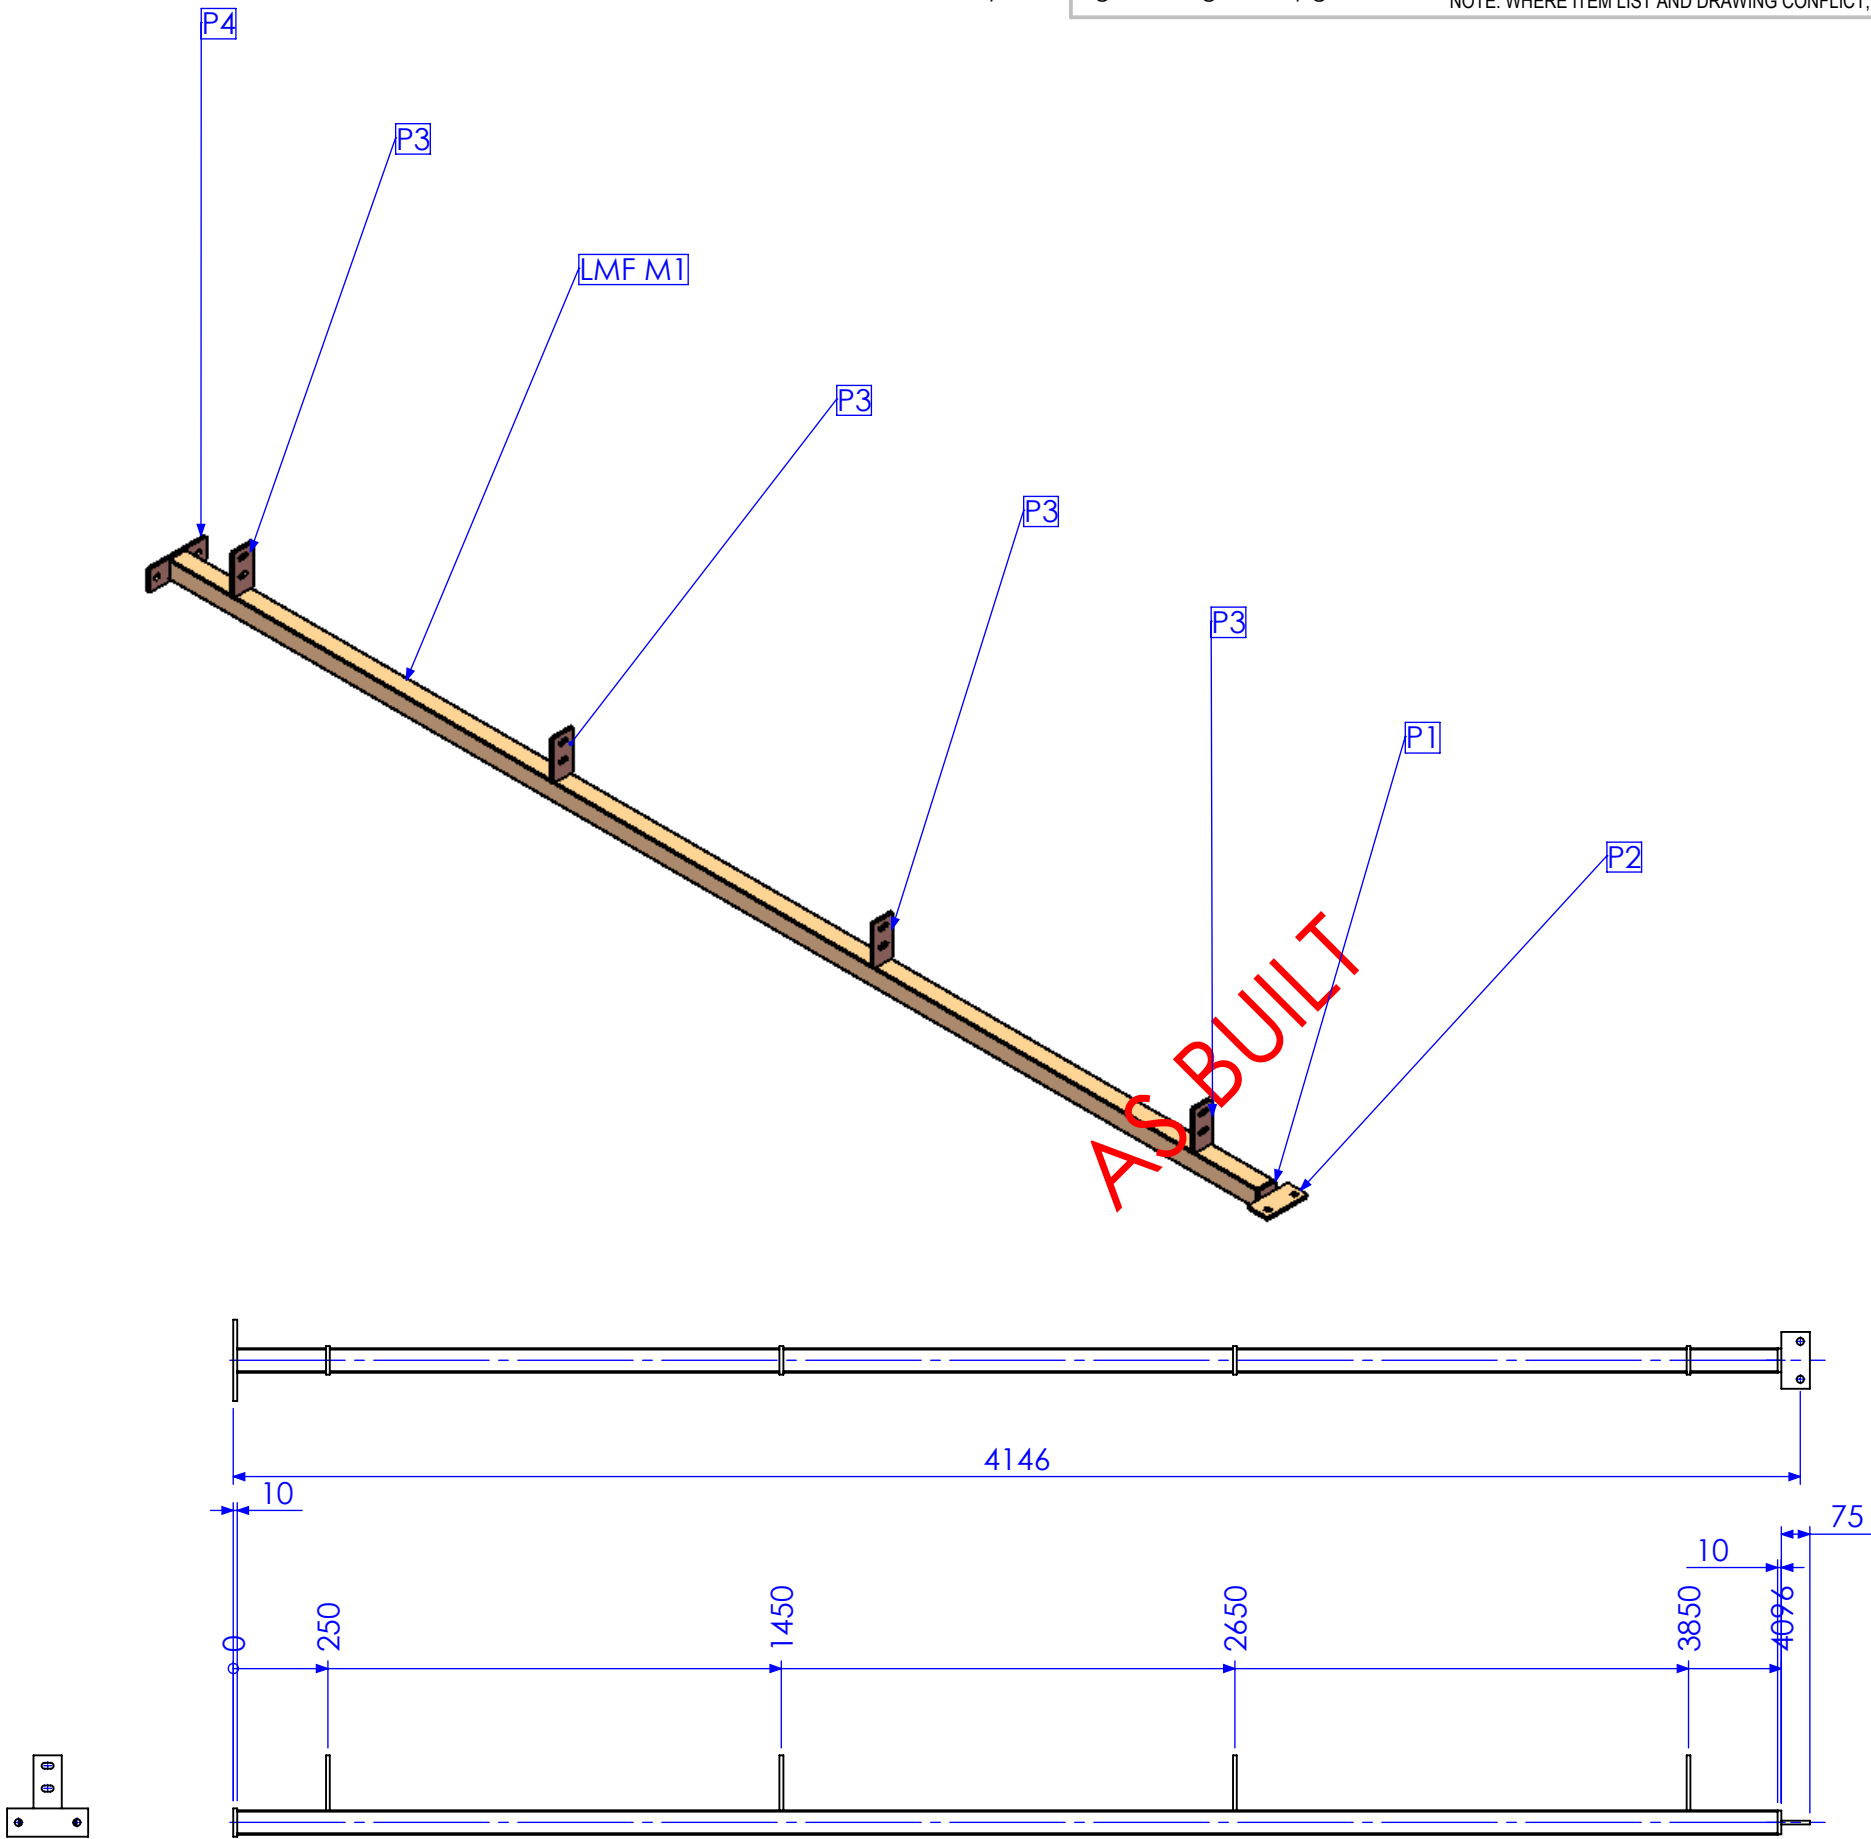

RELEASED FOR MANUFACTURE

REV	DESCRIPTION	DATE	AMMENDED BY
01	INITIAL ISSUE	21/12/2012	SDB
02	ADD GATES TO REAR OF SHED	20/02/2013	SDB
03	AS BUILT DRGS	28/06/2013	SDB
04	AMMENDMENT		



FINISH REQUIREMENTS- HOT DIPPED GALVANISED (ALLOW FOR DRAINAGE WHERE APPLICABLE)		APPROX. MASS: kg		DO NOT SCALE IF IN DOUBT - ASK		JOB NUMBER: 5248		QTY: 2			
<div>PROPRIETARY NOTICE</div> <div>THIS DRAWING IS THE PROPERTY OF AUSFAB CONSTRUCTIONS. COPYRIGHT IS RESERVED. THIS DRAWING MAY NOT BE COPIED OR USED IN ANY MANNER EXCEPT AS AGREED TO BY AUSFAB CONSTRUCTIONS. THE DRAWINGS, IDEAS & INVENTIONS SHOWN SHALL NOT BE DISCLOSED TO OTHER PARTIES.</div>		<div><div>40 Kenilworth Street, Warwick, Queensland, Australia 4011 Phone: 1300 995 970 Fax: 1300 998 983</div><div>15/05/2015</div></div>		<div>DRAWING NOTES:</div> <div>ALL WELDING TO BE IN ACCORDANCE WITH AS1554 PART 1. FOR UNTOLERANCED DIMENSIONS THE FOLLOWING LIMITS SHALL APPLY: FABRICATION ± 2.0mm MACHINING ± 0.25mm</div>		<div>SCALE 1:20 UNO</div> <div>DRAWN SB 21/12/12</div> <div>CHECK EG/DB/NW -</div> <div>APPROVED - -</div>		<div>DESCRIPTION</div> <div>LMF MULLION 1</div> <div>DRAWING No. LMF M1</div>		<div>AS1100 THIRD ANGLE PROJECTION</div> <div>A3</div> <div>SHEET 19 of 21 REV 03</div> <div>PURPOSE OF DRAWING FABRICATION</div>	
						Page 164 of 172					

MARK NO.	DESCRIPTION	LENGTH
LMF MCB	32x5 FL	4640


ST53 - Laidley STP - Regional Lagoons Upgrade - Sheds - OM Manual

NOTE: WHERE ITEM LIST AND DRAWING CONFLICT, CONTACT AUSFAB CONSTRUCTIONS 1300 995 970

MARK NO.	DESCRIPTION	LENGTH
FKMF MCB2	32x5 FL	85

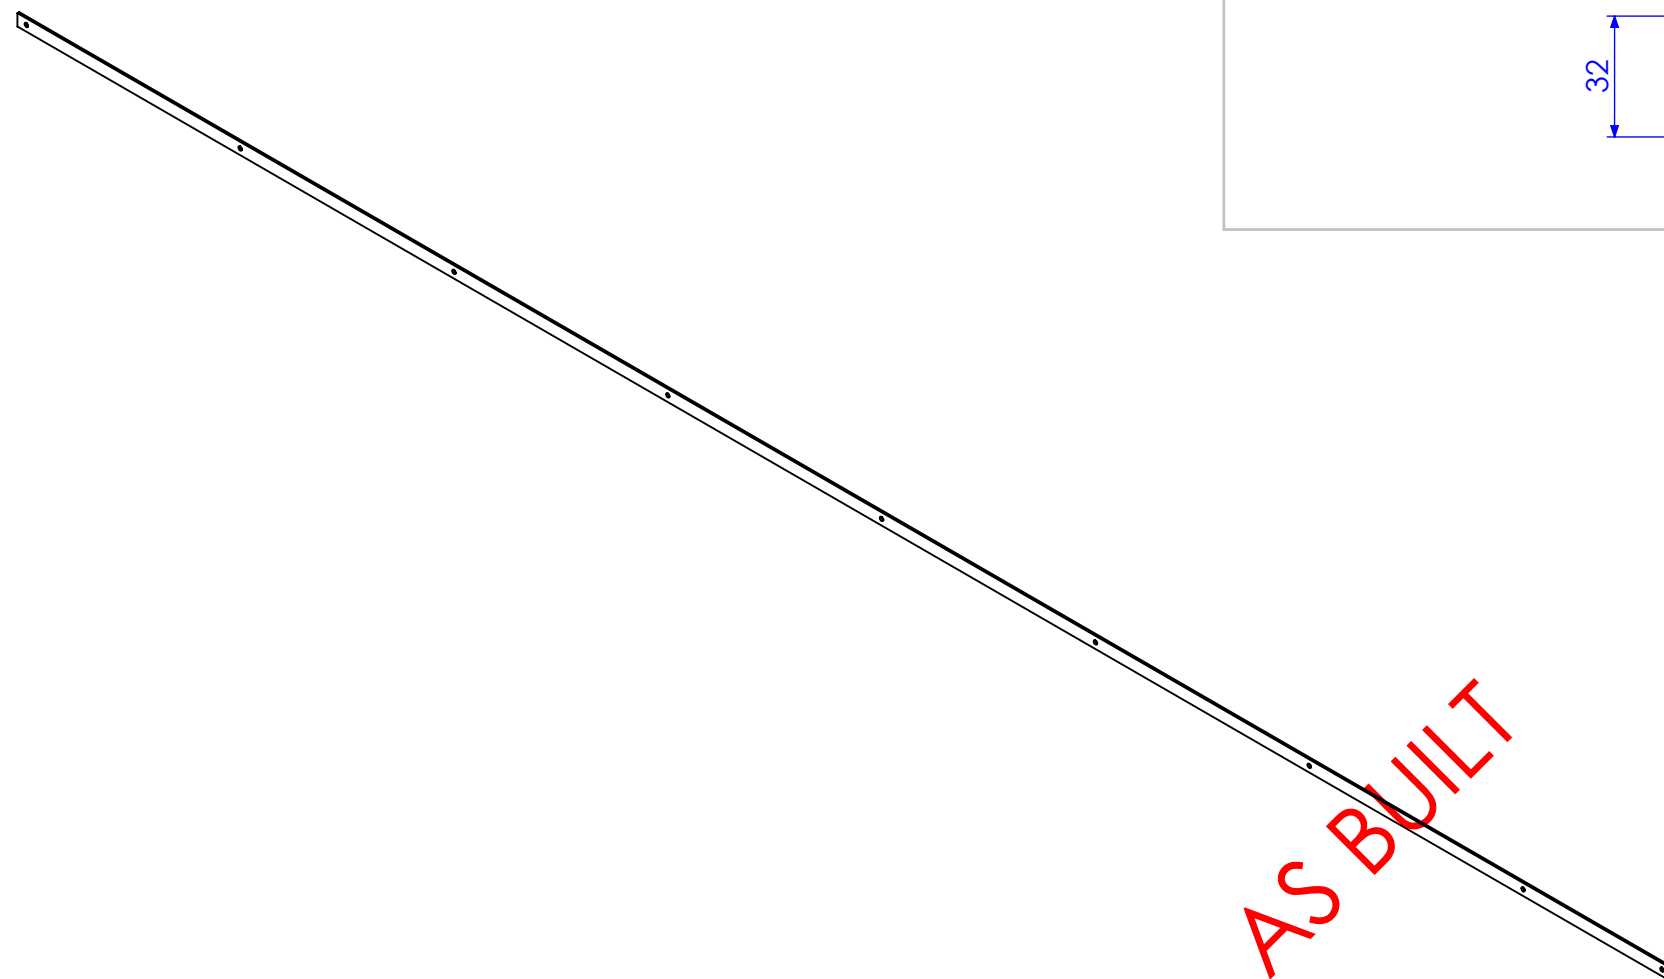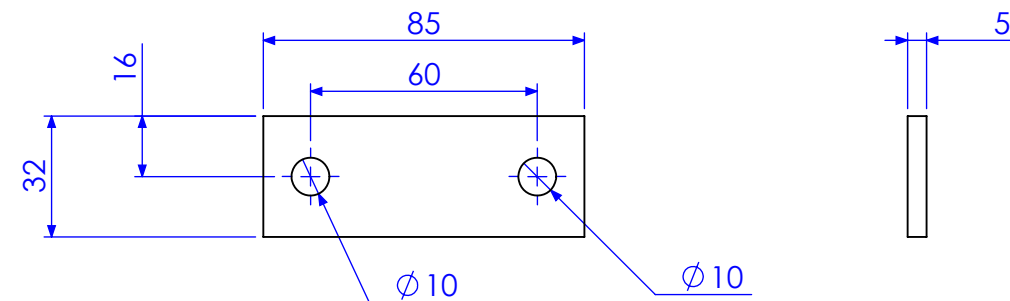


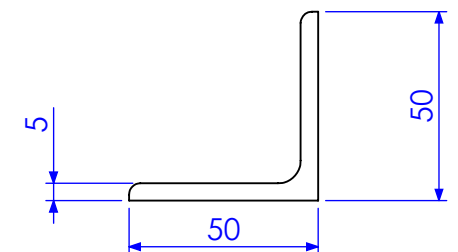
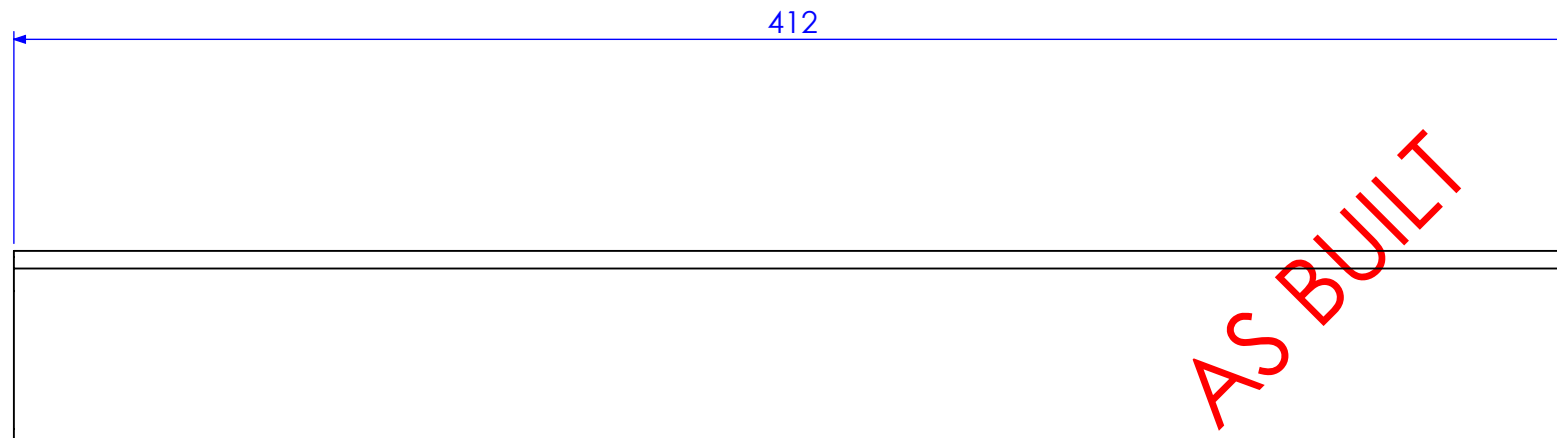
AS BUILT

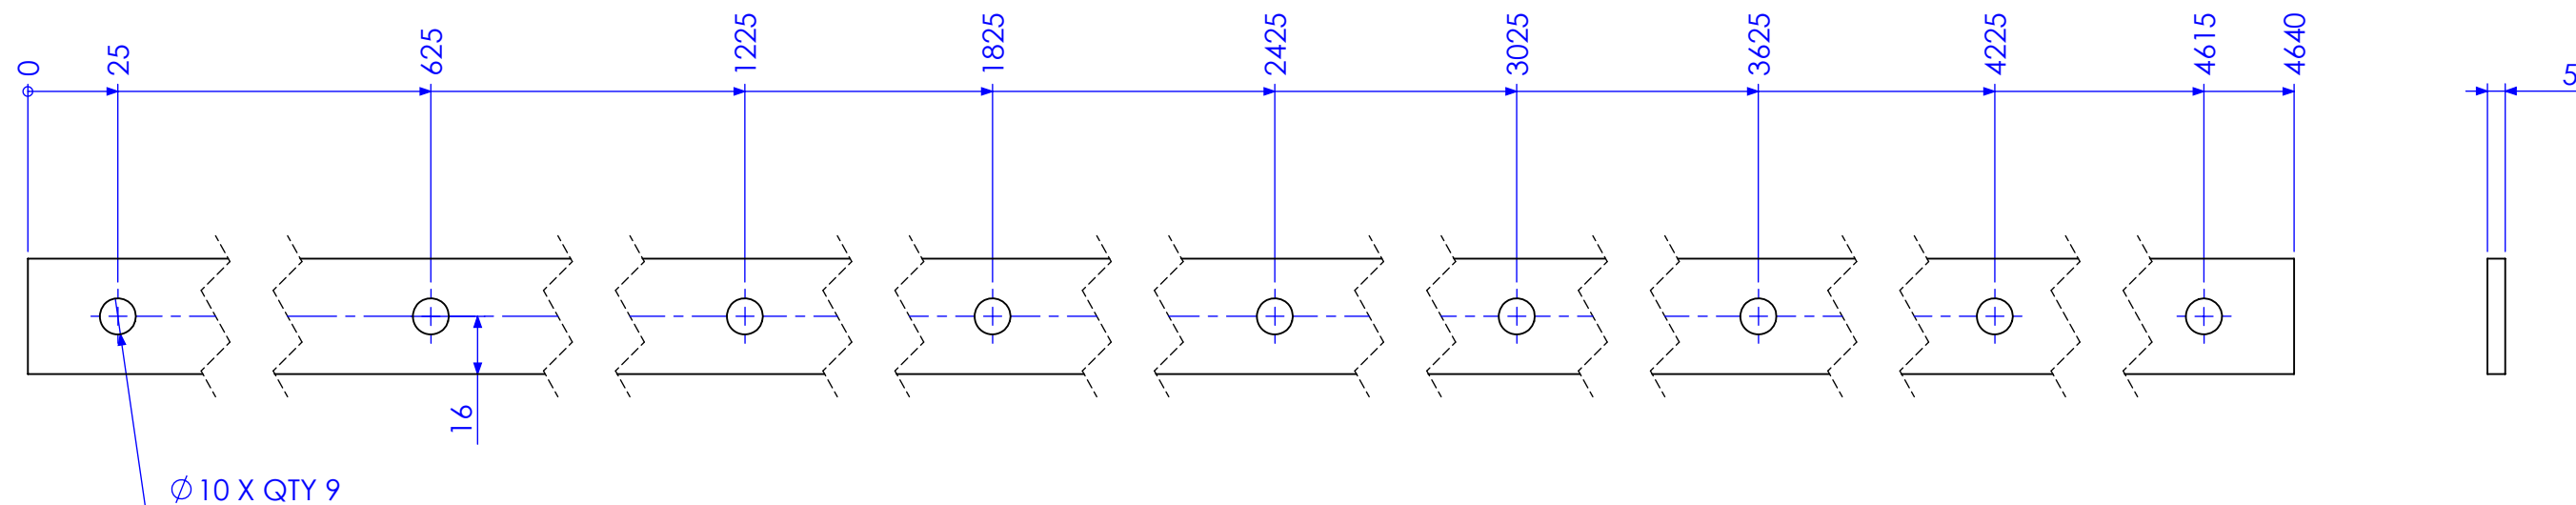

RELEASED FOR MANUFACTURE

01	INITIAL ISSUE	21/12/2012	SDB
02	ADD GATES TO REAR OF SHED	20/02/2013	SDB
03	AS BUILT DRGS	28/06/2013	SDB
REV	AMMENDMENT	DATE	AMMENDED BY

FINISH REQUIREMENTS-		HOT DIPPED GALVANISED (ALLOW FOR DRAINAGE WHERE APPLICABLE)		APPROX. MASS: kg		DO NOT SCALE IF IN DOUBT - ASK		JOB NUMBER:		5248		QTY: 2 OF EACH	
PROPRIETARY NOTICE THIS DRAWING IS THE PROPERTY OF AUSFAB CONSTRUCTIONS . COPYRIGHT IS RESERVED. THIS DRAWING MAY NOT BE COPIED OR USED IN ANY MANNER EXCEPT AS AGREED TO BY AUSFAB CONSTRUCTIONS . THE DRAWINGS, IDEAS & INVENTIONS SHOWN SHALL NOT BE DISCLOSED TO OTHER PARTIES.		 40 Kenilworth Street, Warwick, Queensland, Australia 4011 Phone: 1300 998 983 Fax: 1300 998 983 Date 15/05/2015		DRAWING NOTES: ALL WELDING TO BE IN ACCORDANCE WITH AS1554 PART 1. FOR INTOLERANCED DIMENSIONS THE FOLLOWING LIMITS SHALL APPLY: FABRICATION ± 2.0mm MACHINING ± 0.25mm		SCALE 1:2 UNO DRAWN SB 21/12/12 CHECK EG/DB/NW - APPROVED - -		DESCRIPTION <div style="text-align: center; font-size: 24px; font-weight: bold;">MESH CLAMP BAR 1</div>				AS1100 THIRD ANGLE PROJECTION A3 SHEET 20 of 21 REV 03 PURPOSE OF DRAWING FABRICATION	
								DRAWING No.		MCB1		Page 165 of 172	




ASK	JOB NUMBER:	5248	QTY: 12	
NO	DESCRIPTION		AS1100	A3
21/12/12	PURLIN FLY BRACE		THIRD ANGLE PROJECTION	
-			SHEET 21 of 21	REV 03
-			PURPOSE OF DRAWING	
	DRAWING No.	PFB	Page 166 of 172 FABRICATION	

01	INITIAL ISSUE	21/12/2012	SDB
02	ADD GATES TO REAR OF SHED	20/02/2013	SDB
03	AS BUILT DRGS	28/06/2013	SDB
REV	AMMENDMENT	DATE	AMMENDED BY

ITEM NO.	DESCRIPTION	QTY	Part No
1	JORY PART S4	8	S4-32
2	JORY PART BP4	8	BP4
3	GATE 1	2	5248-H-A1-A3-P3A
4	GATE 2	2	5248-H-A1-A3-P3B
5	MESH SUPPORT 1	4	5248-H-A1-A3-P2
6	MESH SECTION 1	2	5248-H-A1-A3-P6
7	MESH SECTION 2	1	5248-H-A1-A3-P7


- NOTES-
- JORY PARTS STANDARD OUT OF JORY CATALOGUE
 - GATE 2 IS OPPOSITE HAND TO GATE 1

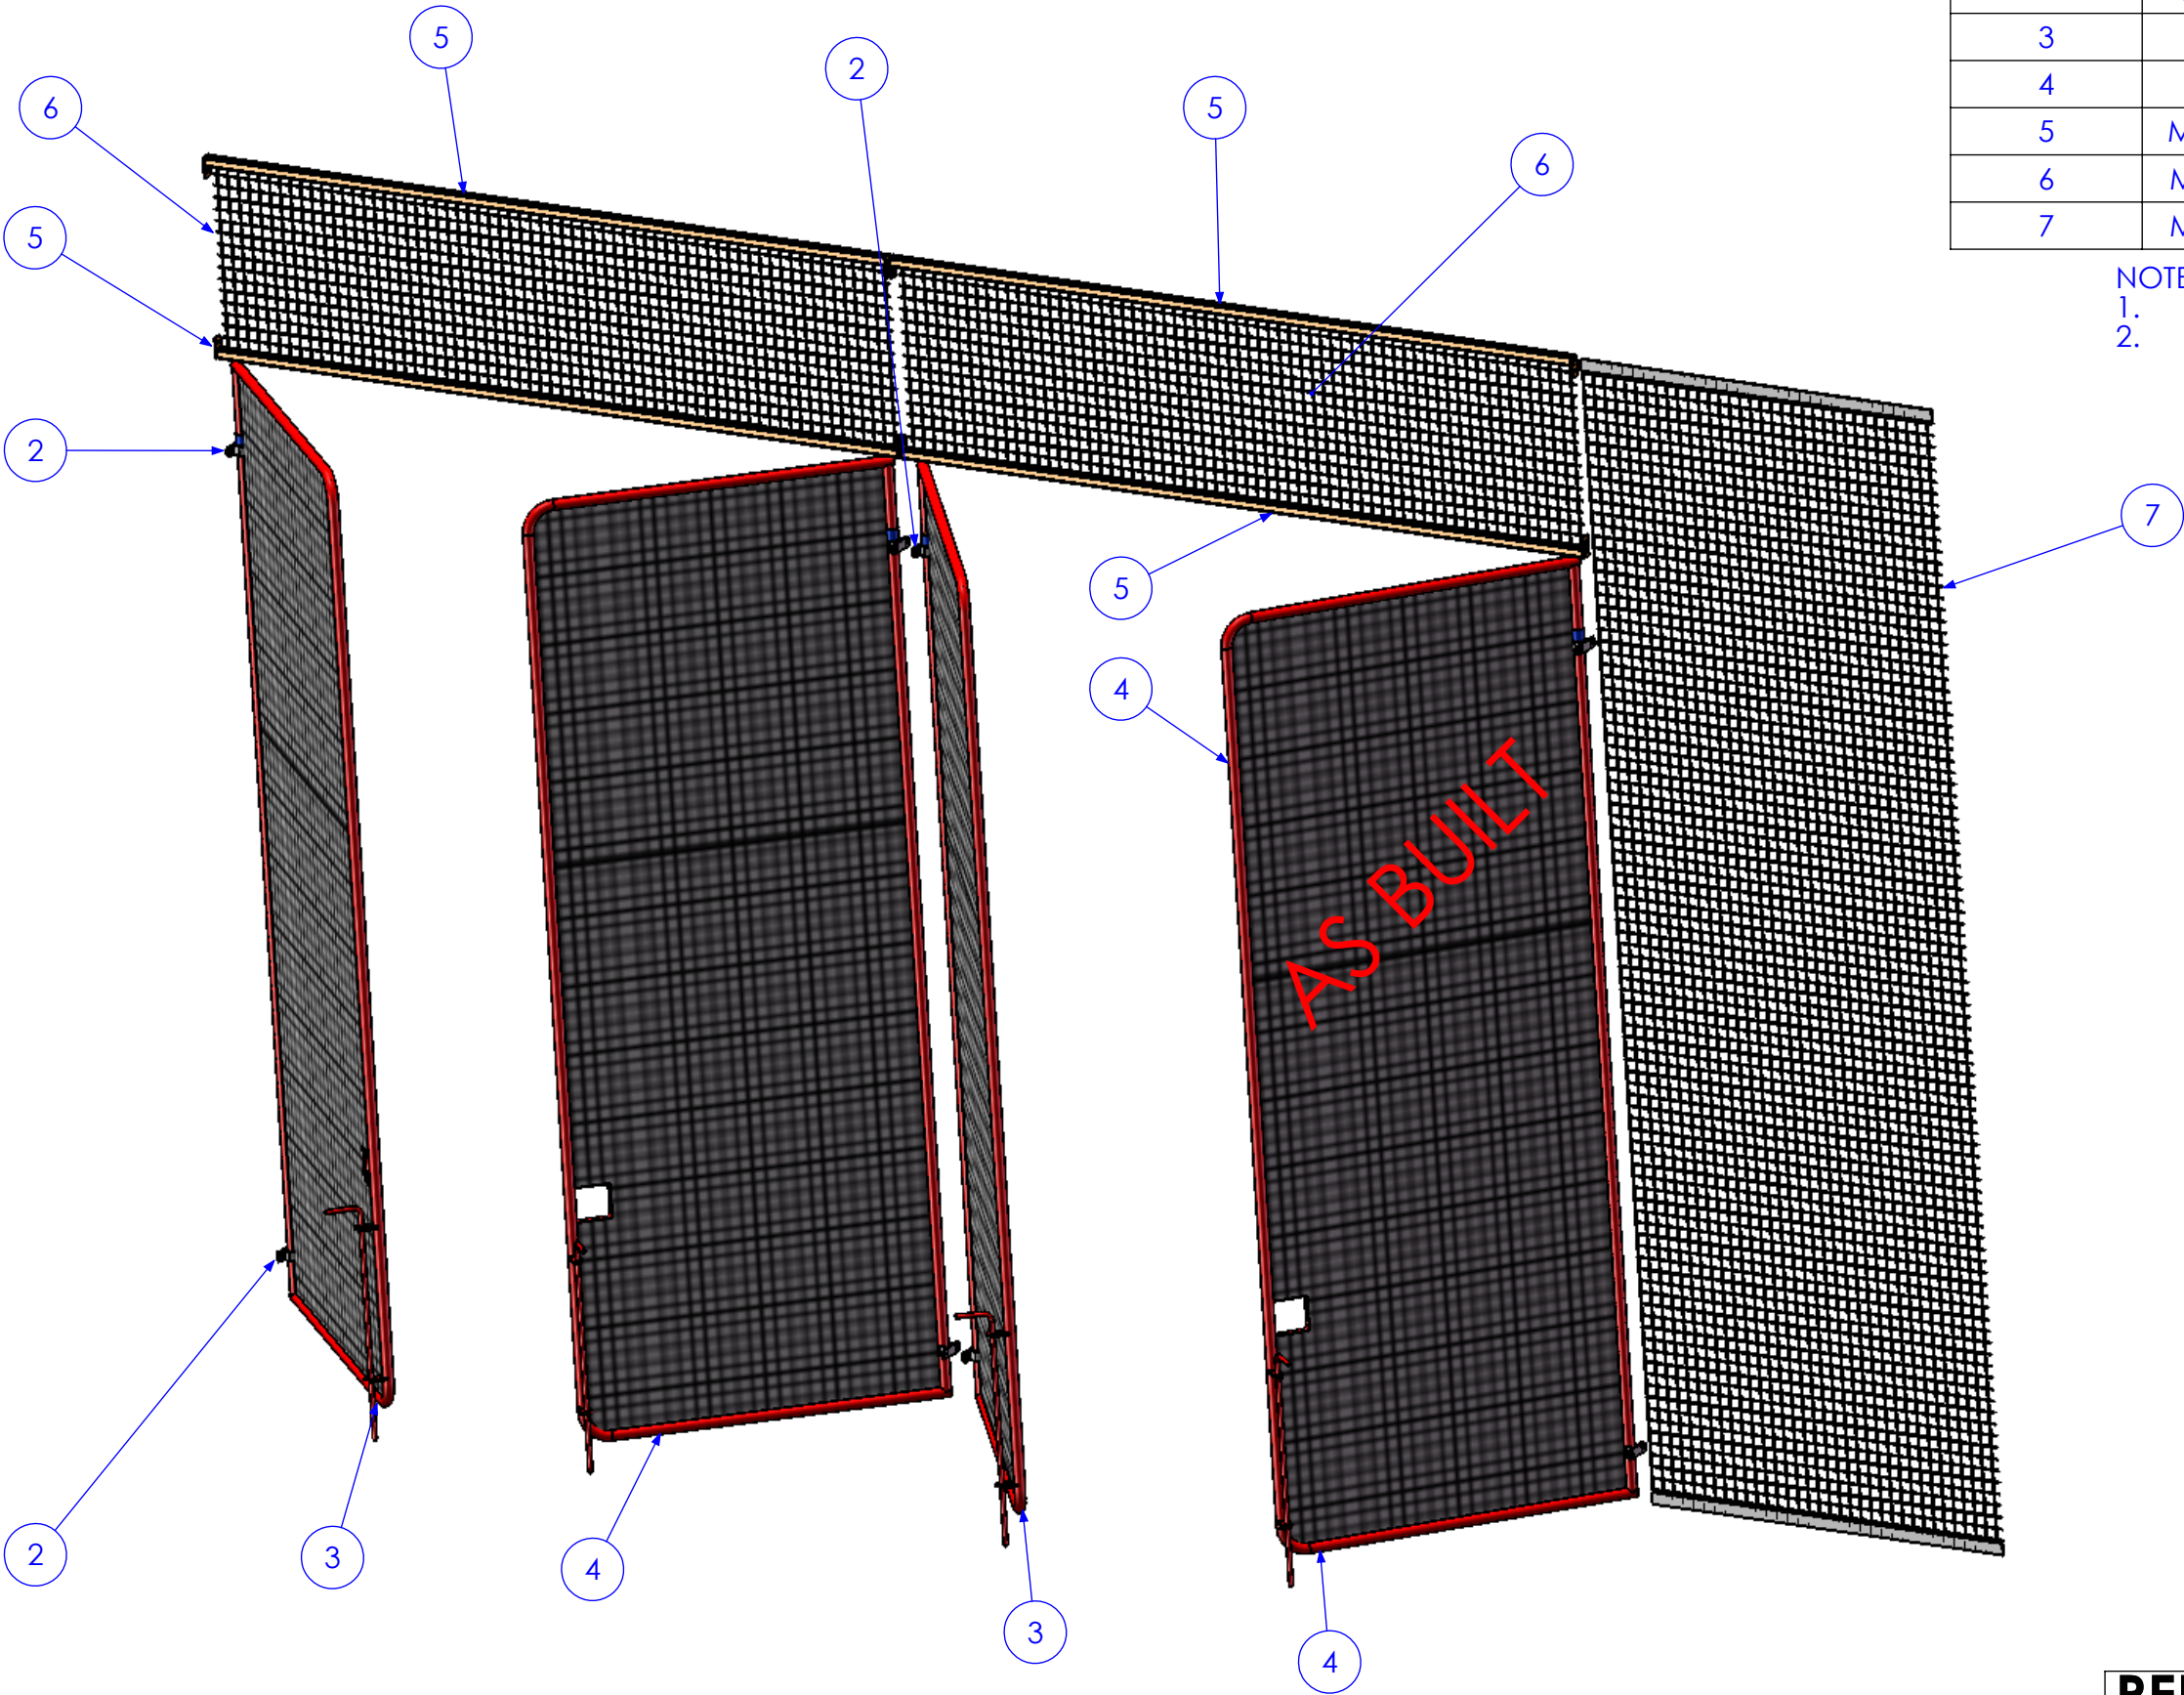

RELEASED FOR MANUFACTURE


01	INITIAL ISSUE	7/01/2013	SDB
02	AS BUILT DRGS	28/06/2013	SDB
03	AMMENDMENT	DATE	AMMENDED BY

Q:\Pulse Id TMS1177 REVISIONS

FINISH REQUIREMENTS-	GALVANISED	APPROX. MASS: kg	DO NOT SCALE IF IN DOUBT - ASK	JOB NUMBER: 5248	QTY: 1
PROPRIETARY NOTICE THIS DRAWING IS THE PROPERTY OF AUSFAB CONSTRUCTIONS. COPYRIGHT IS RESERVED. THIS DRAWING MAY NOT BE COPIED OR USED IN ANY MANNER EXCEPT AS AGREED TO BY AUSFAB CONSTRUCTIONS. THE DRAWINGS, IDEAS & INVENTIONS SHOWN SHALL NOT BE DISCLOSED TO OTHER PARTIES.	 40 Kenilworth Street, Warwick, Queensland, Australia 4011 Phone: 1300 995 970 Fax: 1300 998 983 15/05/2015	DRAWING NOTES: ALL WELDING TO BE IN ACCORDANCE WITH AS1554 PART 1. FOR UNTOLERANCED DIMENSIONS THE FOLLOWING LIMITS SHALL APPLY: FABRICATION ± 2.0mm MACHINING ± 0.25mm	SCALE: 1:25 UNO DRAWN: SB 7/01/13 CHECK: EG/NW 7/01/13 APPROVED: - -	DESCRIPTION: LAIDLEY MF GATES AND MESH SECTIONS DRAWING No. 5248-H-A1-A3	AS1100 THIRD ANGLE PROJECTION A3 SHEET 1 of 5 REV 02 PURPOSE OF DRAWING FABRICATION


ITEM NO.	QTY.	DESCRIPTION	LENGTH
1	1	42.40x2 CHS	4000
2	1	42.40x2 CHS	6967.98
3	1	DIA 16 RB	1137.12
4	2	DIA 12 RB	461.17
5	1	48.30x2.30 CHS	50
6	2	40x10 FL	89.17
7	1	50X50X4 GAL MESH	3957.60 X 1467.60

SEE NOTE ON SHEET 1
REGARDING GATE 2

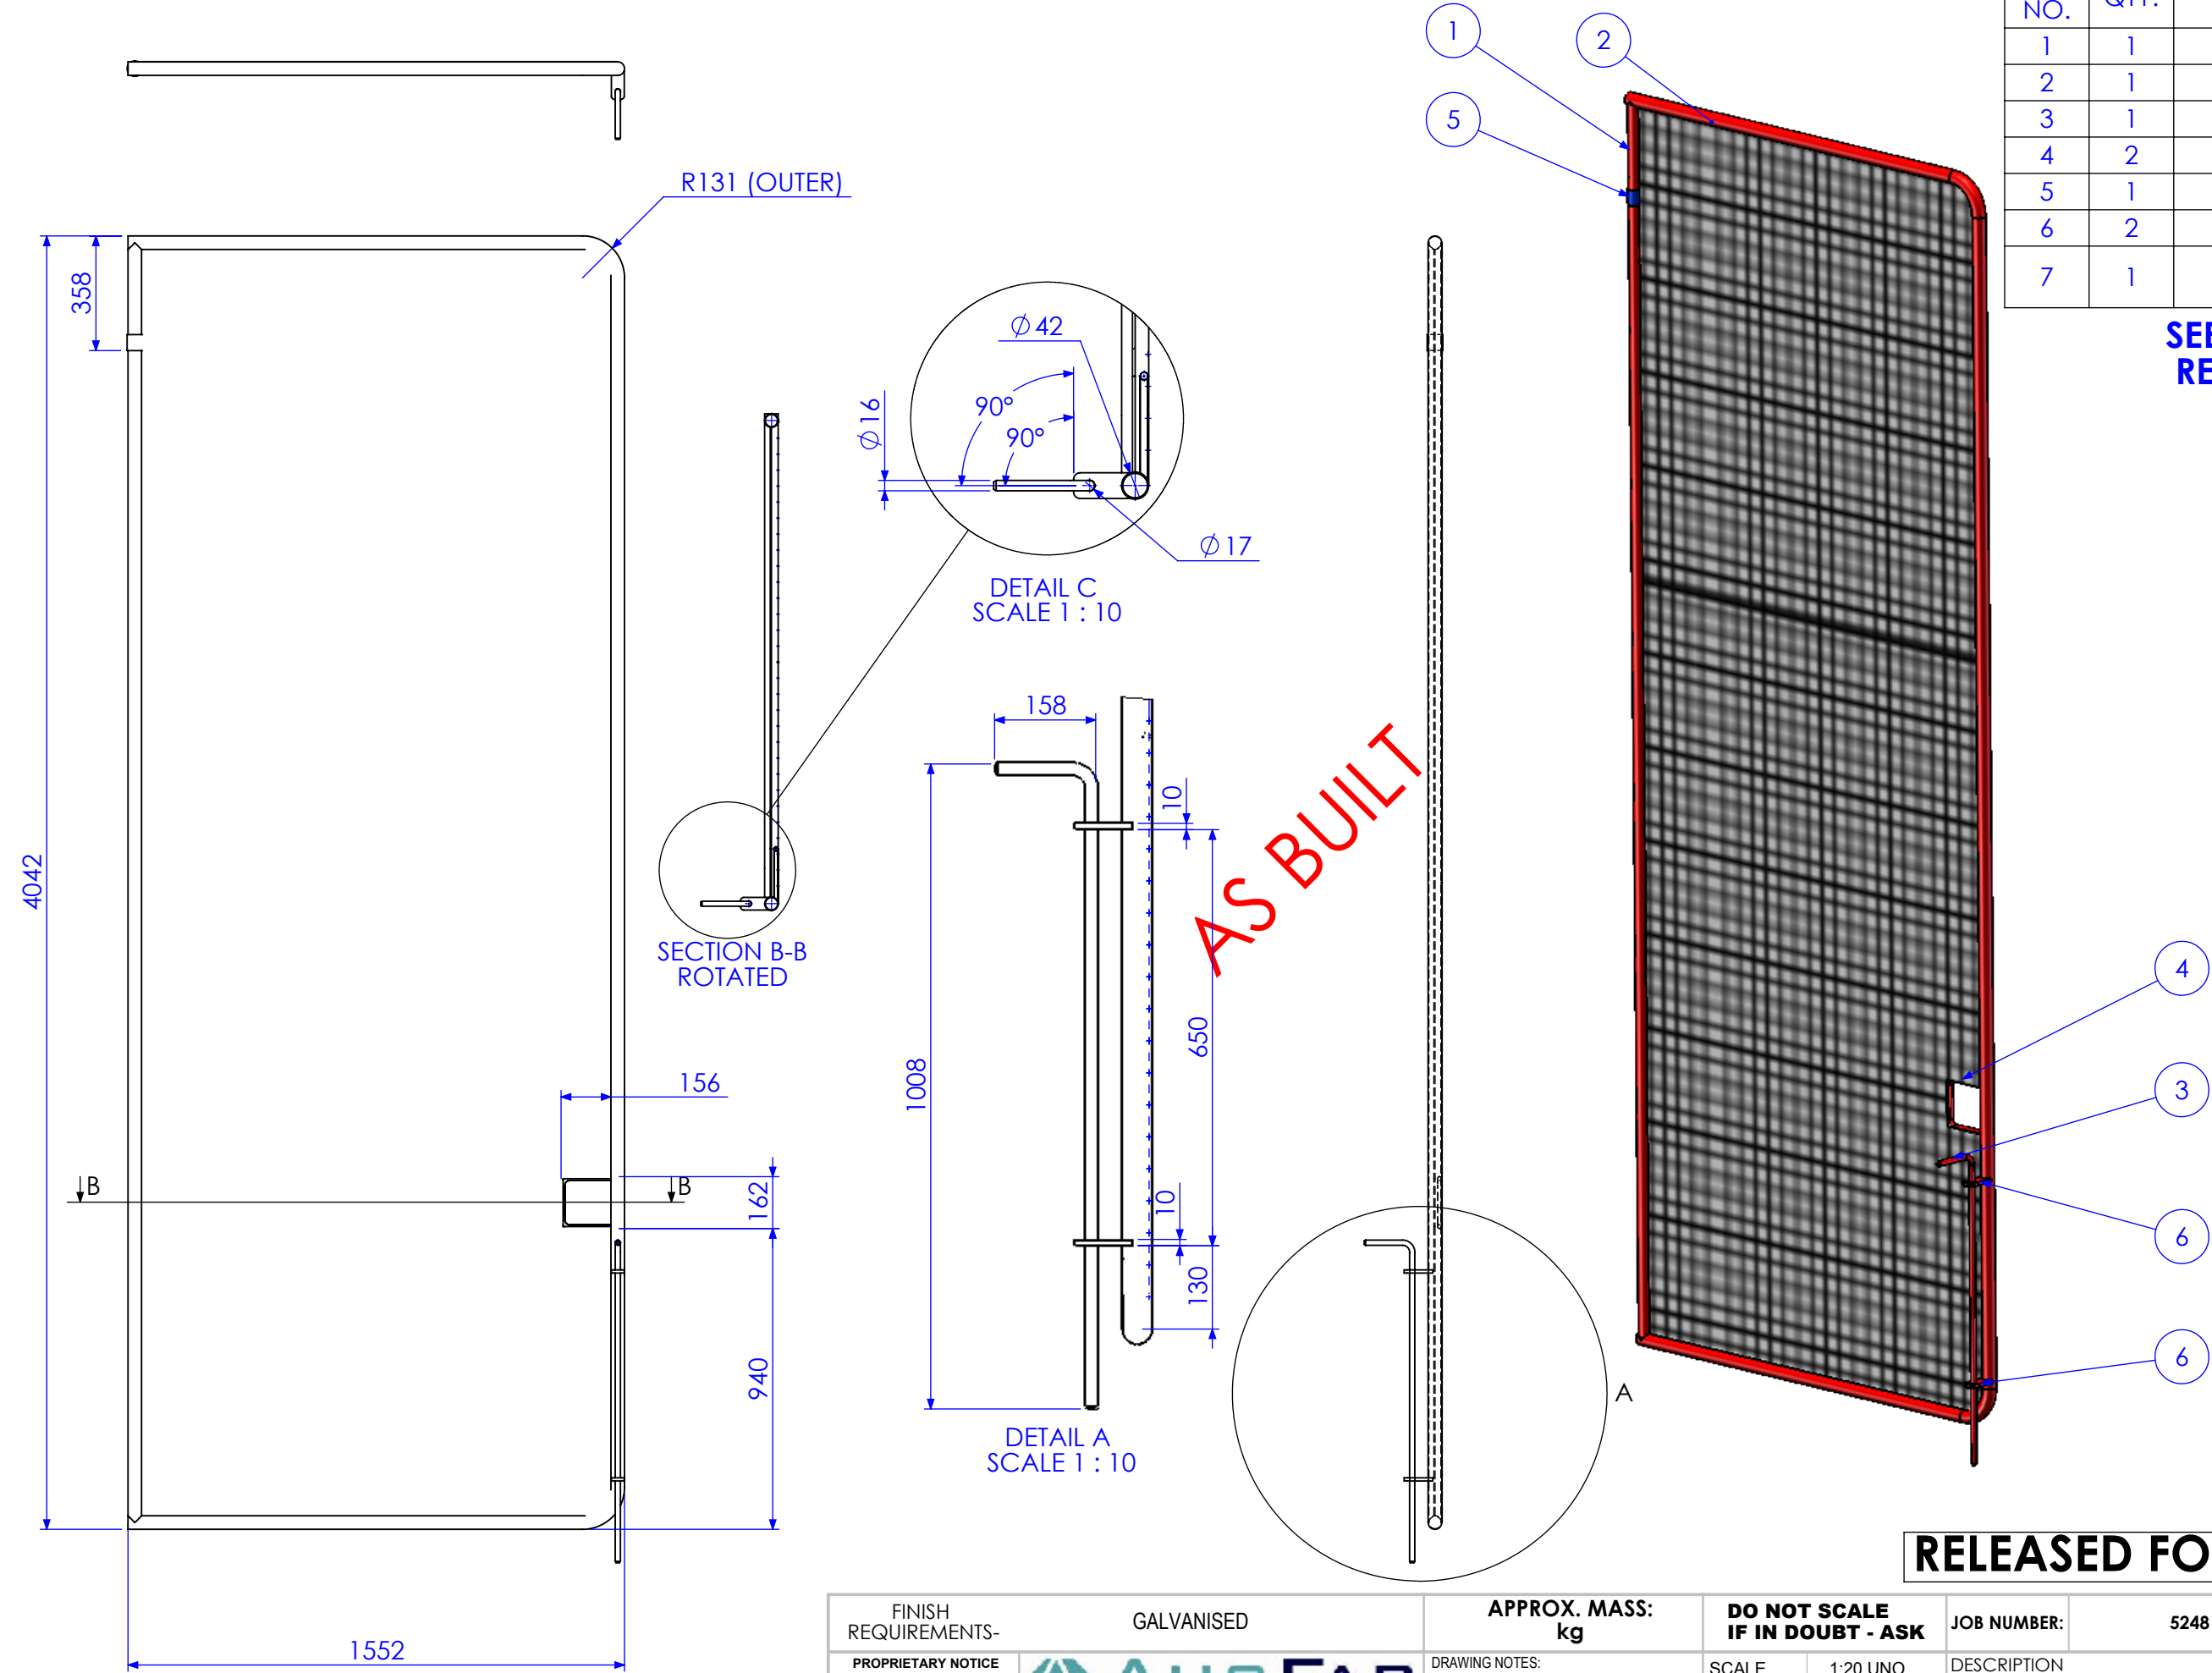


RELEASED FOR MANUFACTURE

01	INITIAL ISSUE	7/01/2013	SDB
02	AS BUILT DRGS	28/06/2013	SDB
REV	AMMENDMENT	DATE	AMMENDED BY
REVISIONS			


FINISH REQUIREMENTS-		GALVANISED		APPROX. MASS: kg		DO NOT SCALE IF IN DOUBT - ASK		JOB NUMBER:		5248		QTY: 2	
<div>PROPRIETARY NOTICE</div> <div>THIS DRAWING IS THE PROPERTY OF AUSFAB CONSTRUCTIONS. COPYRIGHT IS RESERVED. THIS DRAWING MAY NOT BE COPIED OR USED IN ANY MANNER EXCEPT AS AGREED TO BY AUSFAB CONSTRUCTIONS. THE DRAWINGS, IDEAS & INVENTIONS SHOWN SHALL NOT BE DISCLOSED TO OTHER PARTIES.</div>		<div> AUSFAB CONSTRUCTIONS</div> <div>40 Kenilworth Street, Warwick, Queensland, Australia 4011 Phone: 1300 995 970 Fax: 1300 998 983 15/05/2015</div>		<div>DRAWING NOTES:</div> <div>ALL WELDING TO BE IN ACCORDANCE WITH AS1554 PART 1. FOR UNTOLERANCED DIMENSIONS THE FOLLOWING LIMITS SHALL APPLY: FABRICATION ± 2.0mm MACHINING ± 0.25mm</div>		<div>SCALE</div> <div>1:20 UNO</div> <div>DRAWN</div> <div>SB 7/01/13</div> <div>CHECK</div> <div>EG/NW 7/01/13</div> <div>APPROVED</div> <div>- -</div>		<div>DESCRIPTION</div> <div>GATE 1</div> <div>DRAWING No.</div> <div>5248-H-A1-A3-P3A</div>		<div>AS1100 THIRD ANGLE PROJECTION</div> <div>A3</div> <div>SHEET 2 of 5</div> <div>REV 02</div> <div>PURPOSE OF DRAWING FABRICATION</div>			
<div>Page 168 of 172</div>													

ITEM NO.	QTY.	DESCRIPTION	LENGTH
1	1	40x40x3 SHS	3264.5
2	2	40x5 FL	90

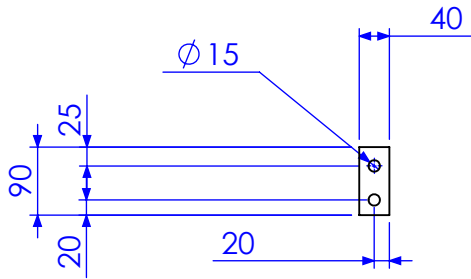

PACKERS REQUIRED
1. QTY 8 IN 2MM
2. QTY 8 IN 3MM
3. QTY 8 IN 5MM

AS BUILT

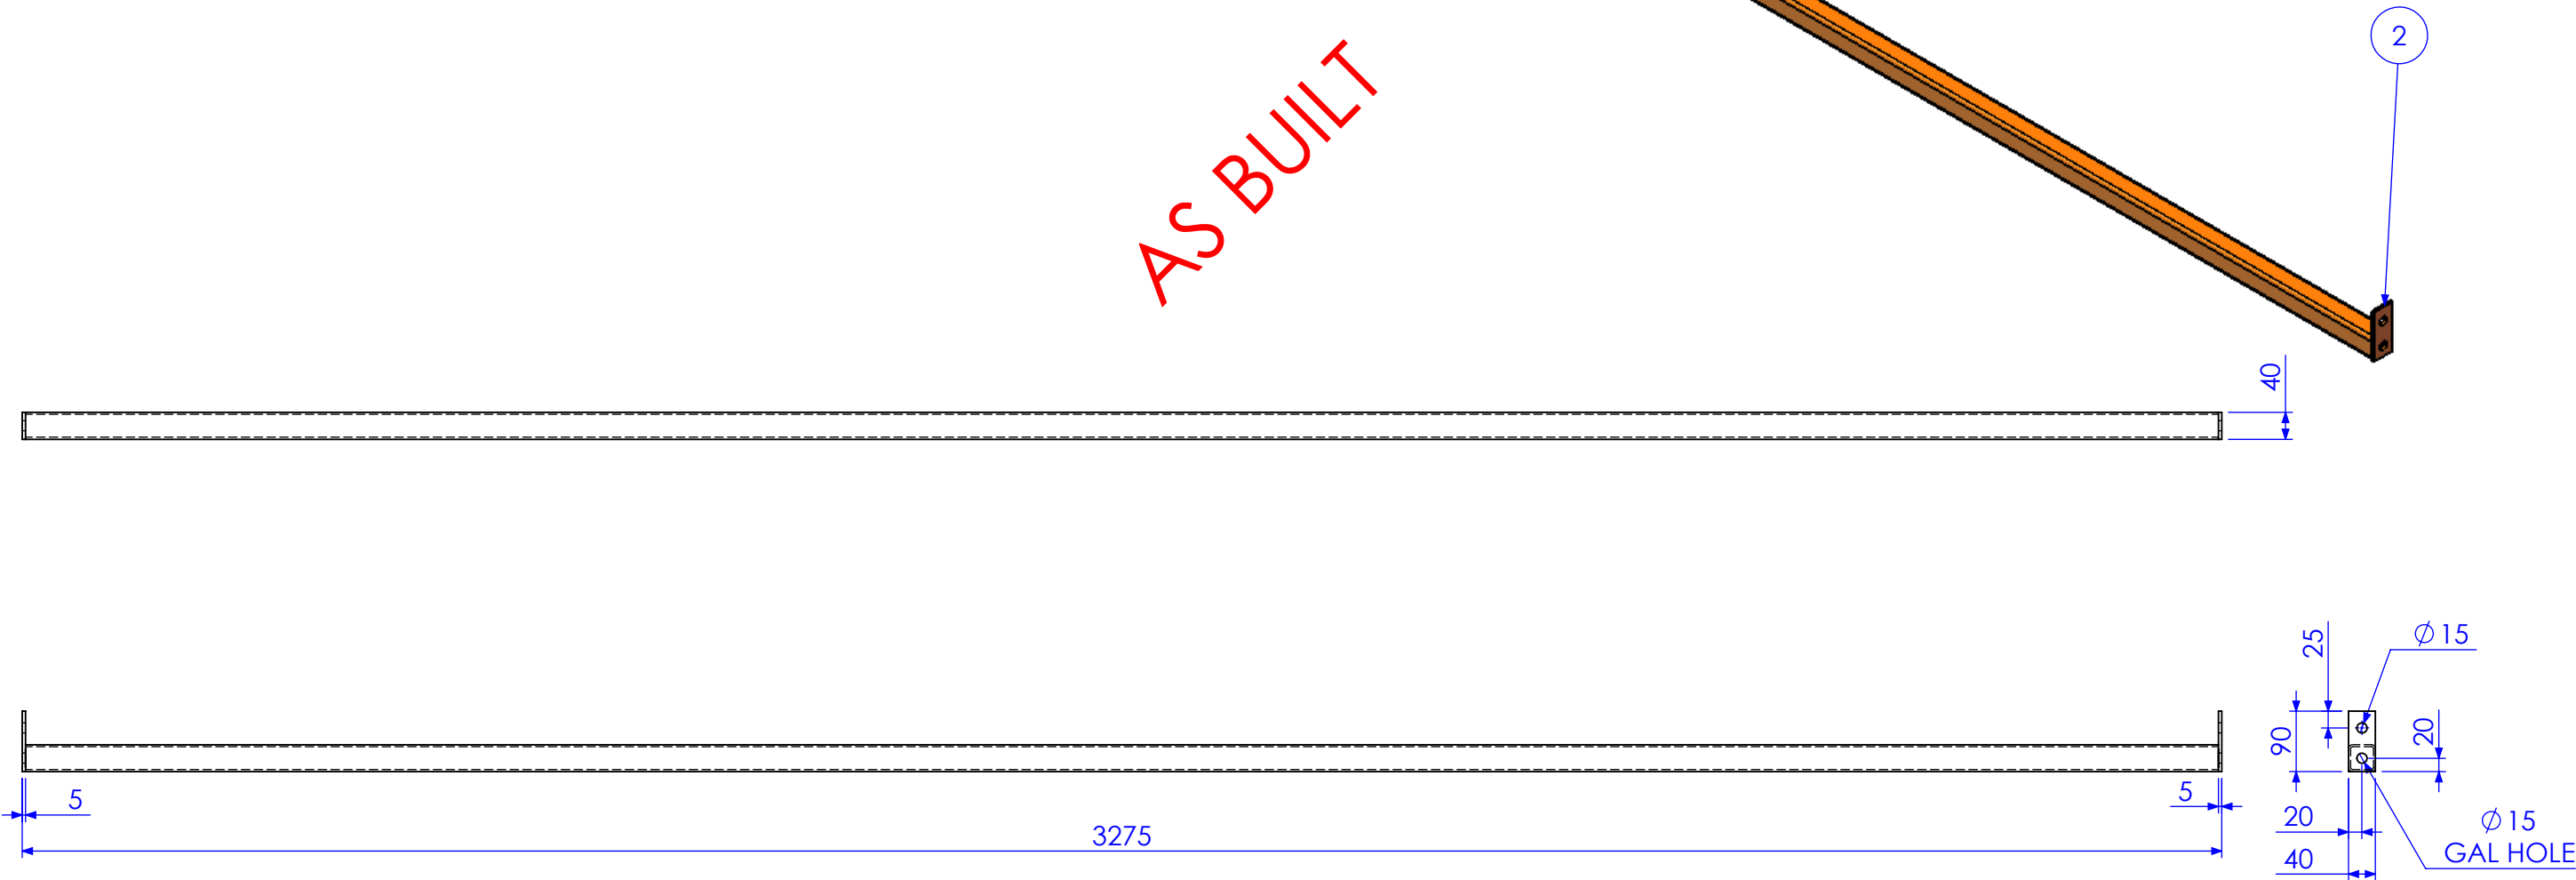


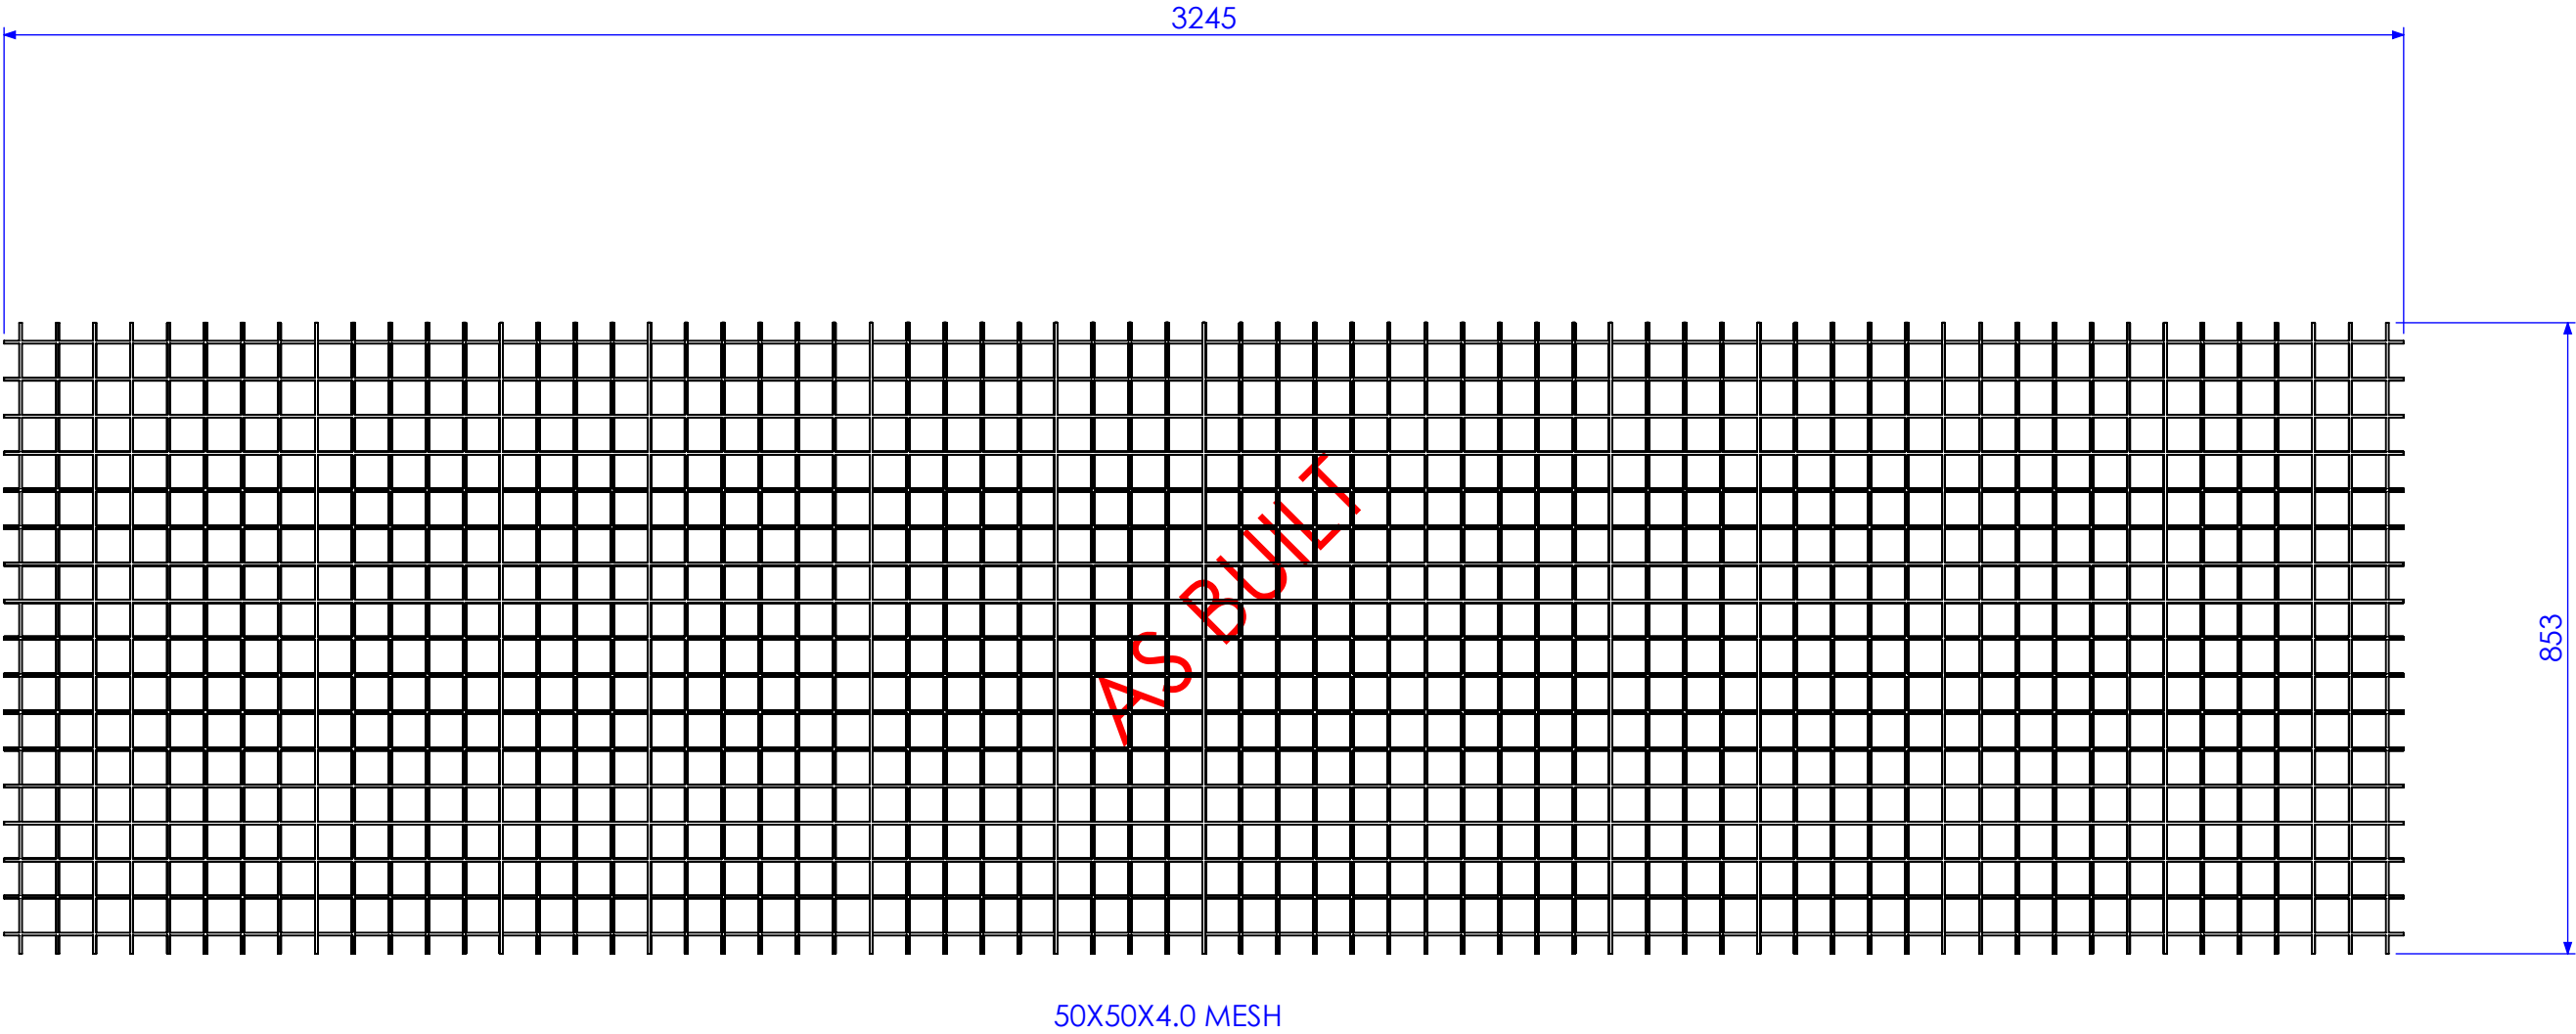
RELEASED FOR MANUFACTURE

01	INITIAL ISSUE	7/01/2013	SDB
02	AS BUILT DRGS	28/06/2013	SDB
03	AMMENDMENT	DATE	AMMENDED BY

QIP Use Id TMS1177

REVISIONS


FINISH REQUIREMENTS-	GALVANISED	APPROX. MASS: kg	DO NOT SCALE IF IN DOUBT - ASK	JOB NUMBER: 5248	QTY: 4
PROPRIETARY NOTICE THIS DRAWING IS THE PROPERTY OF AUSFAB CONSTRUCTIONS. COPYRIGHT IS RESERVED. THIS DRAWING MAY NOT BE COPIED OR USED IN ANY MANNER EXCEPT AS AGREED TO BY AUSFAB CONSTRUCTIONS. THE DRAWINGS, IDEAS & INVENTIONS SHOWN SHALL NOT BE DISCLOSED TO OTHER PARTIES.	 40 Kenilworth Street, Warwick, Queensland, Australia 4011 Phone: 1300 995 970 Fax: 1300 998 983 15/05/2015	DRAWING NOTES: ALL WELDING TO BE IN ACCORDANCE WITH AS1554 PART 1. FOR UNTOLERANCED DIMENSIONS THE FOLLOWING LIMITS SHALL APPLY: FABRICATION ± 2.0mm MACHINING ± 0.25mm	SCALE: 1:10 UNO DRAWN: SB 7/01/13 CHECK: EG/NW 7/01/13 APPROVED: - -	DESCRIPTION: MESH SUPPORT 1 DRAWING No. 5248-H-A1-A3-P2	AS1100 THIRD ANGLE PROJECTION SHEET 3 of 5 REV 02 PURPOSE OF DRAWING: FABRICATION




REQUIREMENT TO JOIN AT THE 3M MARK

RELEASED FOR MANUFACTURE

01	INITIAL ISSUE	7/01/2013	SDB
02	AS BUILT DRGS	28/06/2013	SDB
REV	AMMENDMENT	DATE	AMMENDED BY
Q-Pulse Id TMS1177			
REVISIONS			

FINISH REQUIREMENTS-		GALVANISED		APPROX. MASS: kg		DO NOT SCALE IF IN DOUBT - ASK		JOB NUMBER:	5248	QTY: 2	
PROPRIETARY NOTICE THIS DRAWING IS THE PROPERTY OF AUSFAB CONSTRUCTIONS. COPYRIGHT IS RESERVED. THIS DRAWING MAY NOT BE COPIED OR USED IN ANY MANNER EXCEPT AS AGREED TO BY AUSFAB CONSTRUCTIONS. THE DRAWINGS, IDEAS & INVENTIONS SHOWN SHALL NOT BE DISCLOSED TO OTHER PARTIES.		 40 Kenilworth Street, Warwick, Queensland, Australia 4011 Phone: 1300 995 970 Fax: 1300 998 983 15/05/2015		DRAWING NOTES: ALL WELDING TO BE IN ACCORDANCE WITH AS1554 PART 1. FOR UNTOLERANCED DIMENSIONS THE FOLLOWING LIMITS SHALL APPLY: FABRICATION ± 2.0mm MACHINING ± 0.25mm		SCALE	1:10 UNO	DESCRIPTION MESH SECTION 1		AS1100 THIRD ANGLE PROJECTION A3	
						DRAWN	SB 7/01/13			SHEET 4 of 5 REV 02	
						CHECK	EG/NW 7/01/13			PURPOSE OF DRAWING FABRICATION	
						APPROVED	- -	DRAWING No.	5248-H-A1-A3-P6	Page 170 of 172	

ITEM NO.	DESCRIPTION
1	50X50X4 GAL MESH
2	50x6 FL

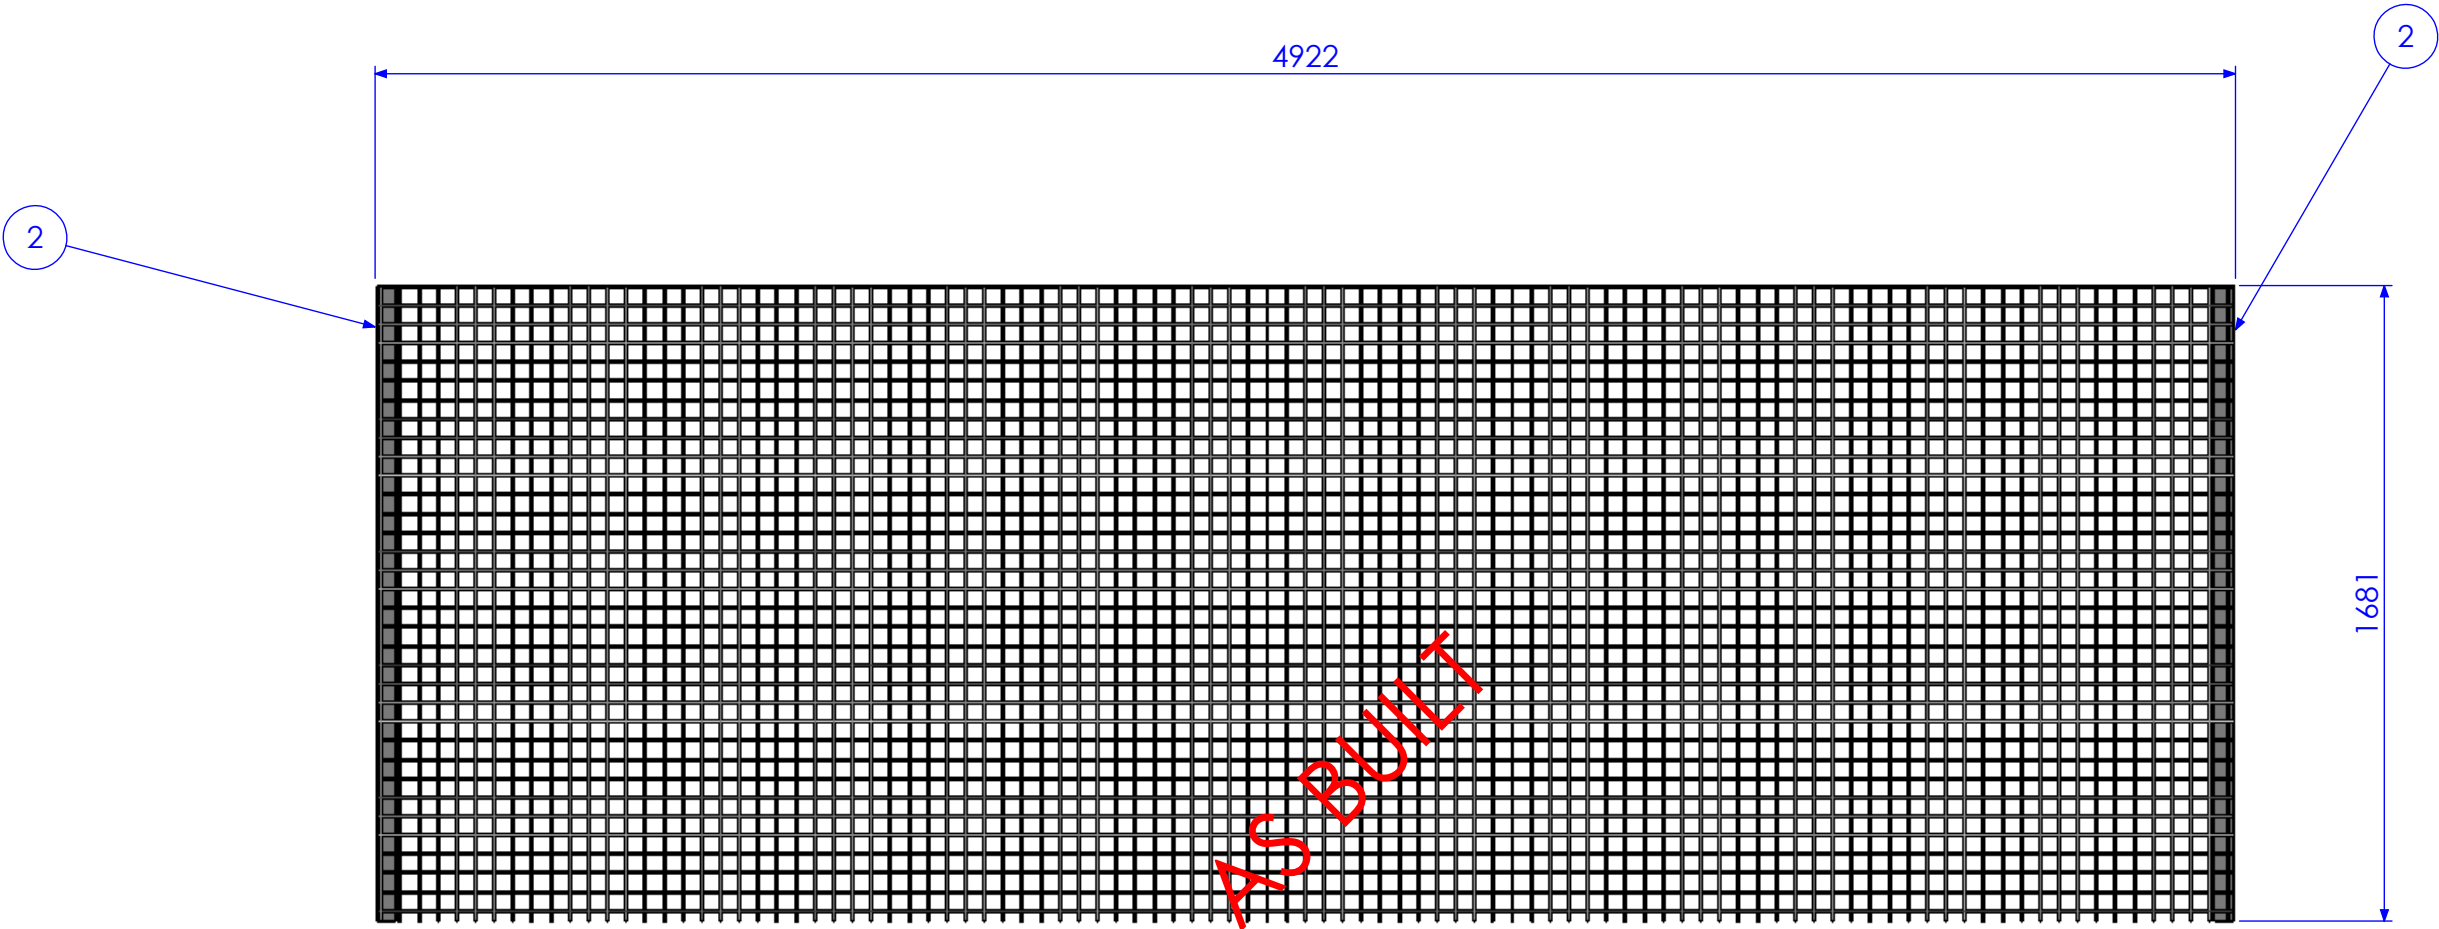


50X50X4.0 MESH

REQUIREMENT TO JOIN AT THE 3M MARK

RELEASED FOR MANUFACTURE

01	INITIAL ISSUE	7/01/2013	SDB
02	AS BUILT DRGS	28/06/2013	SDB
REV	AMMENDMENT	DATE	AMMENDED BY
Revisions			

Q:\Pulse Id TMS1177

FINISH REQUIREMENTS-		GALVANISED		APPROX. MASS: kg		DO NOT SCALE IF IN DOUBT - ASK		JOB NUMBER:	5248	QTY: 1
PROPRIETARY NOTICE THIS DRAWING IS THE PROPERTY OF AUSFAB CONSTRUCTIONS. COPYRIGHT IS RESERVED. THIS DRAWING MAY NOT BE COPIED OR USED IN ANY MANNER EXCEPT AS AGREED TO BY AUSFAB CONSTRUCTIONS. THE DRAWINGS, IDEAS & INVENTIONS SHOWN SHALL NOT BE DISCLOSED TO OTHER PARTIES.		 40 Kenilworth Street, Warwick, Queensland, Australia 4011 Phone: 1300 995 970 Fax: 1300 998 983 15/05/2015		DRAWING NOTES: ALL WELDING TO BE IN ACCORDANCE WITH AS1554 PART 1. FOR UNTOLERANCED DIMENSIONS THE FOLLOWING LIMITS SHALL APPLY: FABRICATION ± 2.0mm MACHINING ± 0.25mm		SCALE	1:20 UNO	DESCRIPTION MESH SECTION 2		
						DRAWN	SB 7/01/13			
						CHECK	EG/NW 7/01/13			
						APPROVED	- -	DRAWING No.	5248-H-A1-A3-P7	PURPOSE OF DRAWING FABRICATION

