



**25 Bunya Street**

**Eagle Farm Q**

**4009**

**Ph. (07) 3403 8888**

**Fx. (07) 3403 1898**

15th August.2002

OPERATING MANUAL FOR:

# ASHGROVE to THE CITY TRUNK MAIN S2 TRUNK MAINS

## CATHODIC PROTECTION SYSTEM

CLIENT:

BRISBANE WATER  
WATER SYSTEM SERVICES

## MANUAL CONTENTS

(1.0)	Introduction
(2.0)	Corrosion and Cathodic Protection
(3.0)	Mains Details
(4.0)	Cathodic Protection
(4.1)	Type of System
(4.2)	Rectifier
(4.3)	Cathode
(4.4)	Anodes
(4.5)	Test Points
(4.6)	Associated Drawings
(4.7)	Associated Standards
(4.8)	Government Regulations
(5.0)	Performed Testing
(6.0)	Conclusion
(7.0)	Maintenance

## DRAWINGS

486/6/25-AA1C0021E	Standard Rectifier Wiring Diagram
(No Number)	Bimonthly Maintenance Program

## (1.0) **INTRODUCTION**

Steel when immersed or covered in water has a tendency to corrode (or rust) as the oxidized form is more stable than the metal.

Because of this, precaution must be taken to stop or minimize the corrosion reaction to an acceptable level consistent with the design life of the structure. This is normally achieved by the use of protective coatings which control the corrosion reaction by isolating the steel from its surrounding environment.

However, it is not practical to achieve a perfect coating and coating damage will always occur with time. Because of this, corrosion may occur at imperfections in the paint coating, causing further deterioration in the coating as well as loss of metal.

As a result of this, the coating defects must be rectified by periodic maintenance or an additional method of protection used to prevent this deterioration and corrosion occurring. This additional protection is achieved by the cathodic protection system.

## (2.0) **CORROSION AND CATHODIC PROTECTION**

Corrosion is an electrochemical process in that it is accompanied by a flow of electrical current.

Corrosion occurs on the surface of metals at active areas known as anodes, which are electrically continuous with less active or passive areas known as cathodes. The electric current flows from the anode through the electrolyte to the cathode, with the circuit being completed by the electrical continuity between the cathode and anode. In practice anodes and cathodes are generally part of the same metallic surface and individual anodic areas may be small.

In applying cathodic protection an external current is applied to the surface so that the entire surface to be protected acts as a cathode. This involves the use of an auxiliary anode and when the current flow from this anode is sufficient, no part of the structure acts as an anode.

An external source of direct current such as a transformer rectifier is used in conjunction with an anode consisting of material with a very slow corrosion rate.

While it is the flow of current which achieves the cathodic protection of the surface it is impractical to measure these currents over individual anodic areas to determine when cathodic protection has been achieved. However, with the flow of cathodic protection current, the structure becomes more negative with respect to the surrounding electrolyte. Because of this, it is possible to state values of metal/electrolyte potential at which corrosion does not occur. This metal/electrolyte potential is generally measured against a standard reference electrode which allows a reproducible potential at which corrosion does not occur to be quoted.

(3.0)

**MAINS DETAILS**

Size: 1370 mm Dia mild steel cement lined.

Coating: Fibreglass Enamel Coated.

Length: Appox 6.0 Km.

Location: From Valve 664 corner Fletcher Pde and Beatrice St. Bardon to corner Ann and Albert St. City

Construction

Drawings:

486/1/22-CC0024E

Cathodic Protection Standard Switchboard Cabinet

486/1/22-AA1T0001E

Cathodic Protection Test Points

**(4.0) CATHODIC PROTECTION DETAILS**

(4.1) Type of Cathodic Protection: Impressed Current.

(4.2) Rectifier: Standard 20 Volt, 20 amp direct current output enclosed in a stainless steel switchboard. This system has 1 rectifier installed. The rectifier is in McCaskie Park near the corner of Blamey and School Sts. Kelvin Grove and has a 240V supply from Energex Pole No.6939, located in Blamey St.

(4.3) Cathode: The cathode point is located on the 1370 mm dia mains near valve 104, opposite the rectifier at Blamey St. Kelvin Grove. The cathode point is where the cabling from the rectifier is attached to the structure under cathodic protection.

(4.4) Anodes: Four 1500 x 75mm silicone iron anodes were installed approximately 70 metres from the trunk mains, in a vertical bed 4 metres deep, at the rear corner of the park at Blamey St. The anodes are backfilled with cokebreeze thereby improving anode - ground resistance. The anodes are identified by a marker post and label. See layout drawing.

(4.5) Test Points: Test points are installed on cathodically protected structures to enable testing to ensure full protection of the mains. On these mains thirteen test points have been installed on the trunk main which can be identified from the layout drawing.

(4.6) Associated Drawings:  
 Cathodic Protection Test Point Details - 486/1/22-AA1T0001E  
 Standard Rectifier Wiring Diagram - 486/6/25-AA1C0021

(4.7) Associated Standards:  
 AS 3000 1991 Australia Wiring Rules  
 AS 2832.1 1991 Pipes, Cables, Ducts, Guide to Cathodic Protection,  
 Part One.

(4.8) Government Regulations:  
 Queensland Electricity Acts and Regulations.

(5.0) **PERFORMED TESTING**

- (1) Natural Potential Survey.
- (2) Testing of Insulated Flanges, Joints.
- (3) Soil Resistance Testing.
- (4) Current Drain Survey.
- (5) Pipe Coating Anomaly Survey.
- (6) Rectifier Loop Resistance.
- (7) Foreign Structure Interference Survey and Mitigation.
- (8) Final Potential Survey and Commissioning.

(6.0) **CONCLUSION**

Full Cathodic protection has been achieved on this section of trunk mains. The cathodic protection system is registered with the Electrical Safety Office, Department of Mines and Energy, and has approval to operate.

(7.0) **MAINTENANCE**

The cathodic protection system is maintained on a bimonthly basis after commissioning. These checks involve testing rectifier operation and recording of pipe to soil potentials.

15th August, 2002.

Cathodic Protection Unit.

### CPS Bimonthly Maintenance Details.

#### Required:

- 1/ Notify plant operator and/or sign entry logs where necessary.
- 2/ Have appropriate keying.

#### Labour:

One tradesperson, one vehicle. 20 minutes per site.

#### Procedure:

- 1/ Identify installation.
- 2/ Check system for operation.
- 3/ Record voltmeter.
- 4/ Record ammeter.
- 5/ Comments.
- 6/ Log entry.

15th August. 2002.

## Cathodic Protection Unit

### CPS 6 Monthly Maintenance Details.

#### Required:

- 1/ Notify plant operator and/or sign entry logs where necessary.
- 2/ Have appropriate keying.
- 3/ Set of tools. (Electricians)
- 4/ Multimeter.
- 5/ DC clampmeter.
- 6/ Copper sulphate reference cell and leads.
- 7/ Cleaning equipment.
- 8/ Gatic cover lifters.

#### Labour:

One tradesperson electrical, one laborer, one vehicle.  
Two hours per site.

#### Procedure:

- 1/ Identify system.
- 2/ Check system for operation.
- 3/ Record voltmeter.
- 4/ Record ammeter.
- 5/ Record "on" potentials for all test points.
- 6/ Record "instant off" potentials for all test points.
- 7/ Record "off" potentials for all test points.
- 8/ Perform loop resistance and record.
- 9/ Check and record anode string currents.
- 10/ Comments.
- 11/ Log entry.



15th August, 2002.

## Cathodic Protection Unit

### CPS 60 Monthly Maintenance Details.

#### Required:

- 1/ Notify plant operator and/or sign entry logs where necessary.
- 2/ Have appropriate keying.
- 3/ Set of tools. (Electricians)
- 4/ Multimeter.
- 5/ DC clampmeter.
- 6/ Copper sulphate reference cell and leads.
- 7/ Cleaning equipment.
- 8/ Gatic cover lifters.
- 9/ Rectifier load bank.
- 10/ PCS2000 Detection Equipment.

#### Labour:

One tradesperson electrical, one laborer, one vehicle.  
Eight hours per site.

#### Procedure:

- 1/ Identify system.
- 2/ Check system for operation.
- 3/ Record voltmeter.
- 4/ Record ammeter.
- 5/ Record "on" potentials for all test points.
- 6/ Record "instant off" potentials for all test points.
- 7/ Record "off" potentials for all test points.
- 8/ Perform loop resistance and record.
- 9/ Check and record anode string currents.
- 10/ Load test rectifier for 10 minutes.
- 11/ Check all switchboard and testpoint terminals for tightness.
- 12/ Check all switchboard and testpoints are labelled and I.D. tags attached.
- 13/ Check plans are correctly drawn and modify if necessary.
- 14/ Remove and inspect anodes.
- 15/ Recheck all interference (CPS) bleeds.
- 16/ Pipecamp structure if applicable.
- 17/ Apply to reregister system if applicable

# Brisbane Water

## Network Services

### Cathodic Protection System Loop Resistance

Blamey St Rectifier. CPS181

Date: 15th August 2002

Cathodic Protection System:

Ashgrove to The City Trunk Main S2

System Operating Volts:


11


System Operating amps:

3.2

Test Voltage:		Test Current:	
(volts)		(amps)	
11		3	
16		6	
20		8	
25		9.5	

Loop Resistance (ohms)
2.5

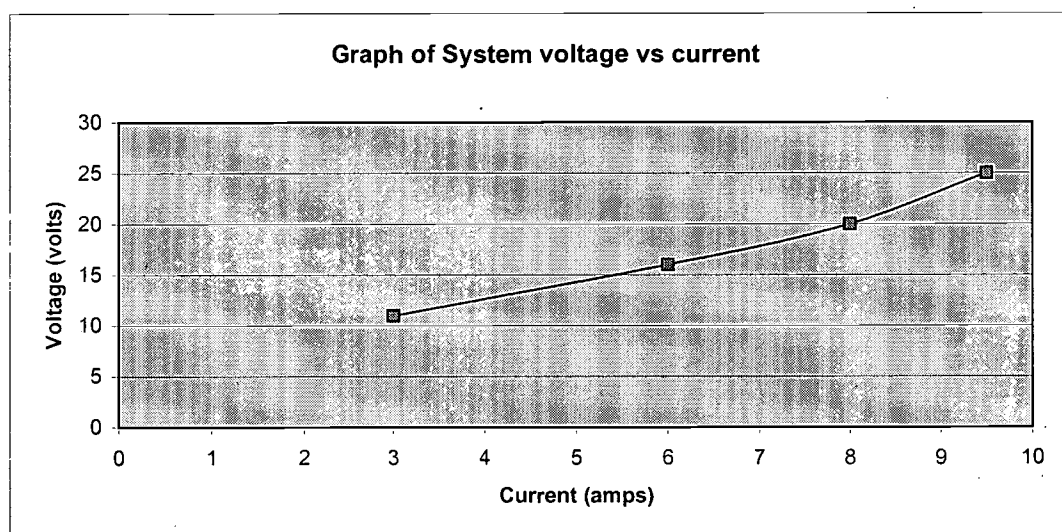

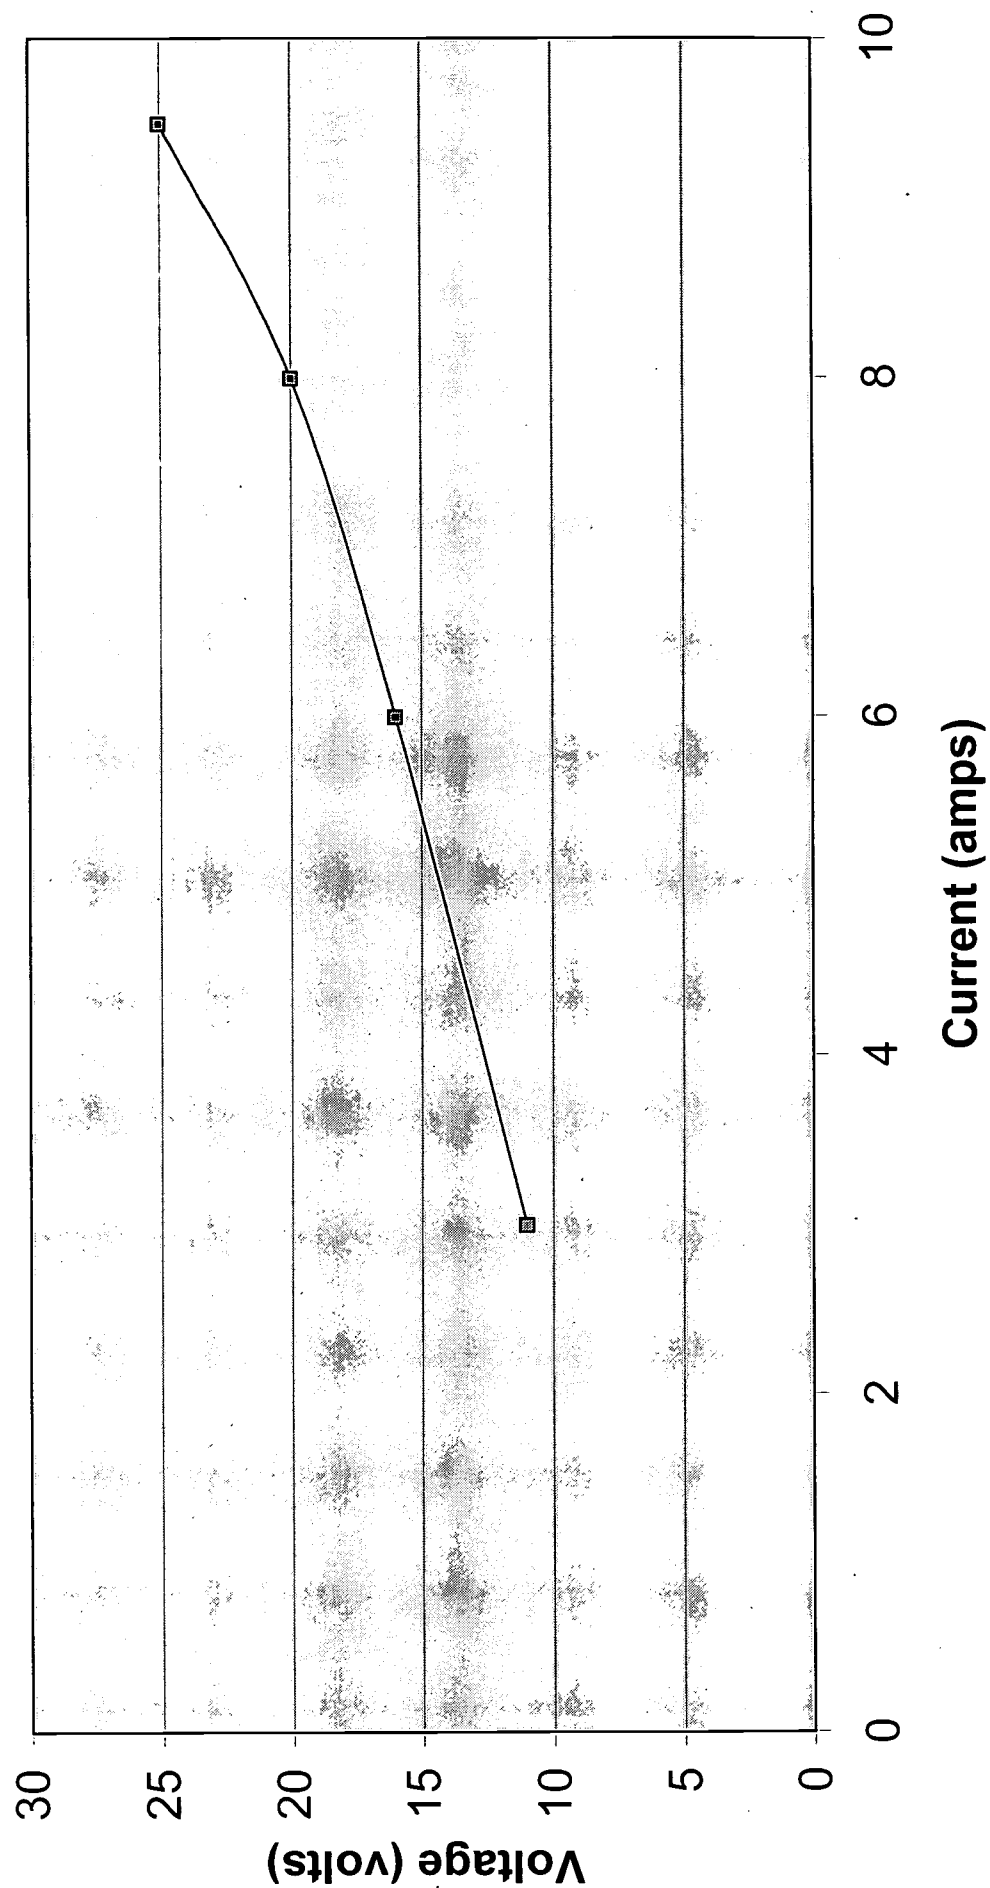
**Graph of System voltage vs current**

**Brisbane Water**

CP Form No. 23


**Network Services****Cathodic Protection System Potential Recording Form****Project** S2 Trunk Main.Ashgrove to the City**Date** 15th August 2002

Test Point number	Distances to T.P. (metres)	Potentials to CuSO4			(mV)
		Natural (mV)	Off (mV)	On (mV)	
1	0	-425	-1120	-1536	-850
2	400	-420	-888	-1153	-850
3	800	-440	-890	-1185	-850
4	1200	-420	-1190	-1320	-850
5	1700	-409	-1140	-1246	-850
6	2100	-330	-876	-1000	-850
7	2700	-566	-1080	-1490	-850
8	3200	-535	-695	-810	-850
9	3500	-514	-1086	-1850	-850
10	4000	-405	-890	-1200	-850
11	4500	-365	-746	-840	-850
12	5100	-544	-790	-860	-850
13	5800	-422	-680	-777	-850
14					

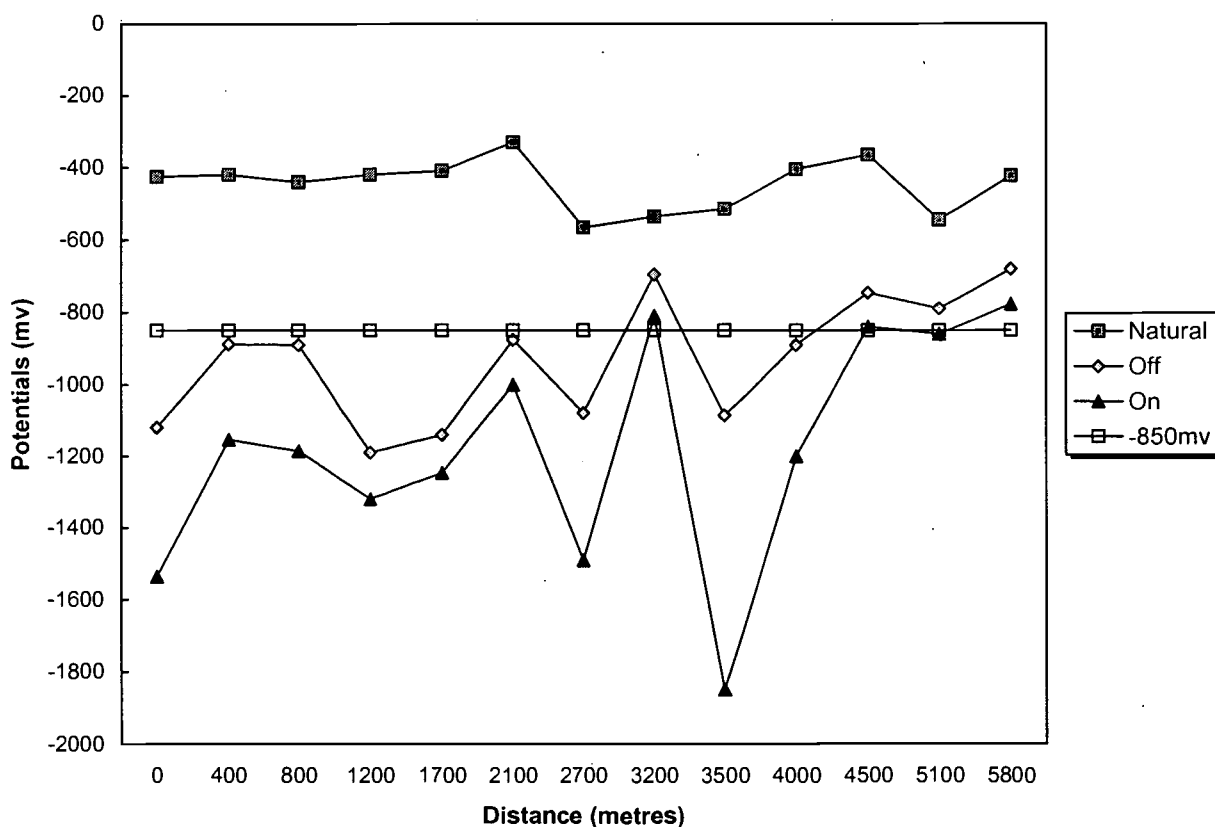**Graph of potentials vs pipelength**

Revision 25/11/2002

Graph of potentials vs pipelength

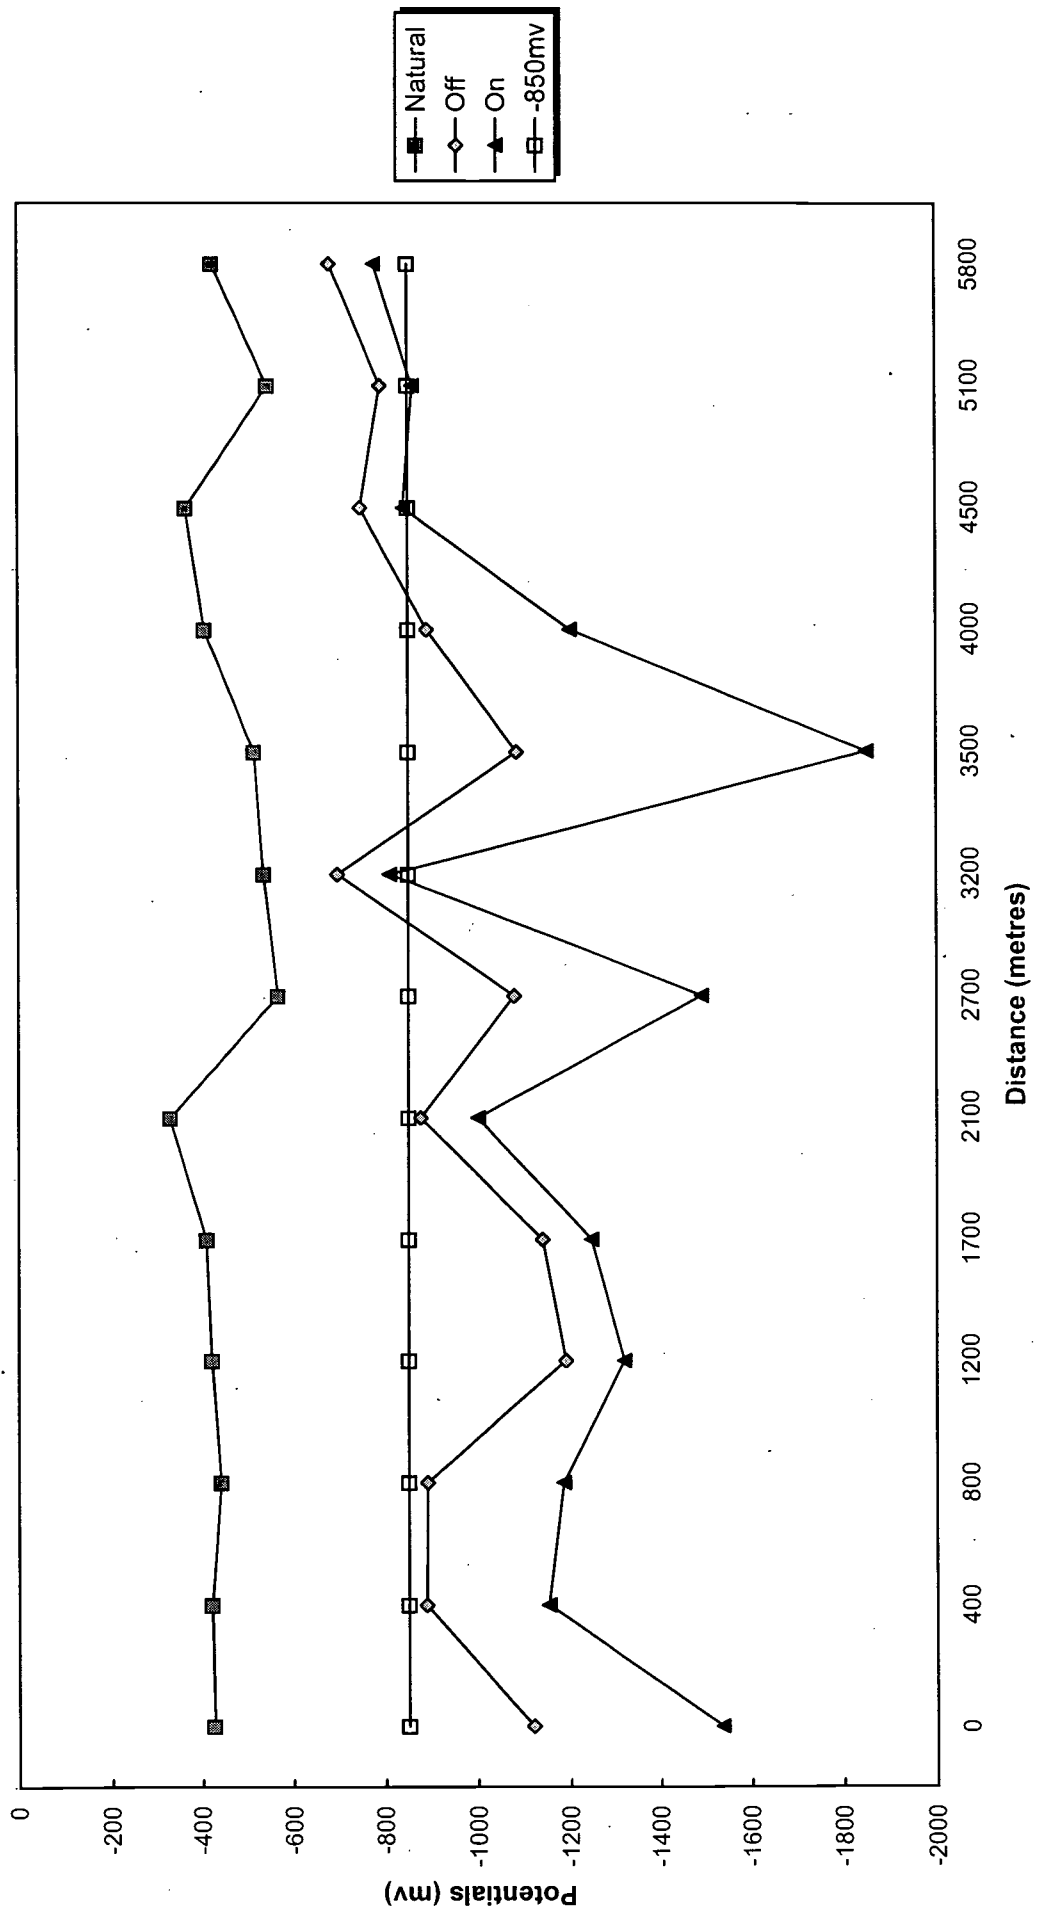


**Brisbane Water**


CP Form No. 23

**Network Services****Cathodic Protection System Resistivities Recording Form****Project** S2 Trunk Main.Ashgrove to the City**Date** 15th August 2002

Test Point number	Distances to T.P.	Resistivities at 2 metres
	(metres)	ohm metres
1	0	62.8
2	400	42.7
3	800	56.5
4	1200	52.7
5	1700	45.2
6	2100	36.4
7	2700	65.3
8	3200	28.8
9	3500	49
10	4000	54
11	4500	20.8
12	5100	38.9
13	5800	47.7
14		

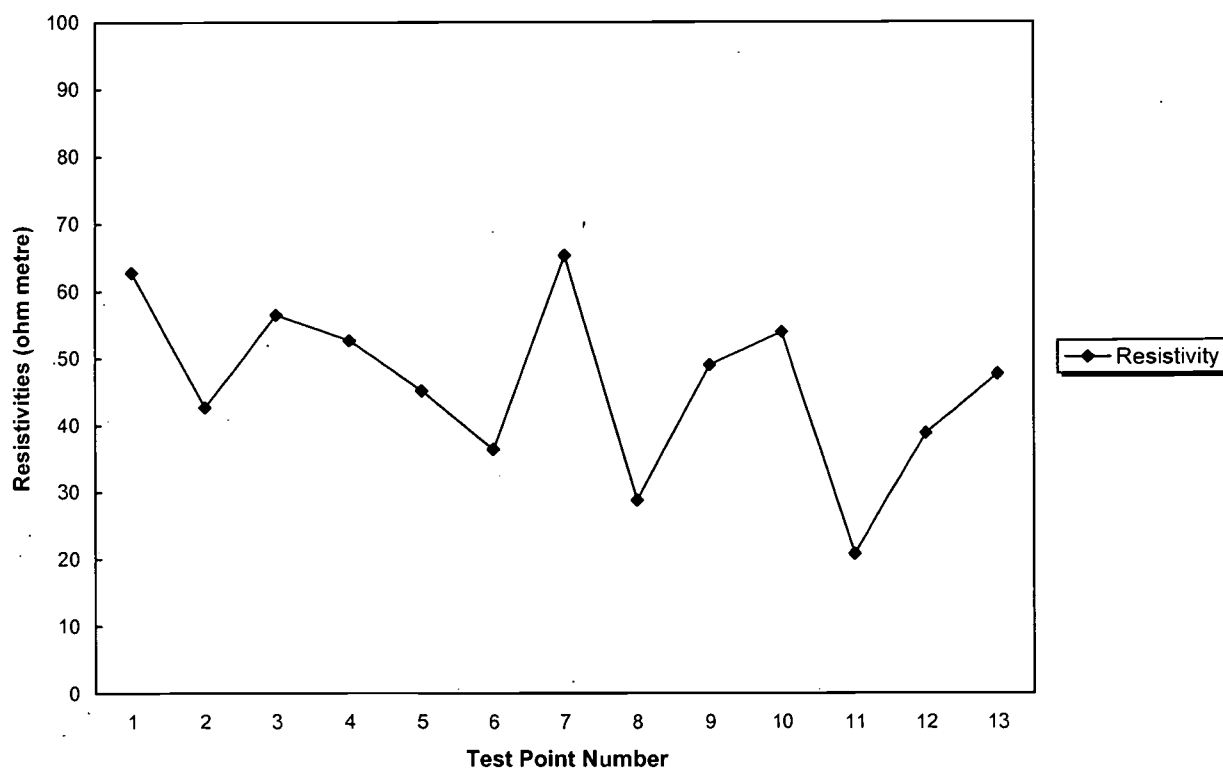**Graph of resistivities vs pipelength**

Graph of resistivities vs pipelength

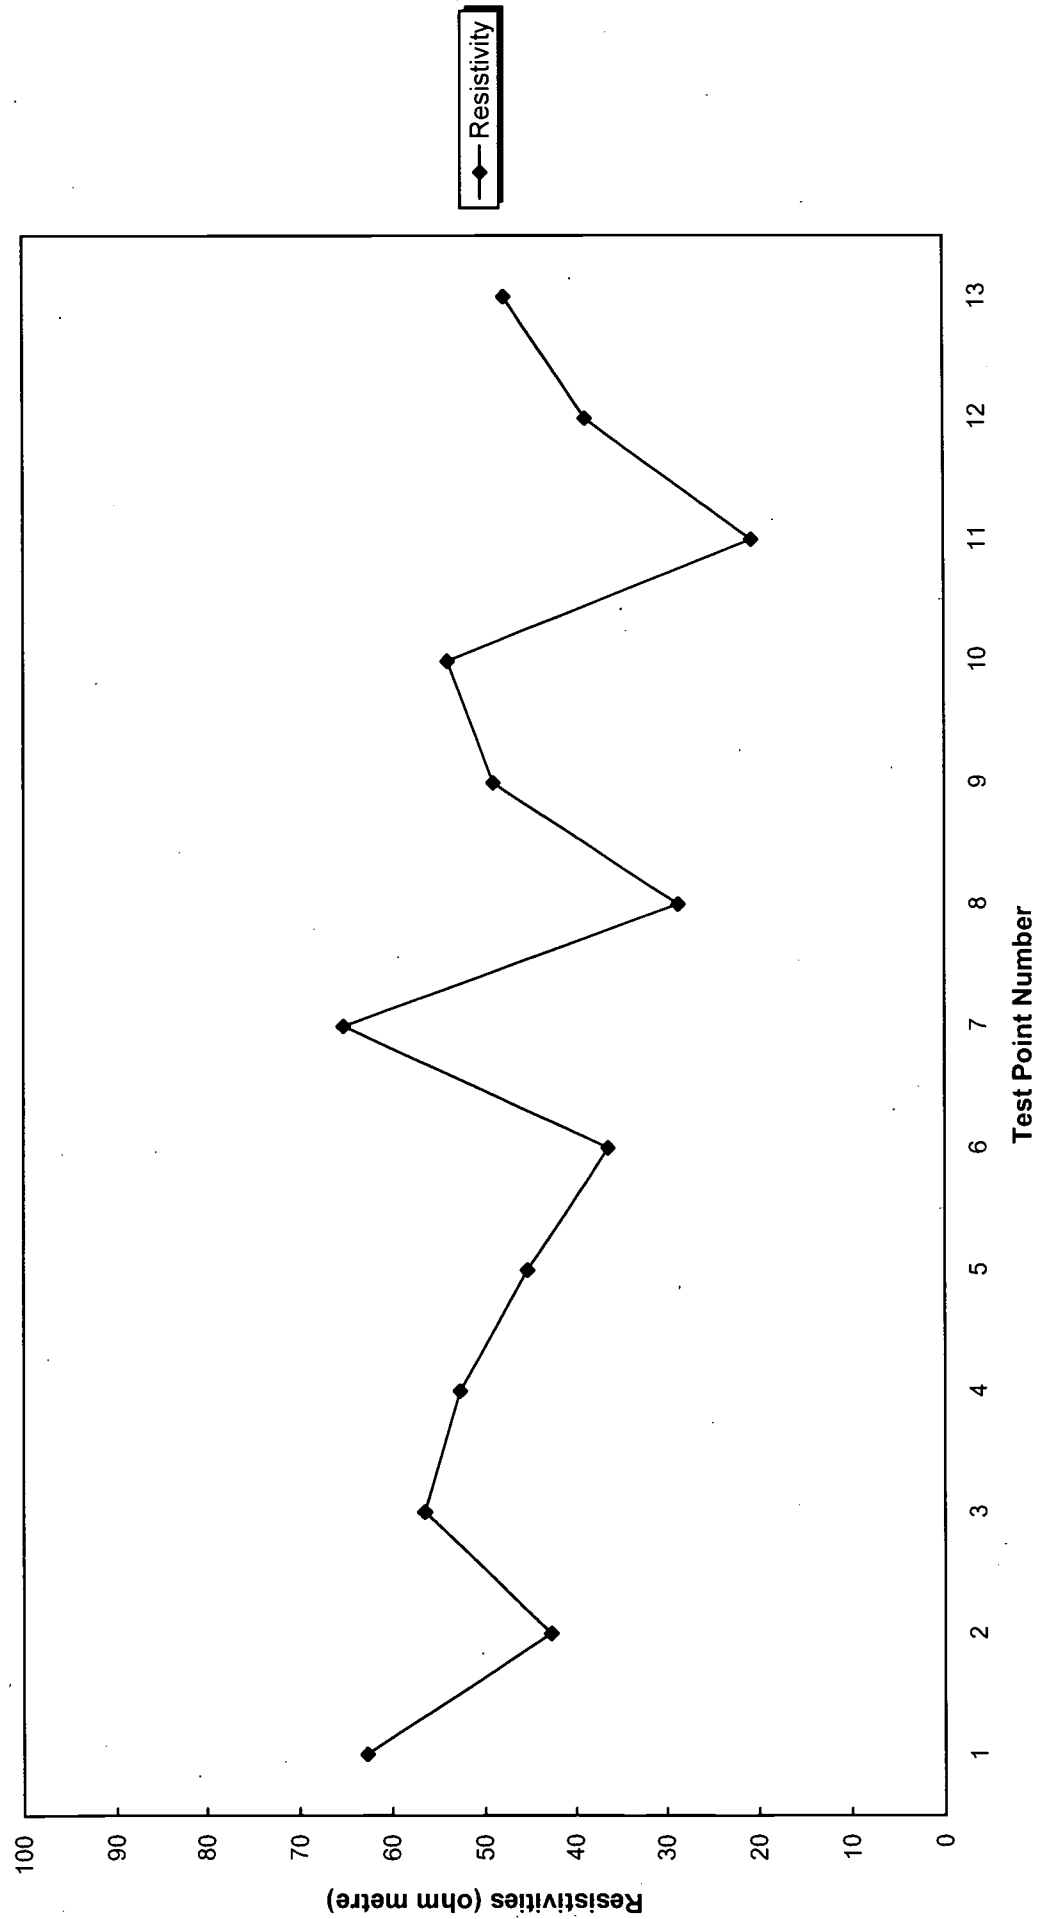

Please note:  
This application must be  
accompanied by a fee of  
\$200.00



# Queensland Government

## Department of Industrial Relations

**ABN – 52 293 849 579**

Electricity Act 1994 (Queensland) (160 and 265)

Electricity Regulation 1994 (186 to 210)

Office use only.  
Fees paid:  
Receipt no:

### APPLICATION TO REGISTER A REGISTRABLE CATHODIC PROTECTION SYSTEM

I/We, as system owner/s, hereby make application to register the registrable Cathodic Protection System described below:

Name and postal address of system owner:	Brisbane City Council / Brisbane Water GPO. Box 1434 Brisbane 4001		
Contact Name:	Telephone no:		
Name and postal address of authorised agent of system owner:	Brisbane Water Network Services 268 Cullen Ave Eagle Farm 4009		
Contact Name:	Jeff Say		
Type of application: (Tick as appropriate)	<input checked="" type="checkbox"/> New system (Note 2) Permit No; <input type="checkbox"/> Alteration to an existing system, Registration No: (Note 3) <input type="checkbox"/> Renewal of system, Registration No:		
Location of system: (Note 4)	Blamey Street Kelvin Grove 4059 From cnr. Fletcher Pde. and Beatrice St Jubilee to Corner Ann and Albert Sts. Brisbane .		
Structure to be protected:	1370mm dia Mild Steel Trunk Main		
Maximum operating current:	4.00A	Amperes DC	Maximum operating voltage (Note 5):
Volts			
I/We, being the owner/s of the Cathodic Protection System described above, make application for the registration of this system and certify with respect to the system that:			
(i) I/We have complied with the requirements of Part 4 of Chapter 3 of Electricity Regulation 1994; (ii) the tests pursuant to section 190 of Electricity Regulation 1994 were based on the maximum operating current stated in this Application; (iii) the maximum operating voltage stated in this Application (in the case of the system operating with an anode/s immersed in water or a marine environment corresponds to the maximum operating current mentioned in paragraph (ii); and (iv) any necessary interference mitigation measures for foreign structures (in the case where the system is currently registered) have been tested and are operating satisfactorily.			
Signature of System owner:		Date: / /	

**Application should be forwarded with registration fee of \$200.00 to:** Electrical Safety Office, Department of Industrial Relations, PO Box 995, SPRING HILL Q 4004. **Please note: This is a GST free supply. No tax invoice will be issued.**

Refer notes overleaflet →

#### NOTES:



1. (a) A Registrable Cathodic Protection System is an impressed current system the converter of which is capable of delivering a current greater than 0.25A.  
  
(b) A separate application is required for each Registrable Cathodic Protection System.
2. The application for a new system is to be accompanied by a plan indicating full particulars about the system including the names of the owners and location of underground and immersed foreign structures.
3. Application submitted pursuant to section 209 of Electricity Regulation 1994.
4. Sufficient details are required to correctly identify the geographical location of the system. Post Code must be included.
5. The maximum operating voltage is only required for a system operating with an anode (or anodes) immersed in water or a marine environment.

For such systems:

- Refer section 197 of Electricity Regulation 1994.
- The application is to be accompanied by the "Technical Schedule Relating to a Registrable Cathodic Protection installation in Water or a Marine Environment".

**Note:** There are no bleeds on the Ashgrove to City System

**Brisbane Water Engineering Services**

CP Form No. 27

Electrical Engineering Unit

**Cathodic Protection Interference Survey Results Form**Project ASH GROVE - City Init Reading 11V 3.2a Date 31-7-02

	Reading	Test Point I.D.	Location	Swing
On	-40		ARTHUR ST	
Off	-40	Men	Pole no 32976	0
On	-480			
Off	-472	Men	Pole no 3060	-8
On	-260			
Off	-262	men	Pole no 26713	+2
On	-420			
Off	-420	men	Pole no 45125	0
On	-380			
Off	-380	men	Pole no A 3453	0
On	-312			
Off	-312	men	Pole no 3126	0
On	-260			
Off	-262	men	Pole no 3156	+2
On	-257			
Off	-255	men	Pole no 3163	-2
On	-315		JAY ST	
Off	-315	men	Pole no 23740	0
On	-368			
Off	-368	men	Pole no 17193	0
On	-160		VICTORIA	
Off	-160	men	Pole no 24841	0
On	-145			
Off	-144	men	Pole no 26406	-1
On	-190			
Off	-190	men	Pole no 26401	0
On	-447			
Off	-440	men	Pole no 40142	-7
On	-455			
Off	-463	men	Pole no 26398	+8

TESTED BY P. Smyth

**Brisbane Water Engineering Services**




CP Form No. 27

Electrical Engineering Unit

**Cathodic Protection Interference Survey Results Form**Project ASHGROVE - City Int Reading 11v 3.2a Date 31-7-02


	Reading	Test Point I. D.	Location	Swing
On	-940		Blamney	
Off	-617	man	Pole no 6939	-323
On	-742			
Off	-642	man	Pole no 3394	-100
On	-566		Romney St Park	
Off	-566	Light	Pole	0
On	-557			
Off	-557	Light	Pole	0
On	-548			
Off	-548	Light	Pole	0
On	-460			
Off	-460	Light	Pole	0
On	-420			
Off	-420	Light	Pole	0
On	-395			
Off	-395	Light	Pole	0
On				
Off				
On				
Off				
TESTED BY P. Smyth

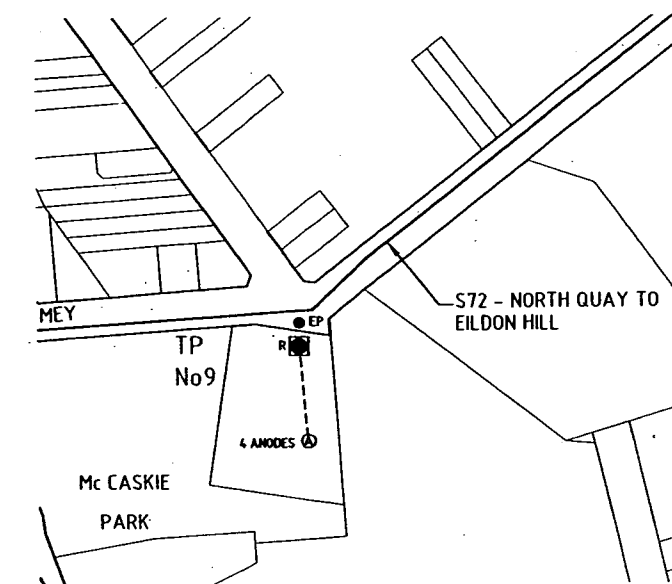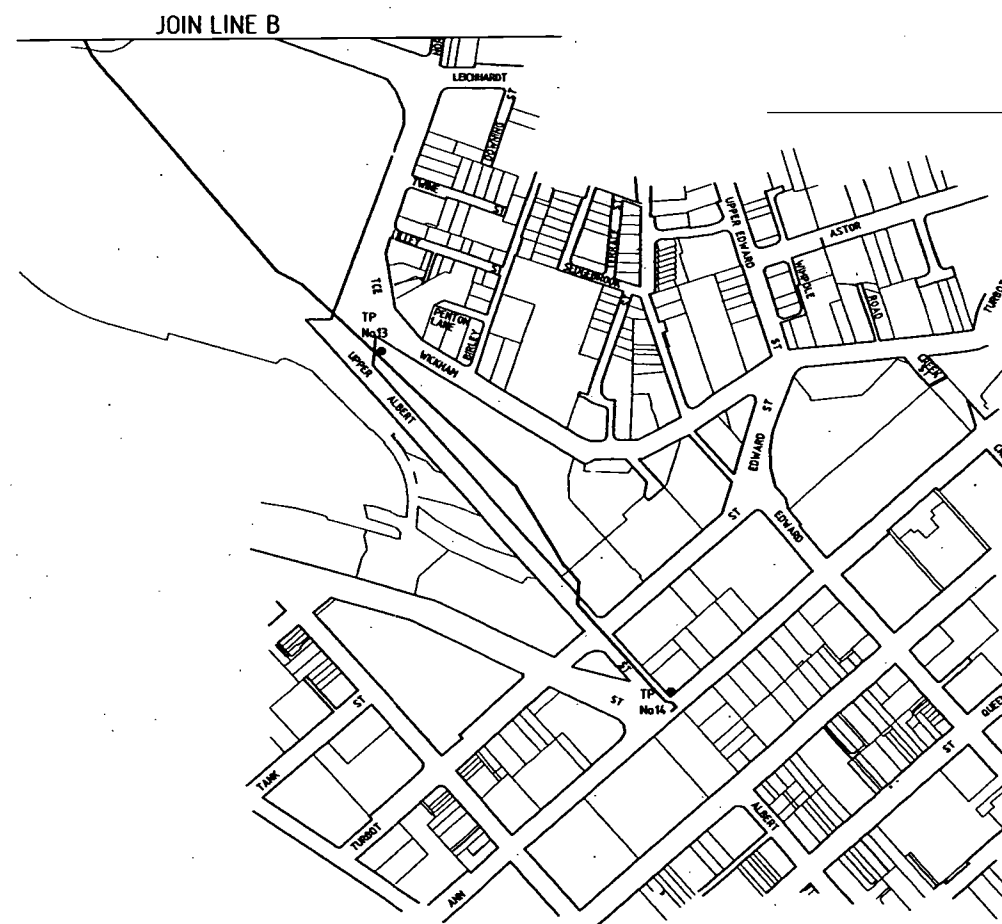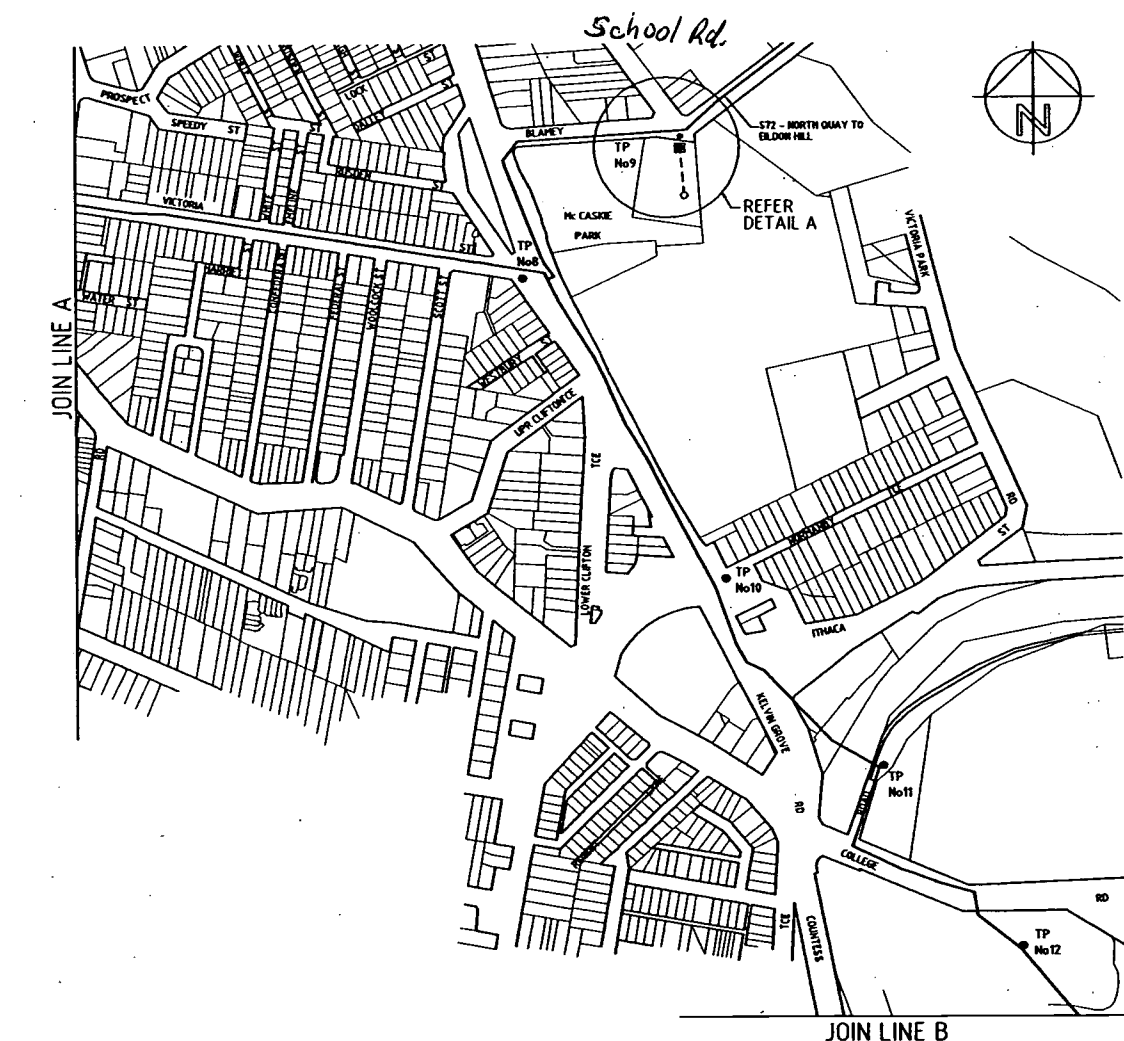


DETAIL A  
SCALE 1:2000 A1





ASSET REGISTER	
TICK APPROPRIATE BOX	
BCC FUNDED	<input checked="" type="checkbox"/> DEVELOPER FUNDED
STATE GOVT. FUNDED	FED. GOVT. FUNDED
AS CONSTRUCTED	
PLOTTED N. KROMAN	DATE 10/02
CHECKED	DATE

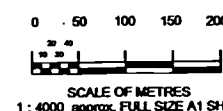





NO. DATE	AMENDMENT	INITIAL	DIRECTOR OF PD & PS	DATE	SUPERVISING ENGINEER	R.P.E.Q. NO.	DATE	DESIGN	DESIGN CHECK	DRAWN	N.K.	OCT 02	DRAFTING CHECK	H.W.	NOV 02	PROJECT	ASHGROVE TO CITY S2 TRUNK WATER MAIN	TITLE	CATHODIC PROTECTION TEST POINT & ANODE BED LOCATIONS	SCALE	AS SHOWN	N° 1 OF 1 SHEETS	A.H. DATUM	DRAWING N°	2/38.02-01	AMEND.	0
----------	-----------	---------	---------------------	------	----------------------	--------------	------	--------	--------------	-------	------	--------	----------------	------	--------	---------	--------------------------------------	-------	--	-------	----------	------------------	------------	------------	------------	--------	---

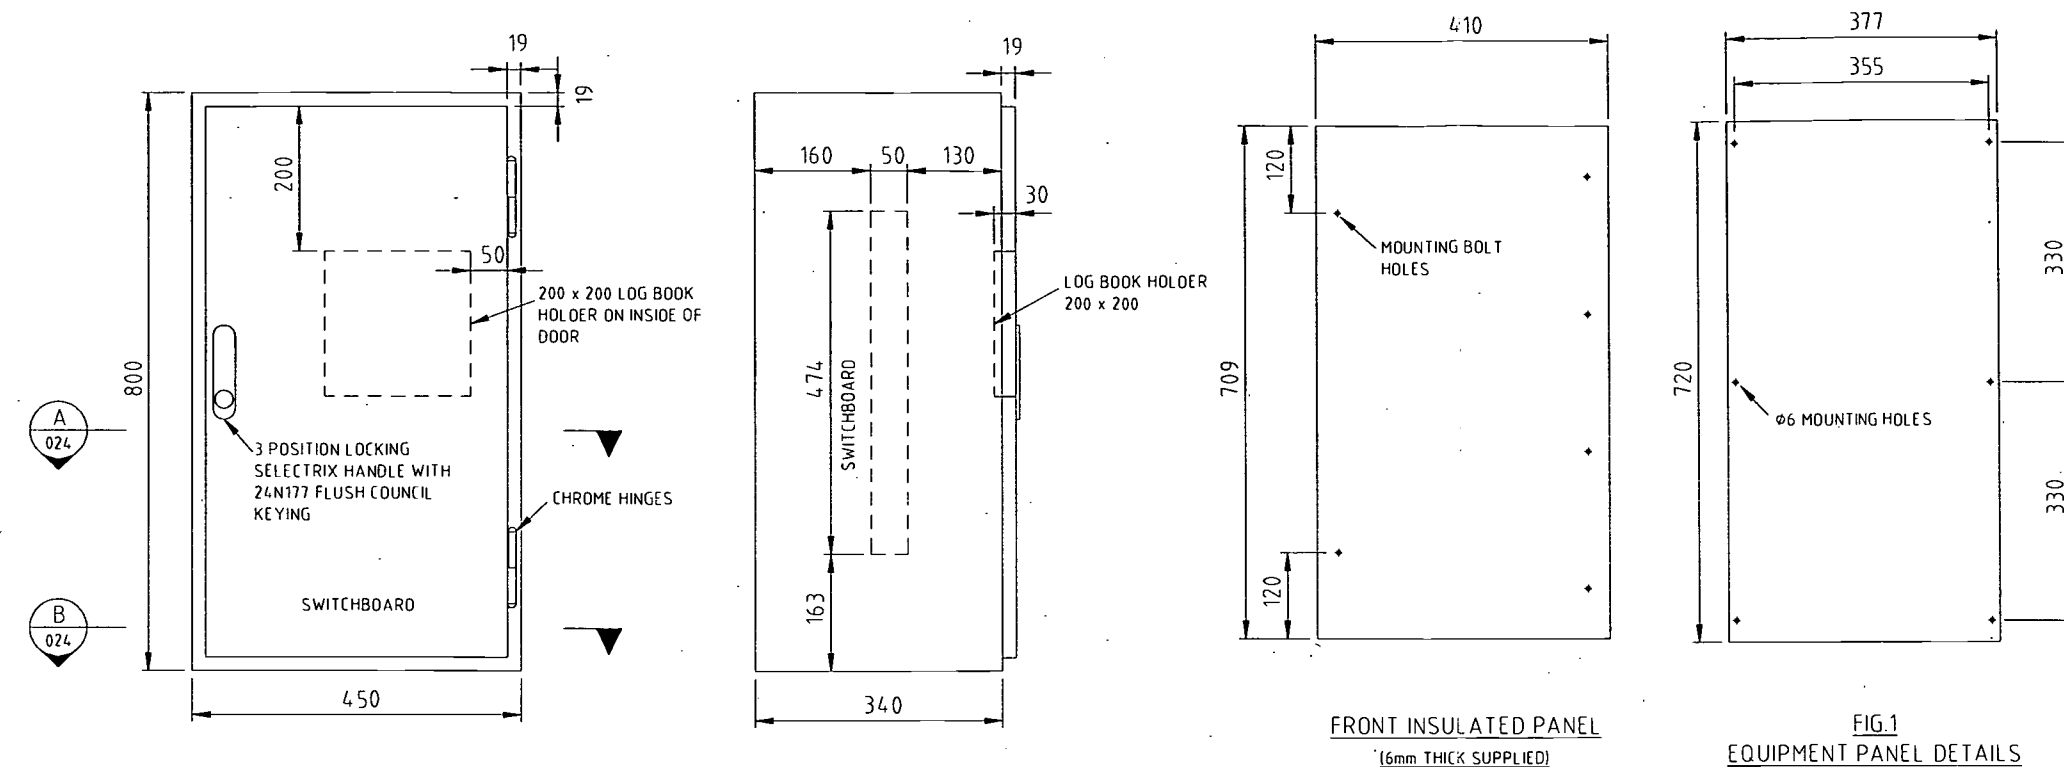

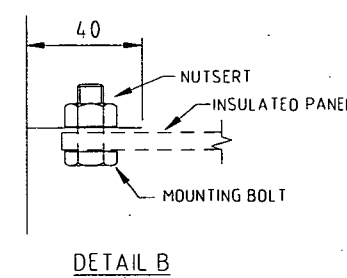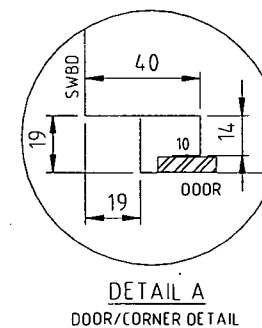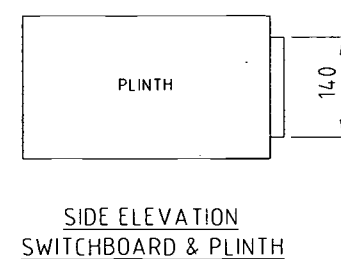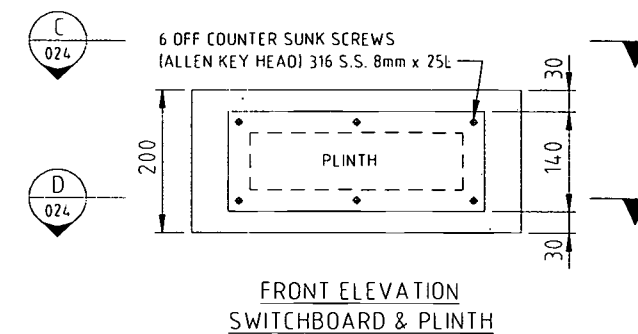

1. CABINET TO BE MANUFACTURED FROM 1.6mm 2B STAINLESS STEEL.
2. UNLESS SPECIFIED, SUPPLY CABINET WITH PLINTH. (MOUNT PLINTH TO SWITCHBOARD CABINET USING STAINLESS STEEL SCREWS).
3. REAR EQUIPMENT PANEL TO BE ZINC PLATED STEEL. POWDER COATED 'ORANGE'. (FULL LENGTH, FULL WIDTH & REMOVABLE). SEE FIG.1.
4. DOUBLE HINGED PANEL SUPPLIED BY B.C.C.
5. PROVIDE 1/4" WW STAINLESS STEEL STUDS TO DOOR & SWITCHBOARD CABINET.
6. DEGREE OF WEATHER PROTECTION IP55.
7. SELECTRIX TYPE HANDLE TO BE SUPPLIED & FITTED BY SWITCHBOARD MANUFACTURER. HANDLE TO BE 1107 SS CU1. KEY TO BE 24N177.
8. DOUBLE HINGED PANEL MOUNT TO BE SUPPLIED WITH MOUNTING BOLTS & NUTSERTS TOP & BOTTOM. SEE DETAIL A.

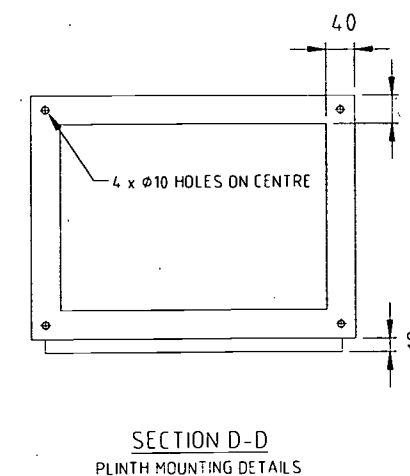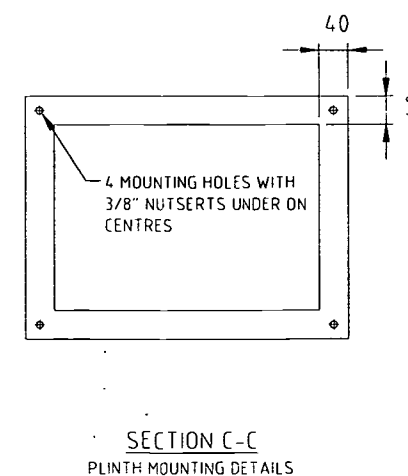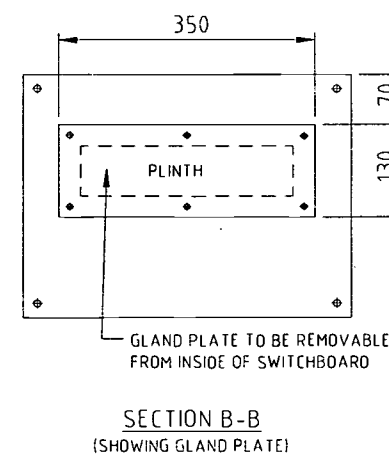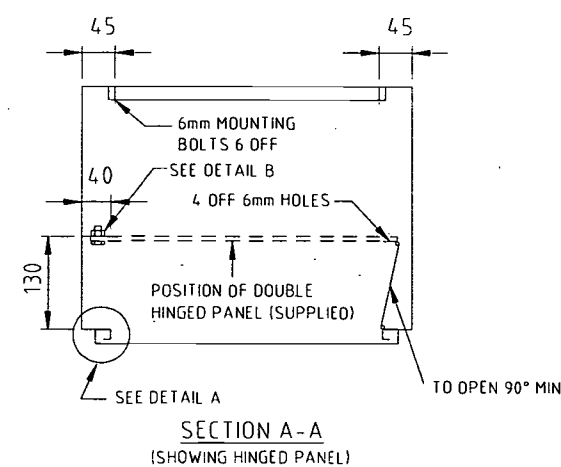




NUMBER OF SWITCHBOARDS REQUIRED	
NUMBER OF PLINTHS REQUIRED	





			DIRECTOR OF P.D. & P.S.		DATE				NAME		DATE		 Brisbane City	JOB FILE				 Professional Services Engineering	PROJECT		TITLE		SCALE NTS		N° 1 OF 1 SHEETS		
C	9-02	NOTE 3 REVISED	H1		DATE		DESIGN		K.M.G		5-5-92			ACAD FILE	22C0024-Rev-C		SHEET SIZE		A1		STANDARD SWITCHBOARD CABINET		DRAWING N°		AMEND		
B	11-95	MODIFIED	O.L.P.				DRAWN		O.L.P		7-5-92			SURVEY No.			FIELD BOOK						486/1/22-C0024E		C		
A	5-97	ISSUED FOR APPROVAL	O.L.P.		SUPERVISING ENGINEER		R.P.E.Q. NO.		DATE		CHECKED					SURVEYED			A.H. DATUM		CATHODIC PROTECTION						
NO. DATE			AMENDMENT		INITIALS																						

## NOTES

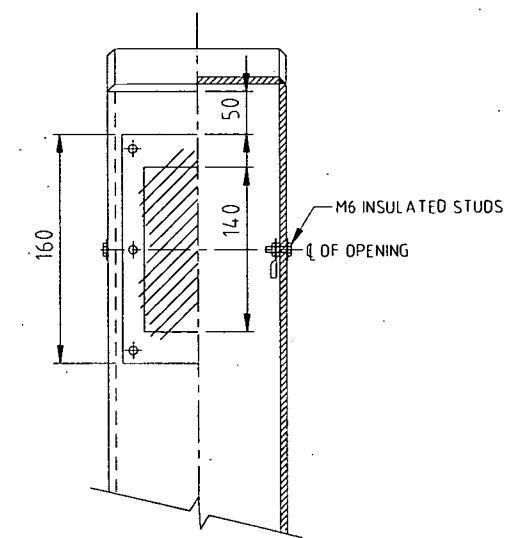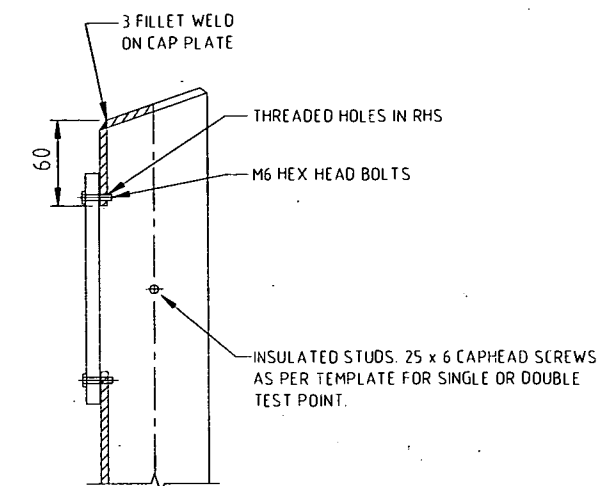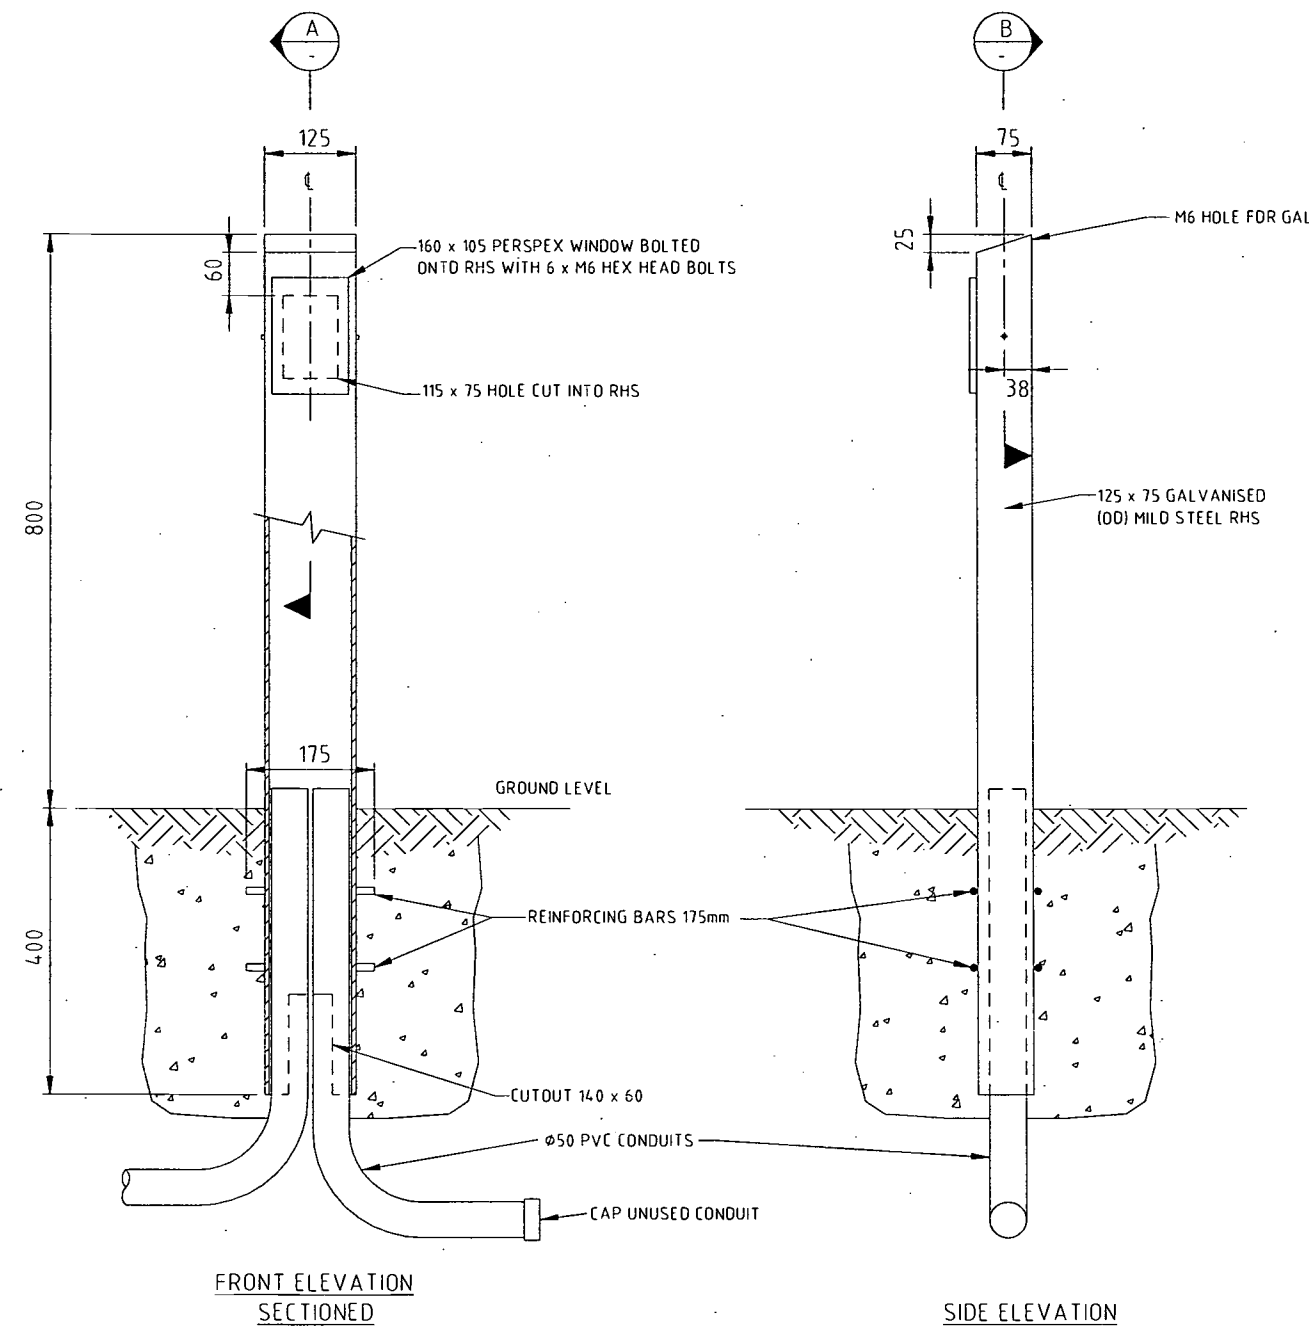1. HOT DIP GALVANISE AFTER FABRICATION.



				DIRECTOR OF P.D. & P.S.		DATE				NAME		DATE		 Brisbane City		JOB FILE		 Professional Services - Engineering		PROJECT CATHODIC PROTECTION		TITLE STANDARD TEST POINT CONSTRUCTION DETAILS		SCALE NTS		N° 1 OF 1 SHEETS	
C	9-92	NOTE 1 REVISED	WT	ENGINEER IN CHARGE	DATE	DESIGN	K.M.G.	5-5-92	ACAD FILE	2270001-RevA	SHEET SIZE	A1	DRAWING N°			AMEND.											
B	11-95	MODIFIED	D.L.P.	IN CHARGE	DATE	DRAWN	D.L.P.	7-5-92	SURVEY No.		FIELD BOOK		486/1/22-AAT0001E			C											
A	5-97	ISSUED FOR APPROVAL	D.L.P.	SUPERVISING ENGINEER	R.P.E.Q. NO.	DATE	CHECKED				A.H. DATUM																
NO.		DATE		AMENDMENT		INITIALS																					

1	R.L.	18.10.93	CHANGES AS SHOWN		
2	R.L.	25.8.93	ISSUED FOR CONSTRUCTION		
3	BY	DATE	REVISION	CHECK	APPR



BRISBANE  
CITY COUNCIL  
DEPARTMENT OF WATER  
SUPPLY & SEWERAGE  
MECHANICAL & ELECTRICAL SERVICES

PROJECT	STANDARD CATHODIC PROTECTION
TITLE	RECTIFIER UNIT WITH DATA LOGGING FACILITIES WIRING DIAGRAM


DRAWN	NAME R.L.	DATE 3.8.93	SUPER. ENG.	NAME M.J.	DATE 25.8.93	SCALE	SIZE A3
DESIGN	J.S.	3.8.93	SENIOR ENG.				
CHECKED	J.S.	25.8.93	ELECT. ENG.				
DRAWING NO. 486/6/25-AA1C0021E					ACADRIE FILE NO. A625C21		A

## Brisbane Water Engineering Services

CP Form No. 16

Electrical Engineering Unit

## Site Plan Drawing Sheet

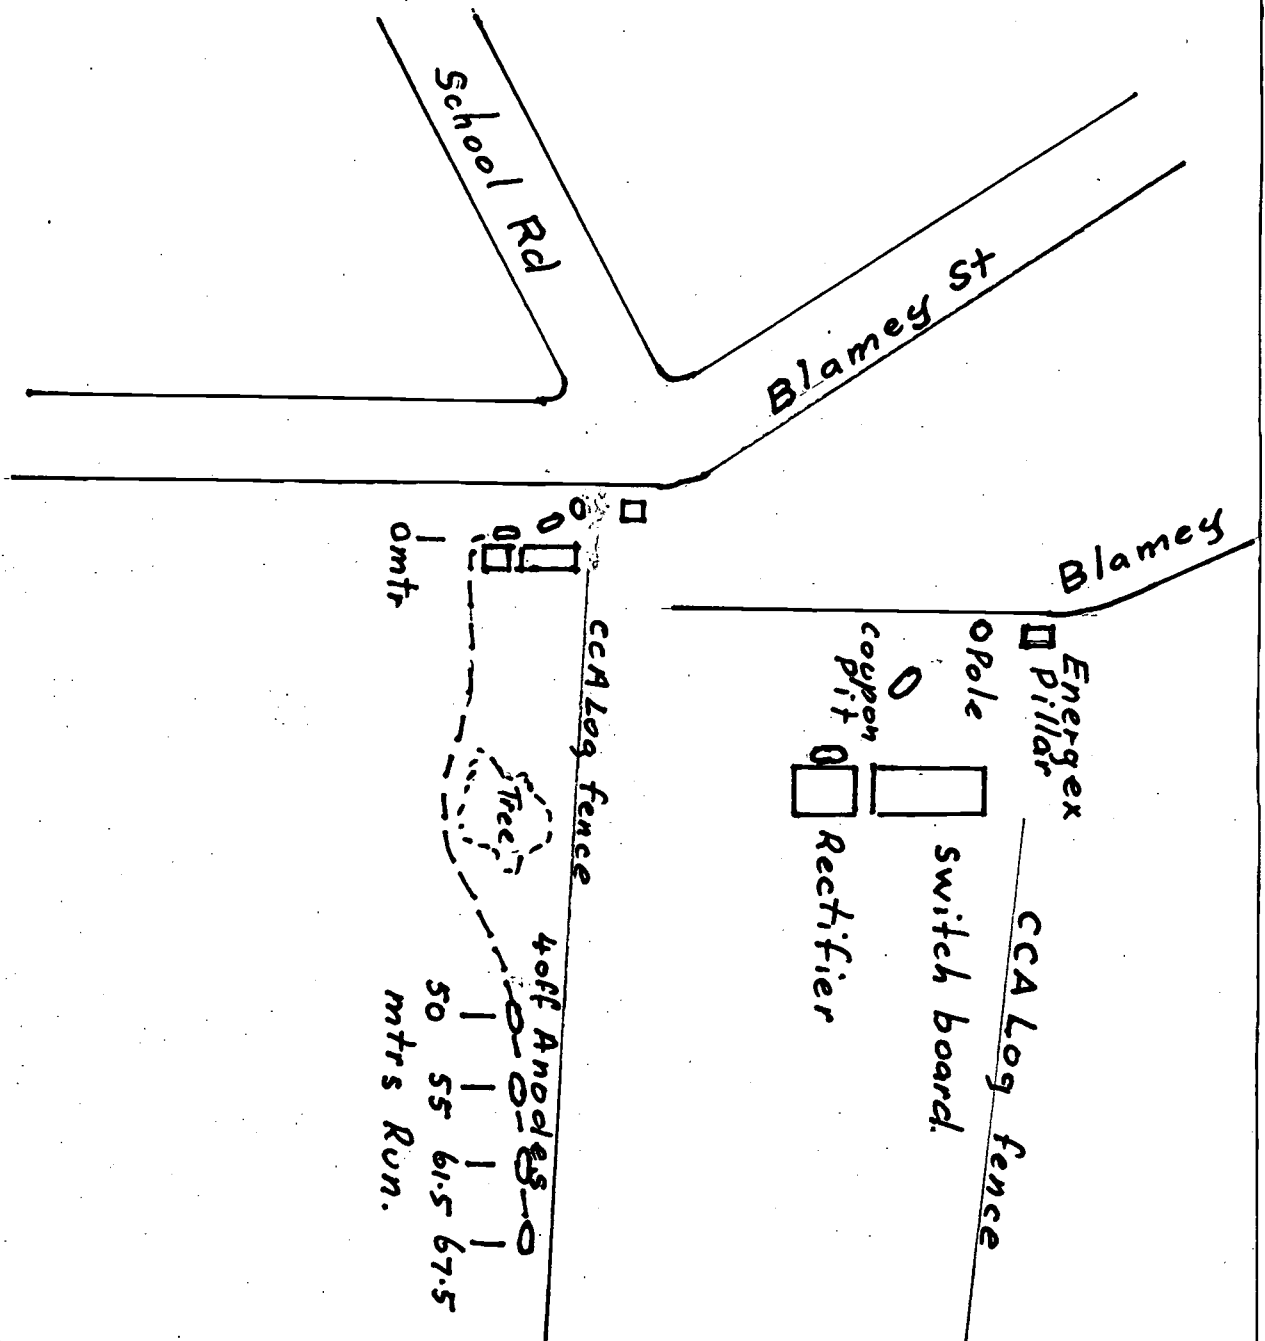Project Ashgrove - City S2 CPS 181Date Anode site 26/11/03COMPILED BY J. Tayler

Revision 09/28/95





Brisbane City Council

TO

DATE

9-12-03

FROM

PHONE

SUBJECT

Blamey St.

20 V 4a

CPS 181

TP 9 Rest on off

Cusore - Pipe - 1630 - 1190

Cusore - ZN - 1021

Cusore - ZN Coupon - 1036

Cusore - P. Coupon - 1644 - 1180

ZN - Pipe - 600 + 390

ZN - Coupon - 669 + 400

ZN - P. Coupon - 1247

TP 1

Cusore - Pipe - 980 - 511

Cusore - ZN - 993

ZN - Pipe + 90 + 420

TP 2

Cusore - Pipe - 763 - 520

Cusore - ZN - 933

ZN - Pipe + 135 + 440

TP 3

Cusore - Pipe - 758 - 560

Cusore - ZN - 840

ZN - Pipe + 80 + 360

Our Business - A Better Brisbane

MEMORANDUM

## MEMORANDUM



Brisbane City Council

TO

DATE

9-12-07

FROM

PHONE

SUBJECT

Blamey St. 20v 4a

TP 4

CuSO <sub>4</sub> - PIPE	-905	-600
CuSO <sub>4</sub> - ZN	-1147	
ZN - PIPE	+240	+575

TP 5

CuSO <sub>4</sub> - PIPE	-800	-512
CuSO <sub>4</sub> - ZN	-825	
ZN - PIPE	+20	+290

TP 6

CuSO <sub>4</sub> - PIPE	-796	-490
CuSO <sub>4</sub> - ZN	-1064	
ZN - PIPE	+275	+540

TP 7

CuSO <sub>4</sub> - PIPE	-1040	-900
CuSO <sub>4</sub> - ZN	-518	
ZN - PIPE	-520	-160

TP 8

CuSO <sub>4</sub> - PIPE	-565	-403
CuSO <sub>4</sub> - ZN	-1207	
ZN - PIPE	+643	+714

Our Business - A Better Brisbane



Brisbane City Council

TO \_\_\_\_\_ DATE 9-12-07

FROM \_\_\_\_\_ PHONE \_\_\_\_\_

SUBJECT Blamey st 20 v 4a.

TP 10

Cusom - Pipe -1179 -920

TP 11

Cusom - Pipe -655 -470

Cusom - ZN -1112

ZN - Pipe +460 +615

TP 12

Cusom - Pipe -622 -530

Cusom - ZN -1096

ZN - Pipe +475 +566

TP 13

Cusom - Pipe -477 -395

Cusom - ZN 989

ZN - Pipe +505 +585



BRISBANE CITY COUNCIL - CITY FLEET

**Temporary Fleet Requisition**

ABN 72 002 765 795

**FAX COMPLETED FORM TO:**

<b>Fleet Hire</b>	<b>3407 0446</b>
<b>Light Plant Store - Acacia Ridge</b>	<b>3407 0451</b>
<b>Light Plant Store - Virginia</b>	<b>3403 1056</b>



Quality  
Endorsed  
Company  
ISO 9001 Lic. 4454  
Standards Australia

**Requirements****Equipment Required**

BOA CAT WITH 4" OR 6" TRENCHER ATTACHMENT

Delivery Required Yes ☒ No ☐ Pick Up Required ☐**Address for Delivery/Pick Up**M<sup>C</sup>CASKIE PARK BLAMEY ST KELVIN GROVE  
UBD 159 J4**Reporting to Officer's name**

PHIL SMYTH

**Site Contact Phone no.**

0414 375 964

**Time**

a.m.

**Date**

24-10-03

**Advise availability to Officer's name**

LES GREAVES

**Phone no.**

34031840

**Fax no.**Terminate Hire  
at p.m. on**Date**

24-10-03

Extend Hire  
to p.m. on**Date**

On current Requisition no.

**Customer Details****Division/Unit**

BRISBANE WATER

**Branch/Section**

NETWORK SERVICES

**Work Unit**

MYE

**Customer no.****Account/Billing Details**

If your requirements are being provided from City Fleet's Pool, please provide the relevant MIMS Purchase Order Number

If City Fleet is sourcing a Council Owner/Driver to meet your requirements, please provide the relevant MIMS Purchase Order Numbers as shown

Labour Charge As recorded by  
Owner/Driver on charge docket

Only fill in one

Work Order/

Oracle PA (Project)

OR

General Ledger (GL)

**Tick Type**Work Order ☐Project ☒

E

TU

RC

ACT

A1

A2

NA

SA

TS

SLN1100267500000

NA

SA

TS

**Section Head/Manager's Authorisation** Division is responsible for correct authorisation of this requisition.**Authorised by Print name**

L. GREAVES

**Officer Code**

EEIESBW

**Employee no.**

32316

**Phone no.**

34031840

**Signature and date**

L. Greaves 22-10-03.

Jax 70446  
Ph 70416

SLN 11002

# BELLS' BOBCAT

BOBCAT, BACKHOE, CHAIN TRENCHING,  
FLOAT, MINI EXCAVATOR, ROLLER, AUGER

V 53 812 544 138

39 Forbes Court, Morayfield 4506

File: 0418 712 918

G: (07) 5497 9427

.. A/Hrs. (07) 5497 9120

**Tax Invoice No. N° 09302**

Date: 27-10-03

Customer: City Council Job Address: Kelangrove  
Address: Blane St Machine:

ours:	\$	
ip Fees:	\$	
Material:	\$	
Transport:	\$	
Total:	\$	

Start: 730  
Lunch:  
Finish: 1245

Completed to my satisfaction:

*[Signature]*

**EARTHING SERVICES PTY LTD**

**155 Williamson Rd**  
**MORAYFIELD Q 4506**

**Phone 07 54287701**  
**Fax 07 54287701**  
**Email**

**TAX INVOICE**

**A.B.N. 63 081 987 519**

**Invoice No: 00000248**

**Date: 07/11/03**

**Invoice To:**

**Brisbane Water**  
**25 Bunya Street**  
**EAGLE FARM QLD 4009**

**Attention: Les Greaves**

<b>DATE</b> Services Provided	<b>DESCRIPTION</b>	<b>AMOUNT</b> Excluding GST	<b>TAX CODE</b>
29/10/03	ORDER NUMBER: H40672EF. BLAMEY STREET, KELVIN GROVE Five (5) hours drilling at \$80 per hour Travle one (1) hour at \$80 per hour	\$400.00 \$80.00	GST GST
		<b>SUBTOTAL</b>	<b>\$480.00</b>
		<b>TAX</b>	<b>\$48.00</b>
		<b>TOTAL</b>	<b>\$528.00</b>

<b>CODE</b>	<b>SALE AMOUNT</b>	<b>RATE</b>	<b>TAX</b>
GST	\$480.00	10%	\$48.00

**Payment Details**

**TERMS: Net 30 Days**

**Cheques to above address**


**E.F.T. to BSB 06 4155 Account 10062054**

**Enquiries: 5428 7702**

**Thank you. We appreciate your business.**

*SLNI 1002.*

*L. J. Greaves*  
*32316*  
*12/11/03*

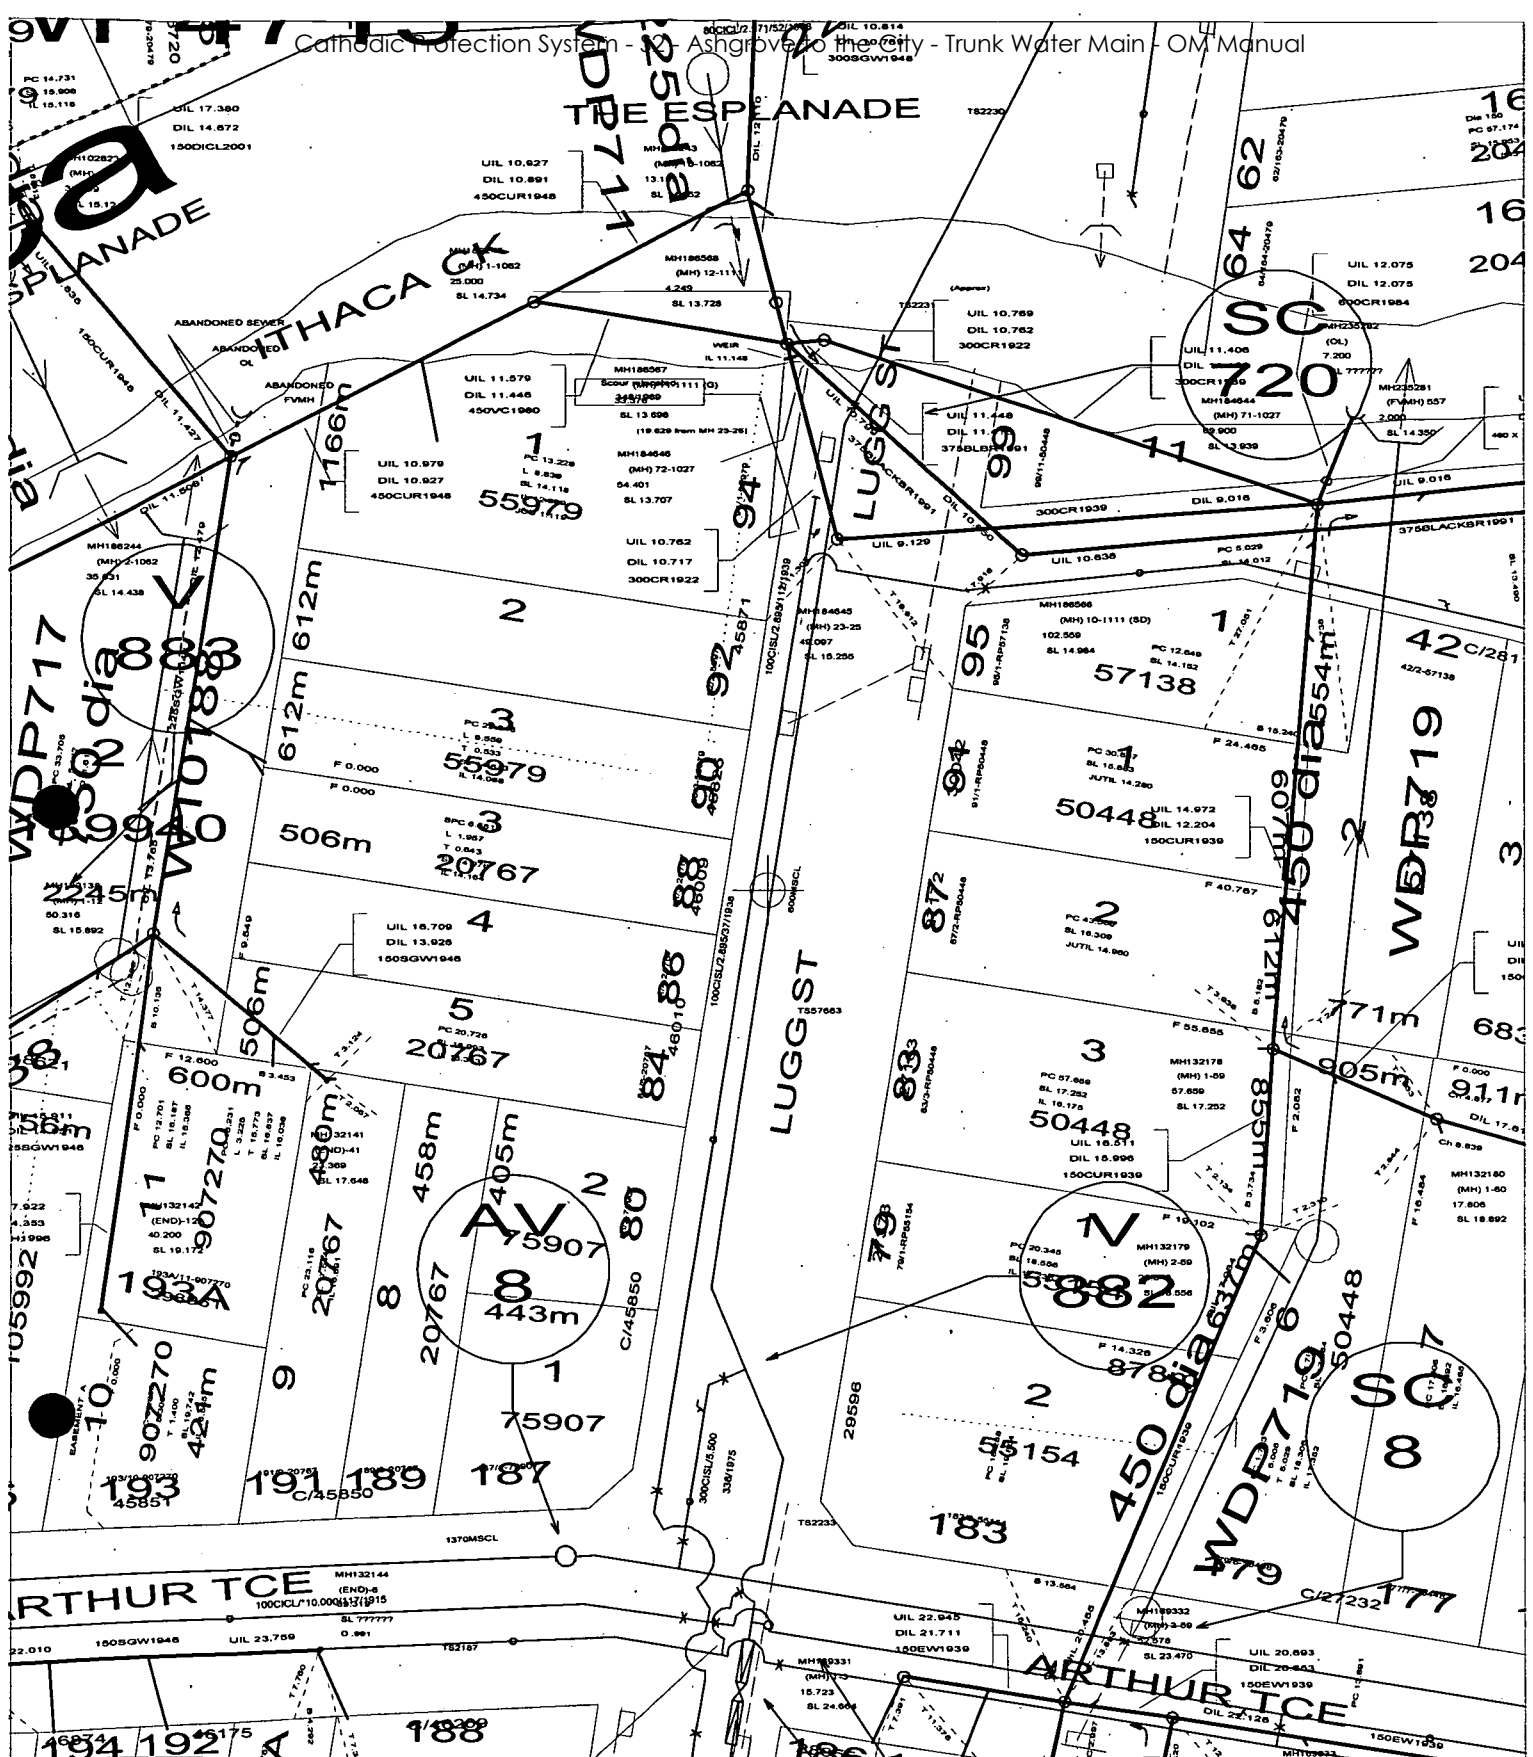

Date: 08/10/2003  
Time: 11:03:34  
Userid: ee1esbw  
Scale: 1:800

Themes:  
Cadastral  
Water Supply BCC  
Storm Water  
Sewerage BCC


### Disclaimer:

"While every care is taken by Brisbane City Council (BCC) and Dept. of Natural Resources & Mines (NRM) to ensure the accuracy of this data, BCC and NRM jointly and severally make no representations or warranties about its accuracy, reliability, completeness or suitability for any particular purpose and disclaim all responsibility and all liability (including without limitation, liability in negligence) for all expenses, losses, damages (including indirect or consequential damage) and costs which may be incurred as a result of data being inaccurate in any way and for any reason."

Based on Data provided with the permission of NRM:  
Cadastral Data (July 2003)





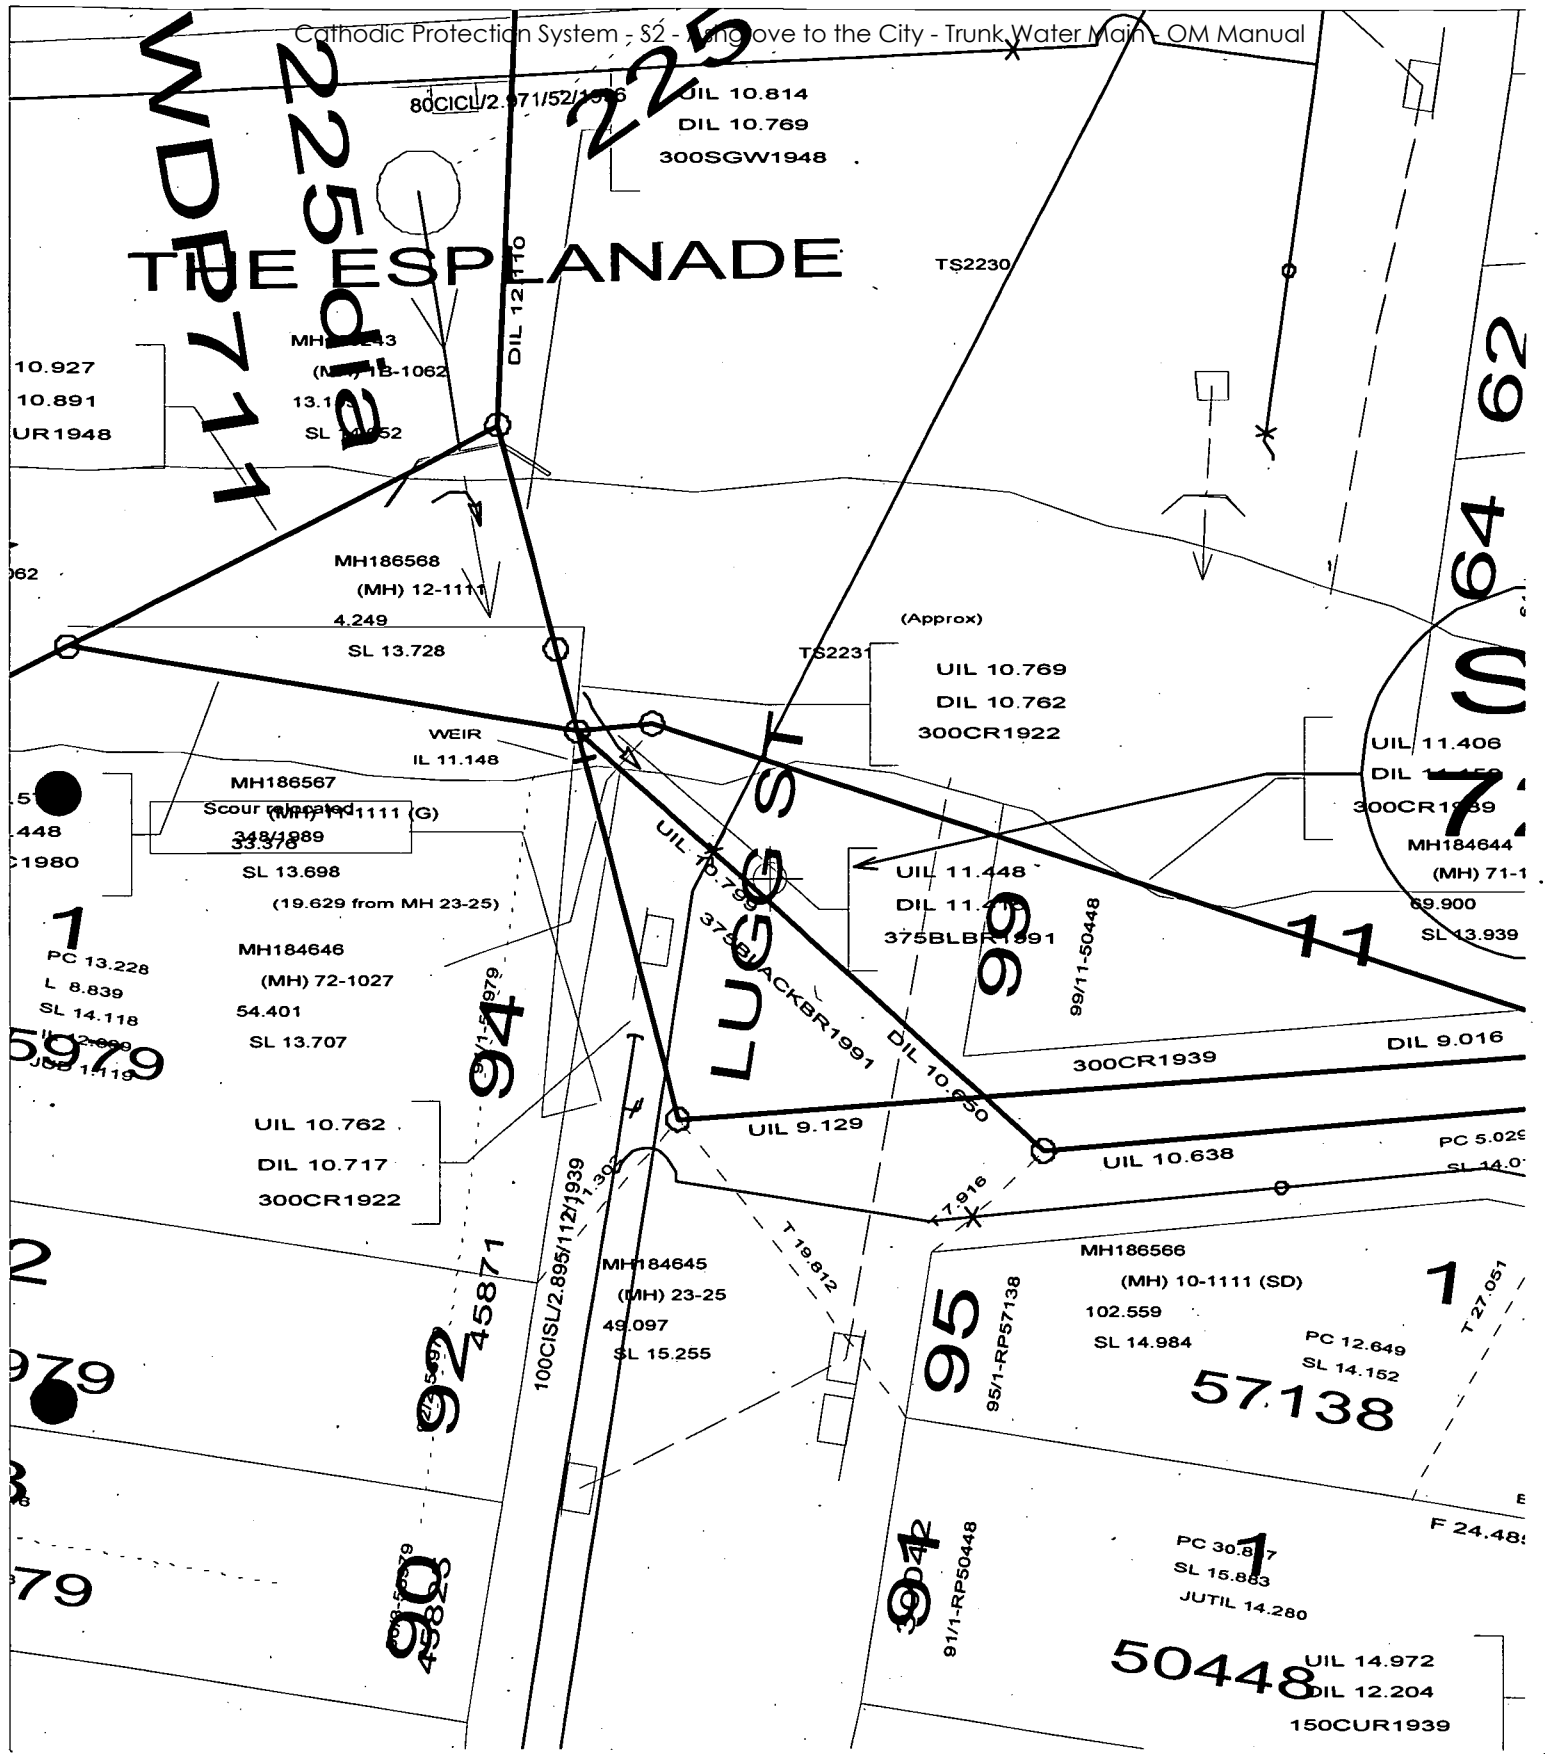

Copyright BCC, 2002  
WebBASX version 1.0

**Date:** 08/10/2003  
**Time:** 11:06:13  
**Userid:** ee1esbw  
**Scale:** 1:400

**Location:**  
499172 6963830

**Themes:**  
Cadastral  
Water Supply BCC  
Storm Water  
Sewerage BCC

**Disclaimer:**

"While every care is taken by Brisbane City Council (BCC) and Dept. of Natural Resources & Mines (NRM) to ensure the accuracy of this data, BCC and NRM jointly and severally make no representations or warranties about its accuracy, reliability, completeness or suitability for any particular purpose and disclaim all responsibility and all liability (including without limitation, liability in negligence) for all expenses, losses, damages (including indirect or consequential damage) and costs which may be incurred as a result of data being inaccurate in any way and for any reason."  
Based on Data provided with the permission of NRM:  
Cadastral Data (July 2003)





**Engineering Services**

268 Cullen Avenue  
Eagle Farm Qld 4009  
Ph: 07 36324664  
Fax: 07 36324771



28 September 2002

To: Ian McKinlay

From: Kerry McGovern

**Re: Relocation of Corrosion Prevention Equipment in E. E. McCaskie Oval**

Ian,

Brisbane Water has installed a corrosion prevention system on a steel water trunk mains in Kelvin Grove Rd. The installation consists of cables and conduits installed underground from Energex pole #6939 in Blamey Street near School Street, running approximately 90metres into the Park, parallel to Kelvin Grove Rd. An electrical cabinet is located near the Energex pole. Brisbane Water applied to install this equipment 14 May 2002 and received approval on 15 May 2002 from your Karen Nuss.

Recently we were advised that the section of E. E. McCaskie Oval that has our corrosion prevention equipment installed was going to be part of a development. We met a representative from Connell Wagner 26 August 2002 on site to discuss the extent of the resumption on the park area and the affect on our equipment. Conversation and plans from Connell Wagner point toward a relocation of our equipment.

Subject to definition of the new park boundary, we are proposing to relocate our corrosion prevention equipment to a new location in the Park as shown in attached sketch 1. It is anticipated works will commence in approximately October, subject to any conditions you may require and be completed within one month. We will monitor the site after for any ground subsidence and re-top trenches as required. As part of the project we will forward you a copy of as constructed drawings for your information and records.

Could you contact me regarding the above proposals and advise if you have services plans for the proposed sites.

Regards,  
Kerry McGovern  
Technical Support Officer  
Ph. 36324664  
Fx. 36324771  
Mob. 0419733978

**From:** Kerry McGovern  
**To:** Les Greaves  
**Date:** 10/13/03 12:37pm  
**Subject:** Fwd: FW: Information: Electrical workplace hazards

Les,  
Connell Wagner meeting on site at Blamey Street is 11.30am-1.00pm tomorrow Tuesday 14th. Job number (already on Maximo) is SLN11002.  
Regards,  
Kerry

**From:** Kerry McGovern  
**To:** Les Greaves  
**Date:** 10/14/03 1:16pm  
**Subject:** Blamey Street CP system

Les,  
Phoned Ian from parks and reminded him of the attached letter where we asked to relocate CP equipment in EE McCaskie Park. He has no objections providing we follow the usual protocols i.e forward plans on completion, tidy up park, etc.  
Copy of letter for your information.  
Regards,  
Kerry



# BRISBANE WATER - ENGINEERING SERVICES

ENQUIRY FORM / WORK ORDER FORM (Cross out whichever is not applicable)



<b>Business / Co Name</b>	EXT	<b>Date</b>	<b>Phone No</b>	<b>Fax No</b>
<b>Contact Name</b>	AO1ESBW	10-OCT-03	3362 8700	
<b>Quote Required?</b>	YES/NO (cross out whichever is not applicable) Quote No .....			
<b>Work Required Description</b>  (Note or attach further information as required, e.g. Quality plan, reference for drawings etc or any special details.)	CONNELL WAGNER PTY LTD RELOCATION OF CATHODIC PROTECTION EQUIPMENT AT THE KELVIN GROVE URBAN VILLAGE PROJECT			
<b>Can we satisfy requirements?</b>		YES/NO (cross out whichever is not applicable)		
<b>Job Details Taken By</b>		<b>Date Required</b>	27-MAY-03	
<b>BWES Work Order No</b>	SLN11002	<b>Date Commenced</b>		
<b>Master Work Order No</b>		<b>Identifier / Pimms No</b>		
<b>Customer/IOB Number</b>	065430CC/3/BW	<b>Job Assigned To</b>	32316	
<b>Amendment Details</b>				
	<b>BW Rep</b>		<b>Customer</b>	<b>Date</b>
<b>Work Completed Details (To be completed by assigned person)</b>				
<b>Checked and/or Tested OK</b>		YES/NO As per work instruction No ..... (if applicable)		
<b>Signature</b> ..... <b>Date</b> ..... (Return to Coordinator upon completion)				
<b>Bill For This Amount</b>	<b>Labour</b>	<b>Materials</b>	<b>Total</b>	<b>Coordinators Signature</b>

(Coordinator - check details and pricing, print completed copy sign off and pass onto administration for invoicing)

(Retain the original of this document in the quality records file) Form F 3-1E/Revision 1 / 10th November 1997

U:\SQR3\BW0052.SQT

10/Oct/2003



A1

BLAMEY STREET

## NOTES

1. REFER DRAWING E-005 FOR LEGEND & GENERAL NOTES.
2. PROVIDE CONTRETE PAD AND FREE-STANDING GALVANISED STEEL FRAME TO MOUNT DB7.
3. 16SL CIRCUIT DOSE NOT PASS THROUGH STREET LIGHT COLUMNS
- CONDUIT TO BE POSITIONED AROUND BASE OF TREE SO AS NOT TO INTERFERE WITH TREE ROOTS
5. DISCONNECT AND REMOVE THE EXISTING POWER SUPPLY TO THE TOILET BLOCK. THE CONTRACTOR SHALL LIAISE WITH ENERGEX TO DISCONNECT THE EXISTING CONSUMER'S MAIN (EXACT ROUTE UNKNOWN) FROM THE ENERGEX NETWORK. PROVIDE A NEW SUPPLY FROM DB-7 AS SHOWN.


## PROPOSED QUT HEALTH FACILITIES BUILDING

REFER DWG  
E-002

FOR CONSTRUCTION

kelvin grove urban village.

Rev.	Date	Revision Details	By	Ver.	App.
A-	27.05.03	ISSUED FOR CONSTRUCTION	JAR		
01	24.01.03	TENDER ISSUE	JSB		

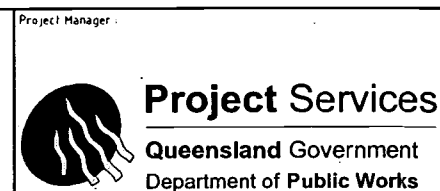

A person using Connell Wagner drawings and other data accepts the risk of:  
1. using the drawings and other data in electronic form without requesting and checking them for accuracy against the original hard copy versions.  
2. using the drawings or other data for any purpose not agreed to in writing by Connell Wagner.

Principal Consultant  
**Connell Wagner**

Connell Wagner Pty Ltd ABN 54 005 139 873 Telephone: +61 7 3246 1000  
433 Boundary St. (Locked Bag 1800) Spring Hill Facsimile: +61 7 3246 1001  
Queensland 4004 Australia Email: cwbne@connwag.com

Sub-Consultants



HASSELL

Drawn	Original signed by	Date
JSB		
Designed	Original signed by	Date
JKL		
Verified	Original signed by	Date
AWJ		
Approved	Original signed by	Date
KJG		
Recommended	Original signed by	Date

Drawing Title  
**ELECTRICAL SERVICES  
MCCASKIE PARK LIGHTING  
SHEET 2 OF 3**

EW Project No	065450BX
Scale	1:250 AT A1
Drawing No	E-006
Rev	A

20 10 0 10 20 30 40 50 100m

A1

URD CONDUIT SCHEDULE - ROADWAYS BY CIVIL CONTRACTOR																				
LOCATION	STATIONS FROM - TO	CONDUIT LENGTH (m)				BENDS (°/No.)				EXCAVATION (m)				PLUGS	DRAW WIRE (m)	RE MARKS (E)	TRENCH DEPTH (m)			
		40mm Class 6	50mm Class 6	75mm Class 6	125mm Class 6	40mm R/D	50mm R/D	75mm R/D	100mm R/D	40mm TRENCH	50mm TRENCH	75mm TRENCH	100mm TRENCH				50	100	150	175
MAIDSTONE STREET	2-3		15											15	0	2x40	16	2	X-ROAD	15
	3-3L	12												12	0	2x40	13	2	X-ROAD	12
ROAD 3	5-6	24			4x24									24	A2	2x40 8x100	125	2	X-ROAD	24
	5-9	26			4x26									26	A2	2x40 8x100	136	2	X-ROAD	26
ROAD 5	11-12	25			4x25									25	A2	2x40 8x100	104	2	X-ROAD	25
BLAMEY STREET	17-18	22				8x22								22	B	2x40 12x125	161	2	X-ROAD	22
	15-16	36				2x36								36	A	2x40 4x100	117	2	X-ROAD	36
	15-20	32				8x32								32	B2	2x40 16x125	297	2	X-ROAD	32
	21-22	25			4x25									25	A2	2x40 8x100	130	2	X-ROAD	25
ROAD 1	39-40	20				8x20								20	B	2x40 12x125	147	2	X-ROAD	20
	43-44	24				8x24								24	B	2x40 12x125	175	2	X-ROAD	24
PROTECTIVE COVER STRIPS																				140m
TOTAL		248	15	476	652									263	20x40	1420	22			27
																2x80				234
																36x100				
																50x125				

- NOTE: 1. REFER SPECIFICATION URD DNG 4025-A4 SHEETS 36 & 37 FOR DETAILS OF CONDUIT CROSS-SECTIONS.
2. PLEASE NOTE: PROTECTIVE PVC COVER STRIPS TO BE INSTALLED ABOVE ALL CONDUITS WHERE THEY CROSS FOOTPATHS.
3. CIVIL CONTRACTOR SHALL ENSURE THAT ELECTRICITY AND TELSTRA CONDUITS HAVE BEEN INSTALLED BEFORE CONSTRUCTING ANY PATHS OR DRIVEWAYS ACROSS THE VERGE.
4. CIVIL CONTRACTOR - CONDUIT ENDS SHOULD BE PLUGGED WITH A SUITABLE MATERIAL TO PREVENT THE ENTRY OF DIRT OR OTHER FOREIGN MATTER.

URD CONDUIT SCHEDULE - FOOTPATH BY ELECTRICAL CONTRACTOR																								
LOCATION	STATIONS FROM - TO	CONDUIT LENGTH (m)				BENDS (°/No.)								X-SECTION (HxW)		REMARKS	TRENCH DEPTH (m)							
		40mm	50mm	75mm	100mm	40mm	50mm	75mm	100mm	Class 6	Class 6	100mm	Class 6	125mm	Class 6		EXCAV TAPE	TRENCH DETAIL	250	300	1830	175		
MAIDSTONE ST	1-3		16									40	4	1830			16	0	ALONG FOOTPATH	16				
ROAD 3	4-5	84		4x84										15	12	1830		84	A2	ALONG FOOTPATH		84		
ROAD 2	6-16	92		4x92														92	A2	ALONG FOOTPATH		92		
ROAD 3	8-7	78		4x78										15	4	1830		78	A2	ALONG FOOTPATH		78		
ROAD 5	8-13	102		4x102										45	4	1830		102	A2	ALONG FOOTPATH		102		
BLAMEY STREET	19-17	22			8x22										16	12	1730	22	B	ALONG FOOTPATH		22		
	17-15	77			8x77										16	8	1830	77	B2	ALONG FOOTPATH		77		
	20-23	78			8x78										45	8	1830	78	B2	ALONG FOOTPATH		78		
	25-20	95		4x95										30	4	1830		95	A2	ALONG FOOTPATH		95		
	27-20	72		4x72											16	8	1830	72	A2	ALONG FOOTPATH		72		
ROAD 1	27-43	160		8x160											95	4		160	B	ALONG FOOTPATH		160		
VICTORIA PARK RD	44-46	6		6x6													16	8	1830	6	0	ALONG FOOTPATH		6
HELVETIA GROVE RD	47-48	98		8x98														98	B	ALONG FOOTPATH		98		
ALL SIGHTS	0					90	6	300										0	0	FOOTPATH		0		
BENDS AT SERVICE CURBS												90	2	460										
1 BEND AT USING SERVICE PIPES LARG PROTECTIVE COVER STRIPS												45	10	1200										
TOTAL		600	16	1864	2962	90	6	300	90	2	460						646				21	824		
												45	10	1200										
												16	1830	16	24	1830	16	26	1830					
												30	1830	30	24	1830	30	12	1830					
												40	4	1830	40	8	1830	46	8	1830				

- NOTE: 1. ELECT. CONTRACTOR - CONDUIT ENDS SHOULD BE PLUGGED AROUND THE CABLE WITH A SUITABLE MATERIAL TO PREVENT THE ENTRY OF DIRT OR OTHER FOREIGN MATTER.
2. ALL MATERIAL ON CONDUIT SCHEDULE TO BE SUPPLIED BY CONTRACTOR.
3. REFER SPECIFICATION URD DNG 4025-A4 SHEETS 36 & 37 FOR DETAILS OF CONDUIT CROSS-SECTIONS.
4. PLEASE NOTE: PROTECTIVE PVC COVER STRIPS TO BE INSTALLED ABOVE ALL CONDUITS WHERE THEY CROSS FOOTPATHS.
5. ALL FOOTPATH CONDUITS SHALL BE INSTALLED WITH MINIMUM COVER OF 700mm.
6. FOOTPATH CONDUITS SHALL NOT BE INSTALLED UNTIL AFTER KERB HAS BEEN CONSTRUCTED AND FOOTPATHS HAVE BEEN GRADED TO FINAL LEVELS LESS TOP SOIL.
7. CABLES SHALL BE INSTALLED WITHIN A CORRIDOR 400-500mm FROM PROPERTY ALIGNMENT, IN ACCORDANCE WITH ENERGEX DRAWINGS No. 4025-A4 SHEETS 29-30.

EQUIPMENT SCHEDULE - SERVICE PILLARS											
LOCATION	STN No.	SITE I.D.	EX	REC	IN	SIZE & DESCRIPTION	IN	COMP	PLANT	MODEL	QTY
MAIDSTONE STREET	3	U053158				CROSS ROAD				LVSP4C3D	1
ROAD 6	10	U053160				2WAY				LVSP4C3D	2
						DIEN				LVSP4C3D	1
						SP BASE & COVER				LVSP4C3D	2
						FUSE PANEL & LUGS				LVSP4C3D	1
						BOLTS SET				LVSP4C3D	1
						LV SHROUD & TIE SET				LVSP4C3D	1
BLAMEY STREET	22	U053162				1WAY				LVSP4C3D	1
						DIEN				LVSP4C3D	1
						SP BASE & COVER				LVSP4C3D	2
						FUSE PANEL & LUGS				LVSP4C3D	1
						BOLTS SET				LVSP4C3D	1
						LV SHROUD & TIE SET				LVSP4C3D	1
BLAMEY STREET	26	U053161				1WAY				LVSP4C3D	1
						DIEN				LVSP4C3D	1
						SP BASE & COVER				LVSP4C3D	2
						FUSE PANEL & LUGS				LVSP4C3D	1
						BOLTS SET				LVSP4C3D	1
						LV SHROUD & TIE SET				LVSP4C3D	1
SCHOOL STREET	28	U053162				LINK PILLAR - 2WAY TYPE				LVSP4C3D	2
						DIEN				LVSP4C3D	1
						SP BASE & COVER				LVSP4C3D	2
						FUSE PANEL & LUGS				LVSP4C3D	1
						BOLTS SET				LVSP4C3D	1
						LV SHROUD & TIE SET				LVSP4C3D	1
SCHOOL STREET	29	U053163				2WAY				LVSP4C3D	2
						DIEN				LVSP4C3D	1
						SP BASE & COVER				LVSP4C3D	2
						FUSE PANEL & LUGS				LVSP4C3D	1
						BOLTS SET				LVSP4C3D	1
						LV SHROUD & TIE SET				LVSP4C3D	1

EQUIPMENT SCHEDULE - 11KV & TRANSFORMER											
LOCATION	STN No.	SITE I.D.	EX	REC	IN	SIZE & DESCRIPTION	IN	COMP	PLANT	MODEL	QTY
ROAD 2	14	SC03134				UNICULVERT FOUNDATION					1
						500KVA PMT TRANSFORMER & RMU					1
						11V FUSES					3
						11V FUSES					2
						EARTHING					1
						ADDITIONAL EARTHING					1
						SIGNS					1
BLAMEY 15	30	SC03020				500KVA PMT & RMU					1
						RECOVER PMT AND					
						TRANSPORT TO					
						EMVY DEPOT.					

UNDERGROUND CABLE SCHEDULE											
LOCATION	STATIONS FROM - TO	VOLT	EX	REC	IN	CABLE SIZE TYPE				REMARKS	
						11KV (m)	11KV (m)	11KV (m)	11KV (m)		
ROAD 1	8-14	11KV				172					
ROAD 2	14-11	LV					132				
	9-4	LV					104				
	14-19	LV					162				
BLAMEY STREET	15-24	LV					130				
	21-22	LV					32				
	25-26	LV					78				
	25-25A	LV					114				
SCHOOL STREET	28A-78	LV					35				
ROAD 1	36-45	11KV				230					
	36-45	LV					228				
MAIDSTONE STREET	1-3	LV					50				
PILLARS		LV					0			(1.5m PER LOOP PILLAR)	
ALL SIGHTS	SP - SAL	SLM								38	SEE SAL SCHEDULE
TOTALS						402	1016	50		38	

THE CONTRACTOR SHALL MEASURE ACTUAL CABLE LENGTHS REQUIRED ON SITE, AFTER INSTALLATION OF CONDUITS, THEN NOTIFY ENERGEX/SUPPLIER WHEN CONFIRMING CABLE ORDER.

Rev.	Date	Revision Details	By	Ver.	App.
04	27.03.02	ISSUED FOR B.C.C. APPROVAL			
03	21.03.02	TENDER ADDENDUM NO.2			
02	11.03.02	PRELIMINARY WORKS PLAN			
01	25.02.02	PRELIMINARY CONDUIT PLAN			

Client:	Queensland Government Department of Housing
Project Manager:	Project Services Queensland Government Department of Public Works
Principal Consultant:	Connell Wagner Connell Wagner Pty Ltd ABN 54 005 139 873 Telephone: +61 7 3246 1000 433 Boundary St. (Locked Bag 1800) Spring Hill Queensland 4004 Australia Facsimile: +61 7 3246 1001 Email: cwbne@connwag.com
Sub-Consultants:	URS HUMPHREYS REYNOLDS PERCHES HASSELL

Drawn	Original signed by	Date	25.2.02
Designed	Original signed by	Date	25.2.02
Verified	Original signed by	Date	
Approved		Date	
Recommended		Date	

Drawing Title:	ELECTRICAL RETICULATION SHEET 4 OF 5
ENERGEX PROJECT No.	D1800513
Drawing No.	S1B-EL-043
Rev.	04

Drawn	Original signed by	Date	25.2.02
Designed	Original signed by	Date	25.2.02
Verified	Original signed by	Date	
Approved		Date	
Recommended		Date	

PRELIMINARY

kelvin grove urban village.

CW Project No  
0654



Scale

Drawing No  
S1B-EL-043Rev  
04





A1

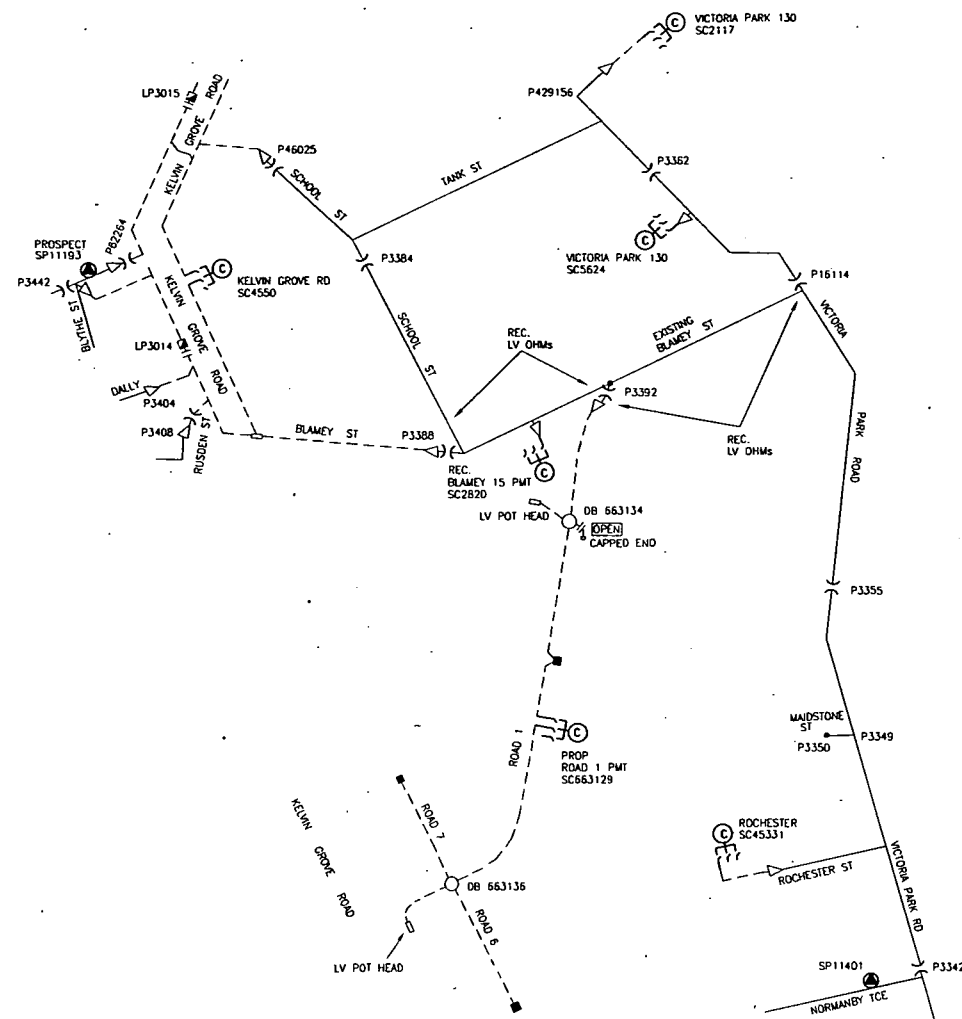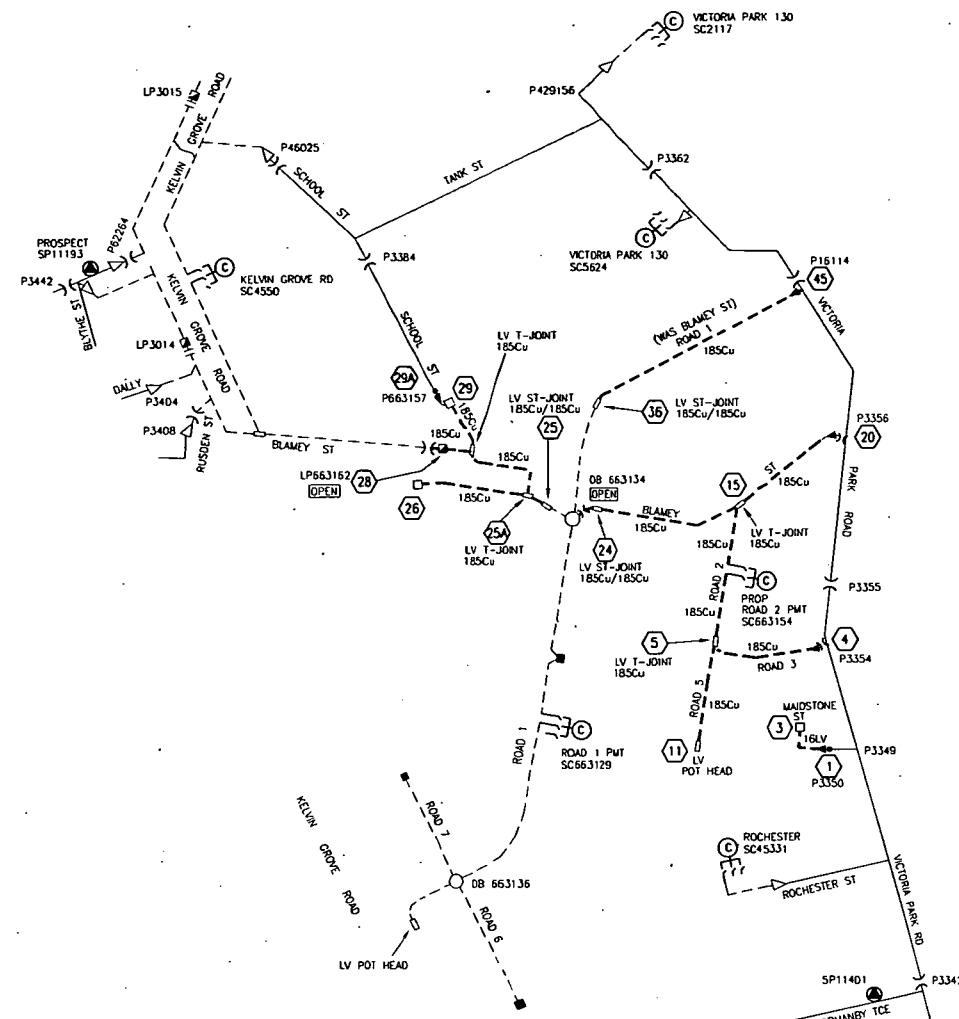EXISTING LV SCHEMATIC  
SCALE 1:2500PROP LV SCHEMATIC  
SCALE 1:2500

LV POLE LABEL		
LABEL SIZE	SITE LOCATION FOR ATTACHING OF LABEL	LABEL INFORMATION
300x100	POLE No. 3354 LOC. VICTORIA PK RD	TO ROAD 2 SC663154/ AND SERVICES

REFER: NETWORK LABELLING &amp; SIGNAGE-SECT.3.4 DWG.6448-A4

LV POLE LABEL		
LABEL SIZE	SITE LOCATION FOR ATTACHING OF LABEL	LABEL INFORMATION
300x100	POLE No. 3356 LOC. VICTORIA PK RD	TO ROAD2 SC663154/ ROAD 1 DB663134 AND SERVICES

REFER: NETWORK LABELLING &amp; SIGNAGE-SECT.3.4 DWG.6448-A4

LV POLE LABEL		
LABEL SIZE	SITE LOCATION FOR ATTACHING OF LABEL	LABEL INFORMATION
300x100	POLE No. 663157 LOC. SCHOOL ST	TO BLAMEY ST P663162/ ROAD 1 DB663134 AND SERVICES

REFER: NETWORK LABELLING &amp; SIGNAGE-SECT.3.4 DWG.6448-A4

LV POLE LABEL		
LABEL SIZE	SITE LOCATION FOR ATTACHING OF LABEL	LABEL INFORMATION
300x100	POLE No. 3356 LOC. VICTORIA PK RD	TO ROAD 2 SC663154/ ROAD 1 DB663134 AND SERVICES

REFER: NETWORK LABELLING &amp; SIGNAGE-SECT.3.4 DWG.6448-A4

LV POLE LABEL		
LABEL SIZE	SITE LOCATION FOR ATTACHING OF LABEL	LABEL INFORMATION
300x100	POLE No. 3404 LOC. DALLEY ST	TO KELVIN GROVE 171 SC4550/ DALLEY ST P3404/ KELVIN GROVE RD LP3014/ BLAMEY ST LP663162 AND SERVICES

REFER: NETWORK LABELLING &amp; SIGNAGE-SECT.3.4 DWG.6448-A4


LV POLE LABEL		
LABEL SIZE	SITE LOCATION FOR ATTACHING OF LABEL	LABEL INFORMATION
300x100	POLE No. 3408 LOC. RUSDEN ST	TO KELVIN GROVE 171 SC4550/ DALLEY ST P3404/ KELVIN GROVE RD LP3014/ BLAMEY ST LP663162 AND SERVICES

REFER: NETWORK LABELLING &amp; SIGNAGE-SECT.3.4 DWG.6448-A4

PMT: ABB LV SWITCHBOARD LABEL				
STATION No: SC663154 ROAD 2, KELVIN GROVE				
CIRCUIT No	LABEL SIZE	LABEL COLOUR	LETTER SIZE	LABEL INFORMATION
1	80x35	WB	5	TRANSFORMER ISOLATOR
2	80x35	WB	5	TO ROAD 1 DB663134/ VICTORIA PARK RD P3356 AND SERVICES
3	80x35	WB	5	TO VICTORIA PARK RD P3354 AND SERVICES
4	80x35	WB	5	

REFER: NETWORK LABELLING &amp; SIGNAGE-SECT.3.3 DWG.6453-A4


FOR LABEL DETAILS SEE ABOVE

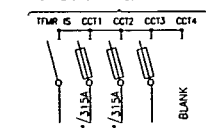

PMT: ABB LV SWITCHBOARD LABEL				
STATION No: SC4550 KELVIN GROVE 171				
CIRCUIT No	LABEL SIZE	LABEL COLOUR	LETTER SIZE	LABEL INFORMATION
1	80x35	WB	5	TRANSFORMER ISOLATOR
2	80x35	WB	5	TO BLAMEY ST LP663162/ RUSDEN ST P3408/ DALLEY ST P3404/ KELVIN GROVE RD LP3014 AND SERVICES
3	80x35	WB	5	
4	80x35	WB	5	

REFER: NETWORK LABELLING &amp; SIGNAGE-SECT.3.3 DWG.6453-A4

FOR LABEL DETAILS SEE ABOVE

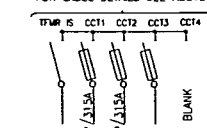LV LABEL ORDERING SHEET:  
DISCONNECT BOX

STATION No: DB 663134			LOCATION: ROAD 1	
			KELVIN GROVE	
LABEL SIZE	LABEL COLOUR	LETTER SIZE	LABEL INFORMATION	
160x40	WB	5	TO VICTORIA PARK RD P16114 AND SERVICES	
160x40	WB	5	TO ROAD 2 SC663154/ VICTORIA PARK RD P3356 AND SERVICES	
160x40	WB	5		
160x40	WB	5	TO BLAMEY ST LP663162/ SCHOOL RD P663157 AND SERVICES	

REFER: NETWORK LABELLING &amp; SIGNAGE-SECT.3.3 DWG.6454-A4

LV LABEL ORDERING SHEET:  
LINK PILLAR (NEW TYPE)

STATION No: LP663162			LOCATION: BLAMEY ST	
			KELVIN GROVE	
LABEL SIZE	LABEL COLOUR	LETTER SIZE	LABEL INFORMATION	
80x35	WB	5	TO KELVIN GROVE 171 SC4550/ DALLEY ST P3404/ RUSDEN ST P3408/ KELVIN GROVE RD LP663162 AND SERVICES	
80x35	WB	5	TO SCHOOL RD P663157/ ROAD 1 DB663134 AND SERVICES	




REFER: NETWORK LABELLING &amp; SIGNAGE-SECT.3.3 DWG.6453-A4

LV LABEL ORDERING SHEET:  
LINK PILLAR (NEW TYPE)

STATION No: LP3014			LOCATION: KELVIN GROVE RD	
			KELVIN GROVE	
LABEL SIZE	LABEL COLOUR	LETTER SIZE	LABEL INFORMATION	
80x35	WB	5	TO KELVIN GROVE 171 SC4550/ DALLEY ST P3404/ RUSDEN ST P3408/ BLAMEY ST LP663162 AND SERVICES	
80x35	WB	5		

REFER: NETWORK LABELLING &amp; SIGNAGE-SECT.3.3 DWG.6453-A4

Rev.	Date	Revision Details	By	Ver.	App.
04	27.03.02	ISSUED FOR B.C.C. APPROVAL			
03	21.03.02	TENDER ADDENDUM NO.2			
02	25.02.02	PRELIMINARY WORKS PLAN			
01	14.02.02	PRELIMINARY CONDUIT PLAN			

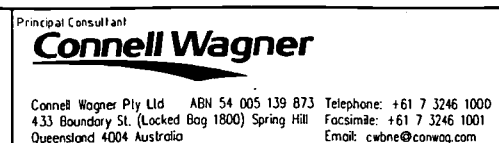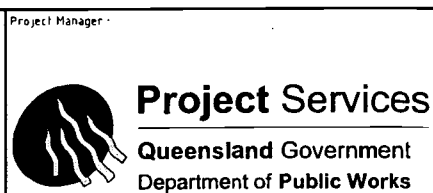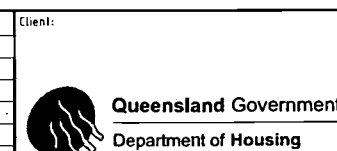

Drawn				Drawing title		CW Project No	
Original signed by	Date	Original signed by	Date	ELECTRICAL RETICULATION		0654	
Designed	Original signed by	Date	Designed	SHEET 3 OF 5			
Verified	Original signed by	Date	Verified				
Approved	Original signed by	Date	Approved				
Recommended	Original signed by	Date	Recommended				
				ENRDEX PROJECT No.			
				D1800513			
				Drawing No		Rev	
				S1B-EL-042		04	

PRELIMINARY  
kelvin grove urban village.

A1

NOTE: - ROAD LIGHTING CERTIFIED TO COMPLY WITH THE NOMINATED CATEGORIES OF AS/NZS 1158.1.1: (AND/OR AS/NZS 1158.3.1 AND/OR AS1158.1.1986). FOR LUMINAIRES AND LAMPS SUPPLIED UNDER ENERGEX CONTRACT QES1 31/98:

- INTERSECTION OF VICTORIA PARK RD & ROAD 1 : BCC STANDARD AS PER MIKE AGER FAX
- INTERSECTION OF VICTORIA PARK RD & BLAMEY ST : BCC STANDARD AS PER MIKE AGER FAX
- INTERSECTION OF VICTORIA PARK RD & ROAD 3 : BCC STANDARD AS PER MIKE AGER FAX
- MAIDSTONE ST : B2
- INTERSECTION OF BLAMEY ST & SCHOOL ST : BCC STANDARD AS PER MIKE AGER FAX


12

CERTIFIED  
ROBIN RUSSELL AND ASSOCIATES PTY LTD  
REG. PROF. CO. OF. QLD. No. 207

### Robin Russell & Associates Pty Ltd. UNDERGROUND CABLE CERTIFICATION

The cables detailed on this drawing have been checked using the cable locator described below and are, as far as can be determined, on the correct alignment and at the correct depths below the finished level, except as marked up.


Make: Metrotech Model: S860RLXT  
Serial No: 16891 Date cables located: \_\_\_\_\_  
Name: \_\_\_\_\_  
Signed: \_\_\_\_\_ Date: \_\_\_\_\_

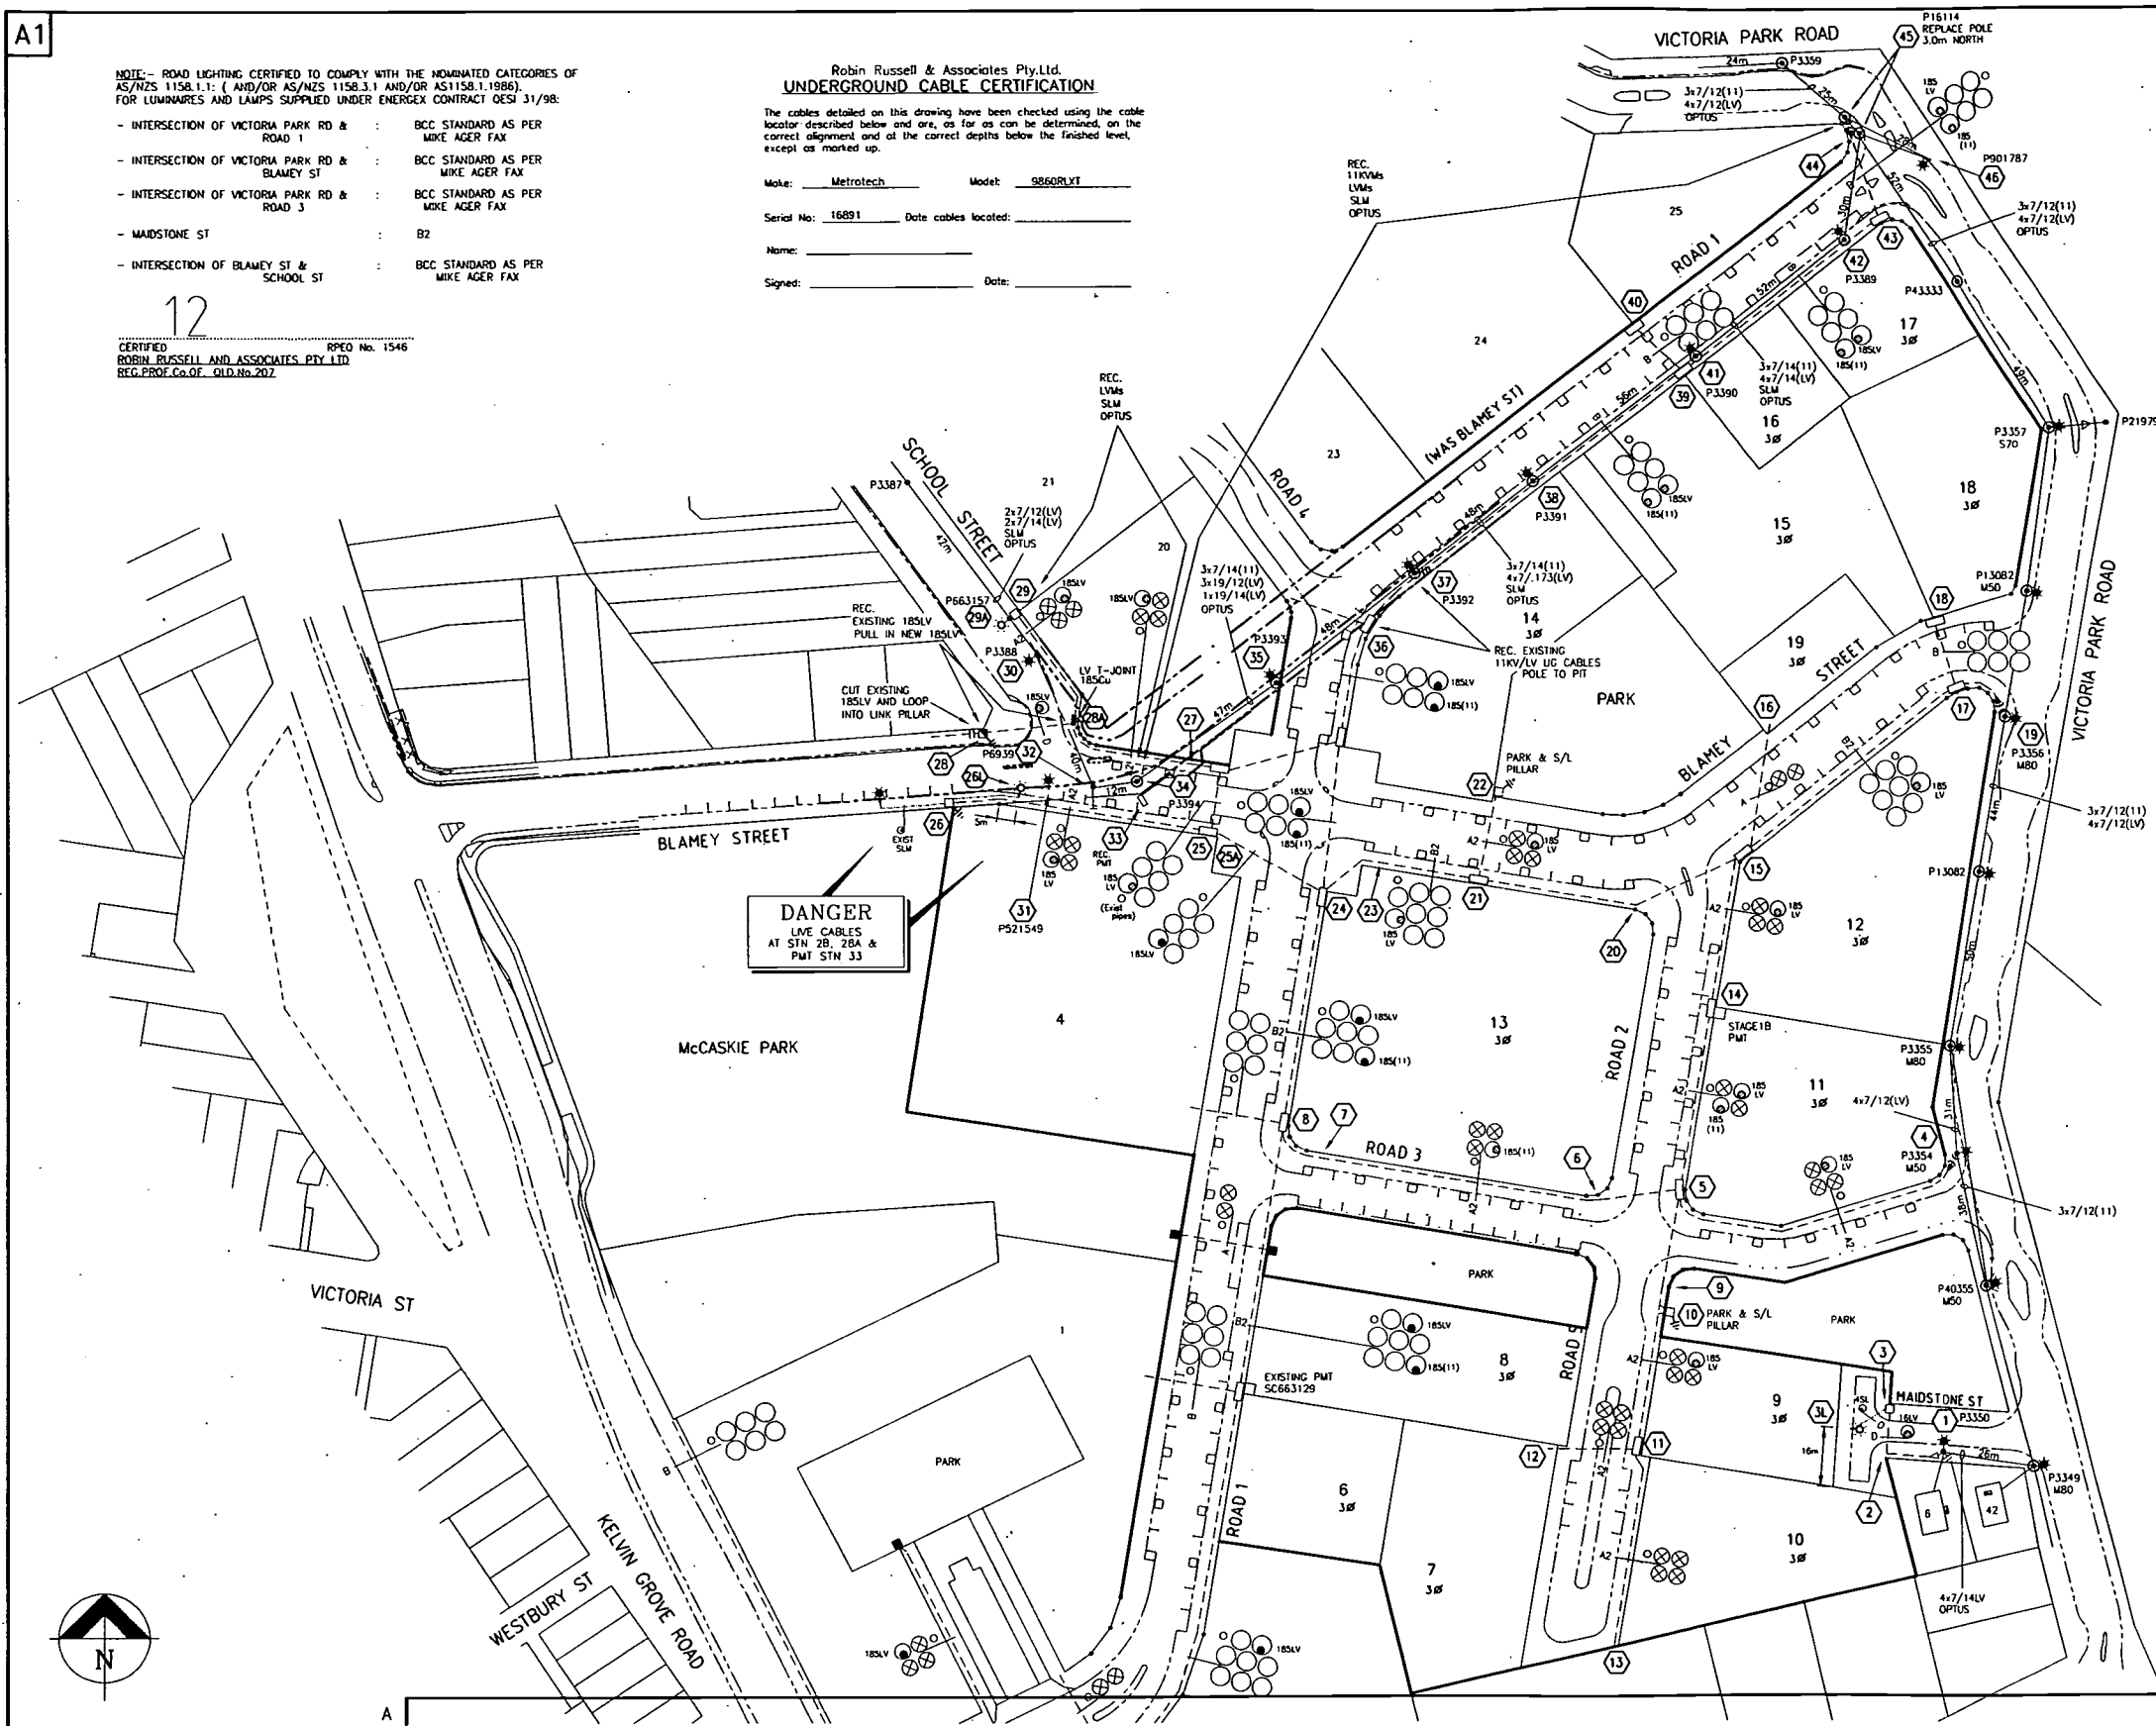

### PROP ROAD 2 PMT SC663154 (LOCATED ON ELECT. EASEMENT)

PMT SITE TO BE CONSTRUCTED BY ELECTRICAL CONTRACTOR TO ENERGEX SPECIFICATION URD DWG Nos 6493-A4, 6494-A4 AND 6496-A4. BASE SLAB IS REQUIRED.  
REFER TO ENERGEX SPECIFICATION URD DWG Nos 6499-A4, 6500-A4 AND 6501-A4 FOR EARTHING DETAILS.

### DETAIL 1

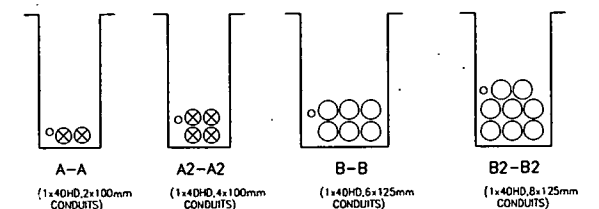

### SPECIFICATIONS

For details of trench cross-section, refer to Energex's Specification URD. Also refer to:

- UG MAINS MANUAL
- D/H CONST. MANUAL
- PUBLIC LIGHTING MANUAL

### TELSTRA INSTALLATION

Design and installation of Telstra's pipes and pits is by ALSTOM PTY LTD GLYNIS WARD - 3865 2605. Civil and electrical contractors shall coordinate with them in relation to the installation of Telstra pipes and pits in shored trenches, etc.

### ON-SITE SERVICES CHECKS

The Contractor's attention is directed to the provisions of the General Specification under: 'Care of Existing Services'.

Sewerage and water plans for the new estate may be obtained of request from the Superintendent.

The Contractor shall request on-site identification and location of existing buried services from the Queensland Call Before You Dig Services - telephone: 1100, fax: 1300 652 077. (A minimum of two days notice is required.)

### NOTE:

LARGE CONCRETE PITS TO BE BUILT BY THE CIVIL CONTRACTOR UNDER INSTRUCTION FROM THE CIVIL ENGINEERS.

ROAD NAMES NOT YET APPROVED

TARGET DATES:  
MATERIALS REQD - EARLY SEPT 2002  
SUPPLY REQD - END SEPT 2002  
PMT COLLECTION DATE: \_\_\_\_\_

AUTHOR	DRAWING	DWG. NO.	REV. NO.	DATE
CONNELL WAGNER	BASE PLAN	D65420B		12.2.02
CONNELL WAGNER				

PRELIMINARY

kelvin grove urban village.

Rev.	Date	Revision Details	By	Ver.	App.
04	27.03.02	ISSUED FOR B.C.C. APPROVAL			
03	21.03.02	TENDER ADDENDUM NO.2	GVF		
02	11.03.02	PRELIMINARY WORKS PLAN	EW		
01	25.02.02	PRELIMINARY CONDUITS PLAN	EW		

Client:  
**Queensland Government**  
Department of Housing



Project Manager  
**Project Services**  
Queensland Government  
Department of Public Works

Principal Consultant  
**Connell Wagner**

Connell Wagner Pty Ltd ABN 54 005 139 873 Telephone: +61 7 3246 1000  
433 Boundary St. (Locked Bag 1800) Spring Hill Facsimile: +61 7 3246 1001  
Queensland 4004 Australia Email: cwbne@connellwagner.com

Sub-Consultants:




Drawn	Original signed by	Date
E.W.		
Designed	Original signed by	Date
B.W.		
Verified	Original signed by	Date
Approved		Date
Recommended		Date

Drawing Title  
**ELECTRICAL RETICULATION**  
SHEET 1 OF 5  
ENERGEX PROJECT No.  
**D1800513**

CW Project No  
**0654**  
Scale  
Drawing No  
**S1B-EL-040**  
Rev  
**04**

A1

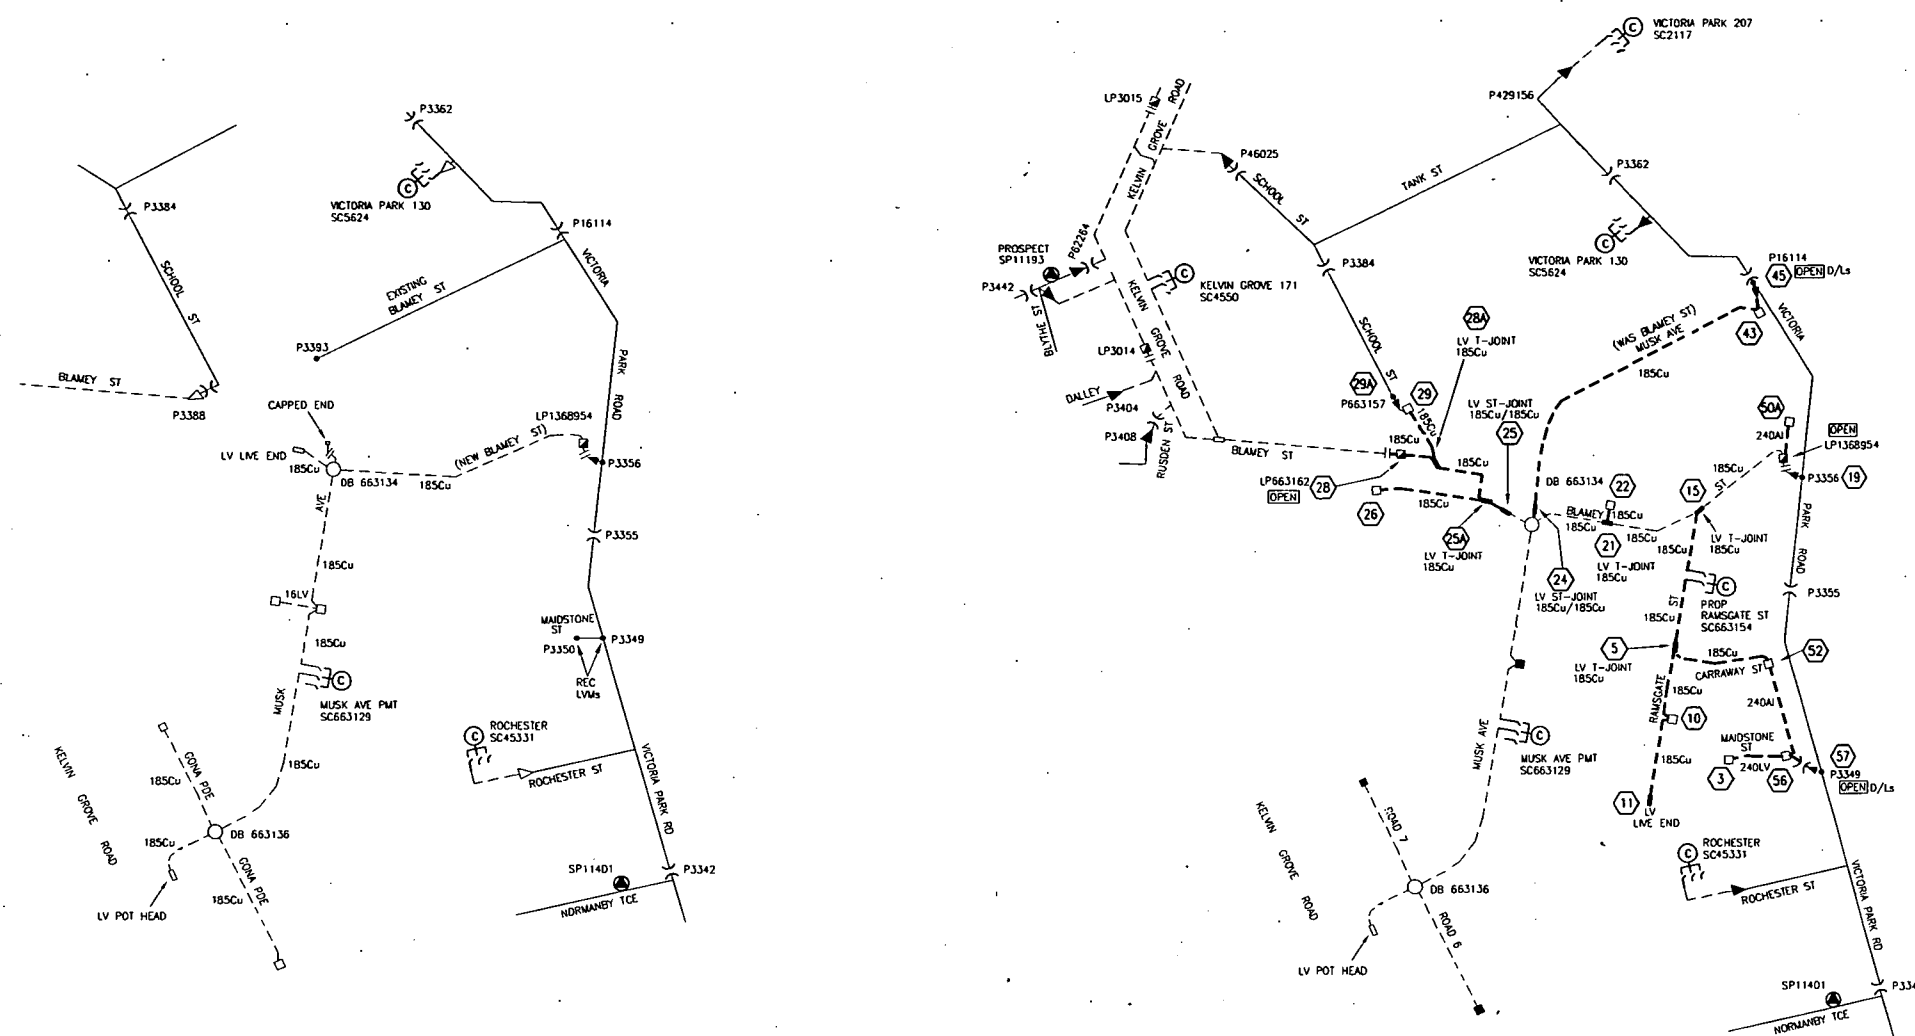

EXISTING LV SCHEMATIC  
SCALE 1:2500

THIS LV SCHEMATIC ASSUMES  
THAT STAGE 1B EARLY WORKS  
(RECOVERY OF BLAMEY ST PMT)  
HAS BEEN COMPLETED.

PROP LV SCHEMATIC  
SCALE 1:2500

**LEGEND**

- EXISTING STREET LIGHT
- PROPOSED STREET LIGHT
- EXISTING SERVICE PILLAR
- PROPOSED SERVICE PILLAR
- LINK PILLAR
- DISCONNECT BOX
- CONC. PIT
- EXISTING UG CABLE
- PROPOSED UG CABLE
- PROPOSED O/H MAINS
- MEN
- LV POLE
- LV/11KV POLE
- 40mm CONDUIT
- 125mm CONDUIT

**LV POLE LABEL**

LABEL SIZE	SITE LOCATION FOR ATTACHING OF LABEL	LABEL INFORMATION
300x100	POLE No. 663157 LOC. SCHOOL ST	LV CABLE TEE BLAMEY ST LP663162/ MUSK AVE DB663134 AND SERVICES

REFER: NETWORK LABELLING & SIGNAGE-SECT.3.4 DWG.6448-A4

**LV POLE LABEL**

LABEL SIZE	SITE LOCATION FOR ATTACHING OF LABEL	LABEL INFORMATION
300x100	POLE No. 3404 LOC. DALLEY ST	LV CABLE TEE KELVIN GROVE 171 SC4550/ RUSSEN ST P3404/ KELVIN GROVE LP3014/ BLAMEY ST LP663162 AND SERVICES

REFER: NETWORK LABELLING & SIGNAGE-SECT.3.4 DWG.6448-A4

**LV POLE LABEL**

LABEL SIZE	SITE LOCATION FOR ATTACHING OF LABEL	LABEL INFORMATION
300x100	POLE No. 3408 LOC. RUSSEN ST	LV CABLE TEE KELVIN GROVE 171 SC4550/ DALLEY ST P3404/ KELVIN GROVE LP3014/ BLAMEY ST LP663162 AND SERVICES

REFER: NETWORK LABELLING & SIGNAGE-SECT.3.4 DWG.6448-A4

**LV POLE LABEL**

LABEL SIZE	SITE LOCATION FOR ATTACHING OF LABEL	LABEL INFORMATION
300x100	POLE No. 16114 LOC. VICTORIA PARK RD	LV CABLE TO MUSK AVE DB663134 AND SERVICES

REFER: NETWORK LABELLING & SIGNAGE-SECT.3.4 DWG.6448-A4

**LV POLE LABEL**

LABEL SIZE	SITE LOCATION FOR ATTACHING OF LABEL	LABEL INFORMATION
300x100	POLE No. 3349 LOC. VICTORIA PARK RD	LV CABLE TO RAMSGATE ST SC663154 AND SERVICES


REFER: NETWORK LABELLING & SIGNAGE-SECT.3.4 DWG.6448-A4

**PMT: ABB LV SWITCHBOARD LABEL**  
STATION No: SC663154 RAMSGATE ST, KELVIN GROVE

CIRCUIT No	LABEL SIZE	LABEL COLOUR	LETTER SIZE	LABEL INFORMATION
1	80x80	WB	6	TRANSFORMER ISOLATOR
2	80x35	WB	5	TEE VICTORIA PARK RD LP1368954/ MUSK ST DB663134 AND SERVICES
3	80x35	WB	5	TO VICTORIA PARK RD P3349 AND SERVICES
4	80x35	WB	5	

REFER: NETWORK LABELLING & SIGNAGE-SECT.3.5 DWG.6455-A4

FOR LABEL DETAILS SEE ABOVE

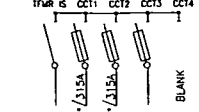


**PMT: ABB LV SWITCHBOARD LABEL**  
STATION No: SC4550 KELVIN GROVE 171

CIRCUIT No	LABEL SIZE	LABEL COLOUR	LETTER SIZE	LABEL INFORMATION
1	80x80	WB	6	TRANSFORMER ISOLATOR
2	80x35	WB	5	TO BLAMEY ST LP663162/ RUSSEN ST P3404/ DALLEY ST P3404/ KELVIN GROVE RD LP3014 AND SERVICES
3	80x35	WB	5	
4	80x35	WB	5	

REFER: NETWORK LABELLING & SIGNAGE-SECT.3.5 DWG.6455-A4

FOR LABEL DETAILS SEE ABOVE

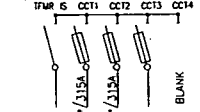

LV LABEL ORDERING SHEET:  
DISCONNECT BOX

STATION No: DB 663134 LOCATION: MUSK ST KELVIN GROVE

LABEL SIZE	LABEL COLOUR	LETTER SIZE	LABEL INFORMATION
180x40	WB	5	TO VICTORIA PARK RD P16114 AND SERVICES
180x40	WB	5	TEE RAMSGATE ST SC663154/ BLAMEY ST LP1368954 AND SERVICES
180x40	WB	5	
180x40	WB	5	TEE BLAMEY ST LP663162/ SCHOOL RD P663157 AND SERVICES

REFER: NETWORK LABELLING & SIGNAGE-SECT.3.5 DWG.6454-A4

LV LABEL ORDERING SHEET:  
LINK PILLAR (NEW TYPE)

STATION No: LP663162 LOCATION: BLAMEY ST KELVIN GROVE

LABEL SIZE	LABEL COLOUR	LETTER SIZE	LABEL INFORMATION
80x35	WB	5	TO KELVIN GROVE 171 SC4550/ DALLEY ST P3404/ RUSSEN ST P3408/ KELVIN GROVE RD LP3014 AND SERVICES
80x35	WB	5	TO SCHOOL RD P663157/ MUSK ST DB663134 AND SERVICES

REFER: NETWORK LABELLING & SIGNAGE-SECT.3.5 DWG.6453-A4

LV LABEL ORDERING SHEET:  
LINK PILLAR (NEW TYPE)

STATION No: LP3014 LOCATION: KELVIN GROVE

LABEL SIZE	LABEL COLOUR	LETTER SIZE	LABEL INFORMATION
80x35	WB	5	TO KELVIN GROVE 171 SC4550/ DALLEY ST P3404/ RUSSEN ST P3408/ BLAMEY ST LP663162 AND SERVICES
80x35	WB	5	

REFER: NETWORK LABELLING & SIGNAGE-SECT.3.5 DWG.6453-A4

LV LABEL ORDERING SHEET:  
LINK PILLAR (NEW TYPE)

STATION No: LP1368954 LOCATION: VICTORIA PK RD KELVIN GROVE

LABEL SIZE	LABEL COLOUR	LETTER SIZE	LABEL INFORMATION
80x35	WB	5	TO VICTORIA PARK RD P3356 DIRECT
80x35	WB	5	TEE RAMSGATE SC663154/ MUSK ST DB663134 AND SERVICES

REFER: NETWORK LABELLING & SIGNAGE-SECT.3.5 DWG.6453-A4

Rev.	Date	Revision Details	By	Ver.	App.	Client:	Project Manager:	Principal Consultant:	KELVIN GROVE URBAN VILLAGE STAGE 1B - KELVIN GROVE
G	9.12.02	11KV CABLE ROUTE CHANGED - SOME CONCRETE PIT CHANGES - UNDERGROUNDING HOUSE No6 MAIDSTONE ST				Queensland Government Department of Housing	Queensland Government Department of Public Works	Connell Wagner Connell Wagner Pty Ltd ABN 54 005 139 873 Telephone: +61 7 3246 1000 433 Boundary St. (Locked Bag 1800), Spring Hill Facsimile: +61 7 3246 1001 Queensland 4004 Australia Email: cwbne@connwag.com	Drawn: ELAINE WILLIAMSON Date: 25.2.02 Designed: BILL WILLIAMSON Date: 25.2.02 Checked: 12 Date: 12.3.02 Approved: Date: 12.3.02 Recommended: Date: 12.3.02 Dept. of Public Works
F	14.11.02	EARLY WORKS - RECOVERY OF BLAMEY STREET PMT							Drawing Title: ELECTRICAL RETICULATION
E	18.10.02	ADDITIONAL ROAD X-ING & PIT BETWEEN STN 38A & 38B 40mmHO S/L CONDUIT DELETED IN AREAS WHERE RATE 3 S/Ls ARE PROPOSED.							Scale: 1:1000
D	14.10.02	FINAL WP - ALLOTMENT BOD. CHANGERS							ENERGEX PROJECT No: D1800531
C	25.3.02	WP SUBMITTED TO ENERGEX							Drawing No: 2353-03G
B	11.3.02	PRELIMINARY WORKS PLAN							Rev: 1
A	25.2.02	PRELIMINARY CONDUIT PLAN							SHEET 3 OF 7

A1

LIGHTING SCHEDULE METERED

LOCATION	STN No	SITE ID POLE No	POLE COMPONENTS					LUMINAIRE					OUTREACH BRACKET					MOUNT HT (m)	COORD		REMARKS		
			COMP ID	EXIST (m)	REC (m)	ERECT (m)	SLM OR BN	DIST. FROM KERB OR PATH (m)	COMP ID	EXIST (m)	RECOVER		ERECT		SLM OR BN	EXIST (m)	REC (m)		ERECT (m)	SLM OR BN		E (m)	N (m)
											LUMINAIRE PATH (m)	CUST	LUMINAIRE PATH (m)	CUST									
McCASKIE PK	261					3.6 BPM		0.3				H70L3					-			3.6			
	262					3.6 BPM		0.3				H70L3					-			3.6			
	263					3.6 BPM		0.3				H70L3					-			3.6			
	264					3.6 BPM		0.3				H70L3					-			3.6			
	265					-		-				H250					-			0.0			UPLIGHTER
	266					-		-				H250					-			0.0			UPLIGHTER
	267					-		-				H250					-			0.0			UPLIGHTER
	268					-		-				H250					-			0.0			UPLIGHTER
	269																						NOT USED
	270					3.6 BPM		0.3				H70L3					-			3.6			
	271																						NOT USED
	272					-		-				H250					-			0.0			UPLIGHTER
	273											H250					-			0.0			UPLIGHTER
	274																						NOT USED
	275					3.6 BPM		0.3				H70L3					-			3.6			

NOTES

1 REFER DRAWING E-005 FOR LEGEND & GENERAL NOTES.

UNDERGROUND CONDUIT SCHEDULE


LOCATION	STN No FROM - TO	CONDUIT LENGTH (m)			BENDS						TRENCH & BACKFILL				MARKER TAPE	PLUGS	DRAW WIRE	KERB MARKERS	REMARKS
		50mm HD	100mm HD	125mm HD	50mm HD	100mm HD	125mm HD	50mm HD	100mm HD	125mm HD	LENGTH (m)	WIDTH (m)	DEPTH (m)	MODEL ID					
McCASKIE PK	277 - 278	5									5	0.3	0.7		5		7		
	278 - 261	150									150	0.3	0.7		150		152		
	263 - 275	15									15	0.3	0.7		15		17		USE COMMON TRENCH WHERE POSSIBLE
	278 - 273	150									150	0.3	0.7		150		152		USE COMMON TRENCH WHERE POSSIBLE
	278 - 280	135									135	0.3	0.7		135		137		USE COMMON TRENCH WHERE POSSIBLE
	278 - 266	160									160	0.3	0.7		160		162		USE COMMON TRENCH WHERE POSSIBLE

UNDERGROUND CABLE SCHEDULE

LOCATION	STN No FROM TO	VOLTS	EXIST	REC	INSTALL	SIZE & DESCRIPTION				REMARKS
						2C06	2C10	2C15	2C25	
McCASKIE PK	277 - 278	240			X				5	
	278 - 261	240			X		150			
	263 - 275	240			X		15			
	278 - 273	240			X		150			
	278 - 280	240			X			135		
	278 - 266	240			X		160			

EQUIPMENT SCHEDULE

LOCATION	STN No / s	SITE ID	EXIST	REC	INSTALL	SIZE & DESCRIPTION	SLM or INN	PLANT No	MODEL ID	QTY	REMARKS
McCASKIE PK	263				X	No. 4 PIT				1	
	274				X	No. 4 PIT				1	
	278				X	No. 4 PIT				1	
	279				X	No. 4 PIT				1	

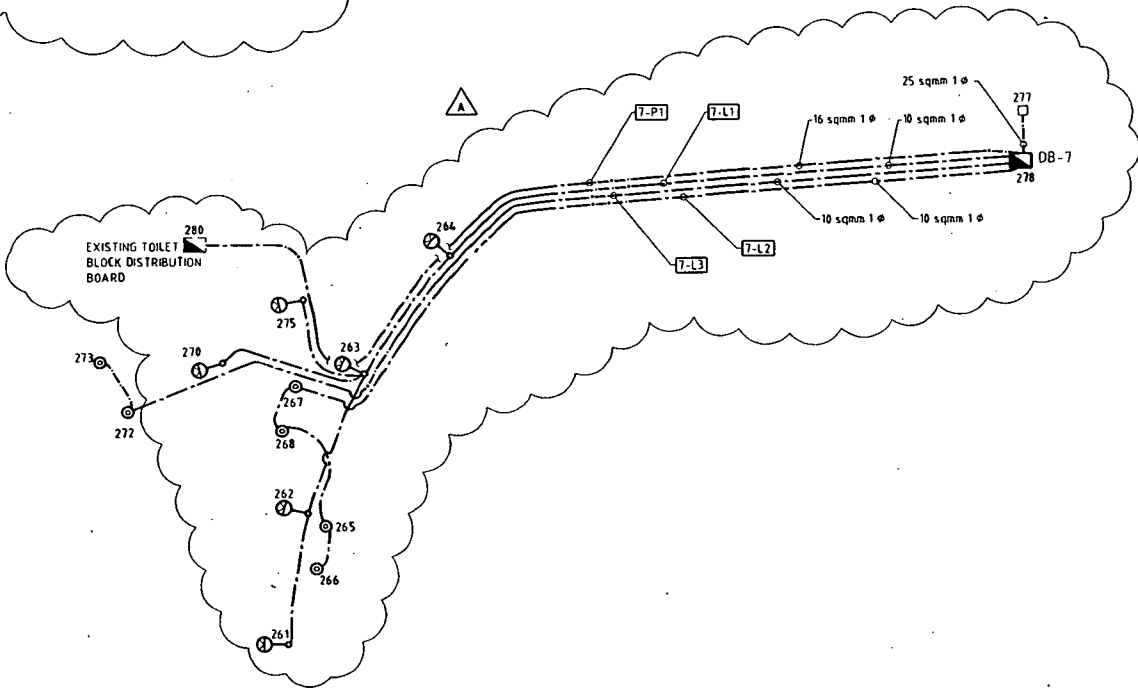



S.L.D. - 7  
N.T.S

FOR CONSTRUCTION  
kelvin grove urban village.

Rev.	Date	Revision Details	By	Ver.	App.
A	27.05.03	ISSUED FOR CONSTRUCTION	JAR		
01	24.01.03	TENDER ISSUE	JSB		


Client:

 **Queensland Government**  
Department of Housing

 **QUT**

A person using Connell Wagner drawings and other data accepts the risk of:  
1. using the drawings and other data in electronic form without requesting and checking them for accuracy against the original hard copy versions.  
2. using the drawings or other data for any purpose not agreed to in writing by Connell Wagner.

Project Manager:

 **Project Services**  
Queensland Government  
Department of Public Works

Principal Consultant:

**Connell Wagner**

Connell Wagner Pty Ltd ABN 54 005 139 873 Telephone: +61 7 3246 1000  
433 Boundary St. (Locked Bag 1800) Spring Hill Facsimile: +61 7 3246 1001  
Queensland 4004 Australia Email: cwbne@cnwag.com

Sub-Consultants:

 **URS**  **Robinson**  **HUMPHREYS REYNOLDS PERKINS**  **HASSELL**

- kelvin grove urban village.

Drawn JSB	Original signed by	Date	Drawing Title  ELECTRICAL SERVICES McCASKIE PARK LIGHTING SHEET 3 OF 3	CW Project No  065450BX	
Designed JKL	Original signed by	Date		Scale  N.T.S A1	
Verified AWJ	Original signed by	Date		Drawing No  E-007	
Approved KJG		Date		Rev  A	
Recommended		Date			
Dept. of Public Works					

A1

NOTE: ROAD LIGHTING CERTIFIED TO COMPLY WITH THE NOMINATED CATEGORIES OF AS/NZS 1158.1.1: (AND/OR AS/NZS 1158.3.1 AND/OR AS 1158.1.1986) FOR LUMINAIRES AND LAMPS SUPPLIED UNDER ENERGEX CONTRACT DESI 31/98:



- INTERSECTION OF VICTORIA PARK RD & MUSK AVE : BCC STANDARD AS PER MIKE AGER FAX
- INTERSECTION OF VICTORIA PARK RD & BLAMEY ST : BCC STANDARD AS PER MIKE AGER FAX
- INTERSECTION OF VICTORIA PARK RD & CARRAWAY ST : BCC STANDARD AS PER MIKE AGER FAX
- MADSTONE ST : B2
- INTERSECTION OF BLAMEY ST & SCHOOL ST : BCC STANDARD AS PER MIKE AGER FAX

12  
CERTIFIED  
ROBIN RUSSELL AND ASSOCIATES PTY LTD  
REG. PROF. Co. OF. QLD No. 207

### UNDERGROUND CABLE CERTIFICATION

The cables detailed on this drawing have been checked using the cable locator described below and are, as far as can be determined, on the correct alignment and at the correct depths below the finished level, except as marked up.

Make: Metrotech Model: 9850RLXT  
Serial No: 16891 Date cables located: \_\_\_\_\_  
Name: \_\_\_\_\_ Date: \_\_\_\_\_  
Signed: \_\_\_\_\_

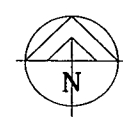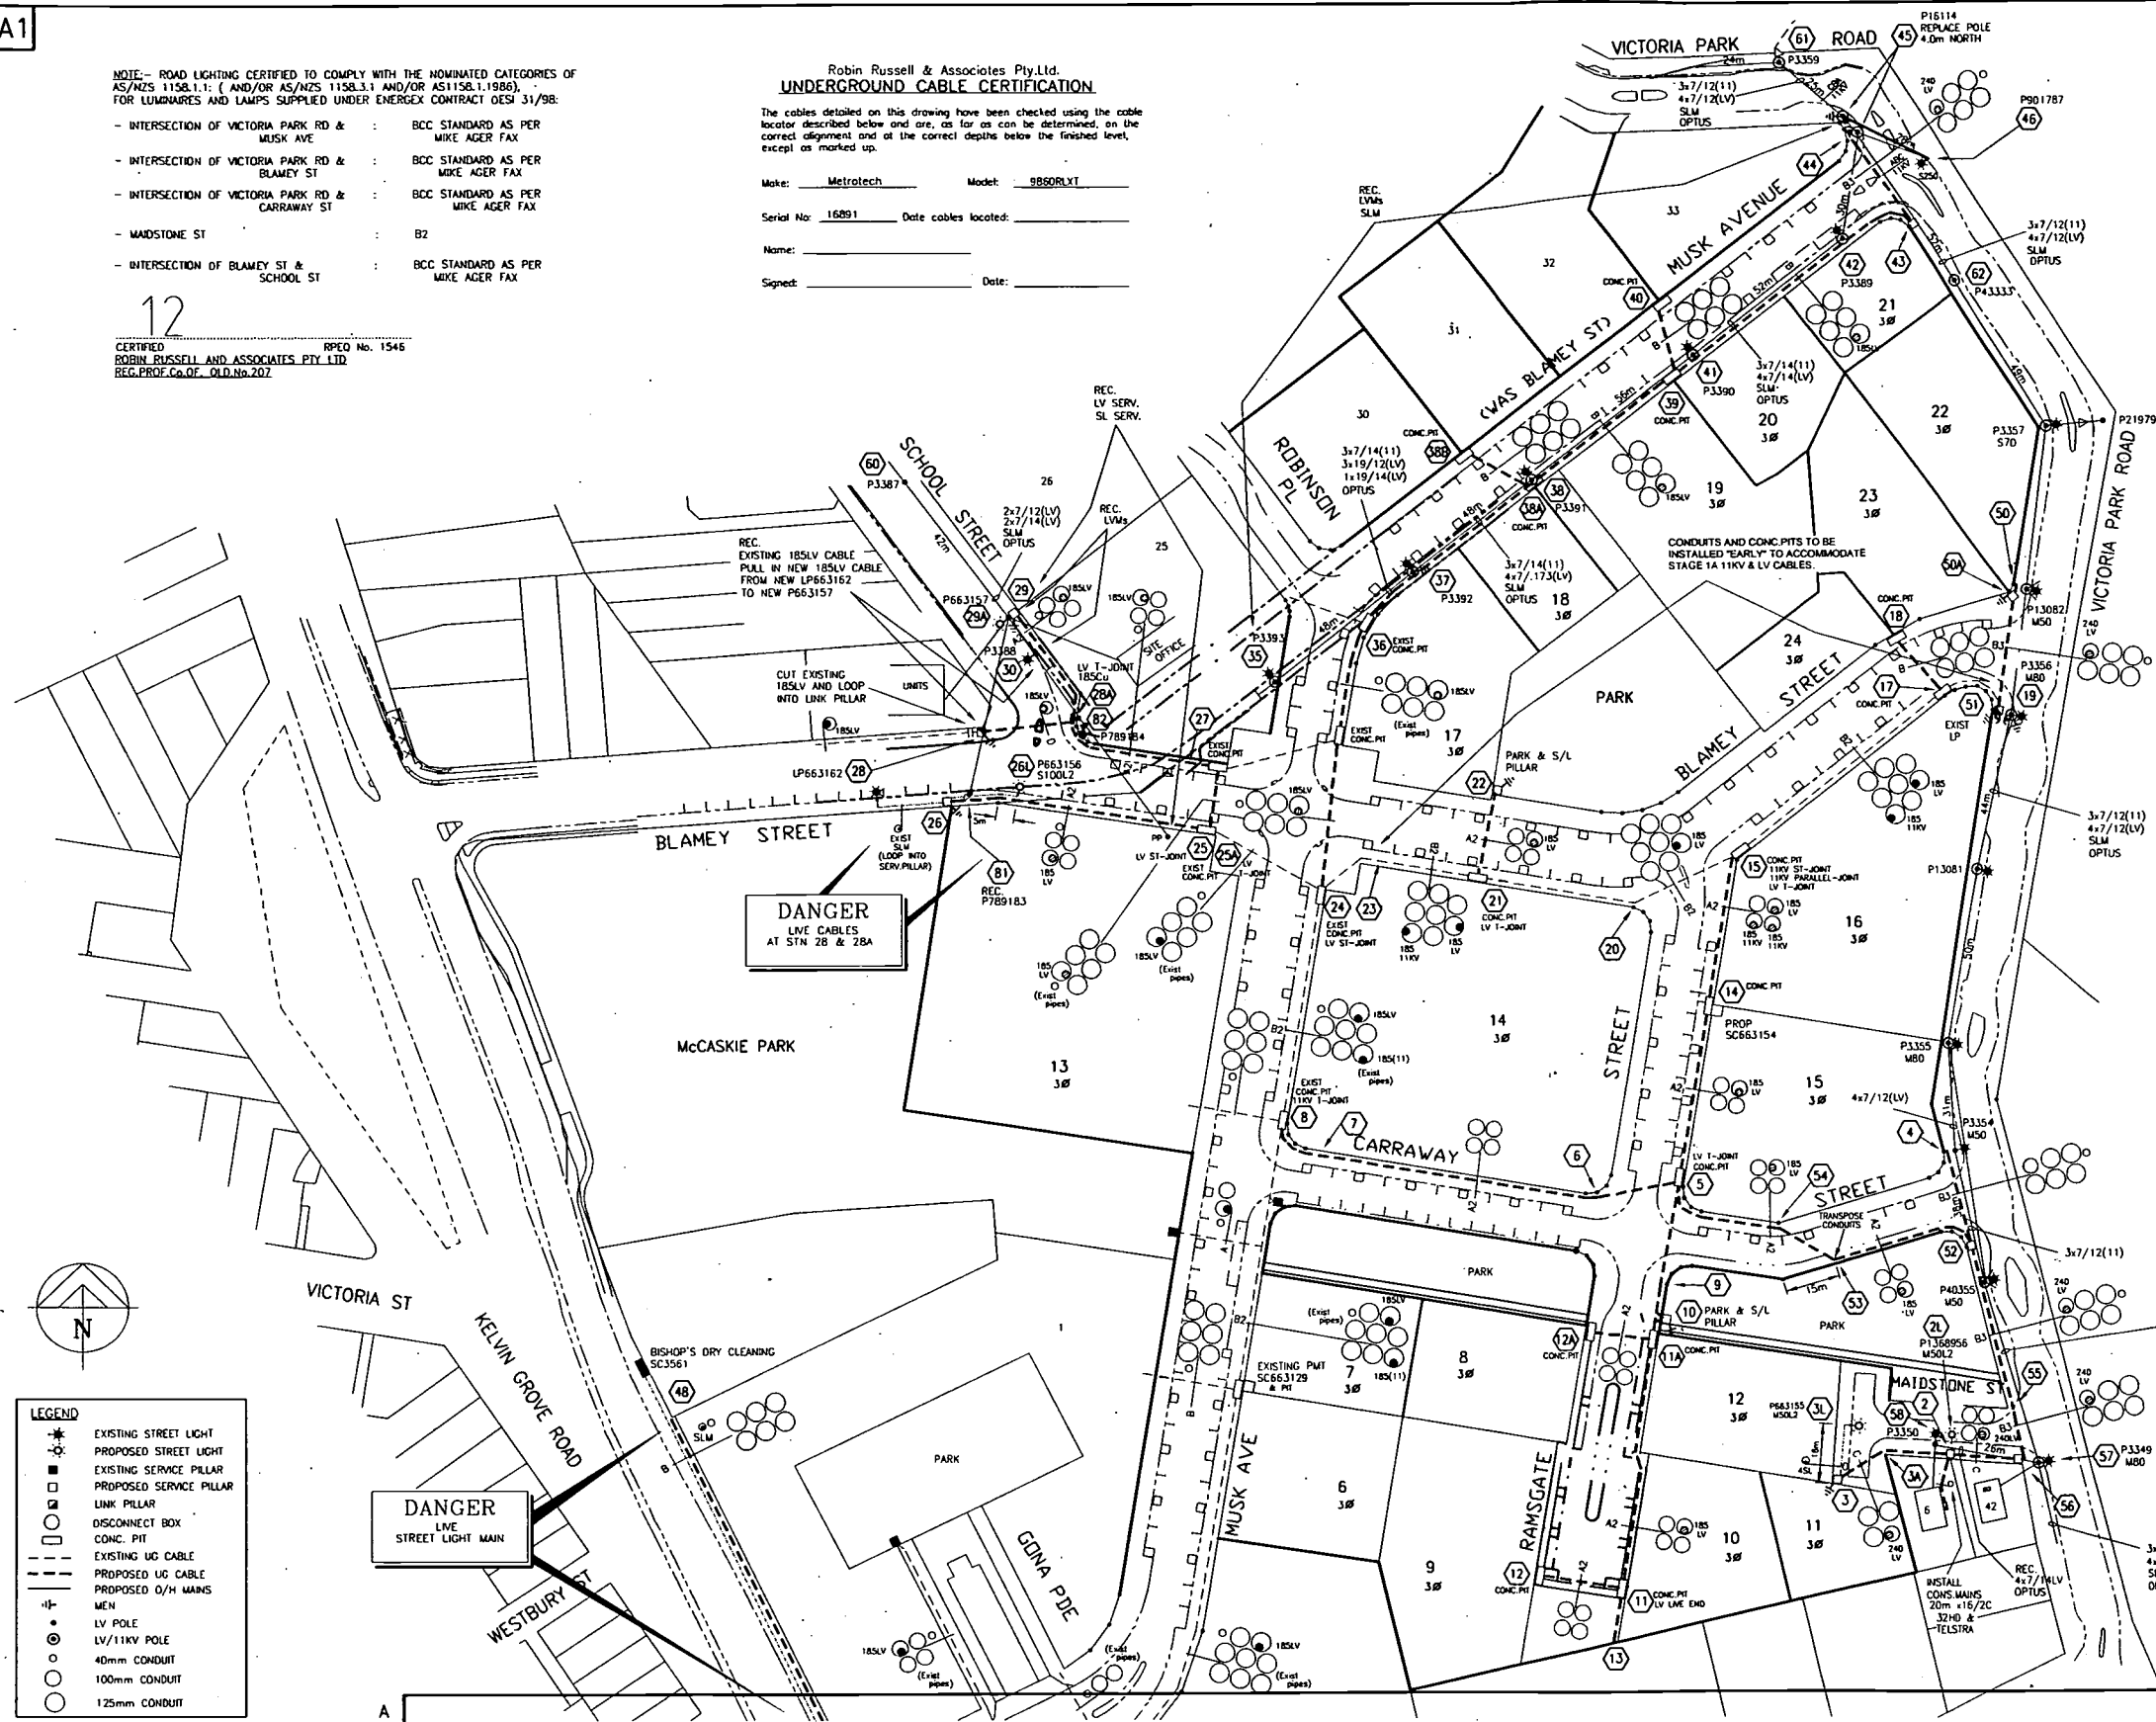


LEGEND
EXISTING STREET LIGHT
PROPOSED STREET LIGHT
EXISTING SERVICE PILLAR
PROPOSED SERVICE PILLAR
LINK PILLAR
DISCONNECT BOX
CONC. PIT
EXISTING UG CABLE
PROPOSED UG CABLE
PROPOSED O/H MAINS
MAN
LV POLE
LV/11KV POLE
40mm CONDUIT
100mm CONDUIT
125mm CONDUIT

### PROP RAMSGATE ST PMT SC663154 (LOCATED ON ELECT. EASEMENT 3.0m WIDE x 3.8m DEEP)

PMT SITE TO BE CONSTRUCTED BY ELECTRICAL CONTRACTOR TO ENERGEX UNDERGROUND DISTRIBUTION CONSTRUCTION MANUAL DWG Nos 7468-A4 AND 7771-A4. BASE SLAB IS REQUIRED. REFER TO DWG Nos 7478-A4 AND 7480-A4 FOR EARTHING DETAILS.

#### DETAIL 1

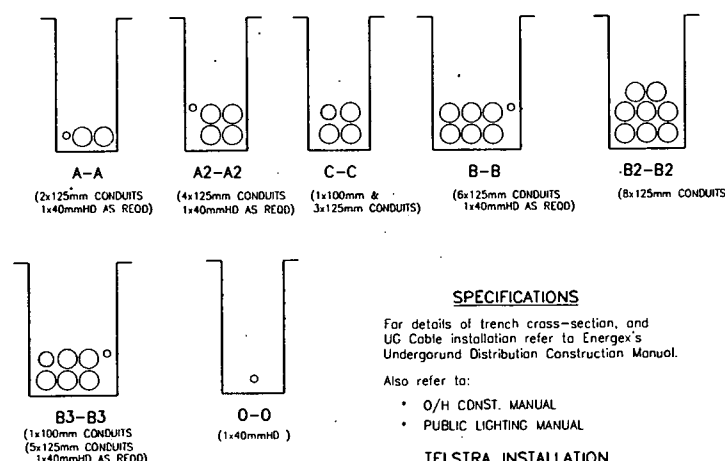

#### SPECIFICATIONS

For details of trench cross-section, and UG Cable installation refer to Energex's Underground Distribution Construction Manual.

Also refer to:

- O/H CONST. MANUAL
- PUBLIC LIGHTING MANUAL

#### TELSTRA INSTALLATION

Design and installation of Telstra's pipes and pits is by ALSTOM PTY LTD GYLYNS WARD - 3865 2605. Civil and electrical contractors shall coordinate with them in relation to the installation of Telstra pipes and pits in shared trenches, etc.

#### ON-SITE SERVICES CHECKS

The Contractor's attention is directed to the provisions of the General Specification under: "Care of Existing Services".

Sewerage and water plans for the new estate may be obtained of request from the Superintendent.

The Contractor shall request on-site identification and location of existing buried services from the Queensland Dial Before You Dig Services - telephone: 1100, fax: 1300 652 077. (A minimum of two days notice is required.)

TARGET DATES:  
MATERIALS REQD - EARLY MAR 2003  
SUPPLY REQD - END APR 2003

PMT COLLECTION DATE:

AUTHOR	DRAWING	DWG. NO.	REV. NO.	DATE
CONNELL WAGNER	BASE PLAN	065420bx		22.8.02

Rev.	Date	Revision Details	By	Ver.	App.
G	9.12.02	11KV CABLE ROUTE CHANGED - SOME CONCRETE PIT CHANGES - UNDERGROUNDING HOUSE NO6 MADSTONE ST			
F	14.11.02	EARLY WORKS - RECOVERY OF BLAMEY STREET PMT			
E	18.10.02	ADDITIONAL ROAD X-ING & PIT BETWEEN STN 38A & 38B 40mmHD S/L CONDUIT DELETED IN AREAS WHERE RATE 3 S/Ls ARE PROPOSED			
D	14.10.02	FINAL WP - ALLOTMENT BOD. CHANGERS			
C	25.3.02	WP SUBMITTED TO ENERGEX			
B	11.3.02	PRELIMINARY WORKS PLAN			
A	25.2.02	PRELIMINARY CONDUIT PLAN			

Client:  
**Queensland Government**  
Department of Housing



Project Manager:  
**Project Services**  
Queensland Government  
Department of Public Works

A person using Connell Wagner drawings and other data accepts the risk of:  
1. using the drawings and other data in electronic form without requesting and checking them for accuracy against the original hard copy versions.  
2. using the drawings or other data for any purpose not agreed to in writing by Connell Wagner.

Principal Consultant:  
**Connell Wagner**

Connell Wagner Pty Ltd ABN 54 005 139 873 Telephone: +61 7 3246 1000  
433 Boundary St. (Locked Bag 1800) Spring Hill Facsimile: +61 7 3246 1001  
Queensland 4004 Australia Email: cw@connellwagner.com.au

Sub-Consultants:

KELVIN GROVE URBAN VILLAGE STAGE 1B - KELVIN GROVE

Drawn ELAINE WILLIAMSON	Date 25.2.02	Drawing Title ELECTRICAL RETICULATION	CW Project No.
Designed BILL WILLIAMSON	Date 25.2.02	ENERGEX PROJECT No. D1800531	Scale 1:1000
Entered 12	Date 12.3.02	Drawing No. 2353-01G	Rev. SHEET 1 OF 7
Approved	Date		
Recommended	Date		

Connell Wagner Pty Ltd  
ABN 54 005 139 873  
433 Boundary Street  
(Locked Bag 1800)  
Spring Hill  
Queensland 4004 Australia

Telephone: +61 7 3246 1000  
Facsimile: +61 7 3246 1001  
Email: cw@cnwag.com  
www.cnwag.com

**Connell Wagner**

Project: Kelvin Grove Urban Village				Reference: 065430CC	
To:	Copy:	Circulate	Name:	Organisation:	Location/Facsimile:
✓			Kerry Peters	BCC - Trunk Mains Group	3407 8471
	✓		Kok Yeo	BCC Compliance North	3407 0750
		✓	MDR/JFN	Connell Wagner	Brisbane
	✓		David Makinson	Civdec Constructions	3832 4325
From: Tanya Sideris				Date: 24 September 2002	Total Pages: 2

**IMPORTANT NOTICE** The information contained in this document is **CONFIDENTIAL** and may also be **LEGALLY PRIVILEGED**, intended only for the addressee. If you are not the addressee, you are hereby notified that any use or dissemination of the information and any copying of the document is strictly prohibited. If you are not the addressee, please immediately notify us by telephone and we will arrange for the return of this document to us.

Subject: Cathodic Protection in Blamey Street


Kerry

Further to our discussions regarding the relocation of the existing cathodic protection system in Blamey Street, attached is a plan that indicates the existing McCaskie Park boundary and the new boundary for a new lot excised from McCaskie Park (relative to Blamey Street). The new lot boundary has moved (east) approximately 65-70m from the old boundary. As part of the works, we will provide a surveyed stake to locate the boundary on site.

As you are aware, the existing Energex power pole is to be eliminated in favour of proposed underground electricity. Hence, an alternative power supply is required for your system. We have indicated on the attached plan that a new pillar will be located adjacent the new lot boundary. The pillar will be built in Stage 1B. Therefore, there will be a time period between removal of pole and installation of pillar, which suggests that the cathodic protection system will be temporarily disconnected until installation of the new source and relocation of the cathodic protection system.


We will advise the time at which the power pole is due to be removed, installation of the new water main and installation of the new pillar. In the meantime, we advise organising the necessary BCC requirements to ensure a smooth transition of installation for the new protection system. Should you have any queries, please do not hesitate to contact myself (3246 1050) or Mark Reardon (3246 4341).

Regards

  
Tanya Sideris  
Engineer

LES,  
CAN YOU DO SOME  
APPROXIMATE \$ TO DO  
THE ABOVE SO WE CAN  
ASK FOR AN ORDER  
FROM TANYA  
TA  
KERRY



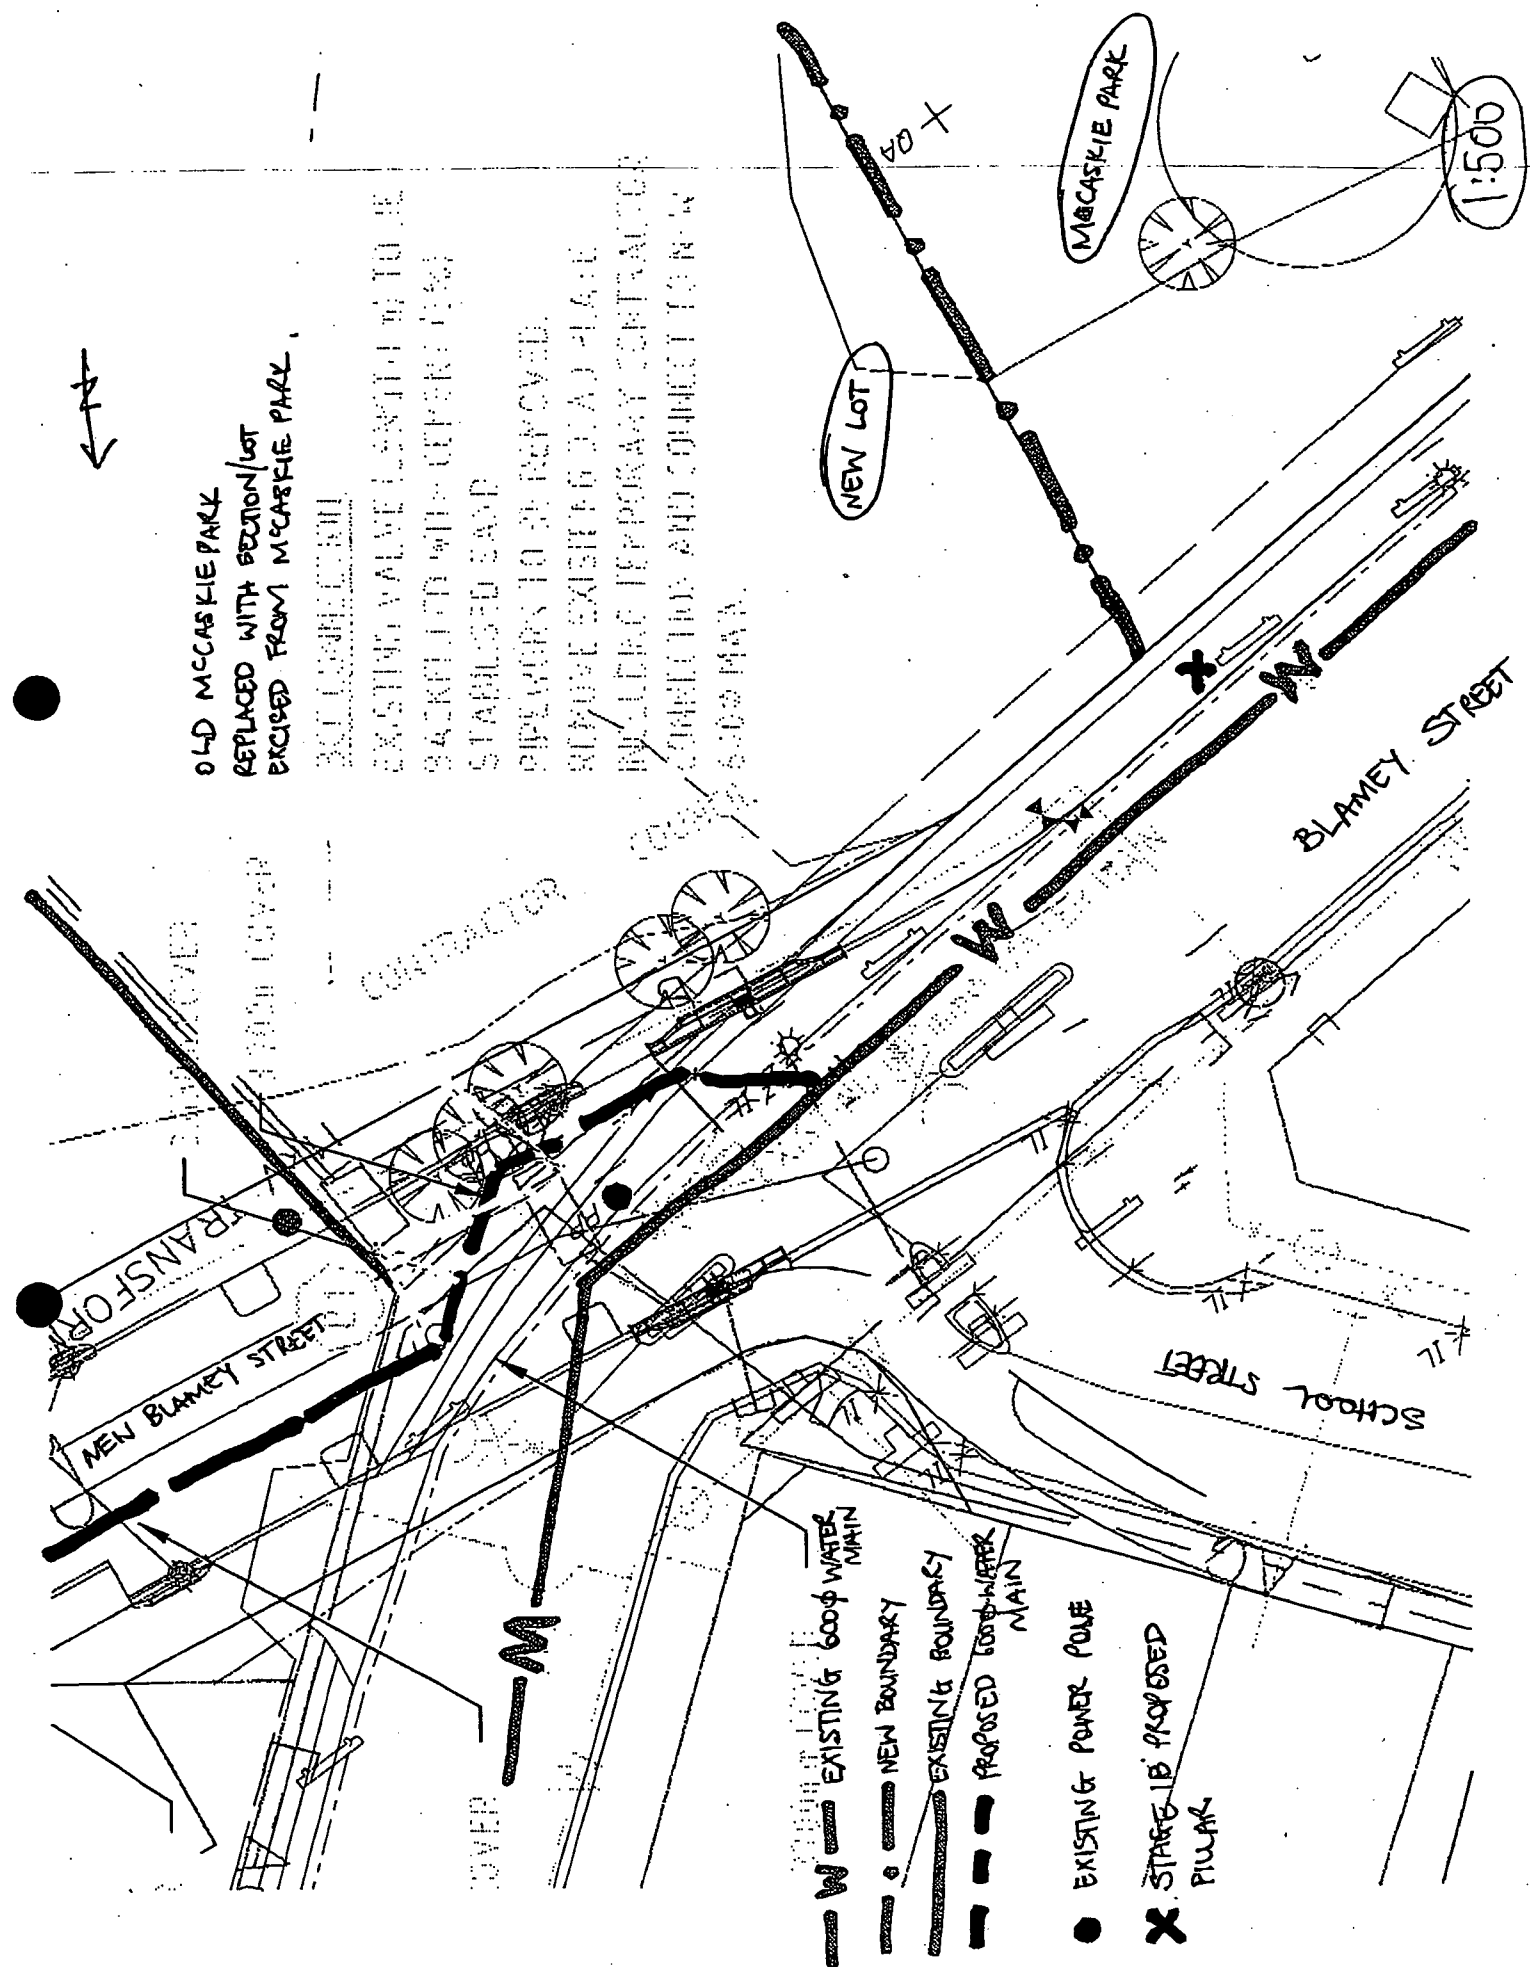



**From:** Kerry McGovern  
**To:** John Whitbourne  
**Date:** 10/9/03 11:07am  
**Subject:** Kelvin Grove Urban Village Cathodic Protection to BCC Water Main

John,

Greg Ogilvie recently did some work in regards to the above site on BCC watermain. As part of that project, some of the associated cathodic protection had to be relocated as it was located in parts of the redevelopment.

I have been in contact with Connell Wagner who are heading the development regarding a quote I gave them some time ago to reinstall the cathodic protection. This was approx \$11k. Connell Wagners reply was to do the work under the work order for Greg Ogilvies work.

Can you advise if we (M&E) can book to this work order and if so what is the number?

Thanks,

Kerry McGovern

**CC:** Les Greaves; Phil Carkeet

2 October 2003

Connell Wagner Pty Ltd  
ABN 54 005 139 873  
433 Boundary Street  
(Locked Bag 1800)  
Spring Hill  
QLD 4004 Australia

Telephone: +61 7 3246 1000  
Facsimile: +61 7 3246 1001  
Email: cwbne@conwag.com  
www.conwag.com

The General Manager  
Brisbane City Council  
GPO Box 1434  
BRISBANE QLD 4001

Attention: Mr Kerry McGovern  
Brisbane Water

Dear Sir

Kelvin Grove Urban Village  
Cathodic Protection to BCC Watermain

Project Services has approved the proposal outlined in your facsimile of 21 August 2002. (Refer copy of approval attached) We propose to do this work under the Work Order for the 600 dia watermain (please refer to Mr Greg Ogilvie of Brisbane Water).

As indicated in our correspondence of August 2002, for construction to proceed you require one (1) weeks notice. It should be realized that the civil contractor, Civdec Construction Pty Ltd, has programmed to complete earthworks in this area. Property pegs have been placed Wednesday 30 September 2003. Could you please advise when you can be on site to undertake these works.

Should you have any questions, please contact me.

Yours faithfully



Mark Reardon  
Associate

cc: Paul Krautz, Project Services  
Michael Gilligan, Rider Hunt

# BRISBANE WATER - ENGINEERING SERVICES QUOTATION FORM

Company / Client Name		Date		Quote No.		
CONNELL WAGNER		18-10-02		Prepared by		L. GREAVES
Contact Name		Phone		Sent by fax / phone / other		
TANYA SIDERIS						
Job Description		No of Pages		Accepted		YES / NO
REPOSITION BLAMEY ST RECTIFIER & ANODE BED.						
Item No	MATERIALS OR LABOUR REQUIRED	QUANTITY (No or Hrs)	SUPPLIER	UNIT COSTING	TOTAL COST + O/H%	
1	1500 x 75 SILICON IRON ANODES	4	CORR. SPECIALISTS	\$315.00	\$1260.00	
2	TELSTRA PITS & LIDS	5	BWES	\$50.00	\$250.00	
3	16mm SDI CABLE BLACK	200M.	DLEX	\$100.00	\$200.00	
4	TRENCHER 8hrs + 1hr travel	9	CITY FLEET	\$70.00	\$630.00	
5	BORE FOR ANODES "	9	J.M. CALLUM	\$70.00	\$630.00	
6	REMOVE SYSTEM. 8 1/2 hrs / 1 person	8 1/2	BWES	\$50.00	\$450.00	
7	REINSTALL SYSTEM 1WK. / 2 PERSON		BWES	\$1000 PER DAY	\$5000.00	
8	ENERGEX SUPPLY	1	ENERGEX	\$229.00	\$229.00	
9.	MATERIAL (CONDUIT, CEMENT, ETC)	Misc	BWES	\$550.00	\$550.00	

Form F 3-2E / Revision 0 / 25th August 1997

\$9199.00

+ 10% OH = \$10,000.00

## Brisbane Water Engineering Services

CP Form No. 16

Electrical Engineering Unit

## Site Plan Drawing Sheet

Project S2 ASHGROVE TO CITYDate 26-8-2002

UBD MAP 159J4 OR MAP 18 B7

PROPOSED RELOCATION OF ANODE BED M'CASKIE PARK.SKETCH NOT TO SCALESCHOOL STREMOVE RECTIFIER PITS ANODES FROM  
CURRENT LOCATION.  
EX PARK.\*NEW PILLAR BOX  
REQUIRED  
NEW CATHODE CONNECTION  
NEW RECTIFIER POSITIONHILL

MH ← 20M → (A) → 45M

CHIMNEY

READING 1.5Ω @ 5.0M. (A)  
SOIL RESISTIVITY = 47Ω/M

BLAMEY ST.

KELVIN GROVE RD.

S2 MAIN

COMPILED BY L. GREAVES

Revision 09/28/95

## Les Greaves - Blamey Street Kelvin Grove CP system.

---

From: Kerry McGovern  
To: Jeff Say; Les Greaves  
Date: 17/03/2003 11:38 AM  
Subject: Blamey Street Kelvin Grove CP system.

---

Rang Tanya from O'Connell Wagner today regarding above. She will follow up and get back to me about where the CP rectifier is and when the further works will take place. Will update you ASAP.  
Kerry

## Les Greaves - Kelvin Grove Urban Village - reconnection of cathodic protection system Blamey Street

---

**From:** <siderist@conwag.com>  
**To:** <ceesbw@brisbane.qld.gov.au>  
**Date:** 17/03/2003 12:57 PM  
**Subject:** Kelvin Grove Urban Village - reconnection of cathodic protection system Blamey Street  
**CC:** <reardonm@conwag.com>

---

Project Code : 065430cc

Attention - Kerry McGovern

Kerry

Confirming our conversation earlier today -

Reconnection of 600 water main in Blamey Street by Brisbane Water approximately 1st week April at earliest.

Installation of pillar in Blamey Street approximately June 2003

The switchboard is currently held on site by Civdec (main Contractor). You can contact Kerry Johns (project supervisor) on 0418 886 879 to arrange to pick it up.

Please call Civdec (Kevin Bell 3832 2728 Site Engineer or David Makinson 3832 2728 Project Manager) to monitor their progress and coordinate site works.

Regarding quotation, could you please send through another copy of your quotation and I will follow up our end regarding payment.

I will be on leave for 12 months from 31 March, so if you have any queries, please call Mark Reardon (3246 4341).

Regards

Tanya Sideris  
 ph + 61 07 3246 1050  
 fax + 61 07 3246 1002  
 siderist@conwag.com

---

A person using Connell Wagner drawings and other data accepts the risk of :

- \* Using the drawings and other data in electronic form without requesting and checking them for accuracy against the original hard copy version ;
- \* Using the drawings or other data for any purpose not agreed to in writing by Connell Wagner. (ABN 54 005 139 873)

This e-mail message and any attached files may hold confidential information. If you are not the intended recipient any use, disclosure or copying of this e-mail is unauthorised. If you have received this e-mail in error please notify the sender immediately by reply e-mail.

Blamey St.

Dec 02

10 V 2.5 A

Mar. 03

O. O. S.

---




08-Oct-2003 13:26

U:\SQR3\BW0100A.SQT

For Team: EEU BWES - Elect Engineering Unit

# BRISBANE WATER - ENGINEERING SERVICES

## BACKLOG REPORT FOR EEU FOR PERIOD 01-Jul-2002 to 07-Oct-2003

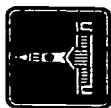Brisbane City  
Page 12 of 12

Worder	Description	Status	Work	Problem	EstLabHrs	ActLabHrs	Reported	TgtStart	ActStart	TgtComp	Freq
--------	-------------	--------	------	---------	-----------	-----------	----------	----------	----------	---------	------

GRAND TOTAL - BACKLOG WORK ORDERS = 290      Total Hours: 1023.90      917.76