



25 Bunya Street

Eagle Farm Q

4009

Ph. (07) 3403 8888

Fx. (07) 3403 1898

16th April 2004

OPERATING MANUAL FOR:

**TARRAGINDI to WYNNUM RD
to LYTTON RD
TRUNK MAINS
S54 and S35 TRUNK MAINS**

CATHODIC PROTECTION SYSTEM

CLIENT:

**BRISBANE WATER
WATER SYSTEM SERVICES**

MANUAL CONTENTS

(1.0)	Introduction
(2.0)	Corrosion and Cathodic Protection
(3.0)	Mains Details
(4.0)	Cathodic Protection
(4.1)	Type of System
(4.2)	Rectifier
(4.3)	Cathode
(4.4)	Anodes
(4.5)	Test Points
(4.6)	Associated Drawings
(4.7)	Associated Standards
(4.8)	Government Regulations
(5.0)	Performed Testing
(6.0)	Conclusion
(7.0)	Maintenance

DRAWINGS

486/6/25-AA1C0021E	Standard Rectifier Wiring Diagram
(No Number)	Bimonthly Maintenance Program

(1.0) INTRODUCTION

Steel when immersed or covered in water has a tendency to corrode (or rust) as the oxidized form is more stable than the metal.

Because of this, precaution must be taken to stop or minimize the corrosion reaction to an acceptable level consistent with the design life of the structure. This is normally achieved by the use of protective coatings which control the corrosion reaction by isolating the steel from its surrounding environment.

However, it is not practical to achieve a perfect coating and coating damage will always occur with time. Because of this, corrosion may occur at imperfections in the paint coating, causing further deterioration in the coating as well as loss of metal.

As a result of this, the coating defects must be rectified by periodic maintenance or an additional method of protection used to prevent this deterioration and corrosion occurring. This additional protection is achieved by the cathodic protection system.

(2.0) CORROSION AND CATHODIC PROTECTION

Corrosion is an electrochemical process in that it is accompanied by a flow of electrical current.

Corrosion occurs on the surface of metals at active areas known as anodes, which are electrically continuous with less active or passive areas known as cathodes. The electric current flows from the anode through the electrolyte to the cathode, with the circuit being completed by the electrical continuity between the cathode and anode. In practice anodes and cathodes are generally part of the same metallic surface and individual anodic areas may be small.

In applying cathodic protection an external current is applied to the surface so that the entire surface to be protected acts as a cathode. This involves the use of an auxiliary anode and when the current flow from this anode is sufficient, no part of the structure acts as an anode.

An external source of direct current such as a transformer rectifier is used in conjunction with an anode consisting of material with a very slow corrosion rate.

While it is the flow of current which achieves the cathodic protection of the surface it is impractical to measure these currents over individual anodic areas to determine when cathodic protection has been achieved. However, with the flow of cathodic protection current, the structure becomes more negative with respect to the surrounding electrolyte. Because of this, it is possible to state values of metal/electrolyte potential at which corrosion does not occur. This metal/electrolyte potential is generally measured against a standard reference electrode which allows a reproducible potential at which corrosion does not occur to be quoted.

(3.0)

MAINS DETAILS

Size: 1060, 910 and 600 mm Dia mild steel cement lined.

Coating: Enamel Coated.

Length: Appox 11.6 Km.

Location: From Valve 188 cnr Tarragindi Rd.and Autumn St. Tarragindi
to Valve 214 Lytton Rd. Murarrie.

Construction

Drawings:

486/1/22-C0024E Cathodic Protection Standard Switchboard Cabinet

486/1/22-AAT0001E Cathodic Protection Test Points

(4.0) CATHODIC PROTECTION DETAILS**(4.1) Type of Cathodic Protection: Impressed Current.****(4.2) Rectifier:** Standard 30 Volt, 30 amp direct current output enclosed in a stainless steel switchboard. This system has 2 rectifiers installed. One rectifier is in Mott Park, corner Logan Rd. and Abbotsleigh St. Holland Park and has a 240V supply from Mott Park toilet block. The second rectifier is in Majestic Park Camp Hill and has a 240V supply from Energex pole No12681 near 70 Eva St Camp Hill.**(4.3) Cathode:** One cathode point is located on the 1060 mm dia mains, adjacent to scour valve 514 in Mott Park, while the second cathode point is located on the 910 mm dia mains adjacent to valve 200 at Majestic Park.. The cathode point is where the cabling from the rectifier is attached to the structure under cathodic protection.**(4.4) Anodes:** Four 1500 x 75mm silicone iron anodes were installed approximately 90 metres from the trunk mains, in a vertical bed 5 metres deep, in the park adjacent to the stormwater drain in Mott Park. Another four anodes were installed approximately 100 metres from the trunk main in a vertical bed 5 metres deep in Majestic Park. The anodes are backfilled with cokebreeze thereby improving anode - ground resistance. The anodes are identified by a marker post and label. See layout drawing.**(4.5) Test Points:** Test points are installed on cathodically protected structures to enable testing to ensure full protection of the mains. On these mains eighteen test points have been installed on the trunk main which can be identified from the layout drawing.**(4.6) Associated Drawings:**

Cathodic Protection Test Point Details	- 486/1/22-AAT0001E
Standard Rectifier Wiring Diagram	- 486/6/25-AA1C0021
Cathodic Protection Test Point & Anode	- 2 / 10.677-01 to 2 / 10.677-05
Bed Locations S54 & S35 Trunk Mains.	- 2 / 10.2315-01

(4.7) Associated Standards:

AS/NZS 3000	2000	Electrical Installations
AS/NZS 2832.1	1998	Cathodic Protection of Metals-Pipes and Cables.

(4.8) Government Regulations:

Queensland	Electricity	Safety	Rules	and	Regulations.	2002
------------	-------------	--------	-------	-----	--------------	------

(5.0)

PERFORMED TESTING

- (1) Natural Potential Survey.
- (2) Testing of Insulated Flanges, Joints.
- (3) Soil Resistance Testing.
- (4) Current Drain Survey.
- (5) Pipe Coating Anomaly Survey.
- (6) Rectifier Loop Resistance.
- (7) Foreign Structure Interference Survey and Mitigation.
- (8) Final Potential Survey and Commissioning.

(6.0)

CONCLUSION

Full Cathodic protection has been achieved on this section of trunk mains. The cathodic protection system is registered with the Electrical Safety Office, Department of Industrial Relations, and has approval to operate.

(7.0)

MAINTENANCE

The cathodic protection system is maintained on a bimonthly basis after commissioning. These checks involve testing rectifier operation and recording of pipe to soil potentials.

16th April, 2004.

Cathodic Protection Unit.

CPS Bimonthly Maintenance Details.

Required:

- 1/ Notify plant operator and/or sign entry logs where necessary.
- 2/ Have appropriate keying.

Labour:

One tradesperson, one vehicle. 20 minutes per site.

Procedure:

- 1/ Identify installation.
- 2/ Check system for operation.
- 3/ Record voltmeter.
- 4/ Record ammeter.
- 5/ Comments.
- 6/ Log entry.

16th April, 2004.

Cathodic Protection Unit

CPS 6 Monthly Maintenance Details.

Required:

- 1/ Notify plant operator and/or sign entry logs where necessary.
- 2/ Have appropriate keying.
- 3/ Set of tools. (Electricians)
- 4/ Multimeter.
- 5/ DC clampmeter.
- 6/ Copper sulphate reference cell and leads.
- 7/ Cleaning equipment.
- 8/ Gatic cover lifters.

Labour:

One tradesperson electrical, one laborer, one vehicle.

Two hours per site.

Procedure:

- 1/ Identify system.
- 2/ Check system for operation.
- 3/ Record voltmeter.
- 4/ Record ammeter.
- 5/ Record "on" potentials for all test points.
- 6/ Record "instant off" potentials for all test points.
- 7/ Record "off" potentials for all test points.
- 8/ Perform loop resistance and record.
- 9/ Check and record anode string currents.
- 10/ Comments.
- 11/ Log entry.

16th April, 2004.

Cathodic Protection Unit

CPS 60 Monthly Maintenance Details.

Required:

- 1/ Notify plant operator and/or sign entry logs where necessary.
- 2/ Have appropriate keying.
- 3/ Set of tools. (Electricians)
- 4/ Multimeter.
- 5/ DC clampmeter.
- 6/ Copper sulphate reference cell and leads.
- 7/ Cleaning equipment.
- 8/ Gatic cover lifters.
- 9/ Rectifier load bank.
- 10/ PCS2000 Detection Equipment.

Labour:

One tradesperson electrical, one laborer, one vehicle.
Eight hours per site.

Procedure:

- 1/ Identify system.
- 2/ Check system for operation.
- 3/ Record voltmeter.
- 4/ Record ammeter.
- 5/ Record "on" potentials for all test points.
- 6/ Record "instant off" potentials for all test points.
- 7/ Record "off" potentials for all test points.
- 8/ Perform loop resistance and record.
- 9/ Check and record anode string currents.
- 10/ Load test rectifier for 10 minutes.
- 11/ Check all switchboard and testpoint terminals for tightness.
- 12/ Check all switchboard and testpoints are labelled and I.D. tags attached.
- 13/ Check plans are correctly drawn and modify if necessary.
- 14/ Remove and inspect anodes.
- 15/ Recheck all interference (CPS) bleeds.
- 16/ Pipecamp structure if applicable.
- 17/ Apply to reregister system if applicable

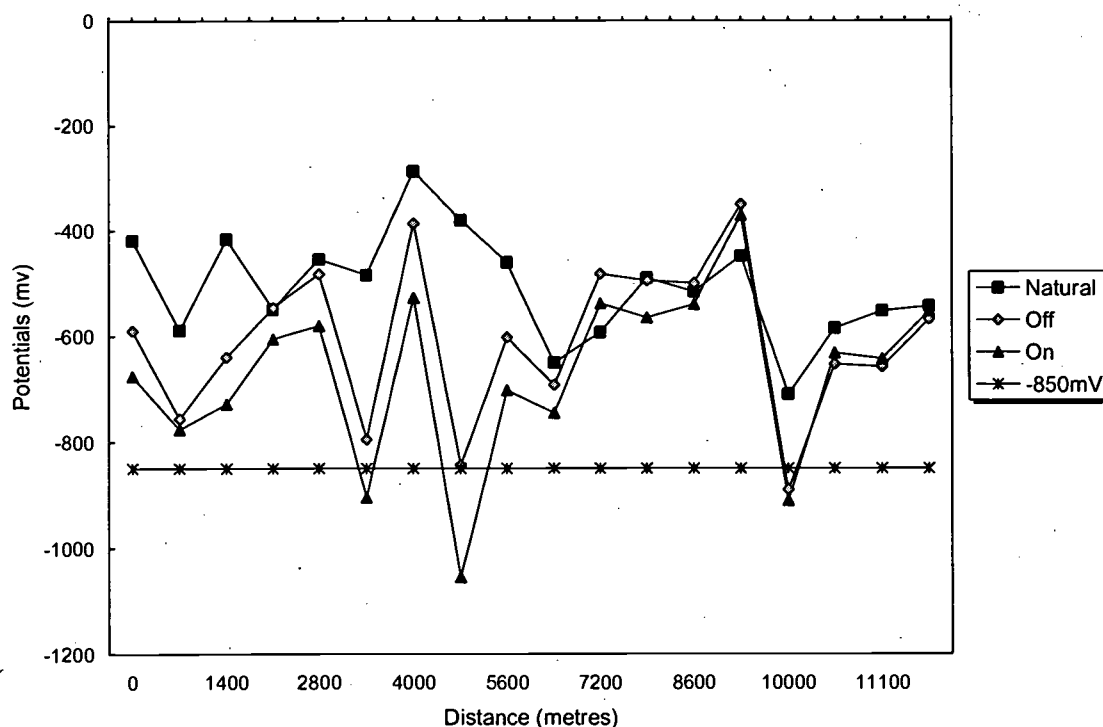
Brisbane Water Engineering Services

CP Form No. 23

Electrical Engineering Unit**Cathodic Protection System Potential Recording Form****Project** Tarragindi to Wynnum Rd. to Lytton Rd S35&S54**Date** 16th June 2004

Test Point Nos 1 to 15 are S54 and Test Points 16 to 18 are S35

Test Point number	Distances to T.P. (metres)	Potentials to CuSO ₄			Distance
		Natural (mV)	Off (mV)	On (mV)	
1	0	-419	-590	-676	0
2	700	-589	-756	-776	700
3	1400	-416	-640	-728	1400
4	1900	-549	-546	-605	1900
5	2800	-454	-482	-580	2800
6	3400	-484	-795	-905	3400
7	4000	-287	-386	-527	4000
8	4800	-380	-844	-1055	4800
9	5600	-460	-602	-702	5600
10	6400	-650	-692	-745	6400
11	7200	-593	-482	-538	7200
12	7900	-490	-495	-565	7900
13	8600	-516	-500	-540	8600
14	9200	-448	-350	-371	9200
15	10000	-710	-890	-910	10000
16	10400	-585	-653	-632	10400
17	11100	-552	-658	-643	11100
18	11600	-543	-568	-552	11600

Rectifiers at
TPs.No6&8**Graph of potentials vs pipelength**

Revision 18/05/2005

Brisbane Water Engineering Services

CP Form No. 23

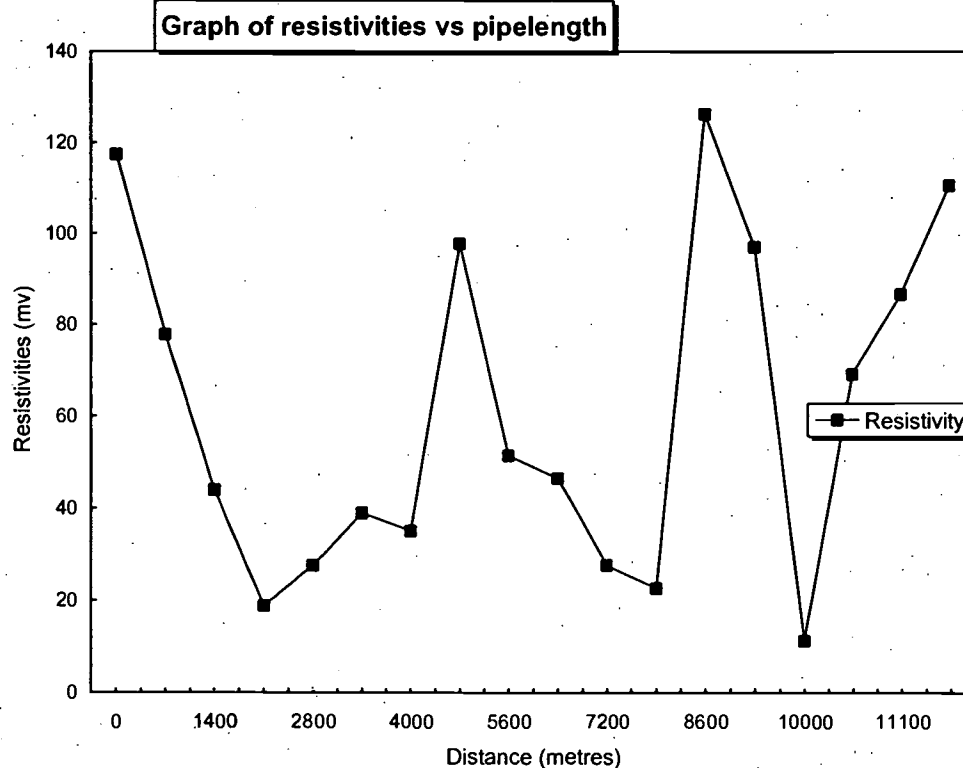
Electrical Engineering Unit**Cathodic Protection System Resistivities Recording Form****Project** Tarragindi to Wynnum Rd. to Lytton Rd. S35 & S54**Date** 16th June 2004

Test Point number	Distances to T.P.	Resistivities at 2 metres
	(metres)	ohm metres
1	0	117.4
2	700	77.8
3	1400	43.9
4	1900	18.8
5	2800	27.6
6	3400	38.9
7	4000	35.1
8	4800	97.7
9	5600	51.4
10	6400	46.4
11	7200	27.6
12	7900	22.6
13	8600	126.3
14	9200	97
15	10000	11.3
16	10400	69.1
17	11100	86.6
18	11600	110.5

Note.

Test Points 1 to 15 are for S54

Test Points 16,17 & 18 are for S35



Brisbane Water Engineering Services

Electrical Engineering Unit

Cathodic Protection System Loop Resistance

Mott Park Rectifier CPS 202

Date: 12th May 2005

Cathodic Protection System:

Tarragindi to Wynnum Rd. S54 Trunk Main

System Operating Volts:

27

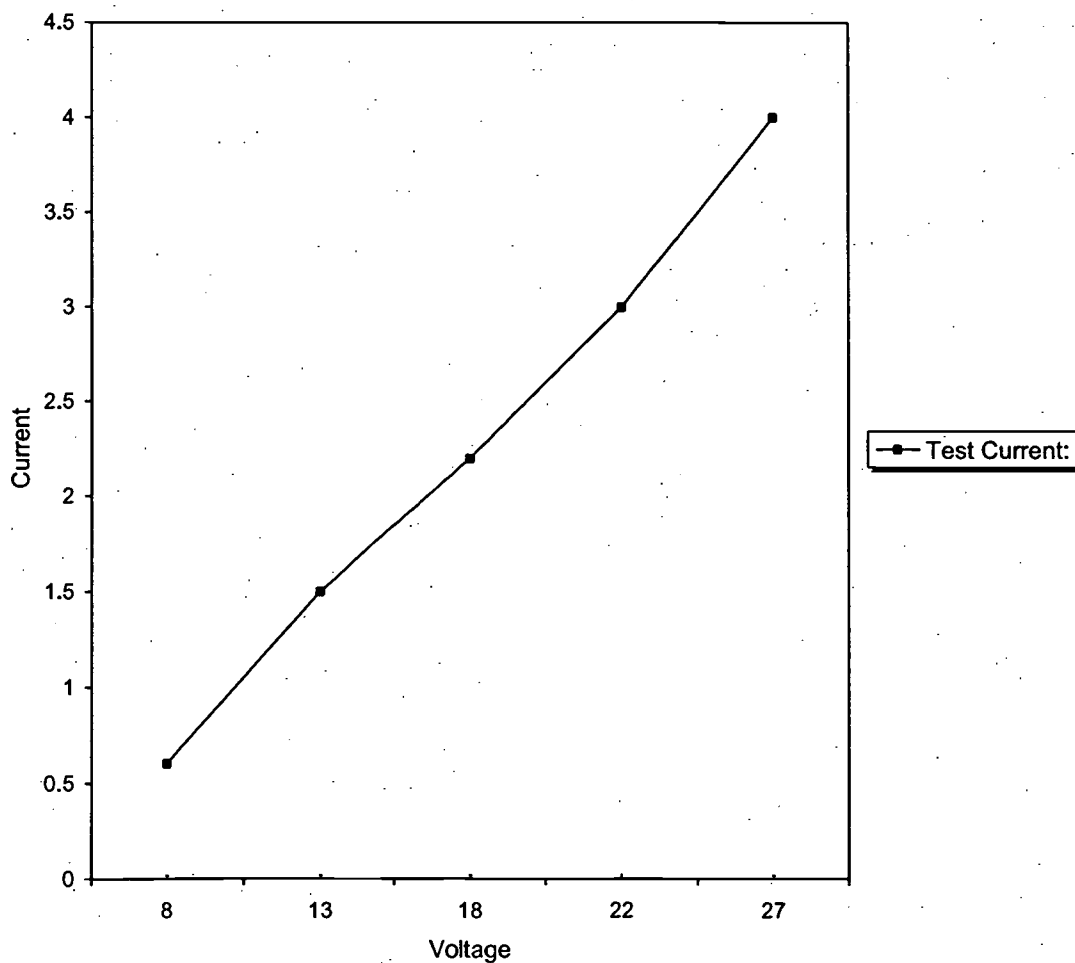
System Operating amps

4

Test Voltage:		Test Current:	
(volts)		(amps)	
8		0.6	
13		1.5	
18		2.2	
22		3	
27		4	

Loop Resistance (ohms)
5

Loop Resistance



13/05/2005

^

Brisbane Water Engineering Services

Electrical Engineering Unit

Cathodic Protection System Loop Resistance

Eva St. Rectifier CPS 206

Date: 12th May 2005

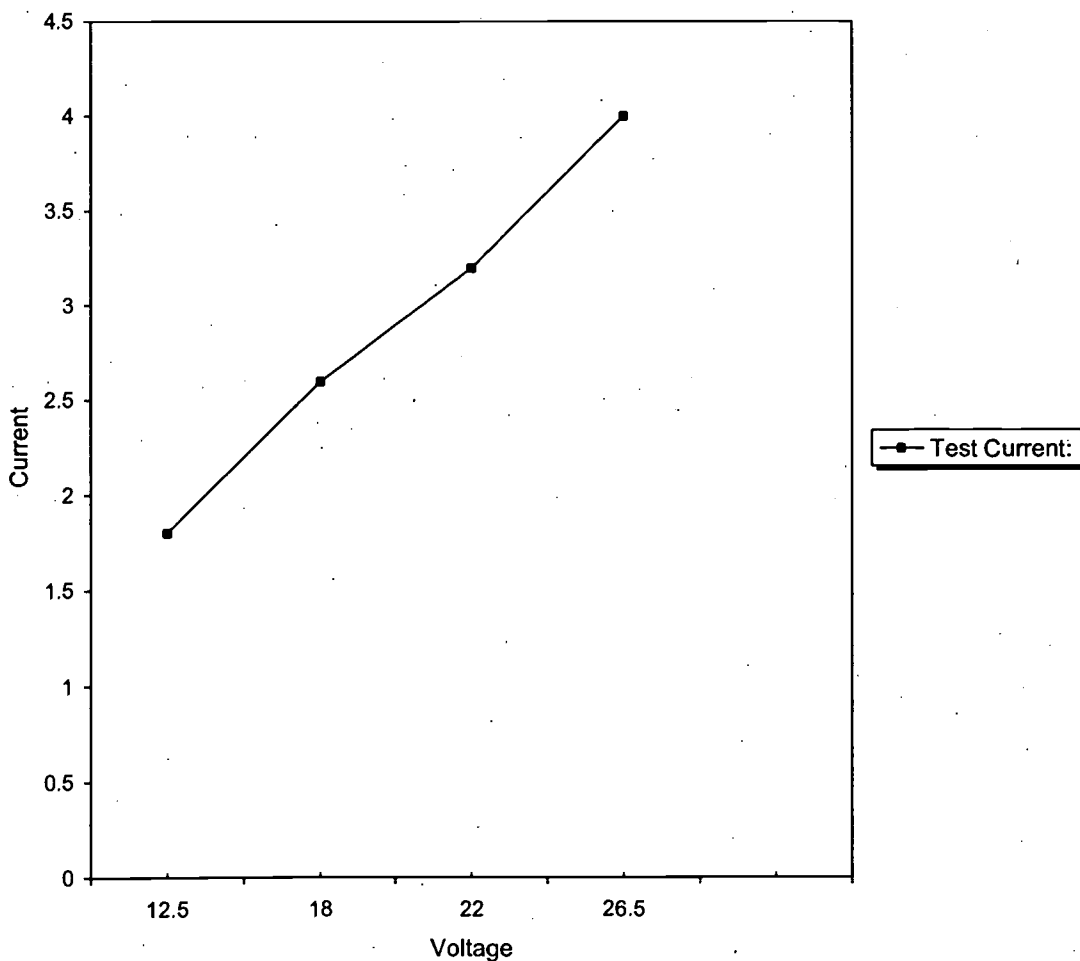
Cathodic Protection System: Tarragindi to Wynnum Rd. S54 Trunk Main

System Operating Volts: 27 System Operating amps 4.7

Test Voltage:		Test Current:	
(volts)		(amps)	
12.5		1.8	
18		2.6	
22		3.2	
26.5		4	

Loop Resistance (ohms)
6.875

Loop Resistance



18/05/2005

FORM 9
V3.01-04Department of Industrial Relations
ABN 52 293 849 579

APPLICATION TO REGISTER A REGISTERABLE CATHODIC PROTECTION SYSTEM

PLEASE COMPLETE ALL SECTIONS OF THIS FORM- PLEASE PRINT

Application Details

Name of system owner:	Brisbane City Council / Brisbane Water		
		ABN	72002765795
Postal address:	GPO Box 1434 Brisbane 4001		
Contact name:		TEL	

Name of authorised agent of system owner:	Brisbane Water Network Services		
		ABN	72002765795
Postal Address:	268 Cullen Ave Eagle Farm 4009		
Contact Name:	Kerry McGovern		
		TEL	07 34078364

Type of Application: (Tick as appropriate)			
<input checked="" type="checkbox"/> New System			
<input type="checkbox"/> Alteration to an existing system, Registration No:			
<input type="checkbox"/> Renewal of system, Registration No:			
Location of system:	From cnr Tarragindi Rd & Autumn St. Tarragindi to Lytton Rd near Metroplex Ave Murarie		
	Rectifier No1(Mott Park) Abbotsleigh St Holland Pk	POST CODE	4121
Structure to be protected:	900 mm and 1060 mm dia Mild Steel Trunk Main		
Maximum operating current:	5.00	Amperes DC	Water or Marine environment Maximum operating voltage: Volts

Declaration

I/We, being the owner/operators of the cathodic protection system described above, make application for the registration of this system and certify with respect to the system that:

- (i) I/We have complied with the requirements of Part 11 of *Electrical Safety Regulation 2002*;
- (ii) tests pursuant to section 177 of *Electrical Safety Regulation 2002*, based on the maximum operating current stated this application have been performed;
- (iii) the maximum operating voltage stated in this application in the case of the system operating with an anode/s immersed in water or a marine environment corresponds to the maximum operating current mentioned in paragraph (ii); and
- (iv) any necessary interference mitigation measures for foreign structures (in the case where the system is currently registered) have been tested and are operating satisfactorily.

Signature of system owner: Day Month Year

PRIVACY STATEMENT. The Department of Industrial Relations respects your privacy and is committed to protecting your personal information. The information provided on this form is for the purpose of applying for the registration of a cathodic protection system and monitoring compliance under the Electrical Safety Act 2002, and will be managed within the requirements of Information Standard 42. The Department may be required to disclose your personal information to other government agencies, entities, or persons as may be required by law or that are outsourced functions. This information may also be used for statistical research, information provision and evaluation of our services. We will assume that we have your permission to do this unless you tell us otherwise. You can do this at any time by contacting Equipment Safety on (07) 3237 0281. Further information on our privacy policy is available at www.dir.qld.gov.au

Application of accompany registration fee of \$205.00
Application for systems to be immersed in a marine environment must have technical schedule attached.
Forward to: Electrical Safety Office, LMB 2234 Brisbane Qld 4001
Please note: This is a GST free supply. No tax invoice will be issued.

FORM 9
V3.01-04Department of Industrial Relations
ABN 52 293 849 579

APPLICATION TO REGISTER A REGISTERABLE CATHODIC PROTECTION SYSTEM

PLEASE COMPLETE ALL SECTIONS OF THIS FORM- PLEASE PRINT

Application Details

Name of system owner:	Brisbane City Council / Brisbane Water		
		ABN	72002765795
Postal address:	GPO Box 1434 Brisbane 4001		
Contact name:		TEL	

Name of authorised agent of system owner:	Brisbane Water Network Services		
		ABN	72002765795
Postal Address:	268 Cullen Ave Eagle Farm 4009		
Contact Name:	Kerry McGovern		
		TEL	07 34078364

Type of Application: (Tick as appropriate)			
<input checked="" type="checkbox"/>	New System		
<input type="checkbox"/>	Alteration to an existing system, Registration No:		
<input type="checkbox"/>	Renewal of system, Registration No:		
Location of system:	From cnr Tarragindi Rd & Autumn St. Tarragindi to Lytton Rd near Metroplex Ave Murarie		
	Rectifier No2 (Majestic Park) Eva St Coorparoo	POST CODE	4151
Structure to be protected:	900 mm and 1060 mm dia Mild Steel Trunk Main		
Maximum operating current:	6.00	Amperes DC	Water or Marine environment Maximum operating voltage: Volts

Declaration

I/We, being the owner/operators of the cathodic protection system described above, make application for the registration of this system and certify with respect to the system that:

- (i) I/We have complied with the requirements of Part 11 of *Electrical Safety Regulation 2002*;
- (ii) tests pursuant to section 177 of *Electrical Safety Regulation 2002*, based on the maximum operating current stated this application have been performed;
- (iii) the maximum operating voltage stated in this application in the case of the system operating with an anode/s immersed in water or a marine environment corresponds to the maximum operating current mentioned in paragraph (ii); and
- (iv) any necessary interference mitigation measures for foreign structures (in the case where the system is currently registered) have been tested and are operating satisfactorily.

Signature of system owner: Day Month Year

PRIVACY STATEMENT. The Department of Industrial Relations respects your privacy and is committed to protecting your personal information. The information provided on this form is for the purpose of applying for the registration of a cathodic protection system and monitoring compliance under the Electrical Safety Act 2002, and will be managed within the requirements of Information Standard 42. The Department may be required to disclose your personal information to other government agencies, entities, or persons as may be required by law or that are outsourced functions. This information may also be used for statistical research, information provision and evaluation of our services. We will assume that we have your permission to do this unless you tell us otherwise. You can do this at any time by contacting Equipment Safety on (07) 3237 0281. Further information on our privacy policy is available at www.dir.qld.gov.au

Application of accompany registration fee of \$205.00

Application for systems to be immersed in a marine environment must have technical schedule attached.

Forward to: Electrical Safety Office, LMB 2234 Brisbane Qld 4001

Please note: This is a GST free supply. No tax invoice will be issued.


Queensland Government

Department of Industrial Relations

Electrical Safety Act 2002

NOTICE OF REGISTRATION OF CATHODIC PROTECTION SYSTEM

Registration No: 3332
Date of Registration: 01 March 2006

Expiry Date: 01 March 2011

The cathodic protection system referred to below has been registered for a term of five years, and the conditions of registration shown hereunder shall apply in addition to the provisions of the Electrical Safety Act and Electrical Safety Regulation 2002.

Name and Postal Address of System Owner	Brisbane City Council Brisbane Water GPO Box 1434 BRISBANE QLD 4001
Location of System	From Cnr Tarragindi Rd and Autum St Tarragindi to Lytton Rd near Metroplex Ave Murarie Rectifier No1 (Mott Park) Abbotsleigh St Holland Park - Post Code: 4121
Structure to be Protected	Mild Steel Trunk Main

CONDITIONS OF REGISTRATION

Maximum Operating Current:
5.00 Amperes DC

DES EDE
Director – Equipment Safety

21/3/2006



Queensland Government

Department of Industrial Relations

Electrical Safety Act 2002

NOTICE OF REGISTRATION OF CATHODIC PROTECTION SYSTEM

Registration No: 3335

Date of Registration: 01 March 2006

Expiry Date: 01 March 2011

The cathodic protection system referred to below has been registered for a term of five years, and the conditions of registration shown hereunder shall apply in addition to the provisions of the Electrical Safety Act and Electrical Safety Regulation 2002.

Name and Postal Address of System Owner	Brisbane City Council Brisbane Water GPO Box 1434 BRISBANE QLD 4001
Location of System	From Cnr Tarragindi Rd and Autumn St Tarragindi to Lytton Rd near Metroplex Ave Murarrie Rectifier No2 (Majestic Park) Eva St Coorparoo - Post Code: 4151
Structure to be Protected	Mild Steel Tunk Main

CONDITIONS OF REGISTRATION

Maximum Operating Current:

6.00 Amperes DC

[Signature]
DES EDE

Director – Equipment Safety

21312006

Brisbane Water Engineering Services

CP Form No. 27

Electrical Engineering Unit

Cathodic Protection Interference Survey Results Form

Tarragindi to Wynnum Rd

Eva ST. 27V 6a

Mott Park 27V 5a

Project S54

Unit Reading

Date 5-5-05

	Reading	Test Point I.D.	Location	Swing
On	-1040	-	Mott Park	
Off	-594	Light	Park Light	-446
On	-830			
Off	-502	Light	Park Light	-328
On	-752			
Off	-530	Light	Park Light	-222
On	-532		Logan Rd	
Off	-270	Men	Pole no 21287	-262
On	-329		NARVE	
Off	-250	Men	Pole no 10836	-19
On	-303		Sexton	
Off	-303	Men	Pole no 32200	0
On	-310		Sexton	
Off	-310	Men	Pole no 32199	0
On	-322		Sexton	
Off	-222	Men	Pole no 39903	0
On	-109		Ferndale	
Off	-109	Men	Pole no 43890	0
On	-687		Ferndale	
Off	-683	Men	Pole no 20503	0
On	-233		Ferndale	
Off	-233	Men	Pole no 23116	0
On	-584		Ferndale	
Off	-584	Men	Pole no 23117	0
On	-382		Ferndale	
Off	-382	Men	Pole no 23118	0
On	-424		ADARTSLICK	
Off	-424	Men	Pole no 349450	0
On	-146		ARLINGTON	
Off	-146	Men	Pole no 33108	0

TESTED BY

P. SMYTH

Brisbane Water Engineering Services

CP Form No. 27

Electrical Engineering Unit

Eva St 27V 6A

Cathodic Protection Interference Survey Results Form

Tarragindi to Wynnum Rd Mott Park 27V 5A

Project S. 34

Unit Reading

Date 3-5-05

	Reading	Test Point I. D.	Location	Swing
On	-226		EVA ST	
Off	-175	Men	Pole no 185	-51
On	-414		CHatsworth	
Off	-414	Men	Pole no 26522	0
On	-283		City View	
Off	-289	Men	Pole no 9590	+6
On	-003		Ferguson	
Off	-003	Men	Pole no 17735	0
On	-488		Ferguson	
Off	-382	Men	Pole no 17734	-106
On	-084		Ferguson	
Off	-084	Men	Pole no 129009	-0
On	-240		Ferguson	
Off	-240	Men	Pole no 27011	0
On	-011		The Promard	
Off	-011	Men	Pole no 1454	0
On	-172		The Promard	
Off	-172	Men	Pole no X19640	0
On	-12		Muir	
Off	-12	Men	Pole no 40265	0
On				
Off				
On				
Off				
TESTED BY P. Smyth

Brisbane Water Engineering Services

CP Form No.18

Electrical Engineering Unit

Standard Cathodic Protection Test Point Data Gathering FormProject S54 TARRAGINDI TO WYNNUM RDDate 3-11-03TP Location AUTUMN 4 TARRAGINDI RDTP No. 1Mains Size 1060 mmTP Type B**POTENTIAL TESTING**

CATHODE TO CATHODE RETURN (RESISTANCE)

0.25V

ZINC REFERENCE TO PIPE

+ 774

CuSo4 REFERENCE TO PIPE

- 419

ZINC TO CuSo4

- 1194**EARTH TESTING**

TEST NO. 1

PIN SPACING

2

RESISTIVITY

117.4 Ω PM

MEGGER READING

9.35

TEST NO 2

PIN SPACING

RESISTIVITY

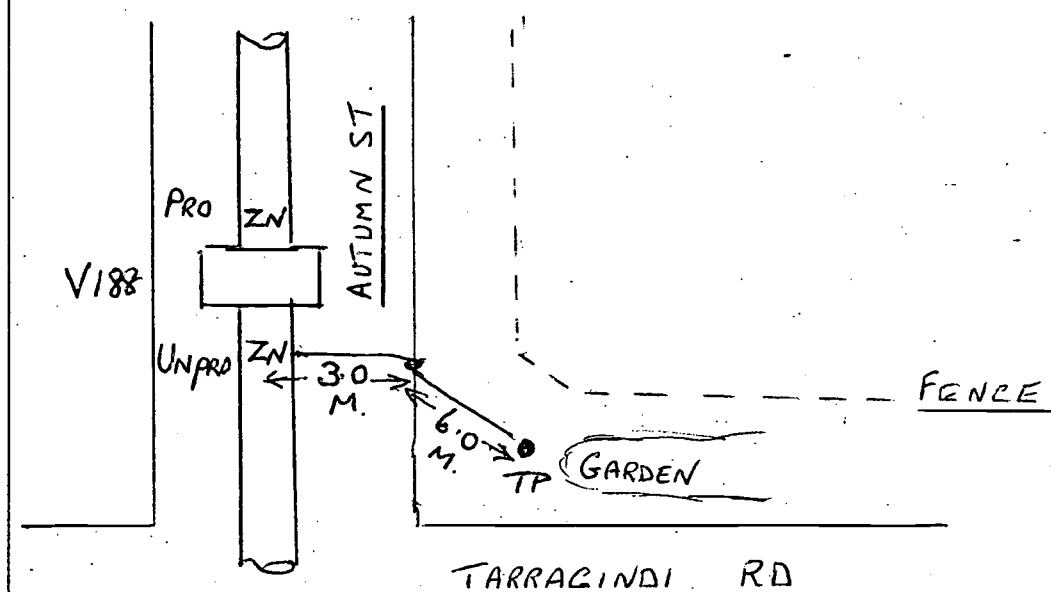
MEGGER READING

TEST NO 3

PIN SPACING

RESISTIVITY

MEGGER READING

COMMENTS / LOCATION DRAWING

TARRAGINDI RD

INSTALLED BY L. GREAVES

Brisbane Water Engineering Services

CP Form No.18

Electrical Engineering Unit

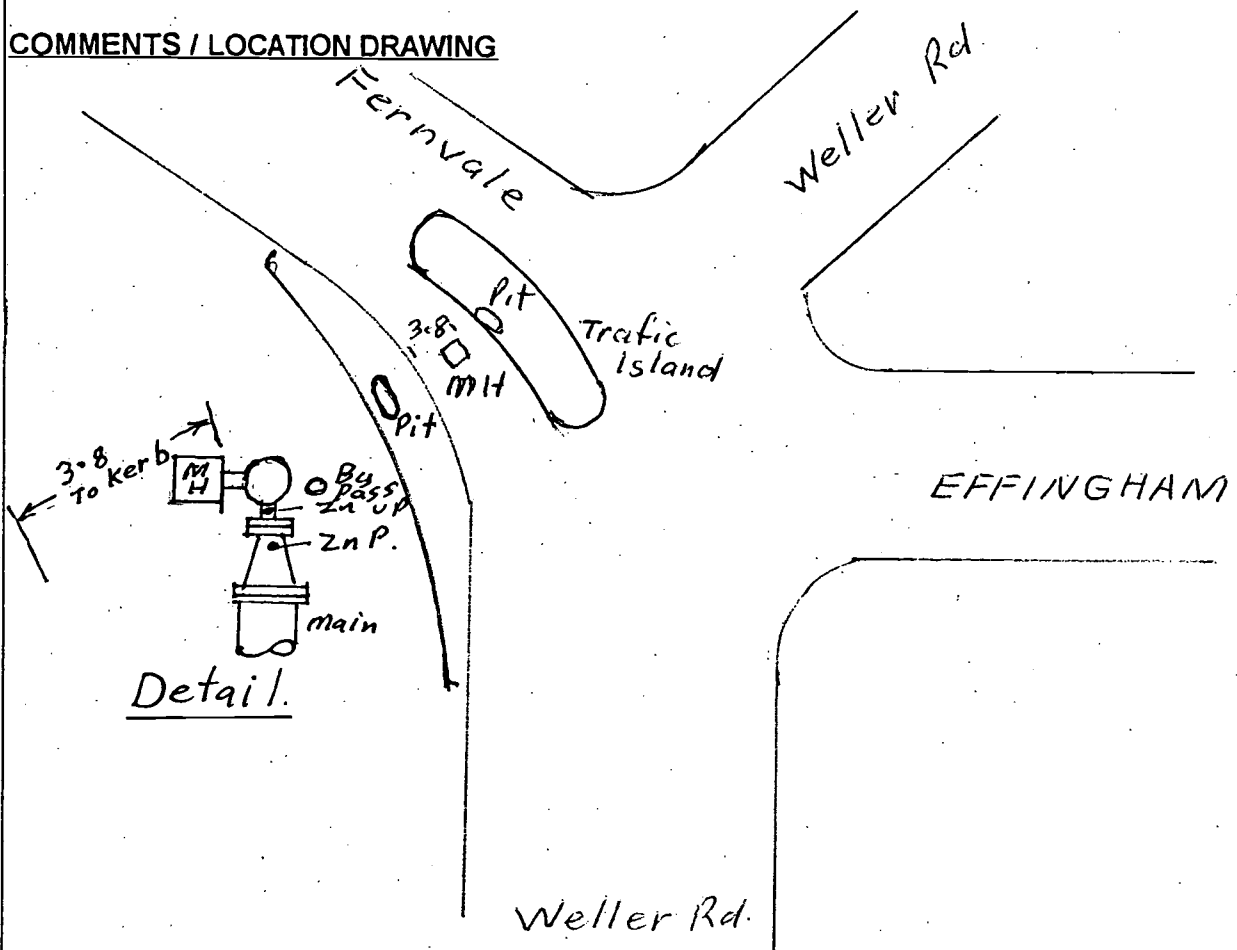
Standard Cathodic Protection Test Point Data Gathering FormProject Weller's Hill - Mt GravattDate 19-4-03T P Location Weller's Rd. FernvaleT P No. 2

Mains Size

T P Type B x 2**POTENTIAL TESTING**

CATHODE TO CATHODE RETURN (RESISTANCE)
 ZINC REFERENCE TO PIPE
 CuSo4 REFERENCE TO PIPE
 ZINC TO CuSo4

P	UP
0.15	0.15
+614	+601
-589	-614
-1203	-1216

EARTH TESTINGTEST NO. 1PIN SPACING 2MEGGER READING 6.2RESISTIVITY 77.8 Ω m**COMMENTS / LOCATION DRAWING**

INSTALLED BY:

Brisbane Water Engineering Services

CP Form No.18

Electrical Engineering Unit

Standard Cathodic Protection Test Point Data Gathering FormProject S54 Tarragindi - Wynnum Date 2-7-03TP Location 18 EFFINGHAM ST. TP No. 3Mains Size 42" to 36" TP Type B**POTENTIAL TESTING**

CATHODE TO CATHODE RETURN (RESISTANCE)

ZINC REFERENCE TO PIPE

CuSo4 REFERENCE TO PIPE

ZINC TO CuSo4

12 Ω
+ 585
- 416
- 111

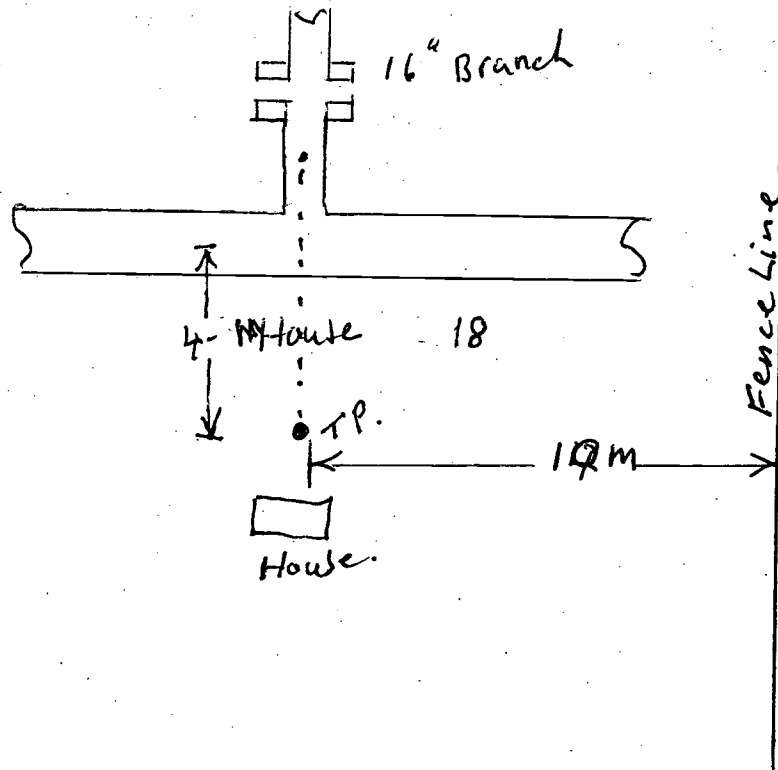
EARTH TESTING

TEST NO. 1

PIN SPACING

MEGGER READING

2
3.5

RESISTIVITY 43.9 Ω PM**COMMENTS / LOCATION DRAWING**

INSTALLED BY

P. SMYTH

Brisbane Water Engineering Services

CP Form No.18

Electrical Engineering Unit

Standard Cathodic Protection Test Point Data Gathering FormProject S54 Tarragindi - Wynnum Date 10-4-03T P Location SextonT P No. 4Mains Size 42-30T P Type B Pit**POTENTIAL TESTING**

CATHODE TO CATHODE RETURN (RESISTANCE)
 ZINC REFERENCE TO PIPE
 CuSo4 REFERENCE TO PIPE
 ZINC TO CuSo4

0.2 Ω
+ 689
- 549
- 1124

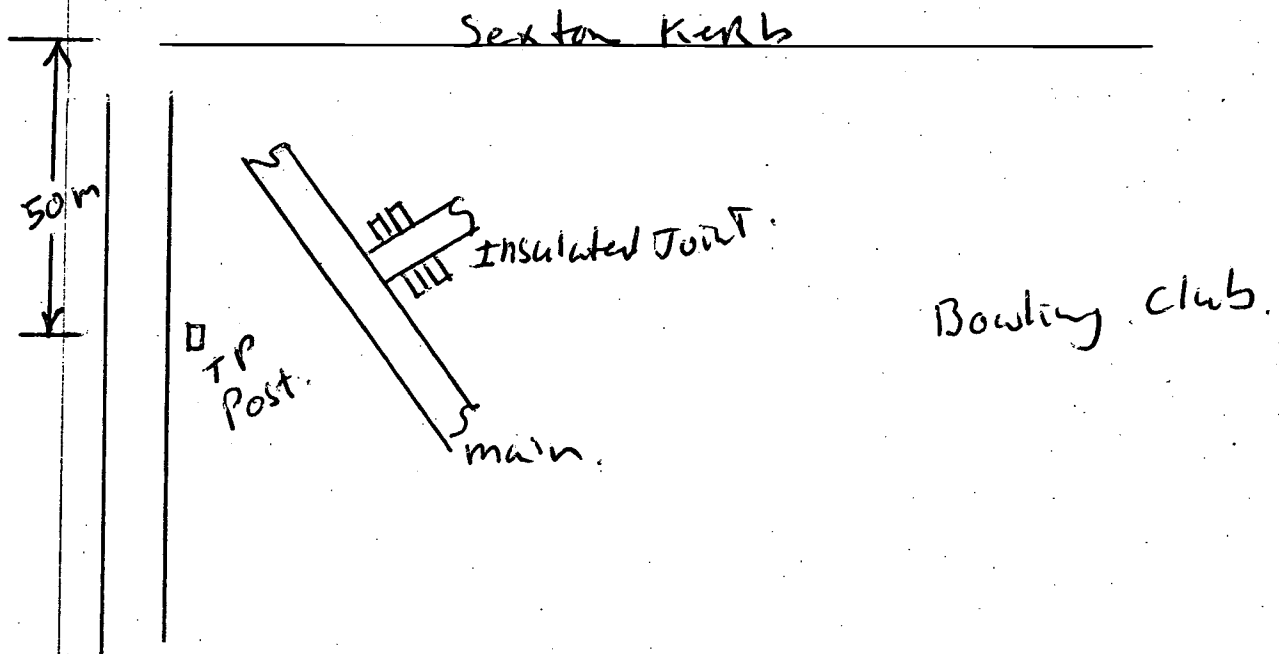
EARTH TESTING

TEST NO. 1

PIN SPACING

MEGGER READING

2
~~1.45~~ 1.5

RESISTIVITY 18.81 ρm **COMMENTS / LOCATION DRAWING**

INSTALLED BY

P. Smith

Brisbane Water Engineering Services

CP Form No.18

Electrical Engineering Unit

Standard Cathodic Protection Test Point Data Gathering FormProject Tarragindi Wynnum Date 28-10-03TP Location Cnr Birdwood & Navy TP No. 5Mains Size 42" to 36" TP Type B Post**POTENTIAL TESTING**

CATHODE TO CATHODE RETURN (RESISTANCE)

ZINC REFERENCE TO PIPE

CuSo4 REFERENCE TO PIPE

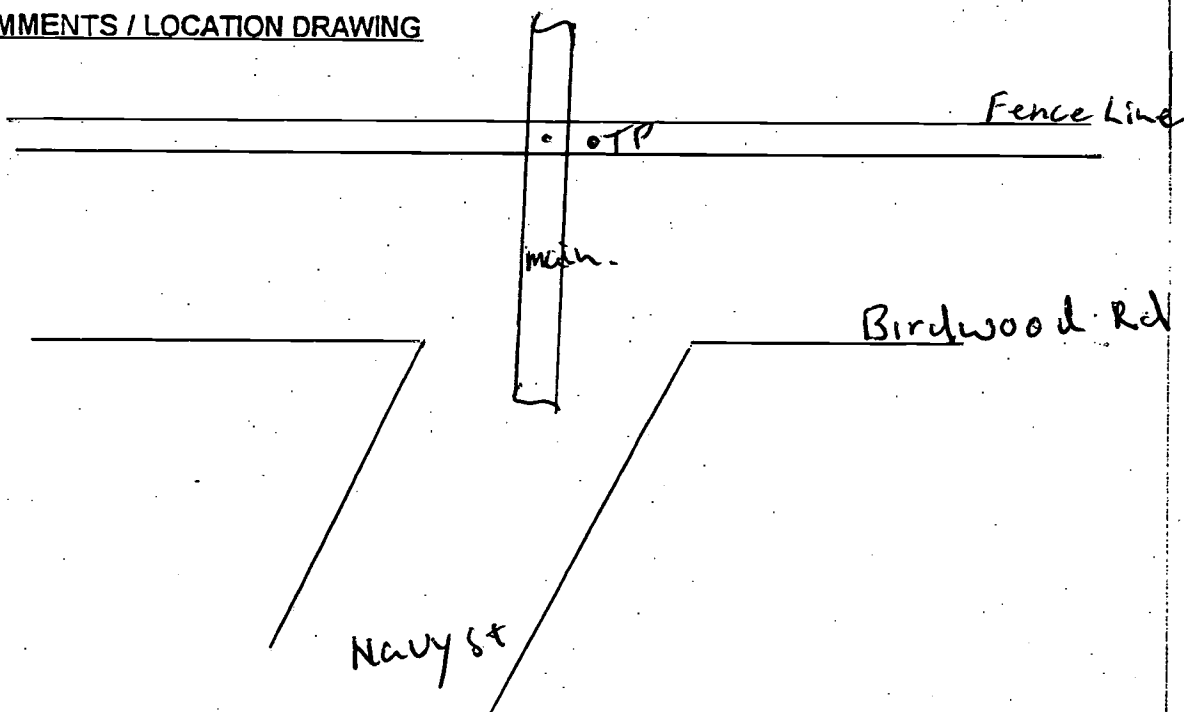
ZINC TO CuSo4

0.15+ 590- 454- 1095**EARTH TESTING**TEST NO. 1

PIN SPACING

2MEGGER READING 2.2

RESISTIVITY

21.6 Ω cm**COMMENTS / LOCATION DRAWING**

INSTALLED BY

Brisbane Water Engineering Services

CP Form No.18

Electrical Engineering Unit

Standard Cathodic Protection Test Point Data Gathering FormProject S54 Tarragindi - Wynnum Date 10-4-03T P Location Mott Park T P No. 6Mains Size 42" - 36" T P Type Rectifier
13**POTENTIAL TESTING**CATHODE TO CATHODE RETURN (RESISTANCE)
ZINC REFERENCE TO PIPE
CuSo4 REFERENCE TO PIPE
ZINC TO CuSo4.1 Ω
+ 585
- 1060
- 484**EARTH TESTING**TEST NO. 1

PIN SPACING

2

MEGGER READING

1.3RESISTIVITY 16.3TEST NO 2

PIN SPACING

MEGGER READING

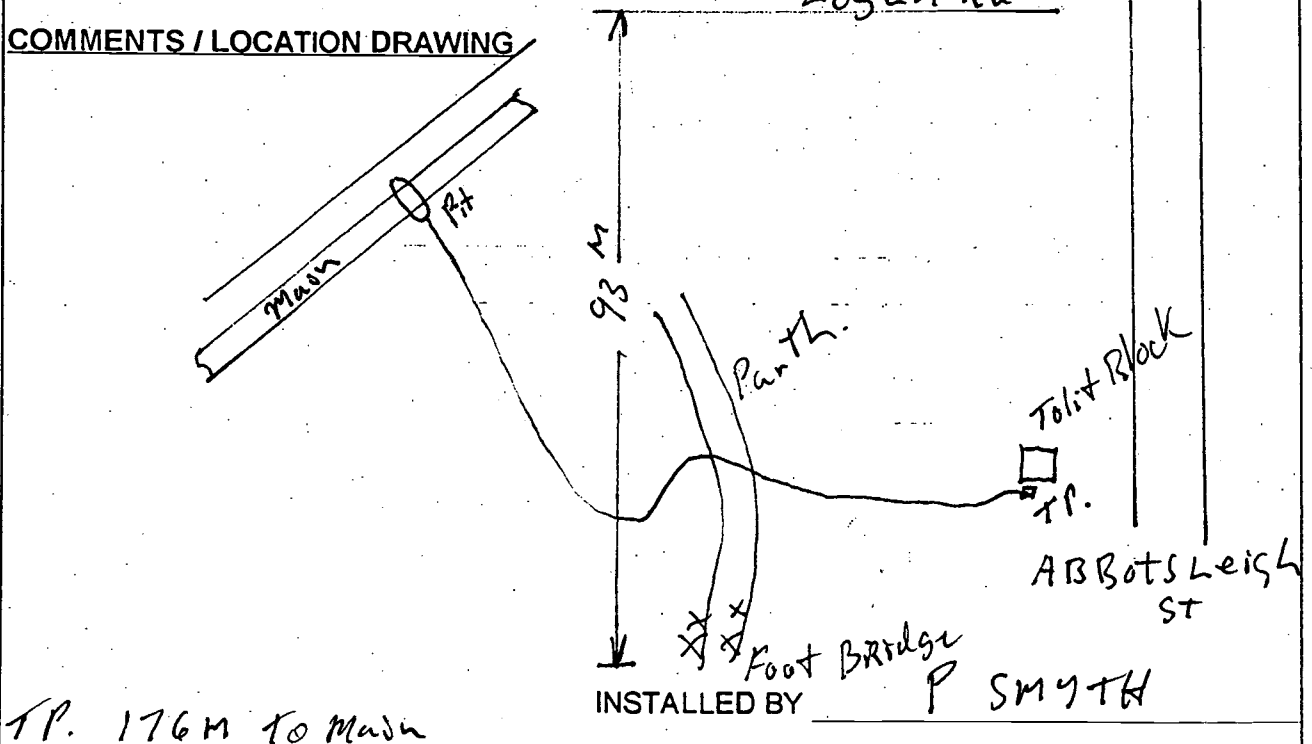
RESISTIVITY

TEST NO 3

PIN SPACING

MEGGER READING

RESISTIVITY

COMMENTS / LOCATION DRAWING

Brisbane Water Engineering Services

CP Form No.18

Electrical Engineering Unit

Standard Cathodic Protection Test Point Data Gathering FormProject S54 Tarragindi - Wynnum Date 10-4-03TP Location 460 Geelong AvTP No. 7Mains Size 4.2" - 36TP Type B Post**POTENTIAL TESTING**

CATHODE TO CATHODE RETURN (RESISTANCE)
 ZINC REFERENCE TO PIPE
 CuSo4 REFERENCE TO PIPE
 ZINC TO CuSo4

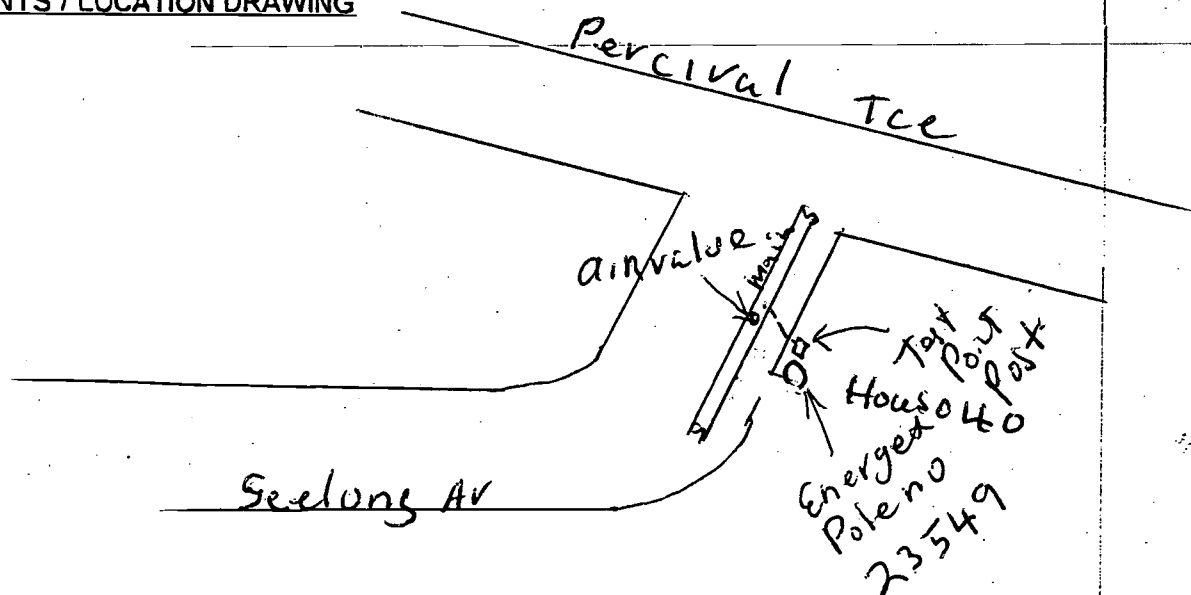
0.15
+ 720
- 287
- 1006

EARTH TESTINGTEST NO. 1

PIN SPACING

MEGGER READING

2m
2.8

RESISTIVITY 35.16 Ω pm**COMMENTS / LOCATION DRAWING**

INSTALLED BY

P. Smyth

Brisbane Water Engineering Services

CP Form No.18

Electrical Engineering Unit

Standard Cathodic Protection Test Point Data Gathering Form

Project Tarragindi - Wynnum Date 28-10-03
 TP Location Eva St in Magestic Park TP No. 8
 Mains Size 42" - 36" TP Type B

POTENTIAL TESTING

CATHODE TO CATHODE RETURN (RESISTANCE)
 ZINC REFERENCE TO PIPE
 CuSo4 REFERENCE TO PIPE
 ZINC TO CuSo4

1 Ω
+726
-380
-1100

EARTH TESTINGTEST NO. 1

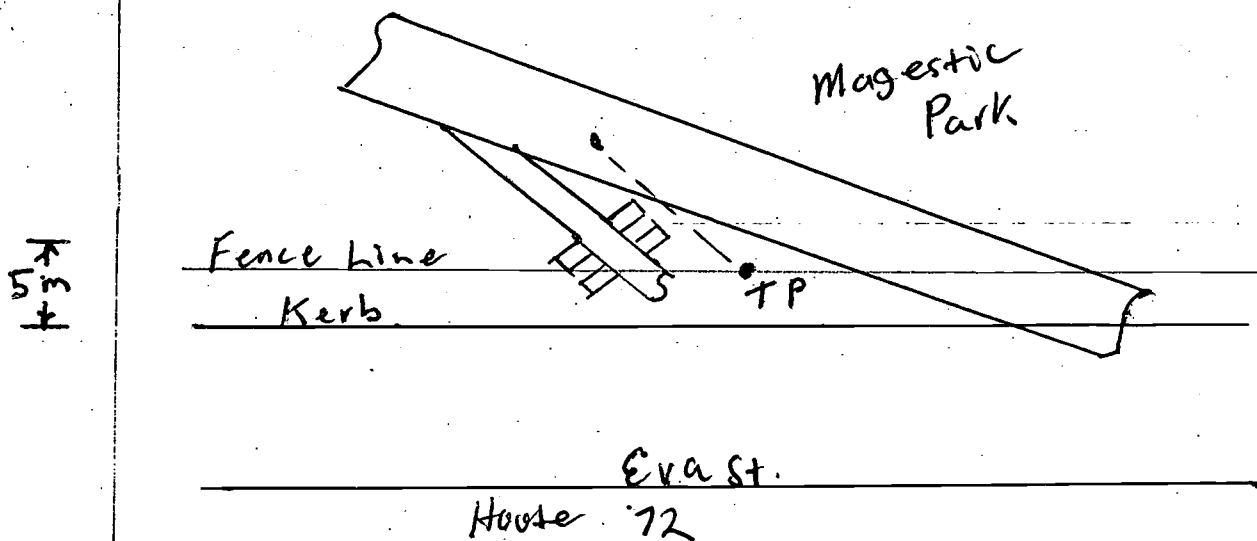
PIN SPACING

2 m

MEGGER READING

7.78

RESISTIVITY

97.7 Ω pm**COMMENTS / LOCATION DRAWING**

INSTALLED BY

Brisbane Water Engineering Services

CP Form No. 18

Electrical Engineering Unit

Standard Cathodic Protection Test Point Data Gathering FormProject Sect 54 Tarragindi - Wynnum Date 18-2-04TP Location Chatsworth at Illidge TP No. 9Mains Size 42" - 36" TP Type B Post**POTENTIAL TESTING**

CATHODE TO CATHODE RETURN (RESISTANCE)

ZINC REFERENCE TO PIPE

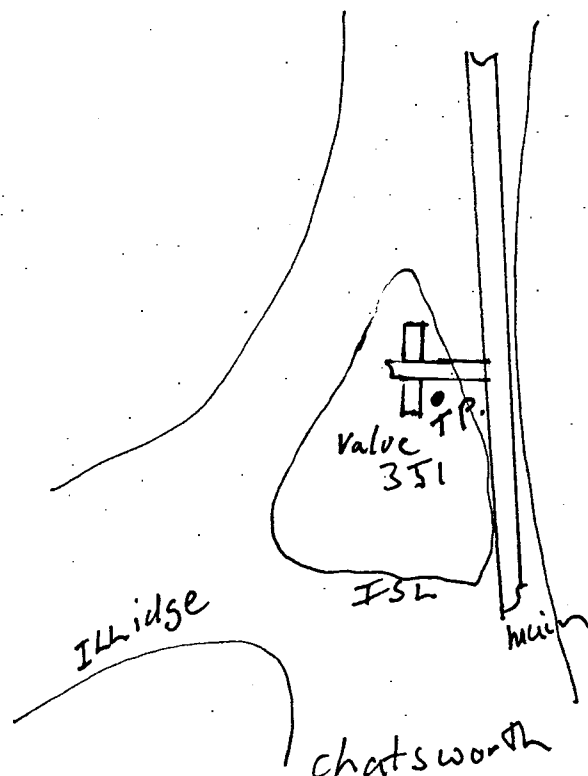
CuSo4 REFERENCE TO PIPE

ZINC TO CuSo4

0.1 Ω +578-460-1095**EARTH TESTING**TEST NO. 1

PIN SPACING

MEGGER READING

24.1RESISTIVITY 51.4 Ω pm**COMMENTS / LOCATION DRAWING**INSTALLED BY P SMYTH

Brisbane Water Engineering Services

CP Form No.18

Electrical Engineering Unit

Standard Cathodic Protection Test Point Data Gathering Form

Project Tarragindi to Wynnum Date 10-10-03
 TP Location Thomas and Prout TP No. 10
 Mains Size 42" to 36" TP Type B Post

POTENTIAL TESTING

CATHODE TO CATHODE RETURN (RESISTANCE)
 ZINC REFERENCE TO PIPE
 CuSo4 REFERENCE TO PIPE
 ZINC TO CuSo4

0.1 Ω
+ 443
- 650
- 1090

EARTH TESTINGTEST NO. 1

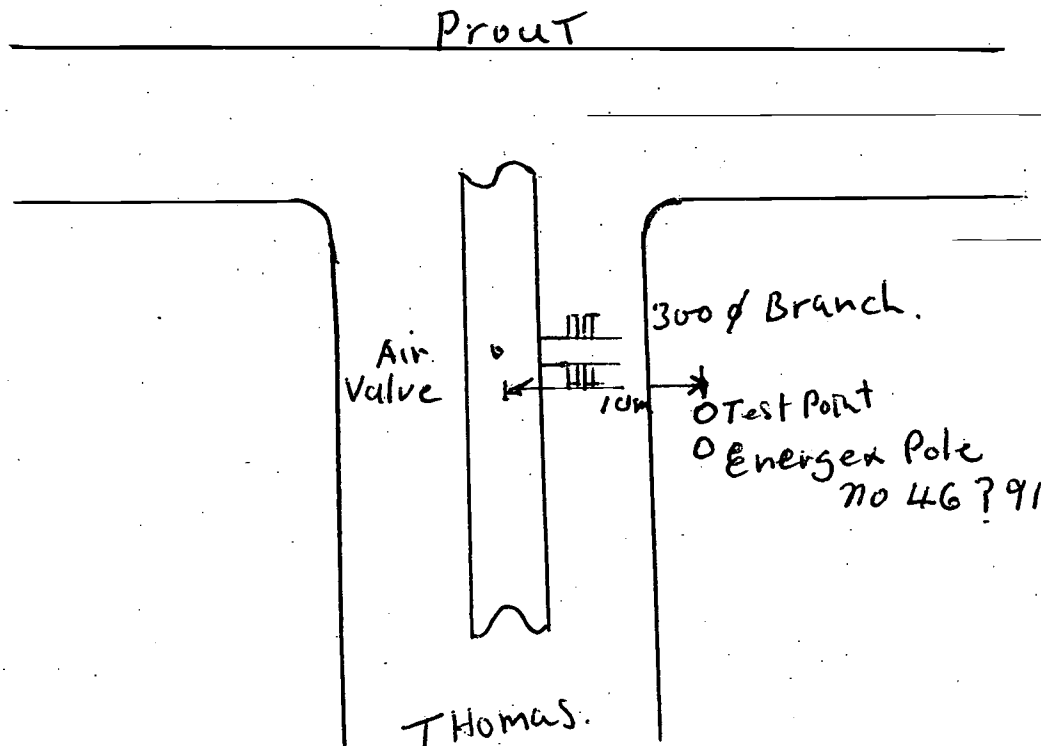
PIN SPACING

3.7 2m

MEGGER READING

3.7

RESISTIVITY

46.4 Ω pm**COMMENTS / LOCATION DRAWING**

INSTALLED BY

P. Smyth

Brisbane Water Engineering Services

CP Form No.18

Electrical Engineering Unit

Standard Cathodic Protection Test Point Data Gathering Form

Project S54 Tarragindi - Wynnum Date 28-4-03
 TP Location Old Cleveland Rd TP No. 112
 Mains Size 42" - 36" TP Type B Post

POTENTIAL TESTING

CATHODE TO CATHODE RETURN (RESISTANCE)
 ZINC REFERENCE TO PIPE
 CuSo4 REFERENCE TO PIPE
 ZINC TO CuSo4

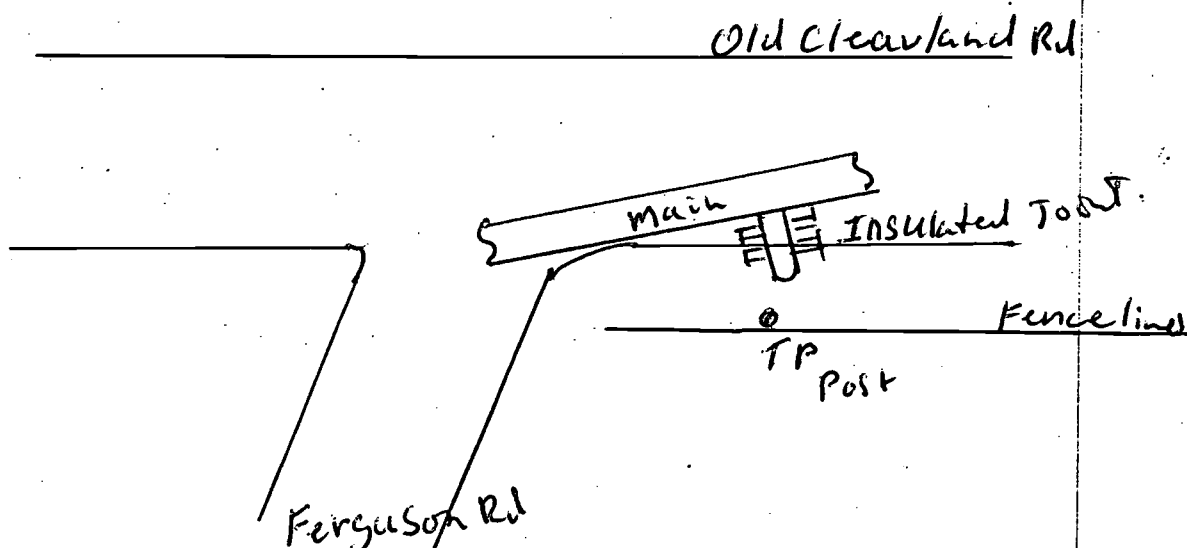
0.1 Ω
+434
-593
-938

EARTH TESTINGTEST NO. 1

PIN SPACING

MEGGER READING

2m
2.2

RESISTIVITY 27.6 Ω cm**COMMENTS / LOCATION DRAWING**

INSTALLED BY

Brisbane Water Engineering Services

CP Form No.18

Electrical Engineering Unit

Standard Cathodic Protection Test Point Data Gathering FormProject Tarragindi - Wynnum RdDate 19-4-03T P Location The PromenadeT P No. 12Mains Size 42" - 36"T P Type B Pit.**POTENTIAL TESTING**

CATHODE TO CATHODE RETURN (RESISTANCE)

ZINC REFERENCE TO PIPE

CuSo4 REFERENCE TO PIPE

ZINC TO CuSo4

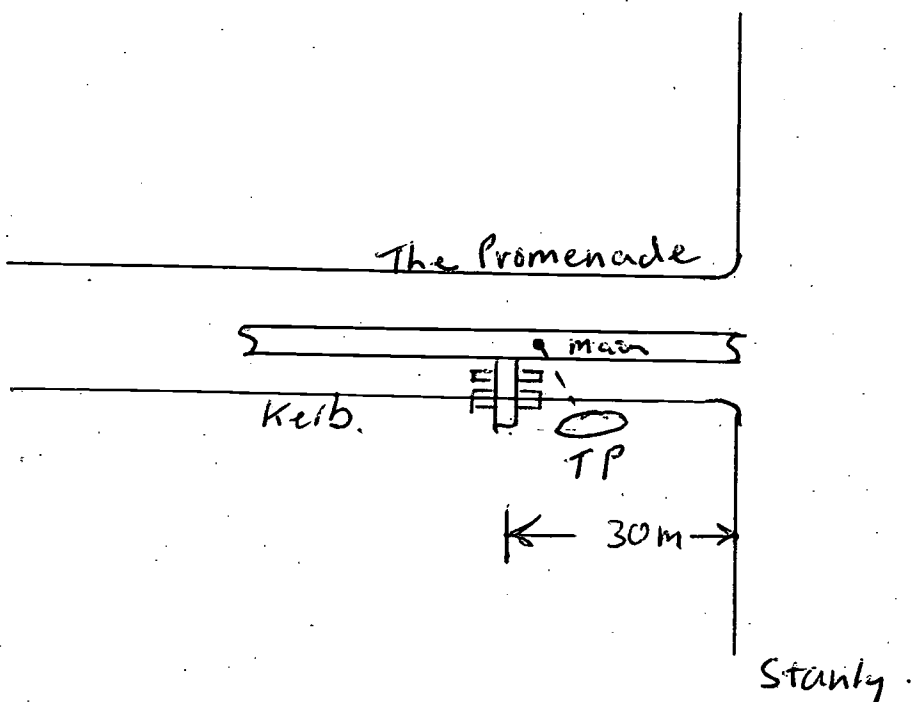
0.1 Ω
+ 446
- 490
- 952

EARTH TESTINGTEST NO. 1

PIN SPACING

MEGGER READING

2
1.8

RESISTIVITY 22.6 Ω Pm**COMMENTS / LOCATION DRAWING**

INSTALLED BY

Brisbane Water Engineering Services

CP Form No.18

Electrical Engineering Unit

Standard Cathodic Protection Test Point Data Gathering FormProject S54Date 15-4-03TP Location 511 Darcy RdTP No. 13Mains Size 42" - 36"TP Type B Post**POTENTIAL TESTING**

CATHODE TO CATHODE RETURN (RESISTANCE)

ZINC REFERENCE TO PIPE

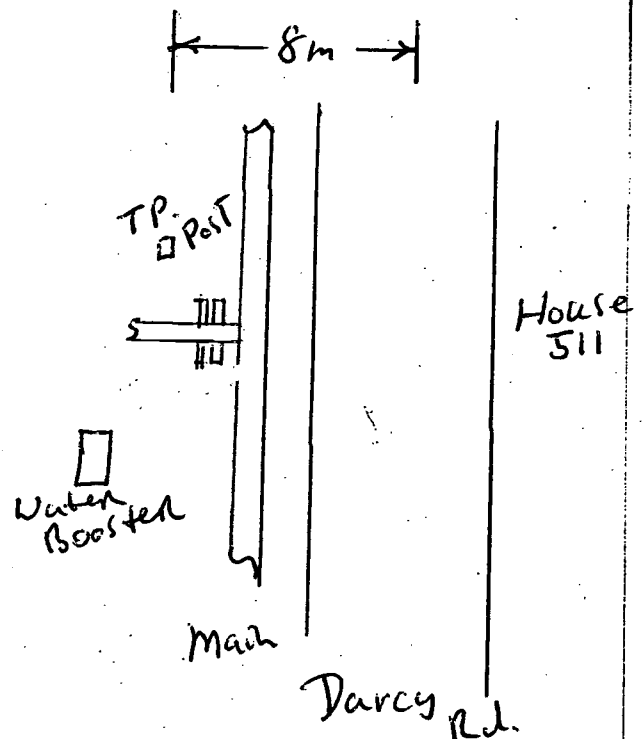
CuSo4 REFERENCE TO PIPE

ZINC TO CuSo4

0.25+709-516-1225**EARTH TESTING**TEST NO. 1

PIN SPACING

MEGGER READING

210.06RESISTIVITY 126.35 Ω m**COMMENTS / LOCATION DRAWING**

INSTALLED BY

Brisbane Water Engineering Services

CP Form No.18

Electrical Engineering Unit

Standard Cathodic Protection Test Point Data Gathering FormUBD
161613Project S54 Tarragindi - Wynnum Rd.

Date

T P Location Baguette St Seven hillsT P No. 14Mains Size 900 mmT P Type B Post.**POTENTIAL TESTING**

CATHODE TO CATHODE RETURN (RESISTANCE)

ZINC REFERENCE TO PIPE

CuSo4 REFERENCE TO PIPE

ZINC TO CuSo4

.02.

+558

-448

-1002

EARTH TESTINGTEST NO. 1

PIN SPACING

2 mtrs

MEGGER READING

7.7

RESISTIVITY

97 Ω mtrsTEST NO 2

PIN SPACING

MEGGER READING

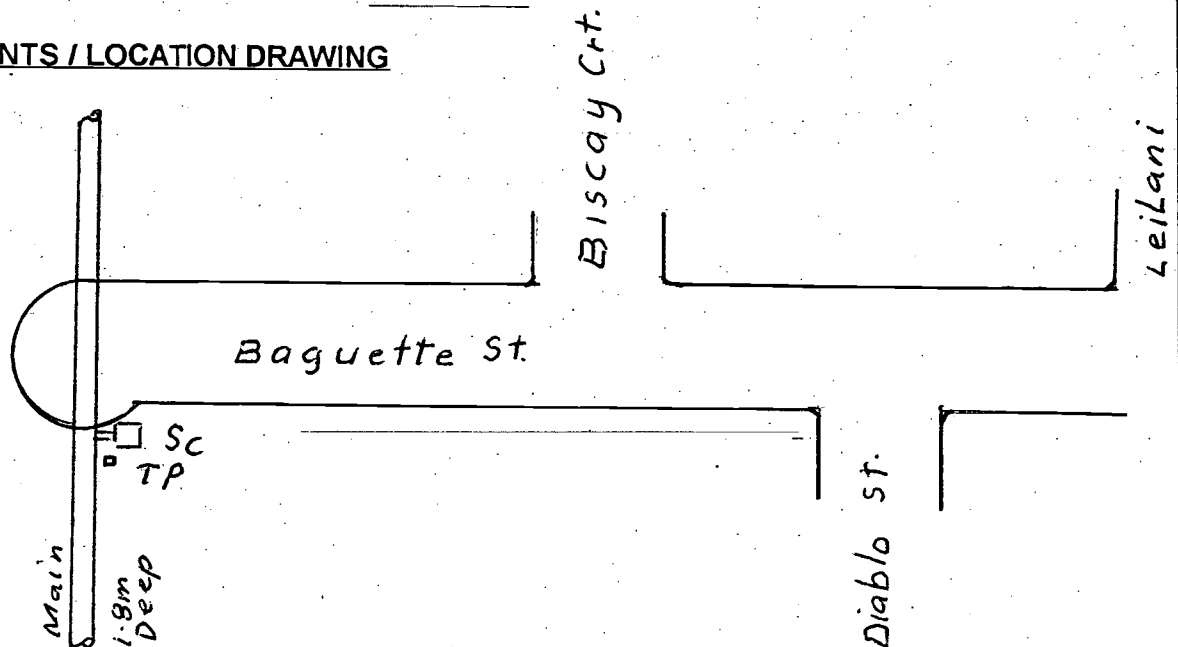
RESISTIVITY

TEST NO 3

PIN SPACING

MEGGER READING

RESISTIVITY

COMMENTS / LOCATION DRAWING

INSTALLED BY

J. Taylor

Brisbane Water Engineering Services

CP Form No. 18

Electrical Engineering Unit

Standard Cathodic Protection Test Point Data Gathering FormProject S54 Tarragindi - Wynnum Date 3-2-04TP Location Cr. Wynnum + Barrack TP No. 15Mains Size 42" TO 36" TP Type B Pit.**POTENTIAL TESTING**

CATHODE TO CATHODE RETURN (RESISTANCE)

ZINC REFERENCE TO PIPE

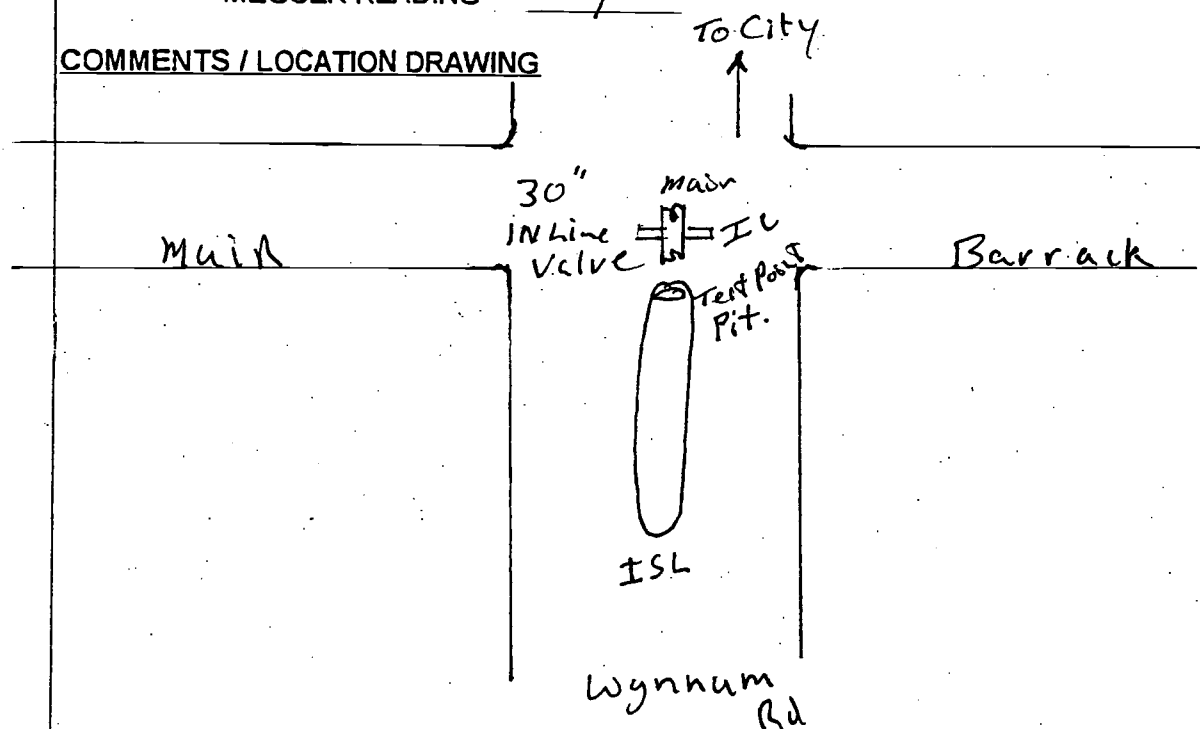
CuSo4 REFERENCE TO PIPE

ZINC TO CuSo4

1 Ω +680-710-1111**EARTH TESTING**TEST NO. 1

PIN SPACING

MEGGER READING

2.9RESISTIVITY 11.3 Ω pm**COMMENTS / LOCATION DRAWING**

INSTALLED BY

P. Smyth

Brisbane Water Engineering Services

CP Form No.18

Electrical Engineering Unit

Standard Cathodic Protection Test Point Data Gathering FormProject Set 35 Wynnum Rd.Date 20-1-04T P Location 88 Barrack RdT P No. 1

Mains Size

T P Type B Post**POTENTIAL TESTING**

CATHODE TO CATHODE RETURN (RESISTANCE)
 ZINC REFERENCE TO PIPE
 CuSo4 REFERENCE TO PIPE
 ZINC TO CuSo4

0.2 Ω
+ 559
- 585
- 1143

EARTH TESTINGTEST NO. 1

PIN SPACING

2m

RESISTIVITY

69.08 Ω m

MEGGER READING

5.5TEST NO 2

PIN SPACING

RESISTIVITY

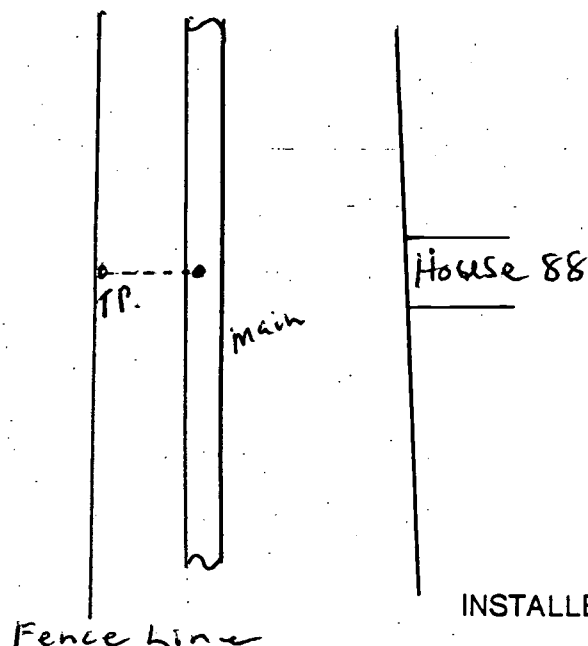
MEGGER READING

TEST NO 3

PIN SPACING

RESISTIVITY

MEGGER READING

COMMENTS / LOCATION DRAWINGINSTALLED BY P. Smyth

Brisbane Water Engineering Services

CP Form No.18

Electrical Engineering Unit

Standard Cathodic Protection Test Point Data Gathering FormProject Set 35 Wynnum Rd Date 21-1-04T P Location Cnr Barrack & Lytton T P No. 2Mains Size T P Type B Post**POTENTIAL TESTING**

CATHODE TO CATHODE RETURN (RESISTANCE)

0.2 Ω

ZINC REFERENCE TO PIPE

+ 569

CuSo4 REFERENCE TO PIPE

- 552

ZINC TO CuSo4

- 1122**EARTH TESTING**TEST NO. 1

PIN SPACING

2 m

RESISTIVITY

86.6 Ω cm

MEGGER READING

6.9TEST NO 2

PIN SPACING

RESISTIVITY

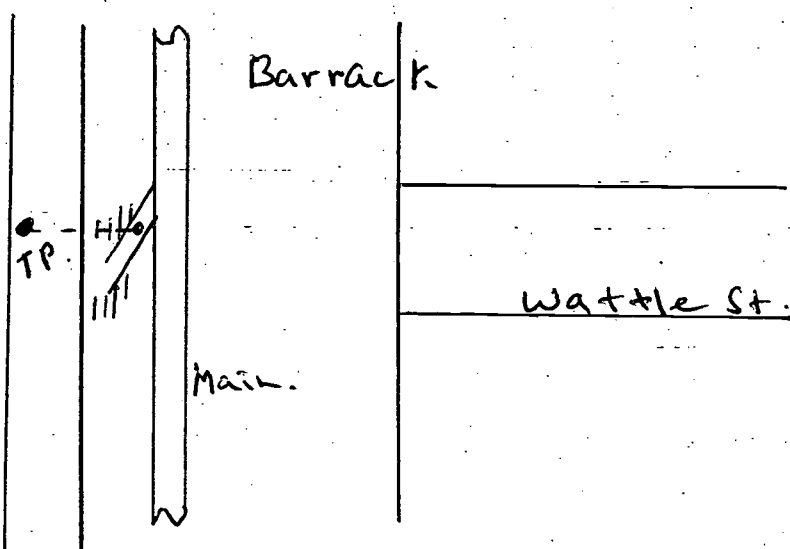
MEGGER READING

TEST NO 3

PIN SPACING

RESISTIVITY

MEGGER READING

COMMENTS / LOCATION DRAWINGINSTALLED BY P. SmythFence Line

Brisbane Water Engineering Services

CP Form No.18

Electrical Engineering Unit

Standard Cathodic Protection Test Point Data Gathering FormProject Sect 35 Wynnum Rd Date 22-1-04T P Location Lytton Rd by Metroplex T P No. 3Mains Size T P Type B Post**POTENTIAL TESTING**

CATHODE TO CATHODE RETURN (RESISTANCE)
 ZINC REFERENCE TO PIPE
 CuSo4 REFERENCE TO PIPE
 ZINC TO CuSo4

.1 Ω
+461
-543
-1002

EARTH TESTING

TEST NO. 1

PIN SPACING

MEGGER READING

0.82 m
8.8

RESISTIVITY

110.5 Ω pr

TEST NO 2

PIN SPACING

MEGGER READING

RESISTIVITY

TEST NO 3

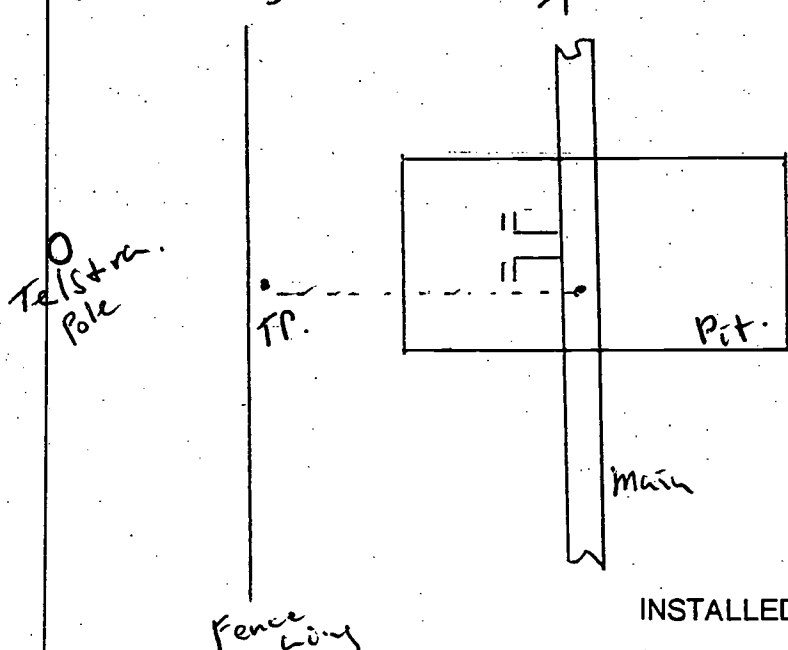
PIN SPACING

MEGGER READING

RESISTIVITY

COMMENTS / LOCATION DRAWING

← 50 m → Metroplex.



INSTALLED BY

P. Smyth

Brisbane Water Engineering Services

CP Form No. 21

Electrical Engineering Unit

Insulated Joint Testing Details Form*Isolation 1*Project *S54 TARRAGINDI TO WYNNUM RD.*Date *3-11-03***DESCRIPTION**

MAINS DETAILS:

LOCATIONS:

SIZE:

MATERIAL:

COATING:

VALVE No.

*TARRAGINDI TO WYNNUM RD**TARRAGINDI AND AUTUMN RD**1060 MM**MILD STEEL**TAR EPOXY**V188***IN GROUND TESTING**

BOLT TO FLANGE RESISTANCE:

ALL > 1.0 MSU

NUMBER OF BOLT:

16

FLANGE TO FLANGE RESISTANCE:

35.0 SU

INSULATION CHECKER MODEL 702:

POTENTIAL DIFFERENCE TO REFERENCE CELL:

PROTECTED SIDE:

- 313 mV

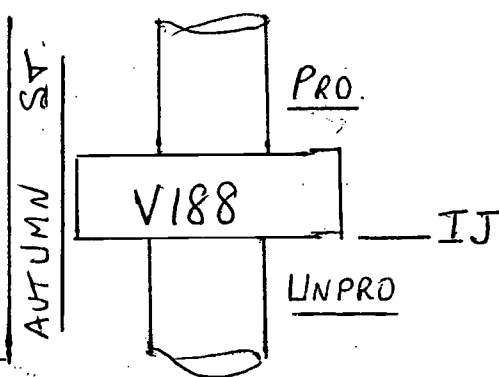
UNPROTECTED SIDE:

*- 303 mV***ABOVE TESTING**

BOLT TO FLANGE RESISTANCE:

NUMBER OF BOLTS:

FLANGE TO FLANGE RESISTANCE:

COMMENTS / LOCATION DRAWING*TARRAGINDI RD.*TESTED BY *L. GREAVES*

Brisbane Water Engineering Services

CP Form No. 21

Electrical Engineering Unit

Insulated Joint Testing Details FormProject S54 TARRAGINDI TO WYNNUM RDDate 4-11-03Isolation 2**DESCRIPTION**

MAINS DETAILS:

LOCATIONS:

SIZE:

MATERIAL:

COATING:

VALVE No.

TARRAGINDI TO WYNNUM RDAUTUMN ST1000 MMMILD STEELTAR EPOXY150 MM RETIC**IN GROUND TESTING**BOLT TO FLANGE RESISTANCE: ALL > 1.5 MΩNUMBER OF BOLT: 8FLANGE TO FLANGE RESISTANCE: 56.0 Ω

INSULATION CHECKER MODEL 702:

POTENTIAL DIFFERENCE TO REFERENCE CELL:

PROTECTED SIDE:

- 394 mV

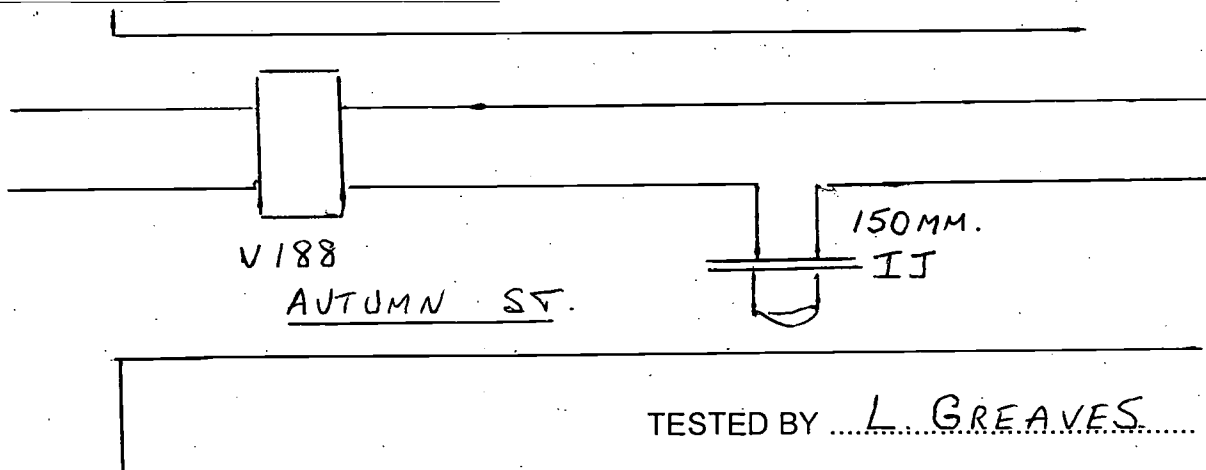
UNPROTECTED SIDE:

- 371 mV**ABOVE TESTING**

BOLT TO FLANGE RESISTANCE:

NUMBER OF BOLTS:

FLANGE TO FLANGE RESISTANCE:

COMMENTS / LOCATION DRAWING

Brisbane Water Engineering Services

CP Form No. 21

Electrical Engineering Unit**Insulated Joint Testing Details Form**Project Tarragindi - WynnumDate 17-2-04
Isolation 3**DESCRIPTION**

MAINS DETAILS:

LOCATIONS:

SIZE:

MATERIAL:

COATING:

VALVE No.

Tarragindi Rd & datum Rd
42" to 36"
mild steel
P.C
254

IN GROUND TESTING

BOLT TO FLANGE RESISTANCE: _____

NUMBER OF BOLT: _____

FLANGE TO FLANGE RESISTANCE: _____

INSULATION CHECKER MODEL 702: _____

POTENTIAL DIFFERENCE TO REFERENCE CELL:

PROTECTED SIDE: _____

UNPROTECTED SIDE: _____

-375
-250

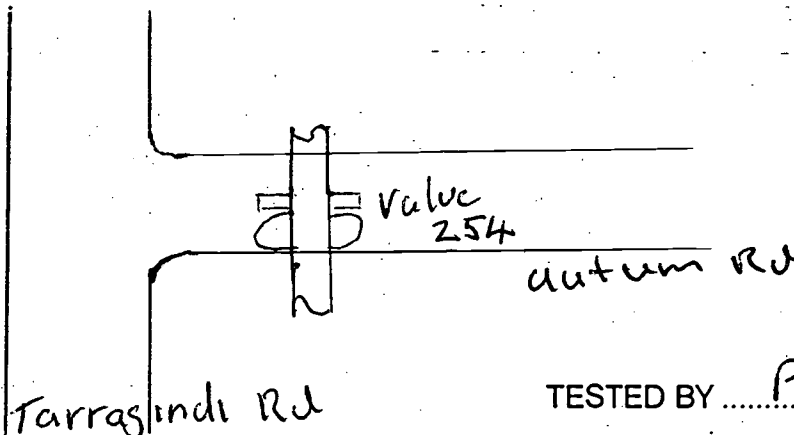
ABOVE TESTING

BOLT TO FLANGE RESISTANCE: _____

NUMBER OF BOLTS: _____

FLANGE TO FLANGE RESISTANCE: _____

all Bolts > 200 Ω
70K Ω

COMMENTS / LOCATION DRAWINGTESTED BY P. Smyth

Brisbane Water Engineering Services

CP Form No. 21

Electrical Engineering Unit**Insulated Joint Testing Details Form**

Isolation No 3a

Project Tarragindi - WynnumDate 28-10-03**DESCRIPTION**

MAINS DETAILS:

LOCATIONS:

SIZE:

MATERIAL:

COATING:

VALVE No.

andrew + Ferndale42" to 36"Mild Steel9" Branch**IN GROUND TESTING**

BOLT TO FLANGE RESISTANCE:

all Bolts 7200 Ω

NUMBER OF BOLT:

12

FLANGE TO FLANGE RESISTANCE:

0.78 M Ω

INSULATION CHECKER MODEL 702:

N/A.**POTENTIAL DIFFERENCE TO REFERENCE CELL**

PROTECTED SIDE:

-250 mV

UNPROTECTED SIDE:

-150 mV**ABOVE TESTING**

BOLT TO FLANGE RESISTANCE:

NUMBER OF BOLTS:

FLANGE TO FLANGE RESISTANCE:

COMMENTS / LOCATION DRAWINGandrewmainFerndaleBranchTESTED BY P. Smyth← 32 m →

Brisbane Water Engineering Services

CP Form No. 21

Electrical Engineering Unit

Insulated Joint Testing Details FormProject S54Date 2-7-03
Isolation 5**DESCRIPTION**

MAINS DETAILS:

LOCATIONS:

SIZE:

MATERIAL:

COATING:

VALVE No:

no 46 EPPingham St
42"-36"
Mild Steel
16" BR 796

IN GROUND TESTINGBOLT TO FLANGE RESISTANCE: all Bolts > 2000

NUMBER OF BOLT:

FLANGE TO FLANGE RESISTANCE: 7 KΩINSULATION CHECKER MODEL 702: N/APOTENTIAL DIFFERENCE TO REFERENCE CELL

PROTECTED SIDE:

UNPROTECTED SIDE:

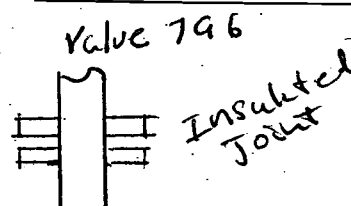
-416
-350

ABOVE TESTING

BOLT TO FLANGE RESISTANCE:

NUMBER OF BOLTS:

FLANGE TO FLANGE RESISTANCE:

COMMENTS / LOCATION DRAWINGTESTED BY P. Smyth

Brisbane Water Engineering Services

CP Form No. 21

Electrical Engineering Unit

Insulated Joint Testing Details FormProject S54Date 28-4-07Isolation 7**DESCRIPTION**

MAINS DETAILS:

LOCATIONS:

SIZE:

MATERIAL:

COATING:

VALVE No.

Tarragindi To WynnumSexton Bowling Club42 36Mild steel**IN GROUND TESTING**

BOLT TO FLANGE RESISTANCE:

all Bolts > 200 Ω

NUMBER OF BOLT:

FLANGE TO FLANGE RESISTANCE:

6 m Ω

INSULATION CHECKER MODEL 702:

N/APOTENTIAL DIFFERENCE TO REFERENCE CELL:

PROTECTED SIDE:

-549

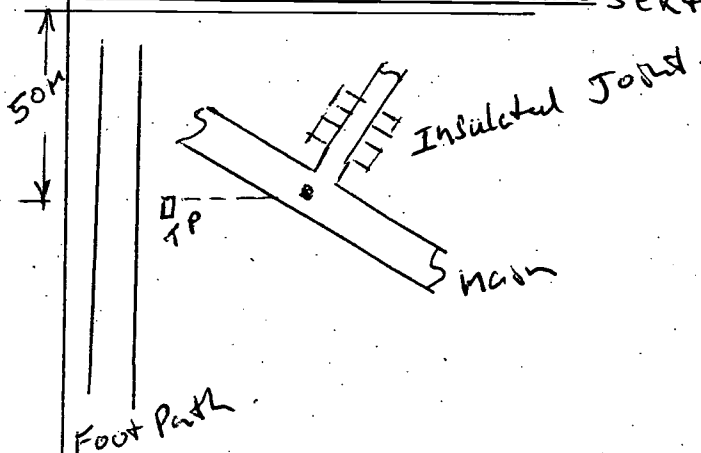
UNPROTECTED SIDE:

-447**ABOVE TESTING**

BOLT TO FLANGE RESISTANCE:

NUMBER OF BOLTS:

FLANGE TO FLANGE RESISTANCE:

COMMENTS / LOCATION DRAWINGSexton KurbTESTED BY P. Smyth

Brisbane Water Engineering Services

CP Form No. 21

Electrical Engineering Unit

Insulated Joint Testing Details FormProject S 54Date 29-4-03
Isolation 8**DESCRIPTION**

MAINS DETAILS:

LOCATIONS:

SIZE:

MATERIAL:

COATING:

VALVE No.

Tarragindi to Wynnum
4 Merrell St
42-36"
Mild Steel
9" Br

IN GROUND TESTING

BOLT TO FLANGE RESISTANCE:

all Bolts > 200Ω

NUMBER OF BOLT:

FLANGE TO FLANGE RESISTANCE:

0.68 mΩ

INSULATION CHECKER MODEL 702:

N/A**POTENTIAL DIFFERENCE TO REFERENCE CELL:**

PROTECTED SIDE:

-455

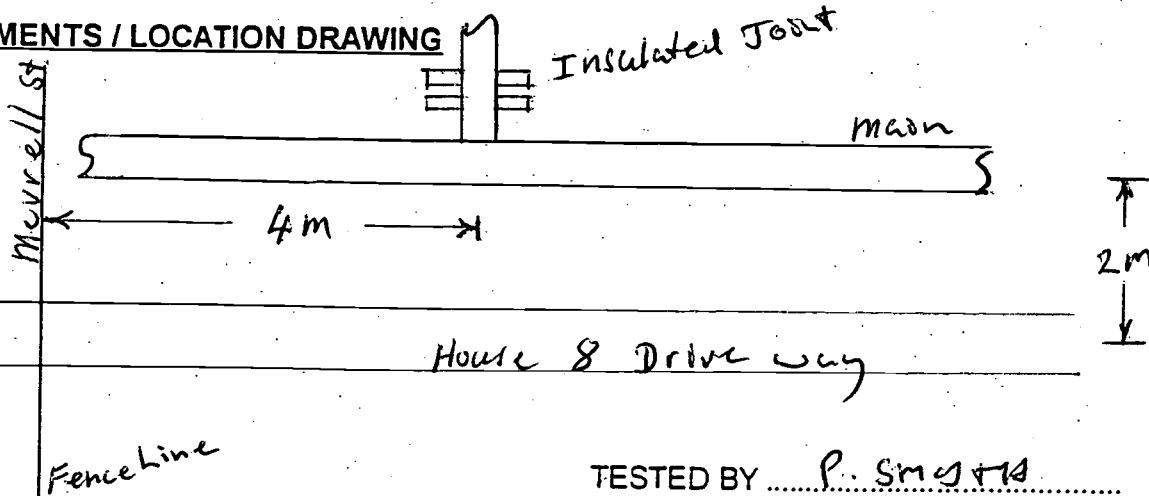
UNPROTECTED SIDE:

-359**ABOVE TESTING**

BOLT TO FLANGE RESISTANCE:

NUMBER OF BOLTS:

FLANGE TO FLANGE RESISTANCE:

COMMENTS / LOCATION DRAWINGTESTED BY P. Smith

Brisbane Water Engineering Services

CP Form No. 21

Electrical Engineering Unit**Insulated Joint Testing Details Form***Isolation 9*Project *Tarragindi - Wynnum*Date *28-10-03***DESCRIPTION**

MAINS DETAILS:

LOCATIONS:

SIZE:

MATERIAL:

COATING:

VALVE No.

*42 Swain St.**42" - 36"**Mild Steel**6" Branch***IN GROUND TESTING**

BOLT TO FLANGE RESISTANCE:

NUMBER OF BOLT:

FLANGE TO FLANGE RESISTANCE:

INSULATION CHECKER MODEL 702:

all Bolts 7 zero Ω *12**~ 8 m Ω* *N/A*POTENTIAL DIFFERENCE TO REFERENCE CELL

PROTECTED SIDE:

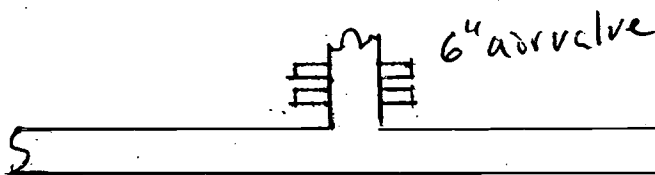
UNPROTECTED SIDE:

*- 440 mV**- 390 mV***ABOVE TESTING**

BOLT TO FLANGE RESISTANCE:

NUMBER OF BOLTS:

FLANGE TO FLANGE RESISTANCE:

COMMENTS / LOCATION DRAWINGTESTED BY *P. Smyth**House 42*

Brisbane Water Engineering Services

CP Form No. 21

Electrical Engineering Unit**Insulated Joint Testing Details Form**Project S 54Date 14-4-03
Isolation 10**DESCRIPTION**

MAINS DETAILS:

LOCATIONS:

SIZE:

MATERIAL:

COATING:

VALVE No.

Tarragindi to Wynnum
Abbotsleigh & Cavendish Rd
42-36
Mild Steel
12" Branch

IN GROUND TESTINGBOLT TO FLANGE RESISTANCE: all Bolts > 200Ω

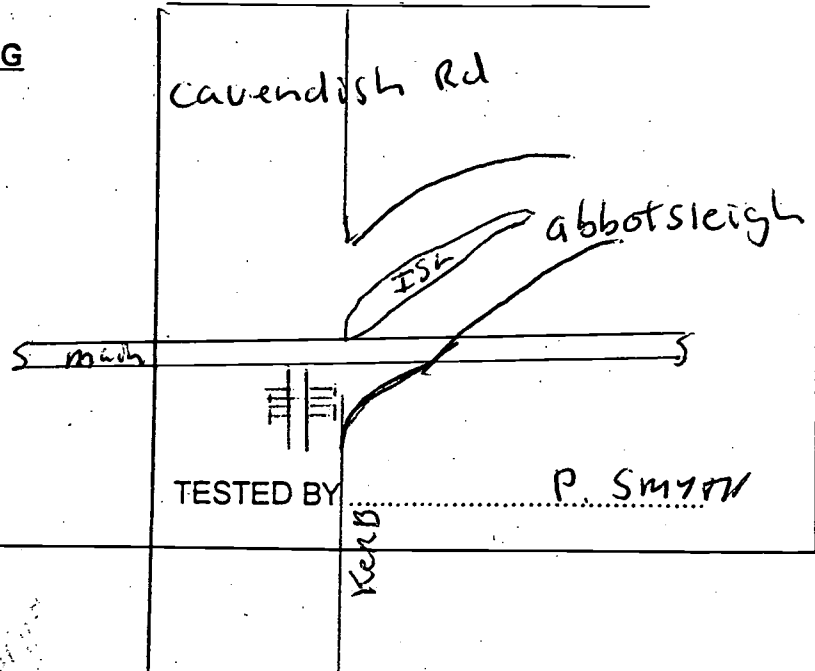
NUMBER OF BOLT: _____

FLANGE TO FLANGE RESISTANCE: 0.2 mΩINSULATION CHECKER MODEL 702: N/A**POTENTIAL DIFFERENCE TO REFERENCE CELL:**PROTECTED SIDE: -414UNPROTECTED SIDE: -356**ABOVE TESTING**

BOLT TO FLANGE RESISTANCE: _____

NUMBER OF BOLTS: _____

FLANGE TO FLANGE RESISTANCE: _____

COMMENTS / LOCATION DRAWING

Brisbane Water Engineering Services

CP Form No. 21

Electrical Engineering Unit

Insulated Joint Testing Details Form

Isolation 10a

Project Tarragindi - WynnumDate 28-10-03**DESCRIPTION**

MAINS DETAILS:

LOCATIONS:

SIZE:

MATERIAL:

COATING:

VALVE No.

Arlington St.
42" - 36"
Mild Steel.
T/E
12" Br

IN GROUND TESTING

BOLT TO FLANGE RESISTANCE:

All Bolts > 200 Ω

NUMBER OF BOLT:

FLANGE TO FLANGE RESISTANCE:

3.8 K Ω

INSULATION CHECKER MODEL 702:

N/APOTENTIAL DIFFERENCE TO REFERENCE CELL.

PROTECTED SIDE:

-465 mV

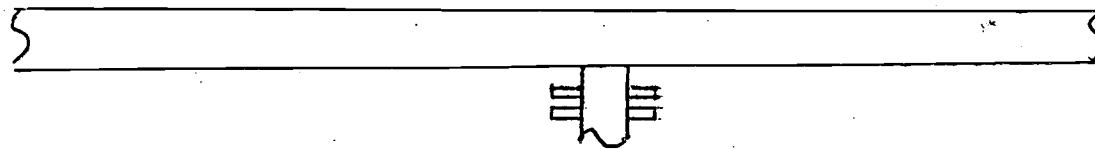
UNPROTECTED SIDE:

-415 mV**ABOVE TESTING**

BOLT TO FLANGE RESISTANCE:

NUMBER OF BOLTS:

FLANGE TO FLANGE RESISTANCE:

COMMENTS / LOCATION DRAWINGHouse 29TESTED BY P. Smyth

Brisbane Water Engineering Services

CP Form No. 21

Electrical Engineering Unit

Insulated Joint Testing Details Form

Isolation No. 11

Project Tarragindi to WynnumDate 28-10-03**DESCRIPTION**

MAINS DETAILS:

LOCATIONS:

SIZE:

MATERIAL:

COATING:

VALVE No.

Eva St.42" to 36"Mild Steel9" Branch**IN GROUND TESTING**

BOLT TO FLANGE RESISTANCE:

all Bolts > 2000

NUMBER OF BOLT:

12

FLANGE TO FLANGE RESISTANCE:

200 Ω

INSULATION CHECKER MODEL 702:

N/A**POTENTIAL DIFFERENCE TO REFERENCE CELL**

PROTECTED SIDE:

-4460 mV

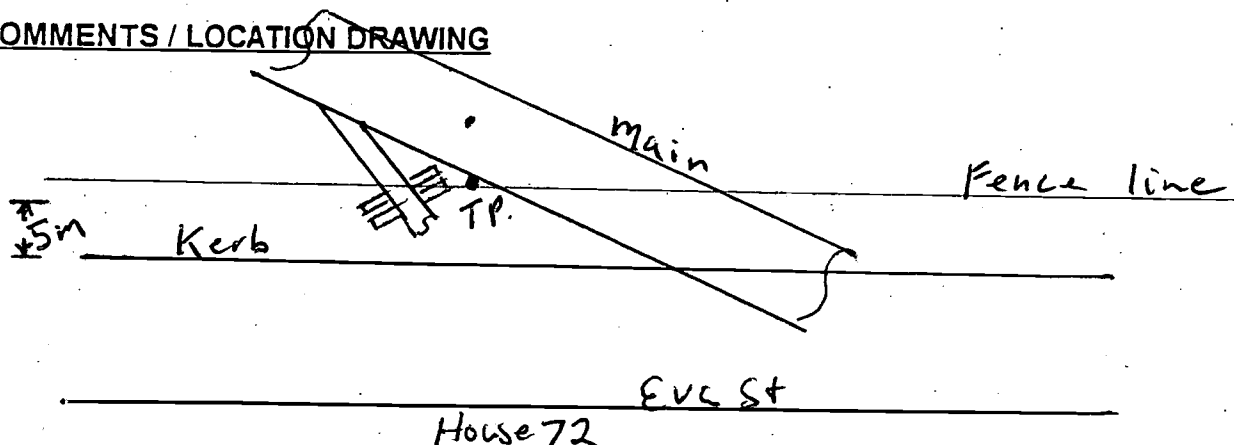
UNPROTECTED SIDE:

-310 mV**ABOVE TESTING**

BOLT TO FLANGE RESISTANCE:

NUMBER OF BOLTS:

FLANGE TO FLANGE RESISTANCE:

COMMENTS / LOCATION DRAWING

TESTED BY

Brisbane Water Engineering Services

CP Form No. 21

Electrical Engineering Unit

Insulated Joint Testing Details Form

ISOLATION 12.

Project S54 Tarragindi Wynnum Date 16-3-04**DESCRIPTION**

MAINS DETAILS:

LOCATIONS:

SIZE:

MATERIAL:

COATING:

VALVE No.

Cnr ILLIDGE + Chatsworth.42" - 36"Mild SteelT/A.351**IN GROUND TESTING**

BOLT TO FLANGE RESISTANCE:

all Bolts. > 200Ω

NUMBER OF BOLT:

FLANGE TO FLANGE RESISTANCE:

45 Ω

INSULATION CHECKER MODEL 702:

N/A.**POTENTIAL DIFFERENCE TO REFERENCE CELL**

PROTECTED SIDE:

- 480 mV

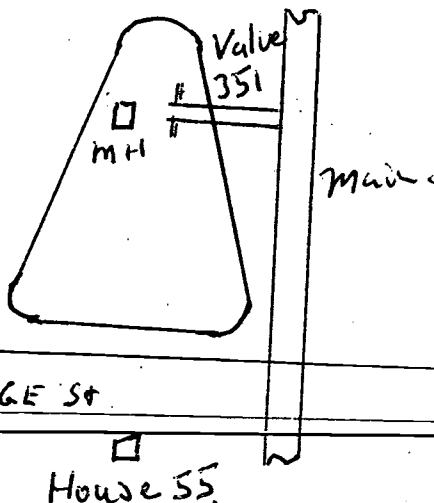
UNPROTECTED SIDE:

- 430 mV**ABOVE TESTING**

BOLT TO FLANGE RESISTANCE:

NUMBER OF BOLTS:

FLANGE TO FLANGE RESISTANCE:

COMMENTS / LOCATION DRAWING

Chatsworth

TESTED BY

P. Smyth

Brisbane Water Engineering Services

CP Form No. 21

Electrical Engineering Unit

Insulated Joint Testing Details Form

Isolation 13

Project Sect 54 Tarragindi - Wynnum Date 14-3-04DESCRIPTION

MAINS DETAILS:

LOCATIONS:

SIZE:

MATERIAL:

COATING:

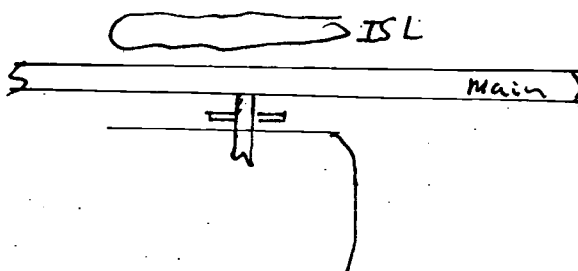
VALVE No.

Chatsworth & Boundary42"-36"Mild SteelT/E12" BrIN GROUND TESTINGBOLT TO FLANGE RESISTANCE: all Bolts > 200 Ω NUMBER OF BOLT: 12FLANGE TO FLANGE RESISTANCE: 0.8 K Ω INSULATION CHECKER MODEL 702: N/APOTENTIAL DIFFERENCE TO REFERENCE CELLPROTECTED SIDE: -560UNPROTECTED SIDE: -480ABOVE TESTING

BOLT TO FLANGE RESISTANCE: _____

NUMBER OF BOLTS: _____

FLANGE TO FLANGE RESISTANCE: _____

COMMENTS / LOCATION DRAWINGChatsworthTESTED BY P. Smyth

Brisbane Water Engineering Services

CP Form No. 21

Electrical Engineering Unit**Insulated Joint Testing Details Form**Project Tarragindi To WynnumDate 14-10-03
ISOLATION N° 14**DESCRIPTION**

MAINS DETAILS:

LOCATIONS:

SIZE:

MATERIAL:

COATING:

VALVE No.

S54ProuT + Thomas.42" to 36"Mild Steel.**IN GROUND TESTING**

BOLT TO FLANGE RESISTANCE:

NUMBER OF BOLT:

FLANGE TO FLANGE RESISTANCE:

INSULATION CHECKER MODEL 702:

all Bolts > 200Ω122-5 mΩN/A.**POTENTIAL DIFFERENCE TO REFERENCE CELL.**

PROTECTED SIDE:

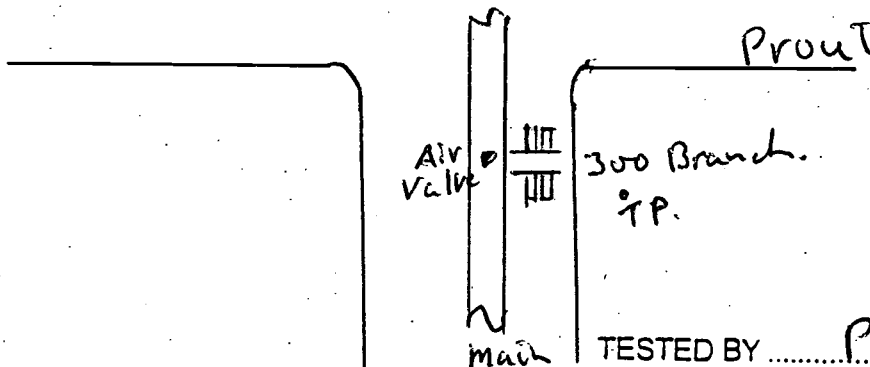
UNPROTECTED SIDE:

-580-318**ABOVE TESTING**

BOLT TO FLANGE RESISTANCE:

NUMBER OF BOLTS:

FLANGE TO FLANGE RESISTANCE:

COMMENTS / LOCATION DRAWINGTHOMAS.

Brisbane Water Engineering Services

CP Form No. 21

Electrical Engineering Unit**Insulated Joint Testing Details Form**Project S 54Date 28-10-03
Isolation No 15**DESCRIPTION**

MAINS DETAILS:

LOCATIONS:

SIZE:

MATERIAL:

COATING:

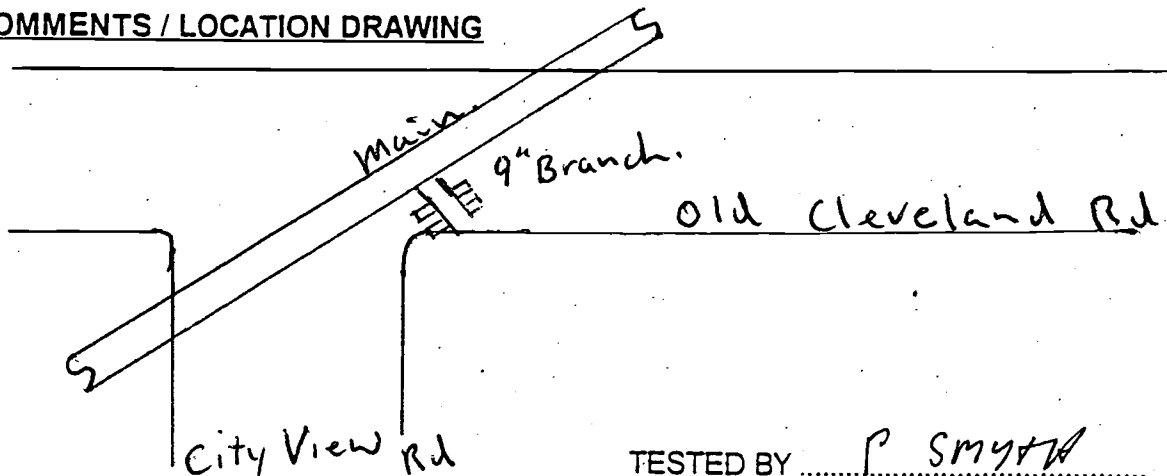
VALVE No.

Old Cleveland Rd42-36"Mild SteelT/A.**IN GROUND TESTING**BOLT TO FLANGE RESISTANCE: all Bolts > 200 Ω NUMBER OF BOLT: 12FLANGE TO FLANGE RESISTANCE: 1 M Ω INSULATION CHECKER MODEL 702: N/APOTENTIAL DIFFERENCE TO REFERENCE CELLPROTECTED SIDE: -550 mVUNPROTECTED SIDE: -388 mV**ABOVE TESTING**

BOLT TO FLANGE RESISTANCE: _____

NUMBER OF BOLTS: _____

FLANGE TO FLANGE RESISTANCE: _____

COMMENTS / LOCATION DRAWINGTESTED BY P Smyth

Brisbane Water Engineering Services

CP Form No. 21

Electrical Engineering Unit

Insulated Joint Testing Details FormProject S54 Tarragindi - WynnumDate 29-4-03Isolation 16**DESCRIPTION**

MAINS DETAILS:

LOCATIONS:

SIZE:

MATERIAL:

COATING:

VALVE No.

Old Cleveland Rd42"-36"Mild Steel**IN GROUND TESTING**

BOLT TO FLANGE RESISTANCE:

All Bolts 7200 Ω

NUMBER OF BOLT:

12

FLANGE TO FLANGE RESISTANCE:

4.5 K Ω

INSULATION CHECKER MODEL 702:

POTENTIAL DIFFERENCE TO REFERENCE CELL

PROTECTED SIDE:

-593 mV

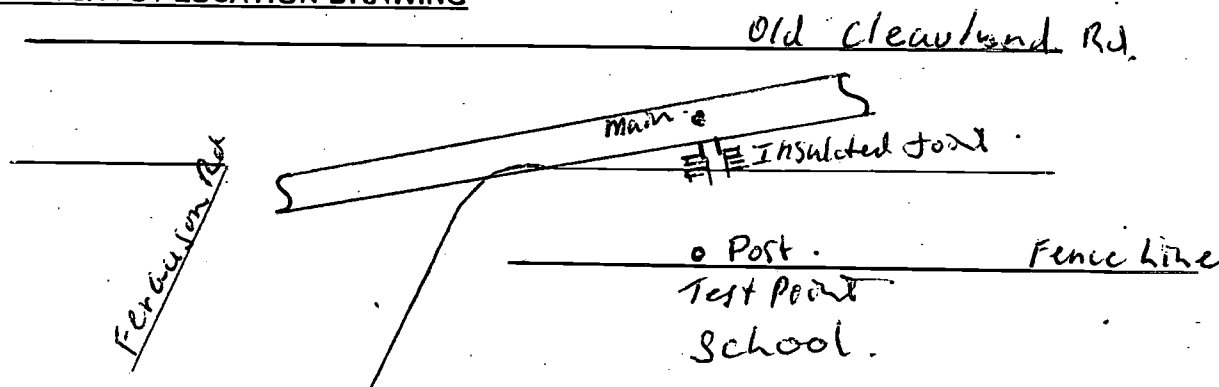
UNPROTECTED SIDE:

-533 mV**ABOVE TESTING**

BOLT TO FLANGE RESISTANCE:

NUMBER OF BOLTS:

FLANGE TO FLANGE RESISTANCE:

COMMENTS / LOCATION DRAWINGTESTED BY P. Smyth

Brisbane Water Engineering Services

CP Form No. 21

Electrical Engineering Unit

Insulated Joint Testing Details FormProject S54Date 29-4-03
Isolation 17**DESCRIPTION**

MAINS DETAILS:

LOCATIONS:

SIZE:

MATERIAL:

COATING:

VALVE No.

Tarragindi Wynnum
Cnr The Promenade + Stanley
42" - 36"
Mild Steel
9" Branch

IN GROUND TESTING

BOLT TO FLANGE RESISTANCE:

NUMBER OF BOLT:

FLANGE TO FLANGE RESISTANCE:

INSULATION CHECKER MODEL 702:

All Bolts > 200Ω2 KΩN/APOTENTIAL DIFFERENCE TO REFERENCE CELL:

PROTECTED SIDE:

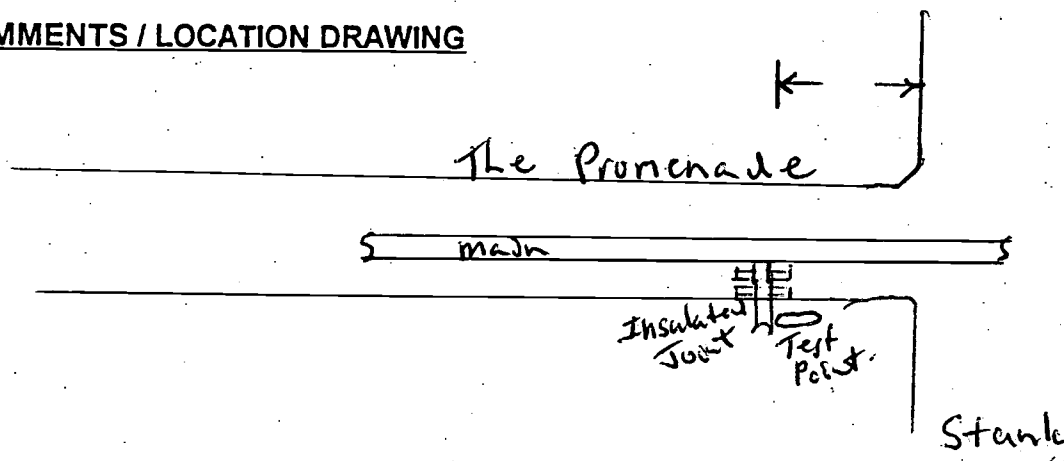
UNPROTECTED SIDE:

-493-345**ABOVE TESTING**

BOLT TO FLANGE RESISTANCE:

NUMBER OF BOLTS:

FLANGE TO FLANGE RESISTANCE:

COMMENTS / LOCATION DRAWINGTESTED BY P. Smyth

Brisbane Water Engineering Services

CP Form No. 21

Electrical Engineering Unit

Insulated Joint Testing Details FormProject S.54Date 15-4-03Isolation No 18**DESCRIPTION**

MAINS DETAILS:

LOCATIONS:

SIZE:

MATERIAL:

COATING:

VALVE No.

Tarragindi - Wynnum Rd
511 Darcy Rd
42" - 36"
Mild Steel
9" Branch

IN GROUND TESTING

BOLT TO FLANGE RESISTANCE:

NUMBER OF BOLT:

FLANGE TO FLANGE RESISTANCE:

INSULATION CHECKER MODEL 702:

all Bolts > 200 Ω 0.25 m Ω N/A**POTENTIAL DIFFERENCE TO REFERENCE CELL:**

PROTECTED SIDE:

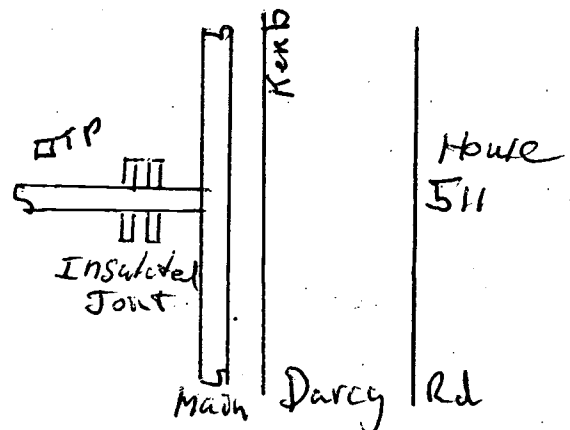
UNPROTECTED SIDE:

- 516- 465**ABOVE TESTING**

BOLT TO FLANGE RESISTANCE:

NUMBER OF BOLTS:

FLANGE TO FLANGE RESISTANCE:

8m**COMMENTS / LOCATION DRAWING**TESTED BY P. Smyth

Brisbane Water Engineering Services

CP Form No. 21

Electrical Engineering Unit

Insulated Joint Testing Details Form

Isolation 19

Project S54 Tarragindi - WynnumDate 28-10-03**DESCRIPTION**

MAINS DETAILS:

LOCATIONS:

534 Darcy Rd

SIZE:

42" - 36"

MATERIAL:

Mild Steel

COATING:

VALVE No.

9" Branch**IN GROUND TESTING**

BOLT TO FLANGE RESISTANCE:

7 all Bolts. 7200 Ω

NUMBER OF BOLT:

12

FLANGE TO FLANGE RESISTANCE:

0.875 m Ω

INSULATION CHECKER MODEL 702:

N/A**POTENTIAL DIFFERENCE TO REFERENCE CELL**

PROTECTED SIDE:

-410 mV

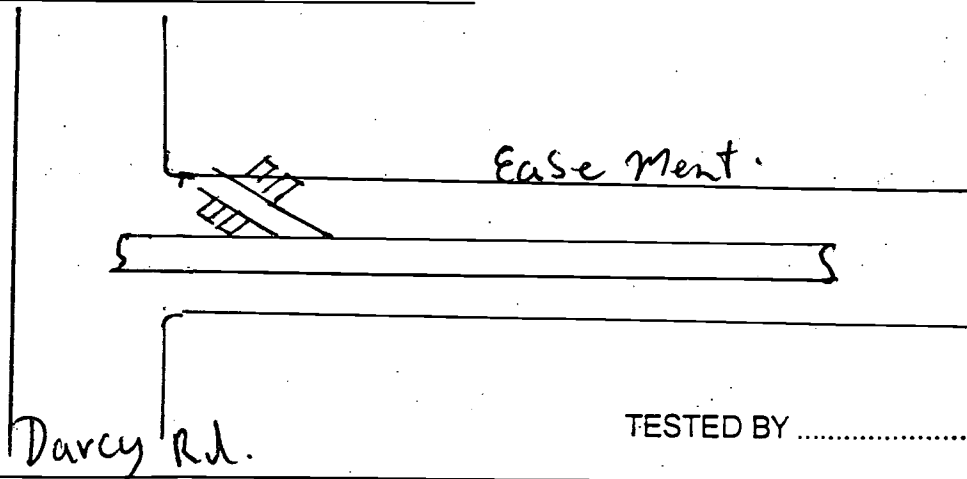
UNPROTECTED SIDE:

-300 mV**ABOVE TESTING**

BOLT TO FLANGE RESISTANCE:

NUMBER OF BOLTS:

FLANGE TO FLANGE RESISTANCE:

COMMENTS / LOCATION DRAWING

TESTED BY

Brisbane Water Engineering Services

CP Form No. 21

Electrical Engineering Unit**Insulated Joint Testing Details Form**Project Tarragindi - Wynnum Rd.Date 11-11-03**DESCRIPTION**

isolation 20

MAINS DETAILS:

S54

LOCATIONS:

Richmond + Muir Rd.

SIZE:

MATERIAL:

M SCL

COATING:

Tar Asbestos

VALVE No.

IN GROUND TESTINGBOLT TO FLANGE RESISTANCE: > 0.4 m Ω NUMBER OF BOLT: 8FLANGE TO FLANGE RESISTANCE: 17 Ω INSULATION CHECKER MODEL 702: 1N11**POTENTIAL DIFFERENCE TO REFERENCE CELL:**

PROTECTED SIDE:

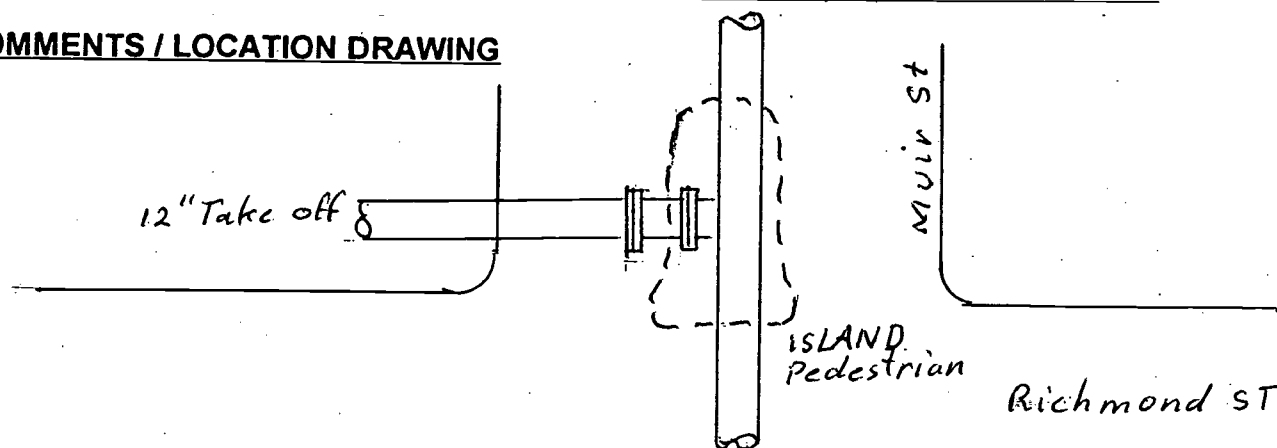
UNPROTECTED SIDE:

ABOVE TESTING

BOLT TO FLANGE RESISTANCE:

NUMBER OF BOLTS:

FLANGE TO FLANGE RESISTANCE:

COMMENTS / LOCATION DRAWINGTESTED BY J Taylor

Brisbane Water Engineering Services

CP Form No. 21

Electrical Engineering Unit

Insulated Joint Testing Details Form

Isolation 21

Project Tarragindi - WynnumDate 30-10-03**DESCRIPTION**

MAINS DETAILS:

LOCATIONS:

SIZE:

MATERIAL:

COATING:

VALVE No.

Cnr Muir & Wynnum42" - 36"Mild SteelT/E12" Dr**IN GROUND TESTING**

BOLT TO FLANGE RESISTANCE:

all Bolts > 200 Ω

NUMBER OF BOLT:

12

FLANGE TO FLANGE RESISTANCE:

69 K Ω

INSULATION CHECKER MODEL 702:

N/APOTENTIAL DIFFERENCE TO REFERENCE CELL:

PROTECTED SIDE:

- 460 mV

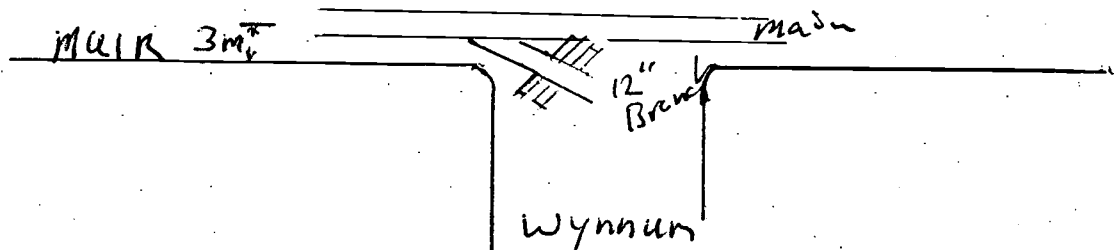
UNPROTECTED SIDE:

- 380 mV**ABOVE TESTING**

BOLT TO FLANGE RESISTANCE:

NUMBER OF BOLTS:

FLANGE TO FLANGE RESISTANCE:

COMMENTS / LOCATION DRAWINGTESTED BY P. SMYTH

Brisbane Water Engineering Services

CP Form No. 21

Electrical Engineering Unit

Insulated Joint Testing Details Form

Isolation No 22

Project S54 Tarragindi To Wynnum

Date 11-11-03

DESCRIPTION

MAINS DETAILS:

LOCATIONS:

SIZE:

MATERIAL:

COATING:

VALVE No.

Chr Muir + Wynnum Rd
42" to 36"
Mild steel
T/E
12" Branch**IN-GROUND TESTING**

BOLT TO FLANGE RESISTANCE:

all Bolts $> 200 \Omega$

NUMBER OF BOLT:

12

FLANGE TO FLANGE RESISTANCE:

.2 K Ω

INSULATION CHECKER MODEL 702:

N/A

POTENTIAL DIFFERENCE TO REFERENCE CELL:

PROTECTED SIDE:

- 485 mV

UNPROTECTED SIDE:

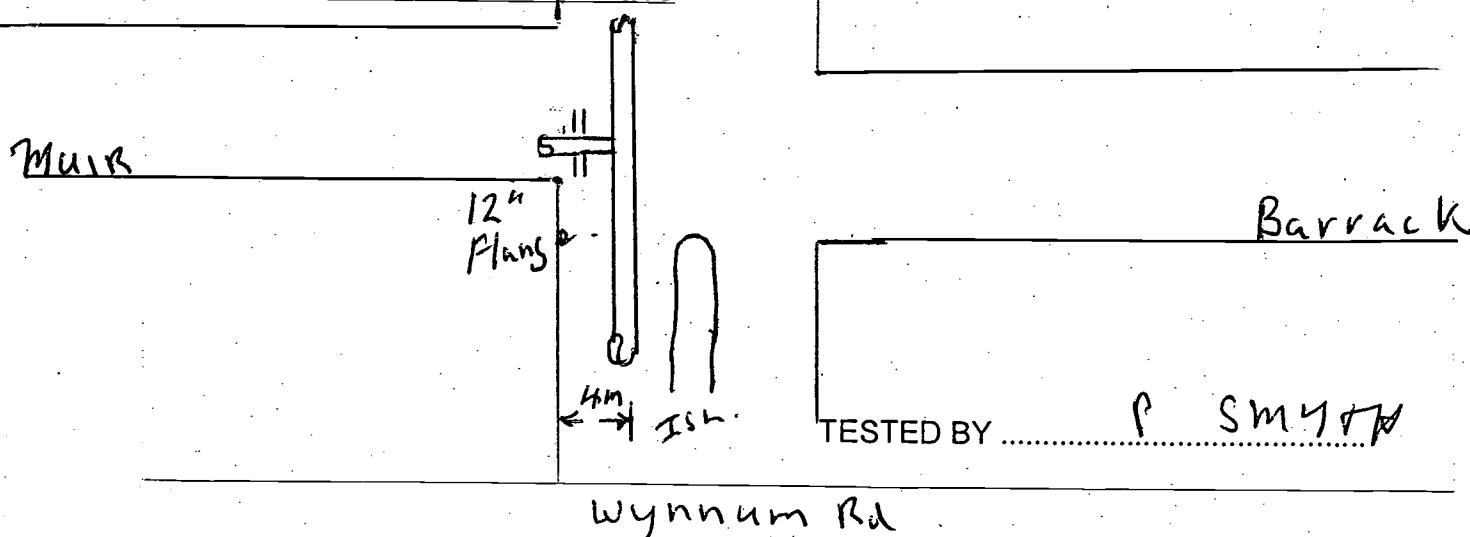
- 310 mV

ABOVE TESTING

BOLT TO FLANGE RESISTANCE:

NUMBER OF BOLTS:

FLANGE TO FLANGE RESISTANCE:

COMMENTS / LOCATION DRAWING

Brisbane Water Engineering Services

CP Form No. 21

Electrical Engineering Unit

Insulated Joint Testing Details Form

ISOLATION N° 24

Project S.E. 53 Murrumbidgee NorthcliffeDate 15-3-06DESCRIPTION

MAINS DETAILS:

LOCATIONS:

SIZE:

MATERIAL:

COATING:

VALVE No.

Cnr Barrack & Wynnum Rdmild steelTA203IN GROUND TESTINGBOLT TO FLANGE RESISTANCE: all Bolts $> 200 \Omega$

NUMBER OF BOLT:

FLANGE TO FLANGE RESISTANCE: 200 Ω INSULATION CHECKER MODEL 702: N/APOTENTIAL DIFFERENCE TO REFERENCE CELL

PROTECTED SIDE:

UNPROTECTED SIDE:

-526-680ABOVE TESTING

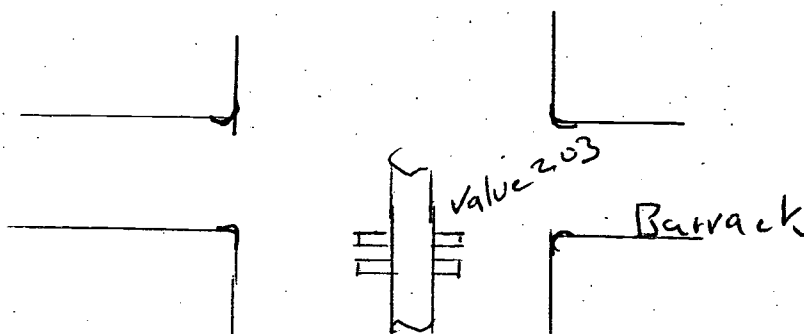
BOLT TO FLANGE RESISTANCE:

NUMBER OF BOLTS:

FLANGE TO FLANGE RESISTANCE:

COMMENTS / LOCATION DRAWING

Wynnum Rd

TESTED BY P. Smyth

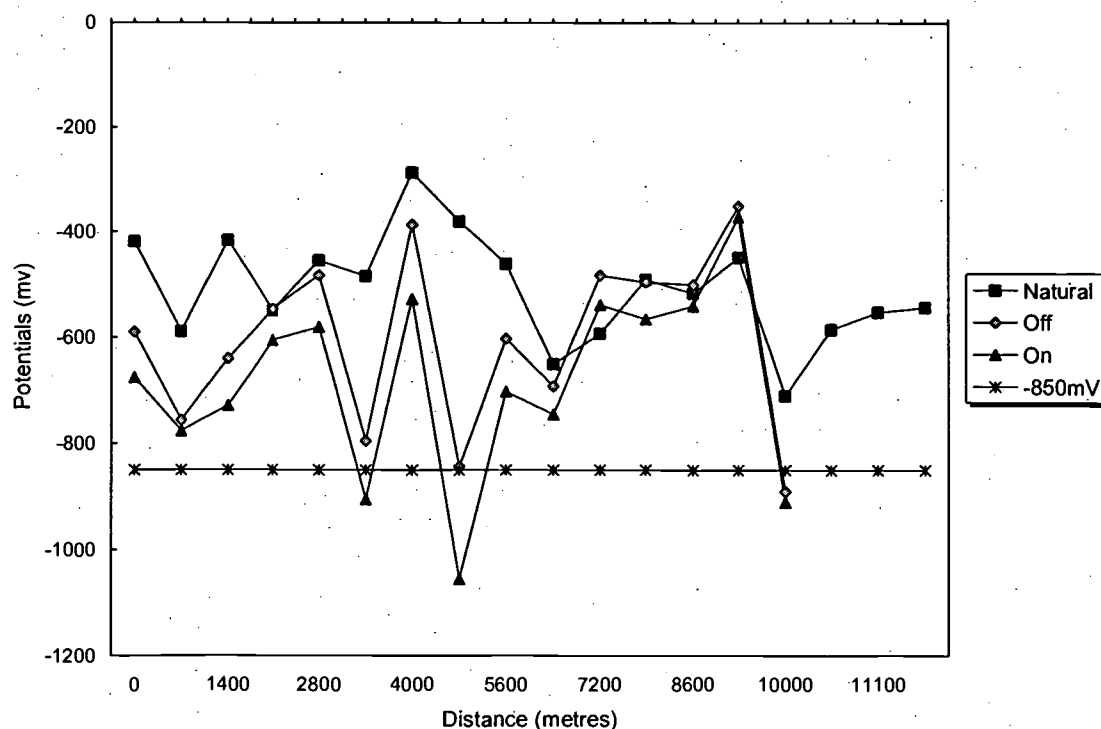
Brisbane Water Engineering Services

CP Form No. 23

Electrical Engineering Unit**Cathodic Protection System Potential Recording Form****Project** Tarragindi to Wynnum Rd.to Lytton Rd S35&S54**Date** 16th June 2004

Test Point Nos 1 to 15 are S54 and Test Points 16 to 18 are S35

Test Point number	Distances to T.P. (metres)	Potentials to CuSO ₄			Distance
		Natural (mV)	Off (mV)	On (mV)	
1	0	-419	-590	-676	0
2	700	-589	-756	-776	700
3	1400	-416	-640	-728	1400
4	1900	-549	-546	-605	1900
5	2800	-454	-482	-580	2800
6	3400	-484	-795	-905	3400
7	4000	-287	-386	-527	4000
8	4800	-380	-844	-1055	4800
9	5600	-460	-602	-702	5600
10	6400	-650	-692	-745	6400
11	7200	-593	-482	-538	7200
12	7900	-490	-495	-565	7900
13	8600	-516	-500	-540	8600
14	9200	-448	-350	-371	9200
15	10000	-710	-890	-910	10000
16	10400	-585			10400
17	11100	-552			11100
18	11600	-543			11600

Rectifiers at
TPs.No6&8**Graph of potentials vs pipelength**

Revision 13/05/2005

Brisbane Water Engineering Services

CP Form No. 23

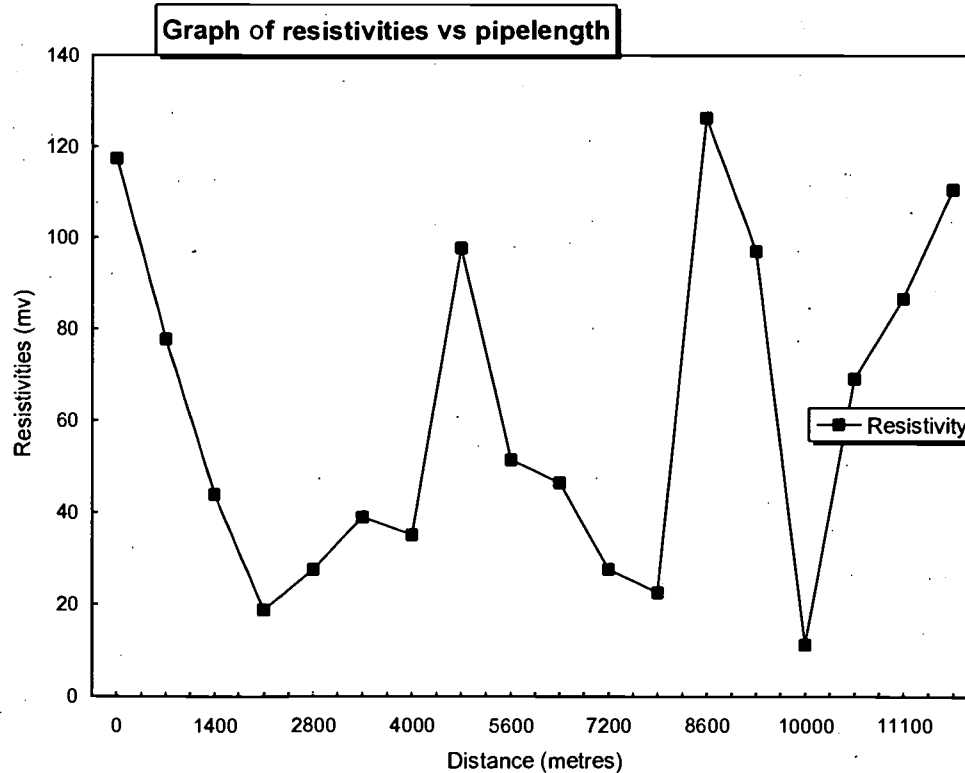
Electrical Engineering Unit**Cathodic Protection System Resistivities Recording Form****Project** Tarragindi to Wynnum Rd. to Lytton Rd. S35 & S54**Date** 16th June 2004

Test Point number	Distances to T.P.	Resistivities at 2 metres
	(metres)	ohm metres
1	0	117.4
2	700	77.8
3	1400	43.9
4	1900	18.8
5	2800	27.6
6	3400	38.9
7	4000	35.1
8	4800	97.7
9	5600	51.4
10	6400	46.4
11	7200	27.6
12	7900	22.6
13	8600	126.3
14	9200	97
15	10000	11.3
16	10400	69.1
17	11100	86.6
18	11600	110.5

Note.

Test Points 1 to 15 are for S54

Test Points 16,17 & 18 are for S35



Revision 21/07/2004

Brisbane Water Engineering Services

Electrical Engineering Unit

Cathodic Protection System Loop Resistance

Mott Park Rectifier CPS 202

Date: 12th May 2005

Cathodic Protection System:

Tarragindi to Wynnum Rd. S54 Trunk Main

System Operating Volts:

27

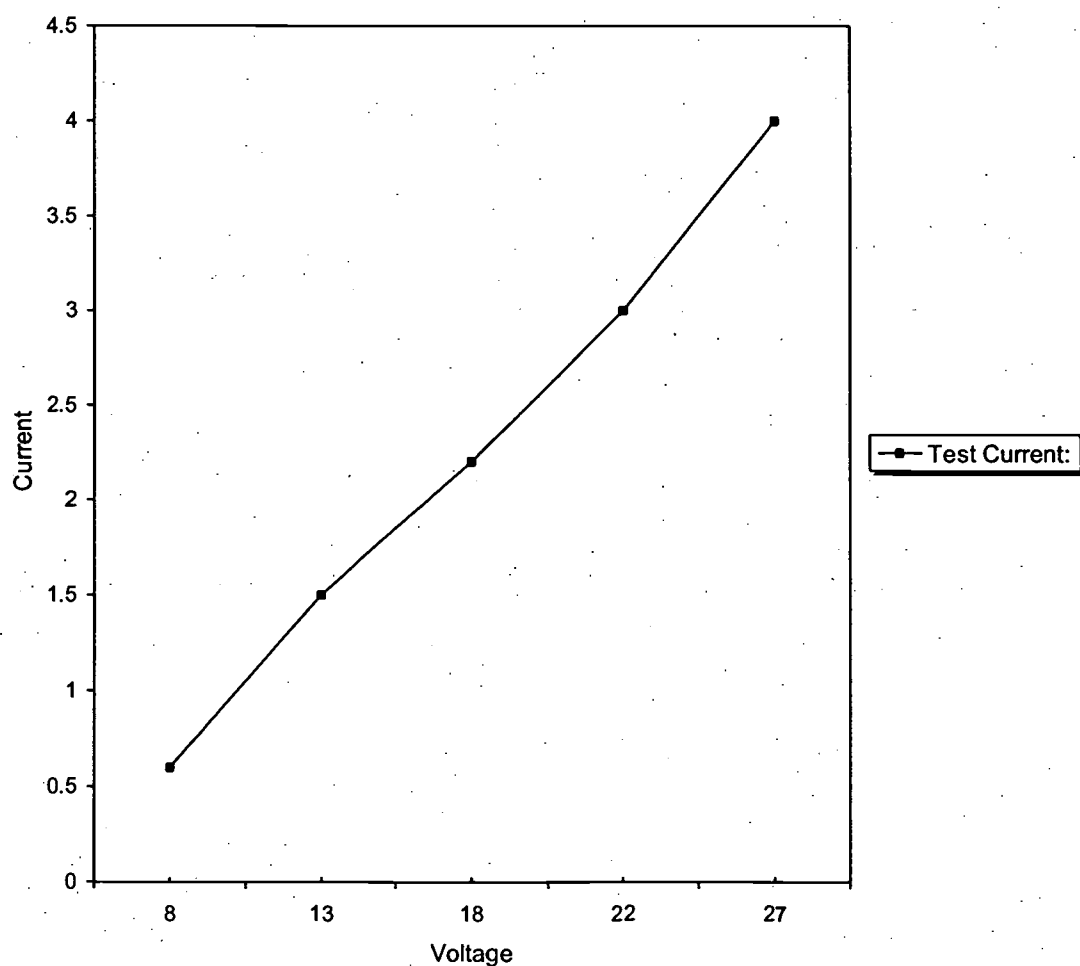
System Operating amps

4

Test Voltage:		Test Current:	
(volts)		(amps)	
8		0.6	
13		1.5	
18		2.2	
22		3	
27		4	

Loop Resistance (ohms)
5

Loop Resistance

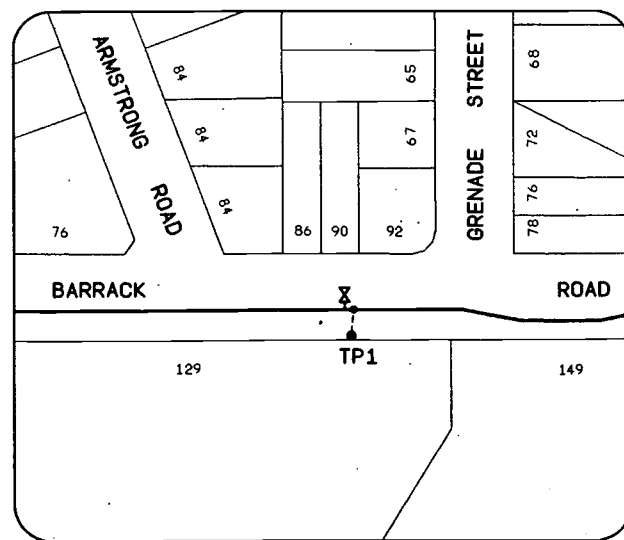


13/05/2005

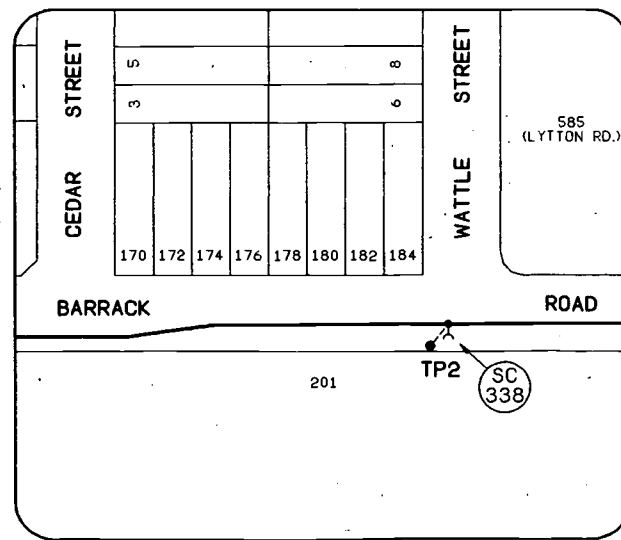
THIS SYSTEM CONTINUES
INTO S54 REFER DRAWING
NO. 2/10.677-01

THIS SYSTEM CONTINUES
INTO S53 REFER DRAWING
NO. 2/10.804-01

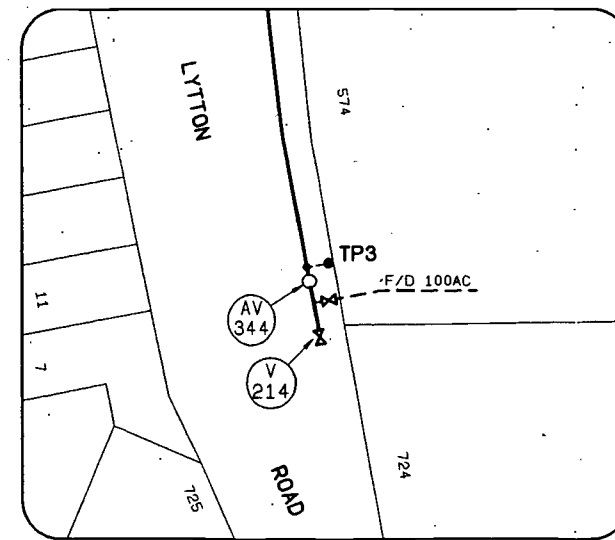
LOCALITY PLAN



TEST POINT NO.1



TEST POINT NO.2



TEST POINT NO.3

DESIGN CHARGE NO.		PA000820	
CONSTRUCTION PROJECT NO.			
AS BUILT RECEIVED			
BY	OFFICER CODE	DATE	
ON MAINTENANCE DETAILS			
START	FINISH	D.R.S. COMMENTS	
FUNDING			
PRIVATE BOOSTER REQUIRED?	YES / NO	DEVELOPER ()	
FUNDED BY BCC (✓)		STATE () OTHER ()	
D.R.S. OFFICER	DATE RELEASED		
PLAN CUSTODIAN			
OFFICER/REC'D	DATE RELEASED		
LIVE CONNECTION(S) / PASSED(W)			
REFERENCE	DATE		
BIMAP CAPTURE			
JOB NUMBER	OFFICER CODE	DATE	
BIMAP COMMENTS			

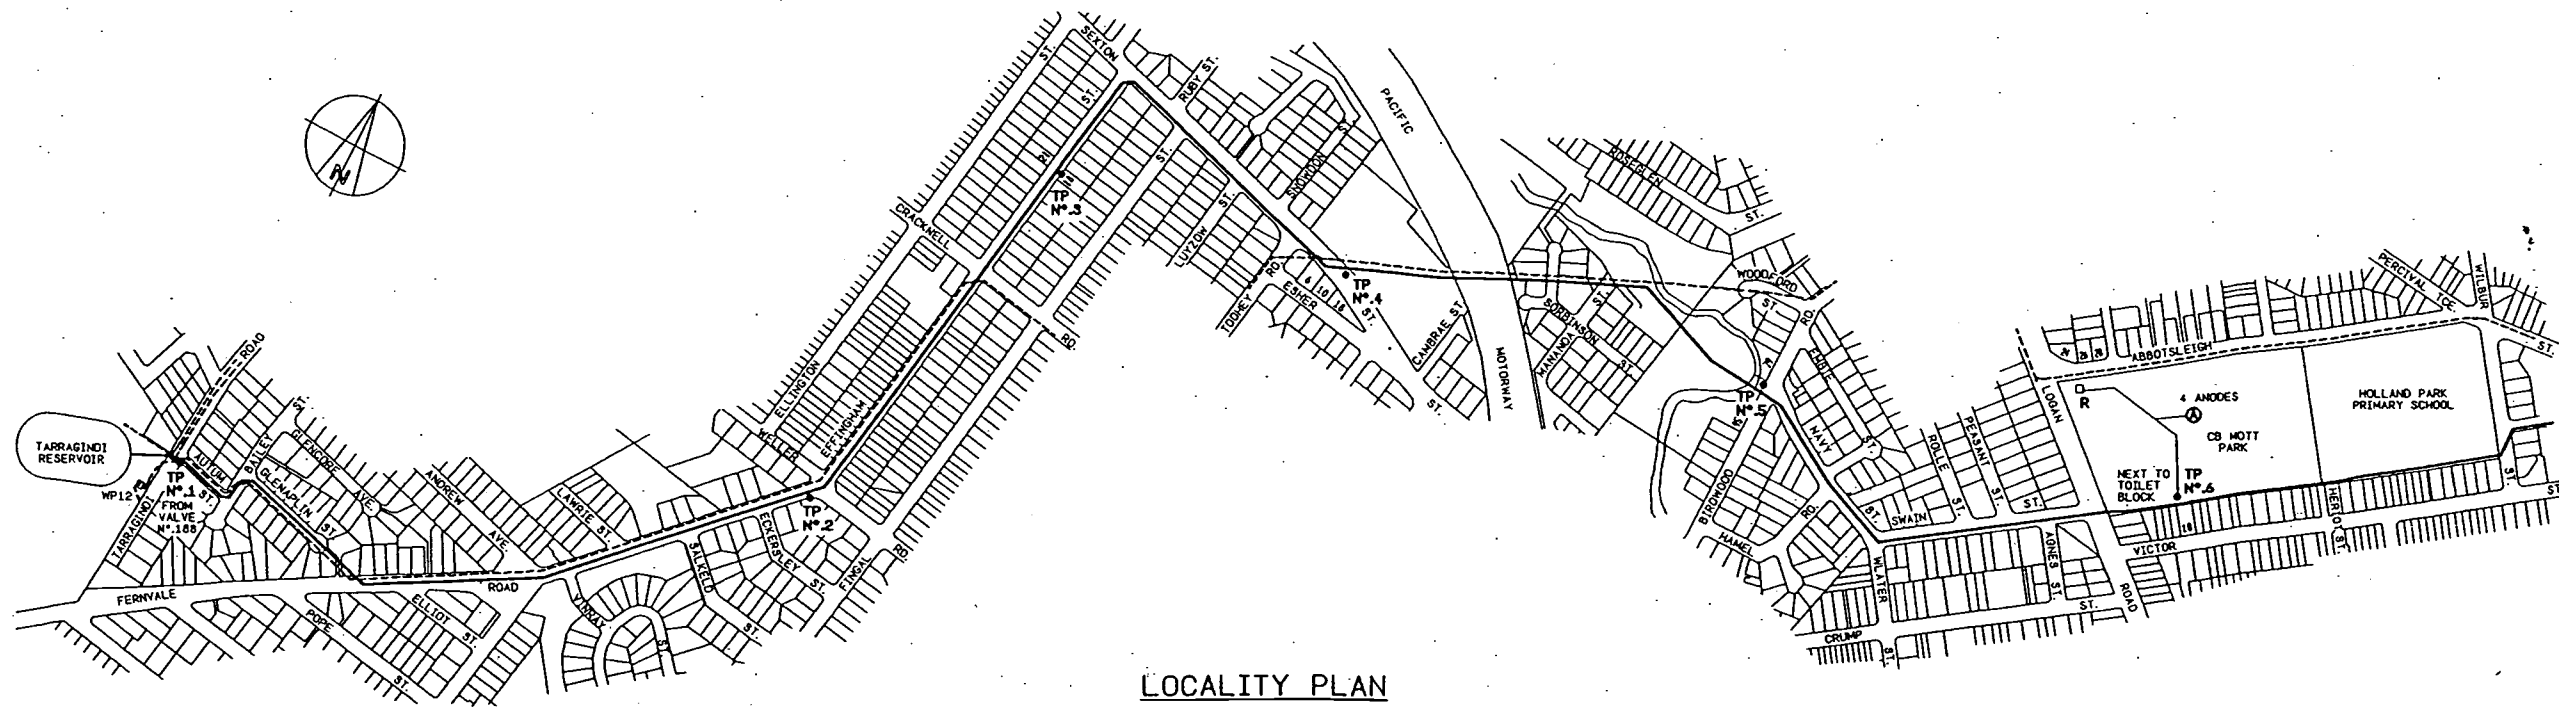
NO. DATE	AMENDMENT	INITIALS	PRINCIPAL ENGINEER	RPEQ. NO.	DATE	CADD FILE	WATER\INFRASTRUCTURE\210231501.DTA	DESIGN		
			MANAGER ENGINEERING		DATE	FILE NO.		DESIGN CHECK		
			PRODUCTION / NETWORK DELEGATE		DATE	SURVEYED		DRAWN	B.O.B	SEPT. 2004
						SURVEY NO.		DRAFTING CHECK		



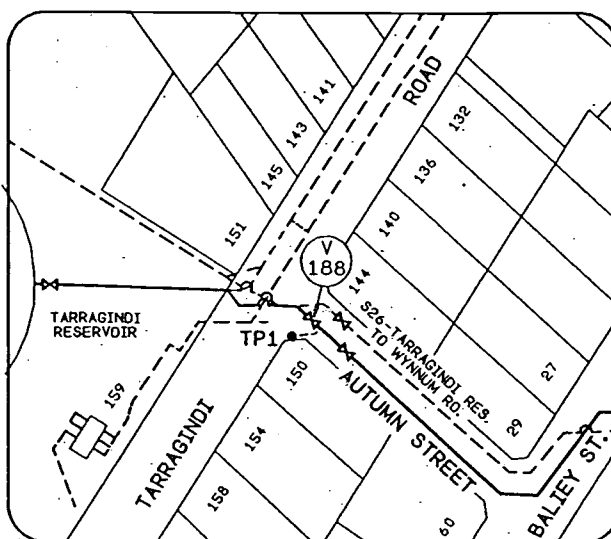
PROJECT
S35-WYNNUM RD. CANNON HILL
TO Q.M.I. ABATTOIR

TITLE
CATHODIC PROTECTION TEST
POINT AND ANODE BED
LOCATIONS

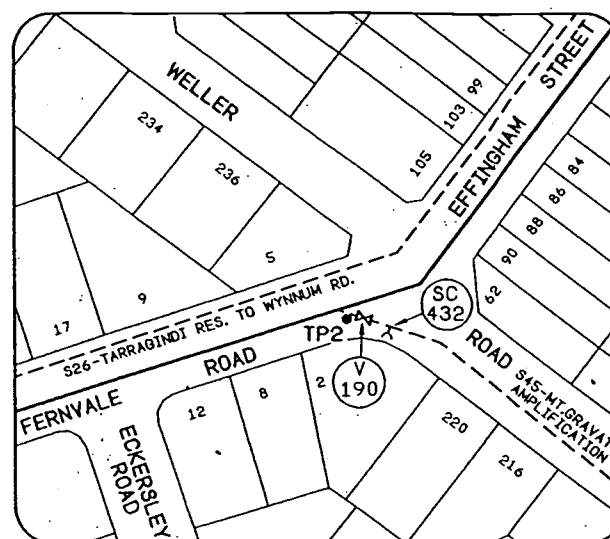
SCALE	A.H. DATUM
DRAWING NO.	NO. 1 OF 1 SHEETS
2/10.2315-01	AMEND. P1



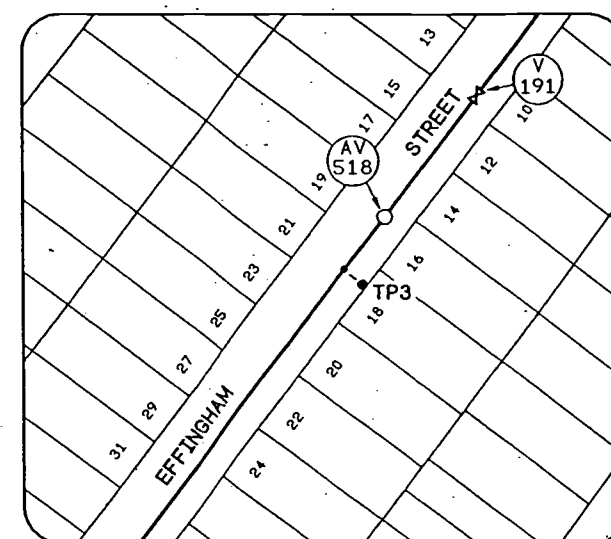
LOCALITY PLAN



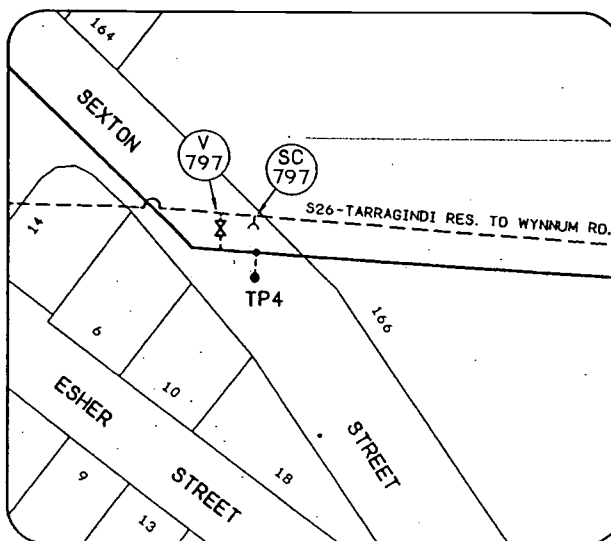
TEST POINT NO.1



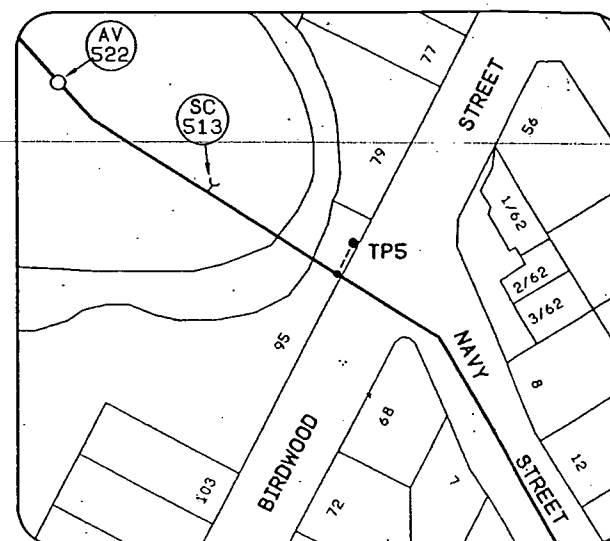
TEST POINT NO.2



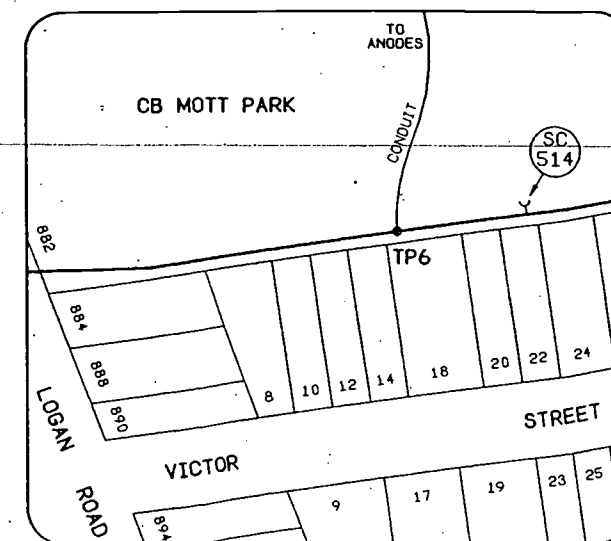
TEST POINT NO.3



TEST POINT NO.4



TEST POINT NO.5



TEST POINT NO.6

DESIGN CHARGE NO.	
PA000820	
CONSTRUCTION PROJECT NO.	
AS BUILT RECEIVED	
BY	DATE
OFFICER CODE	DATE
ON MAINTENANCE DETAILS	
START	FINISH
DRS. COMMENTS	
FUNDING	
PRIVATE BOOSTER REQUIRED?	YES / NO
FUNDED BY BCC (✓)	DEVELOPER ()
FED. GOVT ()	STATE ()
OTHER ()	
DRS OFFICER	DATE RELEASED
PLAN CUSTODIAN	
OFFICER/RECD	DATE RELEASED
LIVE CONNECTIONS / PASSED(W)	
REFERENCE	DATE
BMAP CAPTURE	
JOB NUMBER	OFFICER CODE
DATE	
BMAP COMMENTS	

NO	DATE	AMENDMENT	INITIALS

PRINCIPAL ENGINEER	RPEQ. NO.	DATE
MANAGER ENGINEERING		DATE
PRODUCTION / NETWORK DELEGATE		DATE

CADD FILE	WATER\INFRASTRUCTURE\21067701.DTA
FILE NO.	
SURVEYED	
SURVEY NO.	FIELD BOOK

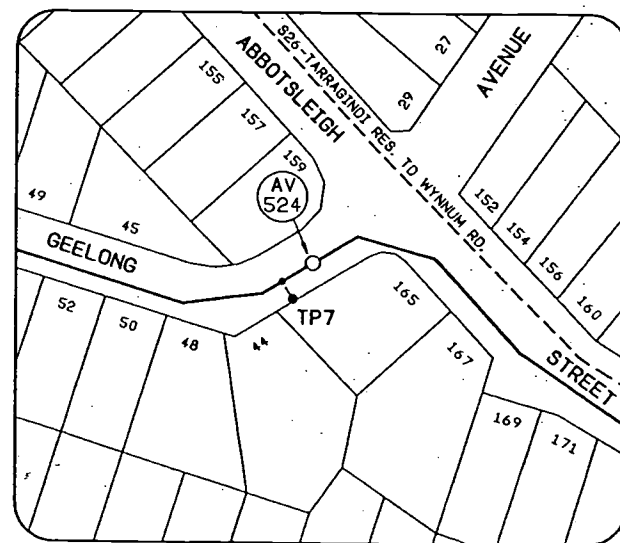
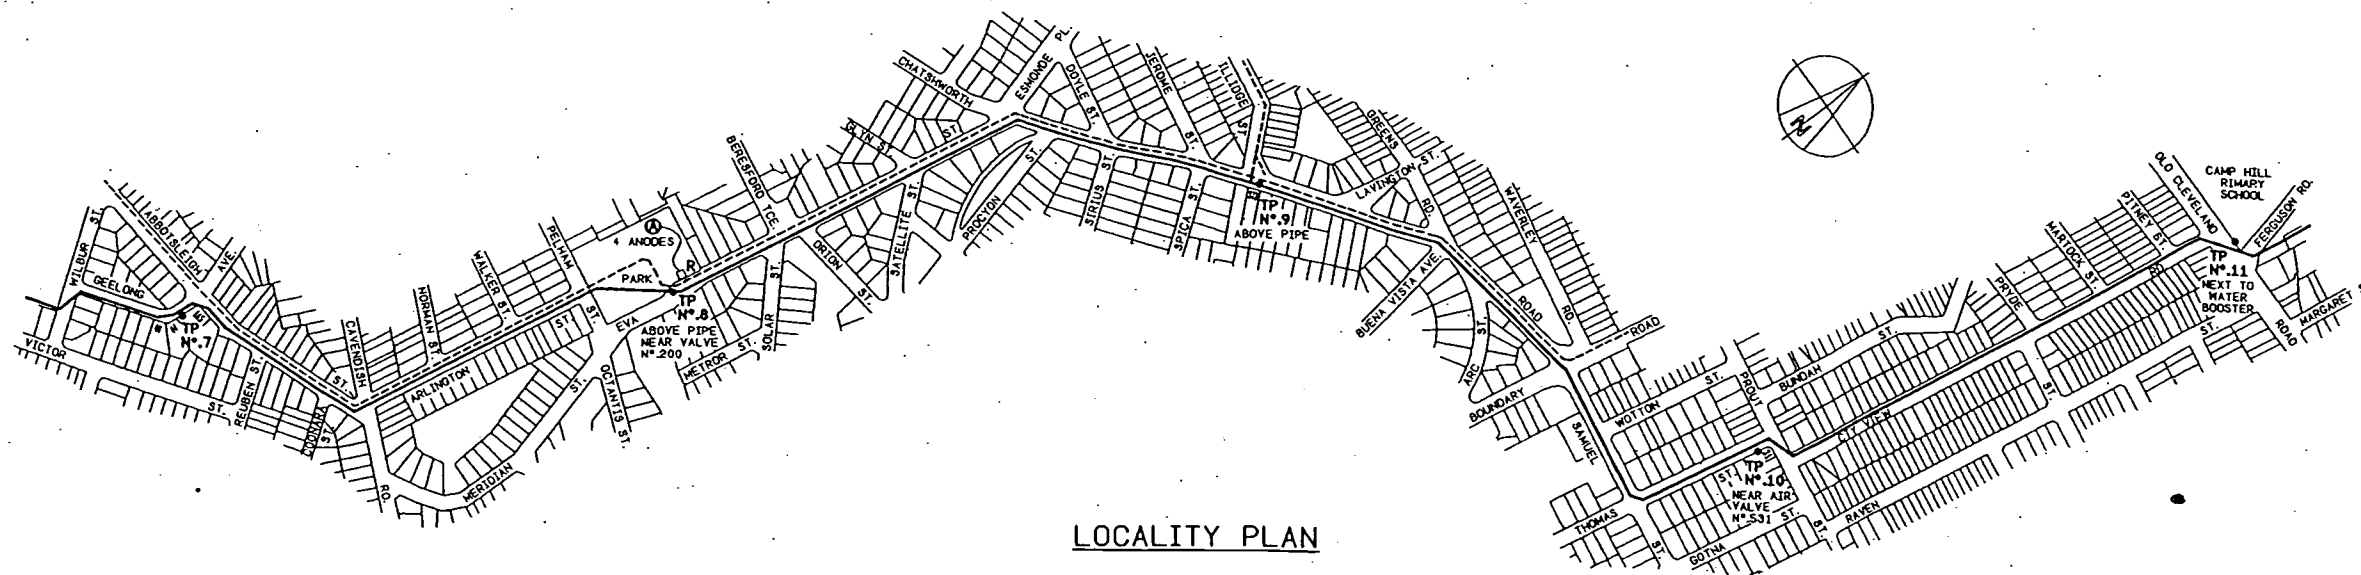
DESIGN		
DESIGN CHECK		
DRAWN	B.O.B	OCT. 2004
DRAFTING CHECK		



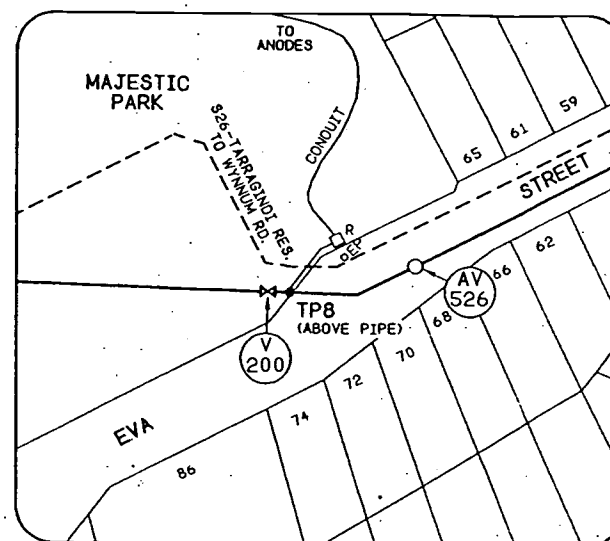
PROJECT	S54-TARRAGINDI TO WYNNUM RD.
---------	------------------------------

TITLE	CATHODIC PROTECTION TEST POINT LOCATIONS
	TEST POINT NOS. 1 TO 5

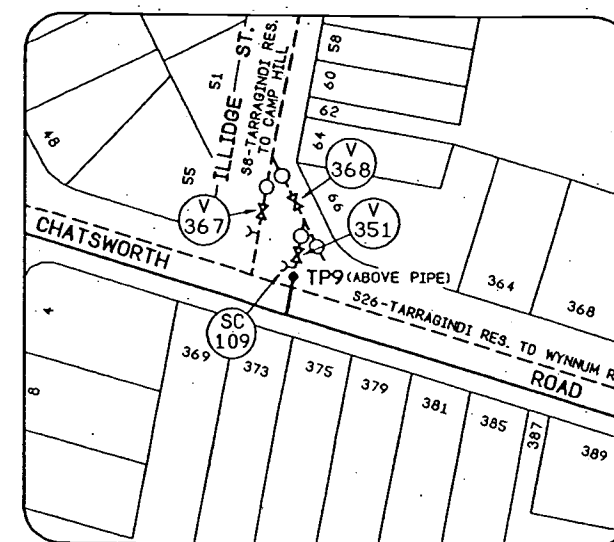
SCALE	AS SHOWN	A.H. DATUM
DRAWING NO.	2/10.677-01	NO. 1 OF 5 SHEETS
		AMEND. P1



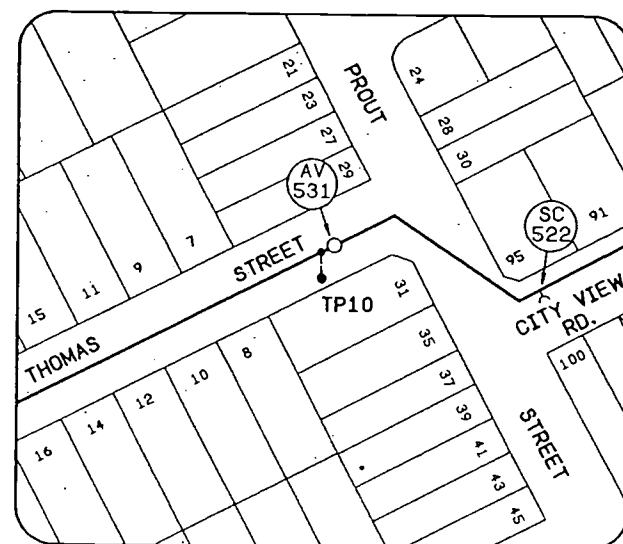
TEST POINT NO.7



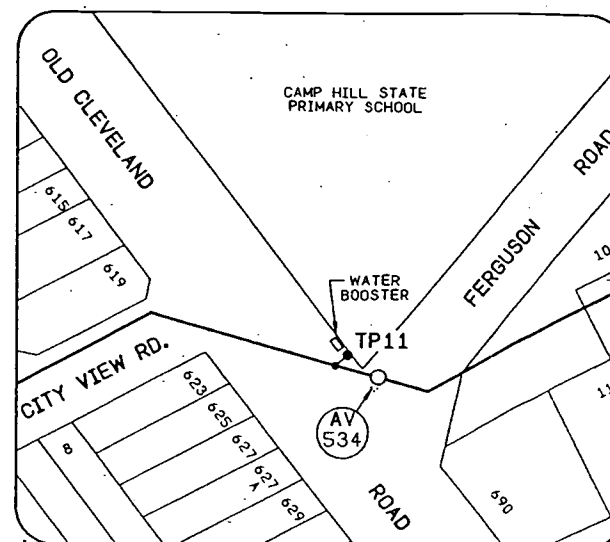
TEST POINT NO.8



TEST POINT NO.9



TEST POINT NO.10



TEST POINT NO.11

DESIGN CHARGE NO.	
PA000820	
CONSTRUCTION PROJECT NO.	
AS BUILT RECEIVED	
BY	OFFICER CODE
DATE	
ON MAINTENANCE DETAILS	
START	FINISH
DRS-COMMENTS	
RUNNING	
PRIVATE BOOSTER REQUIRED?	YES / NO
FUNDED BY BCC (✓)	DEVELOPER ()
FED GOVT ()	STATE () OTHER ()
DRS OFFICER	
DATE RELEASED	
PLAN CUSTODIAN	
OFFICER/REC'D	DATE RELEASED
LIVE CONNECTION(S) / PASSED(W)	
REFERENCE	DATE
BMAP CAPTURE	
JOB NUMBER	OFFICER CODE
DATE	
BMAP COMMENTS	

NO.	DATE	AMENDMENT	INITIALS	PRINCIPAL ENGINEER	RPEQ NO.	DATE	CADD FILE	WATER/INFRASTRUCTURE\21067702.DTA	DESIGN	DESIGN CHECK	DRAWN	DRAFTING CHECK
1												
2												
Brisbane
Water

PROJECT
S54-TARRAGINDI TO WYNNUM RD.

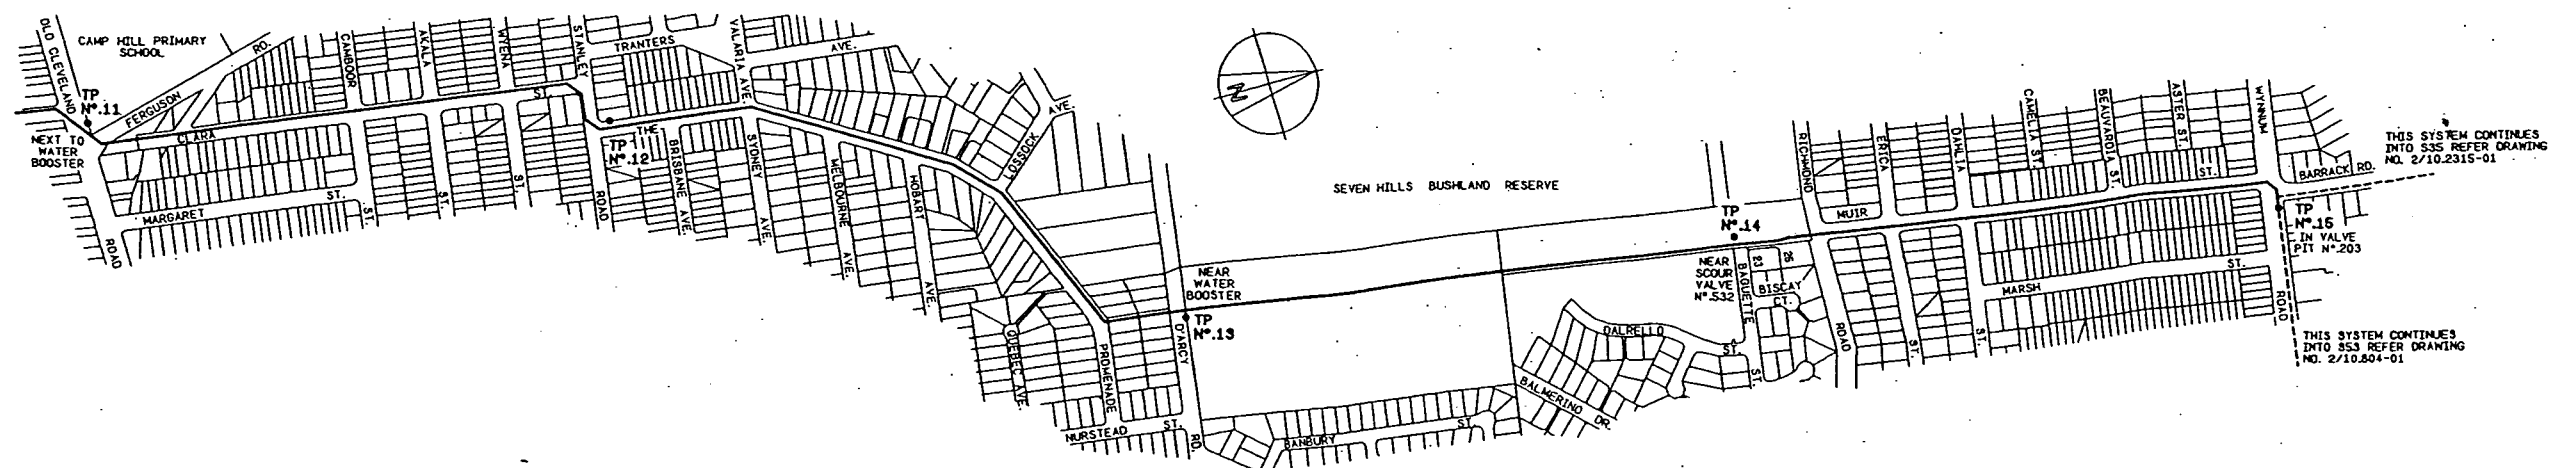
TITLE
CATHODIC PROTECTION TEST
POINT LOCATIONS
TEST POINT NOS. 7 TO 11

SCALE
AS SHOWN

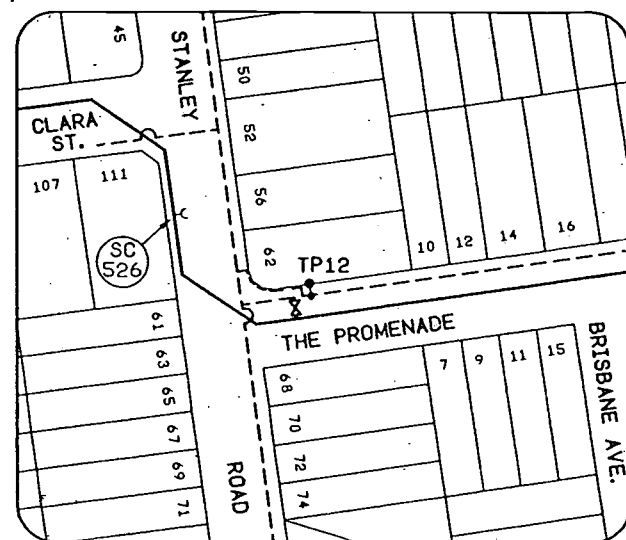
A.H. DATUM
N° 2 OF 5 SHEETS

DRAWING N°
2/10,677-02

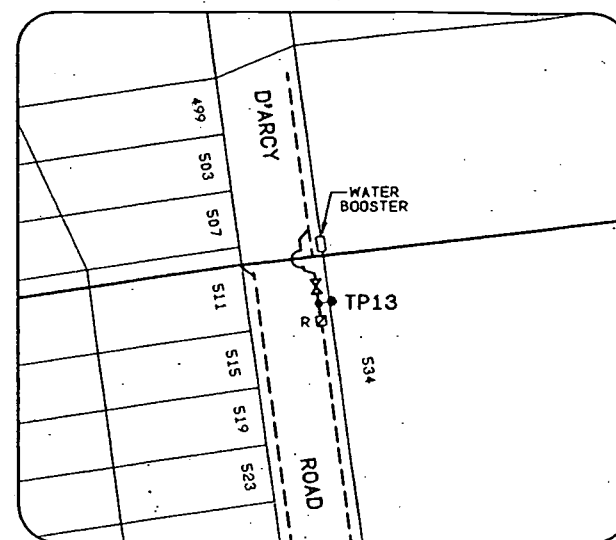
AMEND.
P



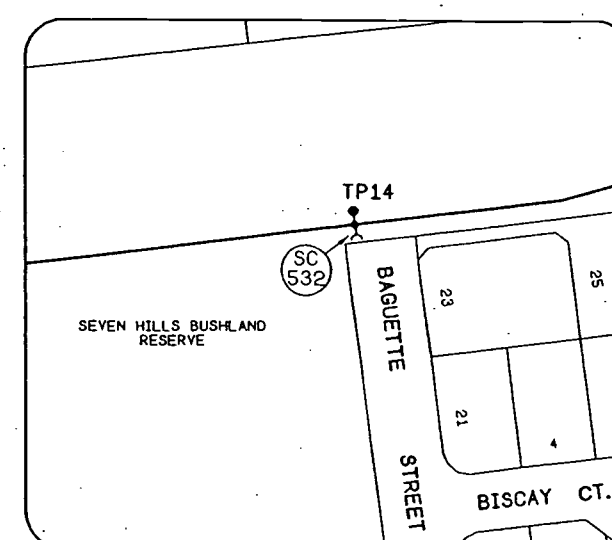
LOCALITY PLAN



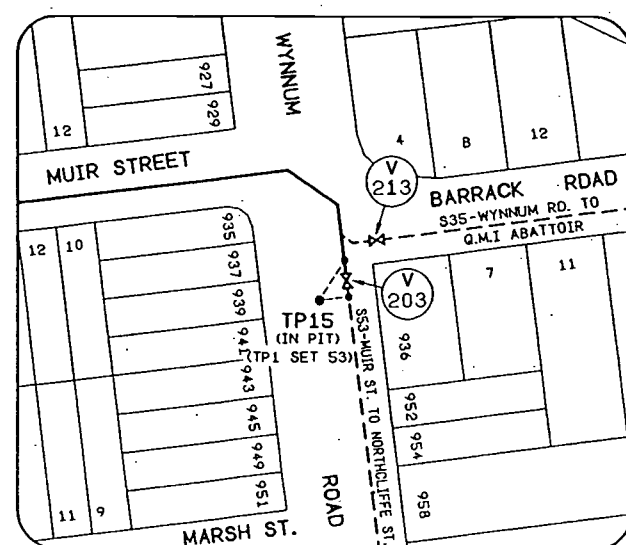
TEST POINT NO.12



TEST POINT NO.13



TEST POINT NO.14



TEST POINT NO.15

DESIGN CHARGE NO.	
PA000820	
CONSTRUCTION PROJECT NO.	
AS BUILT RECEIVED	
BY	
OFFICER CODE	
DATE	
ON MAINTENANCE DETAILS	
START	FINISH
D.R.S. COMMENTS	
FUNDING	
PRIVATE BOOSTER REQUIRED?	YES / NO
FUNDED BY BCC	(✓) DEVELOPER ()
FED. GOVT ()	STATE () OTHER ()
D.R.S. OFFICER	
DATE RELEASED	
PLAN CUSTODIAN	
OFFICER/REC'D	
DATE RELEASED	
LIVE CONNECTION(S) / PASSED(W)	
REFERENCE	
DATE	
BMAP CAPTURE	
JOB NUMBER	
OFFICER CODE	
DATE	
BMAP COMMENTS	

NO	DATE	AMENDMENT	INITIALS	PRINCIPAL ENGINEER	RPEQ NO.	DATE	CADD FILE	FILE NO.	SURVEYED	SURVEY NO.	FIELD BOOK	DESIGN	DESIGN CHECK	DRAWN	DRAFTING CHECK
							\\WATER\INFRASTRUCTURE\21067703.01A							B.O.B	OCT. 2004



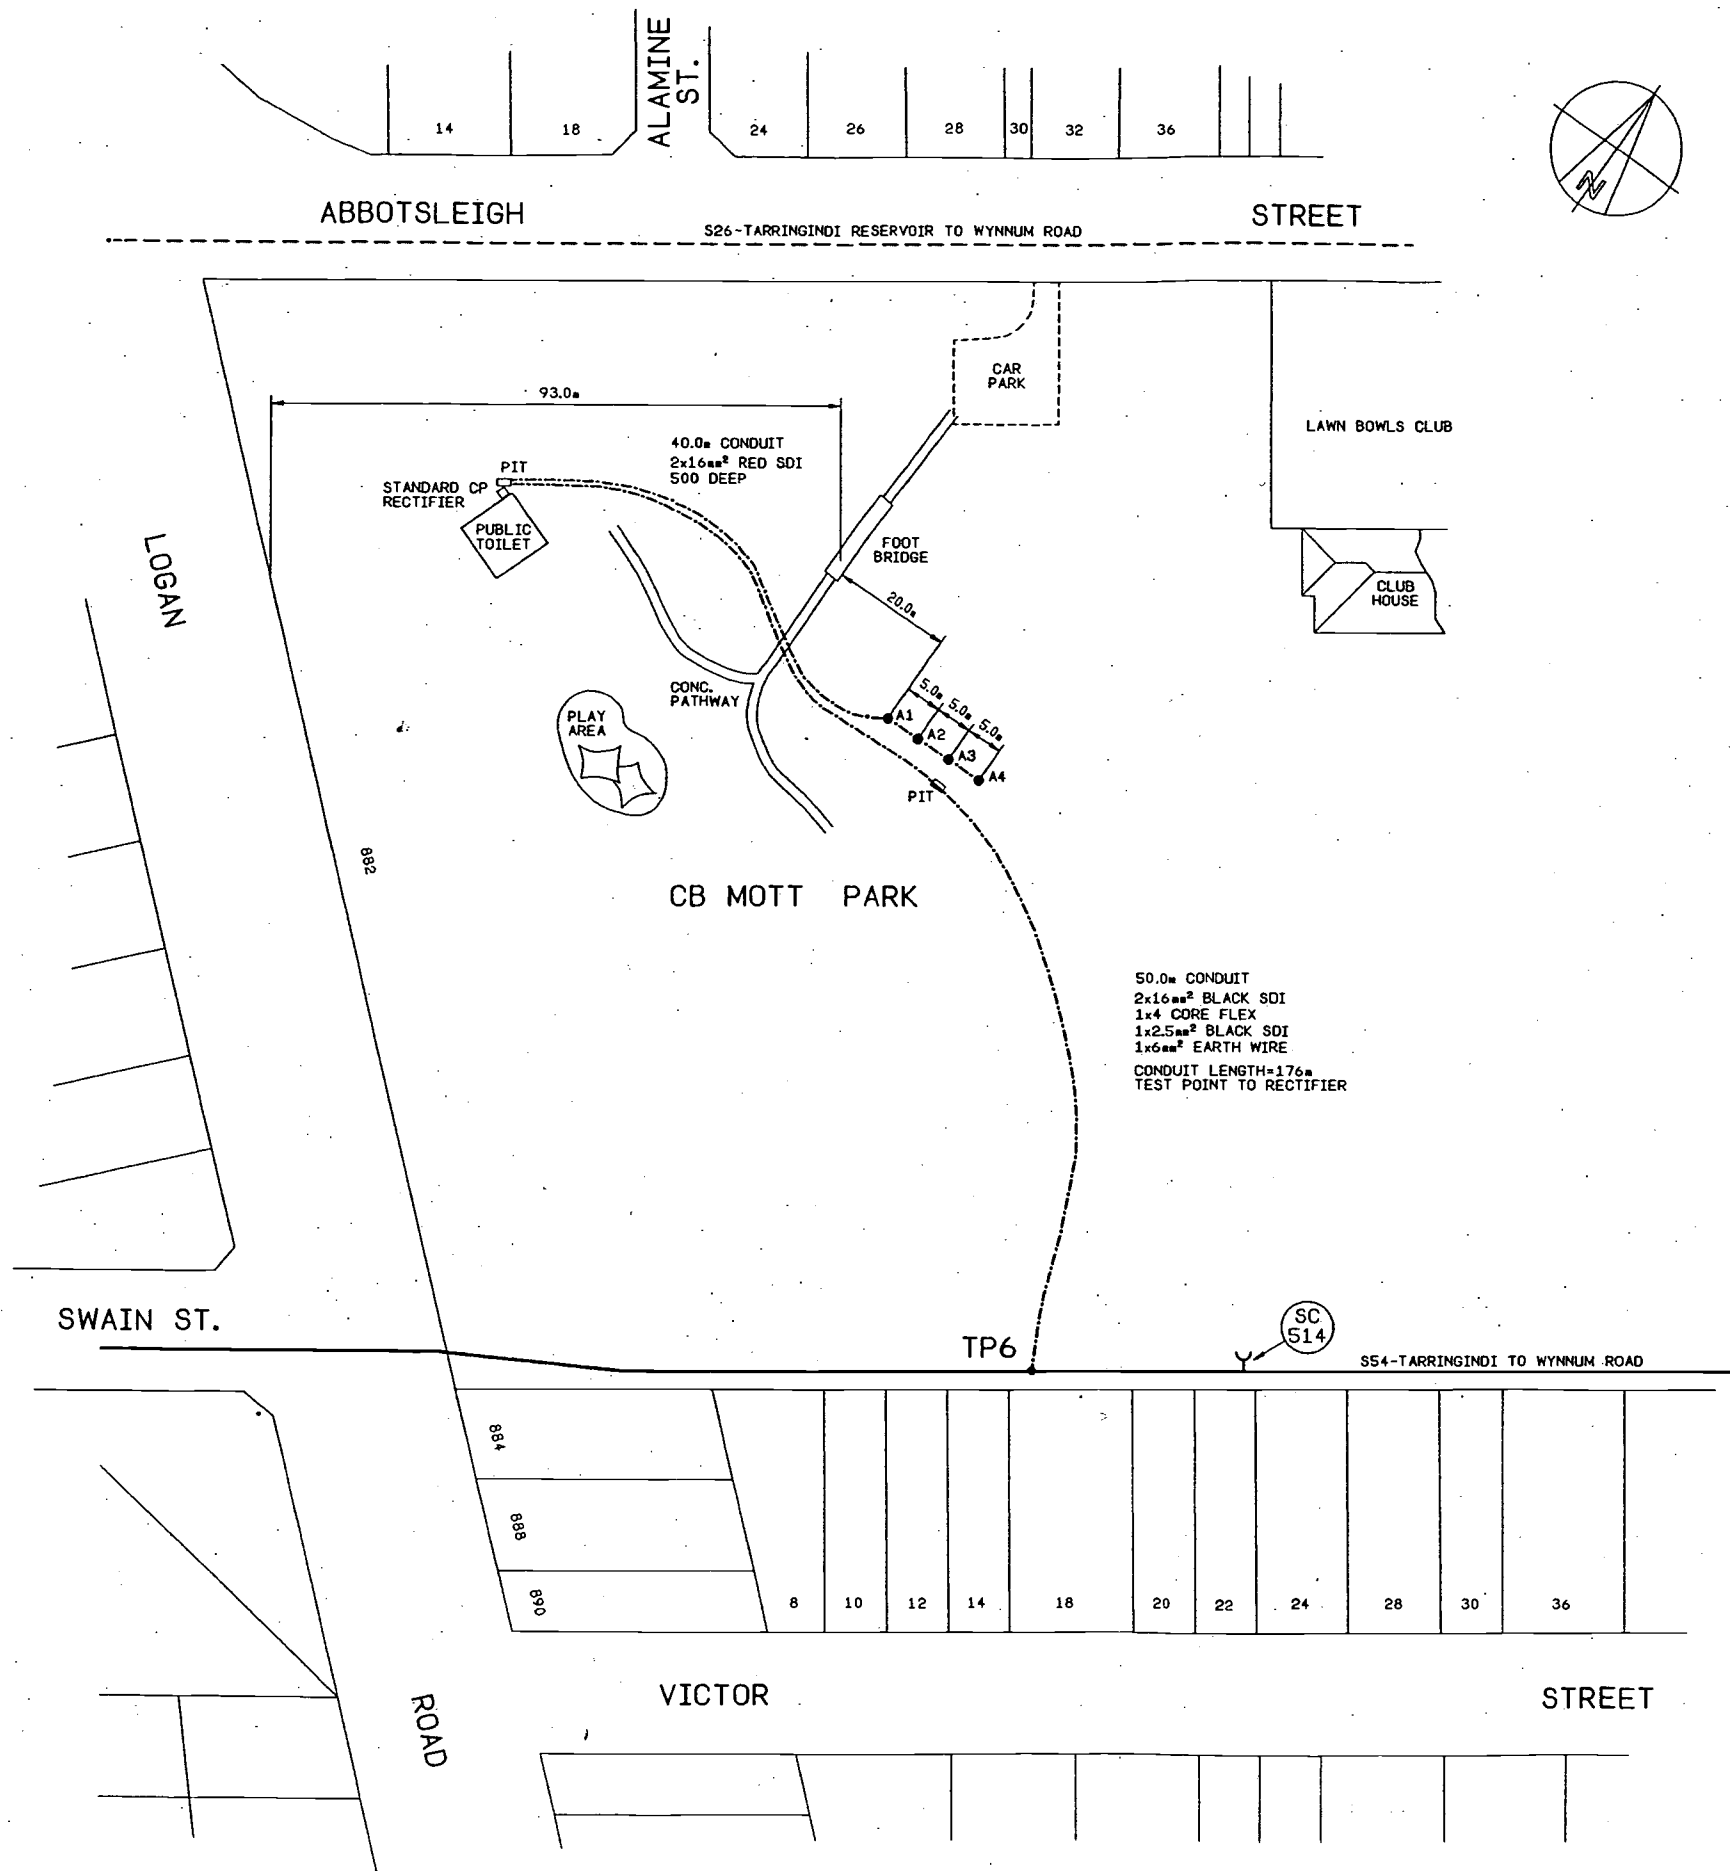
Brisbane Water

PROJECT
S54-TARRAGINDI TO WYNNUM RD.

TITLE
CATHODIC PROTECTION TEST
POINT LOCATIONS
TEST POINT NOS. 12 TO 15

SCALE
AS SHOWN
DRAWING NO.
2/10.677-03

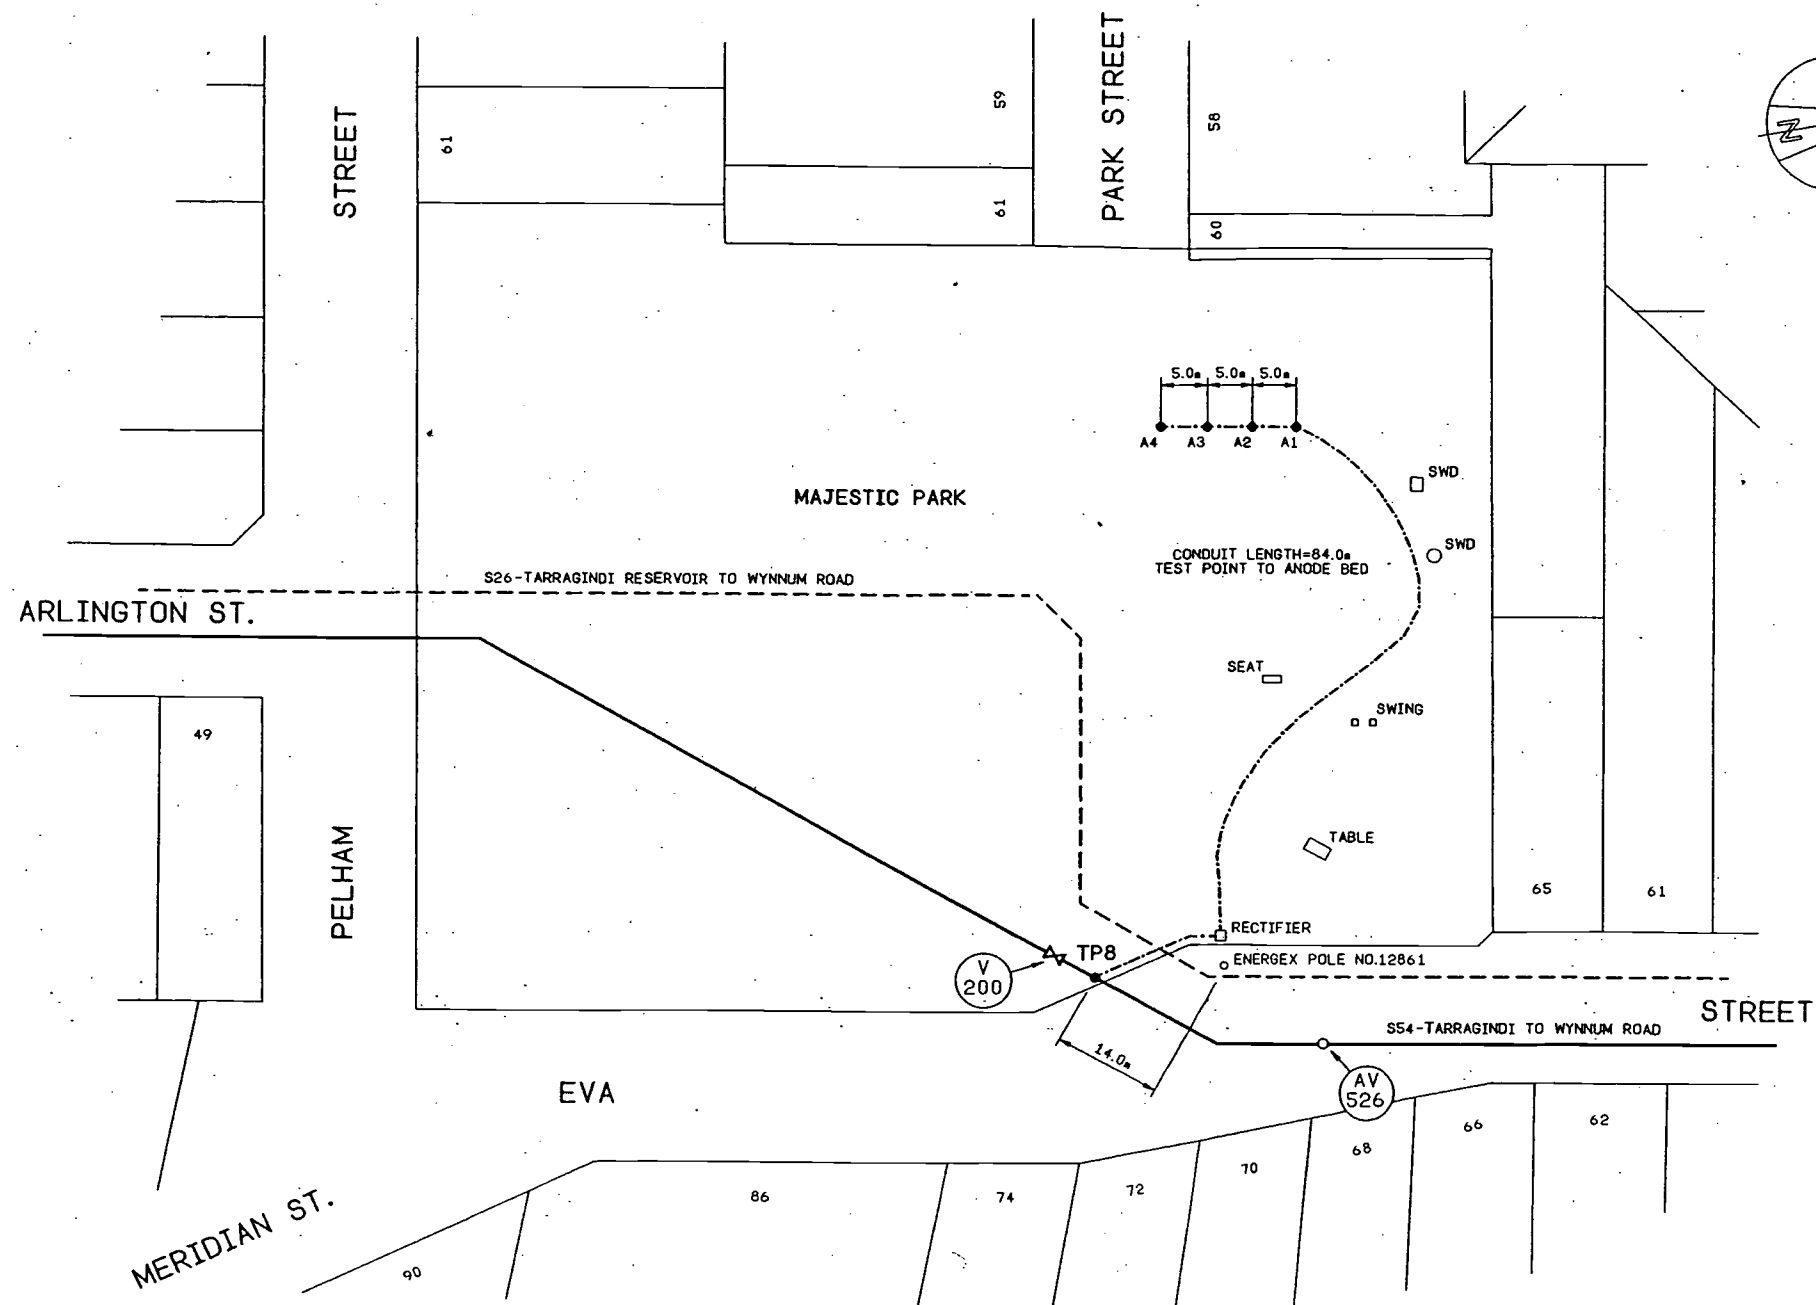
A.H. DATUM
NO 3 OF 5 SHEETS
AMEND.
P



TEST POINT NO.6 AND ANODE BED DETAILS

DESIGN CHARGE NO.		PA000820	
CONSTRUCTION PROJECT NO.			
AS BUILT RECEIVED			
BY	OFFICER CODE	DATE	
ON MAINTENANCE DETAILS			
START	FINISH	D.R.S. COMMENTS	
FUNDING			
PRIVATE BOOSTER REQUIRED?		YES / NO	
FUNDED BY B.C.C. (✓)		DEVELOPER ()	
FED. GOVT ()		STATE () OTHER ()	
D.R.S. OFFICER		DATE RELEASED	
PLAN CUSTODIAN		DATE RELEASED	
LIVE CONNECTION(S) / PASSED(W)			
REFERENCE	DATE	BIMAP CAPTURE	
JOB NUMBER	OFFICER CODE	DATE	
BIMAP COMMENTS			
SCALE		A.H. DATUM	
AS SHOWN		N° 4 OF 5 SHEETS	
DRAWING N°		AMEND.	
2/10.677-04		P	

NO. DATE		AMENDMENT		INITIALS		PRINCIPAL ENGINEER		R.P.E.Q. NO.		DATE		CADD FILE		WATER\INFRASTRUCTURE\21067704.0TA		DESIGN		DESIGN CHECK		DRAWN		8.0.B		OCT. 2004		PROJECT		S54-TARRAGINDI TO WYNNUM RD.		TITLE		CATHODIC PROTECTION TEST NO. 6 AND ANODE BED DETAILS	
						MANAGER ENGINEERING						FILE NO.				DRAFTING CHECK																	
						PRODUCTION / NETWORK DELEGATE						SURVEYED																					
												SURVEY NO.																					



TEST POINT NO.8 AND ANODE BED DETAILS

DESIGN CHARGE NO.		PA000820	
CONSTRUCTION PROJECT NO.			
AS BUILT RECEIVED			
BY	OFFICER CODE	DATE	
ON MAINTENANCE DETAILS			
START	FINISH		
D.R.S. COMMENTS			
FUNDING			
PRIVATE BOOSTER REQUIRED?		YES / NO	
FUNDED BY BGC (✓)		DEVELOPER ()	
FED. GOVT ()		STATE () OTHER ()	
D.R.S. OFFICER		DATE RELEASED	
PLAN CUSTODIAN			
OFFICER/RECD	DATE RELEASED		
LIVE CONNECTION(S) / PASSED(W)			
REFERENCE	DATE		
BIMAP CAPTURE			
JOB NUMBER	OFFICER CODE		
DATE	BIMAP COMMENTS		
SCALE			
AS SHOWN		A.H. DATUM	
DRAWING NO.		N° 5 OF 5 SHEETS	
2/10.677-05		P	

NO	DATE	AMENDMENT	INITIALS

PRINCIPAL ENGINEER	RPEQ. NO.	DATE
MANAGER ENGINEERING	FILE NO.	DATE
PRODUCTION / NETWORK DELEGATE	SURVEYED	DATE
	SURVEY NO.	

CADD FILE	WATER\INFRASTRUCTURE\21067705.DTA
DESIGN	
DESIGN CHECK	
DRAWN	B.O.B
DRAFTING CHECK	OCT. 2004

FIELD BOOK	



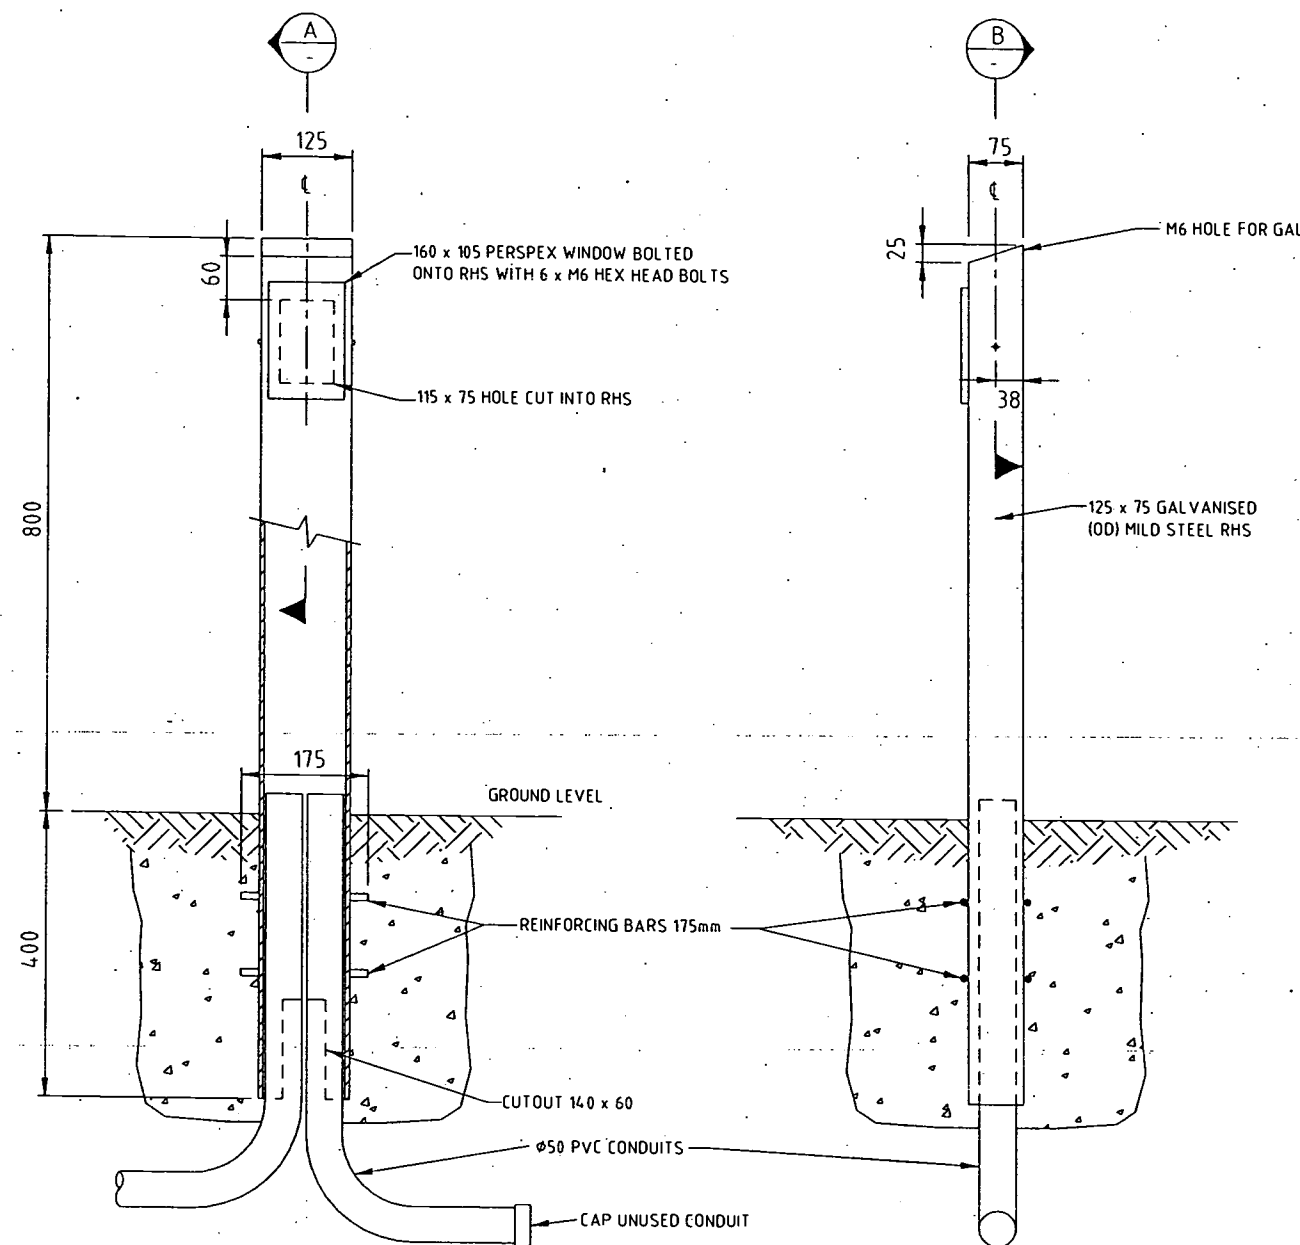
PROJECT	S54-TARRAGINDI TO WYNNUM RD.

TITLE	CATHODIC PROTECTION TEST NO. 8 AND ANODE BED DETAILS

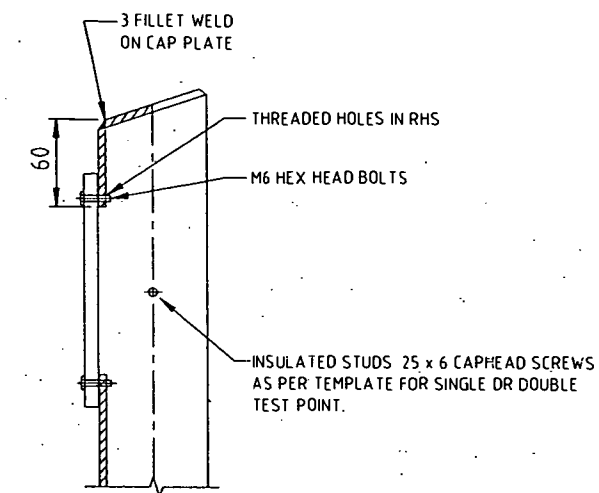
SCALE	A.H. DATUM
AS SHOWN	N° 5 OF 5 SHEETS
DRAWING NO.	2/10.677-05
	P

NOTES

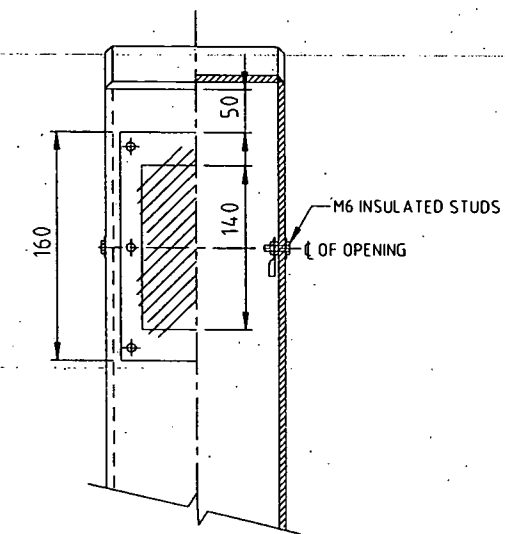
1. HOT DIP GALVANISE AFTER FABRICATION.

FRONT ELEVATION
SECTIONED




SIDE ELEVATION



SECTION A-A



SECTION B-B

				DIRECTOR OF P.D. & P.S.		DATE			NAME	DATE		JOB FILE		 			PROJECT		TITLE STANDARD TEST POINT CONSTRUCTION DETAILS		SCALE NTS		A ^N 1 OF 1 SHEETS		
C	9-02	NOTE 1 REVISED	HT	ENGINEER IN CHARGE		DATE	DESIGN	K.M.G.	5-5-92	ACAD FILE		2210001-RevA	SHEET SIZE				A1	SURVEY No.			FIELD BOOK	DRAWING N°		AMEND C	
B	11-95	MODIFIED	O.L.P.	SUPERVISING ENGINEER		DATE	DRAWN	O.L.P.	7-5-92	SURVEYED		A.H. DATUM					486/1/22-AAT0001E								
A	5-92	ISSUED FOR APPROVAL	O.L.P.	R.P.E.O. NO.		DATE	CHECKED	Brisbane City																	
NO. DATE				AMENDMENT		INITIALS																			

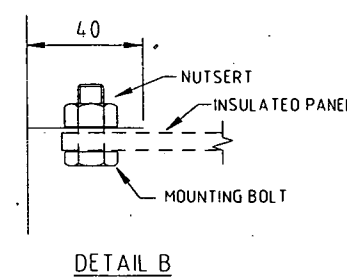
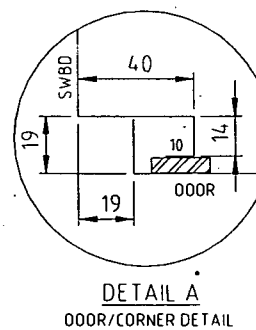
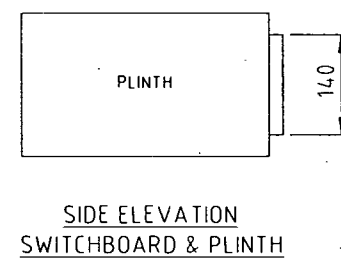
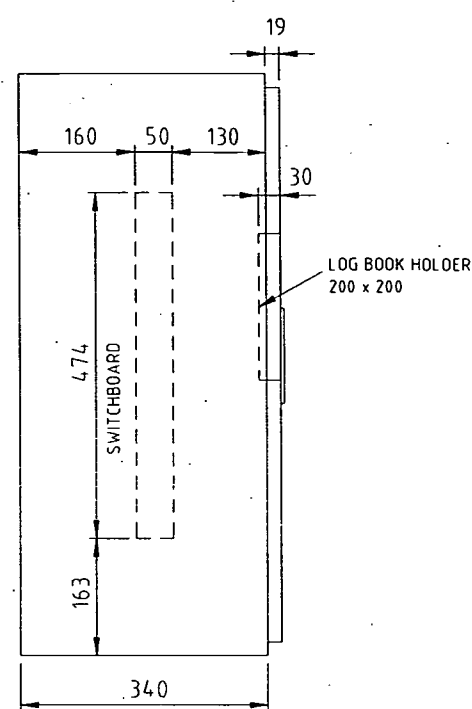
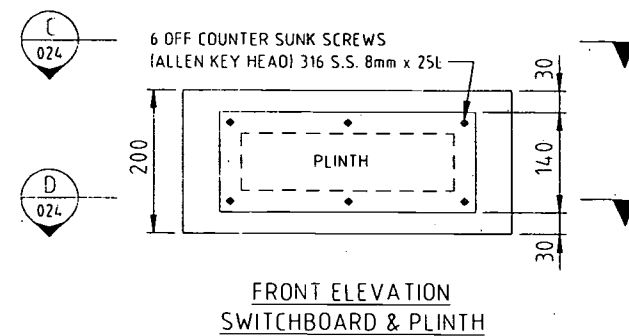
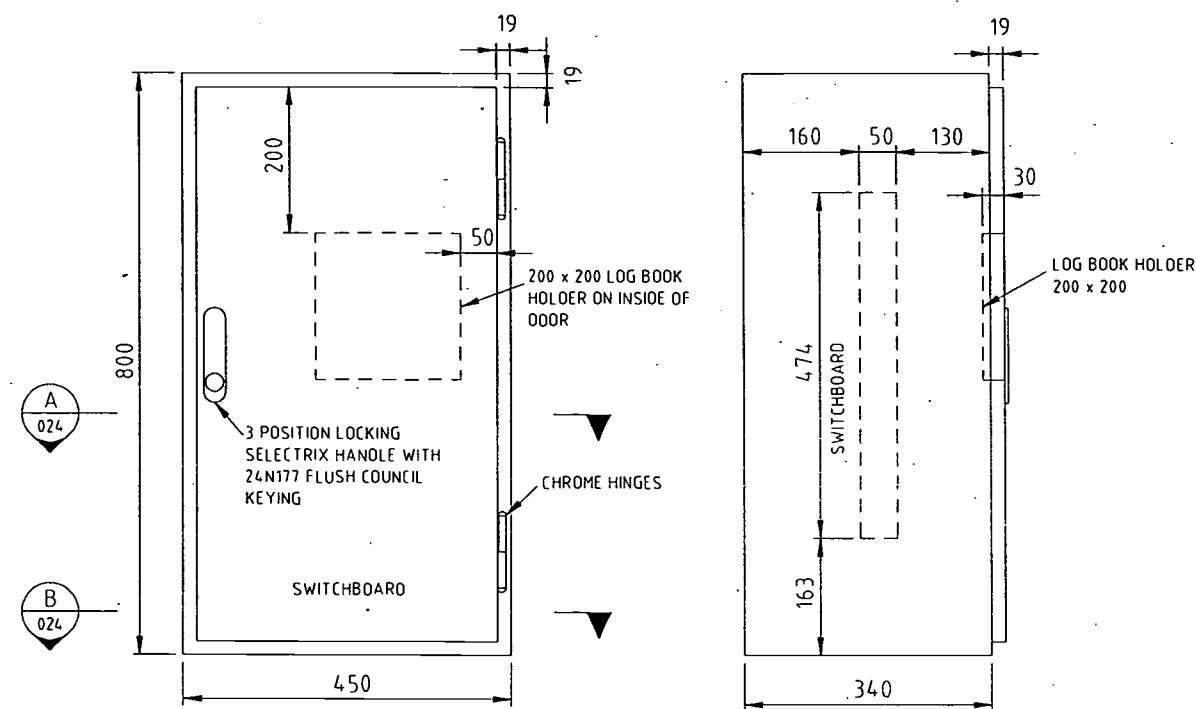
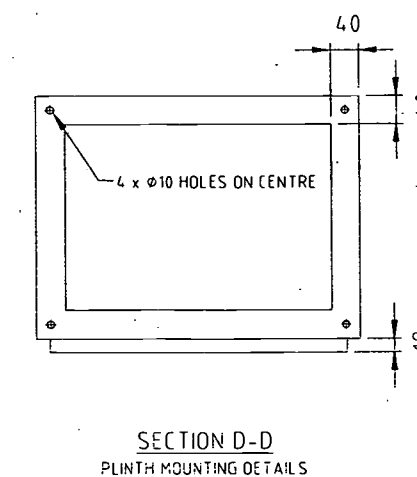
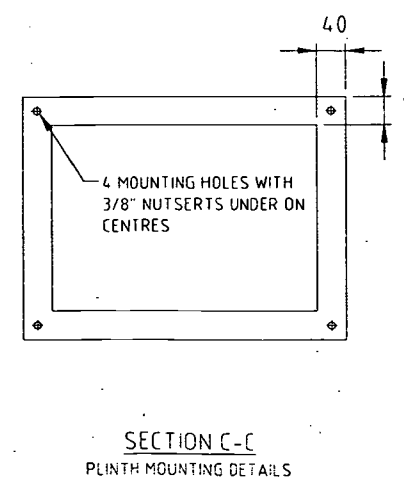
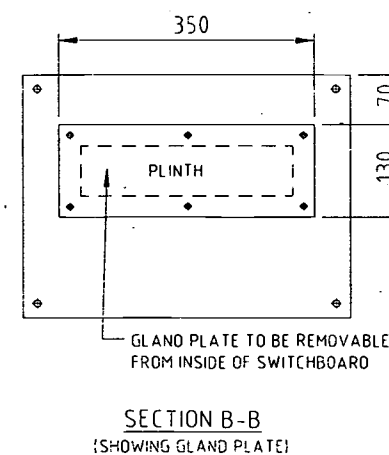
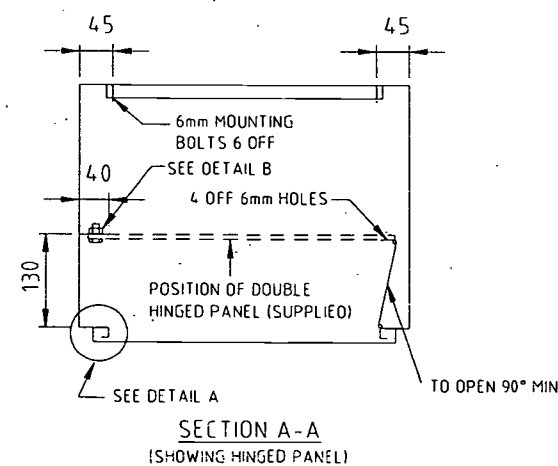


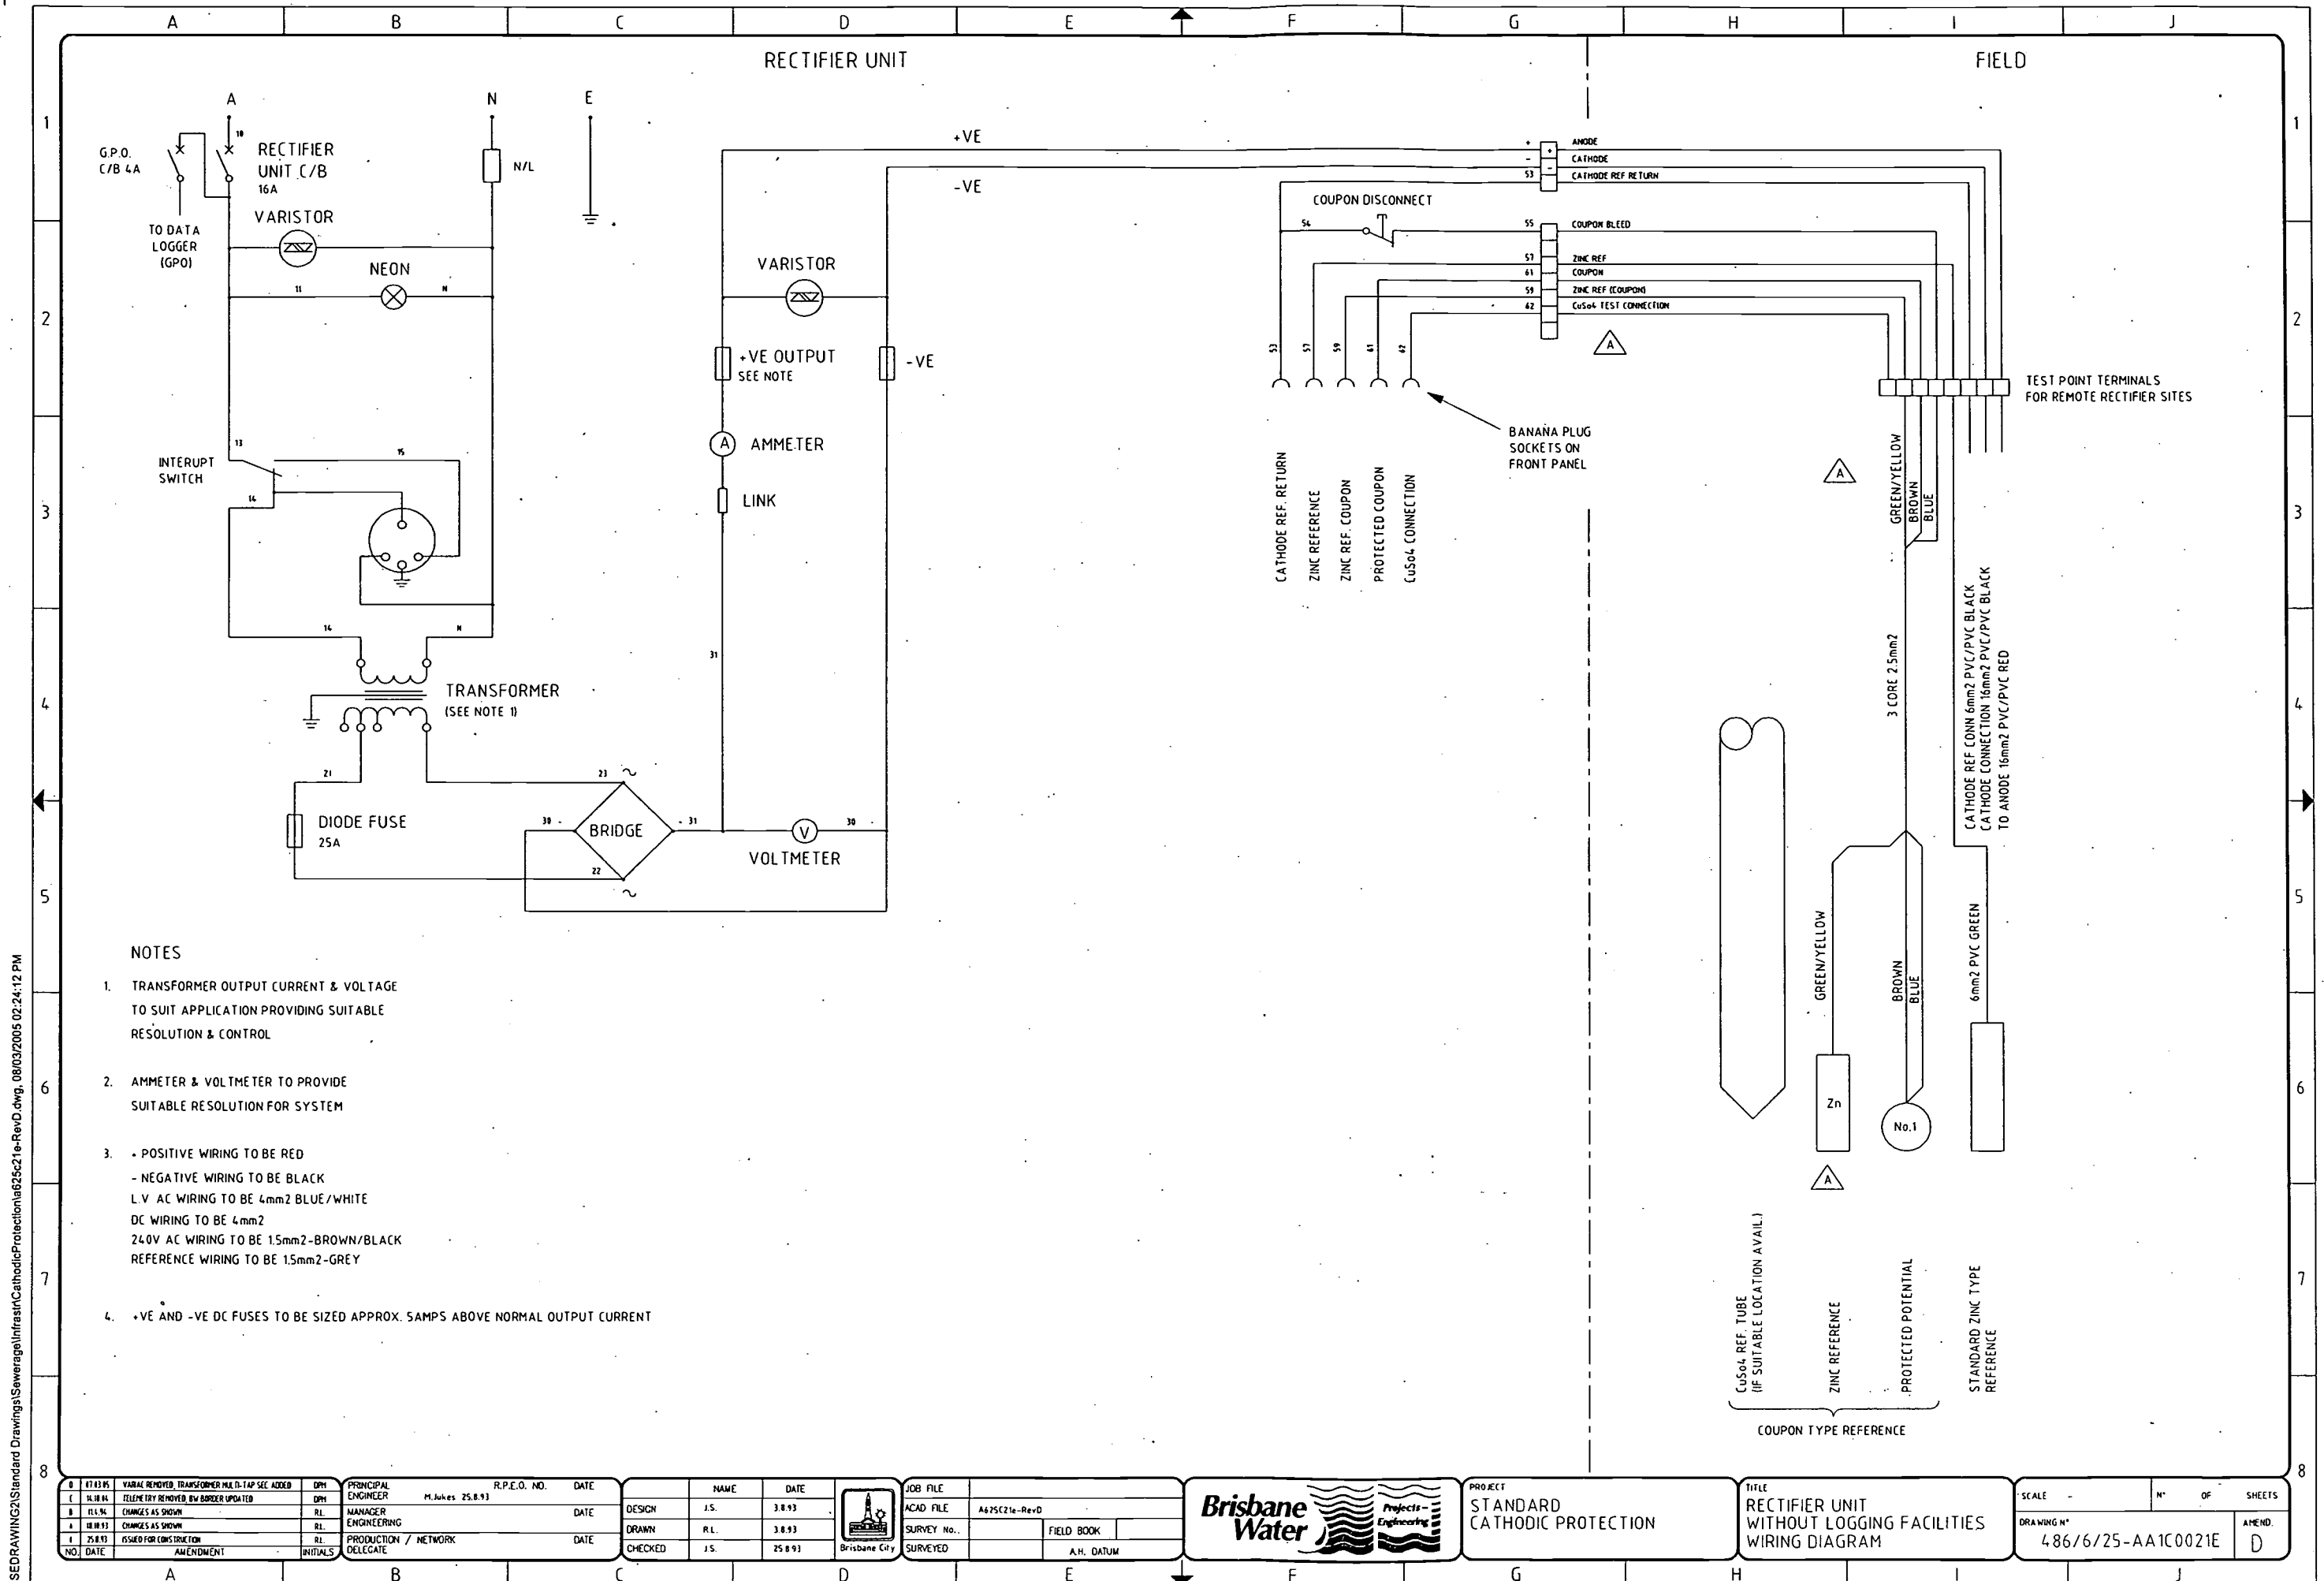
FIG.1
EQUIPMENT PANEL DETAILS

1. CABINET TO BE MANUFACTURED FROM 1.6mm 2B STAINLESS STEEL.
2. UNLESS SPECIFIED, SUPPLY CABINET WITH PLINTH. (MOUNT PLINTH TO SWITCHBOARD CABINET USING STAINLESS STEEL SCREWS).
3. REAR EQUIPMENT PANEL TO BE ZINC PLATED STEEL. POWDER COATED 'ORANGE'. (FULL LENGTH, FULL WIDTH & REMOVABLE). SEE FIG.1.
4. DOUBLE HINGED PANEL SUPPLIED BY B.C.C.
5. PROVIDE 1/4" WW STAINLESS STEEL STUDS TO DOOR & SWITCHBOARD CABINET.
6. DEGREE OF WEATHER PROTECTION IP55.
7. SELECTRIX TYPE HANDLE TO BE SUPPLIED & FITTED BY SWITCHBOARD MANUFACTURER. HANDLE TO BE 1107 SS CU1. KEY TO BE 24N177.
8. DOUBLE HINGED PANEL MOUNT TO BE SUPPLIED WITH MOUNTING BOLTS & NUTSERTS TOP & BOTTOM. SEE DETAIL A.

NUMBER OF SWITCHBOARDS REQUIRED	
NUMBER OF PLINTHS REQUIRED	



L 9-92 NOTE 1 REVISED B 11-95 MODIFIED A 1-97 ISSUED FOR APPROVAL NO. DATE AMENDMENT		DIRECTOR OF P.D. & P.S. ENGINEER IN CHARGE SUPERVISING ENGINEER INITIALS		DATE DATE DATE R.P.E.Q. NO.		DESIGN NAME DATE K.M.G. 5-5-92 DRAWN D.L.P. 7-5-92 CHECKED		JOB FILE ACAD FILE 22C0024-Rev-C SURVEY No. SURVEYED		SHEET SIZE A1 FIELD BOOK A.H. DATUM		PROJECT CATHODIC PROTECTION		TITLE STANDARD SWITCHBOARD CABINET		SCALE NTS DRAWING No. 486/1/22-C0024E No. 1 OF 1 SHEETS AMEND C	
---	--	---	--	--------------------------------------	--	---	--	---	--	---	--	--------------------------------	--	---------------------------------------	--	--	--





25 Bunya Street

Eagle Farm Q

4009

Ph. (07) 3403 8888

Fx. (07) 3403 1898

16th April 2004

OPERATING MANUAL FOR:

**TARRAGINDI to WYNNUM RD
to LYTTON RD
TRUNK MAINS
S54 and S35 TRUNK MAINS**

CATHODIC PROTECTION SYSTEM

CLIENT:

**BRISBANE WATER
WATER SYSTEM SERVICES**

MANUAL CONTENTS

(1.0)	Introduction
(2.0)	Corrosion and Cathodic Protection
(3.0)	Mains Details
(4.0)	Cathodic Protection
(4.1)	Type of System
(4.2)	Rectifier
(4.3)	Cathode
(4.4)	Anodes
(4.5)	Test Points
(4.6)	Associated Drawings
(4.7)	Associated Standards
(4.8)	Government Regulations
(5.0)	Performed Testing
(6.0)	Conclusion
(7.0)	Maintenance

DRAWINGS

486/6/25-AA1C0021E	Standard Rectifier Wiring Diagram
(No Number)	Bimonthly Maintenance Program

(1.0) INTRODUCTION

Steel when immersed or covered in water has a tendency to corrode (or rust) as the oxidized form is more stable than the metal.

Because of this, precaution must be taken to stop or minimize the corrosion reaction to an acceptable level consistent with the design life of the structure. This is normally achieved by the use of protective coatings which control the corrosion reaction by isolating the steel from its surrounding environment.

However, it is not practical to achieve a perfect coating and coating damage will always occur with time. Because of this, corrosion may occur at imperfections in the paint coating, causing further deterioration in the coating as well as loss of metal.

As a result of this, the coating defects must be rectified by periodic maintenance or an additional method of protection used to prevent this deterioration and corrosion occurring. This additional protection is achieved by the cathodic protection system.

(2.0) CORROSION AND CATHODIC PROTECTION

Corrosion is an electrochemical process in that it is accompanied by a flow of electrical current.

Corrosion occurs on the surface of metals at active areas known as anodes, which are electrically continuous with less active or passive areas known as cathodes. The electric current flows from the anode through the electrolyte to the cathode, with the circuit being completed by the electrical continuity between the cathode and anode. In practice anodes and cathodes are generally part of the same metallic surface and individual anodic areas may be small.

In applying cathodic protection an external current is applied to the surface so that the entire surface to be protected acts as a cathode. This involves the use of an auxiliary anode and when the current flow from this anode is sufficient, no part of the structure acts as an anode.

An external source of direct current such as a transformer rectifier is used in conjunction with an anode consisting of material with a very slow corrosion rate.

While it is the flow of current which achieves the cathodic protection of the surface it is impractical to measure these currents over individual anodic areas to determine when cathodic protection has been achieved. However, with the flow of cathodic protection current, the structure becomes more negative with respect to the surrounding electrolyte. Because of this, it is possible to state values of metal/electrolyte potential at which corrosion does not occur. This metal/electrolyte potential is generally measured against a standard reference electrode which allows a reproducible potential at which corrosion does not occur to be quoted.

(3.0)

MAINS DETAILS

Size: 1060, 910 and 600 mm Dia mild steel cement lined.

Coating: Enamel Coated.

Length: Appox 11.6 Km.

Location: From Valve 188 cnr Tarragindi Rd.and Autumn St. Tarragindi
to Valve 214 Lytton Rd. Murarrie.

Construction

Drawings:

486/1/22-C0024E Cathodic Protection Standard Switchboard Cabinet

486/1/22-AAT0001E Cathodic Protection Test Points

(4.0) CATHODIC PROTECTION DETAILS

(4.1) Type of Cathodic Protection: Impressed Current.

(4.2) Rectifier: Standard 30 Volt, 30 amp direct current output enclosed in a stainless steel switchboard. This system has 2 rectifiers installed. One rectifier is in Mott Park, corner Logan Rd. and Abbotsleigh St. Holland Park and has a 240V supply from Mott Park toilet block. The second rectifier is in Majestic Park Camp Hill and has a 240V supply from Energex pole No12681 near 70 Eva St Camp Hill.

(4.3) Cathode: One cathode point is located on the 1060 mm dia mains, adjacent to scour valve 514 in Mott Park, while the second cathode point is located on the 910 mm dia mains adjacent to valve 200 at Majestic Park.. The cathode point is where the cabling from the rectifier is attached to the structure under cathodic protection.

(4.4) Anodes: Four 1500 x 75mm silicone iron anodes were installed approximately 90 metres from the trunk mains, in a vertical bed 5 metres deep, in the park adjacent to the stormwater drain in Mott Park. Another four anodes were installed approximately 100 metres from the trunk main in a vertical bed 5 metres deep in Majestic Park. The anodes are backfilled with cokebreeze thereby improving anode - ground resistance. The anodes are identified by a marker post and label. See layout drawing.

(4.5) Test Points: Test points are installed on cathodically protected structures to enable testing to ensure full protection of the mains. On these mains eighteen test points have been installed on the trunk main which can be identified from the layout drawing.

(4.6) Associated Drawings:

Cathodic Protection Test Point Details	- 486/1/22-AAT0001E
Standard Rectifier Wiring Diagram	- 486/6/25-AA1C0021
Cathodic Protection Test Point & Anode	- 2 / 10.677-01 to 2 / 10.677-05
Bed Locations S54 & S35 Trunk Mains.	- 2 / 10.2315-01

(4.7) Associated Standards:

AS/NZS 3000	2000	Electrical Installations
AS/NZS 2832.1	1998	Cathodic Protection of Metals-Pipes and Cables.

(4.8) Government Regulations:

Queensland Electricity	Safety Rules and Regulations.	2002
------------------------	-------------------------------	------

(5.0)

PERFORMED TESTING

- (1) Natural Potential Survey.
- (2) Testing of Insulated Flanges, Joints.
- (3) Soil Resistance Testing.
- (4) Current Drain Survey.
- (5) Pipe Coating Anomaly Survey.
- (6) Rectifier Loop Resistance.
- (7) Foreign Structure Interference Survey and Mitigation.
- (8) Final Potential Survey and Commissioning.

(6.0)

CONCLUSION

Full Cathodic protection has been achieved on this section of trunk mains. The cathodic protection system is registered with the Electrical Safety Office, Department of Industrial Relations, and has approval to operate.

(7.0)

MAINTENANCE

The cathodic protection system is maintained on a bimonthly basis after commissioning. These checks involve testing rectifier operation and recording of pipe to soil potentials.

16th April, 2004.

Cathodic Protection Unit.

CPS Bimonthly Maintenance Details.

Required:

- 1/ Notify plant operator and/or sign entry logs where necessary.
- 2/ Have appropriate keying.

Labour:

One tradesperson, one vehicle. 20 minutes per site.

Procedure:

- 1/ Identify installation.
- 2/ Check system for operation.
- 3/ Record voltmeter.
- 4/ Record ammeter.
- 5/ Comments.
- 6/ Log entry.

16th April, 2004.

Cathodic Protection Unit

CPS 6 Monthly Maintenance Details.

Required:

- 1/ Notify plant operator and/or sign entry logs where necessary.
- 2/ Have appropriate keying.
- 3/ Set of tools. (Electricians)
- 4/ Multimeter.
- 5/ DC clampmeter.
- 6/ Copper sulphate reference cell and leads.
- 7/ Cleaning equipment.
- 8/ Gatic cover lifters.

Labour:

One tradesperson electrical, one laborer, one vehicle.
Two hours per site.

Procedure:

- 1/ Identify system.
- 2/ Check system for operation.
- 3/ Record voltmeter.
- 4/ Record ammeter.
- 5/ Record "on" potentials for all test points.
- 6/ Record "instant off" potentials for all test points.
- 7/ Record "off" potentials for all test points.
- 8/ Perform loop resistance and record.
- 9/ Check and record anode string currents.
- 10/ Comments.
- 11/ Log entry.

16th April, 2004.

Cathodic Protection Unit

CPS 60 Monthly Maintenance Details.

Required:

- 1/ Notify plant operator and/or sign entry logs where necessary.
- 2/ Have appropriate keying.
- 3/ Set of tools. (Electricians)
- 4/ Multimeter.
- 5/ DC clampmeter.
- 6/ Copper sulphate reference cell and leads.
- 7/ Cleaning equipment.
- 8/ Gatic cover lifters.
- 9/ Rectifier load bank.
- 10/ PCS2000 Detection Equipment.

Labour:

One tradesperson electrical, one laborer, one vehicle.
Eight hours per site.

Procedure:

- 1/ Identify system.
- 2/ Check system for operation.
- 3/ Record voltmeter.
- 4/ Record ammeter.
- 5/ Record "on" potentials for all test points.
- 6/ Record "instant off" potentials for all test points.
- 7/ Record "off" potentials for all test points.
- 8/ Perform loop resistance and record.
- 9/ Check and record anode string currents.
- 10/ Load test rectifier for 10 minutes.
- 11/ Check all switchboard and testpoint terminals for tightness.
- 12/ Check all switchboard and testpoints are labelled and I.D. tags attached.
- 13/ Check plans are correctly drawn and modify if necessary.
- 14/ Remove and inspect anodes.
- 15/ Recheck all interference (CPS) bleeds.
- 16/ Pipecamp structure if applicable.
- 17/ Apply to reregister system if applicable

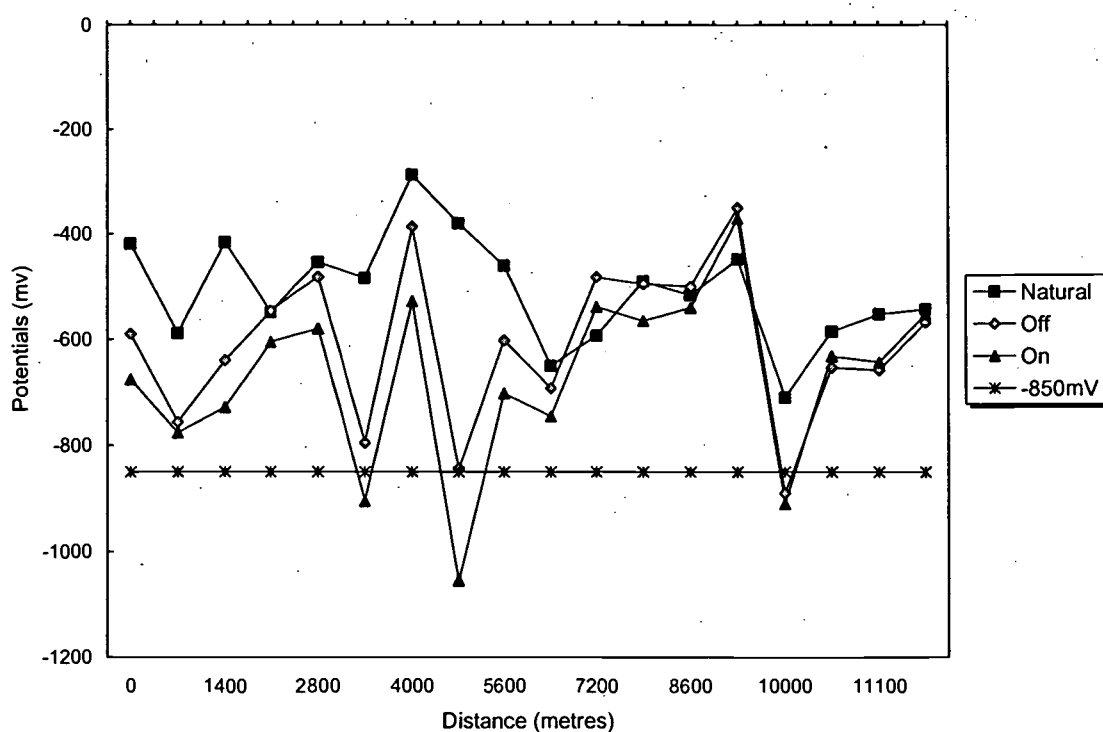
Brisbane Water Engineering Services

CP Form No. 23

Electrical Engineering Unit**Cathodic Protection System Potential Recording Form****Project** Tarragindi to Wynnum Rd.to Lytton Rd S35&S54**Date** 16th June 2004

Test Point Nos 1 to 15 are S54 and Test Points 16 to 18 are S35

Test Point number	Distances to T.P. (metres)	Potentials to CuSO ₄			Distance
		Natural (mV)	Off (mV)	On (mV)	
1	0	-419	-590	-676	0
2	700	-589	-756	-776	700
3	1400	-416	-640	-728	1400
4	1900	-549	-546	-605	1900
5	2800	-454	-482	-580	2800
6	3400	-484	-795	-905	3400
7	4000	-287	-386	-527	4000
8	4800	-380	-844	-1055	4800
9	5600	-460	-602	-702	5600
10	6400	-650	-692	-745	6400
11	7200	-593	-482	-538	7200
12	7900	-490	-495	-565	7900
13	8600	-516	-500	-540	8600
14	9200	-448	-350	-371	9200
15	10000	-710	-890	-910	10000
16	10400	-585	-653	-632	10400
17	11100	-552	-658	-643	11100
18	11600	-543	-568	-552	11600

Rectifiers at
TPs.No6&8**Graph of potentials vs pipelength**

Revision 18/05/2005

Brisbane Water Engineering Services

CP Form No. 23

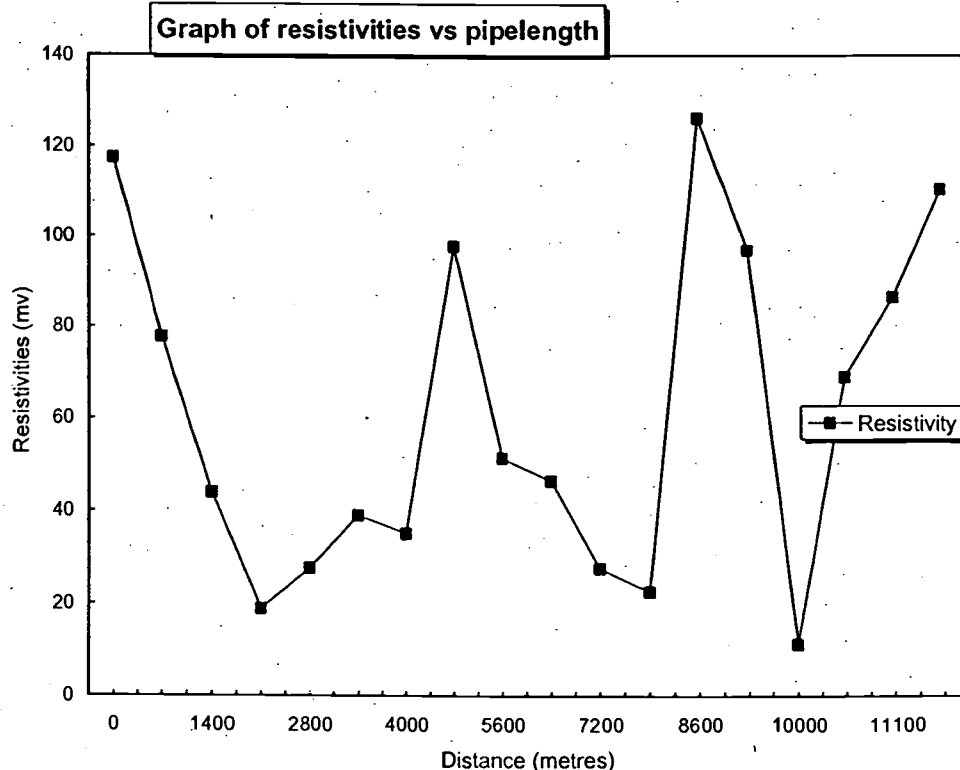
Electrical Engineering Unit**Cathodic Protection System Resistivities Recording Form****Project** Tarragindi to Wynnum Rd. to Lytton Rd. S35 & S54**Date** 16th June 2004

Test Point number	Distances to T.P. (metres)	Resistivities at 2 metres ohm metres
1	0	117.4
2	700	77.8
3	1400	43.9
4	1900	18.8
5	2800	27.6
6	3400	38.9
7	4000	35.1
8	4800	97.7
9	5600	51.4
10	6400	46.4
11	7200	27.6
12	7900	22.6
13	8600	126.3
14	9200	97
15	10000	11.3
16	10400	69.1
17	11100	86.6
18	11600	110.5

Note.

Test Points 1 to 15 are for S54

Test Points 16,17 & 18 are for S35



Brisbane Water Engineering Services

Electrical Engineering Unit

Cathodic Protection System Loop Resistance

Mott Park Rectifier CPS 202

Date: 12th May 2005

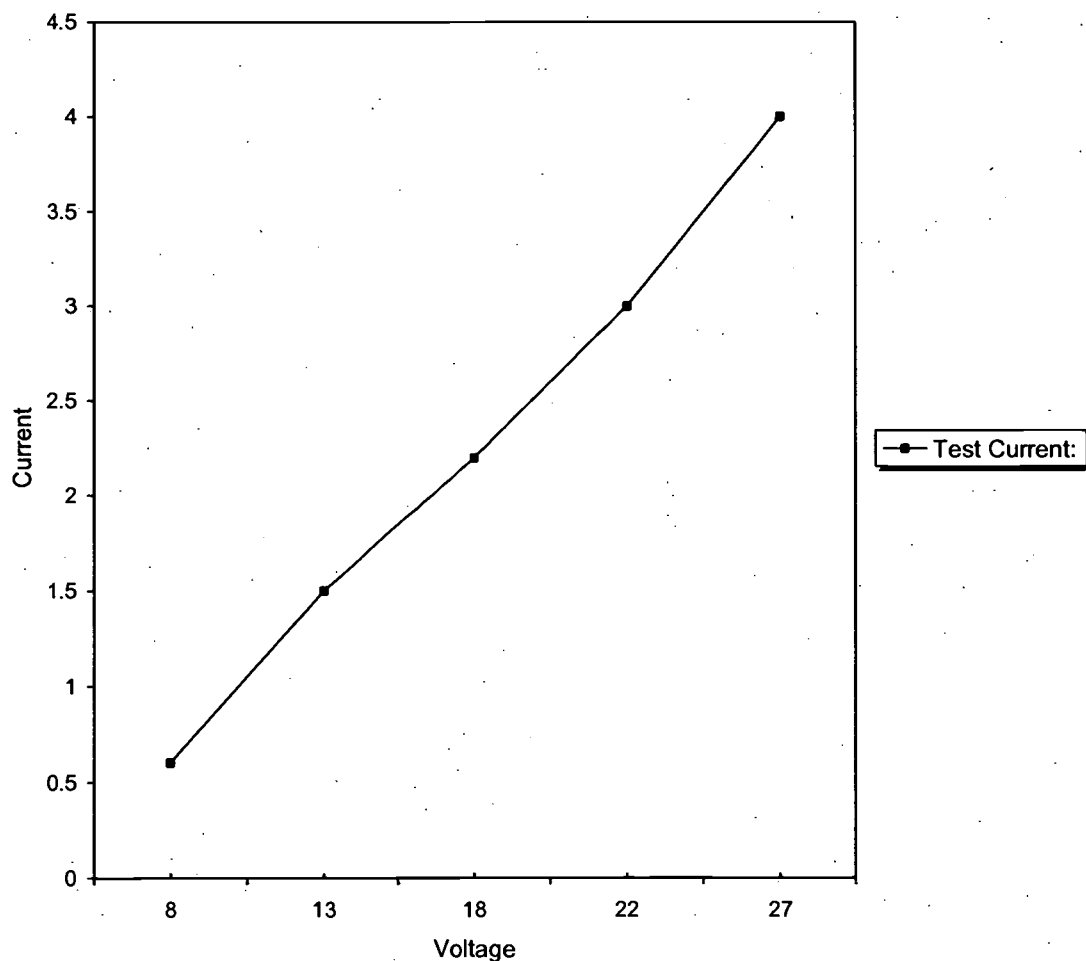
Cathodic Protection System: Tarragindi to Wynnum Rd. S54 Trunk Main

System Operating Volts: 27 System Operating amps 4

Test Voltage:		Test Current:	
(volts)		(amps)	
8		0.6	
13		1.5	
18		2.2	
22		3	
27		4	

Loop Resistance (ohms)
5

Loop Resistance



13/05/2005

Brisbane Water Engineering Services

Electrical Engineering Unit

Cathodic Protection System Loop Resistance

Eva St. Rectifier CPS 206

Date: 12th May 2005

Cathodic Protection System:

Tarragindi to Wynnum Rd. S54 Trunk Main

System Operating Volts:

27

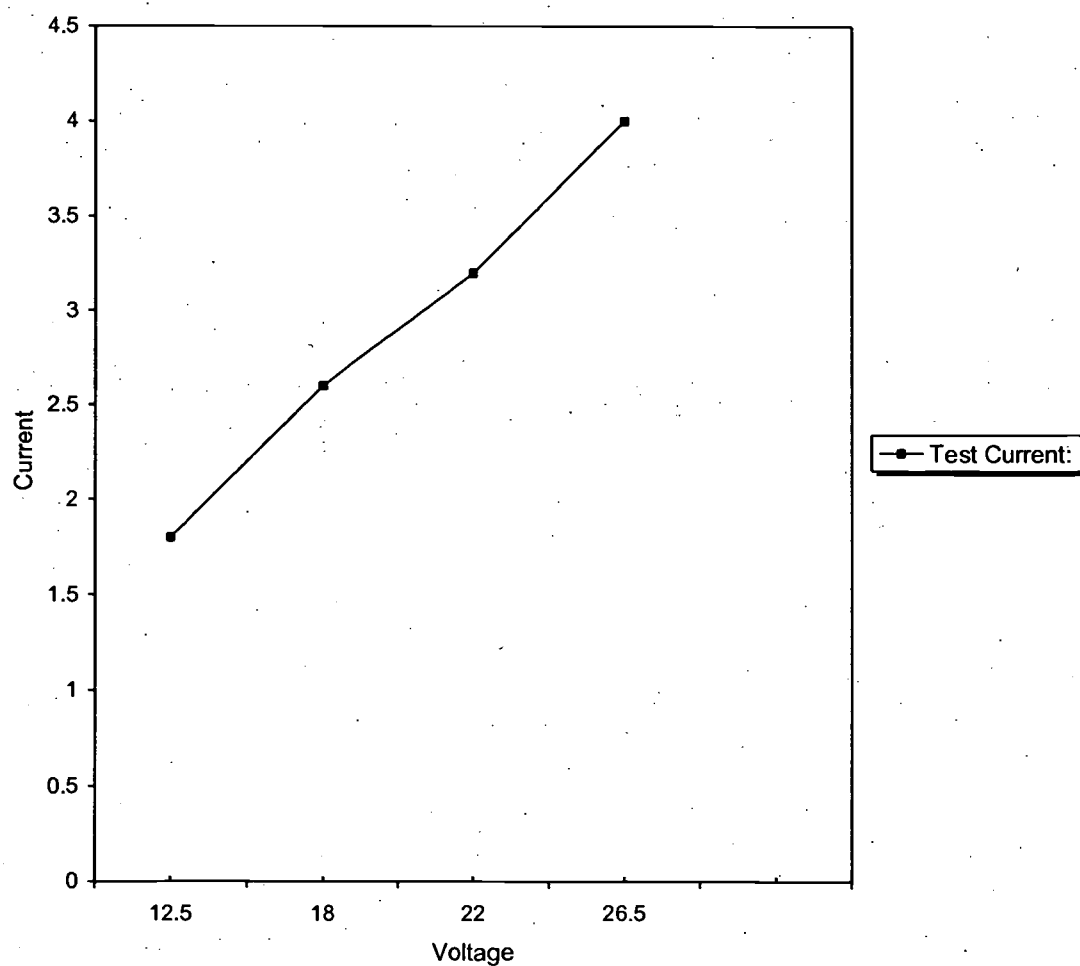
System Operating amps

4.7

Test Voltage:		Test Current:	
(volts)		(amps)	
12.5		1.8	
18		2.6	
22		3.2	
26.5		4	

Loop Resistance (ohms)
6.875

Loop Resistance



18/05/2005

FORM 9
V3.01-04Department of Industrial Relations
ABN 52 293 849 579

APPLICATION TO REGISTER A REGISTERABLE CATHODIC PROTECTION SYSTEM

PLEASE COMPLETE ALL SECTIONS OF THIS FORM- PLEASE PRINT

Application Details

Name of system owner:	Brisbane City Council / Brisbane Water		
		ABN	72002765795
Postal address:	GPO Box 1434 Brisbane 4001		
Contact name:		TEL	

Name of authorised agent of system owner:	Brisbane Water Network Services		
		ABN	72002765795
Postal Address:	268 Cullen Ave Eagle Farm 4009		
Contact Name:	Kerry McGovern		
		TEL	07 34078364

Type of Application: (Tick as appropriate)			
<input checked="" type="checkbox"/> New System			
<input type="checkbox"/> Alteration to an existing system, Registration No:			
<input type="checkbox"/> Renewal of system, Registration No:			
Location of system:	From cnr Tarragindi Rd & Autumn St. Tarragindi to Lytton Rd near Metroplex Ave Murarie		
	Rectifier No1(Mott Park) Abbotsleigh St Holland Pk	POST CODE	4121
Structure to be protected:	900 mm and 1060 mm dia Mild Steel Trunk Main		
Maximum operating current:	5.00	Amperes DC	Water or Marine environment Maximum operating voltage: Volts

Declaration

I/We, being the owner/operators of the cathodic protection system described above, make application for the registration of this system and certify with respect to the system that:

- (i) I/We have complied with the requirements of Part 11 of *Electrical Safety Regulation 2002*;
- (ii) tests pursuant to section 177 of *Electrical Safety Regulation 2002*, based on the maximum operating current stated this application have been performed;
- (iii) the maximum operating voltage stated in this application in the case of the system operating with an anode/s immersed in water or a marine environment corresponds to the maximum operating current mentioned in paragraph (ii); and
- (iv) any necessary interference mitigation measures for foreign structures (in the case where the system is currently registered) have been tested and are operating satisfactorily.

Signature of system owner: Day Month Year

PRIVACY STATEMENT. The Department of Industrial Relations respects your privacy and is committed to protecting your personal information. The information provided on this form is for the purpose of applying for the registration of a cathodic protection system and monitoring compliance under the Electrical Safety Act 2002, and will be managed within the requirements of Information Standard 42. The Department may be required to disclose your personal information to other government agencies, entities, or persons as may be required by law or that are outsourced functions. This information may also be used for statistical research, information provision and evaluation of our services. We will assume that we have your permission to do this unless you tell us otherwise. You can do this at any time by contacting Equipment Safety on (07) 3237 0281. Further information on our privacy policy is available at www.dir.qld.gov.au

Application of accompany registration fee of \$205.00
Application for systems to be immersed in a marine environment must have technical schedule attached.
 Forward to: Electrical Safety Office, LMB 2234 Brisbane Qld 4001
 Please note: This is a GST free supply. No tax invoice will be issued.

FORM 9
V3.01-04Department of Industrial Relations
ABN 52 293 849 579

APPLICATION TO REGISTER A REGISTERABLE CATHODIC PROTECTION SYSTEM

PLEASE COMPLETE ALL SECTIONS OF THIS FORM- PLEASE PRINT

Application Details

Name of system owner:	Brisbane City Council / Brisbane Water		
		ABN	72002765795
Postal address:	GPO Box 1434 Brisbane 4001		
Contact name:		TEL	

Name of authorised agent of system owner:	Brisbane Water Network Services		
		ABN	72002765795
Postal Address:	268 Cullen Ave Eagle Farm 4009		
Contact Name:	Kerry McGovern		
		TEL	07 34078364

Type of Application: (Tick as appropriate)			
<input checked="" type="checkbox"/> New System			
<input type="checkbox"/> Alteration to an existing system, Registration No:			
<input type="checkbox"/> Renewal of system, Registration No:			
Location of system:	From cnr Tarragindi Rd & Autumn St. Tarragindi to Lytton Rd near Metroplex Ave Murarrie		
	Rectifier No2 (Majestic Park) Eva St Coorparoo	POST CODE	4151
Structure to be protected:	900 mm and 1060 mm dia Mild Steel Trunk Main		
Maximum operating current:	6.00	Amperes DC	Water or Marine environment Maximum operating voltage: Volts

Declaration

I/We, being the owner/operators of the cathodic protection system described above, make application for the registration of this system and certify with respect to the system that:

- (i) I/We have complied with the requirements of Part 11 of *Electrical Safety Regulation 2002*;
- (ii) tests pursuant to section 177 of *Electrical Safety Regulation 2002*, based on the maximum operating current stated this application have been performed;
- (iii) the maximum operating voltage stated in this application in the case of the system operating with an anode/s immersed in water or a marine environment corresponds to the maximum operating current mentioned in paragraph (ii); and
- (iv) any necessary interference mitigation measures for foreign structures (in the case where the system is currently registered) have been tested and are operating satisfactorily.

Signature of system owner:

Day

Month

Year

PRIVACY STATEMENT. The Department of Industrial Relations respects your privacy and is committed to protecting your personal information. The information provided on this form is for the purpose of applying for the registration of a cathodic protection system and monitoring compliance under the Electrical Safety Act 2002, and will be managed within the requirements of Information Standard 42. The Department may be required to disclose your personal information to other government agencies, entities, or persons as may be required by law or that are outsourced functions. This information may also be used for statistical research, information provision and evaluation of our services. We will assume that we have your permission to do this unless you tell us otherwise. You can do this at any time by contacting Equipment Safety on (07) 3237 0281. Further information on our privacy policy is available at www.dir.qld.gov.au

Application of accompany registration fee of \$205.00

Application for systems to be immersed in a marine environment must have technical schedule attached.

Forward to: Electrical Safety Office, LMB 2234 Brisbane Qld 4001

Please note: This is a GST free supply. No tax invoice will be issued.



Queensland Government

Department of Industrial Relations

Electrical Safety Act 2002

NOTICE OF REGISTRATION OF CATHODIC PROTECTION SYSTEM

Registration No: 3335

Date of Registration: 01 March 2006

Expiry Date: 01 March 2011

The cathodic protection system referred to below has been registered for a term of five years, and the conditions of registration shown hereunder shall apply in addition to the provisions of the Electrical Safety Act and Electrical Safety Regulation 2002.

Name and Postal Address of System Owner	Brisbane City Council Brisbane Water GPO Box 1434 BRISBANE QLD 4001
Location of System	From Cnr Tarragindi Rd and Autumn St Tarragindi to Lytton Rd near Metroplex Ave Murarrie Rectifier No2 (Majestic Park) Eva St Coorparoo - Post Code: 4151
Structure to be Protected	Mild Steel Tunk Main

CONDITIONS OF REGISTRATION

Maximum Operating Current:

6.00 Amperes DC

[Signature]
DES EDE

Director – Equipment Safety

21312006


Queensland Government

Department of Industrial Relations

Electrical Safety Act 2002

NOTICE OF REGISTRATION OF CATHODIC PROTECTION SYSTEM

Registration No: 3332
Date of Registration: 01 March 2006

Expiry Date: 01 March 2011

The cathodic protection system referred to below has been registered for a term of five years, and the conditions of registration shown hereunder shall apply in addition to the provisions of the Electrical Safety Act and Electrical Safety Regulation 2002.

Name and Postal Address of System Owner	Brisbane City Council Brisbane Water GPO Box 1434 BRISBANE QLD 4001
Location of System	From Cnr Tarragindi Rd and Autum St Tarragindi to Lytton Rd near Metroplex Ave Murarrie Rectifier No1 (Mott Park) Abbotsleigh St Holland Park - Post Code: 4121
Structure to be Protected	Mild Steel Trunk Main

CONDITIONS OF REGISTRATION

Maximum Operating Current:
5.00 Amperes DC


DES EDE

Director – Equipment Safety

21/3/2006

Brisbane Water Engineering Services

CP Form No. 27

Electrical Engineering Unit

Cathodic Protection Interference Survey Results Form

Tarragindi to Wynnum Rd

Eva ST. 27V 6a

Mott Park 27V 5a

Project S54

Unit Reading

Date 5-5-05

	Reading	Test Point I. D.	Location	Swing
On	-1040	-	Mott Park	
Off	-594	Light	Park Light	-446
On	-830			
Off	-502	Light	Park Light	-328
On	-752			
Off	-530	Light	Park Light	-222
On	-532		Logan Rd	
Off	-270	Men	Pole no 21287	-262
On	-329		NARVE	
Off	-250	Men	Pole no 10836	-19
On	-303		Sexton	
Off	-303	Men	Pole no 32200	0
On	-310		Sexton	
Off	-310	Men	Pole no 32199	0
On	-322		Sexton	
Off	-222	Men	Pole no 39903	0
On	-109		Ferndale	
Off	-109	Men	Pole no 43890	0
On	-687		Ferndale	
Off	-683	Men	Pole no 20503	0
On	-233		Ferndale	
Off	-233	Men	Pole no 23116	0
On	-584		Ferndale	
Off	-584	Men	Pole no 23117	0
On	-382		Ferndale	
Off	-382	Men	Pole no 23118	0
On	-424		ADAMS LEIGH	
Off	-424	Men	Pole no 349450	0
On	-146		ARLINGTON	
Off	-146	Men	Pole no 33108	0

TESTED BY

P. SMYTH

Brisbane Water Engineering Services

CP Form No. 27

Electrical Engineering Unit

Eva St 27V 6A

Cathodic Protection Interference Survey Results Form

Tarragindi To Wynnum Rd Mott Park 27V 5A

Project S. 34

Unit Reading

Date 3-5-05

	Reading	Test Point I. D.	Location	Swing
On	-226	Men	Eva St	-51
Off	-175		Pole no 185	
On	-414	Men	CHatsworth	0
Off	-416		Pole no 26522	
On	-283	Men	City View	+6
Off	-289		Pole no 9590	
On	-003	Men	Ferguson	0
Off	-003		Pole no 17735	
On	-488	Men	Ferguson	-106
Off	-382		Pole no 17734	
On	-084	Men	Ferguson	-0
Off	-084		Pole no 29009	
On	-260	Men	Ferguson	0
Off	-260		Pole no 27011	
On	-011	Men	The Promard	0
Off	-011		Pole no 1454	
On	-172	Men	The Promard	0
Off	-172		Pole no X19640	
On	-12	Men	Muir	0
Off	-12		Pole no 40265	
On				
Off				
On				
Off				
TESTED BY

P. Smyth

Brisbane Water Engineering Services

CP Form No.18

Electrical Engineering Unit

Standard Cathodic Protection Test Point Data Gathering FormProject S54 TARRAGINDI TO WYNNUM RDDate 3-11-03TP Location AUTUMN 4 TARRAGINDI RDTP No. 1Mains Size 1060 mmTP Type B**POTENTIAL TESTING**

CATHODE TO CATHODE RETURN (RESISTANCE)

0.25V

ZINC REFERENCE TO PIPE

+ 774

CuSo4 REFERENCE TO PIPE

- 419

ZINC TO CuSo4

- 1194**EARTH TESTING**

TEST NO. 1

PIN SPACING

2

RESISTIVITY

117.4 Ω PM

MEGGER READING

9.35

TEST NO 2

PIN SPACING

RESISTIVITY

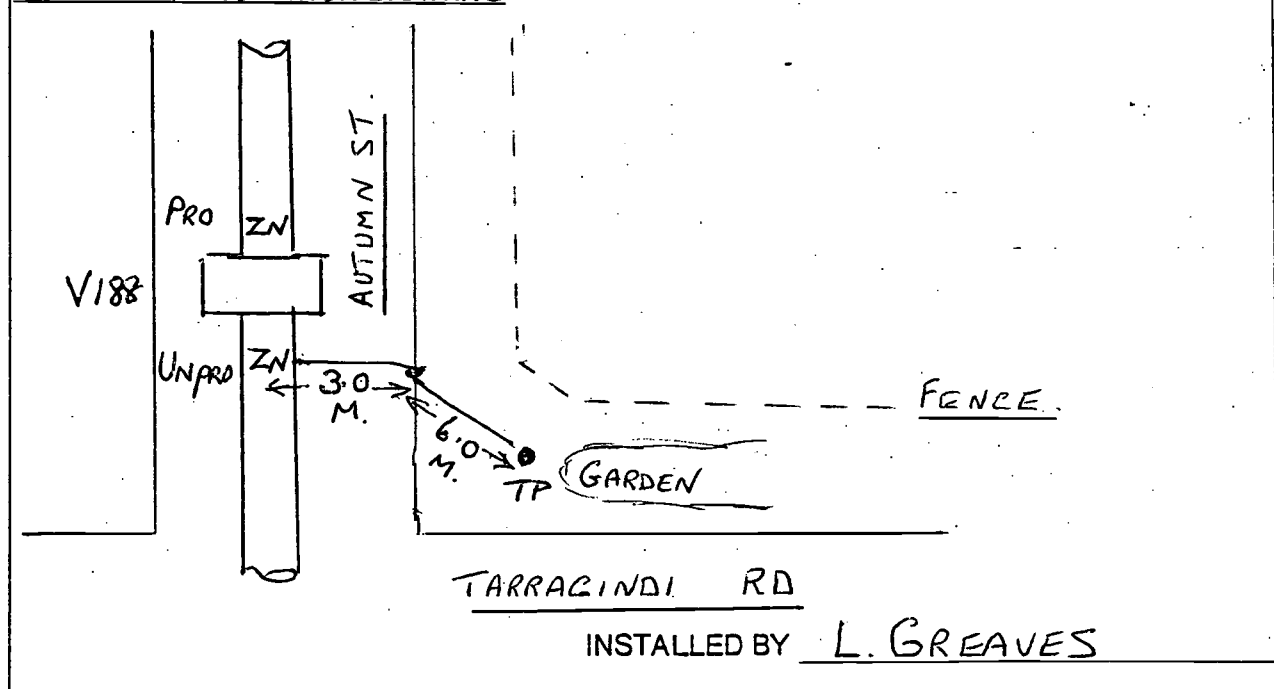
MEGGER READING

TEST NO 3

PIN SPACING

RESISTIVITY

MEGGER READING

COMMENTS / LOCATION DRAWING

Brisbane Water Engineering Services

CP Form No.18

Electrical Engineering Unit

Standard Cathodic Protection Test Point Data Gathering FormProject Weller's Hill - Mt GravattDate 19-4-03T P Location Weller's Rd. FernvaleT P No. 2

Mains Size

T P Type B x 2**POTENTIAL TESTING**

CATHODE TO CATHODE RETURN (RESISTANCE)

ZINC REFERENCE TO PIPE

CuSo4 REFERENCE TO PIPE

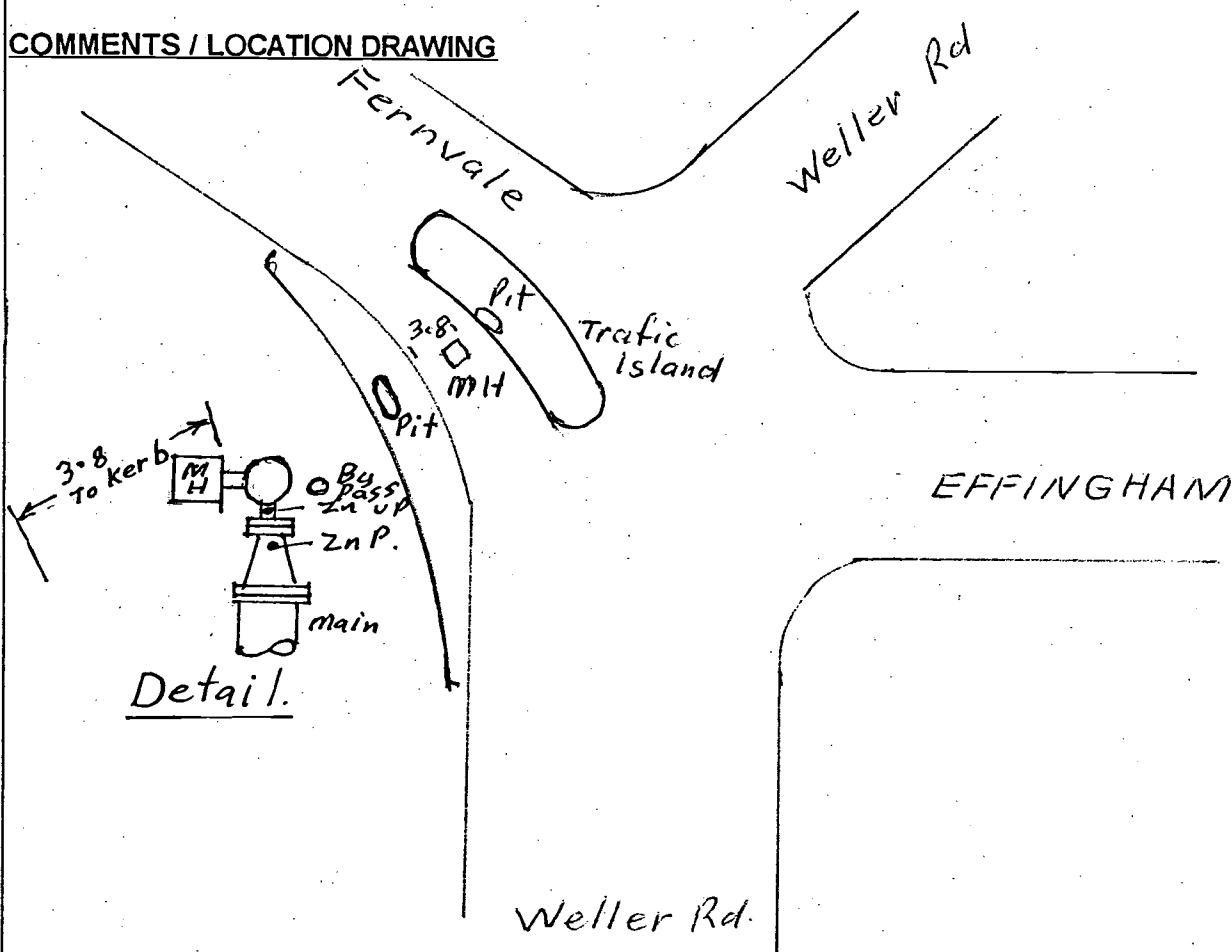
ZINC TO CuSo4

P	UP
0.15	0.15
+614	+601
-589	-614
-1203	-1216

EARTH TESTINGTEST NO. 1

PIN SPACING

MEGGER READING

2
6-2RESISTIVITY 77.8 Ω pm**COMMENTS / LOCATION DRAWING**

INSTALLED BY

Brisbane Water Engineering Services

CP Form No.18

Electrical Engineering Unit

Standard Cathodic Protection Test Point Data Gathering FormProject S54 Tarragindi - Wynnum Date 2-7-03TP Location 18 EFFINGHAM ST. TP No. 3Mains Size 42" to 36" TP Type B**POTENTIAL TESTING**

CATHODE TO CATHODE RETURN (RESISTANCE)

ZINC REFERENCE TO PIPE

CuSo4 REFERENCE TO PIPE

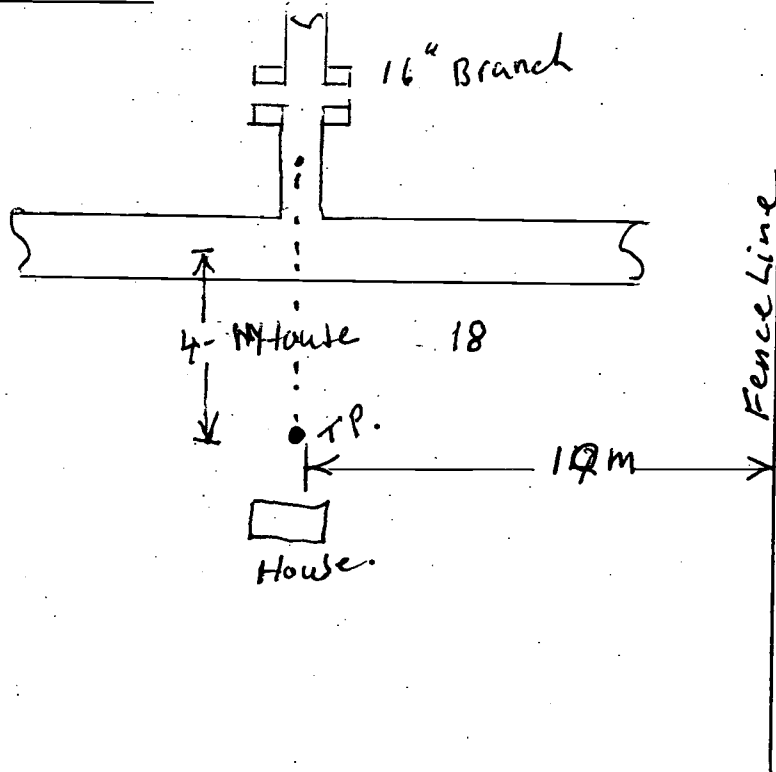
ZINC TO CuSo4

12 Ω
+ 585
- 416
- 111

EARTH TESTINGTEST NO. 1

PIN SPACING

MEGGER READING

2
3.5
RESISTIVITY 43.9 Ω pm**COMMENTS / LOCATION DRAWING**

INSTALLED BY

P. SMYTH

Brisbane Water Engineering Services

CP Form No.18

Electrical Engineering Unit

Standard Cathodic Protection Test Point Data Gathering FormProject S54 Tarragindi - Wynnum Date 10-4-03TP Location Sexton.TP No. 4Mains Size 42-36TP Type B Pit.**POTENTIAL TESTING**

CATHODE TO CATHODE RETURN (RESISTANCE)

ZINC REFERENCE TO PIPE

CuSo4 REFERENCE TO PIPE

ZINC TO CuSo4

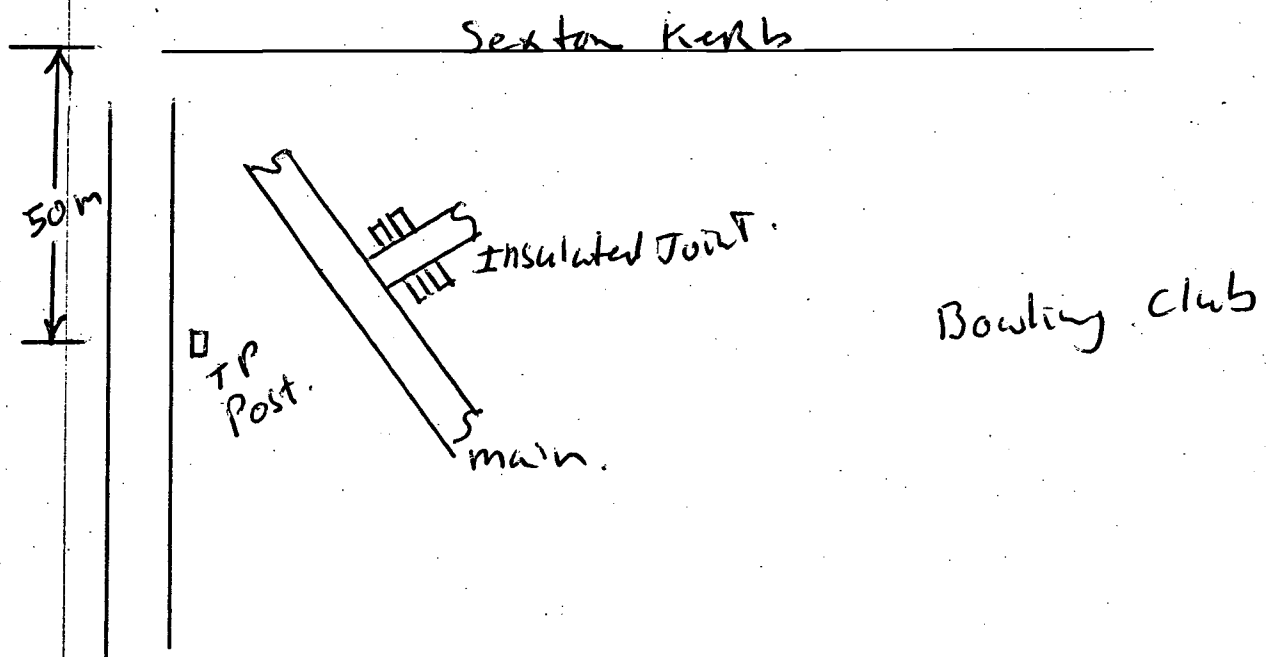
0.2 Ω +689-549-1124**EARTH TESTING**TEST NO. 1

PIN SPACING

MEGGER READING

2~~1.5~~ 1.5

RESISTIVITY

18.81 ρm **COMMENTS / LOCATION DRAWING**

INSTALLED BY

P. Smart

Brisbane Water Engineering Services

CP Form No.18

Electrical Engineering Unit

Standard Cathodic Protection Test Point Data Gathering FormProject Tarragindi Wynnum Date 28-10-03TP Location Cnr Birdwood & Navy TP No. 5Mains Size 42" to 36" TP Type B Post**POTENTIAL TESTING**

CATHODE TO CATHODE RETURN (RESISTANCE)

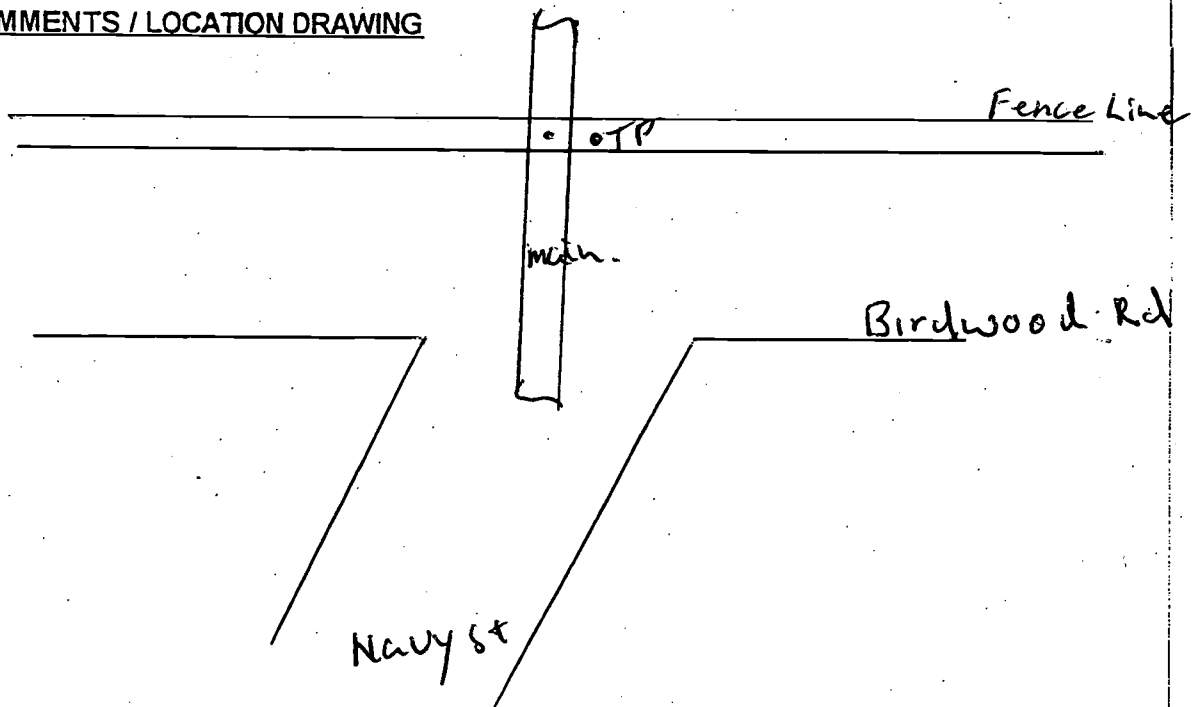
ZINC REFERENCE TO PIPE

CuSo4 REFERENCE TO PIPE

ZINC TO CuSo4

0.15+ 590- 454- 1095**EARTH TESTING**TEST NO. 1

PIN SPACING

MEGGER READING 2.2RESISTIVITY 21.6 Ω pm**COMMENTS / LOCATION DRAWING**

INSTALLED BY

Brisbane Water Engineering Services

CP Form No.18

Electrical Engineering Unit

Standard Cathodic Protection Test Point Data Gathering FormProject S54 Tarragindi - Wynnum Date 10-4-03T P Location Mott ParkT P No. 6Mains Size 42" - 36"T P Type Rest. 15' in
13**POTENTIAL TESTING**

CATHODE TO CATHODE RETURN (RESISTANCE)

ZINC REFERENCE TO PIPE

CuSo4 REFERENCE TO PIPE

ZINC TO CuSo4

.1 Ω+ 585- 1060- 484**EARTH TESTING**TEST NO. 1

PIN SPACING

MEGGER READING

21.3RESISTIVITY 16.3TEST NO 2

PIN SPACING

MEGGER READING

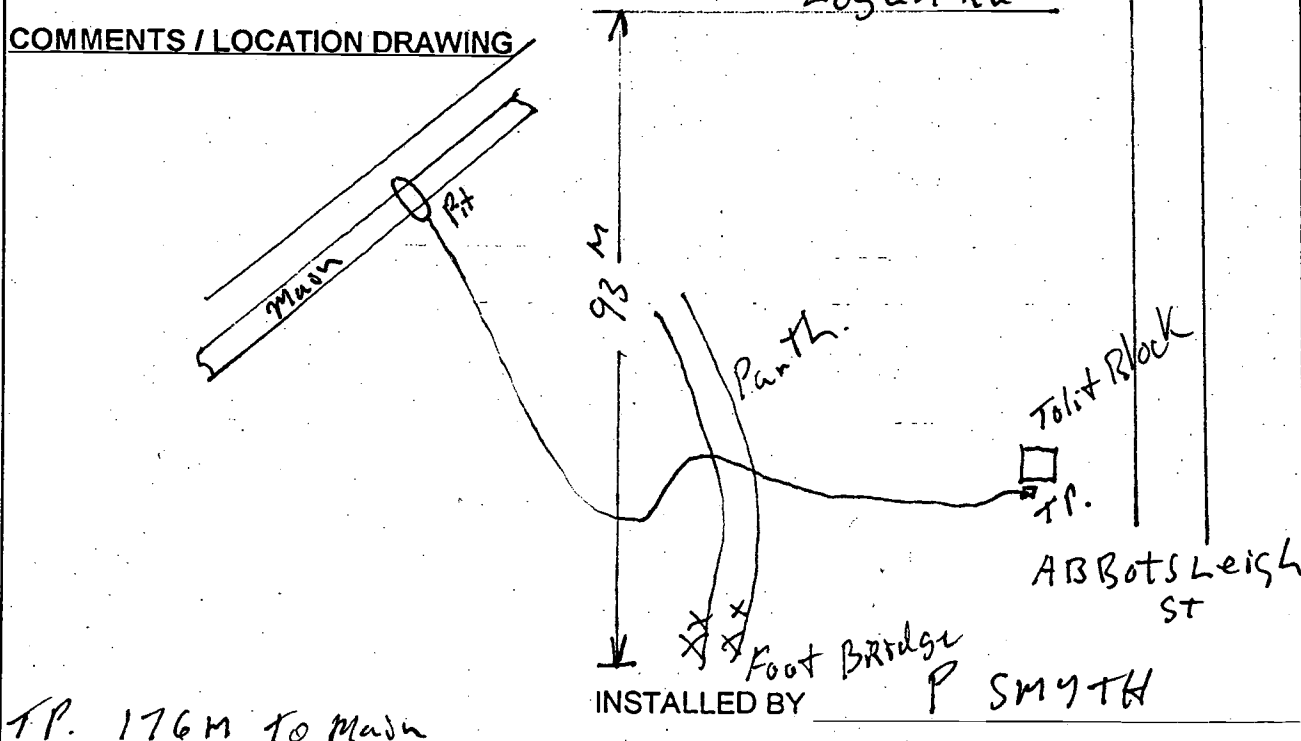
RESISTIVITY

TEST NO 3

PIN SPACING

MEGGER READING

RESISTIVITY

COMMENTS / LOCATION DRAWING

Brisbane Water Engineering Services

CP Form No.18

Electrical Engineering Unit

Standard Cathodic Protection Test Point Data Gathering FormProject S54 Tarragindi - Wynnum Date 10-4-03T P Location 460 Geelong AvT P No. 7Mains Size 4 1/2" - 36T P Type B Post**POTENTIAL TESTING**

CATHODE TO CATHODE RETURN (RESISTANCE)

ZINC REFERENCE TO PIPE

CuSo4 REFERENCE TO PIPE

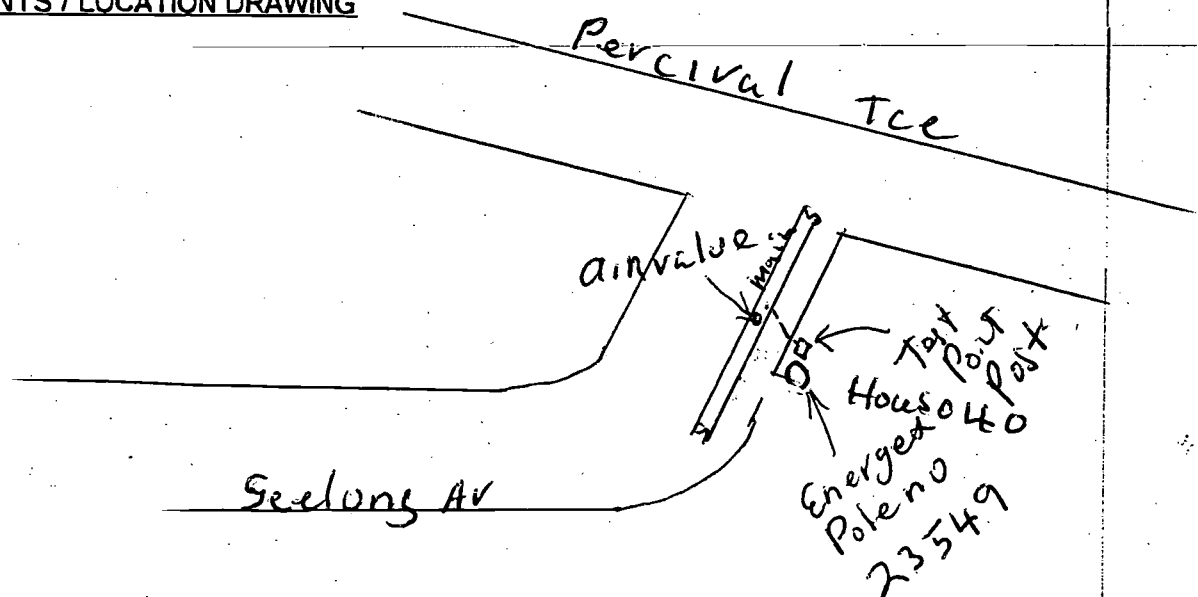
ZINC TO CuSo4

0.15+ 720- 287-1006**EARTH TESTING**

TEST NO. 1

PIN SPACING

MEGGER READING

2m2.8RESISTIVITY 35.16 Ω pm**COMMENTS / LOCATION DRAWING**

INSTALLED BY

P. Smyth

Brisbane Water Engineering Services

CP Form No.18

Electrical Engineering Unit

Standard Cathodic Protection Test Point Data Gathering Form

Project Tarragindi - Wynnum Date 28-10-03
 TP Location Eva St in Magestic Park TP No. 8
 Mains Size 42" - 36" TP Type B

POTENTIAL TESTING

CATHODE TO CATHODE RETURN (RESISTANCE)
 ZINC REFERENCE TO PIPE
 CuSo4 REFERENCE TO PIPE
 ZINC TO CuSo4

1 Ω
+726
-380
-1100

EARTH TESTINGTEST NO. 1

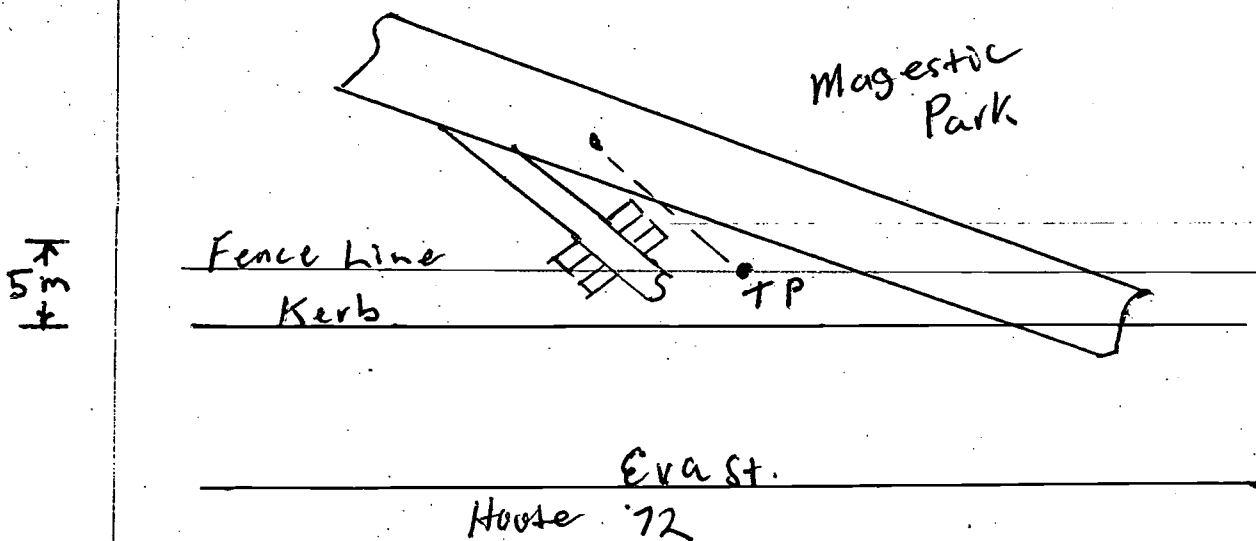
PIN SPACING

2m

RESISTIVITY

97.7 Ωpm

MEGGER READING

7.78**COMMENTS / LOCATION DRAWING**

INSTALLED BY

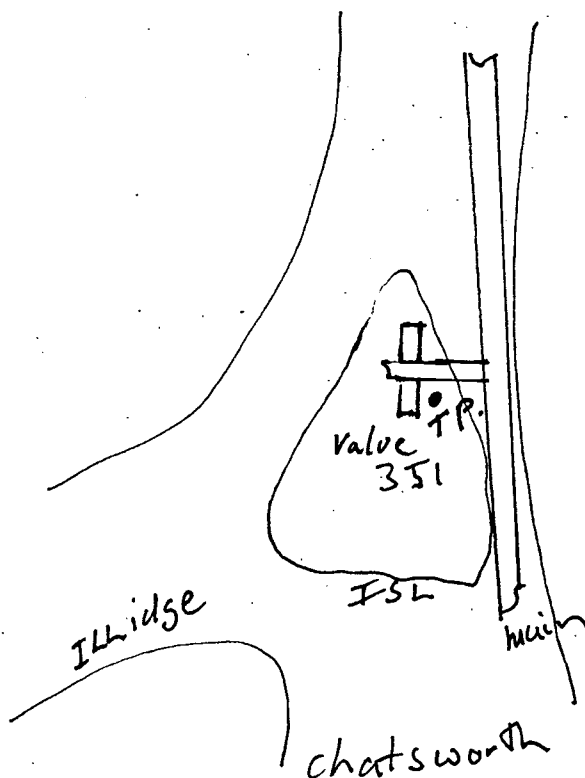
Brisbane Water Engineering Services

CP Form No. 18

Electrical Engineering Unit

Standard Cathodic Protection Test Point Data Gathering FormProject Set 54 Tarragindi - Wynnum Date 18-2-04TP Location Chatsworth at Illidge TP No. 9Mains Size 42" - 36" TP Type B Post**POTENTIAL TESTING**

CATHODE TO CATHODE RETURN (RESISTANCE)
 ZINC REFERENCE TO PIPE
 CuSo4 REFERENCE TO PIPE
 ZINC TO CuSo4

0.1 Ω +578-460-1095**EARTH TESTING**TEST NO. 1PIN SPACING 2MEGGER READING 4.1RESISTIVITY 51.4 Ω pm**COMMENTS / LOCATION DRAWING**INSTALLED BY P SMYTH

Brisbane Water Engineering Services

CP Form No.18

Electrical Engineering Unit

Standard Cathodic Protection Test Point Data Gathering Form

Project Tarragindi To Wynnum Date 10-10-03
 TP Location Thomas and Prout TP No. 10
 Mains Size 42" TO 36" TP Type B Post

POTENTIAL TESTING

CATHODE TO CATHODE RETURN (RESISTANCE)
 ZINC REFERENCE TO PIPE
 CuSo4 REFERENCE TO PIPE
 ZINC TO CuSo4

0.1 Ω
+ 443
- 650
- 1090

EARTH TESTINGTEST NO. 1

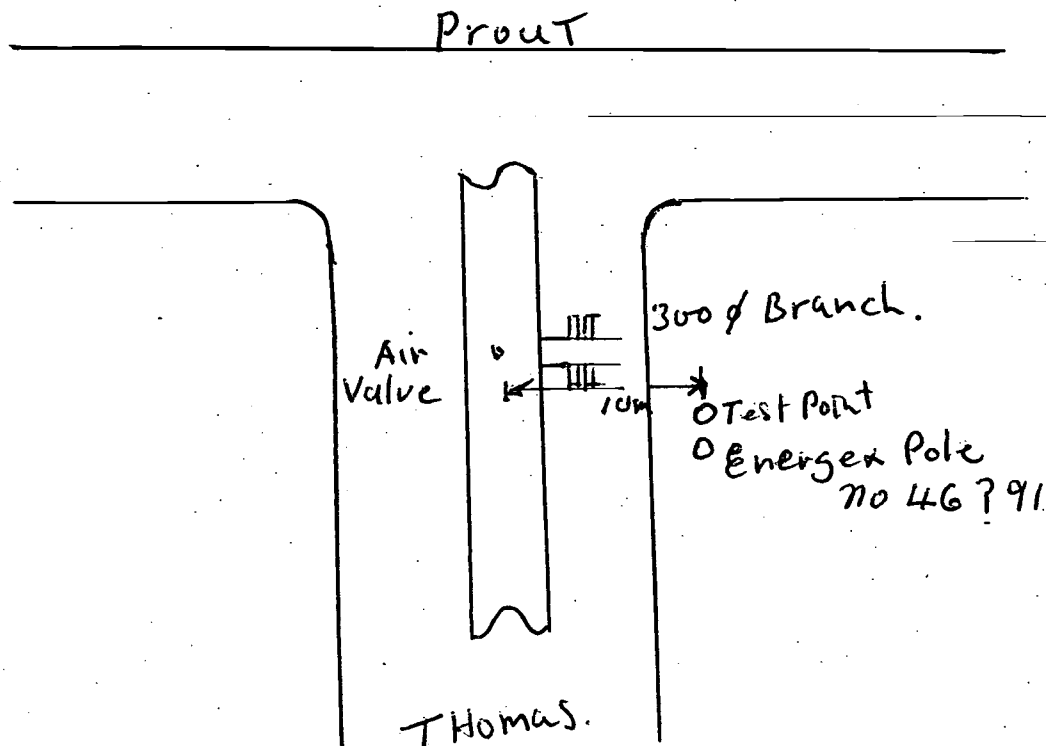
PIN SPACING

3-7 2m

RESISTIVITY

46.4 Ω pm

MEGGER READING

3.7**COMMENTS / LOCATION DRAWING**

INSTALLED BY

P. Smyth.

Brisbane Water Engineering Services

CP Form No.18

Electrical Engineering Unit

Standard Cathodic Protection Test Point Data Gathering Form

Project S54 Tarragindi - Wynnum Date 28-6-03
 TP Location Old Cleveland Rd TP No. 112
 Mains Size 42" - 36" TP Type B Post

POTENTIAL TESTING

CATHODE TO CATHODE RETURN (RESISTANCE)
 ZINC REFERENCE TO PIPE
 CuSo4 REFERENCE TO PIPE
 ZINC TO CuSo4

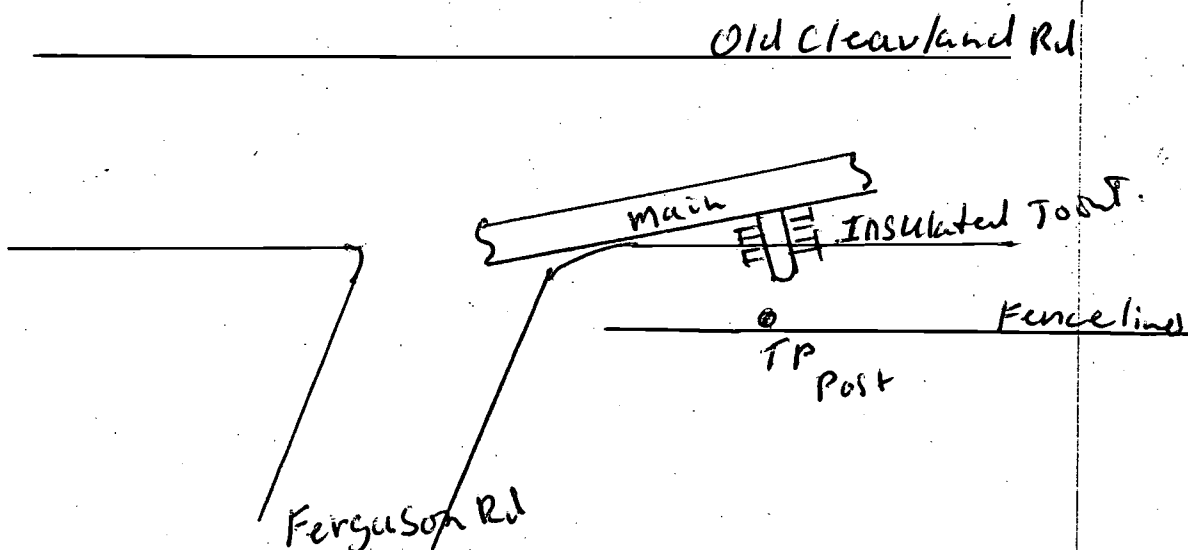
0.1 Ω
+434
-593
-938

EARTH TESTINGTEST NO. 1

PIN SPACING

MEGGER READING

2m
2.2

RESISTIVITY 27.6 Ω cm**COMMENTS / LOCATION DRAWING**

INSTALLED BY

Brisbane Water Engineering Services

CP Form No.18

Electrical Engineering Unit

Standard Cathodic Protection Test Point Data Gathering FormProject Tarragindi - Wynnum RdDate 19-4-03TP Location The PromenadeTP No. 12Mains Size 42" - 36"TP Type B Pit.**POTENTIAL TESTING**

CATHODE TO CATHODE RETURN (RESISTANCE)

ZINC REFERENCE TO PIPE

CuSo4 REFERENCE TO PIPE

ZINC TO CuSo4

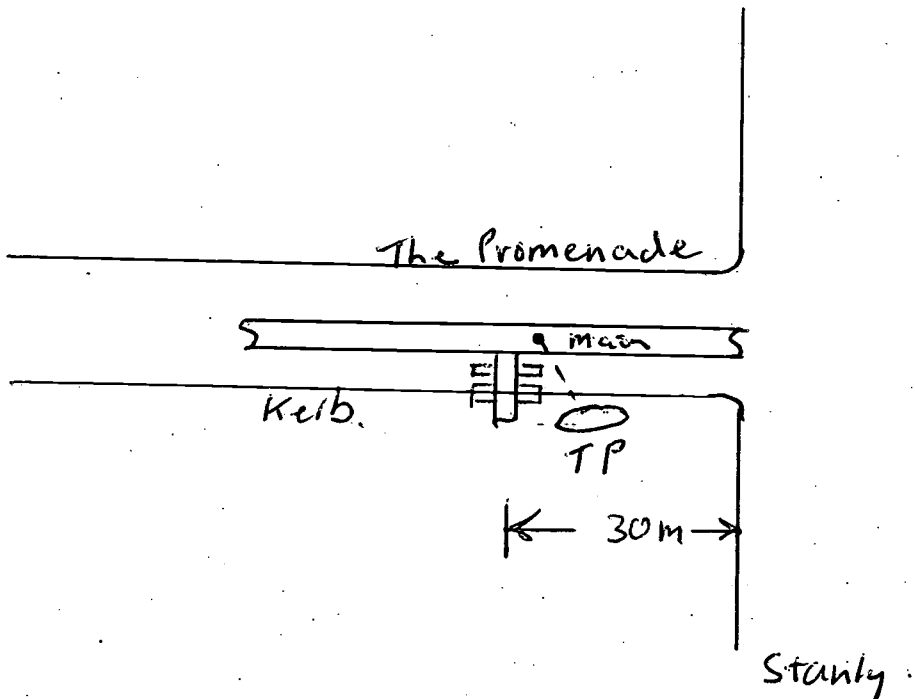
01 Ω
+ 446
- 490
- 952

EARTH TESTINGTEST NO. 1

PIN SPACING

MEGGER READING

2
1.8

RESISTIVITY 22.6 Ω m**COMMENTS / LOCATION DRAWING**

INSTALLED BY

Brisbane Water Engineering Services

CP Form No.18

Electrical Engineering Unit

Standard Cathodic Protection Test Point Data Gathering FormProject ... S54Date 15-4-03T P Location ... 511 Darcy RdT P No. 13Mains Size 42" - 36"T P Type ... B Post**POTENTIAL TESTING**

CATHODE TO CATHODE RETURN (RESISTANCE)

ZINC REFERENCE TO PIPE

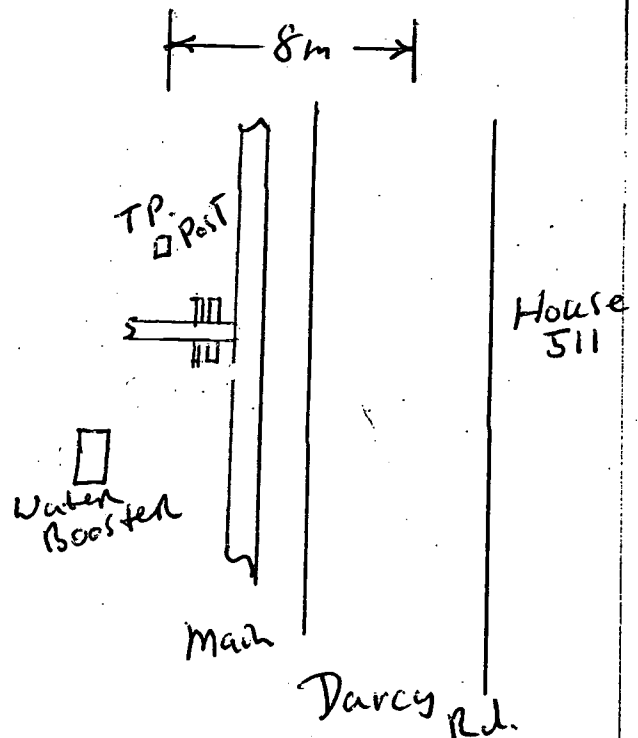
CuSo4 REFERENCE TO PIPE

ZINC TO CuSo4

0.25+709-516-1225**EARTH TESTING**TEST NO. 1

PIN SPACING

MEGGER READING

210.06RESISTIVITY 126.35 Ω pm**COMMENTS / LOCATION DRAWING**

INSTALLED BY

Brisbane Water Engineering Services

CP Form No.18

Electrical Engineering Unit

Standard Cathodic Protection Test Point Data Gathering FormUBD
161613Project S54 Tarragindi - Wynnum Rd.

Date

T P Location Baguette st Seven hillsT P No. 14Mains Size 900 mmT P Type B Post**POTENTIAL TESTING**

CATHODE TO CATHODE RETURN (RESISTANCE)
 ZINC REFERENCE TO PIPE
 CuSo4 REFERENCE TO PIPE
 ZINC TO CuSo4

.02.

+558

-448

-1002

EARTH TESTING**TEST NO. 1**

PIN SPACING

2 mtrs

MEGGER READING

7.7

RESISTIVITY

97 Ω mtrs**TEST NO 2**

PIN SPACING

MEGGER READING

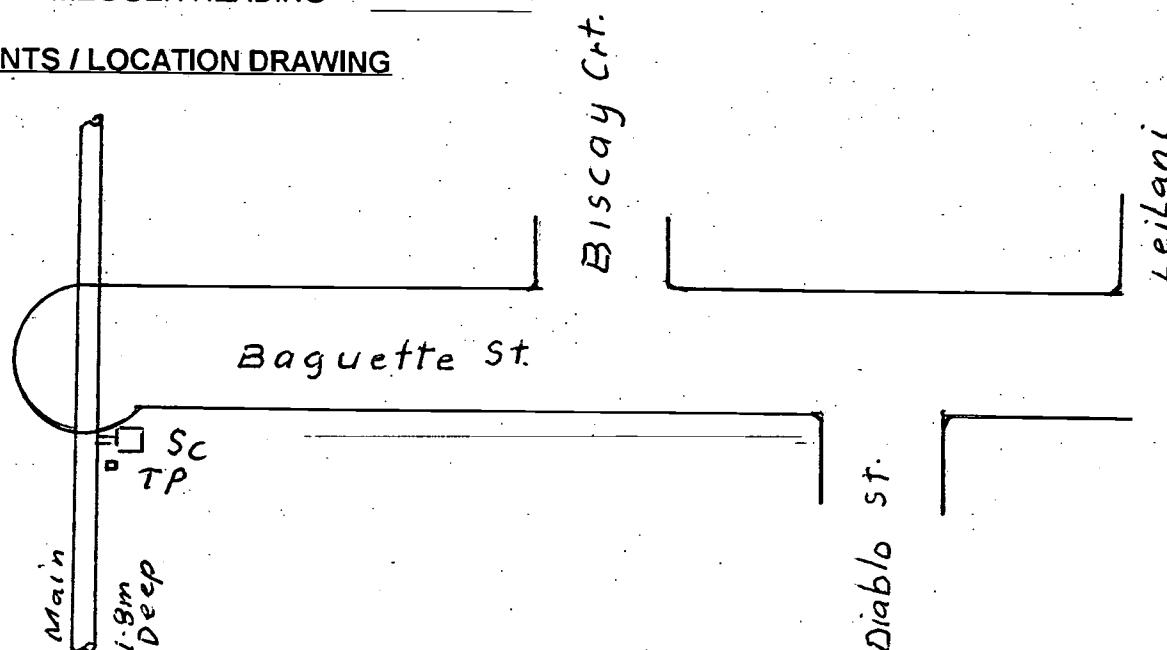
RESISTIVITY

TEST NO 3

PIN SPACING

MEGGER READING

RESISTIVITY

COMMENTS / LOCATION DRAWING

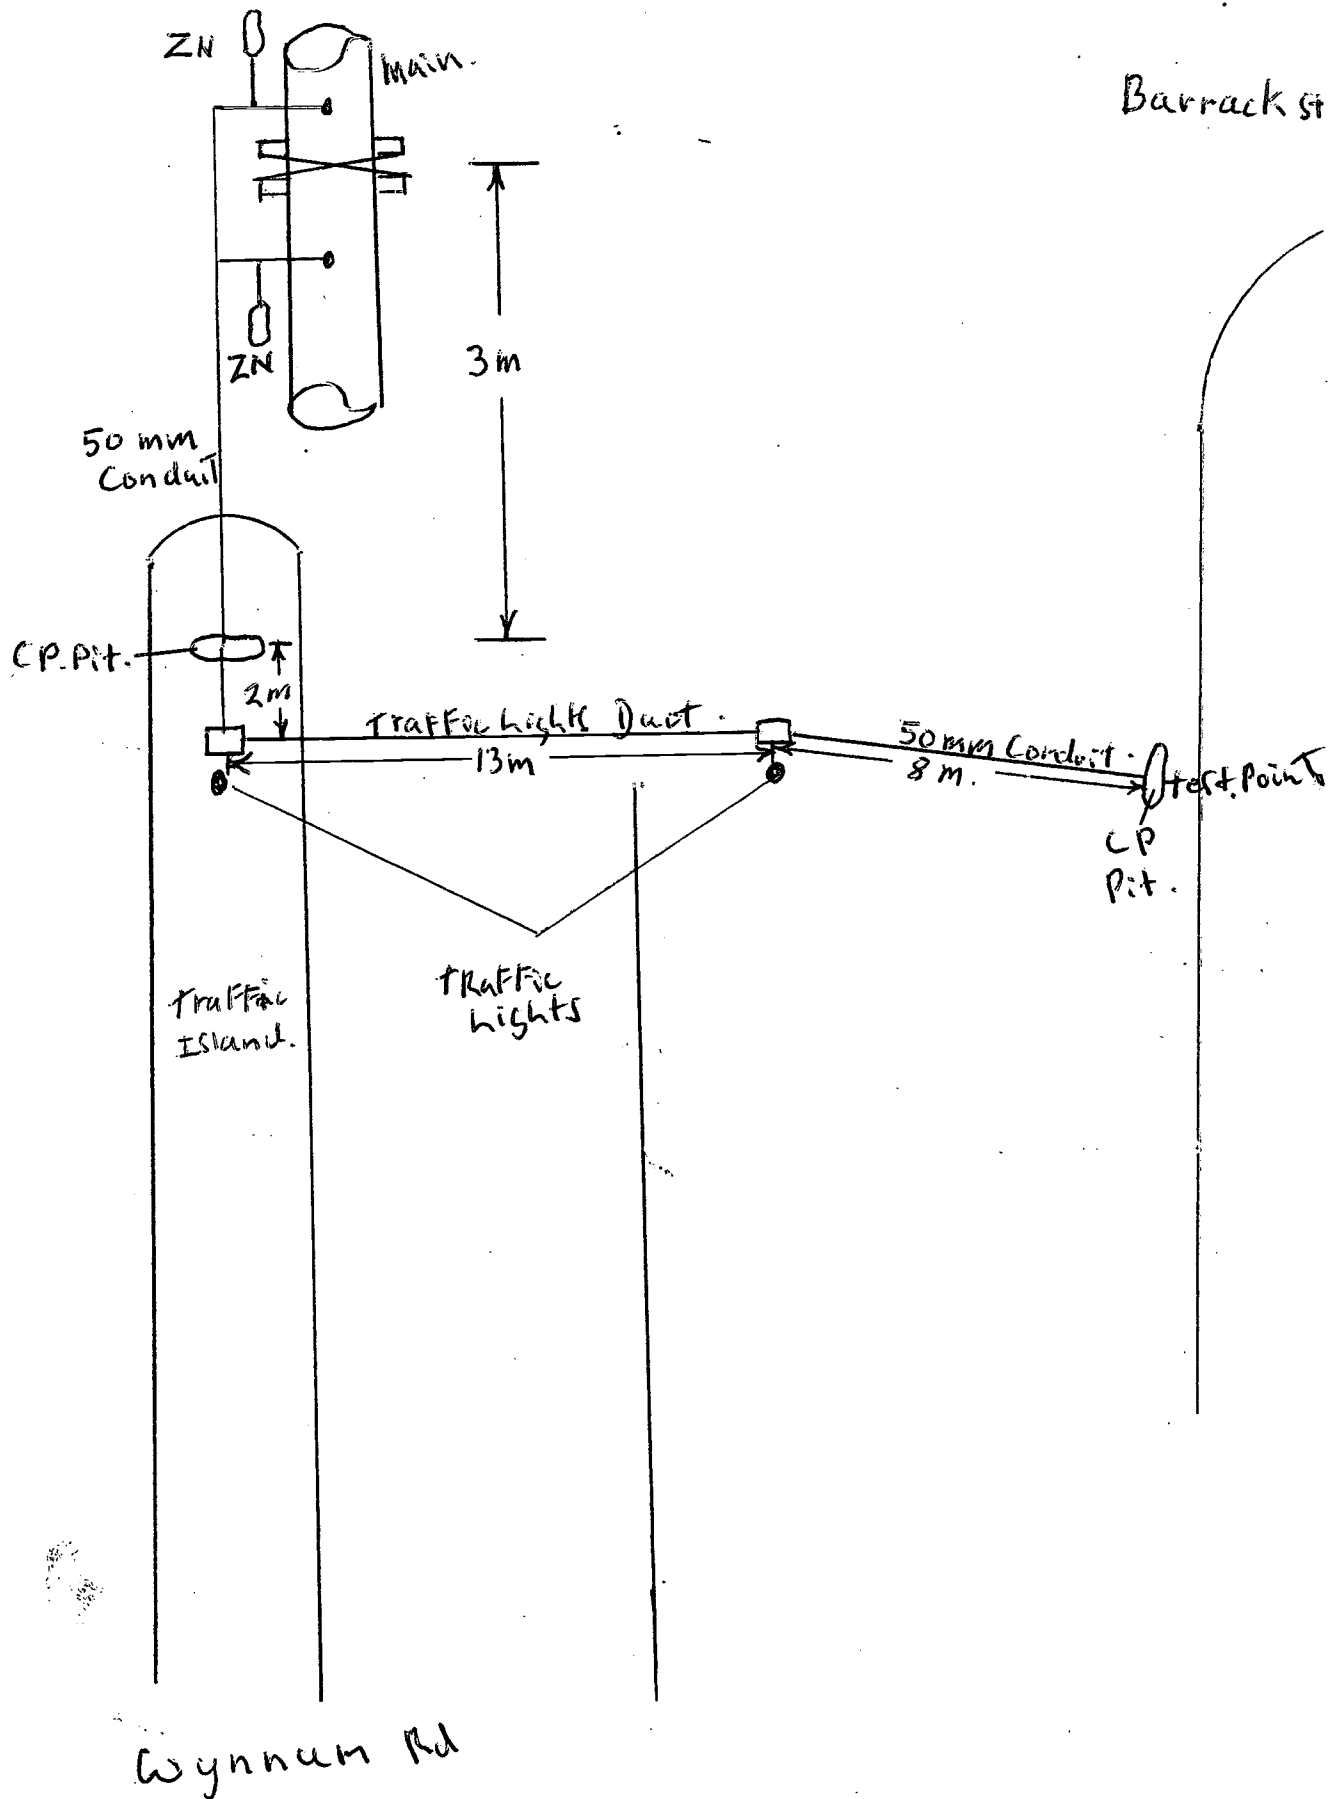
INSTALLED BY

J Taylor

Muar St

cables in Conduit.
2, 6mm² Earth wire
2, 6mm² SDI Black.
2, 16mm² SDI Black

Barrack St



Brisbane Water Engineering Services

CP Form No. 18

Electrical Engineering Unit

Standard Cathodic Protection Test Point Data Gathering FormProject S54 Tarragindi - Wynnum Date 3-2-04TP Location Cnr Wynnum + Barrack TP No. 15Mains Size 42" to 30" TP Type B Pit.**POTENTIAL TESTING**

CATHODE TO CATHODE RETURN (RESISTANCE)

0.1 Ω

ZINC REFERENCE TO PIPE

+680

CuSo4 REFERENCE TO PIPE

-710

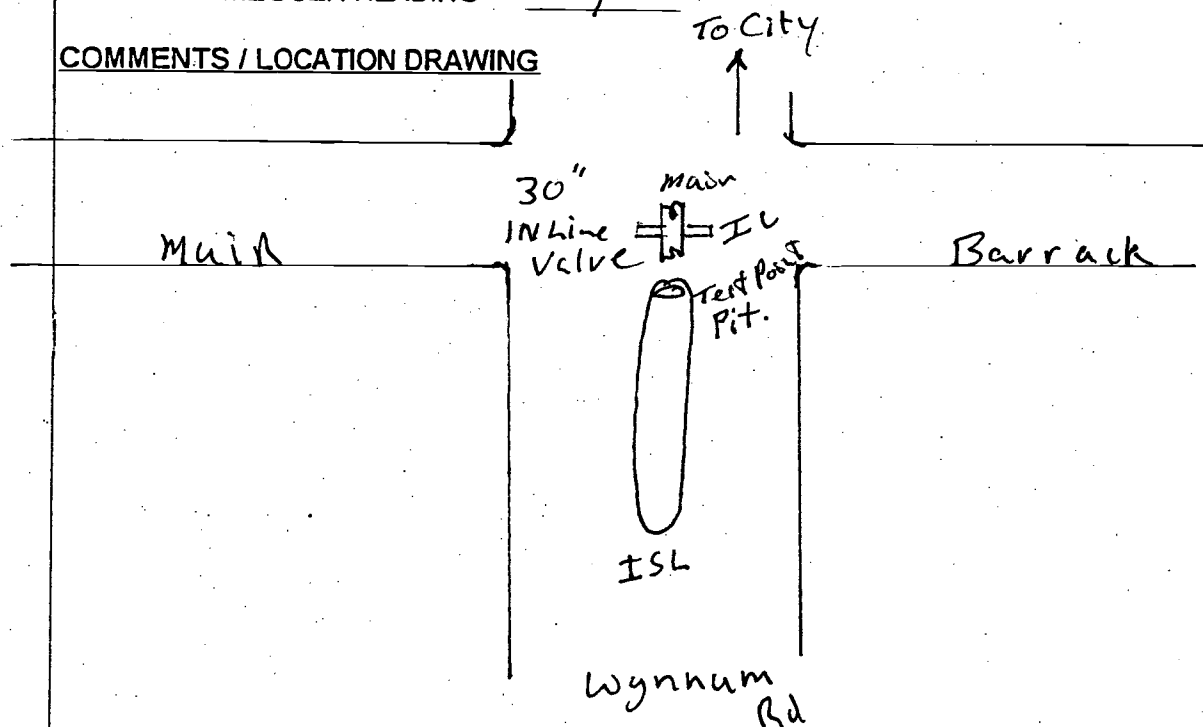
ZINC TO CuSo4

-1111**EARTH TESTING**TEST NO. 1

PIN SPACING

2

MEGGER READING

0.9RESISTIVITY 11.3 Ω pm**COMMENTS / LOCATION DRAWING**

INSTALLED BY

P. Smyth

Brisbane Water Engineering Services

CP Form No.18

Electrical Engineering Unit

Standard Cathodic Protection Test Point Data Gathering FormProject Set 35 Wynnum Rd.Date 20-1-04T P Location 88 Barrack RdT P No. 1

Mains Size

T P Type B Post**POTENTIAL TESTING**

CATHODE TO CATHODE RETURN (RESISTANCE)

ZINC REFERENCE TO PIPE

CuSo4 REFERENCE TO PIPE

ZINC TO CuSo4

0.2 Ω
+ 559
- 585
- 1143

EARTH TESTING

TEST NO. 1

PIN SPACING

MEGGER READING

2m5.5RESISTIVITY 69.08 Ω pm

TEST NO 2

PIN SPACING

MEGGER READING

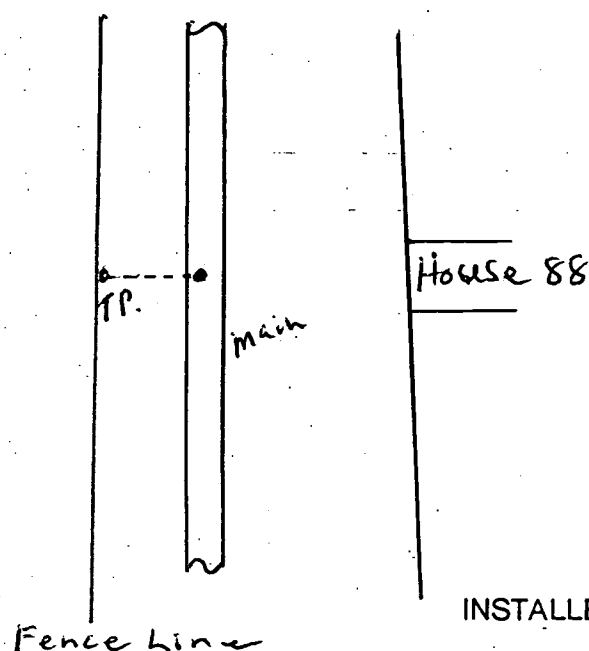
RESISTIVITY

TEST NO 3

PIN SPACING

MEGGER READING

RESISTIVITY

COMMENTS / LOCATION DRAWINGINSTALLED BY P. Smyth

Brisbane Water Engineering Services

CP Form No.18

Electrical Engineering Unit

Standard Cathodic Protection Test Point Data Gathering FormProject Set 35 Wynnum Rd Date 21-1-04T P Location Cnr Barrack & Lytton T P No. 2Mains Size T P Type B Post**POTENTIAL TESTING**

CATHODE TO CATHODE RETURN (RESISTANCE)

0.2 Ω

ZINC REFERENCE TO PIPE

+ 569

CuSo4 REFERENCE TO PIPE

- 552

ZINC TO CuSo4

- 1122**EARTH TESTING**TEST NO. 1

PIN SPACING

2 m

RESISTIVITY

86-6 Ω cm

MEGGER READING

6.9TEST NO 2

PIN SPACING

RESISTIVITY

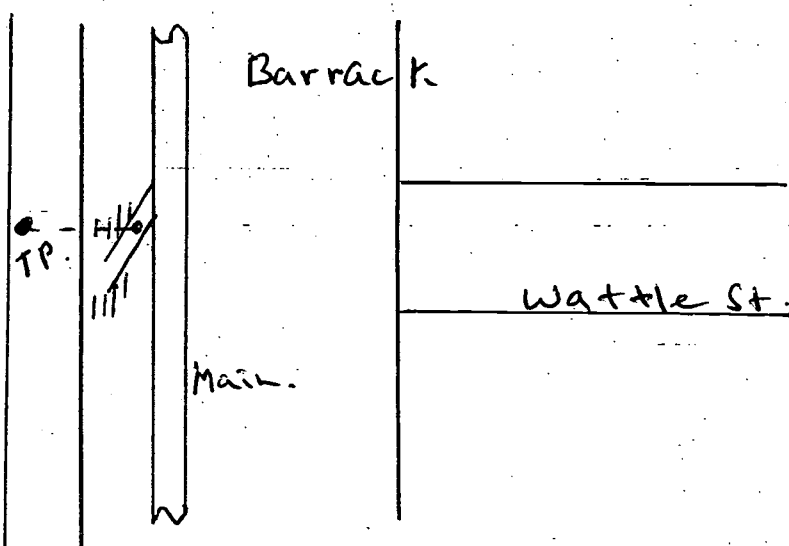
MEGGER READING

TEST NO 3

PIN SPACING

RESISTIVITY

MEGGER READING

COMMENTS / LOCATION DRAWING

INSTALLED BY

P. SmythFence Line.

Brisbane Water Engineering Services

CP Form No.18

Electrical Engineering Unit

Standard Cathodic Protection Test Point Data Gathering FormProject Set 35 Wynnum Rd Date 22-1-04T P Location Lytton Rd by Metroplex T P No. 3Mains Size T P Type B Post**POTENTIAL TESTING**

CATHODE TO CATHODE RETURN (RESISTANCE)
 ZINC REFERENCE TO PIPE
 CuSo4 REFERENCE TO PIPE
 ZINC TO CuSo4

.1 Ω
+461
-543
-1002

EARTH TESTINGTEST NO. 1

PIN SPACING

MEGGER READING

8.2 m
8.8

RESISTIVITY

110.5 Ω mTEST NO 2

PIN SPACING

MEGGER READING

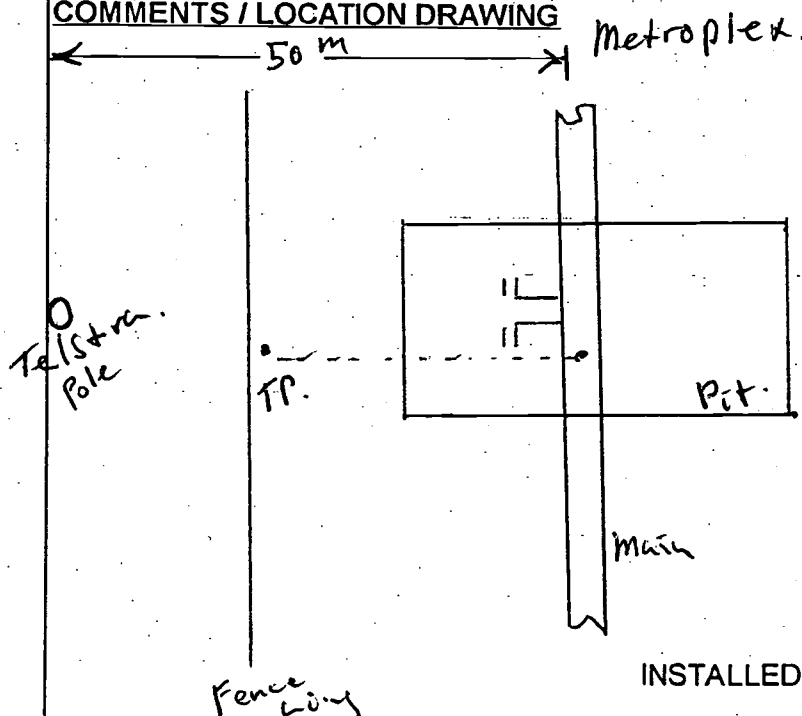
RESISTIVITY

TEST NO 3

PIN SPACING

MEGGER READING

RESISTIVITY

COMMENTS / LOCATION DRAWING

INSTALLED BY

P. Smyth

Brisbane Water Engineering Services

CP Form No. 21

Electrical Engineering Unit

Insulated Joint Testing Details Form*Isolation 1*Project *S54 TARRAGINDI TO WYNNUM RD.*Date *3-11-03***DESCRIPTION**

MAINS DETAILS:

LOCATIONS:

SIZE:

MATERIAL:

COATING:

VALVE No.

*TARRAGINDI TO WYNNUM RD**TARRAGINDI AND AUTUMN RD.**1060 MM**MILD STEEL**TAR EPOXY**V188***IN GROUND TESTING**

BOLT TO FLANGE RESISTANCE:

ALL > 1.0 MSU

NUMBER OF BOLT:

16

FLANGE TO FLANGE RESISTANCE:

35.0 SU

INSULATION CHECKER MODEL 702:

POTENTIAL DIFFERENCE TO REFERENCE CELL:

PROTECTED SIDE:

- 313 mV

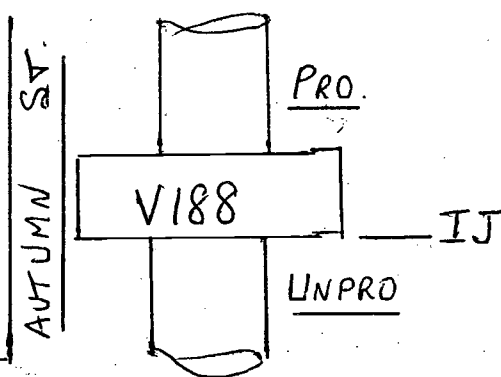
UNPROTECTED SIDE:

*- 303 mV***ABOVE TESTING**

BOLT TO FLANGE RESISTANCE:

NUMBER OF BOLTS:

FLANGE TO FLANGE RESISTANCE:

COMMENTS / LOCATION DRAWING*TARRAGINDI RD.*TESTED BY *L GREAVES*

Brisbane Water Engineering Services

CP Form No. 21

Electrical Engineering Unit

Insulated Joint Testing Details Form

Isolation 2

Project S54 TARRAGINDI TO WYNNUM RDDate 4-11-03**DESCRIPTION**

MAINS DETAILS:

LOCATIONS:

SIZE:

MATERIAL:

COATING:

VALVE No.

TARRAGINDI TO WYNNUM RDAUTUMN ST1000 MMMILD STEELTAR EPOXY150 MM RETIC**IN GROUND TESTING**

BOLT TO FLANGE RESISTANCE:

ALL > 1.5 MV

NUMBER OF BOLT:

8

FLANGE TO FLANGE RESISTANCE:

56.0 V

INSULATION CHECKER MODEL 702:

POTENTIAL DIFFERENCE TO REFERENCE CELL:

PROTECTED SIDE:

- 394 mV

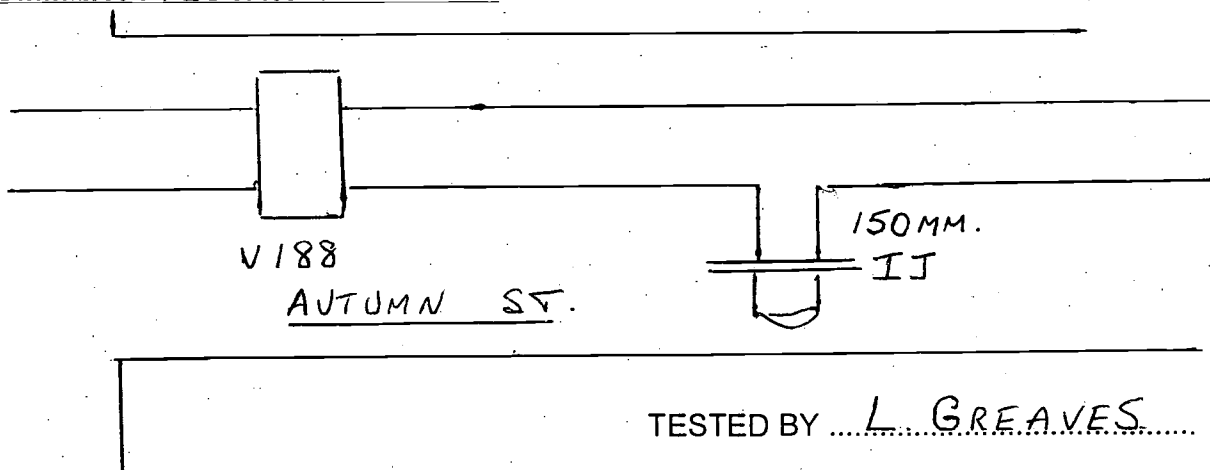
UNPROTECTED SIDE:

- 371 mV**ABOVE TESTING**

BOLT TO FLANGE RESISTANCE:

NUMBER OF BOLTS:

FLANGE TO FLANGE RESISTANCE:

COMMENTS / LOCATION DRAWING

Brisbane Water Engineering Services

CP Form No. 21

Electrical Engineering Unit**Insulated Joint Testing Details Form**Project Tarragindi - WynnumDate 17-2-04
Isolation 3**DESCRIPTION**

MAINS DETAILS:

LOCATIONS:

SIZE:

MATERIAL:

COATING:

VALVE No.

Tarragindi Rd & Datum Rd
42" to 36"
Mild Steel
P.C
254

IN GROUND TESTING

BOLT TO FLANGE RESISTANCE: _____

NUMBER OF BOLT: _____

FLANGE TO FLANGE RESISTANCE: _____

INSULATION CHECKER MODEL 702: _____

POTENTIAL DIFFERENCE TO REFERENCE CELL:

PROTECTED SIDE: _____

UNPROTECTED SIDE: _____

-375
-250

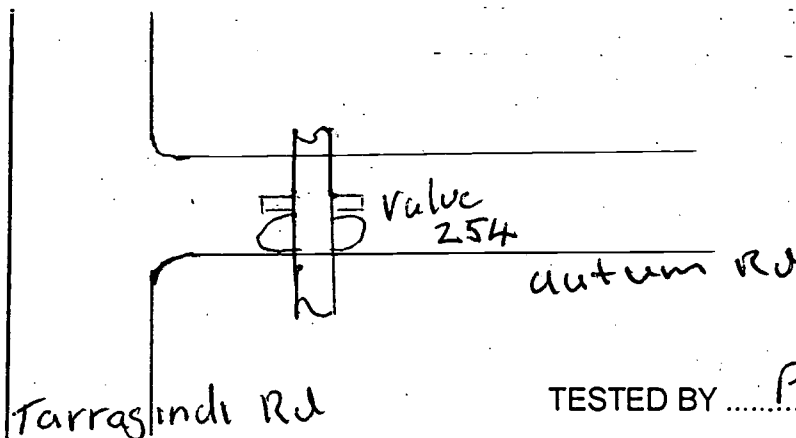
ABOVE TESTING

BOLT TO FLANGE RESISTANCE: _____

NUMBER OF BOLTS: _____

FLANGE TO FLANGE RESISTANCE: _____

all Bolts > 200 Ω
70K Ω

COMMENTS / LOCATION DRAWINGTESTED BY P. Smyth

Brisbane Water Engineering Services

CP Form No. 21

Electrical Engineering Unit

Insulated Joint Testing Details Form

Isolation No 3a

Project Tarragindi - WynnumDate 28-10-03**DESCRIPTION**

MAINS DETAILS:

LOCATIONS:

SIZE:

MATERIAL:

COATING:

VALVE No.

andrew + Ferndale42" to 36"Mild Steel9" Branch**IN GROUND TESTING**

BOLT TO FLANGE RESISTANCE:

all Bolts 7200 Ω

NUMBER OF BOLT:

12

FLANGE TO FLANGE RESISTANCE:

0.78 M Ω

INSULATION CHECKER MODEL 702:

N/A.**POTENTIAL DIFFERENCE TO REFERENCE CELL**

PROTECTED SIDE:

-250 mV

UNPROTECTED SIDE:

-150 mV**ABOVE TESTING**

BOLT TO FLANGE RESISTANCE:

NUMBER OF BOLTS:

FLANGE TO FLANGE RESISTANCE:

COMMENTS / LOCATION DRAWINGandrewmainFerndale.BranchTESTED BY P. SMYTH← 32 m →

Brisbane Water Engineering Services

CP Form No. 21

Electrical Engineering Unit**Insulated Joint Testing Details Form**Project Wellers hill - MT GravattDate 19-4-03Isolation 4**DESCRIPTION**

MAINS DETAILS:

LOCATIONS:

SIZE:

MATERIAL:

COATING:

VALVE No.

Interceptions as belowMSCLTar asbestos**IN GROUND TESTING**

BOLT TO FLANGE RESISTANCE:

> 5 mΩ

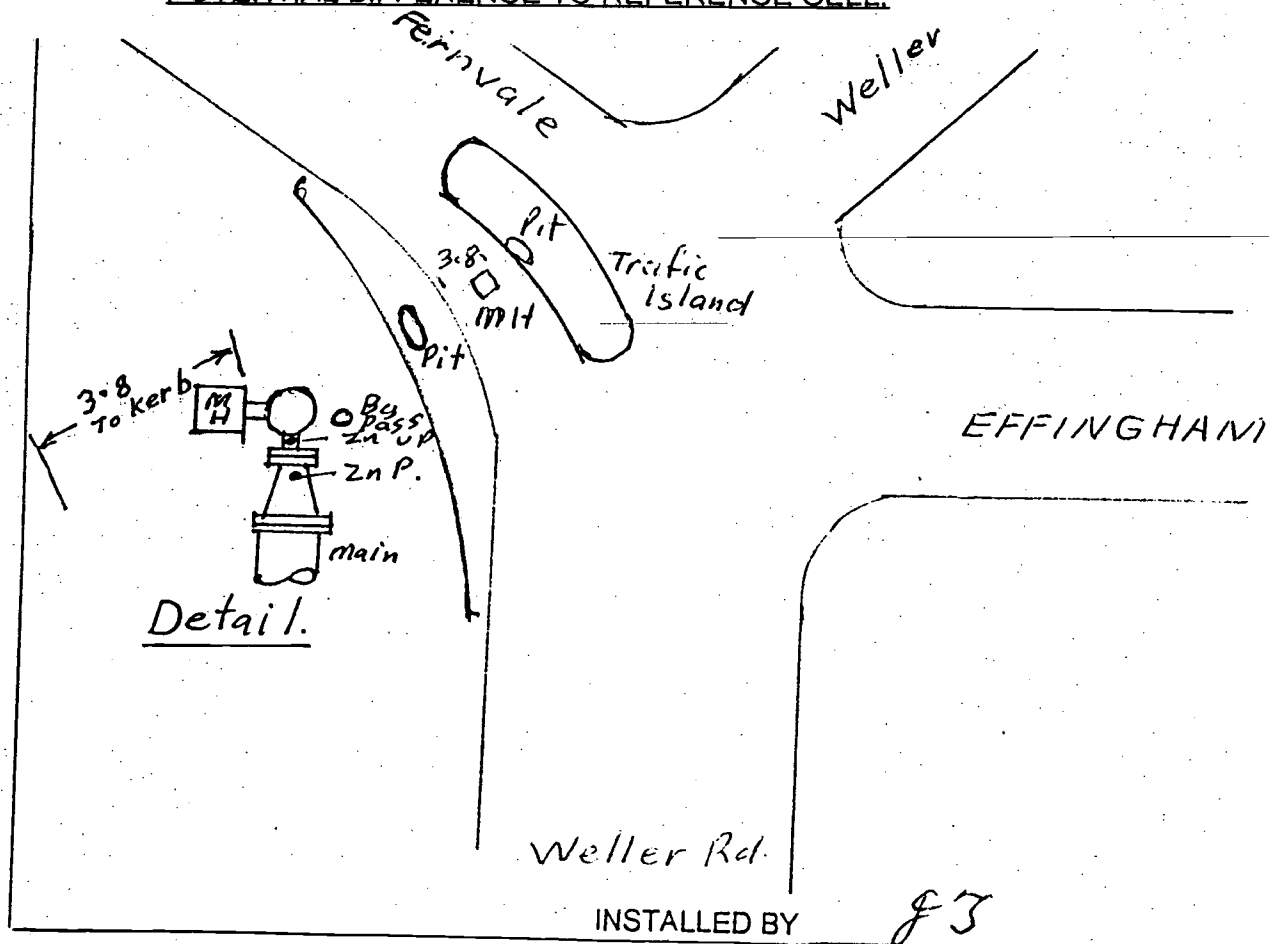
NUMBER OF BOLT:

36 off 4 1/2" x 1"

FLANGE TO FLANGE RESISTANCE:

0.7 mΩ

INSULATION CHECKER MODEL 702:

1 N 11POTENTIAL DIFFERENCE TO REFERENCE CELL:

INSTALLED BY

Brisbane Water Engineering Services

CP Form No. 21

Electrical Engineering Unit

Insulated Joint Testing Details FormProject S54Date 2-7-03
Isolation 5**DESCRIPTION**

MAINS DETAILS:

LOCATIONS:

SIZE:

MATERIAL:

COATING:

VALVE No:

No 46 EPPingham St42"-36"Mild Steel16" BR796**IN GROUND TESTING**

BOLT TO FLANGE RESISTANCE:

all Bolts > 2000

NUMBER OF BOLT:

FLANGE TO FLANGE RESISTANCE:

> KΩ

INSULATION CHECKER MODEL 702:

N/APOTENTIAL DIFFERENCE TO REFERENCE CELL:

PROTECTED SIDE:

-416

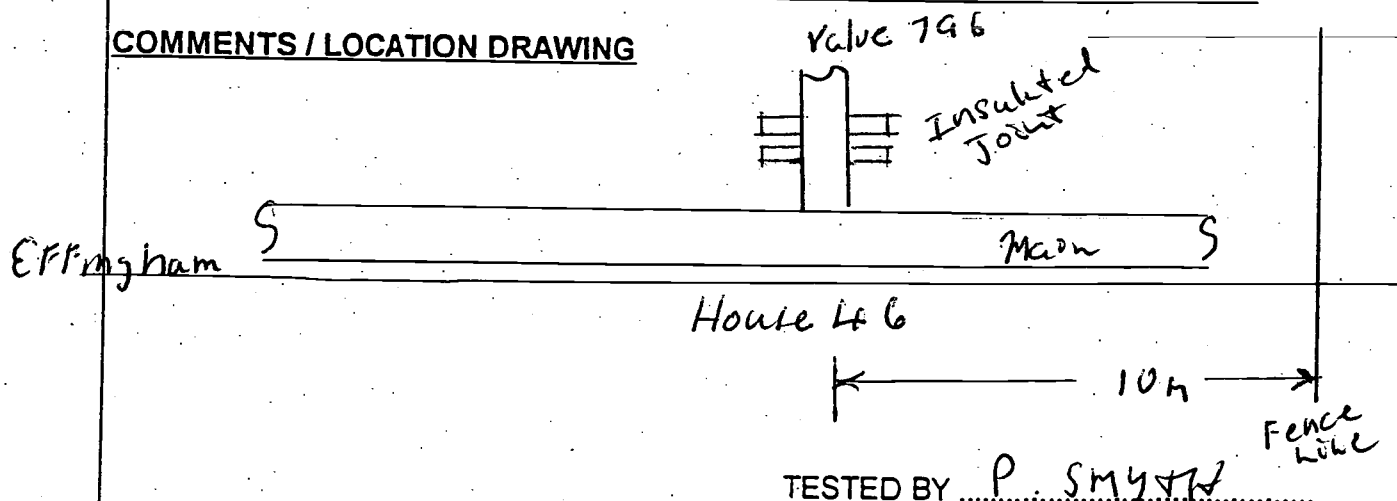
UNPROTECTED SIDE:

-350**ABOVE TESTING**

BOLT TO FLANGE RESISTANCE:

NUMBER OF BOLTS:

FLANGE TO FLANGE RESISTANCE:

COMMENTS / LOCATION DRAWINGTESTED BY P. Smyth

Brisbane Water Engineering Services

CP Form No. 21

Electrical Engineering Unit

Insulated Joint Testing Details FormProject S54Date 28-4-07Isolation 7**DESCRIPTION**

MAINS DETAILS:

LOCATIONS:

SIZE:

MATERIAL:

COATING:

VALVE No.

Tarragindi To Wynnum
Sexton Bowling Club
42 36
Mild Steel

IN GROUND TESTINGBOLT TO FLANGE RESISTANCE: all Bolts > 200 Ω

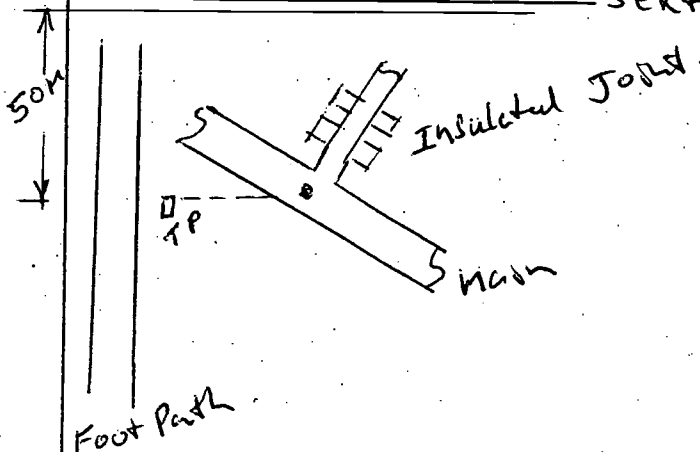
NUMBER OF BOLT:

FLANGE TO FLANGE RESISTANCE: 6 m Ω INSULATION CHECKER MODEL 702: N/APOTENTIAL DIFFERENCE TO REFERENCE CELL:PROTECTED SIDE: -549UNPROTECTED SIDE: -447**ABOVE TESTING**

BOLT TO FLANGE RESISTANCE:

NUMBER OF BOLTS:

FLANGE TO FLANGE RESISTANCE:

COMMENTS / LOCATION DRAWING Sexton KurbTESTED BY P. SMYTH

Brisbane Water Engineering Services

CP Form No. 21

Electrical Engineering Unit

Insulated Joint Testing Details FormProject S 54Date 29-4-03Isolation 8**DESCRIPTION**

MAINS DETAILS:

LOCATIONS:

SIZE:

MATERIAL:

COATING:

VALVE No.

Tarragindi to Wynnum
4 Merrell st
42-36"
Mild Steel
9" Br

IN GROUND TESTING

BOLT TO FLANGE RESISTANCE:

NUMBER OF BOLT:

FLANGE TO FLANGE RESISTANCE:

INSULATION CHECKER MODEL 702:

all Bolts >200Ω0.68mΩN/APOTENTIAL DIFFERENCE TO REFERENCE CELL:

PROTECTED SIDE:

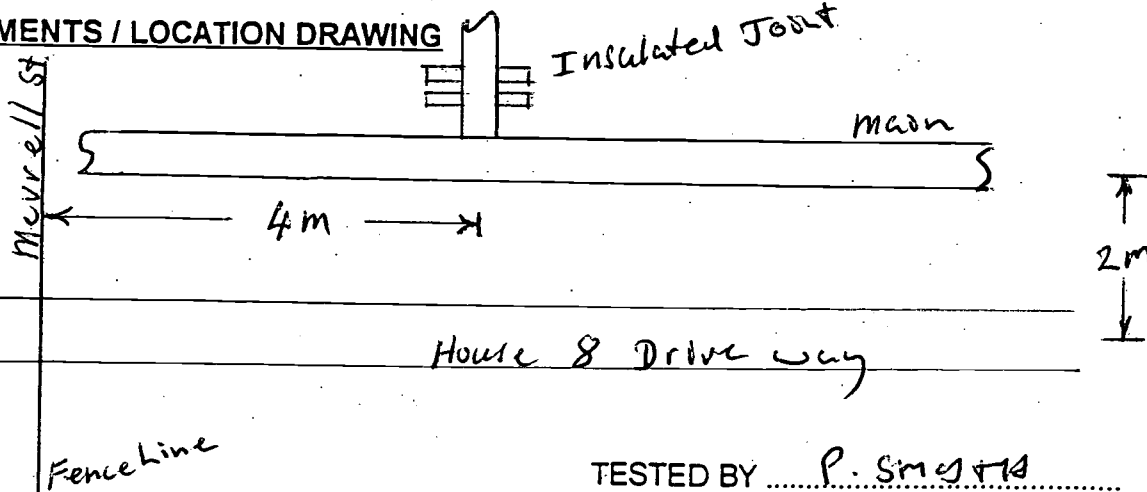
UNPROTECTED SIDE:

-455-359**ABOVE TESTING**

BOLT TO FLANGE RESISTANCE:

NUMBER OF BOLTS:

FLANGE TO FLANGE RESISTANCE:

COMMENTS / LOCATION DRAWINGTESTED BY P. Smith

Brisbane Water Engineering Services

CP Form No. 21

Electrical Engineering Unit**Insulated Joint Testing Details Form***Isolation 9*Project *Tarragindi - Wynnum*Date *28-10-03***DESCRIPTION****MAINS DETAILS:**

LOCATIONS:

SIZE:

MATERIAL:

COATING:

VALVE No.

*42 Swain St.**42" - 36"**Mild Steel**6" Branch.***IN GROUND TESTING**

BOLT TO FLANGE RESISTANCE:

NUMBER OF BOLT:

FLANGE TO FLANGE RESISTANCE:

INSULATION CHECKER MODEL 702:

all Bolts 7 zero Ω *12**~ 8 m Ω* *N/A.***POTENTIAL DIFFERENCE TO REFERENCE CELL**

PROTECTED SIDE:

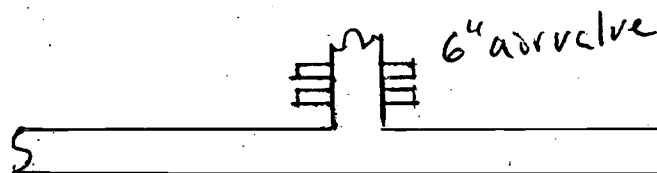
UNPROTECTED SIDE:

*-440 mV**-390 mV***ABOVE TESTING**

BOLT TO FLANGE RESISTANCE:

NUMBER OF BOLTS:

FLANGE TO FLANGE RESISTANCE:

COMMENTS / LOCATION DRAWING*House 42.*TESTED BY *P. Smyth*

Brisbane Water Engineering Services

CP Form No. 21

Electrical Engineering Unit

Insulated Joint Testing Details FormProject S 54Date 14-4-03
Isolation 10**DESCRIPTION**

MAINS DETAILS:

LOCATIONS:

SIZE:

MATERIAL:

COATING:

VALVE No.

Tarragindi to Wynnum
Abbotsleigh & Cavendish Rd
42-36
Mild Steel
12" Branch

IN GROUND TESTINGBOLT TO FLANGE RESISTANCE: all Bolts > 200Ω

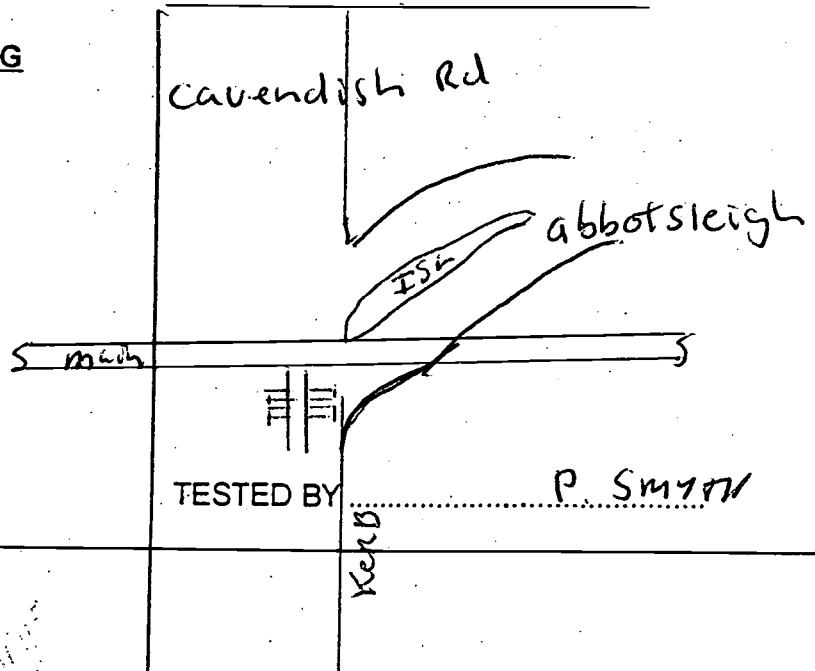
NUMBER OF BOLT: _____

FLANGE TO FLANGE RESISTANCE: 0.2 mΩINSULATION CHECKER MODEL 702: N/A**POTENTIAL DIFFERENCE TO REFERENCE CELL:**PROTECTED SIDE: -414UNPROTECTED SIDE: -356**ABOVE TESTING**

BOLT TO FLANGE RESISTANCE: _____

NUMBER OF BOLTS: _____

FLANGE TO FLANGE RESISTANCE: _____

COMMENTS / LOCATION DRAWING

Brisbane Water Engineering Services

CP Form No. 21

Electrical Engineering Unit**Insulated Joint Testing Details Form***Isolation 10a*Project *Tarragindi - Wynnum*Date *28-10-03***DESCRIPTION**

MAINS DETAILS:

LOCATIONS:

SIZE:

MATERIAL:

COATING:

VALVE No.

Arlington St.
42" - 36"
Mild Steel.
T/E
12" Br

IN GROUND TESTINGBOLT TO FLANGE RESISTANCE: *All Bolts > 200 Ω*

NUMBER OF BOLT:

FLANGE TO FLANGE RESISTANCE: *3.8 K Ω* INSULATION CHECKER MODEL 702: *N/A***POTENTIAL DIFFERENCE TO REFERENCE CELL**

PROTECTED SIDE:

UNPROTECTED SIDE:

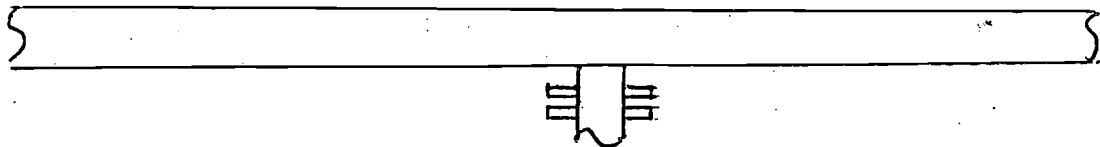
-465 mV
-415 mV

ABOVE TESTING

BOLT TO FLANGE RESISTANCE:

NUMBER OF BOLTS:

FLANGE TO FLANGE RESISTANCE:

COMMENTS / LOCATION DRAWING*House 29*TESTED BY *P. Smyth*

Brisbane Water Engineering Services

CP Form No. 21

Electrical Engineering Unit

Insulated Joint Testing Details Form

Isolation No. 11

Project Tarragindi to WynnumDate 28-10-03**DESCRIPTION**

MAINS DETAILS:

LOCATIONS:

SIZE:

MATERIAL:

COATING:

VALVE No.

Eva St42" to 36"Mild Steel9" Branch**IN GROUND TESTING**

BOLT TO FLANGE RESISTANCE:

all Bolts > 200Ω

NUMBER OF BOLT:

12

FLANGE TO FLANGE RESISTANCE:

200 Ω

INSULATION CHECKER MODEL 702:

N/A**POTENTIAL DIFFERENCE TO REFERENCE CELL**

PROTECTED SIDE:

-4460 mV

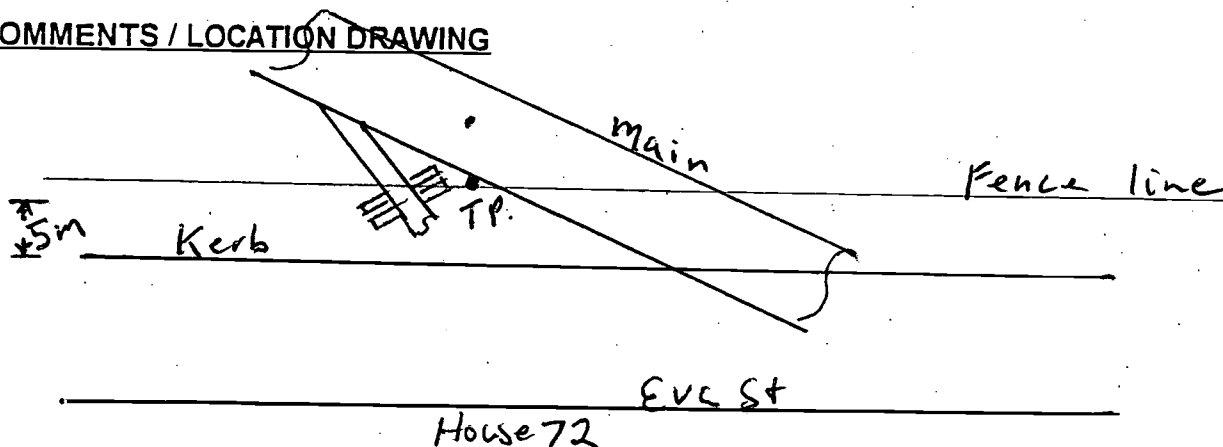
UNPROTECTED SIDE:

-310 mV**ABOVE TESTING**

BOLT TO FLANGE RESISTANCE:

NUMBER OF BOLTS:

FLANGE TO FLANGE RESISTANCE:

COMMENTS / LOCATION DRAWING

TESTED BY

Brisbane Water Engineering Services

CP Form No. 21

Electrical Engineering Unit

Insulated Joint Testing Details Form

ISOLATION 12.

Project S54 Tarragindi Wynnum Date 16-3-04**DESCRIPTION**

MAINS DETAILS:

LOCATIONS:

SIZE:

MATERIAL:

COATING:

VALVE No.

Cnr ILLIDGE + Chatsworth.42" - 36"Mild SteelT/A.351**IN GROUND TESTING**

BOLT TO FLANGE RESISTANCE:

all Bolts > 200Ω

NUMBER OF BOLT:

FLANGE TO FLANGE RESISTANCE:

45 Ω

INSULATION CHECKER MODEL 702:

N/A.**POTENTIAL DIFFERENCE TO REFERENCE CELL**

PROTECTED SIDE:

- 480 mV

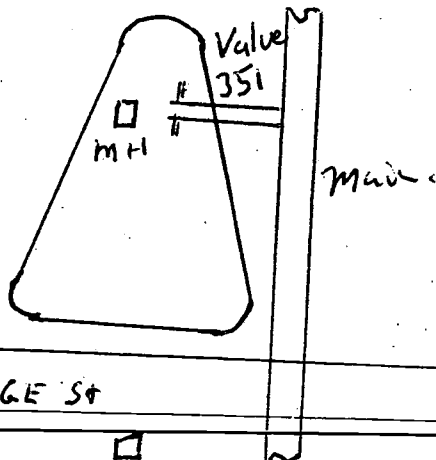
UNPROTECTED SIDE:

- 430 mV**ABOVE TESTING**

BOLT TO FLANGE RESISTANCE:

NUMBER OF BOLTS:

FLANGE TO FLANGE RESISTANCE:

COMMENTS / LOCATION DRAWINGTESTED BY P. Smyth

Brisbane Water Engineering Services

CP Form No. 21

Electrical Engineering Unit

Insulated Joint Testing Details Form

Isolation 13

Project Set 54 Tarragindi - Wynnum Date 14-3-04DESCRIPTION

MAINS DETAILS:

LOCATIONS:

SIZE:

MATERIAL:

COATING:

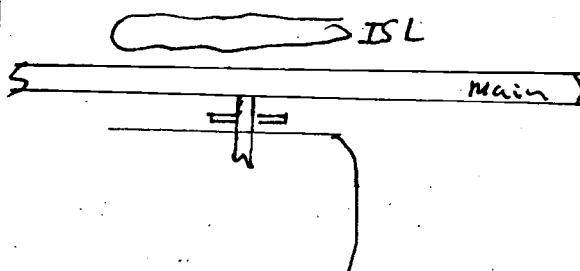
VALVE No.

Chatsworth & Boundary42"-36"Mild SteelT/E12" BrIN GROUND TESTINGBOLT TO FLANGE RESISTANCE: all Bolts > 200 Ω NUMBER OF BOLT: 12FLANGE TO FLANGE RESISTANCE: 0.8 K Ω INSULATION CHECKER MODEL 702: N/APOTENTIAL DIFFERENCE TO REFERENCE CELLPROTECTED SIDE: -560UNPROTECTED SIDE: -480ABOVE TESTING

BOLT TO FLANGE RESISTANCE: _____

NUMBER OF BOLTS: _____

FLANGE TO FLANGE RESISTANCE: _____

COMMENTS / LOCATION DRAWINGChatsworthTESTED BY P. Smyth

Brisbane Water Engineering Services

CP Form No. 21

Electrical Engineering Unit**Insulated Joint Testing Details Form**Project Tarragindi To WynnumDate 14-10-03ISOLATION N° 14**DESCRIPTION**

MAINS DETAILS:

S54

LOCATIONS:

Prout + Thomas.

SIZE:

42" to 36"

MATERIAL:

Mild Steel.

COATING:

VALVE No.

IN GROUND TESTING

BOLT TO FLANGE RESISTANCE:

all Bolts > 200Ω

NUMBER OF BOLT:

12

FLANGE TO FLANGE RESISTANCE:

2.5 mΩ

INSULATION CHECKER MODEL 702:

N/A.POTENTIAL DIFFERENCE TO REFERENCE CELL.

PROTECTED SIDE:

-580

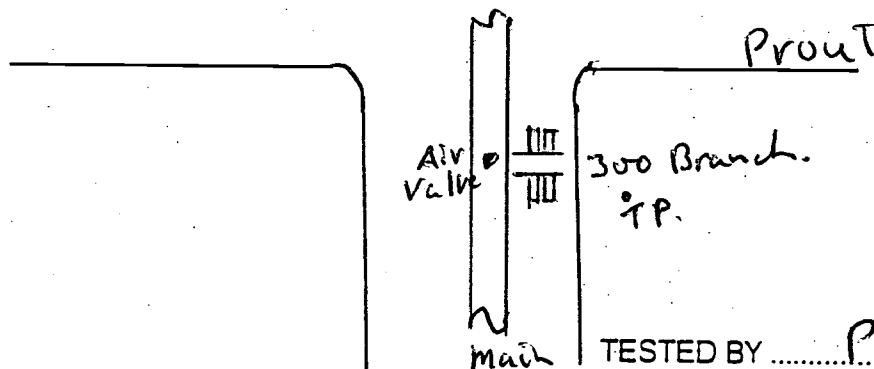
UNPROTECTED SIDE:

-318**ABOVE TESTING**

BOLT TO FLANGE RESISTANCE:

NUMBER OF BOLTS:

FLANGE TO FLANGE RESISTANCE:

COMMENTS / LOCATION DRAWINGThomas.

Brisbane Water Engineering Services

CP Form No. 21

Electrical Engineering Unit**Insulated Joint Testing Details Form**Project S 54Date 28-10-03Isolation No 15**DESCRIPTION**

MAINS DETAILS:

LOCATIONS:

SIZE:

MATERIAL:

COATING:

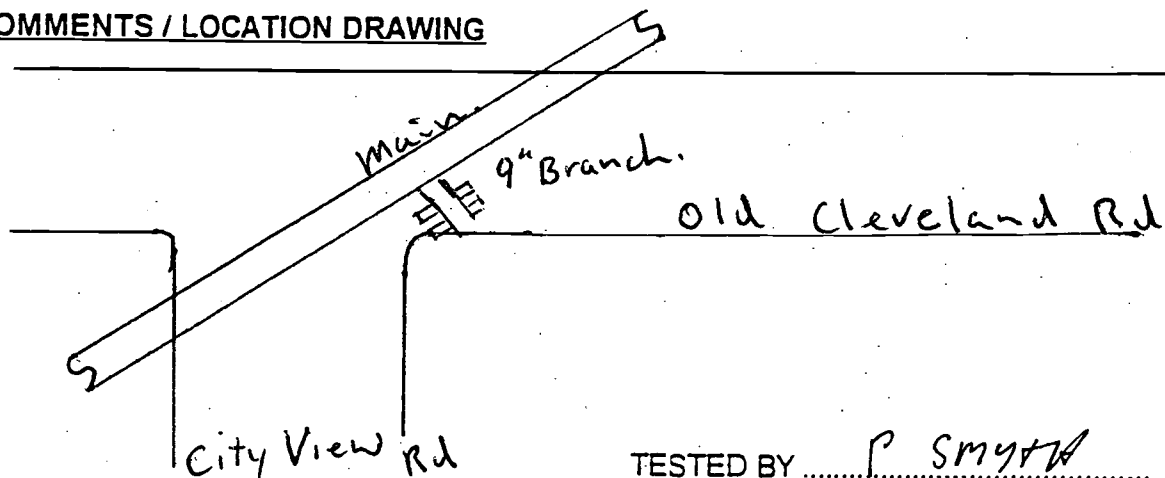
VALVE No.

Old Cleveland Rd42-36"Mild SteelT/A.**IN GROUND TESTING**BOLT TO FLANGE RESISTANCE: all Bolts > 200 Ω NUMBER OF BOLT: 12FLANGE TO FLANGE RESISTANCE: 1 M Ω INSULATION CHECKER MODEL 702: N/A**POTENTIAL DIFFERENCE TO REFERENCE CELL**PROTECTED SIDE: - 550 mvUNPROTECTED SIDE: - 388 mv**ABOVE TESTING**

BOLT TO FLANGE RESISTANCE: _____

NUMBER OF BOLTS: _____

FLANGE TO FLANGE RESISTANCE: _____

COMMENTS / LOCATION DRAWINGTESTED BY P Smyth

Brisbane Water Engineering Services

CP Form No. 21

Electrical Engineering Unit**Insulated Joint Testing Details Form**Project S54 Tarragindi - WynnumDate 29-4-03Isolation 16**DESCRIPTION**

MAINS DETAILS:

LOCATIONS:

SIZE:

MATERIAL:

COATING:

VALVE No.

Old Cleveland Rd42"-36"Mild Steel**IN GROUND TESTING**

BOLT TO FLANGE RESISTANCE:

all Bolts > 200 Ω

NUMBER OF BOLT:

12

FLANGE TO FLANGE RESISTANCE:

4.5 K Ω

INSULATION CHECKER MODEL 702:

POTENTIAL DIFFERENCE TO REFERENCE CELL

PROTECTED SIDE:

-593 mV

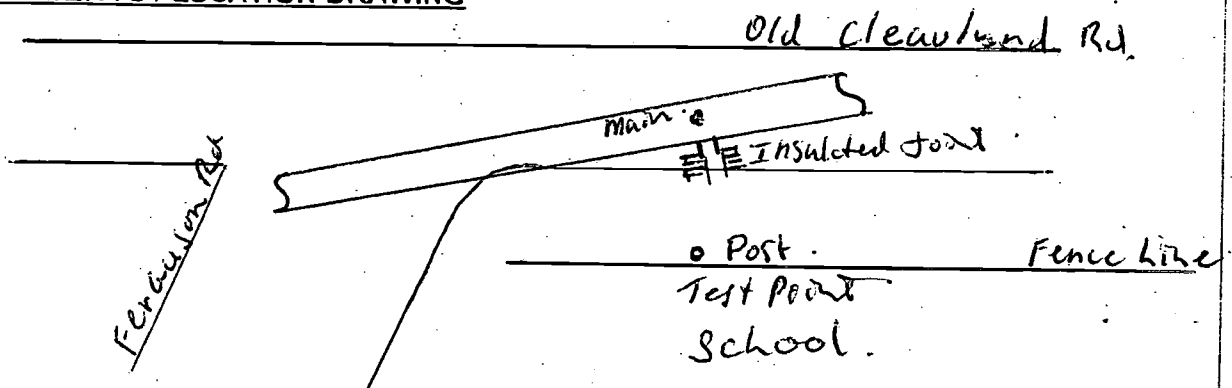
UNPROTECTED SIDE:

-533 mV**ABOVE TESTING**

BOLT TO FLANGE RESISTANCE:

NUMBER OF BOLTS:

FLANGE TO FLANGE RESISTANCE:

COMMENTS / LOCATION DRAWINGTESTED BY P. Smyth

Brisbane Water Engineering Services

CP Form No. 21

Electrical Engineering Unit

Insulated Joint Testing Details FormProject S 54Date 29-4-03
Isolation 17**DESCRIPTION**

MAINS DETAILS:

LOCATIONS:

SIZE:

MATERIAL:

COATING:

VALVE No.

Tarragindi Wynnum
Cnr The Promenade + Stanley
42" - 36"
Mild Steel
9" Branch

IN GROUND TESTING

BOLT TO FLANGE RESISTANCE:

NUMBER OF BOLT:

FLANGE TO FLANGE RESISTANCE:

INSULATION CHECKER MODEL 702:

POTENTIAL DIFFERENCE TO REFERENCE CELL:

PROTECTED SIDE:

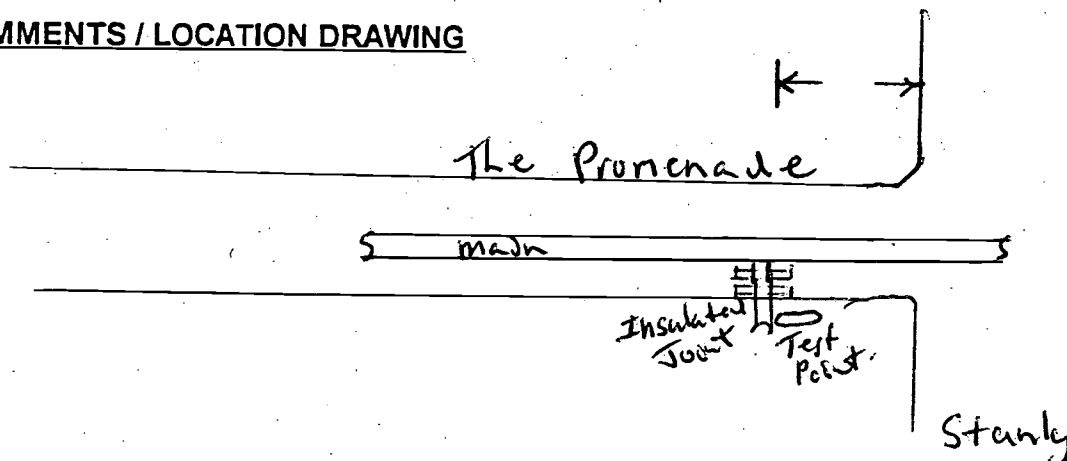
UNPROTECTED SIDE:

all Bolts > 200 Ω 2 K Ω N/A-493-345**ABOVE TESTING**

BOLT TO FLANGE RESISTANCE:

NUMBER OF BOLTS:

FLANGE TO FLANGE RESISTANCE:

COMMENTS / LOCATION DRAWINGTESTED BY P. Smyth

Brisbane Water Engineering Services

CP Form No. 21

Electrical Engineering Unit

Insulated Joint Testing Details Form

Isolation No. 18

Project S54Date 15-4-03**DESCRIPTION**

MAINS DETAILS:

LOCATIONS:

SIZE:

MATERIAL:

COATING:

VALVE No.

Tarragindi - Wynnum Rd
511 Darcy Rd
42" - 36"
Mild Steel
9" Branch

IN GROUND TESTING

BOLT TO FLANGE RESISTANCE:

NUMBER OF BOLT:

FLANGE TO FLANGE RESISTANCE:

INSULATION CHECKER MODEL 702:

all Bolts > 200 Ω 0.25 m Ω N/A**POTENTIAL DIFFERENCE TO REFERENCE CELL:**

PROTECTED SIDE:

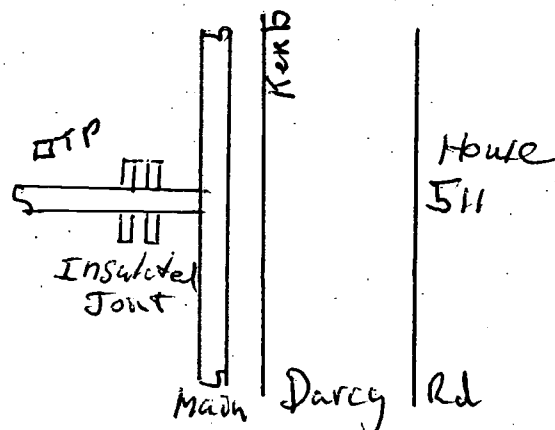
UNPROTECTED SIDE:

- 516- 465**ABOVE TESTING**

BOLT TO FLANGE RESISTANCE:

NUMBER OF BOLTS:

FLANGE TO FLANGE RESISTANCE:

8m**COMMENTS / LOCATION DRAWING**TESTED BY P. Smyth

Brisbane Water Engineering Services

CP Form No. 21

Electrical Engineering Unit

Insulated Joint Testing Details Form

Isolation 19

Project S54 Tarragindi - WynnumDate 28-10-03**DESCRIPTION**

MAINS DETAILS:

LOCATIONS:

534 Darcy Rd

SIZE:

42" - 36"

MATERIAL:

Mild Steel

COATING:

VALVE No.

9" Branch**IN GROUND TESTING**

BOLT TO FLANGE RESISTANCE:

7 all Bolts. 7200 Ω

NUMBER OF BOLT:

12

FLANGE TO FLANGE RESISTANCE:

0.875 m Ω

INSULATION CHECKER MODEL 702:

N/A**POTENTIAL DIFFERENCE TO REFERENCE CELL:**

PROTECTED SIDE:

-410 mV

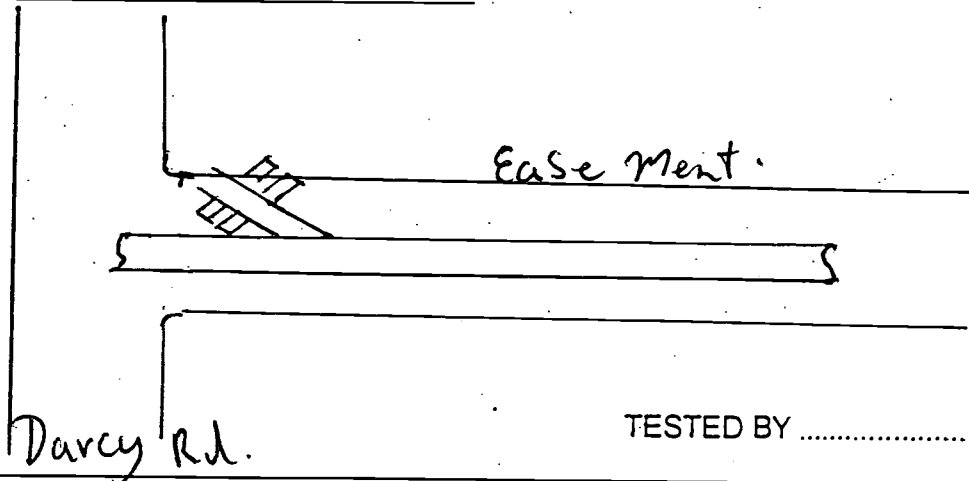
UNPROTECTED SIDE:

-300 mV**ABOVE TESTING**

BOLT TO FLANGE RESISTANCE:

NUMBER OF BOLTS:

FLANGE TO FLANGE RESISTANCE:

COMMENTS / LOCATION DRAWING

TESTED BY

Brisbane Water Engineering Services

CP Form No. 21

Electrical Engineering Unit**Insulated Joint Testing Details Form**Project Tarragindi - Wynnum Rd.Date 11-11-03**DESCRIPTION**

isolation 20

MAINS DETAILS:

S54

LOCATIONS:

Richmond + Muir Rd.

SIZE:

MATERIAL:

M S C L

COATING:

Tar Asbestos

VALVE No.

IN GROUND TESTINGBOLT TO FLANGE RESISTANCE: > 0.4 m Ω

NUMBER OF BOLT:

8FLANGE TO FLANGE RESISTANCE: 17 Ω INSULATION CHECKER MODEL 702: 1N11POTENTIAL DIFFERENCE TO REFERENCE CELL:

PROTECTED SIDE:

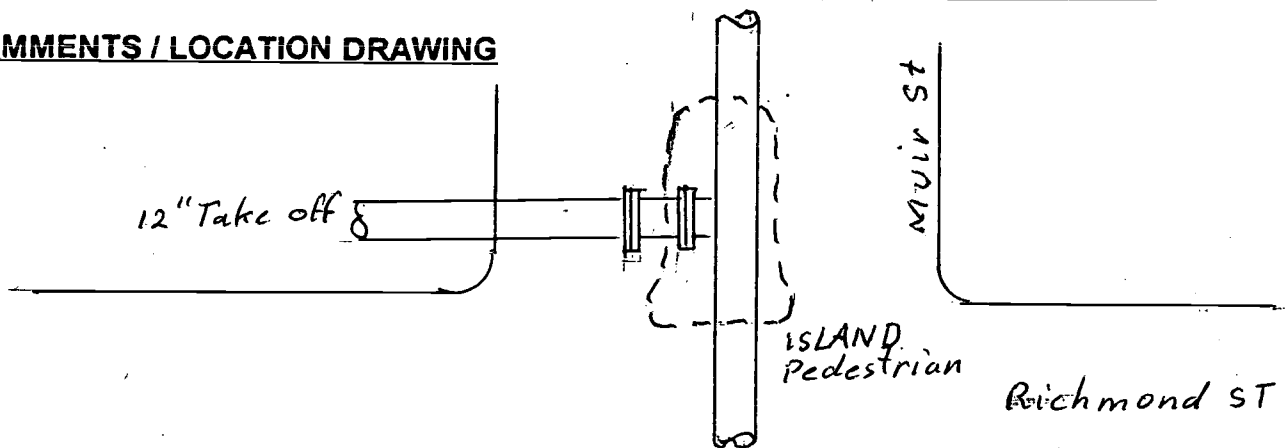
UNPROTECTED SIDE:

ABOVE TESTING

BOLT TO FLANGE RESISTANCE:

NUMBER OF BOLTS:

FLANGE TO FLANGE RESISTANCE:

COMMENTS / LOCATION DRAWINGTESTED BY J Taylor

Brisbane Water Engineering Services

CP Form No. 21

Electrical Engineering Unit

Insulated Joint Testing Details Form

Isolation 21

Project Tarragindi - WynnumDate 30-10-03**DESCRIPTION**

MAINS DETAILS:

LOCATIONS:

SIZE:

MATERIAL:

COATING:

VALVE No.

Cnr Muir & Wynnum42" - 36"Mild SteelT/E12" Dr**IN GROUND TESTING**

BOLT TO FLANGE RESISTANCE:

all Bolts > 200 Ω

NUMBER OF BOLT:

12

FLANGE TO FLANGE RESISTANCE:

69 K Ω

INSULATION CHECKER MODEL 702:

N/APOTENTIAL DIFFERENCE TO REFERENCE CELL:

PROTECTED SIDE:

- 460 mV

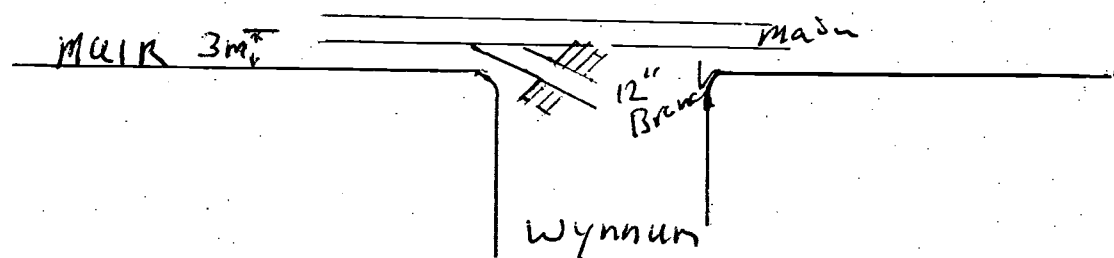
UNPROTECTED SIDE:

- 380 mV**ABOVE TESTING**

BOLT TO FLANGE RESISTANCE:

NUMBER OF BOLTS:

FLANGE TO FLANGE RESISTANCE:

COMMENTS / LOCATION DRAWINGTESTED BY P. SMYTH

Brisbane Water Engineering Services

CP Form No. 21

Electrical Engineering Unit

Insulated Joint Testing Details Form

Isolation No 22

Project S54 Tarragindi To Wynnum

Date 11-11-03

DESCRIPTION

MAINS DETAILS:

LOCATIONS:

SIZE:

MATERIAL:

COATING:

VALVE No.

Chr Muir & Wynnum Rd

42" to 36"

Mild steel

T/E

12" Branch

IN-GROUND TESTING

BOLT TO FLANGE RESISTANCE:

all Bolts $> 200 \Omega$

NUMBER OF BOLT:

12

FLANGE TO FLANGE RESISTANCE:

0.2 $\mu \Omega$

INSULATION CHECKER MODEL 702:

N/A

POTENTIAL DIFFERENCE TO REFERENCE CELL:

PROTECTED SIDE:

- 485 mV

UNPROTECTED SIDE:

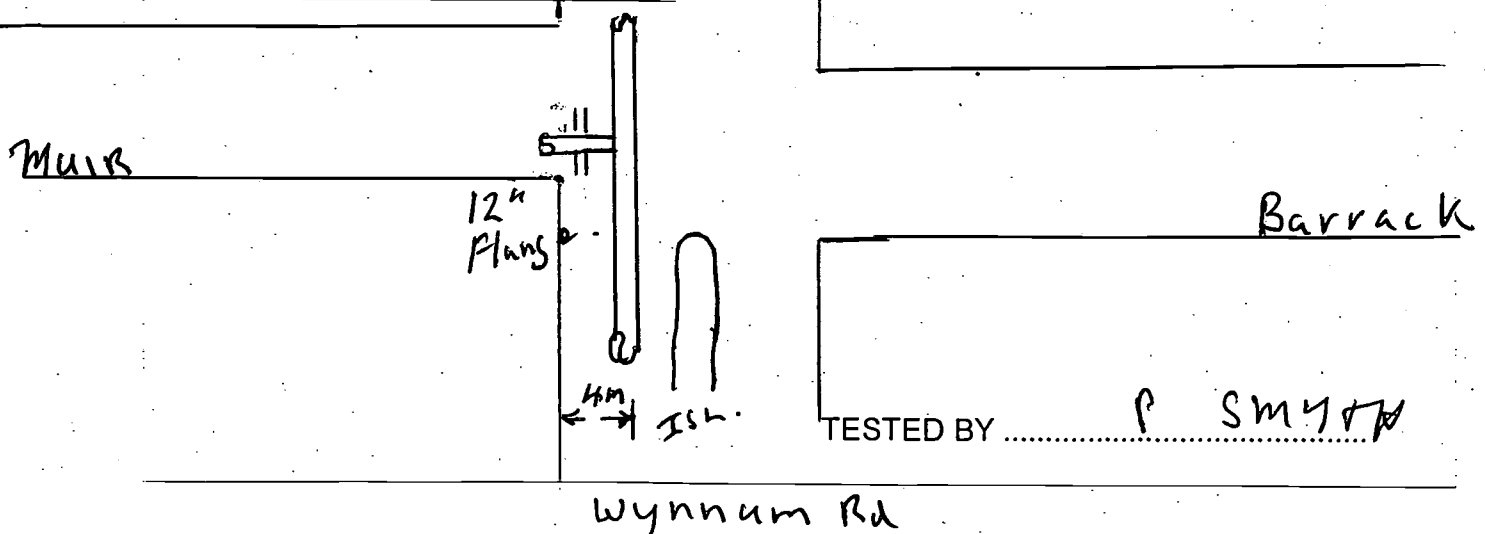
- 310 mV

ABOVE TESTING

BOLT TO FLANGE RESISTANCE:

NUMBER OF BOLTS:

FLANGE TO FLANGE RESISTANCE:

COMMENTS / LOCATION DRAWING

Brisbane Water Engineering Services

CP Form No. 21

Electrical Engineering Unit

Insulated Joint Testing Details Form

ISOLATION N° 24

Project Sect 53 Main To NorthcliffeDate 13-3-06DESCRIPTION

MAINS DETAILS:

LOCATIONS:

SIZE:

MATERIAL:

COATING:

VALVE No.

Cnr Barrack & Wynnum Rdmild steelTA203IN GROUND TESTINGBOLT TO FLANGE RESISTANCE: all Bolts 7200 Ω

NUMBER OF BOLT:

FLANGE TO FLANGE RESISTANCE: 200 Ω INSULATION CHECKER MODEL 702: N/APOTENTIAL DIFFERENCE TO REFERENCE CELL

PROTECTED SIDE:

UNPROTECTED SIDE:

-526-680ABOVE TESTING

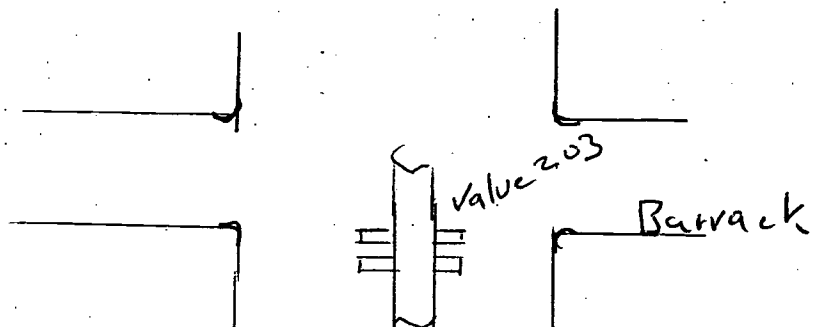
BOLT TO FLANGE RESISTANCE:

NUMBER OF BOLTS:

FLANGE TO FLANGE RESISTANCE:

COMMENTS / LOCATION DRAWING

Wynnum Rd

TESTED BY P. Smyth

Brisbane Water Engineering Services

CP Form No. 21

Electrical Engineering Unit

Insulated Joint Testing Details Form

Isolation no 8

Project Set 35 Wynnum -
Valve 816Date 20-2-04**DESCRIPTION**

MAINS DETAILS:

LOCATIONS:

SIZE:

MATERIAL:

COATING:

VALVE No.

Lytton Rd Metroplexmild steelTA816**IN GROUND TESTING**BOLT TO FLANGE RESISTANCE: all Bolts 7200 Ω

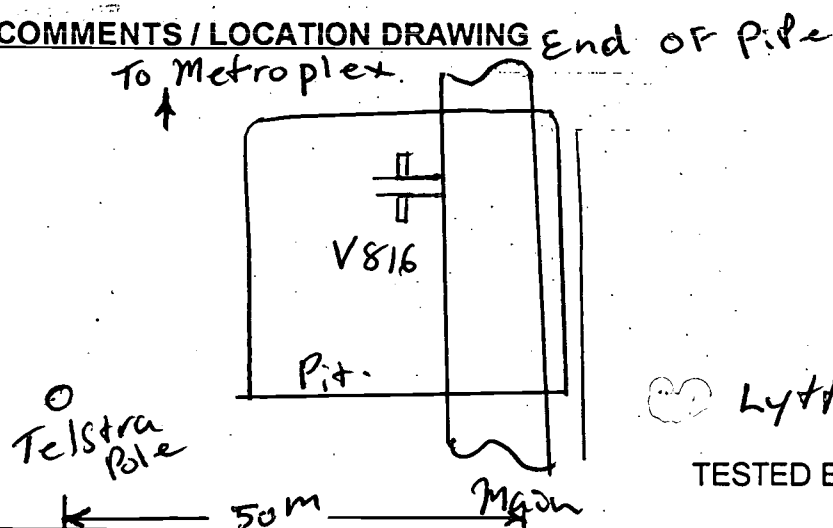
NUMBER OF BOLT: _____

FLANGE TO FLANGE RESISTANCE: 70 Ω INSULATION CHECKER MODEL 702: N/A.POTENTIAL DIFFERENCE TO REFERENCE CELL:PROTECTED SIDE: - 540UNPROTECTED SIDE: - 395**ABOVE TESTING**

BOLT TO FLANGE RESISTANCE: _____

NUMBER OF BOLTS: _____

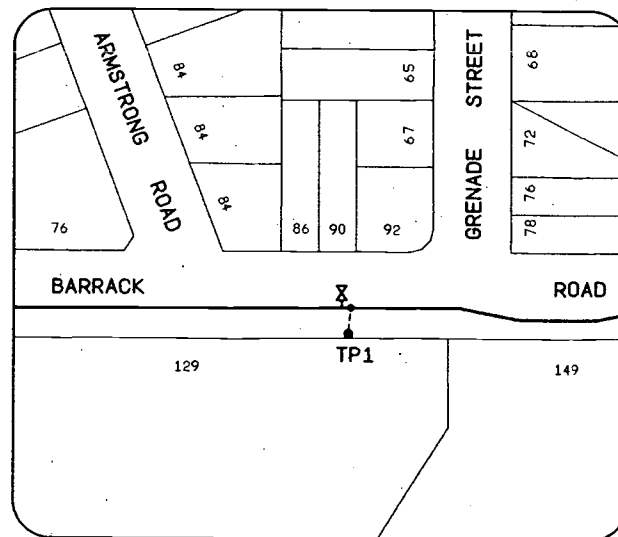
FLANGE TO FLANGE RESISTANCE: _____

COMMENTS / LOCATION DRAWINGLytton Rd.TESTED BY P. Smyth

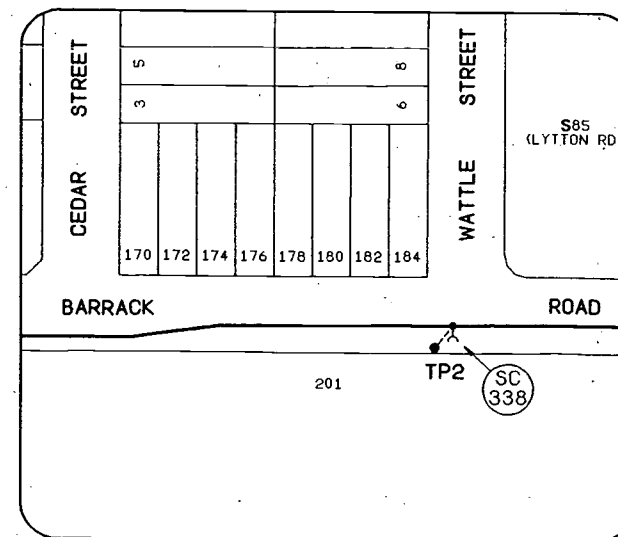
THIS SYSTEM CONTINUES
INTO S54 REFER DRAWING
NO. 2/10.677-01

THIS SYSTEM CONTINUES
INTO S53 REFER DRAWING
NO. 2/10.804-01

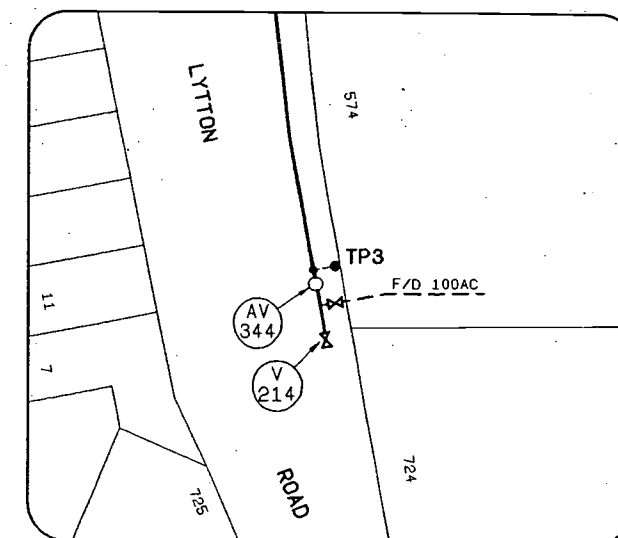
LOCALITY PLAN



TEST POINT NO.1



TEST POINT NO.2



TEST POINT NO.3

DESIGN CHARGE NO.		PA000820
CONSTRUCTION PROJECT NO.		
AS BUILT RECEIVED		
BY	OFFICER CODE	
DATE		
ON MAINTENANCE DETAILS		
START	FINISH	
D.R.S. COMMENTS		
FUNDING		
PRIVATE BOOSTER REQUIRED? YES / NO		
FUNDED BY BCC (✓) DEVELOPER ()		
RED GOVT () STATE () OTHER ()		
D.R.S. OFFICER		
DATE RELEASED		
PLAN CUSTODIAN		
OFFICER/REC'D		
DATE RELEASED		
LIVE CONNECTION(S) / PASSED(W)		
REFERENCE		
DATE		
BIMAP CAPTURE		
JOB NUMBER		
OFFICER CODE		
DATE		
BIMAP COMMENTS		

NO.	DATE	AMENDMENT	INITIALS

PRINCIPAL ENGINEER	RPEQ. NO.	DATE
MANAGER ENGINEERING		
PRODUCTION / NETWORK DELEGATE		

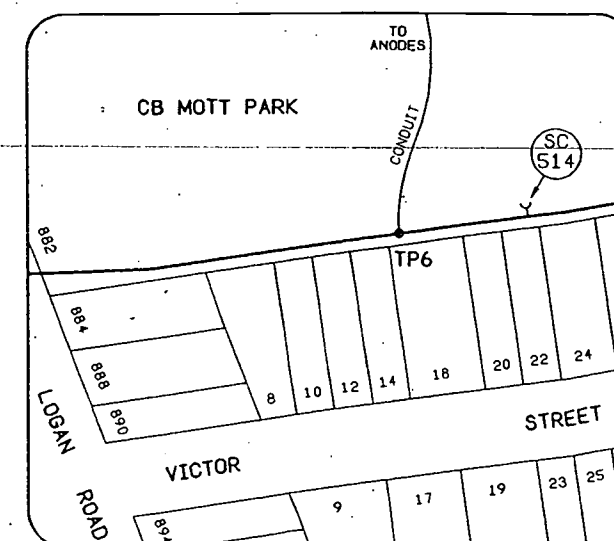
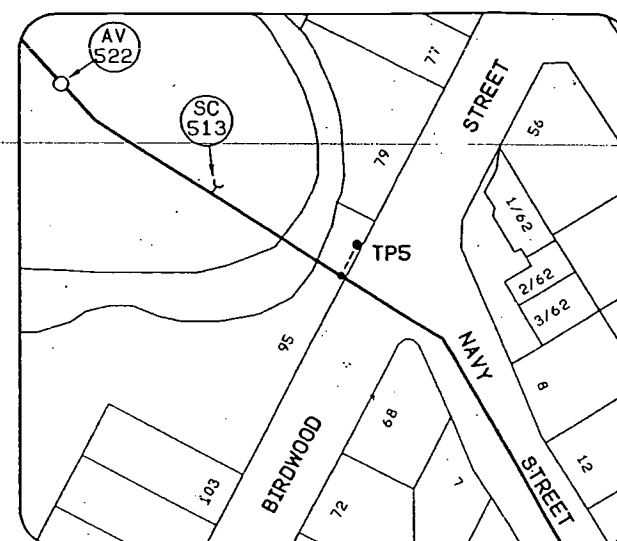
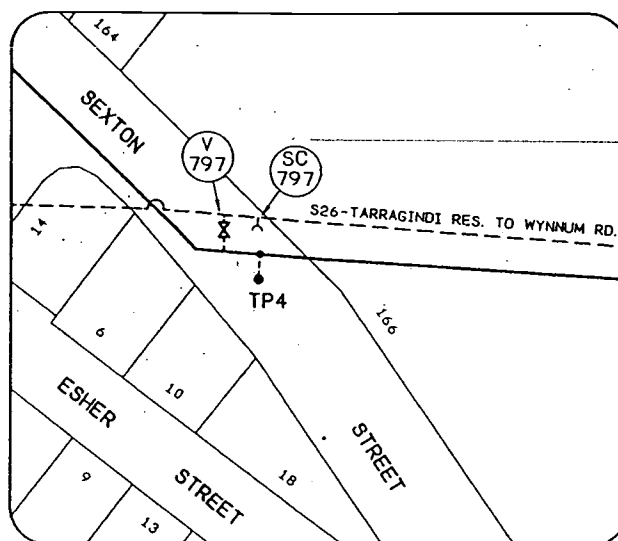
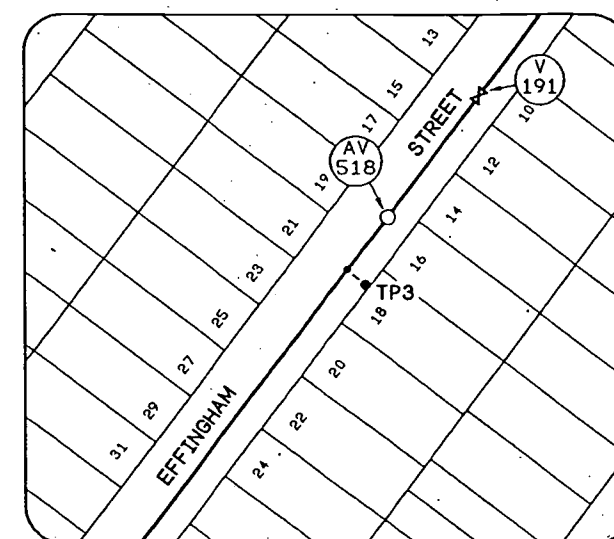
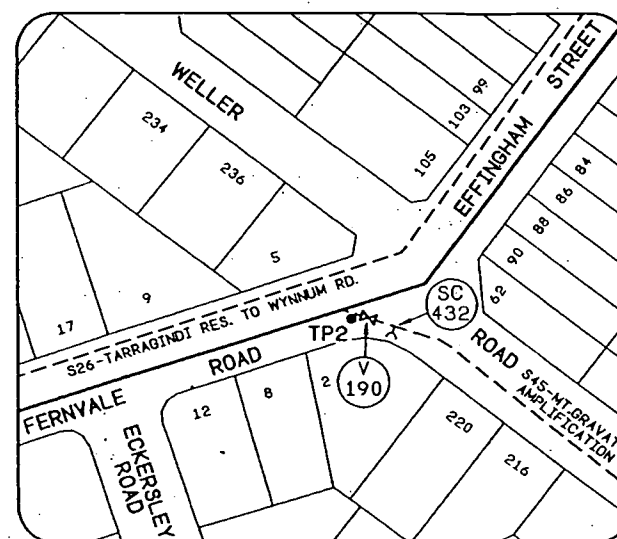
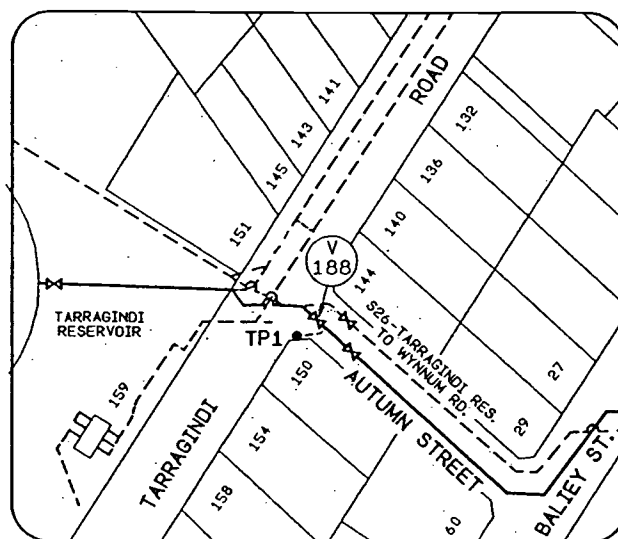
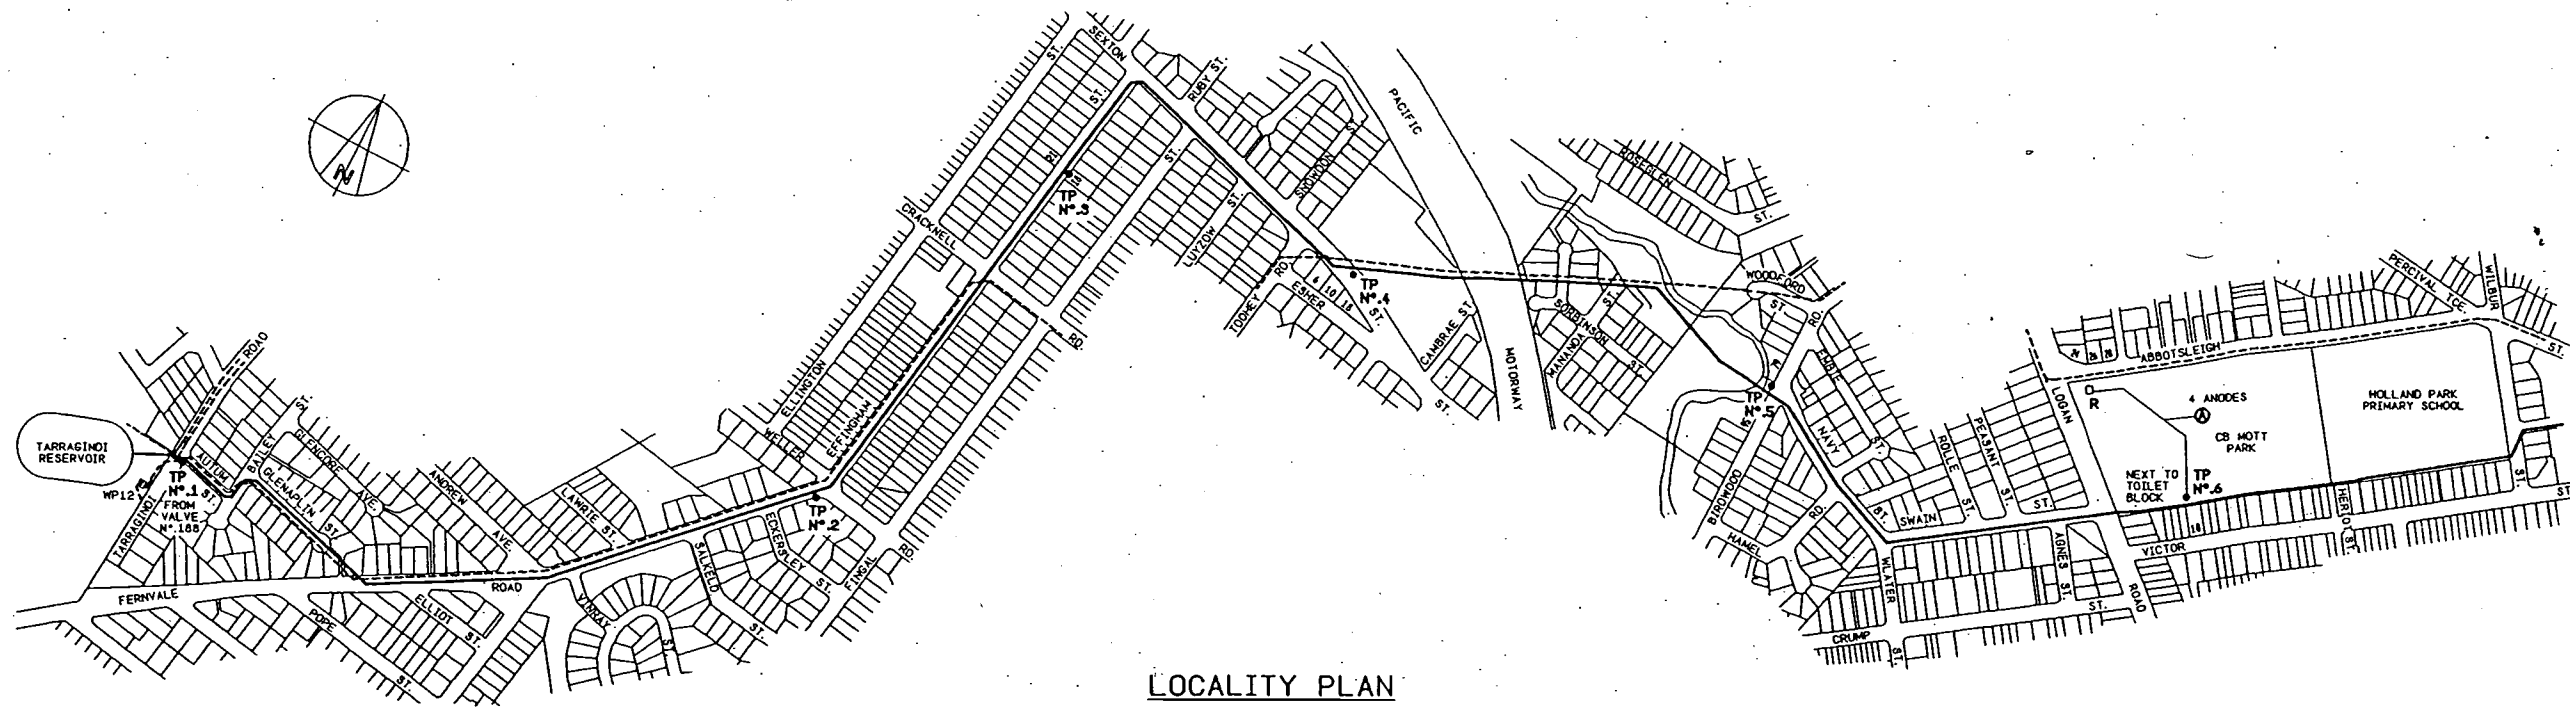
CADD FILE	FILE NO.	DATE
WATER\INFRASTRUCTURE\210231501.DTA		
SURVEYED		
SURVEY NO.		

DESIGN	DESIGN CHECK	DRAWN	DRAFTING CHECK



PROJECT	TITLE
S35-WYNNUM RD. CANNON HILL TO Q.M.I. ABATTOIR	CATHODIC PROTECTION TEST POINT AND ANODE BED LOCATIONS

SCALE	A.H. DATUM
DRAWING NO.	NO. 1 OF 1 SHEETS
2/10.2315-01	P1



DESIGN CHARGE NO.		PA000820	
CONSTRUCTION PROJECT NO.			
AS BUILT RECEIVED			
BY	OFFICER CODE		
DATE			
ON MAINTENANCE DETAILS			
START	FINISH		
DRS COMMENTS			
FUNDING			
PRIVATE BOOSTER REQUIRED?	YES / NO		
FUNDED BY BCC (✓)	DEVELOPER ()		
FED. GOVT ()	STATE ()	OTHER ()	
DRS OFFICER			
DATE RELEASED			
PLAN CUSTODIAN			
OFFICER/REC'D	DATE RELEASED		
LIVE CONNECTION(S) / PASSED(W)			
REFERENCE	DATE		
BIMAP CAPTURE			
JOB NUMBER	OFFICER CODE		
DATE			
BIMAP COMMENTS			
SCALE		A.H. DATUM	
AS SHOWN		N° 1 OF 5 SHEETS	
DRAWING N°		AMEND.	
2/10.677-01		P1	

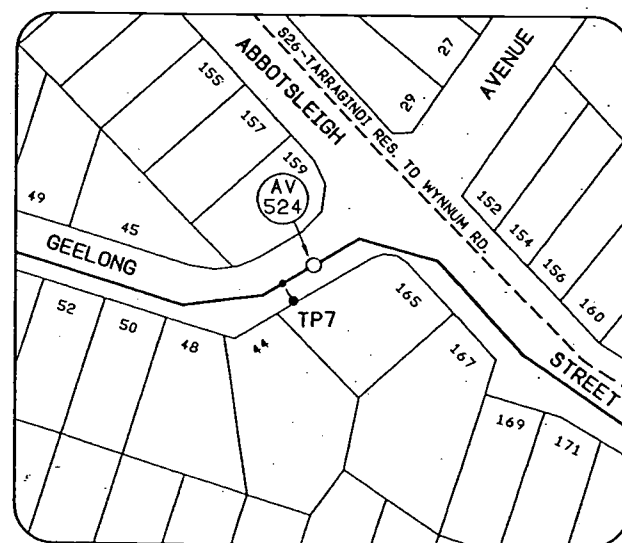
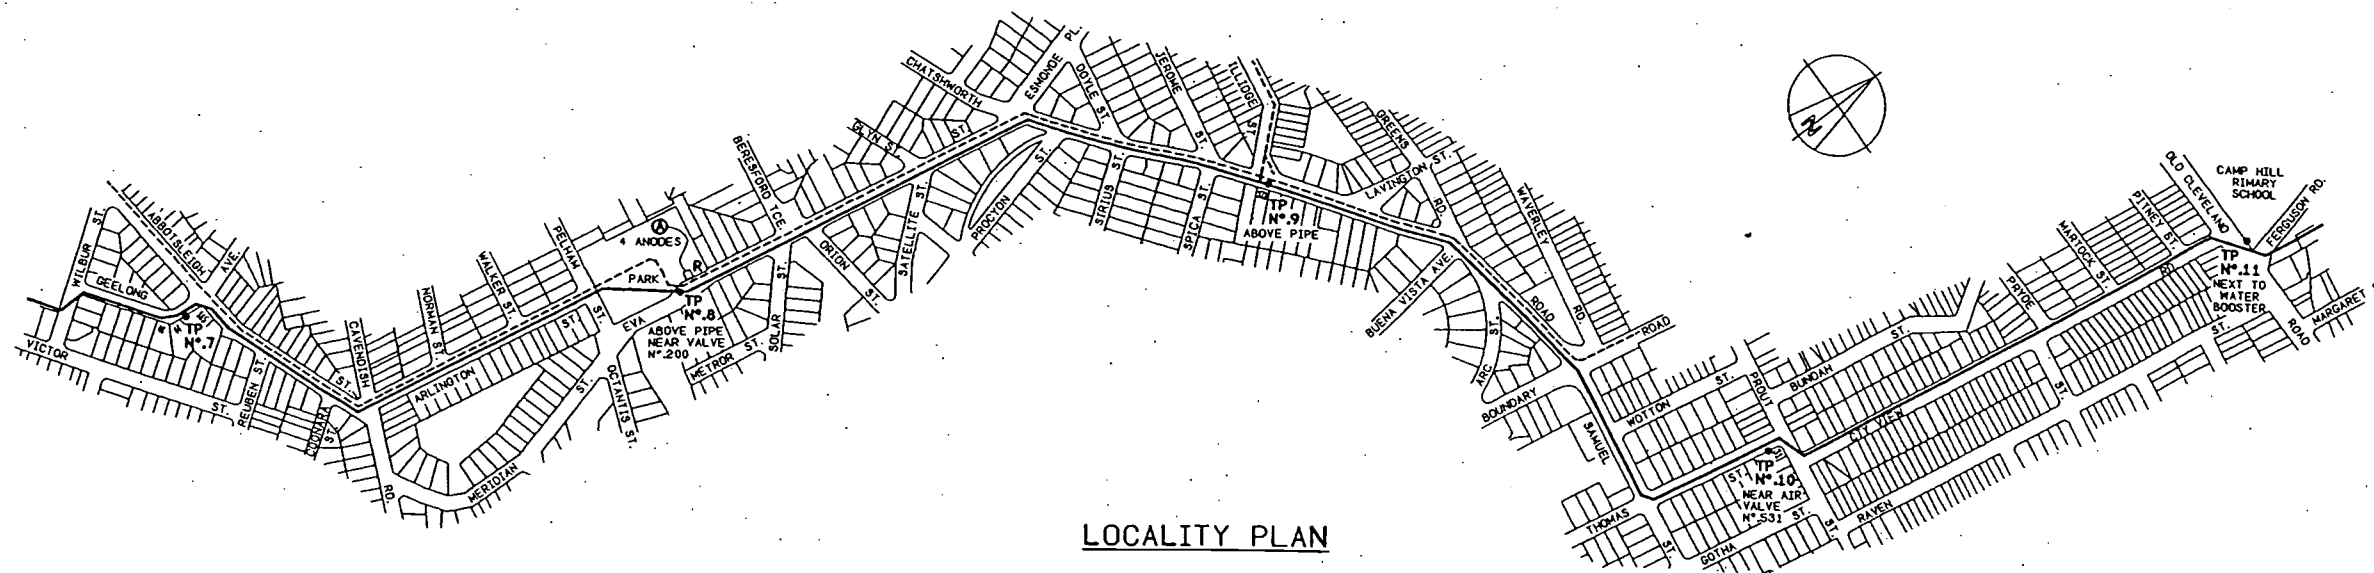
NO DATE	AMENDMENT	INITIALS	PRINCIPAL ENGINEER	RPEQ NO.	DATE	CADD FILE	WATER/INFRASTRUCTURE\21067701.DTA	DESIGN		
			MANAGER ENGINEERING		DATE	FILE NO.		DESIGN CHECK		
			PRODUCTION / NETWORK DELEGATE		DATE	SURVEYED		DRAWN	8.0.8	OCT. 2004
						SURVEY NO.		DRAFTING CHECK		



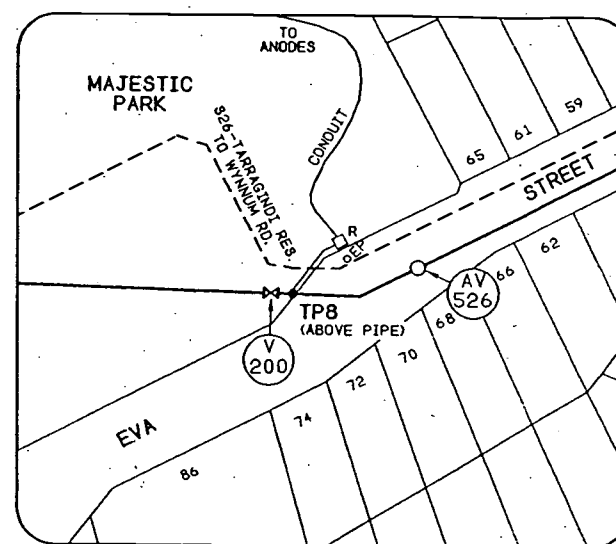
PROJECT
S54-TARRAGINDI TO WYNNUM RD.

TITLE
CATHODIC PROTECTION TEST
POINT LOCATIONS
TEST POINT NOS. 1 TO 5

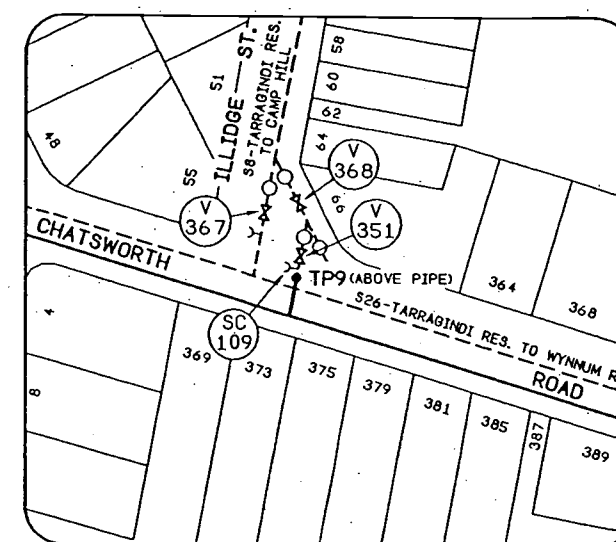
SCALE
AS SHOWN



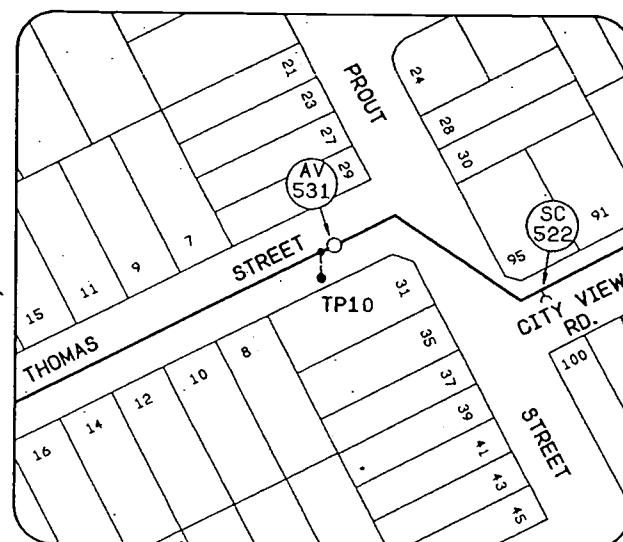
TEST POINT NO.7



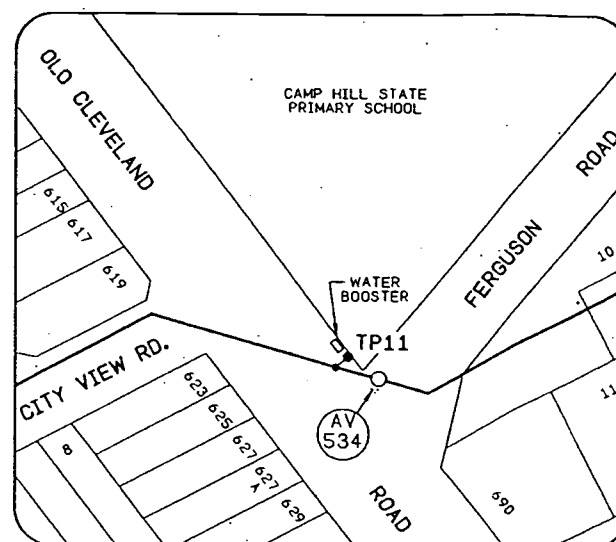
TEST POINT NO.8



TEST POINT NO.9



TEST POINT NO.10



TEST POINT NO.11

DESIGN CHARGE NO.	
PA000820	
CONSTRUCTION PROJECT NO.	
AS BUILT RECEIVED	
BY	OFFICER CODE
DATE	
ON MAINTENANCE DETAILS	
START	FINISH
DRS. COMMENTS	
FUNDING	
PRIVATE BOOSTER REQUIRED?	YES / NO
FUNDED BY BCC (✓)	DEVELOPER ()
RED. GOVT ()	STATE () OTHER ()
DRS OFFICER	
DATE RELEASED	
PLAN CUSTODIAN	
OFFICER/REC'D	
DATE RELEASED	
LIVE CONNECTION(S) / PASSED(W)	
REFERENCE	
DATE	
BIMAP CAPTURE	
JOB NUMBER	
OFFICER CODE	
DATE	
BIMAP COMMENTS	

NO	DATE	AMENDMENT	INITIALS

PRINCIPAL ENGINEER	RPEQ. NO.	DATE
MANAGER ENGINEERING	FILE NO.	DATE
PRODUCTION / NETWORK DELEGATE	SURVEYED	DATE

CADD FILE	WATER/INFRASTRUCTURE/V21067702.DTA
FILE NO.	
SURVEYED	
SURVEY NO.	FIELD BOOK

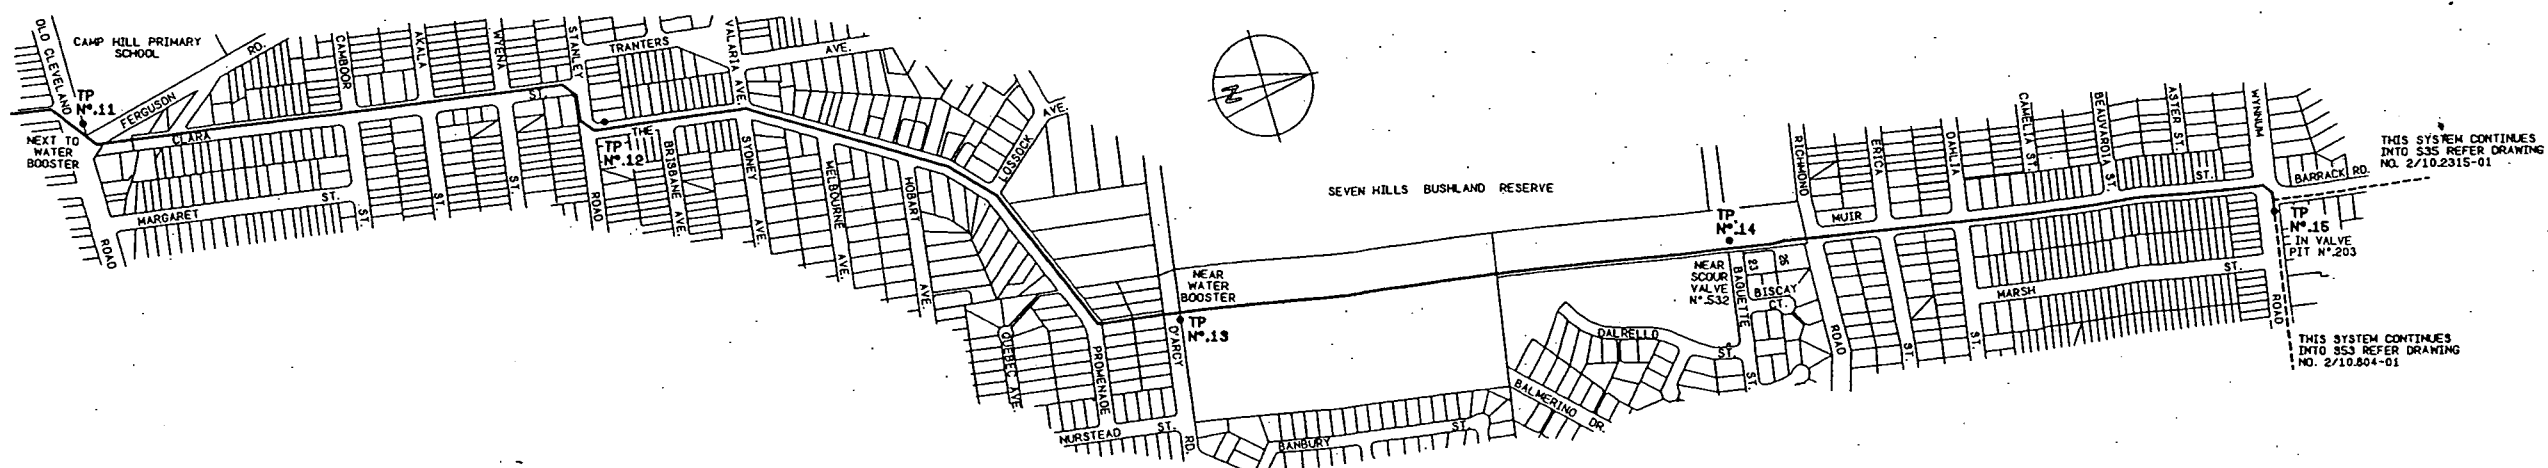
DESIGN	
DESIGN CHECK	
DRAWN	B.O.B.
DRAFTING CHECK	OCT. 2004



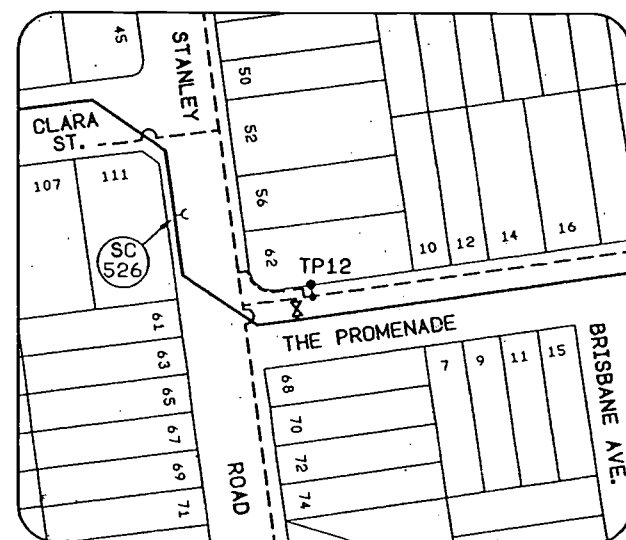
PROJECT	S54-TARRAGINDI TO WYNNUM RD.
---------	------------------------------

TITLE	CATHODIC PROTECTION TEST POINT LOCATIONS
	TEST POINT NOS. 7 TO 11

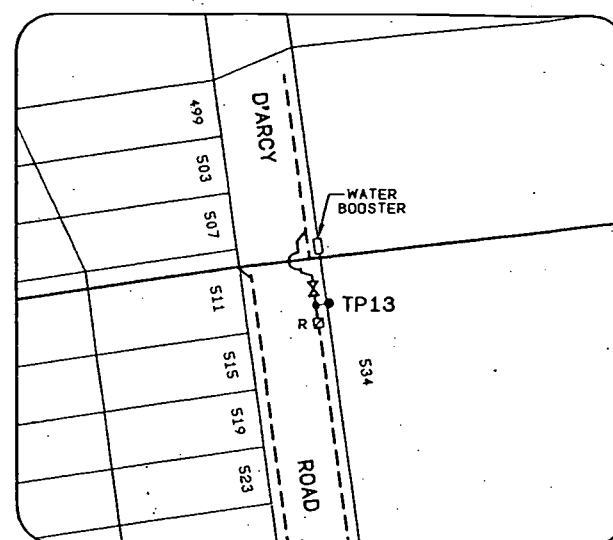
SCALE	AS SHOWN	A.H. DATUM	N° 2 OF 5 SHEETS
DRAWING N°	2/10.677-02	AMEND.	P



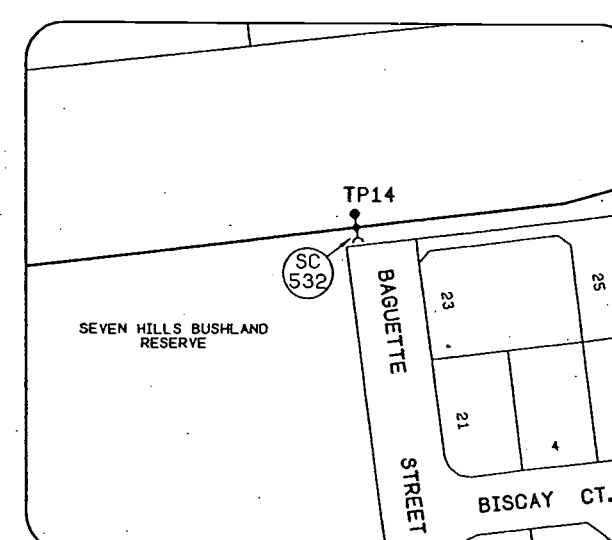
LOCALITY PLAN



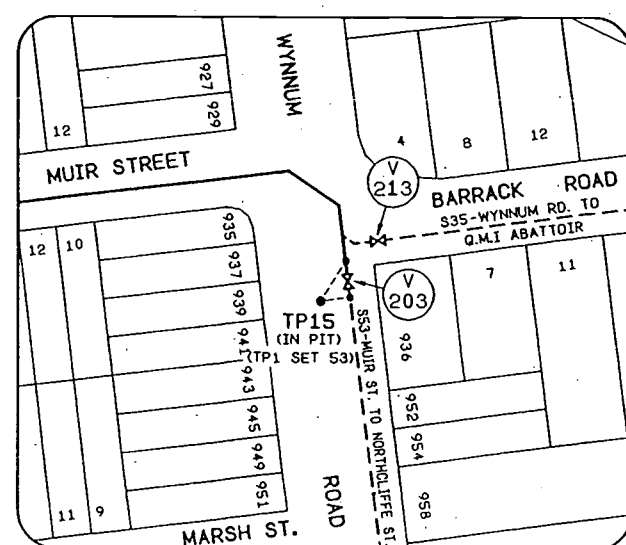
TEST POINT NO.12



TEST POINT NO.13



TEST POINT NO.14



TEST POINT NO.15

DESIGN CHARGE NO.	
PA000820	
CONSTRUCTION PROJECT NO.	
AS BUILT RECEIVED	
BY	
OFFICER CODE	
DATE	
ON MAINTENANCE DETAILS	
START	FINISH
DRS. COMMENTS	
FUNDING	
PRIVATE BOOSTER REQUIRED?	YES / NO
FUNDED BY BCC	(✓) DEVELOPER ()
FED. GOVT ()	STATE () OTHER ()
CPS OFFICER	
DATE RELEASED	
PLAN CUSTODIAN	
OFFICER/REC'D	
DATE RELEASED	
LIVE CONNECTION(S) / PASSED(W)	
REFERENCE	
DATE	
BIMAP CAPTURE	
JOB NUMBER	
OFFICER CODE	
DATE	
BIMAP COMMENTS	

NO	DATE	AMENDMENT	INITIALS	PRINCIPAL ENGINEER	RPEQ NO.	DATE	CADD FILE	FILE NO.	SURVEYED	SURVEY NO.	FIELD BOOK	DESIGN	DESIGN CHECK	DRAWN	DRAFTING CHECK	8.0.8	OCT. 2004



Brisbane Water

PROJECT
S54-TARRAGINDI TO WYNNUM RD.

TITLE
CATHODIC PROTECTION TEST
POINT LOCATIONS
TEST POINT NOS. 12 TO 15

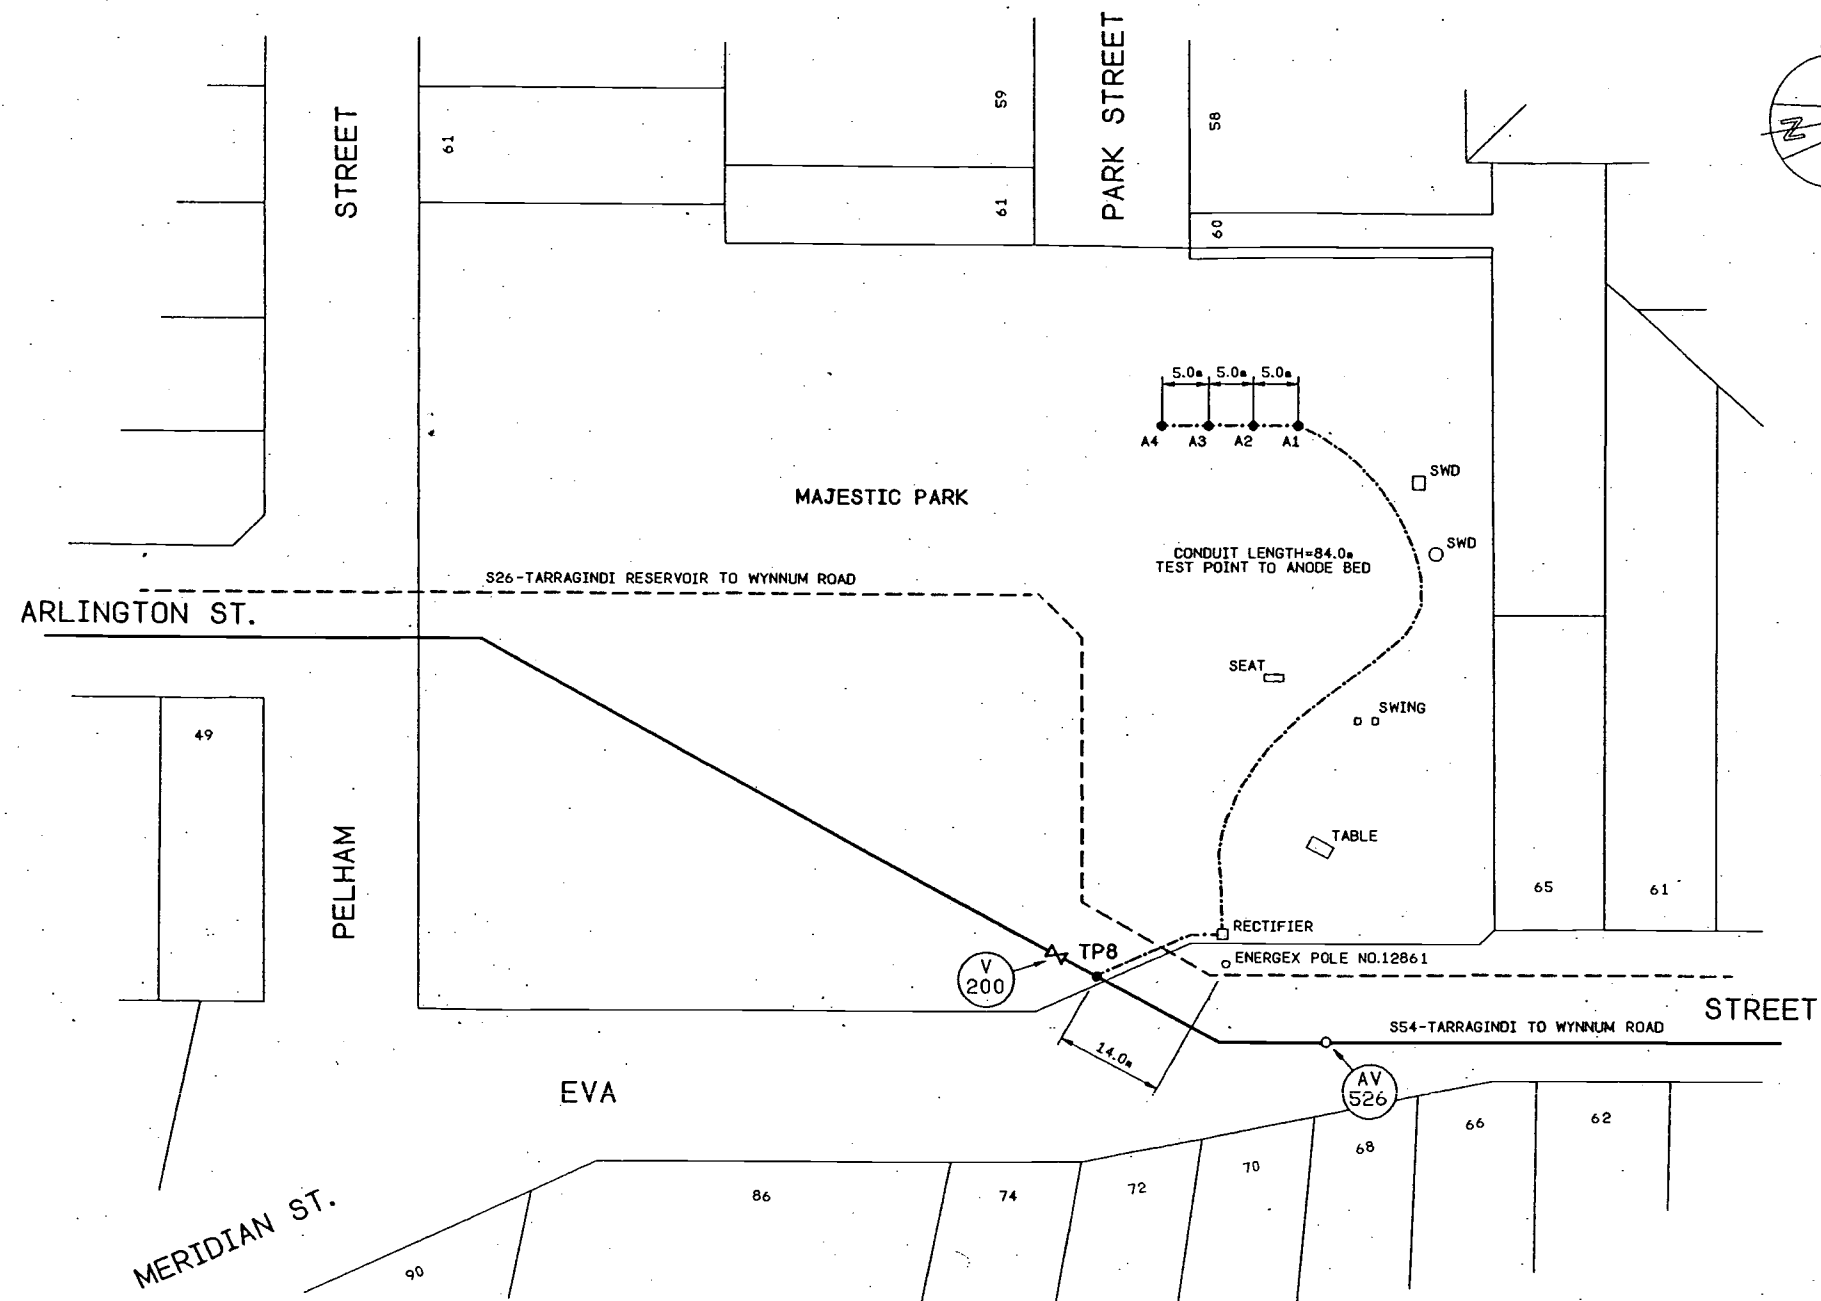
SCALE
AS SHOWN
DRAWING NO.
2/10.677-03

A.H. DATUM
NO. 3 OF 5 SHEETS
AMEND.
P



STREET

SCALE AS SHOWN	A.H. DATUM N° 4 OF 5 SHEET
DRAWING N° 2/10.677-04	AMEND P



TEST POINT NO.8 AND ANODE BED DETAILS

DESIGN CHARGE NO.	
PA000820	
CONSTRUCTION PROJECT NO.	
AS BUILT RECEIVED	
BY	
OFFICER CODE	
DATE	
ON MAINTENANCE DETAILS	
START	FINISH
DRS. COMMENTS	
FUNDING	
PRIVATE BOOSTER REQUIRED? YES / NO	
FUNDED BY BCC (✓)	DEVELOPER ()
FED. GOVT ()	STATE () OTHER ()
DRS OFFICER	
DATE RELEASED	
PLAN CUSTODIAN	
OFFICER/REC'D	
DATE RELEASED	
LIVE CONNECTION(S) / PASSED(W)	
REFERENCE	
DATE	
BMAP CAPTURE	
JOB NUMBER	
OFFICER CODE	
DATE	
BMAP COMMENTS	
SCALE AS SHOWN	
A.H. DATUM	
N° 5 OF 5 SHEETS	
DRAWING N°	
2/10.677-05	
AMEND	
P	

PRINCIPAL ENGINEER	RPEQ. NO.	DATE
MANAGER ENGINEERING		DATE
PRODUCTION / NETWORK DELEGATE		DATE

CADD FILE	WATER\INFRASTRUCTURE\21067705.DTA
FILE NO.	
SURVEYED	
SURVEY NO.	
FIELD BOOK	

DESIGN		
DESIGN CHECK		
DRAWN	8.0.8	OCT. 2004
DRAFTING CHECK		

**Brisbane Water**

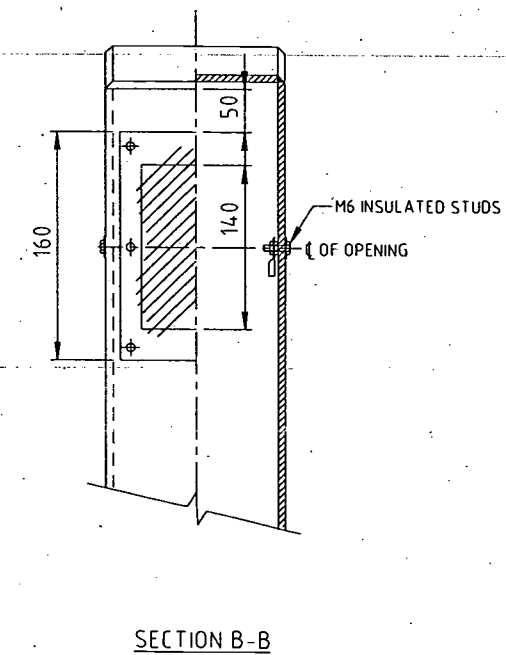
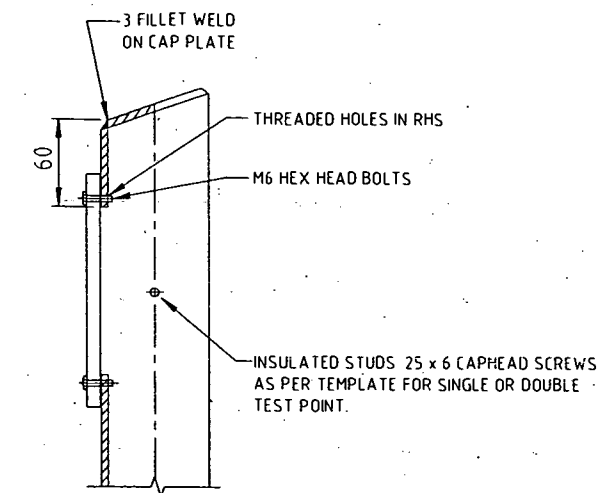
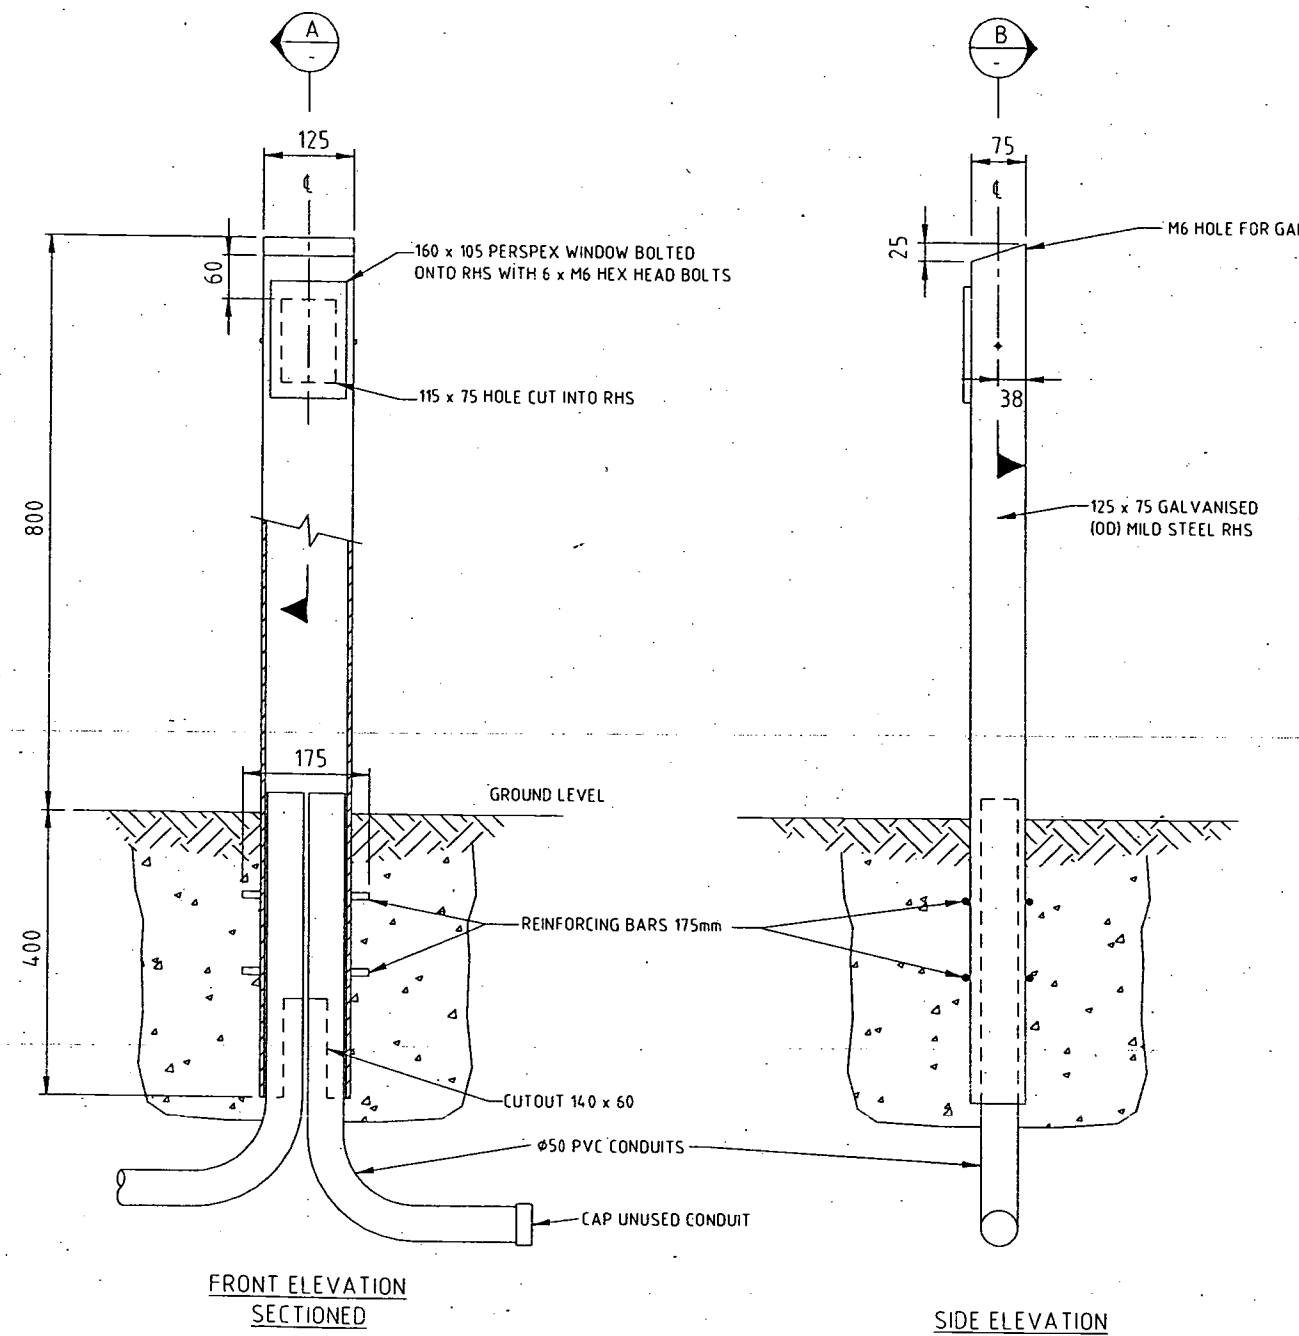
PROJECT	S54-TARRAGINDI TO WYNNUM RD.




TITLE	CATHODIC PROTECTION TEST NO. 8 AND ANODE BED DETAILS

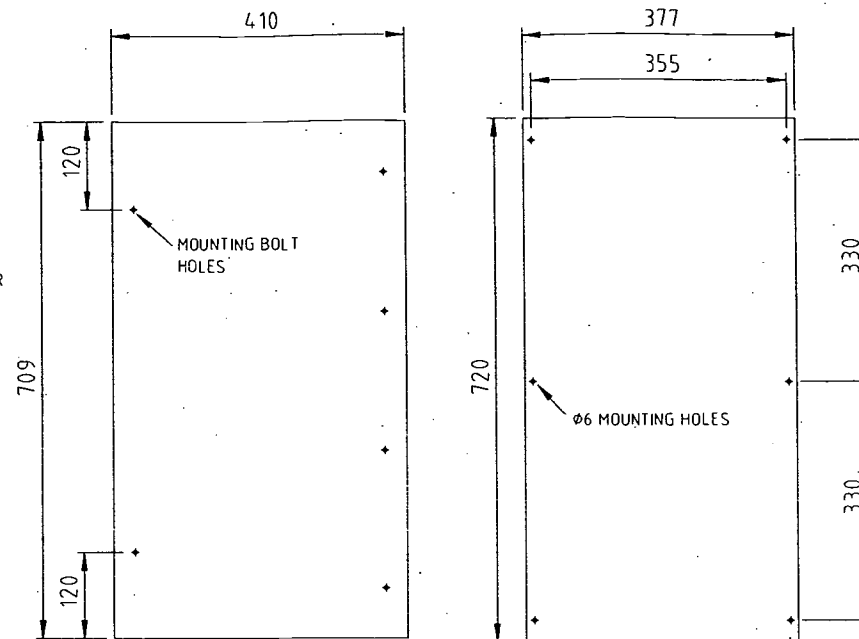
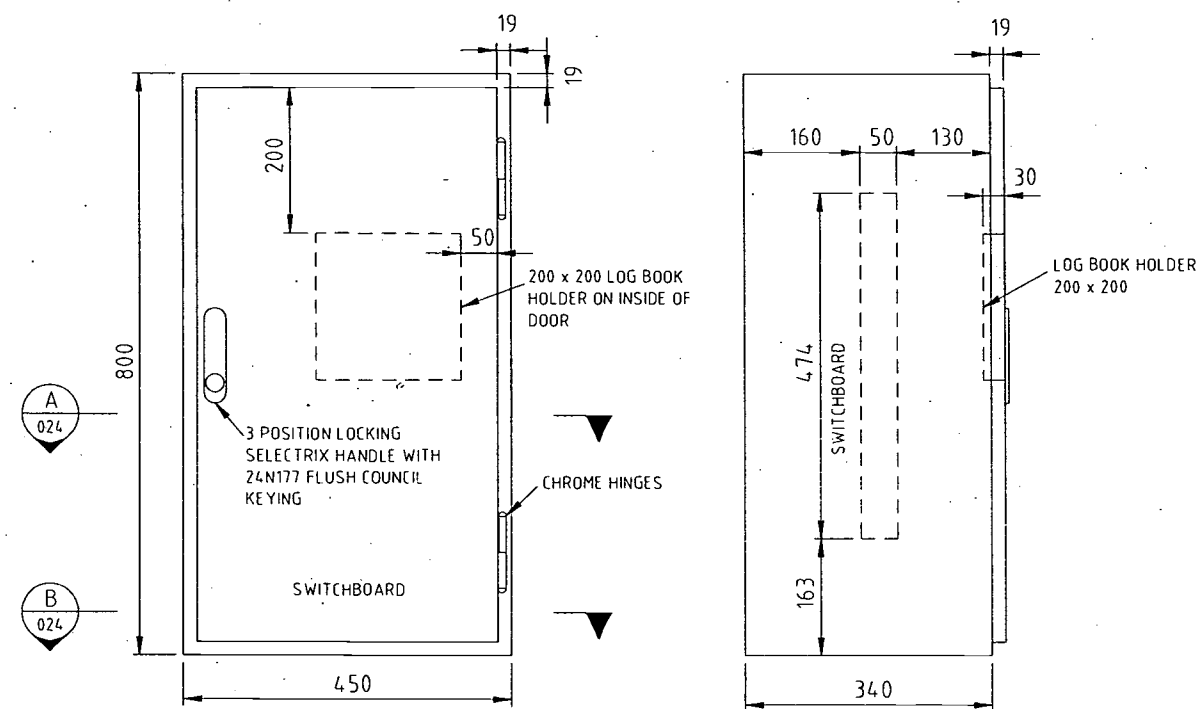
SCALE	AS SHOWN	A.H. DATUM	N° 5 OF 5 SHEETS
DRAWING N°	2/10.677-05	AMEND	P

NOTES

1. HOT DIP GALVANISE AFTER FABRICATION.

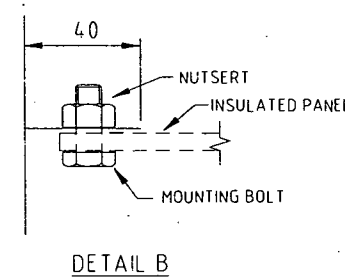
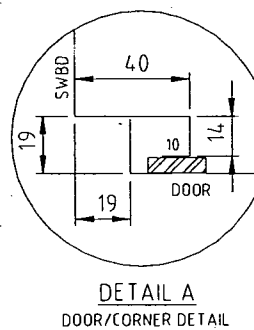
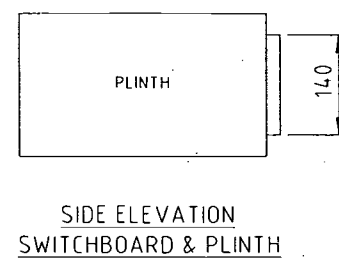
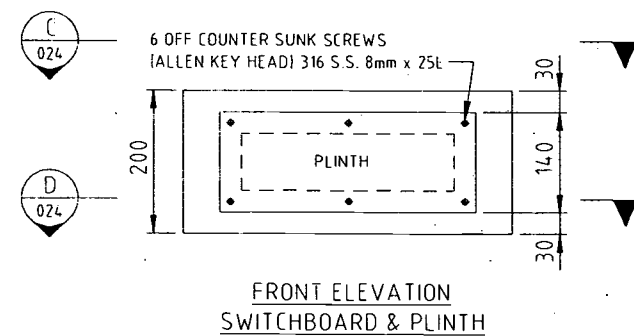


				DIRECTOR OF P.D. & P.S.		DATE			NAME		DATE		JOB FILE						PROJECT				TITLE	STANDARD TEST POINT CONSTRUCTION DETAILS		SCALE NTS		N° 1 OF 1 SHEETS		DRAWING N°	486/1/22-AAT0001E		AMEND.	C	
C		9-92	NOTE 1 REVISED	HI	ENGINEER IN CHARGE	DATE	DESIGN		K.M.G.		5-5-92		ACAD FILE		2210001-RevA				SHEET SIZE		A1			CATHODIC PROTECTION											
B		11-95	MODIFIED	DLP			DRAWN		DLP		7-5-92		SURVEY No.						FIELD BOOK																
A		5-92	ISSUED FOR APPROVAL	DLP	SUPERVISING ENGINEER	DATE	CHECKED						SURVEYED						A.H. DATUM																
NO.		DATE		AMENDMENT		INITIALS		R.P.E.O. NO.		DATE																									

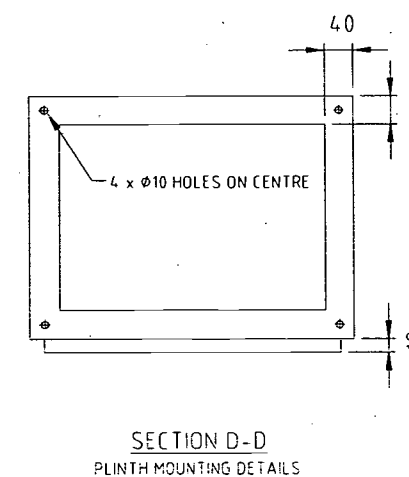
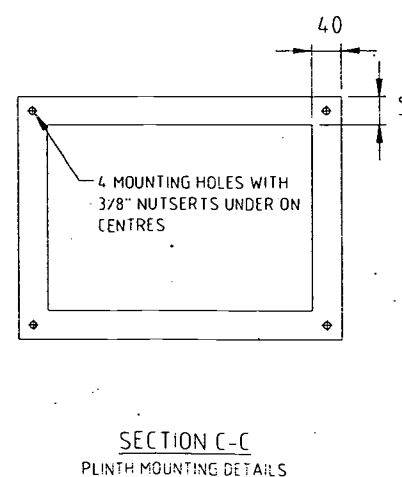
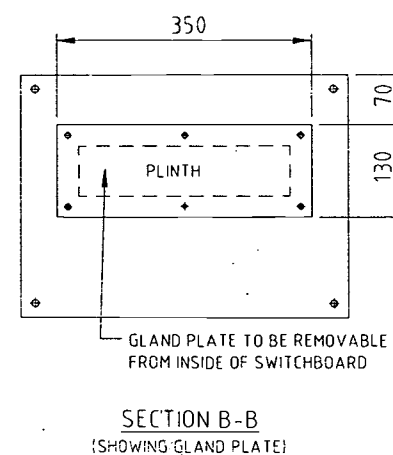
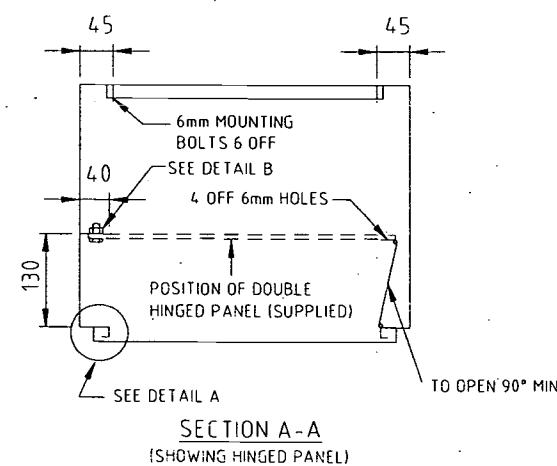


FRONT INSULATED PANEL
(6mm THICK SUPPLIED)

FIG.1
EQUIPMENT PANEL DETAILS



NUMBER OF SWITCHBOARDS REQUIRED	
NUMBER OF PLINTHS REQUIRED	



1. CABINET TO BE MANUFACTURED FROM 1.6mm 2B STAINLESS STEEL.
2. UNLESS SPECIFIED, SUPPLY CABINET WITH PLINTH. (MOUNT PLINTH TO SWITCHBOARD CABINET USING STAINLESS STEEL SCREWS).
3. REAR EQUIPMENT PANEL TO BE ZINC PLATED STEEL. POWDER COATED 'ORANGE'. (FULL LENGTH, FULL WIDTH & REMOVABLE). SEE FIG.1.
4. DOUBLE HINGED PANEL SUPPLIED BY B.C.C.
5. PROVIDE 1/4" WW STAINLESS STEEL STUDS TO DOOR & SWITCHBOARD CABINET.
6. DEGREE OF WEATHER PROTECTION IP55.
7. SELECTRIX TYPE HANDLE TO BE SUPPLIED & FITTED BY SWITCHBOARD MANUFACTURER. HANDLE TO BE 1107 SS CU1. KEY TO BE 24N177.
8. DOUBLE HINGED PANEL MOUNT TO BE SUPPLIED WITH MOUNTING BOLTS & NUTSERTS TOP & BOTTOM. SEE DETAIL A.

C 5-92 NOTE 1 REVISED		H1 DIRECTOR OF P.D. & P.S.		DATE		DESIGN NAME DATE		JOB FILE		PROJECT		TITLE		SCALE NTS		N° 1 OF 1 SHEETS	
B 11-95 MODIFIED		H1 ENGINEER IN CHARGE		DATE		DRAWN D.L.P.		ACAD FILE 22C0024-Rev-C		CATHODIC PROTECTION		STANDARD SWITCHBOARD CABINET		DRAWING N°		AMEND	
A 5-97 ISSUED FOR APPROVAL		H1 SUPERVISING ENGINEER		DATE		CHECKED		SURVEYED		486/1/22-C0024E		C					
NO. DATE		AMENDMENT		INITIALS		R.P.E.O. NO.		SHEET SIZE A1		FIELD BOOK		A.H. DATUM					

