



## **BRISBANE CITY COUNCIL**

### **Pressure Gauge Switchboard P0315**

### **Greentrees Ave Kenmore Hills**

**Contract :            BW 70103-048**

**Job Number :        WT400106**

## **ELECTRICAL INSTALLATION**

## ***OPERATIONS and MAINTENANCE MANUAL***

**INSTALLATION BY:**

**SJ Electric (Qld) Pty Ltd  
19 Elliot Street  
Albion Qld 4010**

**Telephone: 07 3256 1522    Fax: 07 3256 1533**

## **INDEX**

<b>SECTION</b>	<b>Pressure Station – P0315 Greentrees Ave Kenmore Hills</b>
<b>Sect 1</b>	<b>GENERAL</b>
<b>1.</b>	1..1 General Workplace Health & Safety 1..2 Project Overview 1..3 Plant Maintenance 1..4 Electrical Control System 1..5 Control & Monitoring System
<b>Sect 1</b>	<b>MANUFACTURER'S TECHNICAL DATA</b>
<b>2.</b>	2.1 Critec DAR-275V Alarm Relay 2.2 Trio DR900-06A02-D0 Radio. 2.3 Polyphaser IS-50NX Impulse Suppressor. 2.4 Powerbox Radio/DC converter. 2.5 Powerbox Modem/DC converter.
<b>Sect 1</b>	<b>DRAWINGS</b>
<b>3.</b>	
<b>Sect 1</b>	<b>INSPECTION &amp; TEST RESULTS</b>
<b>4.</b>	
<b>Sect 1</b>	<b>COMPLIANCE CERTIFICATES</b>
<b>5.</b>	

# 1. General

## 1.1 General Workplace Health and Safety

- The Workplace Health and Safety Act (1995) sets out the laws about Workplace Health and Safety for all workplaces, workplace activities and specified high risk plant. The Electrical Safety Act (2002) sets out the laws covering electrical safety. Nothing in this document is designed, in any way, to undermine the authority of the Acts.
- All reasonable care must always be taken to ensure the plant is without risk to the health and safety of personnel operating and maintaining plant and equipment.
- Employers have an obligation to ensure the workplace health and safety of all personnel at work.
- It is employer responsibility to ensure that all persons entering or working on the premises use appropriate personal protective equipment.
- Personal protective equipment includes gloves, safety glasses, hard hats, ear protection, safe foot ware and, where necessary, specialist protective clothing for hazardous areas.
- Any item of equipment should always be isolated before maintenance or repairs commence to ensure that inadvertent operation of the item does not result in risk to the health and safety of any person.
- Where the item is isolated, any total or partial shutdown should not allow a hazardous situation to be created.
- Where the item cannot be isolated, another person should be stationed at the controls of the item and an effective means of direct communication should exist between the persons carrying out the maintenance and the person at the controls.

## General Operating Principles

- All persons working the premises must be qualified Electrical Engineers or electrical trades persons capable of performing the required tasks competently. All personnel must also be familiar with plant and equipment.
- Adequate information, instruction, training and supervision must be provided to enable personnel to perform work without risk to health and safety.
- Work in an orderly way.
- Plan work in advance to avoid hazardous situations.
- Warn others of any hazards.
- Make inquiries before starting work, particularly on any unfamiliar installation or equipment.
- Before any work begins ensure that any instructions received or given are fully understood.
- Concentrate on the task on hand.
- Do not distract others or allow yourself to be distracted by foolish actions.
- Work from a safe and convenient position that provides a maximum working space that you do not have to over reach, you cannot slip, trip or stumble and so endanger yourself and others.
- Keep the working area tidy and free of unwanted materials and equipment.
- Use insulated tools where possible.
- Inspect tools and equipment regularly and ensure that any necessary maintenance is carried out.
- Keep yourself in good health.
- Do not work if ill or over tired, to the extent that your concentration, movement or alertness is affected. Illness or fatigue can endanger yourself and others.

## 1.2 Project Overview

Contract BW70103-048 was for the manufacture and testing of ten (10) new Pressure switchboards for various locations throughout Brisbane.

Equipment provided by SJ Electric ensures safe and efficient operation of the pump stations. Equipment supplied and installed by SJ Electric includes: -

- Switchboards
- Instrumentation
- Civil Works

The switchboard incorporates the latest technology in power monitoring, and instrumentation. It is important engineers, technicians and operators are familiar with the equipment installed before attempting any adjustments, modifications or maintenance.

The following Sections of this manual contain a comprehensive description of all equipment supplied, by SJ Electric. It is recommended that this manual be referred to before carrying out any work on any equipment.

### 1.3 Plant Maintenance

To ensure proper operation of the plant the following should be observed: -

- The plant should be kept clean and tidy at all times. Not only is this of aesthetic value, it extends equipment life.
- Check that all plant and equipment is operating correctly. Correctly operating equipment promotes overall plant efficiency.
- All items and areas of equipment should be hosed down and cleaned regularly.

#### **WARNING**

- **Avoid directly hosing any drive motor or electrical item.**

- All maintenance, service, modifications and significant deviations from Normal operating conditions should be recorded in the Plant Service Log
- After a month of operation, check the tension of all bolts associated with the plant and thereafter periodically. Bolted connections on painted surfaces can loosen due to thinning of the paint underneath the bolt head-bearing surface. Motor mounting bolts and other bolted connections subjected to vibration should be periodically checked for loosening.

#### **WARNING**

- **Before starting work on any item ensure that the power supply is isolated, tagged off, and the item cannot be started.**

- The importance of preventative maintenance cannot be over-emphasized. Regular maintenance and suitable care of the equipment will ensure a long and reliable service life of the equipment.
- Many stoppages can be avoided by following the recommended maintenance procedures. Do not wait until you hear the grinding of equipment that has broken down. If you see any item wearing down, replace it, before it causes damage to other associated items.

## **Preventive Maintenance**

Maintenance procedures recommended to extend switchboard life are outlined as follows: -

- Switchboard exterior should be regularly wiped down with a solvent base cleaner such as "Spray & Wipe". This will ensure longevity of the powder-coated surface.
- Accessible areas like distribution boards and motor starter panels should be cleaned with a vacuum cleaner to remove dust and foreign matter.
- RTU panels should be maintained as dust free as possible. Dusting with a dry rag is recommended - taking care not to allow dust inside the I/O modules or processor.
- When removing or installing PLC modules care should be taken to ensure that power is turned off to the rack before modules are removed or installed.
- Connections and efficient operation of circuit breakers, contactors and isolators should be checked every 12 months - especially where connected to busbars.
- Busbar connections should be checked every 12 months.
- Globes for indicator lights should be checked on a weekly basis with any faulty lamps replaced.
- Cubicle Fans Filter should be inspected and cleaned frequently.



## **1.4 Electrical Control System**

### **General Description**

The switchboards are manufactured from 3mm aluminium and are suitable for location outdoors; the switchboards have been designed by Brisbane Water and contain several separate sections including:

- Incoming Section.
- Distribution Section.
- RTU Section.

## **1.5 Control and Monitoring System.**

The control and monitoring of the system is performed by the Brisbane Water telemetry system and was not included in this contract.

## **2. MANUFACTURER'S TECHNICAL DATA**

# **TECHNICAL DATA SHEET**

**For**

## **PRESSURE STATION P0315** **Greentrees Ave Kenmore Hills**

<b>Equipment Type:</b>	Surge Filter Alarm Relay
<b>Location:</b>	Main Incomer
<b>Model Numbers:</b>	DAR-275V
<b>Manufacturer:</b>	Critec
<b>Supplier:</b>	Energy Correction Options PO Box 431 Kelvin Grove, QLD. 4059  Ph: 07 3356 0577 Fx: 07 3356 1432 Web: <a href="http://www.ecoptions.com.au">www.ecoptions.com.au</a>

# **TECHNICAL DATA SHEET**

**For**

## **PRESSURE STATION P0315** **Greentrees Ave Kenmore Hills**

<b>Equipment Type:</b>	Radio
<b>Location:</b>	RTU Section
<b>Model Numbers:</b>	DR900-06A02-D0
<b>Manufacturer:</b>	Trio
<b>Supplier:</b>	Brisbane Water

# **TECHNICAL DATA SHEET**

**For**

## **PRESSURE STATION P0315** **Greentrees Ave Kenmore Hills**

**Equipment Type:** Impulse Suppressor

**Location:** RTU Section

**Model Numbers:** IS-50NX-C2

**Manufacturer:** Polyphaser

**Supplier:** Brisbane Water

# **TECHNICAL DATA SHEET**

**For**

## **PRESSURE STATION P0315** **Greentrees Ave Kenmore Hills**

**Equipment Type:** Radio/DC Converter

**Location:** RTU Section

**Model Numbers:** PB1H-2412G-CC

**Manufacturer:** Powerbox

**Supplier:** Brisbane Water

# **TECHNICAL DATA SHEET**

**For**

## **PRESSURE STATION P0315** **Greentrees Ave Kenmore Hills**

**Equipment Type:** Modem/DC Converter

**Location:** RTU Section

**Model Numbers:** 24VDC-SP-CC

**Manufacturer:** Powerbox

**Supplier:** Brisbane Water

## **2. MANUFACTURER'S TECHNICAL DATA**

### **2.1 Critec DAR-275V Alarm Relay**



**INSTALLATION INSTRUCTIONS**

**MODEL NUMBER**  
**DAR 275V**

**1. PREPARATION**

**DANGER:** *Electrical shock or burn hazard. Installation of this device should only be made by qualified personnel. Failure to lockout electrical power during installation or maintenance can result in fatal electrocution or severe burns. Before making any connections be sure that power has been removed from all associated wiring, electrical panels, and other electrical equipment.*

**CAUTION NOTES:**

1. *The installation of this device should follow all applicable electrical codes, such as the National Electrical Code.*
2. *Check to make sure line voltage does not exceed DAR275V voltage ratings.*
3. *Follow all instructions to ensure correct and safe operation.*
4. *Do not attempt to open or tamper with the DAR in any way as this may compromise performance and will void warranty. No user serviceable parts are contained.*

**2. INTRODUCTION**

Selected DSD, TDS & TDF DINLINE Surge Protection Devices include status monitoring circuits which provide visual status display of device capacity. They may also provide a low voltage opto-coupler alarm output circuit that can be connect to the DAR to provide potential free (Form C) change-over contacts. The DAR alarm contacts may be used to provide output to external alarm systems or remote monitoring circuits.

One DAR can be used per DSD/TDS/TDF opto-coupler alarm or up to 16 DSD opto-coupler alarms can be connected in series to the one DAR to provide a common output. It is recommended that the DAR be powered from the same power circuit that feeds the device(s) being monitored, however the DAR can be powered from other circuits. This allows for example, one DAR unit to be connected to separate SPDs that are protecting a three phase circuit.

Note. Depending upon the usage of the DAR output contacts, failure of power to the DAR may be interpreted as a failure of one or more of the SPDs being monitored. Visual inspection of the DAR and SPDs status displays would determine this.

**3. MOUNTING**

The DAR is designed to clip to 35mm (top hat) DIN rails (standard EN50022). Unless otherwise mechanically restrained, use horizontal DIN rails with the DAR module spring clips to the bottom and the label text the correct way up.

**NOTE:** The DAR must be installed in an enclosure or panel that:

- *prevents the DAR temperature from exceeding 131°F (55°C)*
- *provides adequate electrical and safety protection*
- *prevents the ingress of moisture and water*
- *allows DAR status indicators to be inspected*

**4. ELECTRICAL CONNECTION**

The interconnecting wiring should:

- be of size #10 to #14 AWG (2.5mm<sup>2</sup> to 6mm<sup>2</sup>) solid or stranded conductor.
- The wire insulation should be stripped back 5/16" (8mm).
- **NOTE:** Do not use greater than 9inlbs (1Nm) of torque when tightening the terminals.


**CONNECTION TO TELECOMMUNICATIONS NETWORKS**

The DAR is approved for use in Australia where the alarm contacts may be connected to private lines or building cabling associated with the telecommunications network. NO direct connection to the public switched network should be made.


## INSTALLATION INSTRUCTIONS

### 5. INTERCONNECTION

When connecting the DAR to a single opto-coupler output the + terminal of the SPD should connect to the + terminal on the DAR. The – terminal should connect to the -- terminal.

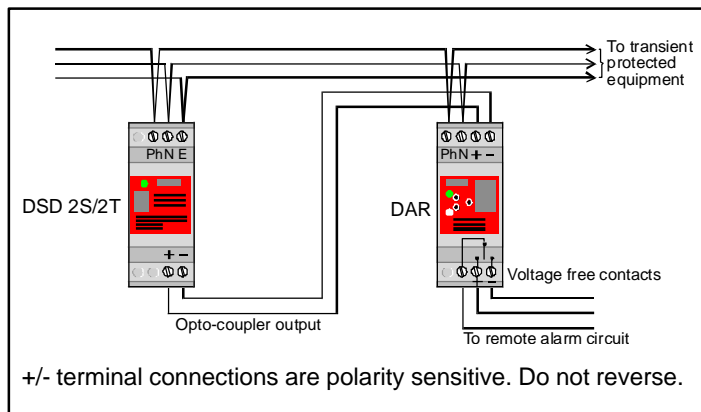

When connecting the DAR to multiple opto-couplers the opto-couplers should be connected in series with + terminal of one connected to the – terminal of the next. The DAR + terminal should connect to + SPD terminal at one end of the series connection and the – DAR terminal connect to the – SPD terminal at the other end of the series connection.

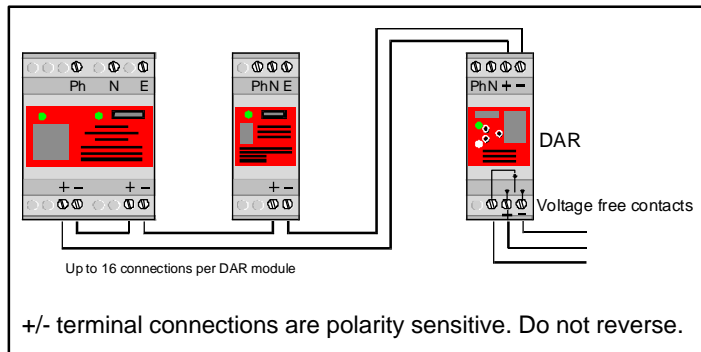

### 5. STATUS INDICATION

	✓	!	X
STATUS	Protection Operational	Protection Alarm	Fault Mode
DISPLAY			
EXPLANATION	Normal operation Normal (green) indicator ON Red indicator OFF Relay is energised Power is supplied	DSD in alarm mode or power to DSD has been removed Normal (green) indicator OFF Red indicator ON Relay is de-energised Power is supplied	Power to DAR removed Protection status unknown Normal (green) indicator OFF Red indicator OFF Relay is de-energised Power is OFF

### 6. FUSING AND ISOLATION

Overcurrent protection must be installed in the upstream circuit of the power supply to the DAR to provide protection to the unit itself and the wiring in case of fault conditions.

The fuse rating should be based on the wiring size used to connect to the DAR Ph & N terminals. Australian regulations AS3000-1991, Table B2 specifies the following upstream protection for single phase circuits, unenclosed in air.

Cable Size	HRC Fuse or	CB Rewirable Fuse
1.5mm <sup>2</sup>	16A	12A
2.5mm <sup>2</sup>	20A	16A
4mm <sup>2</sup>	25A	20A
6mm <sup>2</sup>	32A	25A

Where overcurrent protection of the appropriate rating or smaller is already fitted in the upstream circuit, overcurrent protection at the DAR will not be required

### 6. MAINTENANCE & TESTING

Before removing a DAR unit from service, ensure that the power has been removed. Maintenance, testing and replacement should only be undertaken by qualified personnel.

Testing of a DAR unit which is connected to a fully functional DSD unit can be accomplished by removing power to the DSD only. The DAR Status indication and output contacts should alter from the Normal to Fault condition.

Testing of the DAR unit alone may be accomplished by disconnecting the + / - connections to the unit. When power is applied the DAR "Fault" Status Indicator should be illuminated. By connecting the + / - terminals together, the "Normal" Status Indicator should be illuminated. The output contacts should alter to the appropriate state.

### 7. USE OF OTHER INTERFACES

Only DAR units are recommended for the interfacing of equipment to the DSD, TDS & TDF opto-coupler alarm output circuit(s). The direct connection of other equipment to these opto-coupler alarm outputs may not provide sufficient isolation or exceed the opto-coupler specifications. This may damage the SPD and/or the connected equipment. Warranty may be voided under such circumstances.

**NOTE:** In connecting to the SPD opto-coupler alarm output(s), do not reverse the +/- connections as damage may occur.

## **2. MANUFACTURER'S TECHNICAL DATA**

### **2.2 Trio DR900-06A02-D0 Radio.**



# TC-900DR USER GUIDE

41 Aster Avenue Carrum Downs 3201 Australia Tel: 61 3 9775 0505 Fax: 61 3 9775 0606

## GENERAL

The Trio DataCom TC-900DR is a full duplex 900 MHz Radio featuring a fully integrated 4800/9600 bps data radio modem and antenna diplexer. Configuration of the unit is fully programmable, with parameters held in non volatile memory (NVRAM). All configuration parameters are accessible using the TC-DRPROG installation package, consisting of a programming lead, manual and software which will run on a PC under Windows 95/98/NT. It is essential that each unit is programmed to suit individual requirements prior to operation. *For detailed information refer to the TC-900DR Handbook.*


## DATA CONNECTION

The data connection is via a DB9 connector labeled 'Port A' (shown below), which is wired as a DCE.

### User Serial "Port A" Pin Assignment.

#### EXTERNAL VIEW OF 'PORT A'


**NOTE:** Pin 6 and pin 9 provide a dual function which depends on the mode that the TC-900DR is operating in.

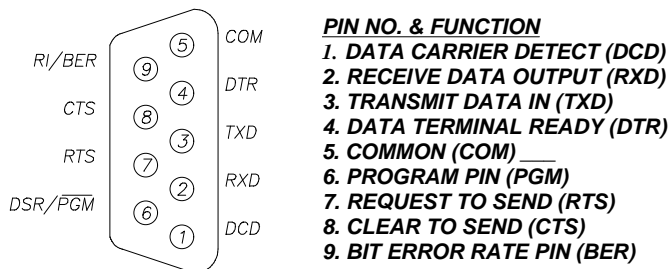

### User Serial "Port B" Pin Assignment.

Port B can be used as a secondary data stream (independent of Port A) once configured by the programmer. Port B also has one connection that may be of use for installation. This connection (Pin 9) is Receive Signal Strength Indicator (RSSI) output. 0-5V where 1.5V typically indicates -110dBm and every 0.5V increase indicates an improvement of » 10dBm.

#### EXTERNAL VIEW OF 'PORT B'

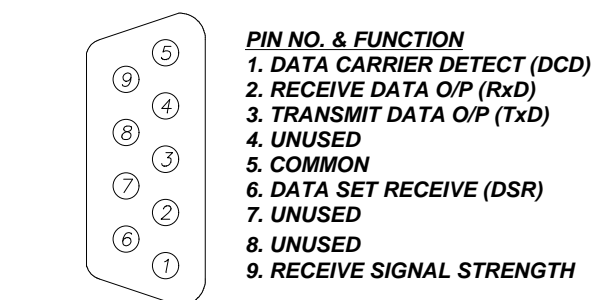


**NOTE:** Port B Pin 9 output has a high impedance of around 50K OHMS and loading will decrease accuracy of the RSSI measurement.

## POWER CONNECTIONS

The power required is 13.8VDC nominal, at 600mA (Tx) nominal. If the POWER LED indicator is not illuminated once power is applied, check the internal 1Amp fuse fitted within the unit.


POWER CONNECTOR	PIN ASSIGNMENT
TOP PIN	+VE SUPPLY (13.8vdc)
BOTTOM PIN	GROUND

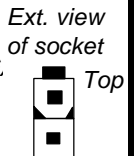

## AUXILIARY CONNECTOR

The auxiliary connector is primarily for use with the optional audio handset. The connections to this auxiliary 6 pin RJ11 connector are as follows:

PIN NUMBER	FUNCTION
1	8 VOLTS
2	AUDIO OUT
3	GROUND
4	MIC INPUT/SENSE
5	GROUND
6	MANUAL PTT

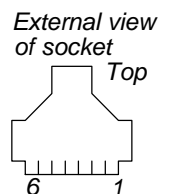

The optional audio handset is recommended as an aid in checking installations for radio path viability. This audio handset will only function when fitted prior to applying power to the unit.

The modem upon power up will check the presence of the handset and will inhibit data being transmitted so that voice communications can be established.

Once the path tests have been conducted the audio handsets **MUST be REMOVED** and the unit powered up with the handset removed before data communication can commence.

## USER INDICATIONS

The TC-900DR provides 4 LED's that show status information to the user - POWER, RXSIG, SYNC, and TXMIT indications.

The POWER is indicated by a green LED and simply signifies that power has been applied to the unit.

The RXSIG LED (yellow) indicates the level of RSSI signal from the radio IF strip, compared to a threshold level set in the configuration data programmed by the user. If the signal is above the threshold, then the LED indicator is turned on.

In all operation modes except "Programmer mode", the SYNC LED (yellow) indicates when the modem has detected a valid data stream. The SYNC LED is activated, when the modem detects a valid HDLC flag sequence, and remains active until an invalid sequence of seven or more consecutive "1" bits is detected.

The SYNC LED will not be turned on if the RSSI signal strength (as indicated by the RXSIG LED) is below the minimum threshold. This prevents false SYNC detection from noise.

The TXMIT LED (red) indicator is connected directly to the modem's PTT output transistor. Whenever the radio is transmitting, this TXMIT LED indicator will be on.

## **SPECIAL MODES OF OPERATION**

Part of the power-up/reset initialisation phase of the TC-900DR are tests to determine if the modem should enter one of 3 "special operation" modes. *In these modes the TC-900DR won't operate in its standard run mode.*

- ◆ Programmer mode.
- ◆ Bit error rate test mode.
- ◆ Handset mode.

These modes are only entered if the required setup conditions are present at power up. An error mode of operation can also be entered into, if during normal operation, an error condition occurs.

### **PROGRAMMER MODE**

CABLE - Pins 2, 3, 4, 5 straight through with Pin 6 on the DB9 connector of Port A, connected to pin 5. When the modem is powered up with this fitted, the controller senses this and attempts to enter "Programmer mode" and the "SYNC" LED will flash approx. once per second. (Note, the TC-DRPROG programming software and lead has the required connections). Failure to supply the correct password in time, will cause the modem to abandon the "Programmer mode" attempt, and go on with its normal power-up procedure.

### **BIT ERROR RATE TEST MODE**

Pin 9 of the DB9 connector of Port A, is normally the Ring Indicate output line. However, if this pin is driven positive (connecting it to pin 6 [DSR] and pin 7 [RTS]), then the modem's data transmitter and receiver will enter the BER test mode. This will activate the RF transmitter, and generate a scrambled bit pattern which should be decoded at a receiver as a constant logic "1" level in the unscrambled data. Any errors in the decoded bitstream, will be "0", and the receiver portion of the modem in this mode, will activate the SYNC LED every time it sees a "0" bit.

Note: As the TC-900DR is full duplex this test can operate in both directions simultaneously.

Every error bit detected, will activate the SYNC LED. For error rates of 1 in  $10^3$  and above, the SYNC LED will be ON most of the time. A 1 in  $10^4$  error rate will show the SYNC LED active for approximately 10% of the time. This function provides a crude indication of Bit Error Rate for installation purposes. Note: Error count messages (ET:XXXX) for every 10,000 bits are presented to Port A for the user. If pin 9 ceases to be driven positive, then the BER Test mode is terminated, and the modem restarts its initialisation phase.

### **HANDSET MODE**

The DFM4-9 modem tests for the presence of a handset plugged into the handset auxiliary port at power up. If a handset is plugged in, the modem will not generate a data stream. However, it will continue to indicate received RF signal strength. The handset has a PTT button, and this signal is connected across the modem's PTT output. Thus the handset PTT switch will activate the TXMIT LED. It is essential to remove the handset from the unit and reapply power to the unit in order to return to normal operation.

### **ERROR INDICATION MODES**

There are 3 error conditions that cause the RXSIG & SYNC LEDs to be used for error indications and not their normal purpose. Two are fatal conditions, that cause the modem to restart after the duration of the error indication phase.

## **TRANSMIT POWER LOW**

While the modem activates the radio transmitter, it periodically checks the transmit power. If the power measurement is less than a threshold set in the non-volatile memory, then the RXSIG and SYNC LEDs are made to alternate, approximately 4 times per second. The TXMIT LED will also be on during this process. This indication condition will persist for the duration of the transmission. As soon as the transmission is discontinued, the error indication will cease, and the two LEDs revert to their normal function. Factory set to 100 milliWatts.

### **NVRAM READ ERROR**

The DFM4-9DR modem accesses the non-volatile memory as part of its initialisation phase, to read programming configuration data. If the communication protocol with the device is violated, or the non-volatile memory CRC checksum is found to be incorrect, then the modem indicates this by flashing the RXSIG and SYNC LEDs twice alternately. That is, one LED operates ON and OFF twice, then the other. A total of five cycles of this occurs, then the modem restarts initialisation.

### **SYNTHESISER LOCK DETECT ERROR**

If at any time during normal operation, BER mode, or handset mode, the TBB206 frequency synthesiser indicates an out of lock condition, the modem enters an error indication mode for a short time before restarting.

One LED is turned ON (☉), the LEDs are swapped, then both turned OFF (●). Then the latter LED ON again, swap LEDs, and then OFF. This will give the appearance of a sweeping motion between the LEDs. The following table shows all error condition displays.

Tx PWR Err		NVRAM Err		SYNTH Err	
RXSIG	SYNC	RXSIG	SYNC	RXSIG	SYNC
☉	●	☉	●	☉	●
●	☉	●	●	●	☉
☉	●	☉	●	●	●
●	☉	●	●	●	☉
☉	●	●	☉	☉	●
●	☉	●	●	●	●
☉	●	●	☉		repeat
●	☉	●	●		
continue		repeat			

## **MOUNTING AND ANTENNA CONNECTION**

The TC-900DR should be mounted in a cool, dry, vibration free environment, whilst providing easy access to screws and connections. There are 4 mounting holes on the unit. The antenna should be an external yagi antenna but can be a ground independent dipole mounted via a feeder to the antenna connector (SMA type) for short range applications. However the whole radio modem should be clear of the associated data equipment to prevent mutual interference.

### **ASSEMBLY OF POWER LEAD**

A small plastic bag containing a molex connector (M5557-2R) and two pins (M5556-TL) is provided in the packing box.

The pins are designed to take 18-24 (AWG) wire size with insulation range 1.3 - 3.10mm.

Please take care when crimping the pins.

04/01




## **2. MANUFACTURER'S TECHNICAL DATA**

### **2.3 Polyphaser IS-50NX Impulse Suppressor.**

ALL DESIGN, OPERATIVE AND PROCESS DATA PERTAINING TO THE ARTICLE SHOWN ON THIS SHEET IS THE PROPERTY OF POLYPHASER CORPORATION. THE INFORMATION IS NOT TO BE COPIED, REPRODUCED, REVEALED TO OR APPROPRIATED BY OTHERS WITHOUT THE EXPRESS WRITTEN CONSENT OF POLYPHASER CORPORATION.

## REVISIONS

REV	LTR	DATE	ENG	MKTG	Q.A.
A		01/30/96 <sub>PJP</sub>	T. K.	— —	R. M.
B		06/30/99 <sub>JCG</sub>	K.C.B.	T.G.F.	R. M.
C		01/16/01 <sub>SH</sub>	KCB	PH	RM
D		11/18/02 <sub>SH</sub>	LC	SD	LJ

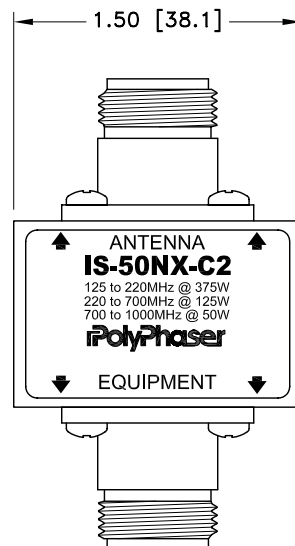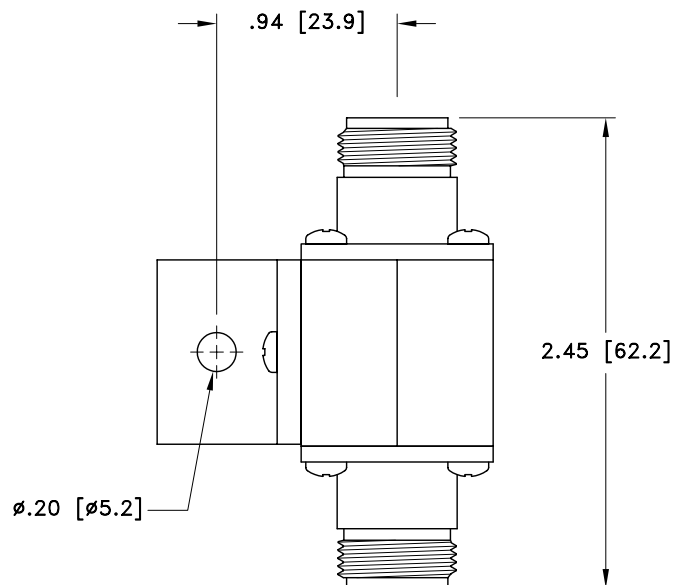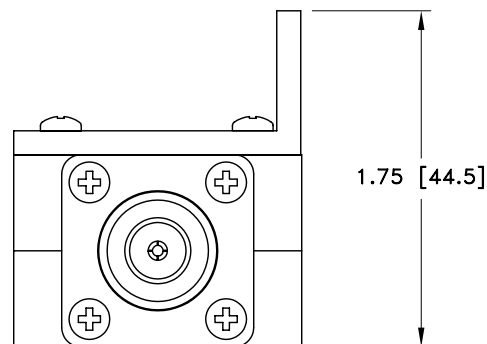


## MAXIMUM CHARACTERISTICS

SURGE:  
50kA IEC 1000-4-5 8/20 $\mu$ s WAVEFORM 500 JOULES  
TURN ON:  
600Vdc  $\pm$ 20%  
TURN ON TIME:  
2.5ns FOR 2kV/ns  
FREQUENCY RANGE:  
125MHz TO 1GHz  
VSWR:  
 $\leq$ 1.1:1 OVER FREQUENCY RANGE  
INSERTION LOSS:  
 $\leq$ 0.1dB OVER FREQUENCY RANGE  
TEMPERATURE:  
-45°C TO +85°C STORAGE/OPERATING +50°C

CUSTOMER APPROVAL: \_\_\_\_\_ DATE: \_\_\_\_\_

ALL DIMENSIONS SHOWN ABOVE ARE FOR REFERENCE ONLY.

DRAFTER J. CALLISTER	DATE 09/21/93	 P.O. BOX 9000, MINDEN, NV 89423-9000 (775) 782-2511 FAX (775) 782-4476 DWG NO/PART NO/DESCRIPTION			
MECH ENGINEER — — — —	DATE — — —				
ELEC ENGINEER J. JONES	DATE 04/12/95	IS-50NX-C2 CUSTOMER PRINT			
MARKETING — — — —	DATE — — —				
QUALITY DEPT R. MATHEUS	DATE 04/12/95	CAGE CODE 61114	FILE NAME -C1	SCALE 1/1	SHEET 1 OF 1

## **2. MANUFACTURER'S TECHNICAL DATA**

### **2.4 Powerbox Radio/DC converter.**



# PBIH Series

## 15-150 WATTS DC/DC SINGLE OUTPUT

### Features

- Wide selection of models
- 4 input voltage ranges
- High efficiency
- Low output ripple
- Proven reliability
- Good thermal margins



### Specifications

#### INPUT

Input voltage	12VDC (9.2–16) 24VDC (19–32) 48VDC (38–63) 110VDC (85–140)
---------------	---

Inrush current	20A max. for 110V only
----------------	------------------------

#### OUTPUT

Output voltage	See table
Voltage adjustment	±10%, ±5% for PBIH-F
Output current	See table
Ripple & noise	Output Volts x 1% + 50mV to -100mV pk-pk
Line regulation	0.8% over input range
Load regulation	0.9%, 0%–100% load
Temperature coefficient	0°C to 50°C, 0.03% per °C
Overvoltage protection	O.V. clamp, PBIH-F Output shutdown, PBIH-G, J, M, R – input must be switched off for at least 30S to reactivate
Overcurrent protection	Fold back – PBIH-F Current limiting, PBIH-G, J, M, R (PBIH-R series is adjustable); PBIH110xxR models are not adjustable
Drift	Output V x 0.5% + 15(mV) per 8 hrs after 1 hr warm-up
Rise Time	200mS max. – PBIH-F, M, R 100mS max. – PBIH-G, J (at 25°C)
Holdup time	10mS (only 110V input)
Remote sense	PBIH-R Series only

### OPERATING

Efficiency	70%–89%
Safety isolation (1 minute)	Type – 12, 24, 48V input Input – Output: 1500VAC Input– Case: 1500VAC Output– Case: 500VAC Type– 110V input Input– Output: 2000VAC Input– Case: 2000VAC Output– Case: 500VAC
Insulation resistance	50M (500VDC) Input – Case
Parallel operation	Consult sales office for details
Remote control	PBIH-R Series: Open link: output normal Short link: output off

### ENVIRONMENTAL

Operating temperature	0°C to 50°C full load
Cooling	Convection cooled
Storage temperature	-20°C to +85°C
Humidity	85%
Shock	30G, PBIH-F, G and J
Vibration	(5Hz–10Hz, 10mm), (10Hz–50Hz) 2G, PBIH-F, G and J

### STANDARDS AND APPROVALS

Safety	Designed to UL1950
C-tick	AS/NZS CISPR11 Group 1, Class A

### MECHANICAL

Weight	PBIH-F : 250g PBIH-G : 380g PBIH-J : 410g PBIH-M : 800g PBIH-R : 1.4kg
--------	--

# PBIH Series

## 15-150 WATTS DC/DC SINGLE OUTPUT


### Selection Table

MODEL NUMBER	INPUT	OUTPUT	OUTPUT POWER
PBIH-1205F	9.2-16V	5V 3A	15W
PBIH-1212F	9.2-16V	12V 1.2A	15W
PBIH-1215F	9.2-16V	15V 1A	15W
PBIH-1224F	9.2-16V	24V 0.62A	15W
PBIH-2405F	19-32V	5V 3A	15W
PBIH-2412F	19-32V	12V 1.2A	15W
PBIH-2415F	19-32V	15V 1A	15W
PBIH-2424F	19-32V	24V 0.62A	15W
PBIH-4805F	38-63V	5V 3A	15W
PBIH-4812F	38-63V	12V 1.2A	15W
PBIH-4815F	38-63V	15V 1A	15W
PBIH-4824F	38-63V	24V 0.62A	15W
PBIH-11005F	85-140V	5V 3A	15W
PBIH-11012F	85-140V	12V 1.2A	15W
PBIH-11015F	85-140V	15V 1A	15W
PBIH-11024F	85-140V	24V 0.62A	15W
PBIH-1205G	9.2-16V	5V 5A	25W
PBIH-1212G	9.2-16V	12V 2.1A	25W
PBIH-1215G	9.2-16V	15V 1.7A	25W
PBIH-1224G	9.2-16V	24V 1.1A	25W
PBIH-1248G	9.2-16V	48V 0.5A	25W
PBIH-2405G	19-32V	5V 5A	25W
PBIH-2412G	19-32V	12V 2.1A	25W
PBIH-2415G	19-32V	15V 1.7A	25W
PBIH-2424G	19-32V	24V 1.1A	25W
PBIH-2448G	19-32V	48V 0.5A	25W
PBIH-4805G	38-63V	5V 5A	25W
PBIH-4812G	38-63V	12V 2.1A	25W
PBIH-4815G	38-63V	15V 1.7A	25W
PBIH-4824G	38-63V	24V 1.1A	25W
PBIH-4848G	38-63V	48V 0.5A	25W
PBIH-11005G	85-140V	5V 5A	25W

MODEL NUMBER	INPUT	OUTPUT	OUTPUT POWER
PBIH-11012G	85-140V	12V 2.1A	25W
PBIH-11015G	85-140V	15V 1.7A	25W
PBIH-11024G	85-140V	24V 1.1A	25W
PBIH-11048G	85-140V	48V 0.5A	25W
PBIH-1205J	9.2-16V	5V 8A	50W
PBIH-1212J	9.2-16V	12V 3.3A	50W
PBIH-1215J	9.2-16V	15V 2.7A	50W
PBIH-1224J	9.2-16V	24V 1.7A	50W
PBIH-1248J	9.2-16V	48V 0.8A	50W
PBIH-2405J	19-32V	5V 10A	50W
PBIH-2412J	19-32V	12V 4.3A	50W
PBIH-2415J	19-32V	15V 3.4A	50W
PBIH-2424J	19-32V	24V 2.5A	50W
PBIH-2448J	19-32V	48V 1A	50W
PBIH-4805J	38-63V	5V 10A	50W
PBIH-4812J	38-63V	12V 4.3A	50W
PBIH-4815J	38-63V	15V 3.4A	50W
PBIH-4824J	38-63V	24V 2.5A	50W
PBIH-4848J	38-63V	48V 1A	50W
PBIH-11005J	85-140V	5V 10A	50W
PBIH-11012J	85-140V	12V 4.3A	50W
PBIH-11015J	85-140V	15V 3.4A	50W
PBIH-11024J	85-140V	24V 2.5A	50W
PBIH-11048J	85-140V	48V 1A	50W
PBIH-1205M	9.2-16V	5V 18A	100W
PBIH-1212M	9.2-16V	12V 9A	100W
PBIH-1215M	9.2-16V	15V 7A	100W
PBIH-1224M	9.2-16V	24V 4.5A	100W
PBIH-1248M	9.2-16V	48V 2A	100W
PBIH-2405M	19-32V	5V 20A	100W
PBIH-2412M	19-32V	12V 9A	100W
PBIH-2415M	19-32V	15V 7A	100W

MODEL NUMBER	INPUT	OUTPUT	OUTPUT POWER
PBIH-2424M	19-32V	24V 5A	100W
PBIH-2448M	19-32V	48V 2A	100W
PBIH-4805M	38-63V	5V 20A	100W
PBIH-4812M	38-63V	12V 9A	100W
PBIH-4815M	38-63V	15V 7A	100W
PBIH-4824M	38-63V	24V 5A	100W
PBIH-4848M	38-63V	48V 2A	100W
PBIH-11005M	85-140V	5V 20A	100W
PBIH-11012M	85-140V	12V 9A	100W
PBIH-11015M	85-140V	15V 7A	100W
PBIH-11024M	85-140V	24V 5A	100W
PBIH-11048M	85-140V	48V 2A	100W
PBIH-1205R	9.2-16V	5V 27A	150W
PBIH-1212R	9.2-16V	12V 13A	150W
PBIH-1215R	9.2-16V	15V 10A	150W
PBIH-1224R	9.2-16V	24V 6.5A	150W
PBIH-1248R	9.2-16V	48V 3.3A	150W
PBIH-2405R	19-32V	5V 30A	150W
PBIH-2412R	19-32V	12V 14A	150W
PBIH-2415R	19-32V	15V 11A	150W
PBIH-2424R	19-32V	24V 7A	150W
PBIH-2448R	19-32V	48V 3.5A	150W
PBIH-4805R	38-63V	5V 30A	150W
PBIH-4812R	38-63V	12V 14A	150W
PBIH-4815R	38-63V	15V 11A	150W
PBIH-4824R	38-63V	24V 7A	150W
PBIH-4848R	38-63V	48V 3.5A	150W
PBIH-11005R	85-140V	5V 30A	150W
PBIH-11012R	85-140V	12V 14A	150W
PBIH-11015R	85-140V	15V 11A	150W
PBIH-11024R	85-140V	24V 7A	150W
PBIH-11048R	85-140V	48V 3.5A	150W

### PBIH-F

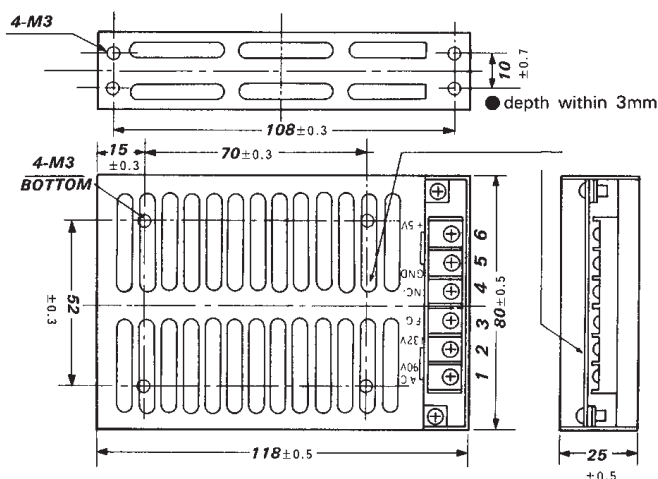


\* Dimensions in mm

terminal No.	
1	0 V (DC in)
2	+ V (DC in)
3	FG
4	NO Connection
5	- V out
6	+ V out

# PBIH Series


## 15-150 WATTS SINGLE OUTPUT

### PBIH-G

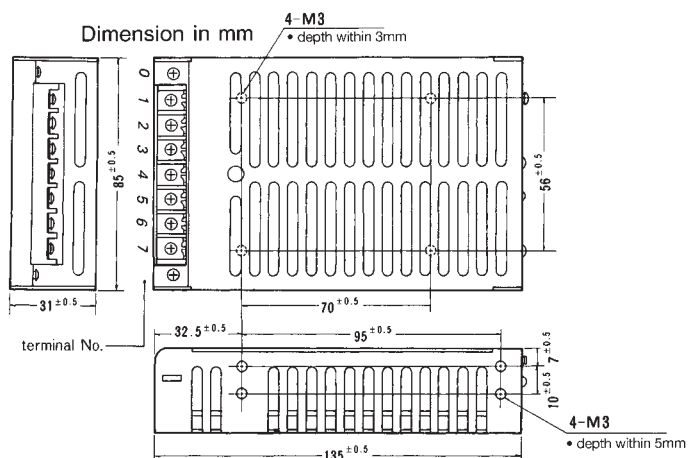


Terminal	Connection
0	FG
1	DC +V in
2	0V in
3	LFG
4	NO
5	NO
6	-V out
7	+V out

### PBIH-J

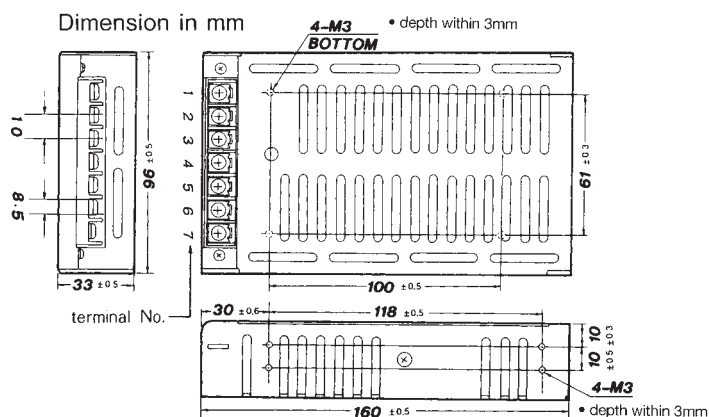


Terminal	Connection
1	FG
2	DC +V in
3	0V in
4	LFG
5	-V out
6	+V out
7	NC

### PBIH-M

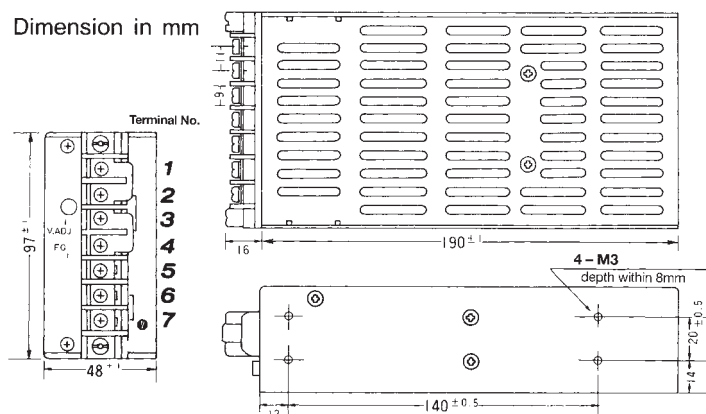

Terminal	Connection
1	+V out
2	+V out
3	-V out
4	-V out
5	FG
6	-V in
7	+V in

### PBIH-R

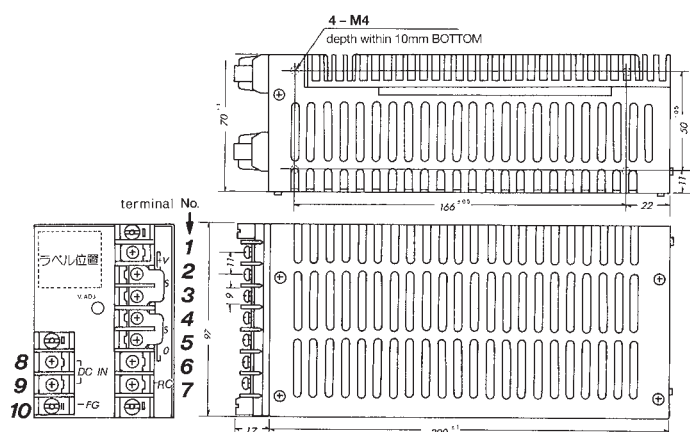

Terminal	Connection
1, 2	+V out
3	+S
4	-S
5, 6	-V out
7	Remote Control
8	DC +V in
9	DC 0V in
10	FG

## **2. MANUFACTURER'S TECHNICAL DATA**

### **2.5 Powerbox Modem/DC converter.**

# PB251 Series

220-330 WATTS DC UPS

## Features

- Ultra-low noise output
- Independent battery charging output
- DC output OK & battery OK alarms & LEDs
- Battery-LVD and alarm
- Over-temperature protection
- Battery fuse fail LED



## Specifications

### INPUT

Voltage:	190 to 264 vac, or 190 to 400VDC
Line regulation:	0.2% typical
Current:	1.4A maximum
Inrush current:	10A maximum
Frequency:	45 to 65 Hz

### OUTPUT

Voltage	See table
Current	See table
Load regulation	0.5% typical
Current limit type - load cct	Constant current
Current limit type - batt. cct	Constant current
Short circuit protection	Indefinite, auto-resetting
Over-voltage protection	17.5 to 20V latching (13.8Vdc output) 31.5 to 39V latching (27.6Vdc output)
Ripple & noise 100 MHz bandwidth	28mVp-p (13.8Vdc output) 55mVp-p (27.6Vdc output)

### ENVIRONMENTAL

Operating temperature	0 to 70°C ambient with derating, 5...90% relative humidity (non-condensing)
Over-temperature protection	Automatic & auto-resetting
Cooling requirement	Natural convection
Efficiency	80% minimum

## STANDARDS & APPROVALS

Safety	Complies with AS/NZS 60950, class 1, NSW Office of Fair Trading Approval N20602
EMC	Emissions comply with AS/NZS CISPR11, Group 1, Class B. Complies with ACA EMC Scheme, Safety & EMC Regulatory Compliance Marked
Isolation i/p-o/p i/p-ground o/p-ground	4242VDC for 1 minute 2121VDC for 1 minute 707VDC for 1 minute

## ALARMS & BATTERY FUNCTIONS

Converter ON/OK alarm	Indicated by voltage-free changeover relay contacts &
green LED	ON=PSU OK
Battery low (& fuse) alarm	10.2 to 12.6V for 12V battery, adjustable 20.4 to 25.2V for 24V battery, adjustable Indicated by voltage-free changeover relay contacts & green LED: ON=BATT OK
Low voltage disconnect	9.6 to 12V for 12V battery, adjustable 19.2 to 24V for 24V battery, adjustable
Charger over-load protection	Auto-resetting electronic circuit breaker
Reverse polarity protection	Internal battery fuse
Battery to load voltage drop	0.2 to 0.25V typical

## MECHANICAL

Case size	264 L x 172 W x 67 H mm
Case size with heatsink	264 L x 186 W x 67 H mm
Rack size	232 D x 19" W x 2RU H
Weight	1.9 kg
Weight with heatsink	2.1 kg
Weight (rack mounted version)	5.5 kg

## Selection Table


MODEL NUMBER	OUTPUT			
	VDC	I <sub>LOAD</sub>	I <sub>BATT</sub>	OUTPUT POWER
PB251-12CM	13.8V	16A	2A	220W
PB251-12CM-H	13.8V	20A	2A	275W
PB251-24CM	27.6V	11A	2A	300W
PB251-24CM-H	27.6V	12A	2A	330W
PB251-12RML	13.8V	20A	4A	275W
PB251-12B	13.8V	20A	4A	275W
PB251-24RML	27.6V	12A	2A	330W

Note: Non standard battery charging current available on request. ie PB251-12CM-H-10 for 10A.


# PB251 Series

275-330 WATTS DC UPS


## Technical Illustrations

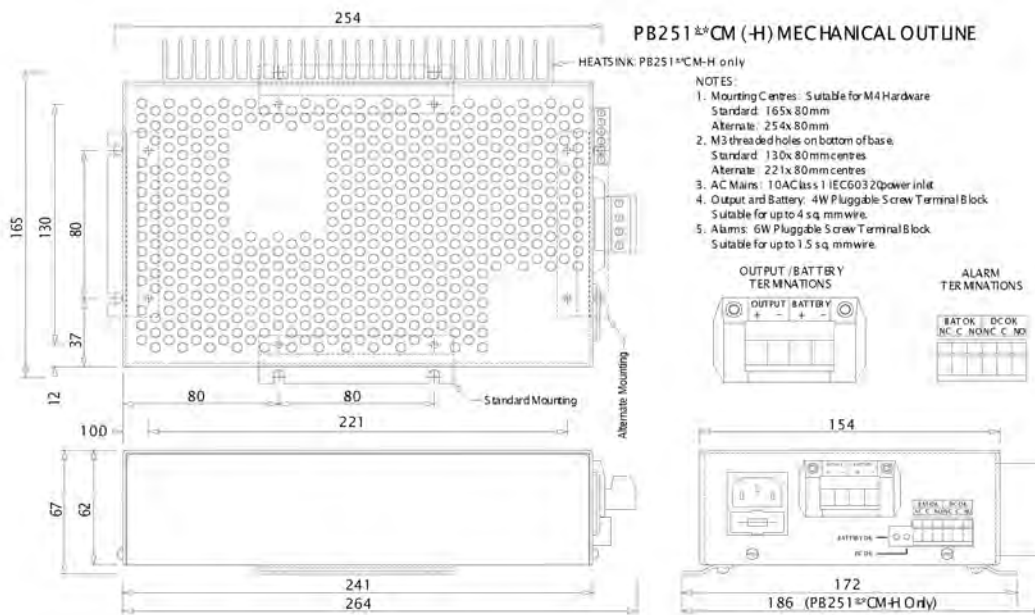



## PB251-\*\*RML & -12B MECHANICAL OUTLINE

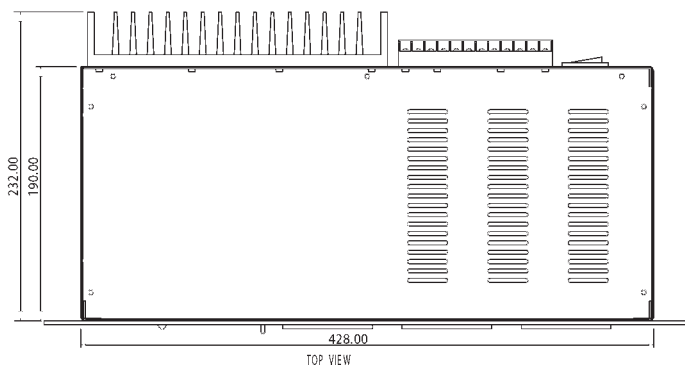



- NOTES:
1. 2RU x 19" rack enclosure per IEC 297
  2. Mounting slots are suitable for M6 hardware.
  3. Input connector is a 10A Class 1 IEC60320 inlet.
  4. 2 meter IEC mains cord with Australian plug is supplied with unit.
  5. PB251-12B alarm terminal is DB25 female.
  6. PB251-12B output and battery connector is Hirose pn. HS28R-4A. Mating connector is Hirose pn. HS28P-4A (not supplied).
  7. PB251-\*\*RML alarm and output terminals are M3.5 screws suitable for ring or fork lugs up to 8 mm wide.

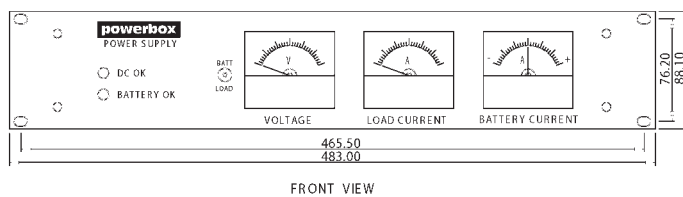

### PB251-\*\*RML ALARM AND OUTPUT TERMINALS

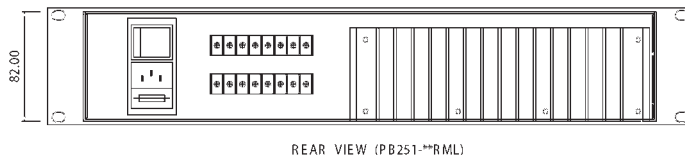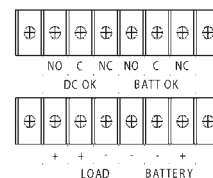

### PB251-12B OUTPUT & BATTERY CONNECTOR

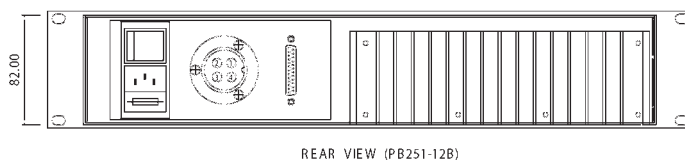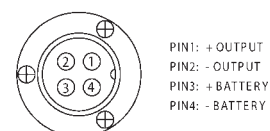

### PB251-12B ALARM CONNECTOR



# 3. DRAWINGS



ABN 86 673 835 011

# P0315

## GREENTREES AVE, KENMORE HILLS

### PRESSURE GAUGE SWITCHBOARD

DRAWING VARIABLE	VARIABLE / LAYER	VALUE / ON or OFF
	SITE ID (01)	P0315
	StreetName (02)	GREENTREES AVE
	SuburbName (03)	KENMORE HILLS
	P1 Gauge No. (04)	P0315
	P2 Gauge No. (05)	-
	Flowmeter No. (06)	-
	RadioPartNo. (07)	DR900-07A02-D0
	DrawingNo. (08)	486/4/9-0791-
	Site Function (09)	PRESSURE GAUGE
DRAWING LAYER	Antenna Mast Height (10)	6.0
	1.1 Main PRV fitted	no
	12.1 Bypass PRV fitted	no
	2.1 Radio fitted	yes
	2.1.1 Side Antenna Mast fitted	yes
	2.1.2 Rear Antenna Mast fitted	no
	3.1 PSTN Modem fitted	no
	3.2 GSM Modem fitted	no
	4.1 Flowmeter fitted	no
	5.1.1 Pressure Gauge 1 fitted	yes
	5.2.1 Pressure Gauge 2 fitted	no
	6.1 Sump Pump fitted	no
	7.1 RTU - MD331 fitted	no
	7.2 RTU - eNet fitted	yes
	7.3 RTU plg/skt fitted	yes


## ELECTRICAL DRAWINGS INDEX

DWG N°.	TITLE	SHEET	REVISIONS				
486/4/9-0791-001	ELECTRICAL DRAWING INDEX	01	0	A			
486/4/9-0791-002	POWER DISTRIBUTION SCHEMATIC DIAGRAM	02	0	A			
486/4/9-0791-003	DIGITAL INPUTS AND OUTPUTS TERMINATION DIAGRAM	03	0				
486/4/9-0791-004	ANALOG INPUTS AND OUTPUTS TERMINATION DIAGRAM	04	0	A			
486/4/9-0791-005	SWITCHBOARD GENERAL ARRANGEMENT	05	0	A			
486/4/9-0791-006	SWITCHBOARD CONSTRUCTION DETAILS	06	0				
486/4/9-0791-007	SWITCHBOARD EQUIPMENT LIST	07	0	A			
486/4/9-0791-008	SWITCHBOARD CABLE SCHEDULE & LABEL SCHEDULE	08	0	A			
486/4/9-0791-009	SWITCHBOARD SITE LAYOUT	09	0	A			
486/4/9-0791-010	SPARE						


ELECTRICAL AS BUILT DETAILS			
REV	COMPANY	-	
-	ELECTRICIAN	-	
	LICENCE No.	-	DATE: -

SHEET 01

FOR CONSTRUCTION

					DRAFTED	E.PARANAGAMA 04.10	* A.CHAVEZ-PLASENCIA		* K.VAHEESAN		7/5/10		SITE P0315 GREENTREES AVE, KENMORE HILLS PRESSURE GAUGE ELECTRICAL INSTALLATION	TITLE ELECTRICAL DRAWINGS INDEX	SHEET No.				
A	06/10	MINOR REV FOR CONSTRUCTION		DPM	GA	DRAFTING CHECK	P.MOSTERT	04.10	DESIGN	R.P.E.Q. No.	DATE				PRINCIPAL DESIGN MANAGER	DATE	Queensland Urban Utilities	DRAWING No.	AMEND.
O	04-10	FOR CONSTRUCTION		E.P.	AW	CAD FILE	49-0791SetA.dwg		* A.WITTHOFT	8895	5/5/10				* P.SHERRIFF	5/5/10	486/4/9-0791-001		A
No	DATE	AMENDMENT		DRN.	APD.	B.C.C. FILE No.			DESIGN CHECK	R.P.E.Q. No.	DATE				CLIENT DELEGATE	DATE			



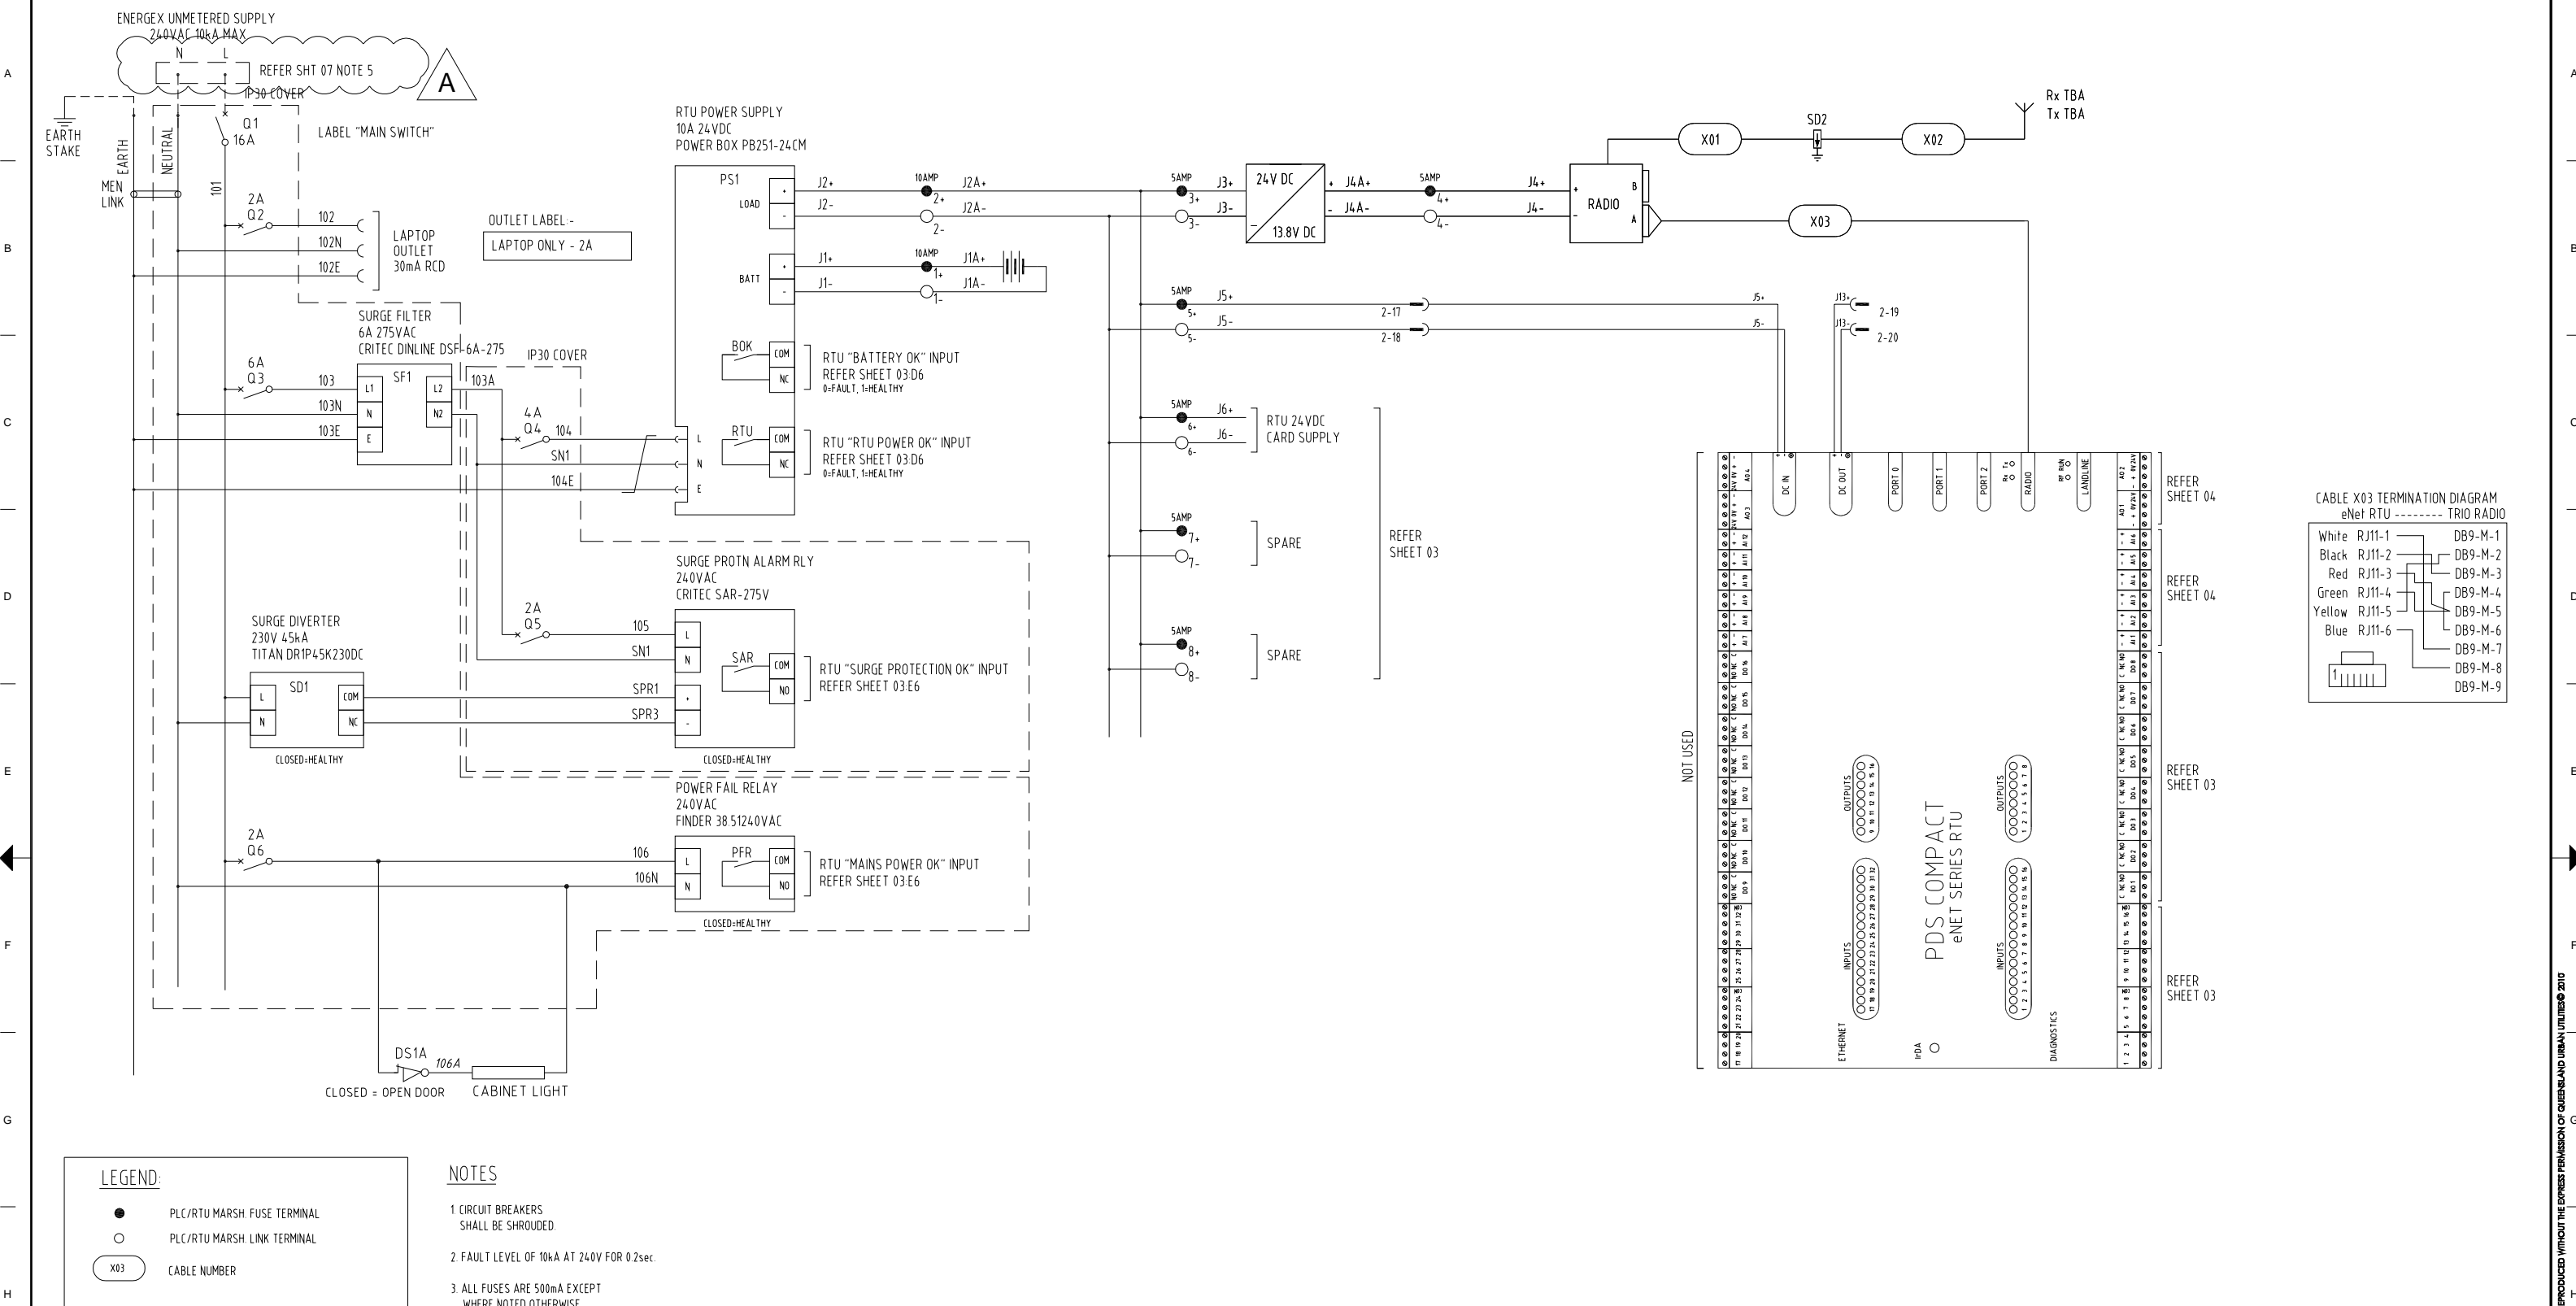


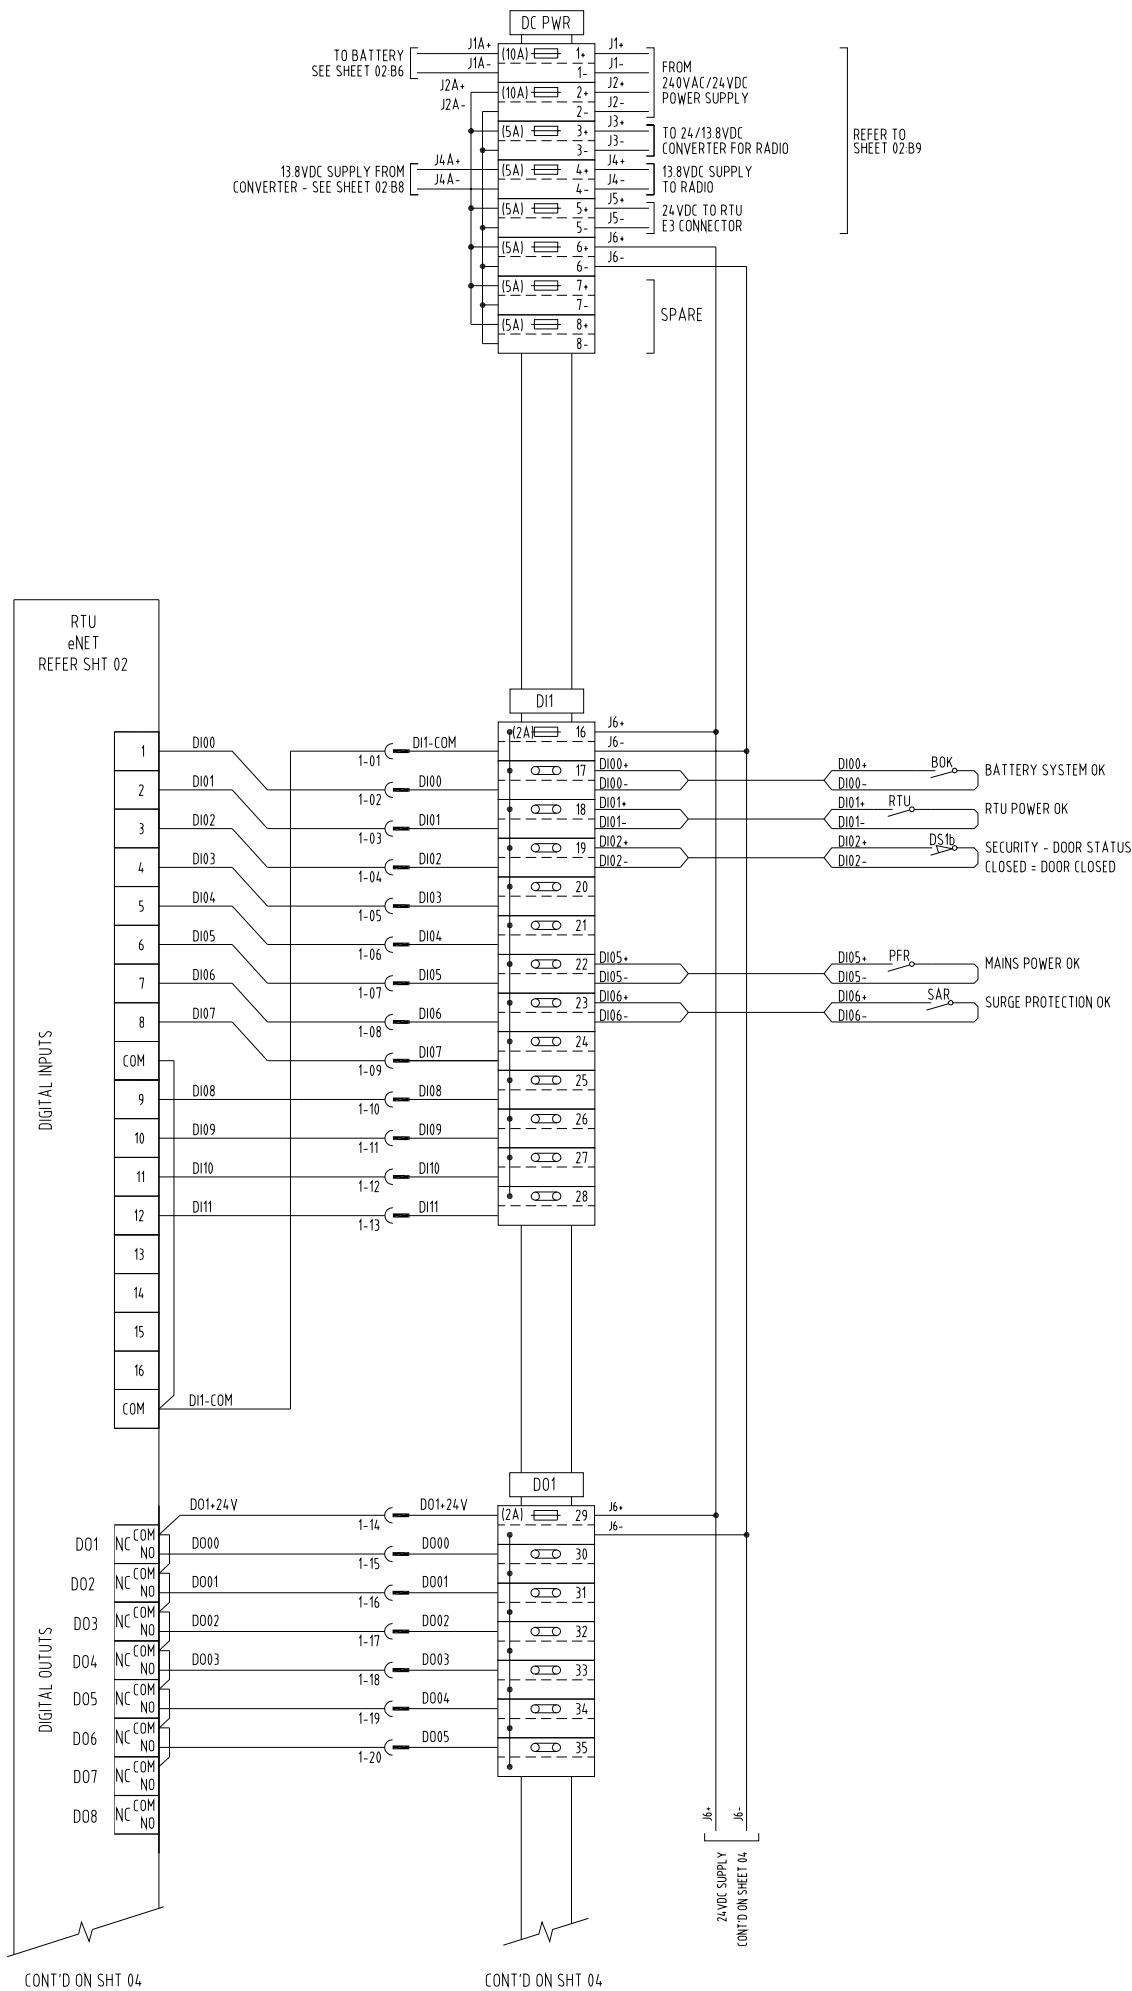
## ELECTRICAL AS BUILT DETAILS

REV	COMPANY	-
-	ELECTRICIAN	-
-	LICENCE No.	-
-	DATE:	-

SHEET 02

FOR CONSTRUCTION

				DRAFTED	E.PARANAGAMA 04.10	* A.CHAVEZ-PLASENCIA	* K.VAHEESAN	7/5/10		SITE P0315 GREENTREES AVE, KENMORE HILLS PRESSURE GAUGE ELECTRICAL INSTALLATION	TITLE POWER DISTRIBUTION SCHEMATIC DIAGRAM	SHEET No.  Queensland Urban Utilities DRAWING No. <b>486/4/9-0791-002</b>	AMEND.  <b>A</b>			
A	07-10	MINOR REV FOR CONSTRUCTION	AP	GA	DRAFTING CHECK	P.MOSTERT 04.10	DESIGN	R.P.E.Q. No.						DATE	PRINCIPAL DESIGN MANAGER	DATE
O	04-10	FOR CONSTRUCTION	E.P.	AW	CAD FILE	49-0770SetO.dwg	* A.WITTHOFT	8895						5/5/10	* P.SHERRIFF	5/5/10
No.	DATE	AMENDMENT	DRN.	APD.	B.C.C. FILE No.		DESIGN CHECK	R.P.E.Q. No.						DATE	CLIENT DELEGATE	DATE



NOTES

1 ALL FUSES ARE 500mA EXCEPT WHERE NOTED OTHERWISE.

ELECTRICAL AS BUILT DETAILS

REV	COMPANY	-	DATE	-
-	ELECTRICIAN	-		
-	LICENCE No.	-		

SHEET 03

FOR CONSTRUCTION


DRAFTED				E.PARANAGAMA 04.10				* A.CHAVEZ-PLASENCIA				7/5/10			
DRAFTING CHECK				P.MOSTERT 04.10				DESIGN				PRINCIPAL DESIGN MANAGER			
O 04-10				FOR CONSTRUCTION				E.P. AW				8895 5/5/10			
No. DATE				AMENDMENT				DRN. APD.				5/5/10			
Q-Pulse Id TMS471				B.C.C. FILE No.				DESIGN CHECK				CLIENT DELEGATE			



SITE  
P0315  
GREENTREES AVE, KENMORE HILLS  
PRESSURE GAUGE  
ELECTRICAL INSTALLATION

TITLE  
DIGITAL INPUTS AND OUTPUTS  
TERMINATION DIAGRAM

SHEET No.		AMEND.
Queensland Urban Utilities DRAWING No.		
486/4/9-0791-003		O

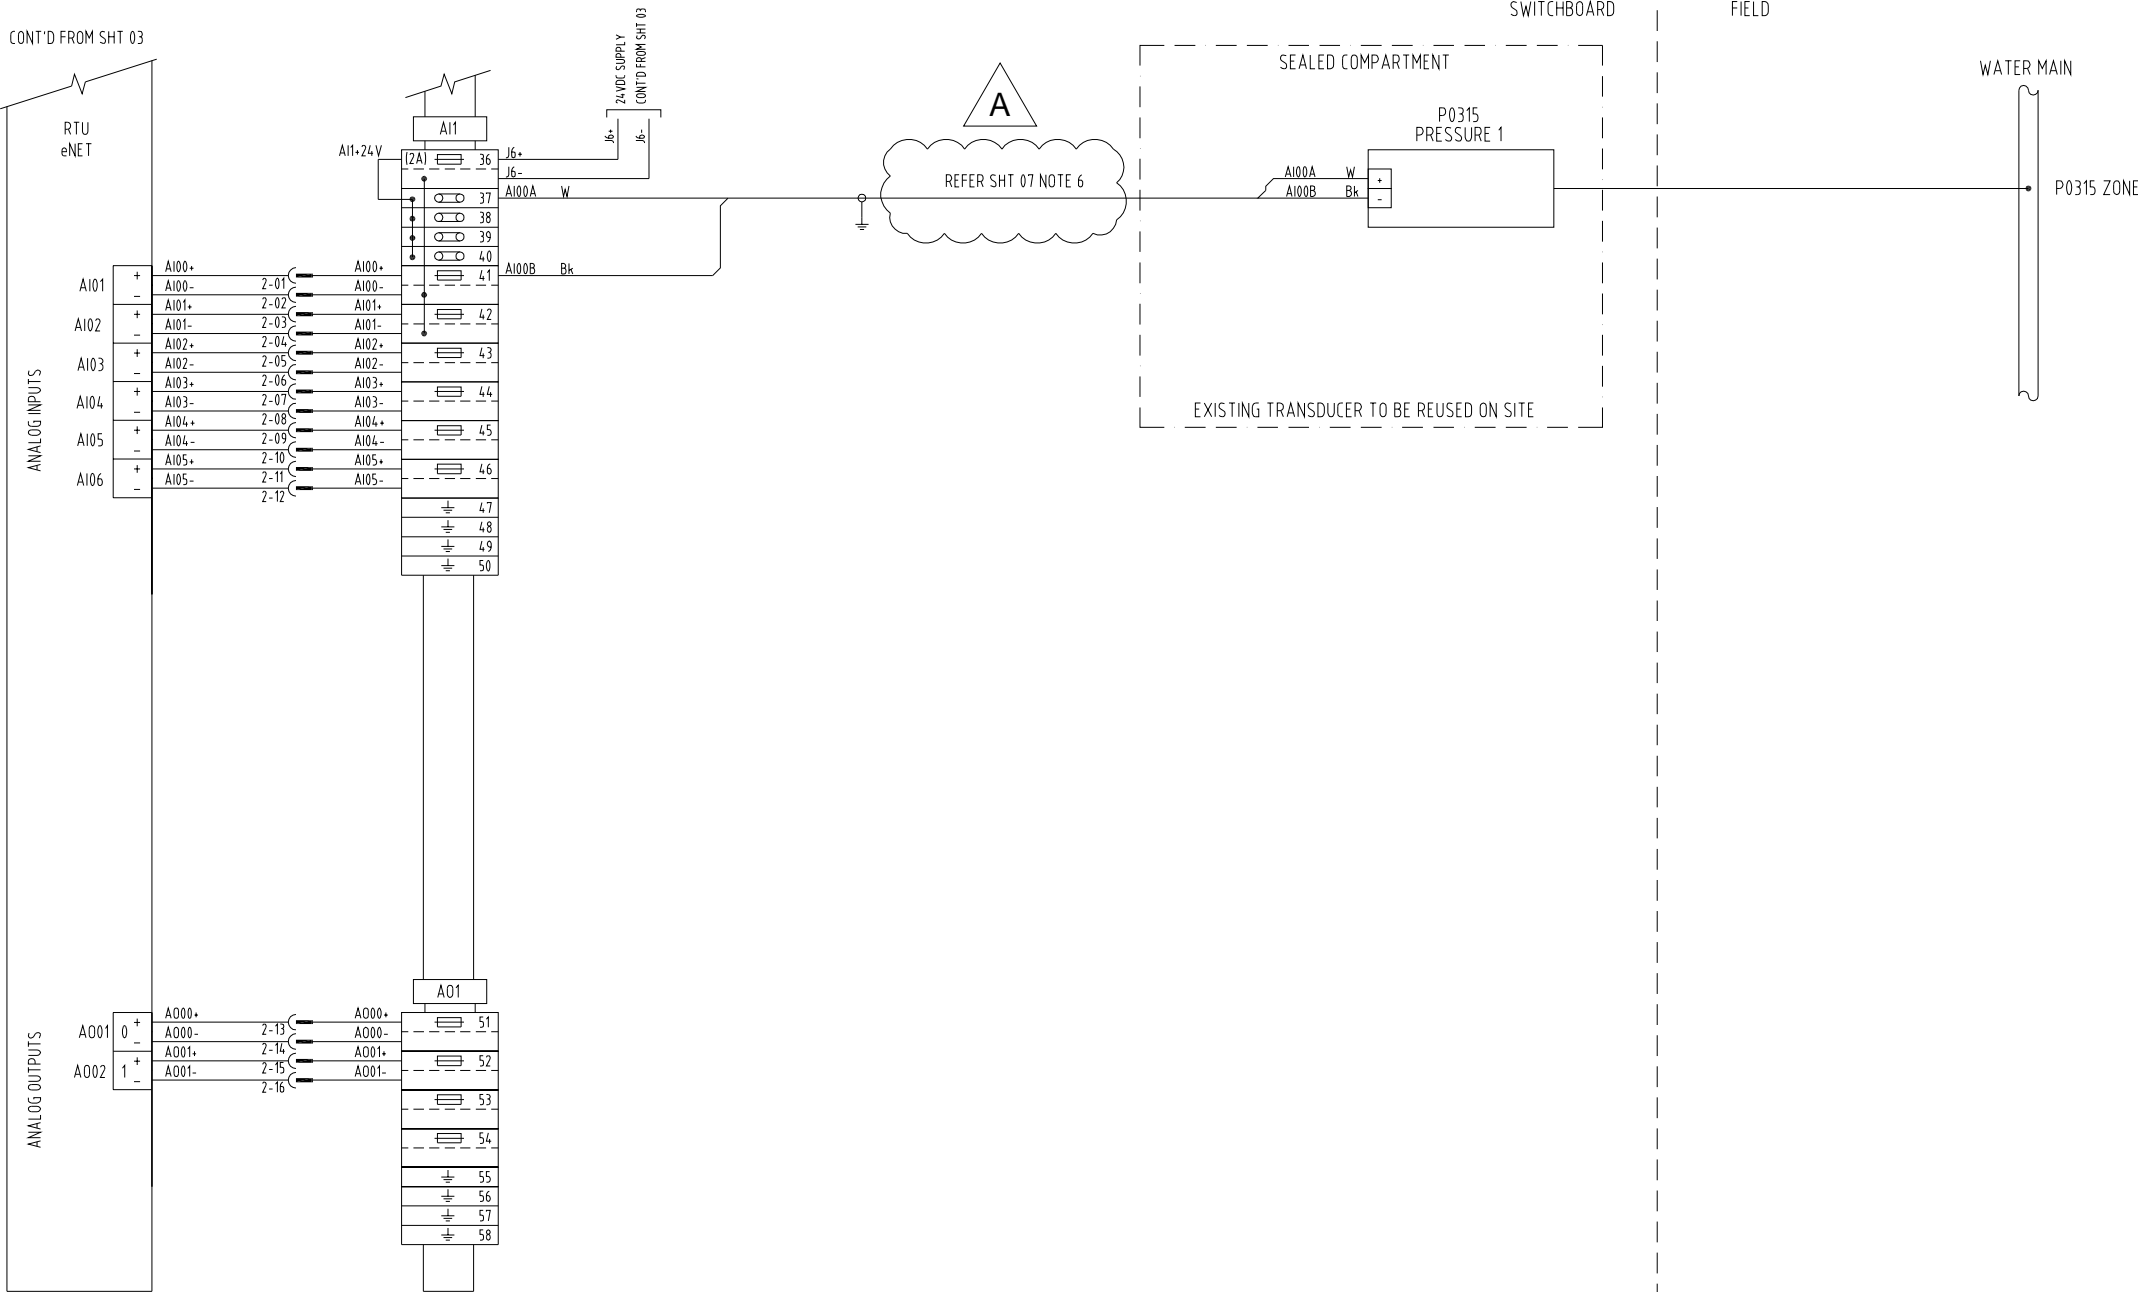

NOTES

1. ALL FUSES ARE 500mA EXCEPT WHERE NOTED OTHERWISE

ELECTRICAL AS BUILT DETAILS			
REV	COMPANY	-	
-	ELECTRICIAN	-	
	LICENCE No.	-	DATE: -

SHEET 04

FOR CONSTRUCTION

No.	DATE	AMENDMENT	DRN.	APD.	B.C.C. FILE No.
A	06-10	MINOR REV FOR CONSTRUCTION	DPM	GA	DRAFTING CHECK P.MOSTERT 04.10
O	04-10	FOR CONSTRUCTION	E.P.	AW	CAD FILE 49-0770SetO.dwg

* A.CHAVEZ-PLASENCIA	7/5/10
DESIGN	R.P.E.Q. No. DATE
* A.WITTHOFT	8895 5/5/10
DESIGN CHECK	R.P.E.Q. No. DATE


* K.VAHEESAN	7/5/10
PRINCIPAL DESIGN MANAGER	DATE
* P.SHERRIFF	5/5/10
CLIENT DELEGATE	DATE



SITE	P0315
GREENTREES AVE, KENMORE HILLS	
PRESSURE GAUGE	
ELECTRICAL INSTALLATION	

TITLE	ANALOG INPUTS AND OUTPUTS TERMINATION DIAGRAM
-------	---



SHEET No.	486/4/9-0791-004	AMEND.	A
Queensland Urban Utilities DRAWING No.			

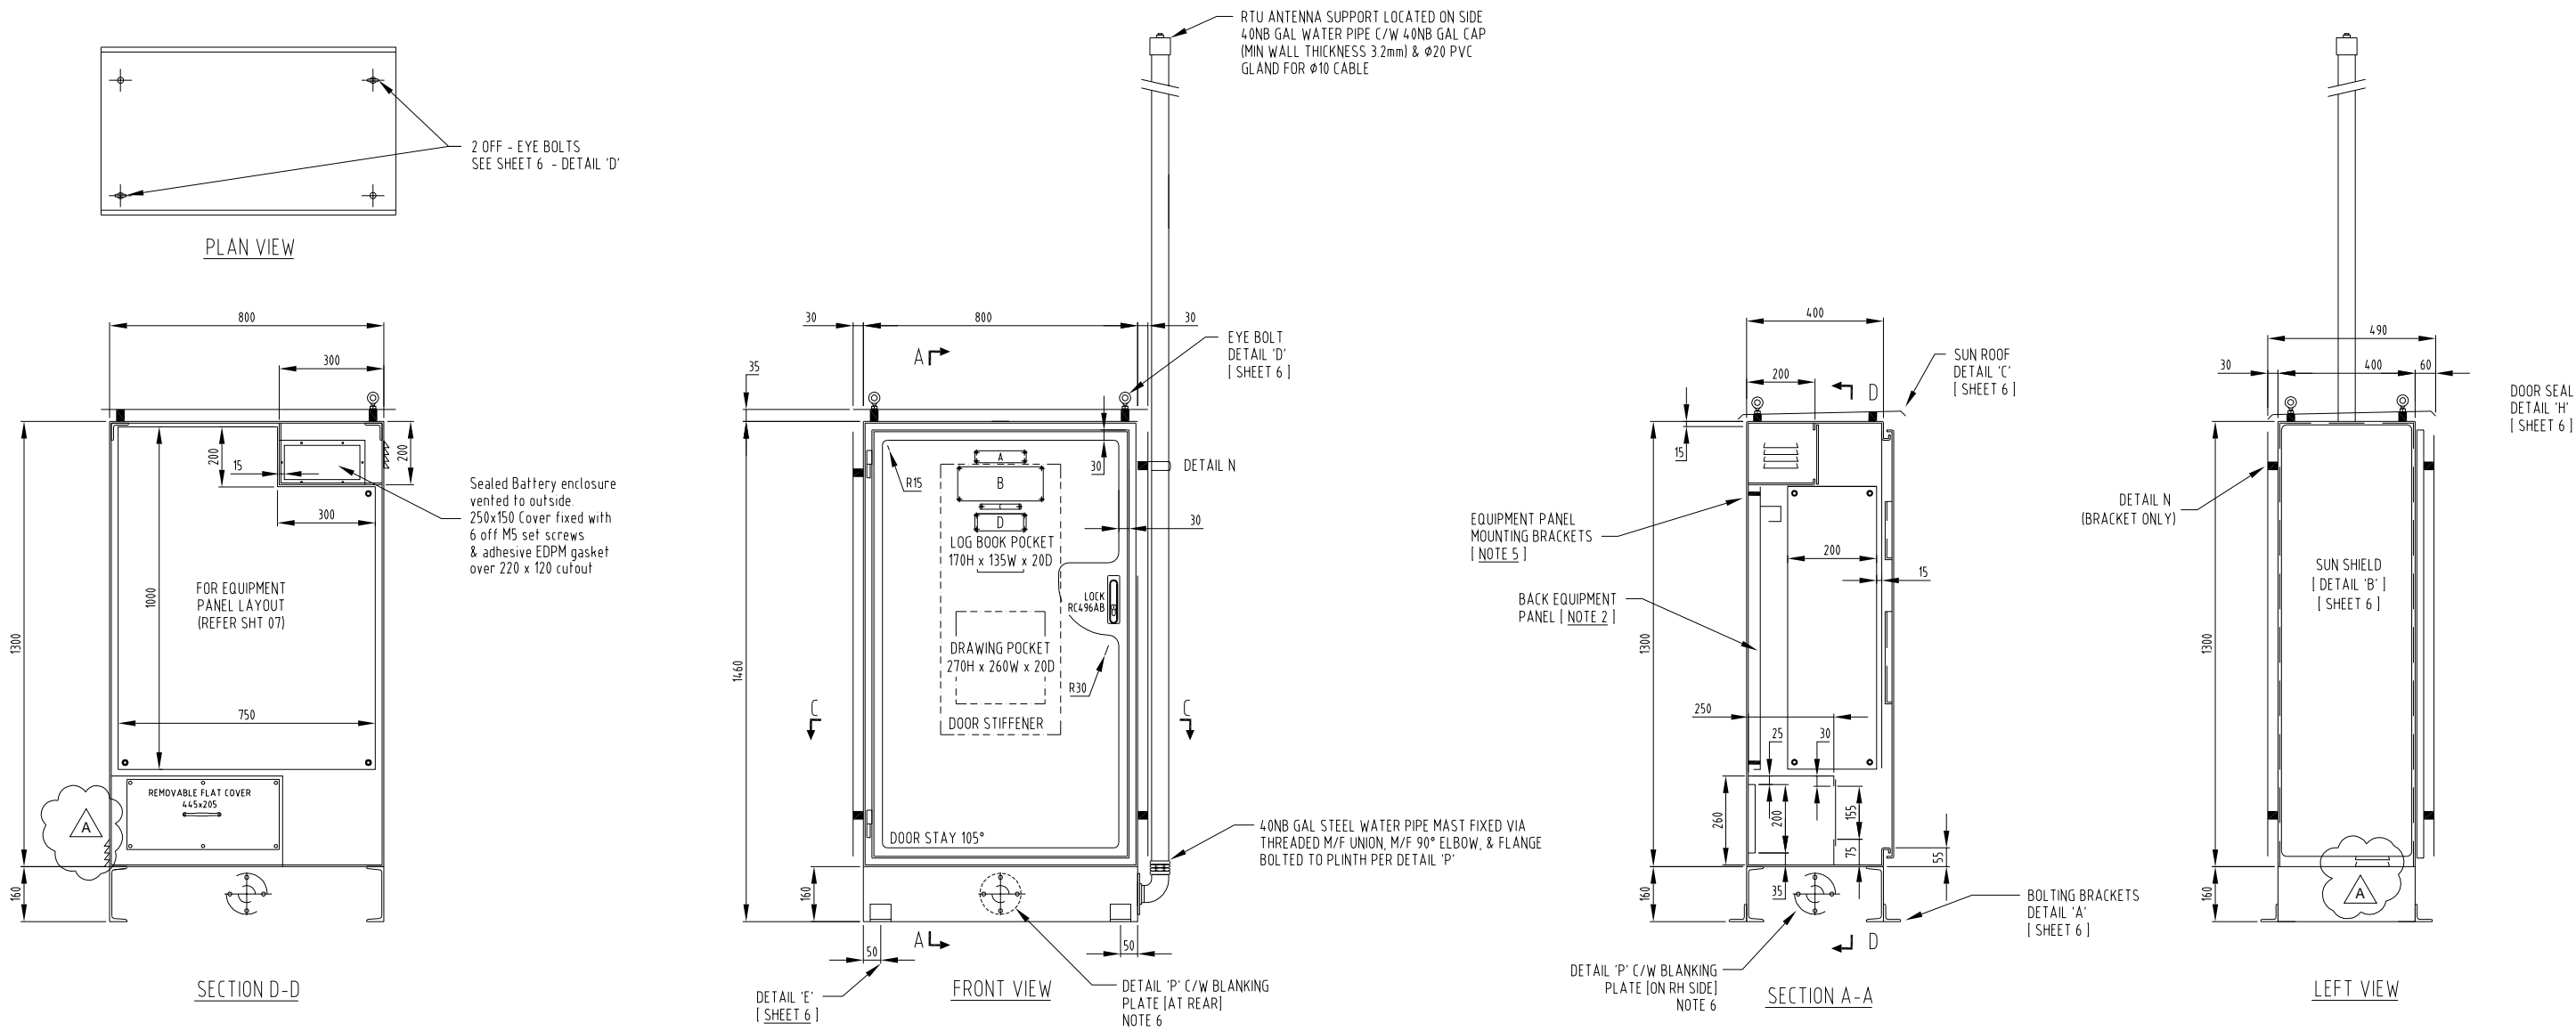

GENERAL ARRANGEMENT

SCALE: 1/10 ON A1 SIZE PRINT


- NOTES:
- 1. REFER TO SHEET 06 FOR THE SWITCHBOARD CONSTRUCTION DETAILS.
  - 2. SIDE & BACK EQUIPMENT PANELS TO BE MOUNTED 40mm OFF THE SIDE & BACK WALLS AND OPEN AT BOTH THE TOP AND BOTTOM TO ALLOW FOR AIR FLOW.
  - 3. REFER TO SHEET 07 FOR THE EQUIPMENT PANEL LAYOUT DETAIL AND EQUIPMENT SCHEDULE.
  - 4. BACK & SIDE GEAR MOUNTING BRACKETS [ 6 OFF TOTAL] [ 25 X 25 X 3 (TYP)].
  - 5. THIS DRAWING TO BE READ IN CONJUNCTION WITH SHEET 06, FOLLOWING.
  - 6. ANTENNA FLANGE MOUNTING DETAILS:- WHERE NO ANTENNA IS TO BE INSTALLED, PROVIDE Ø120 BLANKING PLATES WITH GASKETS, TO COVER SIDE AND REAR ANTENNA FLANGE DRILLING POSITIONS.

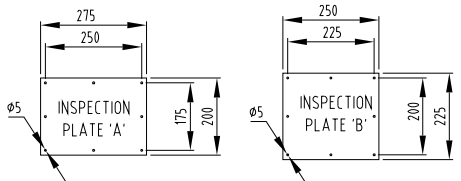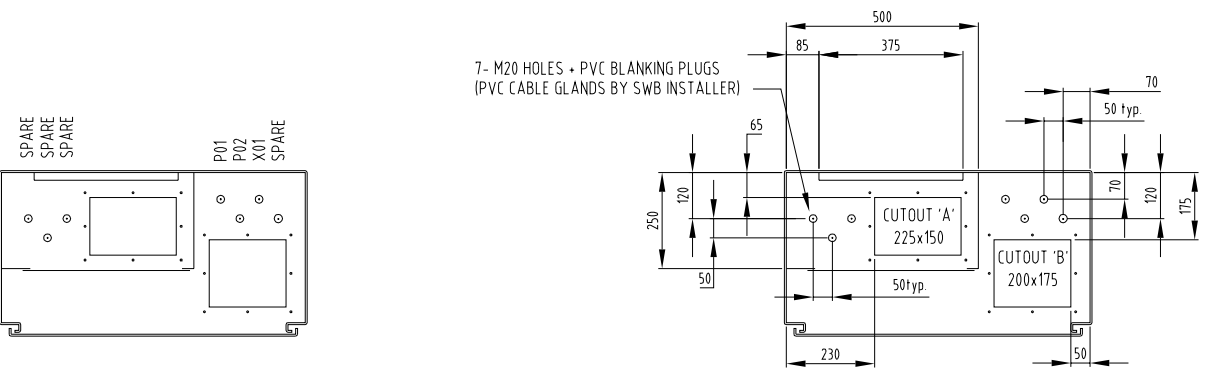

INSPECTION PLATE  
3mm AL + GASKET + M4 SCREWS

ELECTRICAL AS BUILT DETAILS				
REV	COMPANY	-		
-	ELECTRICIAN	-		
	LICENCE No.	-		DATE: -

SHEET 05  
FOR CONSTRUCTION

				DRAFTED		E.PARANAGAMA 04.10		* A.CHAVEZ-PLASENCIA		* K.VAHEESAN		7/5/10				SITE P0315 GREENTREES AVE, KENMORE HILLS PRESSURE GAUGE ELECTRICAL INSTALLATION		TITLE SWITCHBOARD GENERAL ARRANGEMENT		SHEET No.	
A	07-10	MINOR REV FOR CONSTRUCTION		AP	GA	DRAFTING CHECK	P.MOSTERT 04.10	DESIGN	R.P.E.Q. No.	DATE	PRINCIPAL DESIGN MANAGER	DATE	Queenland Urban Utilities DRAWING No.							AMEND.	
O	04-10	FOR CONSTRUCTION		E.P.	AW	CAD FILE	49-0770SetO.dwg	* A.WITTHOFT	8895	5/5/10	* P.SHERIFF	5/5/10	486/4/9-0791-005							A	
No	DATE	AMENDMENT		DRN.	APD.	B.C.C. FILE No.		DESIGN CHECK	R.P.E.Q. No.	DATE	CLIENT DELEGATE	DATE									

CONSTRUCTION

Cubicle construction 3mm Marine grade Aluminium (5251).  
Plinth construction 160x60 channel 6061 T6 Grade Aluminium.  
Folded, "Pulse MIG" & "TIG welded" with all visible seams and joints fully welded, free from splatter and ground smooth where needed.  
External doors and covers fitted with Emka 1011-207 self grip seal.  
"D" Handles fitted where indicated on the drawings.  
M6 Earth studs fixed to the interior of all doors and hinged escutcheons and on adjacent cubicle interior surfaces.  
Door stiffeners, door stays, cable straps, and document holders etc fitted where shown on the drawings.  
Lift-off covers and mounting panels fixed with M8 studs & chrome acorn nuts.  
Gland plates manufactured from 6mm Bakelite.  
Gland plate openings reinforced with 25x6mm flat aluminium bar.  
Gland plate seals attached to cubicle not gland plate.  
Gland plate fixings are NOT more than 150 mm apart  
Hinges Selectrix HI-B650.  
Star washers fitted under all hinge screws.  
Lock Door  
Selectrix 1107 - PSCU1 handle  
Selectrix 1107-U123 3pt cam  
Lockwood 71 Barel Lock  
Emka 1049-U3 roller rod  
Lock Code RC496AB

PAINTING

Aluminium Surface Preparation.  
Finish smooth all exposed welds, clean, descale, and degrease all surfaces.  
Surfaces pretreatment in accordance with AS 1580 & AS 3715 using Novox LF acid etch cleaner, Novacoat 12 conversion coating, & clean water rinses  
Apply DULUX ALPHATECH 3000 powder coat to manufacturer's recommendations.  
CUBICLE & EXTERNAL COMPONENTS :- DULUX Mist Green (36648) matt finish.  
INTERIOR ITEMS (mounting panels, escutcheons, etc.) :- DULUX Bright White (32166)  
Minimum Dry Film Thickness all surfaces 40 microns.

OPERATING PARAMETERS

Standard	AS 3439.1
Current & Frequency	AC 50Hz
Rated Operational Voltage Ue	240 VAC
Rated Insulation Voltage Ui	660 V
Rated Auxiliary Voltage	24 VDC / 240 VAC
Rated Current (Main Bus)	N/A
Short Circuit Current Isc	10 kA
Duration of Isc	1 sec
Degree of Protection	1P 55 to AS 1939
Measure of Protection by barriers and enclosures	
Service Conditions	Outdoors
Mass	Not exceeding 200kg
Forms of Segregation	Form 1
Earthing System	TN-S

WIRING

All wiring to be PVC V90 HT 0.6/1Kv Grade with tinned conductor.  
Control and instrumentation wiring has flexible copper conductors, and is colour coded as detailed below, numbered each end, and terminated by the use of appropriate pre-insulated crimp lugs.  
Power wiring to be minimum 2.5sqmm stranded copper conductors, phase colour coded as detailed below.  
Earth cables minimum 2.5sqmm flexible.  
Doors and hinged escutcheons bonded with 4sqmm flexible earth strap.  
Wire numbering will be equal to Grafoplast SJ2000 system.  
Wire numbers are readable left to right, bottom to top as shown.

COLOUR CODE

Phase wiring (A,B &C)	Red, White, Blue	2.5sqmm (min)
Potential Metering (240/415 VAC)	Red, White, Blue, Black	1.5sqmm
Current Metering (Secondary)	Red, White, Blue, Grey	2.5sqmm
240 VAC Control Active	Red	1.5sqmm
240 VAC Neutral	Black	1.5sqmm
24 V ELV Positive	Orange	1.5sqmm
24 V ELV Negative	Violet	1.5sqmm
24 V RTU Positive	Orange	0.5sqmm
24 V RTU Negative	Violet	0.5sqmm
RTU Wiring	Grey	0.5sqmm
Intrinsically safe wiring	Blue	1.5sqmm
Earth	Green/Yellow	2.5sqmm (min)
Door & Escutcheon Earth Bonds	Green/Yellow	4 sqmm

LABELS

Internal labels W/B/W engraved traffolyte to label schedule.  
Warning labels R/W/R engraved traffolyte.

Main switch labels

MAIN SWITCH  
16A

Material B/W/W



Warning labels

DANGER 240V  
ISOLATE ELSE WHERE


Material R/W/R

Internal labels secured by M3 chrome plated metal threads.  
Labels obstructed by switchboard wiring are relocated to adjacent duct lid.  
The duct lid is secured by a single cable tie at one corner.

External labels secured by M3 316 stainless steel metal threads.

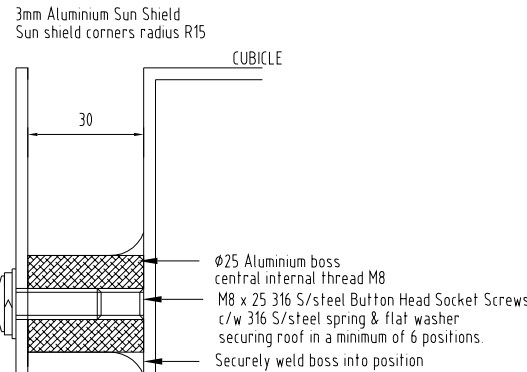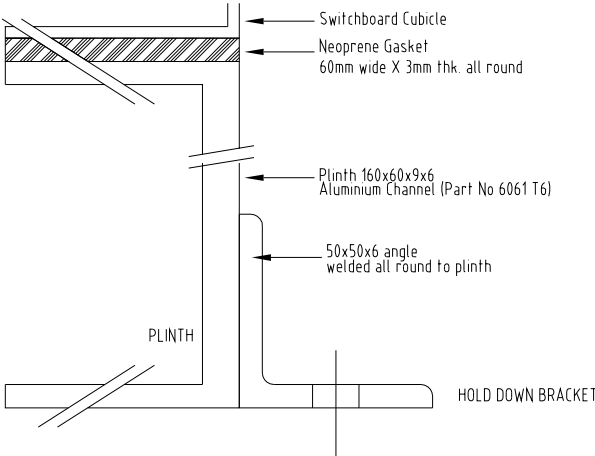


DETAIL B  
(SUN SHIELD MOUNTING TO SIDES, REAR AND DOORS)

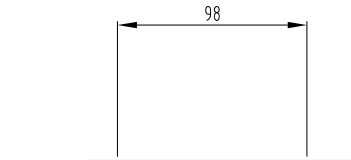


(FIT 3m  
(FIXINGS 316 S/STEEL BOLTS, NUTS, FLAT & SPRING WASHERS)  
(AERIAL FLANGE MOUNTING DETAIL)

2 OFF M8x80 S/S EYEBOLTS, DIAGONALLY OPPOSITE

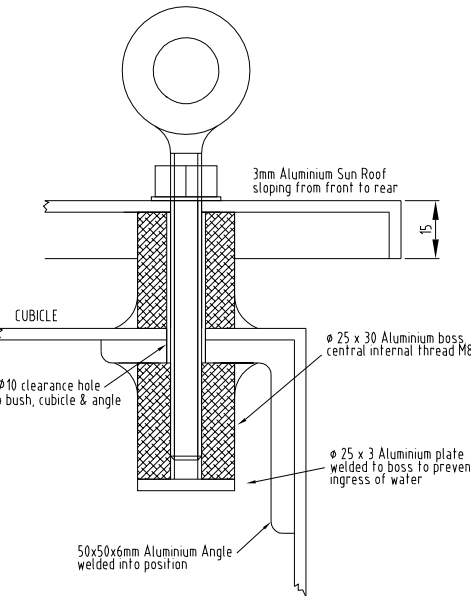


DETAIL D  
(EYE BOLT FIXING DETAIL - 2 OFF M8x80 s/s, DIAGONALLY OPPOSITE)


SET UP CUBICLE TO BE LEVEL & PLUMB BEFORE  
BOLTING TO CONCRETE PLINTH USING M12 BOLTS

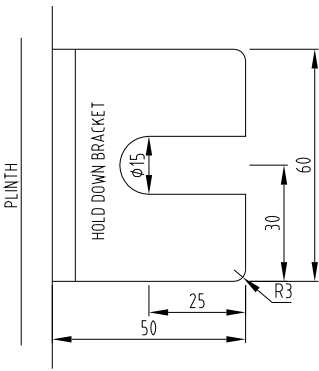


DETAIL E  
(BOLTING DOWN FACILITIES DETAIL)

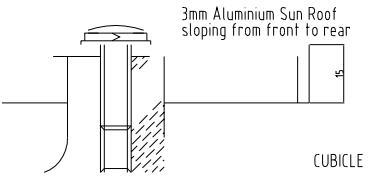

CUBICLE

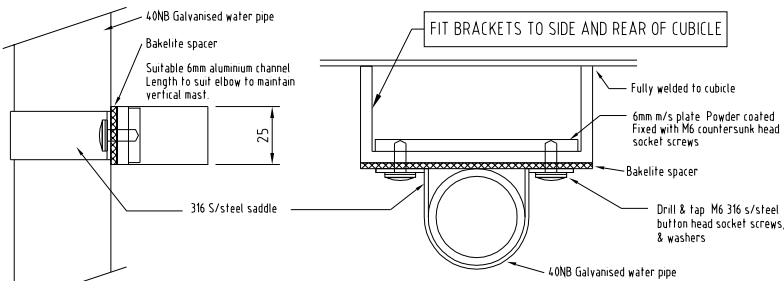


DETAIL N  
(AERIAL SUPPORT BRACKET DETAIL)

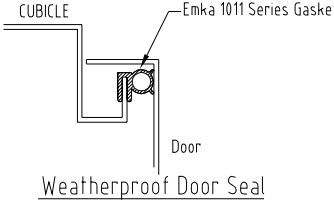

ELECTRICAL AS BUILT DETAILS			
REV	COMPANY	-	
-	ELECTRICIAN	-	
	LICENCE No.	-	DATE: -


SHEET 06

FOR CONSTRUCTION

				DRAFTED		E.PARANAGAMA 04.10		* A.CHAVEZ-PLASENCIA		* K.VAHEESAN		7/5/10			SITE P0315 GREENTREES AVE, KENMORE HILLS PRESSURE GAUGE ELECTRICAL INSTALLATION	TITLE SWITCHBOARD CONSTRUCTION DETAILS	SHEET No.					
				DRAFTING CHECK		P.MOSTERT 04.10		DESIGN		R.P.E.Q. No. DATE		PRINCIPAL DESIGN MANAGER					DATE		Queensland Urban Utilities DRAWING No.		AMEND.	
O 04-10 FOR CONSTRUCTION				E.P. AW		CAD FILE		49-0770SetO.dwg		* A.WITTHOFT		8895 5/5/10					* P.SHERRIFF		5/5/10			486/4/9-0791-006
No. DATE AMENDMENT				DRN. APD.		B.C.C. FILE No.				DESIGN CHECK		R.P.E.Q. No. DATE					CLIENT DELEGATE		DATE			

EQUIPMENT LIST

REF	QTY	DESCRIPTION	MANUFACTURER	CATALOGUE No	REMARKS
01	1	Q1 - MAIN CIRCUIT BREAKER	TERASAKI	DTCB10_16	10kA
02	5	POLE FILLER	TERASAKI	DT POLE FILLER	
03	2	IP30 8 POLE COVER	TERASAKI	DTPC8	
04	1	SD1 - SURGE DIVERTER	NHP	TITIAN DR1P45K230DC	45KA MAX
05	1	Q2 - GPO CIRCUIT BREAKER	TERASAKI	DTCB10_02	
06	1	GPO - COMPUTER OUTLET 30mA RCD	CLIPSAL	2A CB + RCD	
07	1	Q3 - SURGE FILTER CIRCUIT BREAKER	TERASAKI	DTCB10_06	
08	1	SF1 - SURGE FILTER	CRITEC	DSF-6A-275	
09	1	Q4 - PWR SUPPLY CIRCUIT BREAKER	TERASAKI	DTCB10_04	
10	1	Q5 - SURGE ALARM RLY CIRCUIT BREAKER	TERASAKI	DTCB10_02	
11	1	SAR- SURGE PROTN ALARM RLY	CRITEC	DAR-275V	
12	1	Q6 - POWER FAILURE RLY CIRCUIT BREAKER	TERASAKI	DTCB10_02	
13	1	PFR - POWER FAILURE RELAY	FINDER	38.51240VAC	
14	2	NEUTRAL LINK	CLIPSAL	LA6	
15	1	EARTH LINK	CLIPSAL	BP165D18	
16					
17					
18					
19	2	SW/BD DOOR MICRO SWITCHES	CAMSCO	SM202	1 OFF N/O 1 OFF N/C
20	1	SW/BD 8W INTERNAL FLUORO LIGHTS	THORN	BB0108	
21	1	CORROSION INHIBITOR	CORTEC	VPCI-110 OR 111	FROM AP CONTROLS
22	1	RTU	SERCK	eNET -5XEW-EI	eNET RTU WITH 1/2 I.O., 10-30V INPUT.
23	2	DISCONNECT PLUGS	PHOENIX CONTACT	MSTB 2,5/20-ST-5 08	
24	2	DISCONNECT BLOCKS	PHOENIX CONTACT	UMSTBVK2,5/20-G-5 08	
25	2	CABLE HOUSING	PHOENIX CONTACT	KGS-MSTB2 5/20	
26	1	CODING PINS	PHOENIX CONTACT	CP-MSTB + CR-MSTB	
27	Lot	FUSED TERMINALS with LED 24V INDICATION	PHOENIX CONTACT	UT4-HESI LED24 (5x20)	
28	Lot	FUSE CARTRIDGES	PHOENIX CONTACT	M205	RATINGS AS REQUIRED
29	Lot	DISCONNECT TERMINALS	PHOENIX CONTACT	UT4-MT P/P	
30	Lot	TERMINALS	PHOENIX CONTACT	UT4-?	
31	8	EARTH TERMINALS	PHOENIX CONTACT	UT4-MTD-PE/S	
32	6	GROUP MARKER CARRIER	PHOENIX CONTACT	UBE	
33	2	TEST PLUG ADAPTOR	PHOENIX CONTACT	PS-6	
34	1	SCREW DRIVER	PHOENIX CONTACT	SZS 0.6 x 3.5	
35	Lot	PLUG-IN BRIDGE	PHOENIX CONTACT	FBS	AS REQUIRED
36					
37	2	PRESSURE TRANSDUCER	EXISTING	EXISTING	INSTALLER TO REUSE EXISTING
38					
39	2	12V 6.5Ah SEALED LEAD ACID BATTERY	YUASA	NP7-12	
40					
41	1	PS1 - RTU 24VDC POWER SUPPLY	POWERBOX	PB251-24CM-CC-T	
42					
43					
44					
45					
46					
47	1	24V/13.8V DC CONVERTER	POWERBOX	PB1H-2412G	
48	1	RADIO	TRIO	DR900-07A02-D0	FREE ISSUE
49	1	SD2 - RADIO COAX SURGE PROTECTOR	POLYPHASE CORPORATION	IS-50NX-C2	
50	1	ANTENNA MAST	SWBD MANUFACTURER		6.0 METRES
51	1	ANTENNA	TRIO	ANT13AL	SUPPLIED LOOSE BY SWBD MFR & FITTED ON SITE
52	1	INTERNAL COAX CABLE (Radio to Lightning Arrester)	TRIO	TRIO - SMAM/NM/TL23	Cable No X01
53	1	EXTERNAL COAX CABLE (Lightning Arrester to Aerial)	R.F. INDUSTRIES	ANDREW - CNT400	Cable No X02
54	1	COAX PLUG	R.F. INDUSTRIES	SMA	SUPPLIED LOOSE BY SWBD MFR & FITTED ON SITE
55	1	COAX PLUG	R.F. INDUSTRIES	N88 (MALE)	SUPPLIED LOOSE BY SWBD MFR & FITTED ON SITE
56	2	COAX PLUG (For CNT400 cable)	PULSE	N-203HS	Straight plug crimp ( Cable No X02 )
57	1	U-CLAMP	R.F. INDUSTRIES	UNV	SUPPLIED LOOSE BY SWBD MFR & FITTED ON SITE
58					
59					
60					
61					
62					

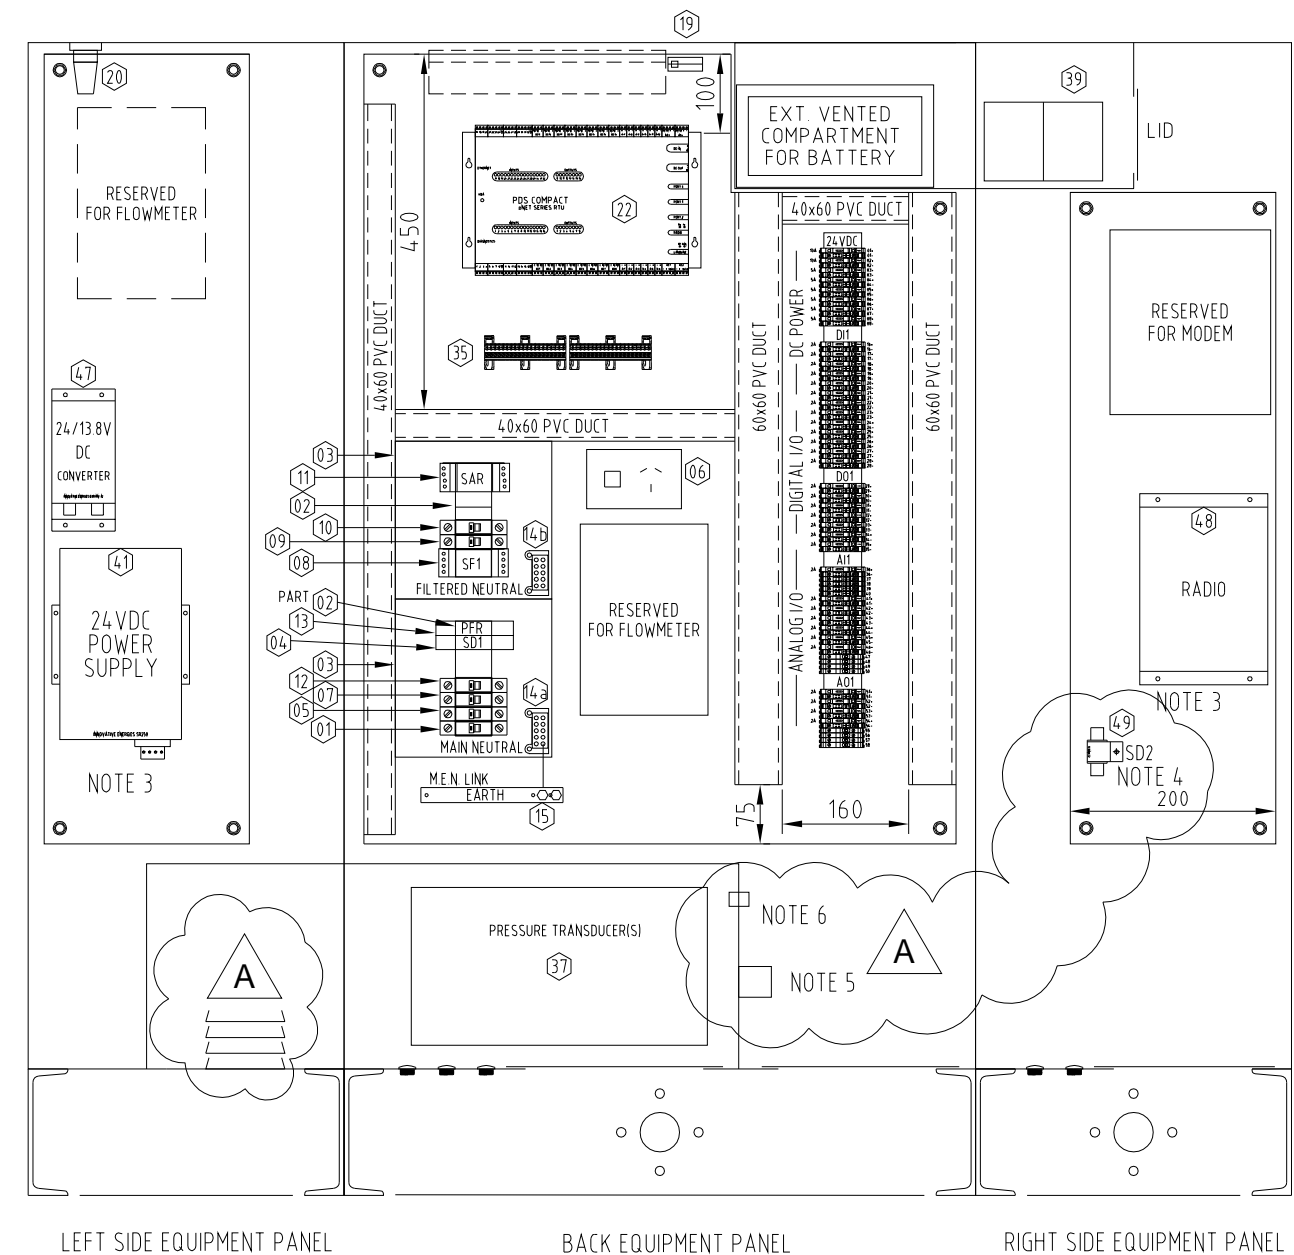

EQUIPMENT PANEL - LAYOUT DETAIL

SCALE: 1/5 ON A1 SIZE PRINT

NOTES:


1. LABELS FITTED ADJACENT ASSOCIATED EQUIPMENT
2. LABELS OBSTRUCTED BY SWITCHBOARD WIRING ARE RELOCATED TO ADJACENT DUCT LID  
DUCT LIDS LOCATED BY SINGLE CABLE TIE AT ONE CORNER
3. INDICATING LIGHTS ON THE 24V DC POWER SUPPLY AND THE RADIO MUST FACE UPWARDS.

4. USE STAR WASHER BETWEEN SD2 & PANEL TO FIX SD2 IN POSITION, OR USE DIN RAIL FOR MOUNTING SD2.
5. INCOMING IP30 240V TERMINALS WIRED TO Q1 & NEUTRAL BAR IN FACTORY.
6. FACTORY PREWIRE PRESSURE Tx SIGNAL CABLE THRU PVC GLAND TO MARSHALLING TERMINALS.

ELECTRICAL AS BUILT DETAILS			
REV	COMPANY	-	
-	ELECTRICIAN	-	
-	LICENCE No.	-	DATE: -

SHEET 07

FOR CONSTRUCTION

				DRAFTED		E.PARANAGAMA 04.10		* A.CHAVEZ-PLASENCIA		7/5/10			SITE P0315 GREENTREES AVE, KENMORE HILLS PRESSURE GAUGE ELECTRICAL INSTALLATION	TITLE SWITCHBOARD EQUIPMENT LIST	SHEET No.		
A	06/10	MINOR REV FOR CONSTRUCTION		DPM	GA	DRAFTING CHECK	P.MOSTERT 04.10	DESIGN	R.P.E.Q. No.	DATE	PRINCIPAL DESIGN MANAGER				DATE	Queensland Urban Utilities DRAWING No.	AMEND.
O	04-10	FOR CONSTRUCTION		E.P.	AW	CAD FILE	49-0770SetO.dwg	* A.WITTHOFT	8895	5/5/10	* P.SHERRIFF				5/5/10	486/4/9-0791-007	A
No.	DATE	AMENDMENT		DRN.	APD.	B.C.C. FILE No.		DESIGN CHECK	R.P.E.Q. No.	DATE	CLIENT DELEGATE				DATE		

## CABLE SCHEDULE

[illegible]

NOTES

1. REUSE THE EXISTING INCOMING MAINS CABLE,  
EXTENDING AS NECESSARY TO TERMINATE IN NEW MAIN CB.

## EQUIPMENT LABEL LIST

REF	TEXT HEIGHT mm / MATERIAL	TEXT LINE 1 / TEXT LINE 2
01	10mm / 4mm / WBW TRAFFOLYTE	MAIN SWITCH / Q1 - 16A
04	4mm / WBW TRAFFOLYTE	SD1 - SURGE DIVERTER
05	4mm / WBW TRAFFOLYTE	Q2 - LAPTOP GPO - 2A
06	4mm / WBW TRAFFOLYTE	2Amp LAPTOP ONLY
07	4mm / WBW TRAFFOLYTE	Q3 - SURGE FILTER - 6A
08	4mm / WBW TRAFFOLYTE	SF1 - SURGE FILTER
09	4mm / WBW TRAFFOLYTE	Q4 - 24V PWR SUPPLY - 4A
10	4mm / WBW TRAFFOLYTE	Q5 - SURGE ALMRLY - 2A
11	4mm / WBW TRAFFOLYTE	SAR - SURGE ALMRLY
12	4mm / WBW TRAFFOLYTE	Q6 - POWER FAIL RLY - 2A
13	4mm / WBW TRAFFOLYTE	PFR - POWER FAIL RLY
14	4mm / WBW TRAFFOLYTE	NEUTRAL
15	4mm / WBW TRAFFOLYTE	EARTH
18		
19	4mm / WBW TRAFFOLYTE	PS1 - 24VDC10A PWR SUPPLY
20	4mm / WBW TRAFFOLYTE	24/13.8VDC CONVERTER
21	4mm / WBW TRAFFOLYTE	BATTERY COMPARTMENT
22	4mm / WBW TRAFFOLYTE	RTU
24		
25		
28		
29		
45		

## EQUIPMENT LABEL LIST

[illegible]

## EXTERNAL LABELS

LABEL	TEXT	TEXT HEIGHT	PAINT FILL LETTERING	DIMENSIONS	QTY
A	P0315	20mm	BLACK	150X35	1
B	<p style="text-align: center;"><u>WARNING</u></p> <p style="text-align: center;">THIS SITE IS MONITORED BY THE CONTROL ROOM OPERATOR PLEASE INFORM THE OPERATOR BEFORE ISOLATING STATION</p>	8mm	BLACK	250X100	1
C	DANGER 240V	8mm	RED	120X15	1
D	<p>REMINDER:</p> <p>THIS IS AN UN-METERED SUPPLY AND ANY ALTERATIONS TO THESE CIRCUITS MUST BE NOTIFIED TO SUPPLY AUTHORITY BILLING DEPARTMENT.</p>	3mm	BLACK	TO SUIT	1
EXTERNAL LABELS 1mm THK. 316 GRADE STAINLESS STEEL FIXED WITH M3 316 STAINLESS STEEL METAL THREADS.					

ELECTRICAL AS BUILT DETAILS	
REV	COMPANY -
-	ELECTRICIAN -
	LICENCE No. - DATE: -

SHEET 08

FOR CONSTRUCTION



SHEET No.		
Queensland Urban Utilities	DRAWING No.	AMEND
486/4/9-0791-008		A

						DRAFTED	E.PARANAGAMA 04.10	* A.CHAVEZ-PLASENCIA		* K.VAHEESAN		7/5/10
A	06/10	MINOR REV FOR CONSTRUCTION	DPM	GA	DRAFTING CHECK	P.MOSTERT	04.10	DESIGN	R.P.E.Q. No.	DATE	PRINCIPAL DESIGN MANAGER	DATE
O	04-10	FOR CONSTRUCTION	E.P.	AW	CAD FILE	49-0770SetO.dwg		* A.WITTHOFT	8895	5/5/10	* P.SHERRIFF	5/5/10
No	DATE	AMENDMENT	DRN.	APD.	B.C.C. FILE No.			DESIGN CHECK	R.P.E.Q. No.	DATE	CLIENT DELEGATE	DATE




SITE  
P0315  
GREENTREES AVE, KENMORE HILLS  
PRESSURE GAUGE  
ELECTRICAL INSTALLATION

TITLE  
SWITCHBOARD  
CABLE & LABEL SCHEDULE

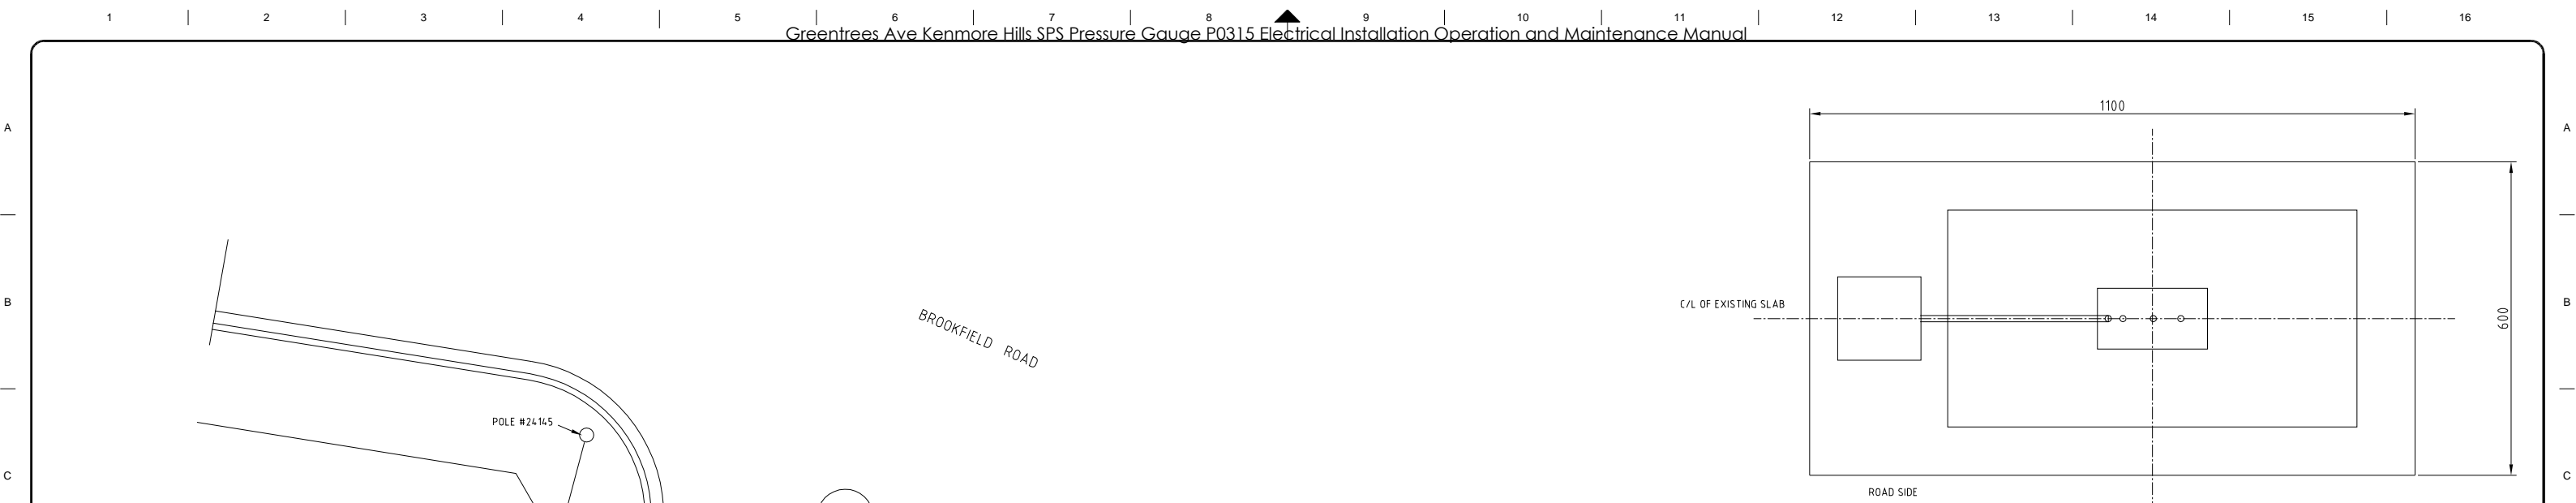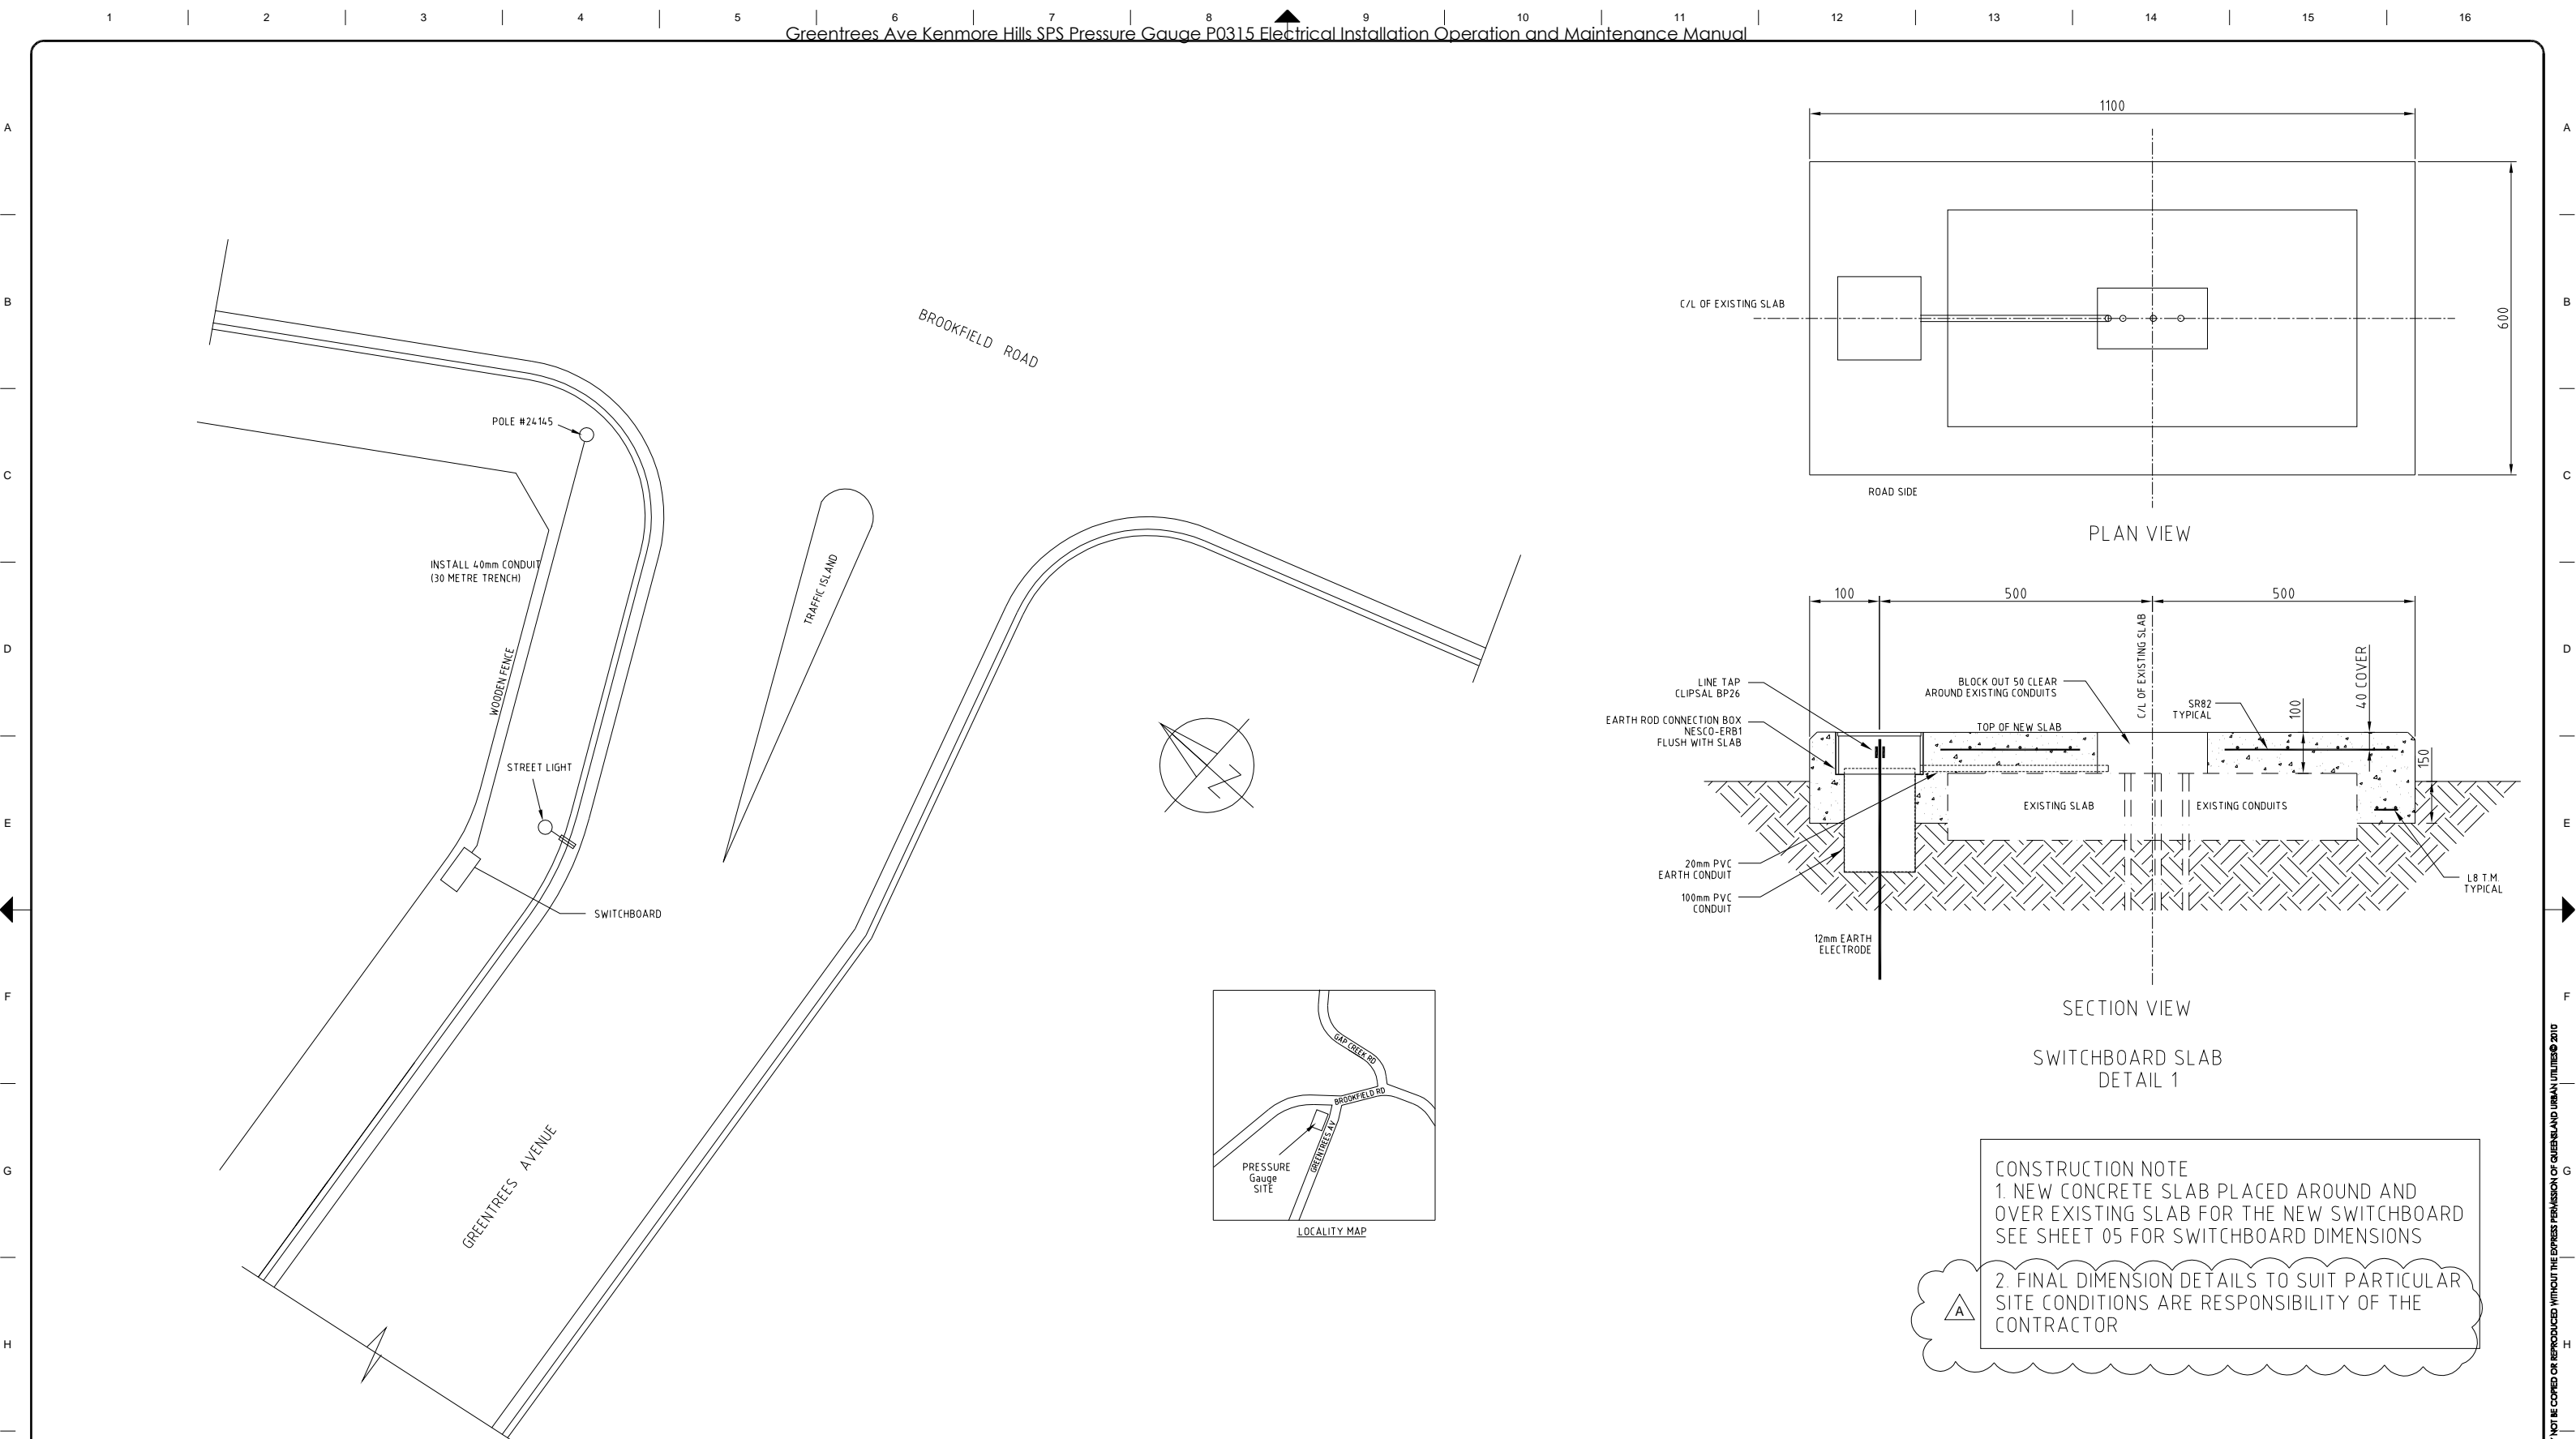

The site plan on the left shows the proposed location of the electrical installation relative to Brookfield Road and Pole #24145. The plan view on the right shows the layout of the proposed electrical installation, including the existing slab, the proposed slab, and the proposed electrical equipment. The plan view shows a rectangular area with a width of 600 and a length of 1100. The existing slab is shown as a dashed line, and the proposed slab is shown as a solid line. The proposed electrical equipment is shown as a rectangle within the proposed slab. The plan view is labeled "PLAN VIEW" and "ROAD SIDE".

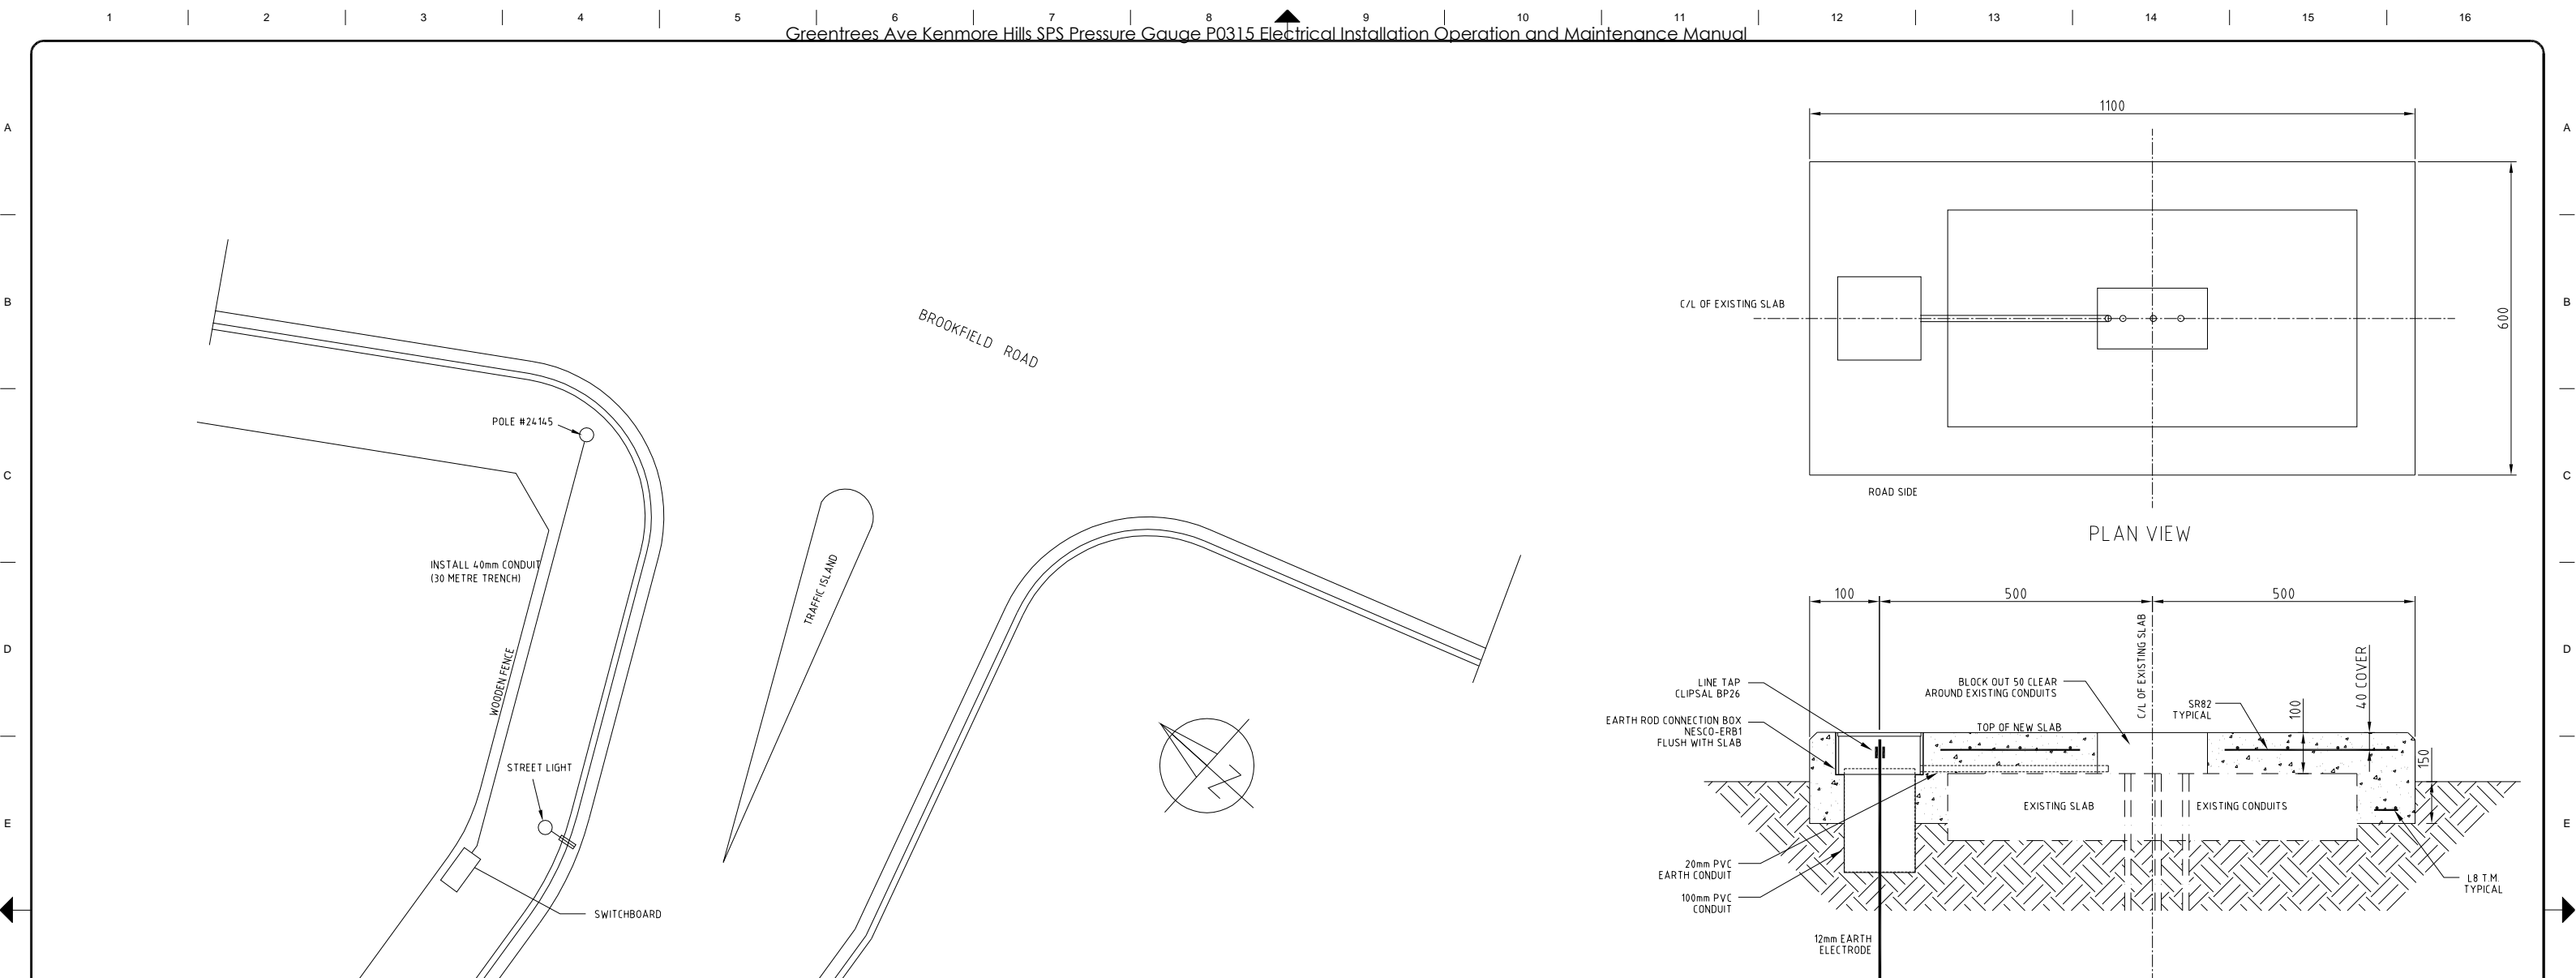

The site plan shows Brookfield Road with a traffic island. A wooden fence runs along the road. A pole (#241x5) is located near the fence. A street light is positioned near the pole. A switchboard is located near the road. A 40mm conduit is installed in a 30-metre trench. A north arrow is shown. The cross-section view shows the installation details: a 12mm earth electrode, 20mm PVC earth conduit, 100mm PVC conduit, a line tap (CLIPSAL BP26), an earth rod connection box (NESCO-ERB1) flush with the slab, a block out 50 clear around existing conduits, a top of new slab, existing slab, existing conduits, SR82 typical, 4.0 cover, 100, 150, and L8 T.M. typical.

Greentrees Ave Kenmore Hills SPS Pressure Gauge P0315 Electrical Installation Operation and Maintenance Manual

PLAN VIEW

SECTION VIEW

SWITCHBOARD SLAB  
DETAIL 1

Labels in site plan: BROOKFIELD ROAD, TRAFFIC ISLAND, WOODEN FENCE, POLE #24145, STREET LIGHT, SWITCHBOARD, INSTALL 40mm CONDUIT (30 METRE TRENCH).

Labels in detail drawings: LINE TAP CLIPSAL BP26, EARTH ROD CONNECTION BOX NESCO-ERB1 FLUSH WITH SLAB, 20mm PVC EARTH CONDUIT, 100mm PVC CONDUIT, 12mm EARTH ELECTRODE, TOP OF NEW SLAB, BLOCK OUT 50 CLEAR AROUND EXISTING CONDUITS, SR82 TYPICAL, 40 COVER, 150, L8 T.M. TYPICAL, C/L OF EXISTING SLAB, ROAD SIDE, EXISTING SLAB, EXISTING CONDUITS.

Dimensions: 1100, 600, 100, 500, 500, 100, 150.

Scale: 1:100

UNIVERSITY OF WITwatersrand 2010

1 2 3 4 5 6 7 8 9 10 11 12 13 14 15 16

A  
B  
C  
D  
E  
F  
G

Greentrees Ave Kenmore Hills SPS Pressure Gauge P0315 Electrical Installation Operation and Maintenance Manual

The figure consists of four main parts: a main site plan, a plan view of the switchboard slab, a section view of the switchboard slab, and a locality map.

**Main Site Plan:** This plan shows the layout of the electrical installation. It includes a wooden fence, a street light, a switchboard, and a traffic island. The installation is located on Greentrees Avenue, adjacent to Brookfield Road. A pole (#24145) is shown near the street light. A note indicates the installation of 40mm conduit in a 30-metre trench. A north arrow is provided for orientation.

**Plan View:** This view shows the layout of the switchboard slab. The slab is 1100 units wide and 600 units deep. It is located on the road side of the existing slab. The center line of the existing slab is shown. The slab is divided into three sections: a 100-unit wide section on the left, a 500-unit wide section in the middle, and a 500-unit wide section on the right. The center line of the existing slab is shown.

**Section View:** This view shows the cross-section of the switchboard slab. The slab is 150 units thick. It is shown over an existing slab. The top of the new slab is 40 units above the existing slab. The bottom of the new slab is 100 units below the existing slab. The slab is divided into three sections: a 100-unit wide section on the left, a 500-unit wide section in the middle, and a 500-unit wide section on the right. The center line of the existing slab is shown. The slab is supported by a 12mm earth electrode. The slab is shown with a 40-unit cover. The slab is shown with a 100-unit depth. The slab is shown with a 150-unit thickness. The slab is shown with a 40-unit cover. The slab is shown with a 100-unit depth. The slab is shown with a 150-unit thickness.

**Locality Map:** This map shows the location of the installation. It includes Greentrees Ave, Brookfield Rd, and Gap Creek Rd. The installation is located at the intersection of Greentrees Ave and Brookfield Rd. The map is labeled "LOCALITY MAP".

**CONSTRUCTION NOTE**  
1. NEW CONCRETE SLAB PLACED AROUND AND OVER EXISTING SLAB FOR THE NEW SWITCHBOARD SEE SHEET 05 FOR SWITCHBOARD DIMENSIONS

16

PRESS PERMISISON OF QUEENSLAND URBAN UTILITIES © 2010

1 2 3 4 5 6 7 8 9 10 11 12 13 14 15 16

A B C D E F G

Greentrees Ave Kenmore Hills SPS Pressure Gauge P0315 Electrical Installation Operation and Maintenance Manual

The figure consists of four main diagrams: a main site plan, a plan view, a section view, and a locality map. The main site plan shows the intersection of Brookfield Road and Greentrees Avenue. It includes a traffic island, a wooden fence, a street light, a switchboard, and a pole. A note indicates the installation of 40mm conduit in a 30-metre trench. The plan view shows the layout of the switchboard slab with dimensions 1100 by 600. The section view shows the cross-section of the slab with dimensions 100, 500, 500, 100, 150, and 40. It includes labels for various components like the line tap, earth rod connection box, top of new slab, existing slab, existing conduits, 20mm PVC earth conduit, 100mm PVC conduit, 12mm earth electrode, and SR82 typical. The locality map shows the location of the pressure gauge site at the intersection of Greentrees Ave and Brookfield Rd.

BROOKFIELD ROAD

TRAFFIC ISLAND

POLE #24145

INSTALL 40mm CONDUIT (30 METRE TRENCH)

WOODEN FENCE

STREET LIGHT

SWITCHBOARD

GREEN TREES AVENUE

PLAN VIEW

SECTION VIEW

LOCALITY MAP

CONSTRUCTION NOTE

1. NEW CONCRETE SLAB PLACED AROUND AND OVER EXISTING SLAB FOR THE NEW SWITCHBOARD SEE SHEET 05 FOR SWITCHBOARD DIMENSIONS

2. FINAL DIMENSION DETAILS TO SUIT PARTICULAR SITE CONDITIONS ARE RESPONSIBILITY OF THE CONTRACTOR

100 500 500 100 150 40 COVER

LINE TAP CLIPSAL BP26

EARTH ROD CONNECTION BOX NESCO-ERB1 FLUSH WITH SLAB

20mm PVC EARTH CONDUIT

100mm PVC CONDUIT

12mm EARTH ELECTRODE

SR82 TYPICAL

100

150

40 COVER

1.8 T.M TYPICAL

TOP OF NEW SLAB

EXISTING SLAB

EXISTING CONDUITS

C/L OF EXISTING SLAB

1100

600

C/L OF EXISTING SLAB

ROAD SIDE

GREEN TREES AV

BROOKFIELD RD

GAP CREEK RD

PRESSURE Gauge SITE

LOCALITY MAP

QUEENSLAND UTILITY SERVICES © 2010

1 2 3 4 5 6 7 8 9 10 11 12 13 14 15 16

A

B

C

D

E

F

G

H

I

Greentrees Ave Kenmore Hills SPS Pressure Gauge P0315 Electrical Installation Operation and Maintenance Manual

BROOKFIELD ROAD

TRAFFIC ISLAND

POLE #24145

INSTALL 40mm CONDUIT (30 METRE TRENCH)

WOODEN FENCE

STREET LIGHT

SWITCHBOARD

GREEN TREES AVENUE

LOCALITY MAP

PLAN VIEW

SECTION VIEW

SWITCHBOARD SLAB DETAIL 1

CONSTRUCTION NOTE

1. NEW CONCRETE SLAB PLACED AROUND AND OVER EXISTING SLAB FOR THE NEW SWITCHBOARD SEE SHEET 05 FOR SWITCHBOARD DIMENSIONS

2. FINAL DIMENSION DETAILS TO SUIT PARTICULAR SITE CONDITIONS ARE RESPONSIBILITY OF THE CONTRACTOR

ELECTRICAL AS BUILT DETAILS

REV	COMPANY	
-	ELECTRICIAN	-
-	LICENCE No.	-
		DATE: -

WAYS OF COPYRIGHT AND MAY NOT BE COPIED OR REPRODUCED WITHOUT THE EXPRESS PERMISSION OF QUEENSLAND URBAN UTILITIES © 2010

1 2 3 4 5 6 7 8 9 10 11 12 13 14 15 16

A  
B  
C  
D  
E  
F  
G  
H  
I

Greentrees Ave Kenmore Hills SPS Pressure Gauge P0315 Electrical Installation Operation and Maintenance Manual

POLE #24145

INSTALL 40mm CONDUIT (30 METRE TRENCH)

WOODEN FENCE

STREET LIGHT

SWITCHBOARD

BROOKFIELD ROAD

TRAFFIC ISLAND

GREENTREES AVENUE

LOCALITY MAP

PRESSURE Gauge SITE

1100

600

C/L OF EXISTING SLAB

ROAD SIDE

PLAN VIEW

100

500

500

100

40 COVER

150

12mm EARTH ELECTRODE

20mm PVC EARTH CONDUIT

100mm PVC CONDUIT

EARTH ROD CONNECTION BOX NESCO-ERB1 FLUSH WITH SLAB

LINE TAP CLIPSAL BP26

BLOCK OUT 50 CLEAR AROUND EXISTING CONDUITS

TOP OF NEW SLAB

EXISTING SLAB

EXISTING CONDUITS

SR82 TYPICAL

L8 T.M. TYPICAL

C/L OF EXISTING SLAB

SECTION VIEW

SWITCHBOARD SLAB DETAIL 1

CONSTRUCTION NOTE

1. NEW CONCRETE SLAB PLACED AROUND AND OVER EXISTING SLAB FOR THE NEW SWITCHBOARD SEE SHEET 05 FOR SWITCHBOARD DIMENSIONS

2. FINAL DIMENSION DETAILS TO SUIT PARTICULAR SITE CONDITIONS ARE RESPONSIBILITY OF THE CONTRACTOR

A

ELECTRICAL AS BUILT DETAILS			
REV	COMPANY	-	
-	ELECTRICIAN	-	
-	LICENCE No.	-	DATE: -

SHEET 09

REJECTED BY THE LAWS OF COPYRIGHT AND MAY NOT BE COPIED OR REPRODUCED WITHOUT THE EXPRESS PERMISSION OF QUEENSLAND URBAN UTILITIES © 2010

1 2 3 4 5 6 7 8 9 10 11 12 13 14 15 16

A

B

C

D

E

F

G

H

I

Greentrees Ave Kenmore Hills SPS Pressure Gauge P0315 Electrical Installation Operation and Maintenance Manual

BROOKFIELD ROAD

TRAFFIC ISLAND

POLE #24145

INSTALL 40mm CONDUIT (30 METRE TRENCH)

WOODEN FENCE

STREET LIGHT

SWITCHBOARD

GREEN TREES AVENUE

LOCALITY MAP

PLAN VIEW

SECTION VIEW

SWITCHBOARD SLAB DETAIL 1

CONSTRUCTION NOTE

1. NEW CONCRETE SLAB PLACED AROUND AND OVER EXISTING SLAB FOR THE NEW SWITCHBOARD SEE SHEET 05 FOR SWITCHBOARD DIMENSIONS

2. FINAL DIMENSION DETAILS TO SUIT PARTICULAR SITE CONDITIONS ARE RESPONSIBILITY OF THE CONTRACTOR

ELECTRICAL AS BUILT DETAILS

REV	COMPANY	DATE
-	ELECTRICIAN	-
-	LICENCE No.	-

SHEET 09

FOR CONSTRUCTION

THESE DOCUMENTS ARE THE PROPERTY OF THE CITY OF QUEENSLAND AND MAY NOT BE COPIED OR REPRODUCED WITHOUT THE EXPRESS PERMISSION OF QUEENSLAND URBAN UTILITIES © 2010



# **4. INSPECTION & TEST RESULTS**

# TEST SHEET

CUSTOMER NAME: BRISBANE WATER  
SWITCHBOARD ID: P0315  
DATE: 26-12-10

DATE: 26-12-12

CUSTOMERS ADDRESS: CREESTREE AVENUE KENMORE HILLS JOB No.: 32400106

JOB No.: 37400106

[illegible]

NAME: Andrew Burnell

NAME: Andrew Burnell

IC NO: 39850

IC NO: 39850





Inspection and Test Check List

Project: QUU PRV Cubicle P0315 Green Trees Ave	
Contractor / Order No.	SJ Electric Job No. BT430025
ITC No. 003	Date: 24/9/10
Corresponding ITP No. 001	
General Data	

Built By: Renee Wardrop, David King	Test Equipment: Megger / Multimeter
Location Tested: Workshop	Type: Kyoritsu / Fluke
Drg rev No:	Serial No. 5149622 / 10620027

Check List (Tick ( ) acceptable items only, note deviations under "REMARKS") (If not applicable mark as N/A)

Switch Board and Control Panels Construction Check List				
Item	Activity Description	Hold Points	Checked	By (Initial)
Busbar				
1	Correct size busbar to rated current load to meet AS 2067	NA	( )	BS
2	Appearance is good i.e. Straight & level		( )	
3	Correct phase identification		( )	
4	Correct hole sizes for joins and terminations		( )	
5	All clearances have been meet		( )	
6	Correct busbar support material has been used		( )	
7	Busbar supports are at the correct distances apart		( )	
8	Correct tensioning & blue spotted at all joins & terminations		( )	
9	Correct hole format in joining cubicle		( )	
10	Sufficient clearances for terminating cable		( )	
11	Heat shrink attached to flags for terminations		( )	
12	All joins are dressed flat		( )	
13	Busbar is insulated at supports		( )	
Cabling				
15	Correct size for demand of circuit		( )	BS
16	Correct phase colouring		( )	
17	Correct termination & insulated		( )	
18	Correct numbering		( )	
19	Correctly formed and neat		( )	
20	Correctly supported		( )	
21	All cable entry holes are insulated		( )	
22	Check cable tray is mounted correctly & all sharp surfaces are removed		( )	
23	All cable ties are neatly trimmed		( )	
24	All cable clear from busbar's	NA	( )	
25	Check all analog inputs and outputs are shielded		( )	
26	All shielded cables have been earthed		( )	

Remarks/Remedial Action Required Hold Points:

Remedial Actions Completed <input type="checkbox"/>	Signature: .....	Date: .....
Approved By: Brendan Stringer		
Signature: <i>BStringer</i>	Checked By: Ben George	Date: 24/9/10
Electrical Licence No. 114766	Signature: <i>Ben George</i>	

All the above signatories certify that the Electrical switchboard ~~work~~ listed has been checked and tested in accordance with the prescribed procedure and that such work complies in every respect with the requirements of the Electricity Act, AS3000 2007 and AS3008.1.1 1998

Switch Board and Control Panels Construction Check List (SJQF 502)				
Item	Activity Description	Hold Points	Checked	By (Initial)
<b>Switchgear</b>				
1	Check all main switches & circuit breakers are the correct <ul style="list-style-type: none"><li>• current rating</li><li>• ka rating</li><li>• trip settings</li><li>• correct to cabling</li><li>• to labels</li><li>• shunt trips</li><li>• inter locks</li></ul>		(S)(S)(S)(S)(S)(S)(S)	BA
2	Check the fixings			
3	Check the number of poles			
4	Check correct operation			
5	Correct mechanism			
<b>Control Switches</b>				
6	Check correct number of positions	NA		BA
7	Check correct size			
8	Check correct to labels			
9	Check mountings			
<b>Contactors</b>				
10	Check for correct model no	NA		BA
11	Check for correct current rating to control			
12	Correct auxiliary contacts			
13	Correct phasing			
14	Correct coil size			
15	Check that it is accessible			
16	Check it has correct overloads			
17	Correct labelling			
<b>Relays and Timers</b>				
18	Check correct rated voltage			BA
19	Correct contacts			
20	Correct variances			
21	Dip switches in required position			
22	Timers set to correct settings	NA		
23	Correct operation			
24	Correct auxiliaries			
<b>Transformers and Power Supplies</b>				
25	Check for correct voltage ratings			BA
26	Check for correct current ratings			
27	Check cabling is correct (no crossed voltage)			
28	Check the secondary has been earthed when applicable			
29	Check correct labelling			
30	Check mountings			
31	Check for clearance around for heat extraction			
Remarks/Remedial Action Required:				
Remedial Actions Completed <input type="checkbox"/> Signature: Date:				
Approved By: Brendan Stringer				
Signature: Ben George				
Electrical Licence No. 114766				
Signature: Date: 24/9/10				
All the above signatories certify that the Electrical switchboard work listed has been checked and tested in accordance with the prescribed procedure and that such work complies in every respect with the requirements of the Electricity Act 2002, AS3000 2007 and AS3008.1 1998				



Switch Board and Control Panels Construction Check List (S/J QF 502)				
Item	Activity Description	Hold Points	Checked	By (Initial)
<b>Fuses</b>				
1	Check that the cartridge is correct size		(✓)	BS
2	Correct mountings		(✓)	
3	Correct labelling		(✓)	
4	Check that line side conductors are SDI and < 500mm	NA	( )	
<b>Current Transformers</b>				
6	Correct ratio & size	NA	( )	BS
7	Correct direction of feed		( )	
8	Correct earthing		( )	
9	Correct cabling		( )	
<b>Voltage / Current Monitoring Equipment</b>				
10	Correct voltage / current range on meter to the installation	NA	( )	BS
11	Correct ratio on Cts		( )	
12	Voltmeter terminations are insulated		( )	
13	Check that all meters are preset to zero		( )	
14	Correct indication labels applied		( )	
<b>Indication Equipment</b>				
15	Correct colour	NA	( )	BS
16	Correct voltage size with matching lamp attached		( )	
17	Correct operation eg. Push to test		( )	
18	Correct labelling		( )	
<b>Terminal Blocks</b>				
19	Correct size to cable		(✓)	BS
20	Correct colour coding		(✓)	
21	Correct numbering		(✓)	
22	Correctly mounted with lock ends		(✓)	
23	Correct labels		(✓)	
<b>Neutral Links</b>				
24	Check that they are accessible		(✓)	BS
25	Correct labelling		(✓)	
26	Correct numbers stamped to match circuit identification		(✓)	
27	Correct cabling to circuit identification		(✓)	
28	Check that all neutral links & bar are insulated from the switchboard frame		(✓)	
<b>Earthing</b>				
29	Check that all main earth bar is correct size		(✓)	BS
30	Check that the main earth is continuous		(✓)	
31	Correctly labelled		(✓)	
32	Continuous for CT wiring	NA	( )	
33	Check that all doors with equipment mount are electrically earth		( )	
34	Check all frames are earthed		(✓)	
Remarks/Remedial Action Required:				
Remedial Actions Completed <input type="checkbox"/> Signature: Date:				
Approved By: Brendan Stringer				
Signature: Signature: Checked By: Ben George Date: 24/9/10				
Electrical Licence No. 114766				
All the above signatories certify that the Electrical switchboard work listed has been checked and tested in accordance with the prescribed procedure and that such work complies in every respect with the requirements of the Electricity Act 2002, AS3000 2007 and AS3008.1 1998				

Switch Board and Control Panels Construction Check List (SIQF 502)				
Item	Activity Description	Hold Points	Test Result	By (Initial)
<b>Earthling Resistance &amp; Continuity Test</b> (Note all readings should be < .5 ohms) Make sure the MEN connection is removed and attach lead to main earth connection point than test with other lead between				
1	The frame of each section		PASS	BS
2	The doors		<.1 Ω	
3	All mounting bolts to all equipment		<.1 Ω	
4	All brackets		<.1 Ω	
5	All earth links		<.1 Ω	
6	All bolts & threads for the mounting of escutcheon		<.1 Ω	
7	All gland plates		<.1 Ω	
8	All cable trays		<.1 Ω	
9	All earth connection		<.1 Ω	
10	Earth secondary of transformers and power supplies		<.1 Ω	
11	Earth surge diverters	NA	Ω	
12	Current transformers	NA	Ω	
<b>Insulation Test</b>				
1	Make sure all control fuses and earths are removed from all electronic equipment before this test is carried out and Set insulation tester (meggar) to 500 volts before proceeding		PASS	BS
	<ul style="list-style-type: none"><li>• Red – White</li><li>• Red – Blue</li><li>• Red – Earth</li><li>• Red – Neutral</li><li>• White – Blue</li><li>• White – Earth</li><li>• White – Neutral</li><li>• Blue – Earth</li><li>• Blue – Neutral</li></ul>		+200M Ω	
			+200M Ω	
			+200M Ω	
2	If all readings are clear the insulation tester is to be set at 1000 volts then proceed with the following		PASS	BS
	<ul style="list-style-type: none"><li>• Red – White</li><li>• Red – Blue</li><li>• White – Blue</li></ul>		+200M Ω	
			+200M Ω	
			+200M Ω	
Remarks/Remedial Action Required:				
Remedial Actions Completed <input type="checkbox"/> Signature: ..... Date: .....				
Approved By: Brendan Stringer				
Signature: <i>BStringer</i>				
Electrical Licence No. 114766				
Checked By: Ben George				
Signature: <i>BGeorge</i>				
Date: 24/9/10				
All the above signatories certify that the Electrical switchboard work listed has been checked and tested in accordance with the prescribed procedure and that such work complies in every respect with the requirements of the Electricity Act 2002, AS3000 2007 and AS3008.1 1998				




Switch Board and Control Panels Construction Check List (SJQF 502)					
Item	Activity Description	Hold Points	Checked	By (Initial)	
<b>2.5 KV Test This test is used to prove all busbar construction</b>					
1	Make sure all control fuses and earths are removed from all electronic equipment before this test is carried out	NA			
2	All the following tests must be set at a 1 minute time period, result should be 0 Amps		( )		
			( )		
3	Test between:	Passed	Test Result	By (Initial)	
	• Red – White	( )	0 A		
	• Red – Blue	( )	0 A		
	• Red – Earth	( )	0 A		
	• Red – Neutral	( )	0 A		
	• White – Blue	( )	0 A		
	• White – Earth	( )	0 A		
	• White – Neutral	( )	0 A		
	• Blue – Earth	( )	0 A		
	• Blue – Neutral	( )	0 A		
<b>Supply Authority section</b>					
1	Check supply authority main isolator lockable in the on position	NA	( )		
2	Check all doors before the Ct's. Or meters are lockable		( )		
3	Check where the neutral link is located for the site connection if metres are remotely mounted		( )		
4	Check where the earth link is located for the site connection if meters are remotely mounted		( )		
5	Check double insulated cable for POT fuses are less than 800 mm		( )		
6	Check double insulated cable are taken on line side of Ct.s		( )		
7	Check metre wiring is in building wire and correct size		( )		
8	Check if Ct meter wiring is in steel conduit when closer than 100mm to other conductors		( )		
9	Check there is no equipment connected before on the line side of meters or Ct.s (i.e., surge diverters)		( )		
10	Check list may vary if switch board is going interstate. Alter where applicable		( )		
Remarks/Remedial Action Required:					
Remedial Actions Completed <input type="checkbox"/> Signature: ..... Date: .....					
Approved By: Brendan Stringer					
Signature: <i>BStringer</i>		Checked By: Ben George		Date: 24/9/10	
Electrical Licence No. 114766					
All the above signatories certify that the Electrical switchboard work listed has been checked and tested in accordance with the prescribed procedure and that such work complies in every respect with the requirements of the Electricity Act 2002, AS3000 2007 and AS3008.1 1998					

Inspection and Test Check List

Switch Board and Control Panels Construction Check List (SJQF 502)					
Item	Activity Description	Hold Points	Checked	By (Initial)	
<b>Functional Test</b>					
<b>Prior to connection of supply all inspection and test check lists must be completed</b>					
1	Point to point test on all cables as per schematic and single line drgs. (Leave spot for drawing. No's and Rev No's		✓		
2	Check all Cts are not open circuit	NA	(-)		
<b>Connect supply (personal protection equipment must be used)</b>					
3	Check polarity of connection <ul style="list-style-type: none"><li>• Red - White</li><li>• Red - Blue</li><li>• Red - Earth</li><li>• Red - Neutral</li><li>• White - Blue</li><li>• White - Earth</li><li>• White - Neutral</li><li>• Blue -Earth</li><li>• Blue - Neutral</li></ul>	NA	V		
		NA	V		
			240 V		
			240 V		
		NA	V		
		NA	V		
4	Correct voltage / current range on meter to the installation				
5	Check functional operation of switchboard following specific construction issue drawings (leave spot for drawing No's and Rev No's		✓		
6	Check operation of all RCD's < 0.3s		0.26s		
<b>Pre delivery check list</b>					
		F.A.T TEST	NA		
1	Check all punch list items are complete		( )		
2	Check if Compliance label is mounted and correct		( )		
3	Check if heat shrinks is supplied when necessary		( )		
4	Check all load bolts are supplied		( )		
5	Check if m.e.n is mounted after testing		( )		
7	Photos have been taken of every section and given to manager		( )		
8	Test reports have been photo copied and placed in the client folder and SJ Electric folder		( )		
9	As built drawings received back from drafting office, verify Rev No.		( )		
10	Manuals placed in client folder				
11	Switch Board wrapped with delivery details supplied		( )		
12	As built drawings placed in client folder. (Latest revision ( )		( )		
Remarks/Remedial Action Required: Copy of red lined marked Drawing ( )					

Remedial Actions Completed <input type="checkbox"/>		Signature: .....	Date:
Approved By: Brendan Stringer			
Signature:	Checked By: Ben George		
Electrical Licence No. 114766	Signature:	Date: 24/9/10	
All the above signatories certify that the Electrical switchboard work listed has been checked and tested in accordance with the prescribed procedure and that such work complies in every respect with the requirements of the Electricity Act 2002, AS3000 2007 and AS3008.1 1998			



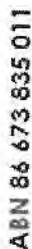

# ELECTRICAL DRAWINGS INDEX

DWG N°.	TITLE	SHEET	REVISIONS
486/11/9-0791-001	ELECTRICAL DRAWING N° X	01	A
486/11/9-0791-002	POWER DISTRIBUTION SCHEMATIC DIAGRAM	01	A
486/11/9-0791-003	DIGITAL INPUTS AND OUTPUTS TERMINATION DIAGRAM	03	A
486/11/9-0791-004	ANALOG INPUTS AND OUTPUTS TERMINATION DIAGRAM	04	A
486/11/9-0791-005	SWITCHBOARD GENERAL ARRANGEMENT	05	A
486/11/9-0791-006	SWITCHBOARD CONSTRUCTION DETAILS	06	A
486/11/9-0791-007	SWITCHBOARD EQUIPMENT LIST	07	A
486/11/9-0791-008	SWITCHBOARD CABLE SCHEDULE & LABEL SCHEDULE	08	A
486/11/9-0791-009	SWITCHBOARD SITE LAYOUT	09	A
486/11/9-0791-010	SPARE		

SHEET 01

FOR CONSTRUCTION

A 06/10 MINOR REV FOR CONSTRUCTION		DRAFT		E. PARANAGAMA 04/10		* ACHAVEZ-PLASENCIA		K. VAHESAN		7/5/10		SITE P0315		TITLE ELECTRICAL DRAWINGS INDEX		SHEET No. 486/4/9-0791-001		Drawing No. 486/4/9-0791-001		AMEND A																																																																																																																																																																																																																																																																																																																																																																																																																																																																																																																																																																																																																																																																																																																																																																																																																																																																																																																																																																																																																																																																																																																																																																																																																																																																																																																																																																																																																																																																																																																																																																																																																																																																																																																																																																																																																																																																																																																																																																																																																																																																																																																																																																																																																																																																											
O 04/10 FOR CONSTRUCTION		QA		P. MOUNTERT		DESIGN		R.P.E.Q. No. DATE		5/5/10		PRINCIPAL DESIGN MANAGER		P. SHERIFF		CLIENT DELEGATE		8		9		10		1102	





1. CIRCUIT BREAKERS SHALL BE SHROUDED

**FOR CONSTRUCTION**

etA.dwg Last Saved by 088901 on Wednesday, 14 July 2010 10:12:14 AM

FOR CONSTRUCTION  
AMENDMENT







No. DATE		AMENDMENT		DRN.	APD.
Q	04-10	FOR CONSTRUCTION	EP.	AW	
A	05-10	MINOR REV FOR CONSTRUCTION	DRM	GA	

Kenmore Hills 19-0791 SetA.dwg Last Saved by 083901 on Wednesday, 14 July 2010 10:12:14 AM

3/4" ANTENNA SUPPORT LOCATED ON SIDE  
LONG CAL WATER PIPE C/W 403 CAL CAP  
(MIN WALL THICKNESS 3.7mm) & Ø70 PVC  
50 AND FOR Ø10 CABLE

2 OFF EYE BOLTS  
SEE SHEET 6 - DETAIL 11

PLAN VIEW

Scaled Battery enclosure  
ventilated to outside  
250x150 Cover fixed with  
5 off M5 set screws  
& adhesive EPDM gasket  
over 270 x 120 cutout

SECTION D-D

SECTION E-E

SECTION F-F

SECTION G-G

SECTION H-H

SECTION I-I

SECTION J-J

SECTION K-K

SECTION L-L

SECTION M-M

SECTION N-N

SECTION O-O

SECTION P-P

SECTION Q-Q

SECTION R-R

SECTION S-S

SECTION T-T

SECTION U-U

SECTION V-V

SECTION W-W

SECTION X-X

SECTION Y-Y

SECTION Z-Z

SECTION AA-AA

SECTION BB-BB

SECTION CC-CC

SECTION DD-DD

SECTION EE-EE

SECTION FF-FF

SECTION GG-GG

SECTION HH-HH

SECTION II-II

SECTION JJ-JJ

SECTION KK-KK

SECTION LL-LL

SECTION MM-MM

SECTION NN-NN

SECTION OO-OO

SECTION PP-PP

SECTION QQ-QQ


SECTION RR-RR

SECTION SS-SS

SECTION TT-TT

SECTION UU-UU

SECTION VV-VV

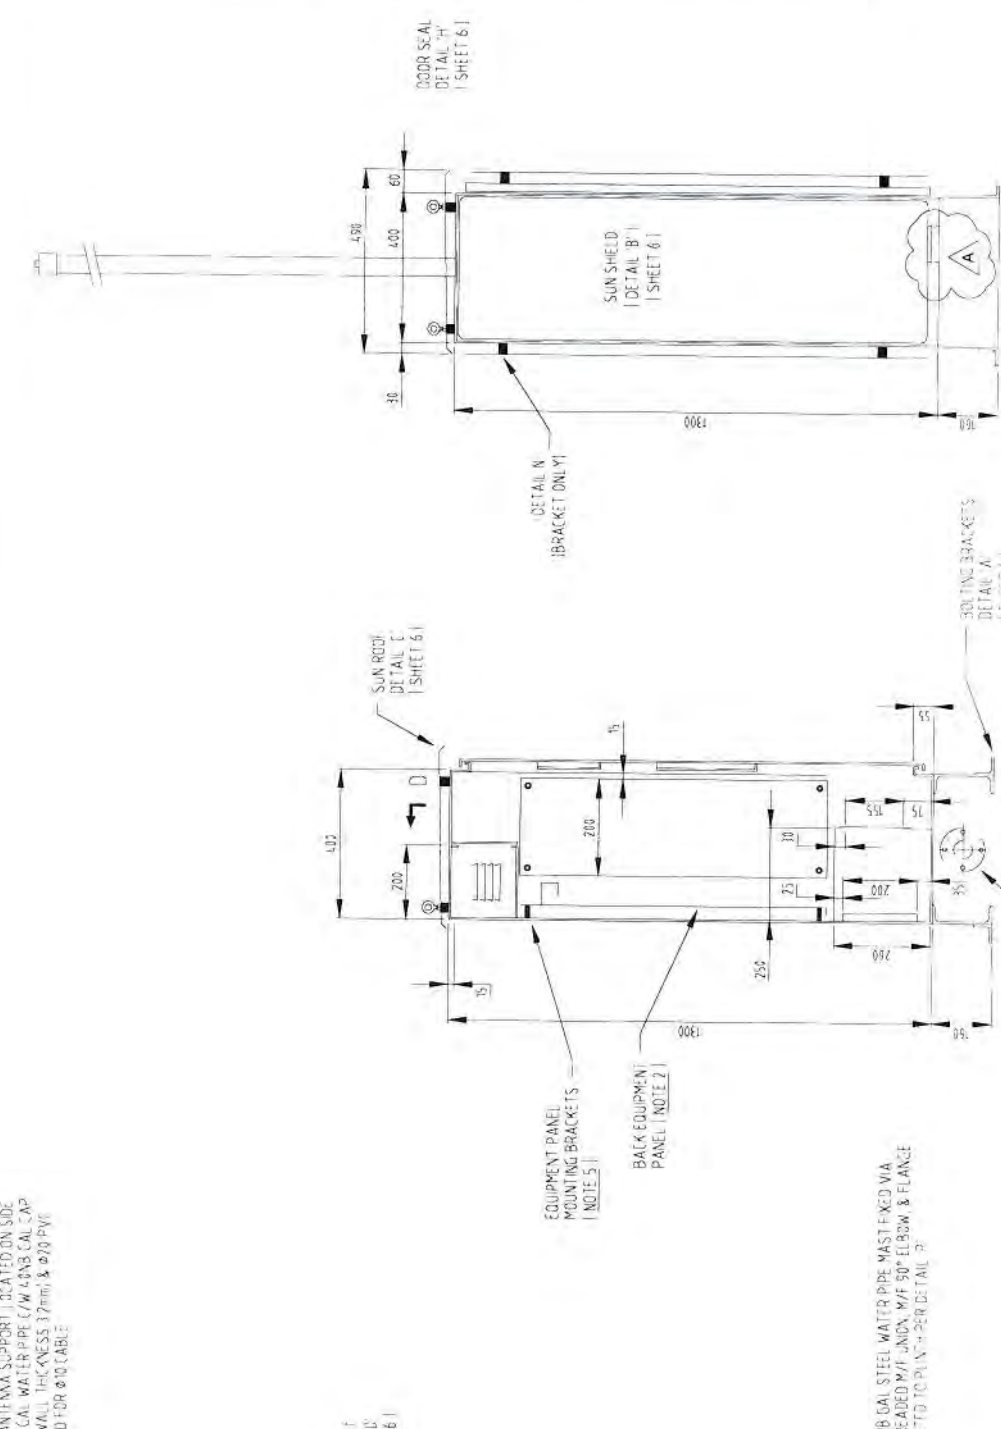


NOTES

1. REFER TO SHEET 04 FOR THE SWITCHBOARD CONSTRUCTION DETAILS
2. SIDE & BACK EQUIPMENT PANELS TO BE MOUNTED 40mm OFF THE SIDE & BACK WALLS AND OPEN AT BOTH THE TOP AND BOTTOM TO ALLOW FOR AIR FLOW
3. REFER TO SHEET 07 FOR THE EQUIPMENT PANEL LAYOUT DETAIL AND EQUIPMENT SCHEDULE
4. BACK & SIDE GEAR MOUNTING BRACKETS (16 USE TOTAL) 175 X 25 X 3 (TYP)
5. THIS DRAWING TO BE READ IN CONJUNCTION WITH SHEET 06 FOLLOWING
6. ANTENNA FLANGE MOUNTING DETAILS - WHERE NO ANTENNA IS TO BE INSTALLED, PROVIDE Ø70 BLANKING PLATES WITH GASKETS TO COVER SIDE AND REAR ANTENNA FLANGE DRILLING POSITIONS

GENERAL ARRANGEMENT

SCALE 1:750 ON A1/S1/1 PRINT

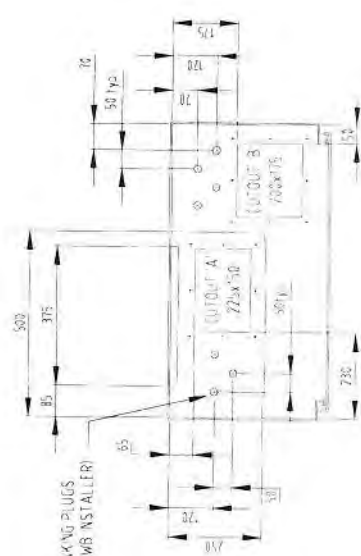

APR ENTRY ALLOCATION

FOR CABLE ENTRY & ANTENNA ACCESS

SECTION C-C

ELECTRICAL AS BUILT DETAILS  
REV COMPANY  
- ELECTRICIAN - ST ELECTRIC  
- LICENCE No. - 1147666 DATE: 24-9

SHEET 05

FOR CONSTRUCTION

SHEET No  
Greenland Urban Utilities DRAWING No  
486/4/9-0791-005 A  
AMEND

SWITCHBOARD  
GENERAL ARRANGEMENT

SITE  
P0315  
GREENTREES AVE, KENMORE HILLS  
PRESSURE GAUGE  
ELECTRICAL INSTALLATION

UrbanUtilities

7/5/10  
DATE  
PRINCIPAL DESIGN MANAGER  
7/5/10  
DATE  
CLIENT DELEGATE

DRAFTED  
E. PANAGIOTAKIS  
DESIGN  
H.P.E.Q. No. 04.10  
DATE  
R.P.E.Q. No. 04.10  
DATE

DRAFTING CHECK  
P. MUSTERT  
04.10  
DATE  
CADD FILE  
45-0770S40.dwg  
B.C.C. FILE No.

APD  
DRN  
FOR CONSTRUCTION  
AMENDMENT  
1 2 3 4 5 6 7 8 9 10 11 12 13 14 15 16



**CONSTRUCTION**  
Cubicle constructed of 3mm Marine Plate Aluminium (5252)  
with construction (6063) Marine 6063-T6 Grade Aluminium  
clad. Paint MIL-8170, with all visible seals and joints fully welded  
free from surface and ground leakage where needed.  
External doors and covers fitted with 100% self-sealing  
O-rings fitted to the interior of all doors, and hinge escutcheons  
and on adjacent table meter or surfaces.  
Door stiffeners, door stays, cable straps, and door hinges are fitted  
where shown on the drawings.  
Lift-off covers and mounting panels fixed with M8 studs and one screw  
each. Mounting panels fixed with 25x6mm flat aluminium bar.  
Gland plate openings reinforced with 25x6mm flat aluminium bar.  
Gland plate areas are NOT more than 50mm apart.  
Nuts, Selectrix M8-BES3  
Star washers fitted under all hinge screws  
Lock Door  
Selectrix 1107-PS-01 handle  
Selectrix 1107-PS-02 for latch  
Lockwood 71 Barrel Lock  
Fima 1049-U3 roller rod  
Lock Code R049548

**PAINTING**  
Aluminium Surface Preparation  
Finish smooth all exposed welds, clean, descale, and degrease all surfaces.  
Surfaces pretreated in accordance with AS 1530 & AS 3715 using  
Novox LF acid etch cleaner. Novoxcat 12 converters on coating, & clean water rinses.  
Apply DULUX ALPHATEC 8000 powder coat to manufacturer's recommendations  
CUBICLE & EXTERNAL COMPONENTS. DULUX M45 Green (6662) for all  
INTERIOR ITEMS (mounting panels, escutcheons, etc.) - DULUX Bright White (32766)  
Minimum Dry Film Thickness all surfaces 40 microns.

**OPERATING PARAMETERS**  
Standard  
AS 3149-1  
AL 5004  
240 VAC  
660 V  
72 VDC / 240 VAC  
10 mA  
1 sec  
IP 35 to AS 1535  
Measure of protection by barriers  
and enclosures  
Service conditions  
Mass  
20ms of Surge Protection  
Warning System

AS 3149-1  
AL 5004  
240 VAC  
660 V  
72 VDC / 240 VAC  
10 mA  
1 sec  
IP 35 to AS 1535  
Measure of protection by barriers  
and enclosures  
Service conditions  
Mass  
20ms of Surge Protection  
Warning System






**WIRING**  
All wiring to be PVC 95B 0.6/1kV cable with lined conductor.  
Control and instrument wiring has flexible copper conductors, and is colour  
coded as per standard. Numbered each end, and terminated by the use of  
appropriate wire nuts or crimp lugs.  
Power wiring to be minimum 2.5sqmm stranded copper conductors, make  
colour coded as per standard.  
Low level instrumentation signals & 1-20mA signals wired in shielded pair  
minimum size 0.5sqmm. Earthed at one end only.  
Earth cables minimum 2.5sqmm flexible.  
Doors and hinge escutcheons bonded with 1sqmm flexible earth strap.  
Wire numbering will be equal to GPO standard S0000 system.  
Wire numbers are readable left to right bottom to top as shown.

**COLOUR CODE**  
Phase wiring (A, B & C) Red, White, Blue  
Potential Metering (240/415 VAC) Red, White, Blue, Black  
Current Metering (Secondary) Red, White, Blue, Grey  
240 VAC Control Active Red  
240 VAC Neutral Black  
24 V ELV Positive Orange  
24 V ELV Negative Violet  
24 V RTU Positive Orange  
24 V RTU Negative Violet  
RTU Wiring Grey  
Intrinsically safe wiring Grey  
Earth Green/Yellow  
Door & Escutcheon Earth Bonds Green/Yellow

**Labels**  
Internal labels W/B/W engraved traffic to label schedule  
Warning labels B/W/B engraved traffic to label schedule

**Main switch labels**  
MAIN SWITCH  
10mm  
6mm

**Warning labels**  
DANGER 240V  
ISOLATED WIRE

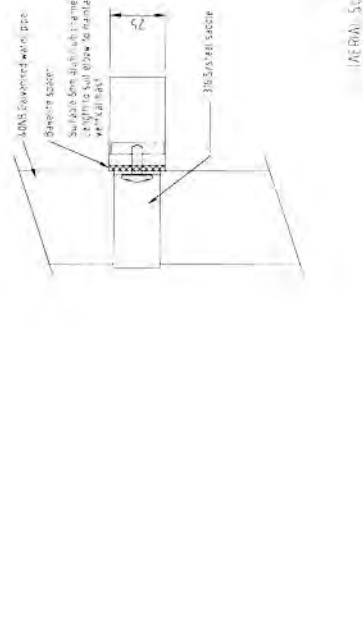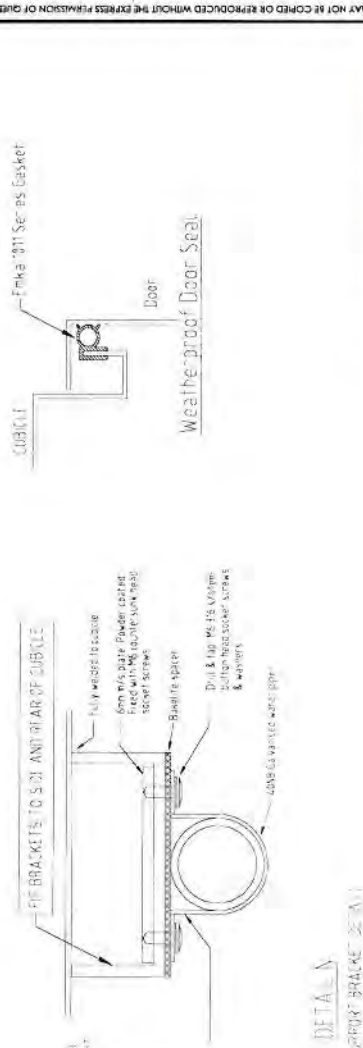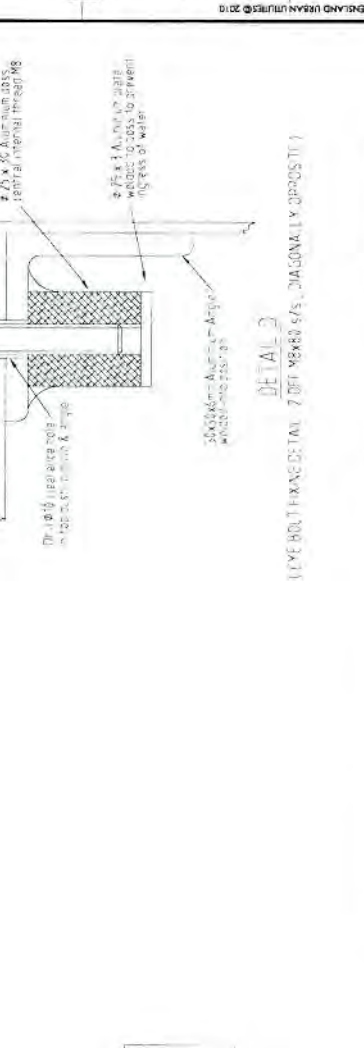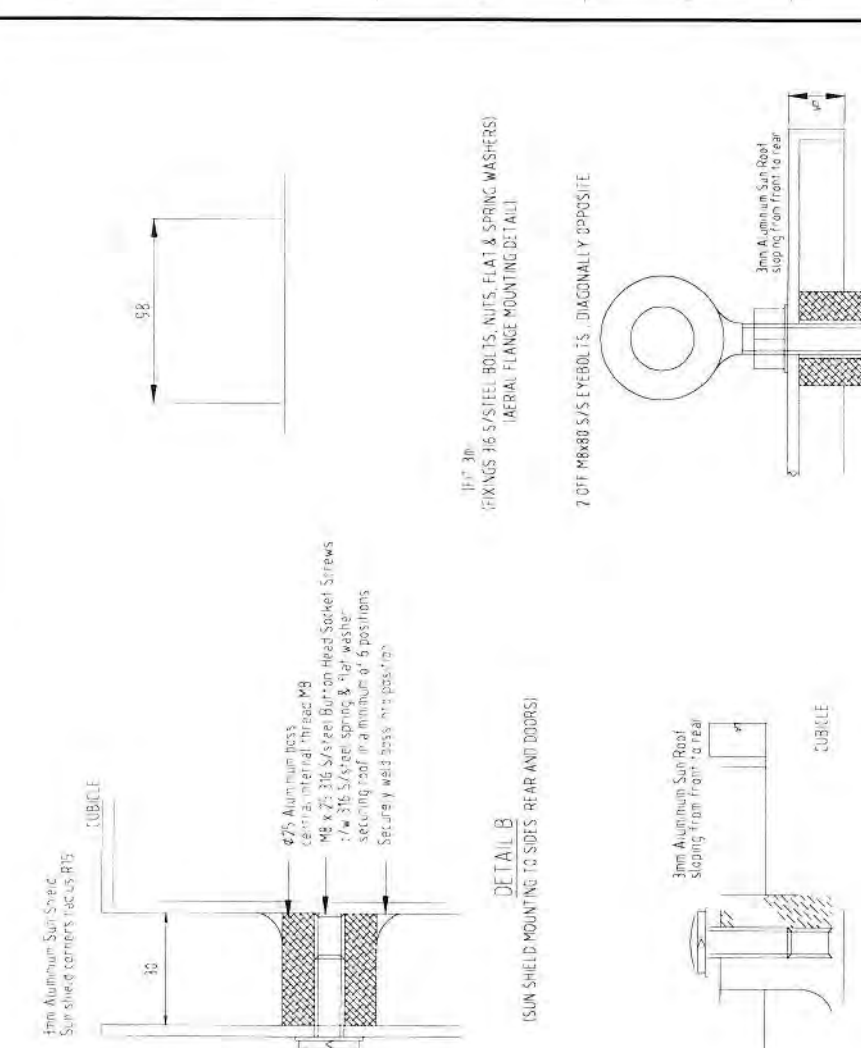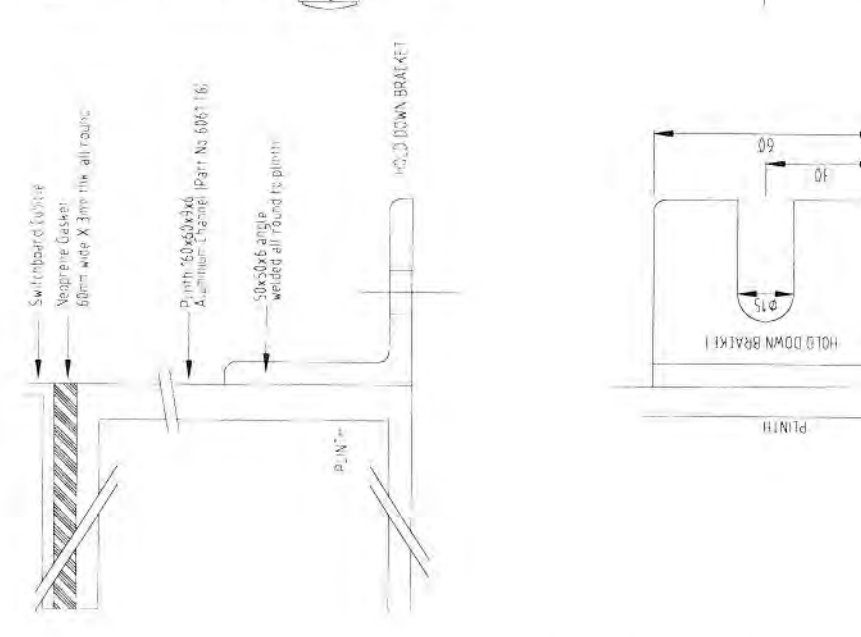

ELECTRICAL AS BUILT DETAILS  
REV COMPANY  
ELECTRICIAN  
LICENCE No. 114766  
DATE 14-9-2010

**SHEET 06**  
**FOR CONSTRUCTION**

SHEET No.  
Greentrees Ave Kenmore Hills SPS Pressure Gauge P0315  
486/4/9-0791-006  
AMEND.

SITE  
P0315  
GREEN TREES AVE, KENMORE HILLS  
PRESSURE GAUGE  
ELECTRICAL INSTALLATION

Principal Design Manager  
P. SHEPHERD  
Client Delegate


DESIGN CHECK  
P. MOSTERT  
49-07-2010  
B.C.C. FILE No.

FOR CONSTRUCTION  
AMENDMENT  
DRN. APD.



EQUIPMENT LIST

REF	QTY	DESCRIPTION	MANUFACTURER	CATALOGUE No.	REMARKS
01	1	0" - MAIN CIRCUIT BREAKER	TERASAKI	DTCB10-16	100A
02	5	POLE FILLER	TERASAKI	DTPOLE FILLER	
03	7	IP30 8 POLE COVER	TERASAKI	DTIPCB	
04	1	SD1 - SURGE DIVERTER	NHP	TITAN DRIPLESK2302C	45KA MAX
05	1	Q2 - GPO CIRCUIT BREAKER	TERASAKI	DTCB10-02	
06	1	Q3 - SURGE FILTER CIRCUIT BREAKER	CLIPSAL	7A CB - RD	
07	1	Q4 - PWR SUPPLY CIRCUIT BREAKER	TERASAKI	DTCB10-06	
08	1	Q5 - SURGE A-ARM RLY CIRCUIT BREAKER	CRITEC	DSF-6A 275	
09	1	Q6 - POWER FAILURE RLY CIRCUIT BREAKER	TERASAKI	DTCB10-04	
10	1	Q7 - SURGE PROTN ALARM RLY	CRITEC	DAR-275V	
11	1	Q8 - POWER FAILURE RLY CIRCUIT BREAKER	TERASAKI	DTCB10-07	
12	1	Q9 - POWER FAILURE RLY CIRCUIT BREAKER	TERASAKI	385124VAC	
13	1	Q10 - POWER FAILURE RLY CIRCUIT BREAKER	TERASAKI	LA5	
14	2	NEUTRAL LINK	CLIPSAL	BP165D18	
15	1	EARTH LINK	CLIPSAL	BP165D18	
16	1				
17	1				
18	2	SW/BD DOOR MICRO SWITCHES	CAMSCD	SW202	
19	2	SW/BD 8W INTERNAL FLUORO LIGHTS	THORN	B80108	1 OFF NO. 1 OFF N/C
20	1	CORROSION INHIBITOR	CORTEC	VPC1-110 OR 111	
21	1	RTU	SERCK	eNET-SXEW-E1	FROM AP CONTROLS
22	1	DISCONNECT PLUGS	PHOENIX CONTACT	MS1B 2.5/20-51-5.08	ENET RTU WITH 1/2 10-10-30V INPUT
23	2	DISCONNECT BLOCKS	PHOENIX CONTACT	UMS1BWK2.5/20-5.08	
24	2	CABLE HOUSING	PHOENIX CONTACT	KGS-MS1BZ 5/20	
25	2	CODING PINS	PHOENIX CONTACT	CP-MS1B-CR-MS1B	
26	1	FUSED TERMINALS WITH LED 24V INDICATION	PHOENIX CONTACT	UTA-HES-LED24 15x201	
27	101	FUSE CARTRIDGES	PHOENIX CONTACT	Y205	RATINGS AS REQUIRED
28	101	DISCONNECT TERMINALS	PHOENIX CONTACT	UTA-MT PIP	
29	101	TERMINALS	PHOENIX CONTACT	UTA-7	
30	101	EARTH TERMINALS	PHOENIX CONTACT	UTA-MT PIP	
31	8	GROUP MARKER (ARMER)	PHOENIX CONTACT	UTA-MT PIP	
32	6	TEST PLUG ADAPTER	PHOENIX CONTACT	UTA-MT PIP	
33	2	SCREW DRIVER	PHOENIX CONTACT	UTA-MT PIP	
34	1	PLUG IN BRIDGE	PHOENIX CONTACT	UTA-MT PIP	
35	2	PRESSURE TRANSDUCER	EXISTING		AS REQUIRED
36	2	12V 6.5AH SEALED LEAD ACID BATTERY	YUASA	NP7-12	INSTALLER TO REUSE EXISTING
37	1	PS1 - RTU 24VDC POWER SUPPLY	POWERBOX	70251-24VDC-CE-1	
38	1	24V/18V DC CONVERTER	POWERBOX	PRH-247C	
39	1	RADIO	TB0	DR900-01A02-20	FREE ISSUE
40	1	SD2 - RADIO COAX SURGE PROTECTOR	POPHASER CORPORATION	S-50M-X2	
41	1	ANTENNA MAST	SWBC MANUFACTURER		6.0 METRES
42	1	ANTENNA	FRN		SUPPLIED-BASE BY SWBC WITH 1/2" DIA. SITE
43	1	INTERNAL COAX CABLE (Radio to Lighting Mast)	FRN		2.0m No X11
44	1	EXTERNAL COAX CABLE (Lighting Mast to Antenna)	FRN		2.0m No X11
45	1	COAX CABLE (Radio to Antenna)	FRN		2.0m No X11
46	1	COAX CABLE (Radio to Antenna)	FRN		2.0m No X11
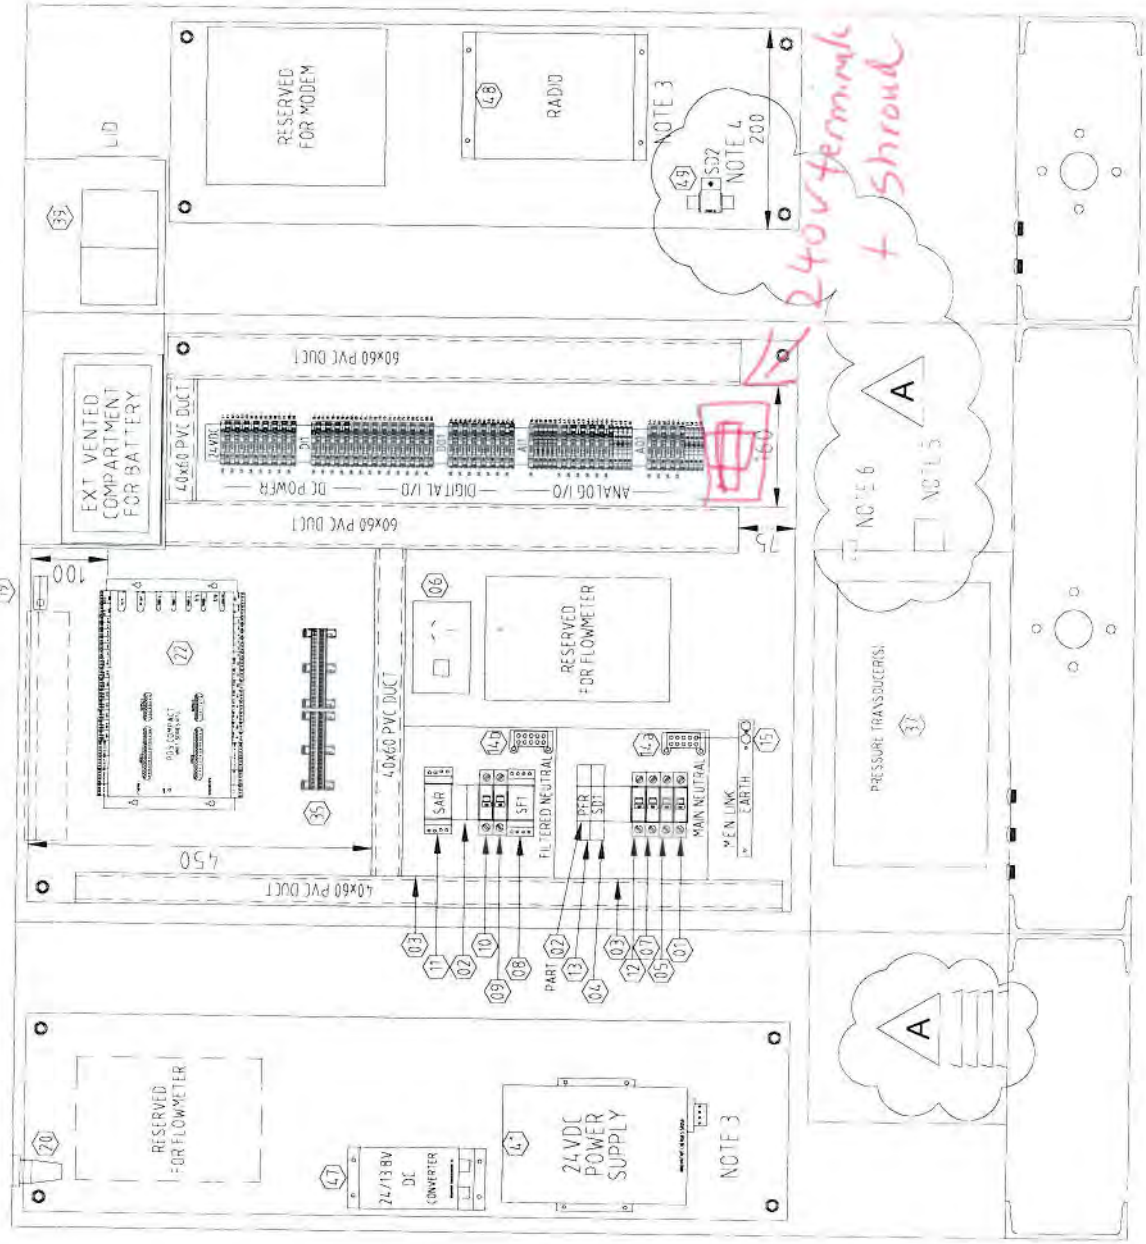

EQUIPMENT PANEL - LAYOUT DETAIL  
SCALE 1/5 ON A1 SIZE PRINT

- NOTES
- 1. LABELS FITTED ADJACENT TO ASSOCIATED EQUIPMENT
  - 2. LABELS OBSOLETE BY SWITCHBOARD WIRING ARE RELOCATED TO ADJACENT DUCT LID
  - 3. ANTENNA LOCATED BY 50% OF ANTENNA SITE
  - 4. ANTENNA LOCATED BY 50% OF ANTENNA SITE
  - 5. ANTENNA LOCATED BY 50% OF ANTENNA SITE
  - 6. ANTENNA LOCATED BY 50% OF ANTENNA SITE

ELECTRICAL AS BUILT DETAILS  
REV COMPANY - ST ELECTRIC  
ELECTRICIAN - STRINGER  
LICENCE No - 114766 DATE - 24-9

SHEET 07

FOR CONSTRUCTION

UrbanUtilities  
SHEET No. 486/4/9-0791-007  
TITLE SWITCHBOARD EQUIPMENT LIST  
PRESSURE GAUGE ELECTRICAL INSTALLATION  
SITE P0315  
GREEN TREES AVE, KENMORE HILLS  
ELECTRICAL INSTALLATION  
DATE 7/5/10  
DATE 5/5/10  
DATE 5/5/10  
DATE 5/5/10



LABEL	TEXT	TEXT HEIGHT	PAINT/FILL LETTERING	DIMENSIONS	QTY
A	P0375	20mm	BLACK	150X35	1
B	WARNING THIS SITE IS MONITORED BY THE CONTROL ROOM OPERATOR PLEASE INFORM THE OPERATOR BEFORE ISOLATING STATION	8mm	BLACK	250X100	1
C	WARNING DANGER ZONE	8mm	RED	120X15	1
D	REMEMBER THIS IS AN UN-METERED SUPPLY AND ANY ALTERATIONS TO THESE CIRCUITS MUST BE NOTIFIED TO SUPPLY AUTHORITY BILLING DEPARTMENT	3mm	BLACK	TO SUIT	1

## EXTERNAL LABELS

**SHEET 08**

FOR CONSTRUCTION

SITE P0315 GREENTREES AVE, KENMORE HILLS PRESSURE GAUGE ELECTRICAL INSTALLATION	TITLE SWITCHBOARD CABLE & LABEL SCHEDULE	SHEET No. Queensland Urban Utilities DRAWING No. 486/4/9-0791-008 AMEND, A
---	--	--

11 12 13 14 15 16  
G194 WATER SUPPLY264 Drafting6268 PlansElectrical3 WATERNE WORKS14 Gauges-Meter1-P0315 Greenstreet Ave Kenmore Hills40-77915c4.1wg Last Saved by 060901 on Wednesday, 14 July 2010 10:33:06 AM





SHEET 09

**FOR CONSTRUCTION**

SHEET No. 486/4/9-0791-009 A  
Queensland Urban Utilities DRAWING No. AMEND.

TITLE	DATE	BY	REVISION
SWITCHBOARD			
SITE LAYOUT			

SITE  
P0315  
GREENTREES AVE, KENMORE HILLS  
PRESSURE GAUGE  
ELECTRICAL INSTALLATION

Urban Utilities

K. VAHEESAN	7/5/10
PRINCIPAL DESIGN MANAGER	
P. SMITH	7/5/10
CLIENT DELEGATE	

LEATON	6511	5/5/10
DESIGN	R.P.O. No	DATE
* A. WITTHOFT	8895	5/5/10
DESIGN CHECK	R.P.O. No	DATE

E:PARANAGAMA DA U	P: MOSTERT	D4.10
	49-0770Set0.dwg	
DRAFTING CHECK		
CAD FILE		
B.C.C. FILE No.		

A	07-10	AMENDMENT TO NOTES	AP	GA
O	04-10	FOR CONSTRUCTION	F P	AW
No.	DATE	AMENDMENT	DRN	APD.



ABN 86 673 835 011

# ELECTRICAL DRAWINGS INDEX

DWG N°	TITLE	SHEET	REVISIONS
486/11/9-0791-00*	ELECTRICAL DRAWING INDEX	01	C A
486/11/9-0791-002	POWER DISTRIBUTION SCHEMATIC DIAGRAM	07	C A
486/11/9-0791-003	DIGITAL INPUTS AND OUTPUTS TERMINATION DIAGRAM	01	C
486/11/9-0791-004	ANALOG INPUTS AND OUTPUTS TERMINATION DIAGRAM	04	C A
486/11/9-0791-005	SWITCHBOARD GENERAL ARRANGEMENT	05	C A
486/11/9-0791-006	SWITCHBOARD CONSTRUCTION DETAILS	06	C
486/11/9-0791-007	SWITCHBOARD EQUIPMENT LIST	07	C A
486/11/9-0791-008	SWITCHBOARD CABLE SCHEDULE & LABEL SCHEDULE	08	C A
486/11/9-0791-009	SWITCHBOARD SITE LAYOUT	09	C A
486/11/9-0791-010	SPARE		



SHEET 01

FOR CONSTRUCTION

[illegible]

Kenmore Hills 49-0791SetA.dwg    Last Saved by 088901 on Wednesday, 14 July 2010 10:12:14 AM



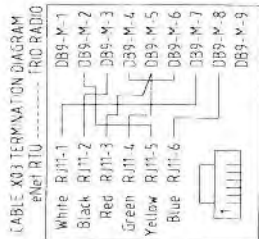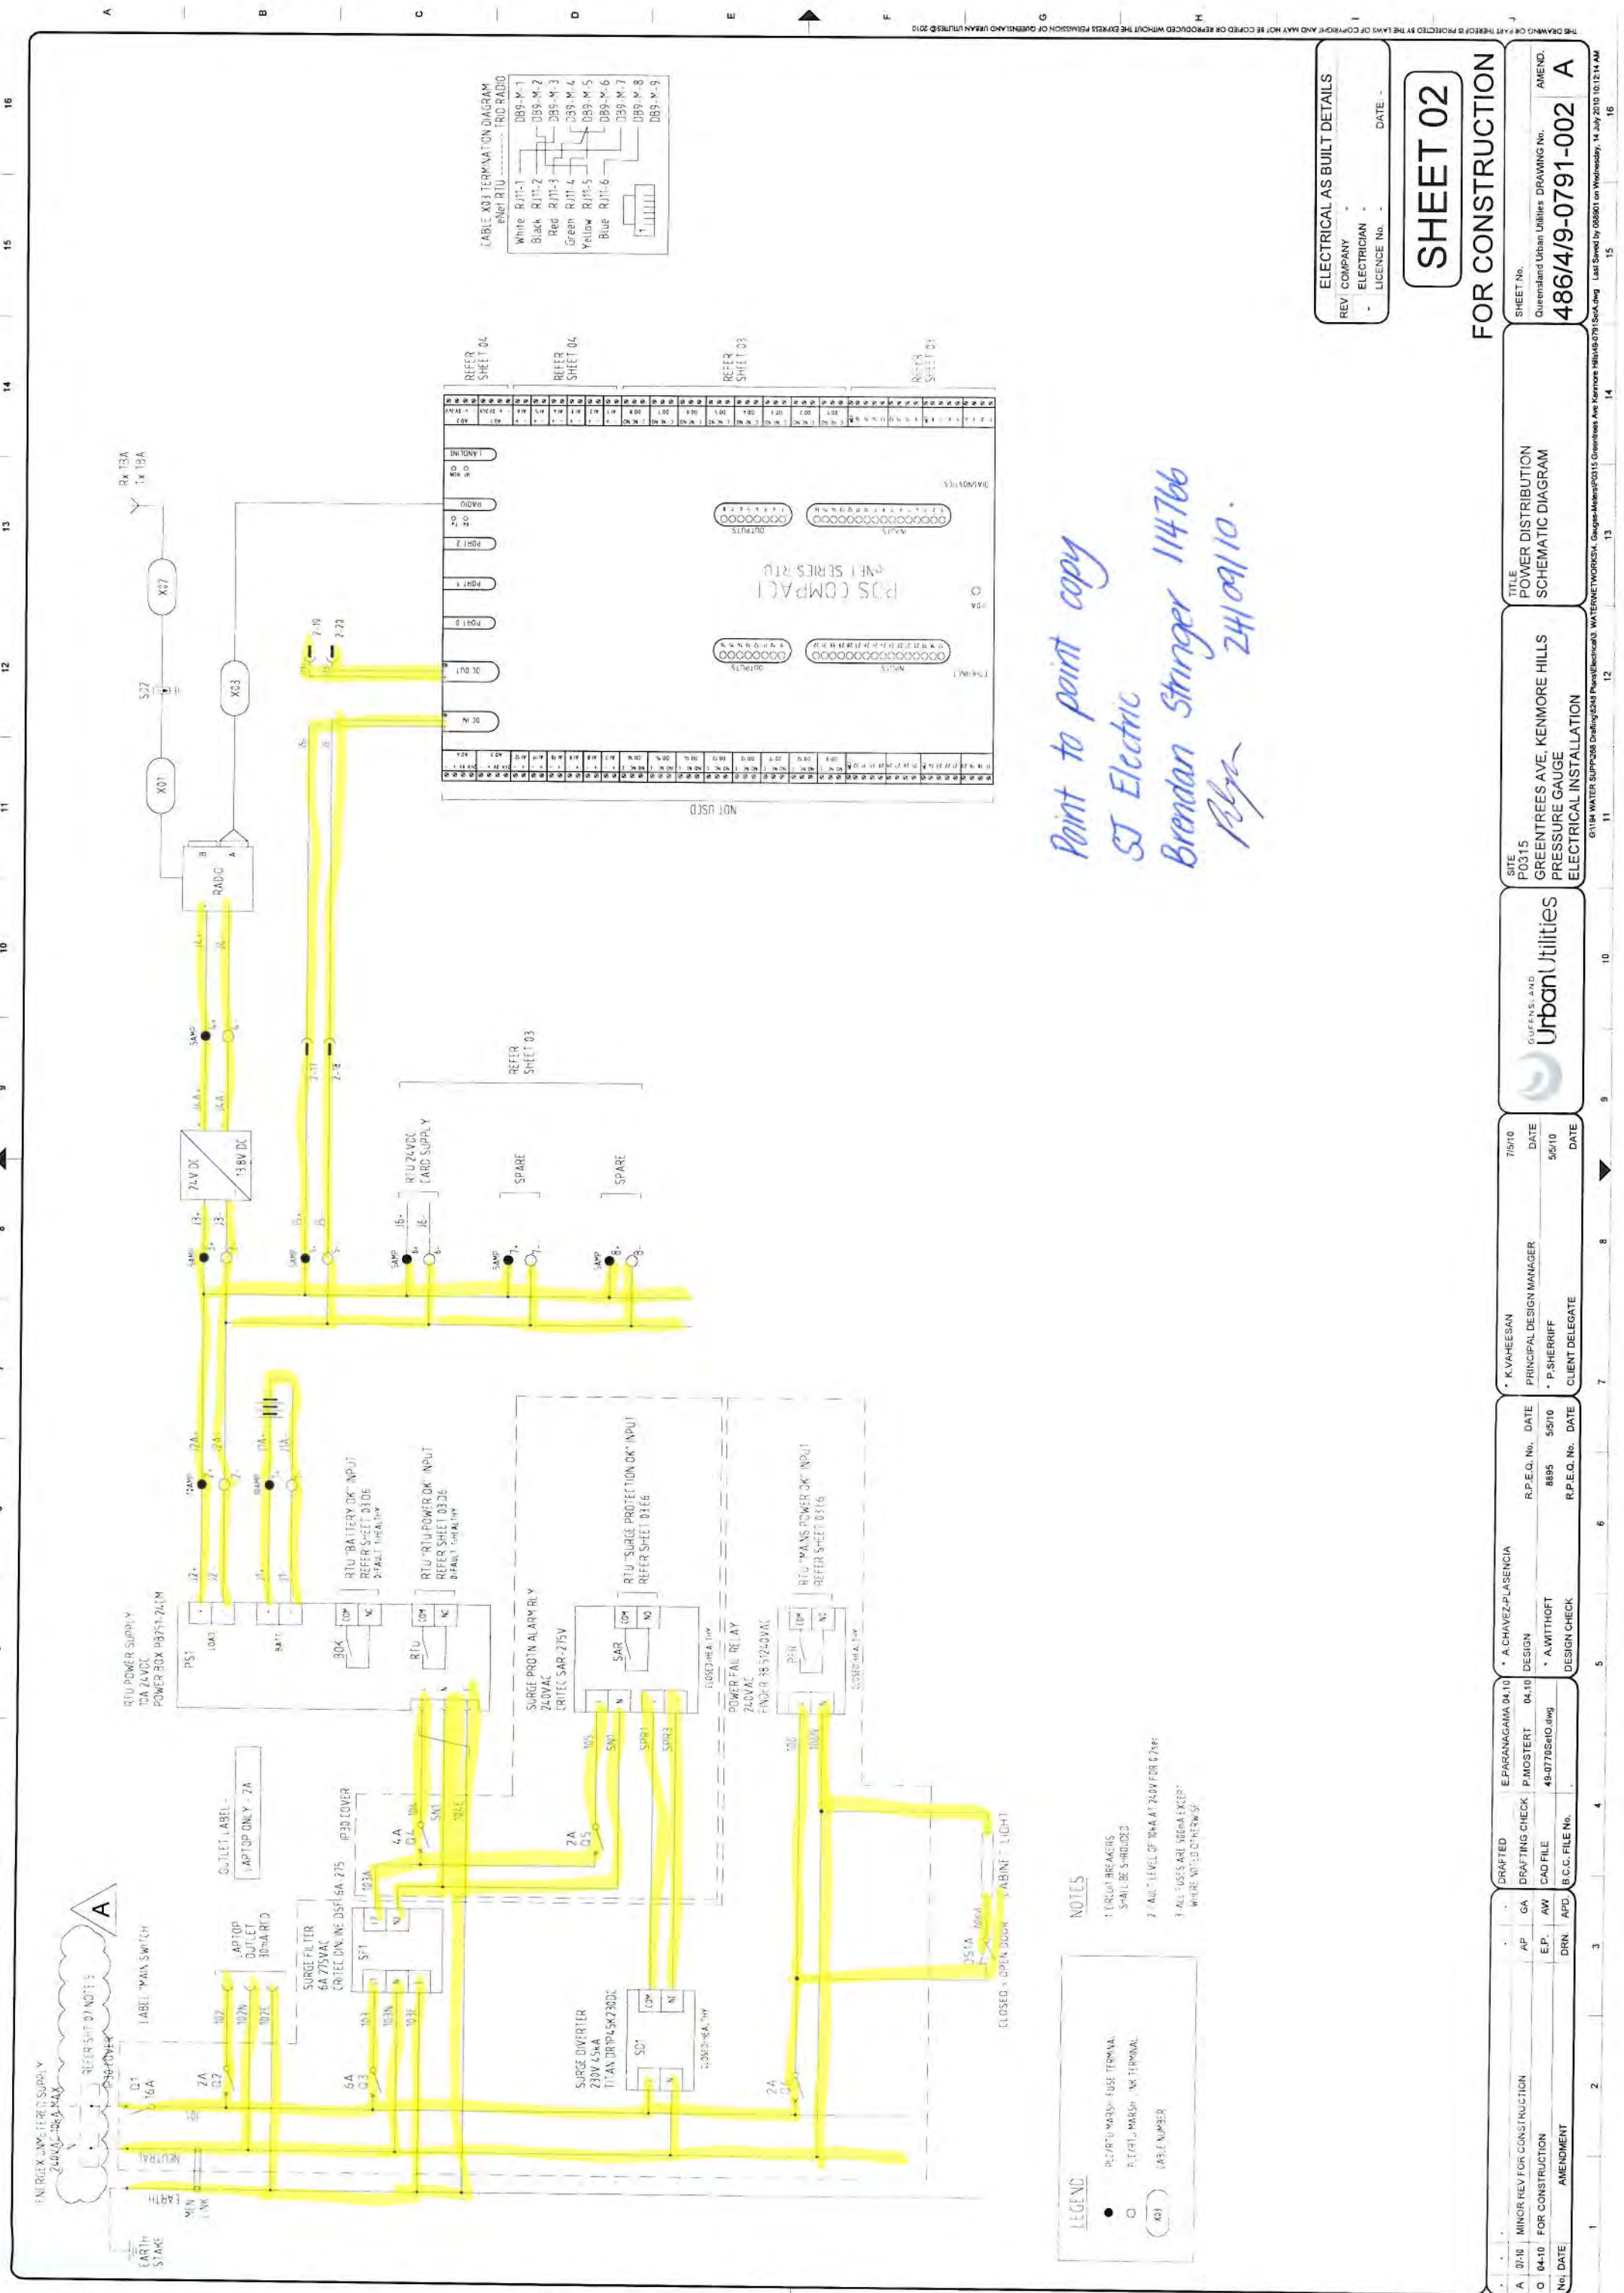

Point to point copy  
ST Electric  
Brendan Stringer 114766  
Rly 24/09/10.

ELECTRICAL AS BUILT DETAILS  
REV COMPANY  
ELECTRICIAN  
LICENCE No. DATE

# SHEET 02

FOR CONSTRUCTION

SHEET No.  
486/4/9-0791-002  
AMEND.  
A

TITLE  
POWER DISTRIBUTION  
SCHEMATIC DIAGRAM

SITE  
P0315  
GREENTREES AVE, KENMORE HILLS  
PRESSURE GAUGE  
ELECTRICAL INSTALLATION

UrbanUtilities  
K. VAHEESAN  
PRINCIPAL DESIGN MANAGER  
P. SHERIFF  
CLIENT DELEGATE

DRAFTED  
E. PARANAGAMA 04/10  
DRAFTING CHECK  
P. MOSTERT 04/10  
CAD FILE  
48-0778S01.dwg  
B.C.G. FILE No.  
APD

R.P.E.Q. No.  
8895  
DATE  
5/5/10  
DESIGN CHECK  
R.P.E.Q. No.  
DATE

MINOR REV FOR CONSTRUCTION  
04/10  
FOR CONSTRUCTION  
AMENDMENT  
APD


## LEGEND

- PLANT MARKS - FUSE TERMINAL
- PLANT MARKS - WIRE TERMINAL
- CABLE NUMBER

## NOTES

1. ALL BREAKERS SHALL BE SHUT DOWN
2. ALL LEVELS OF WORK AT 24V FOR 0.7sec
3. ALL WORKS ARE 100% EXCEPT WHERE NOTED OTHERWISE



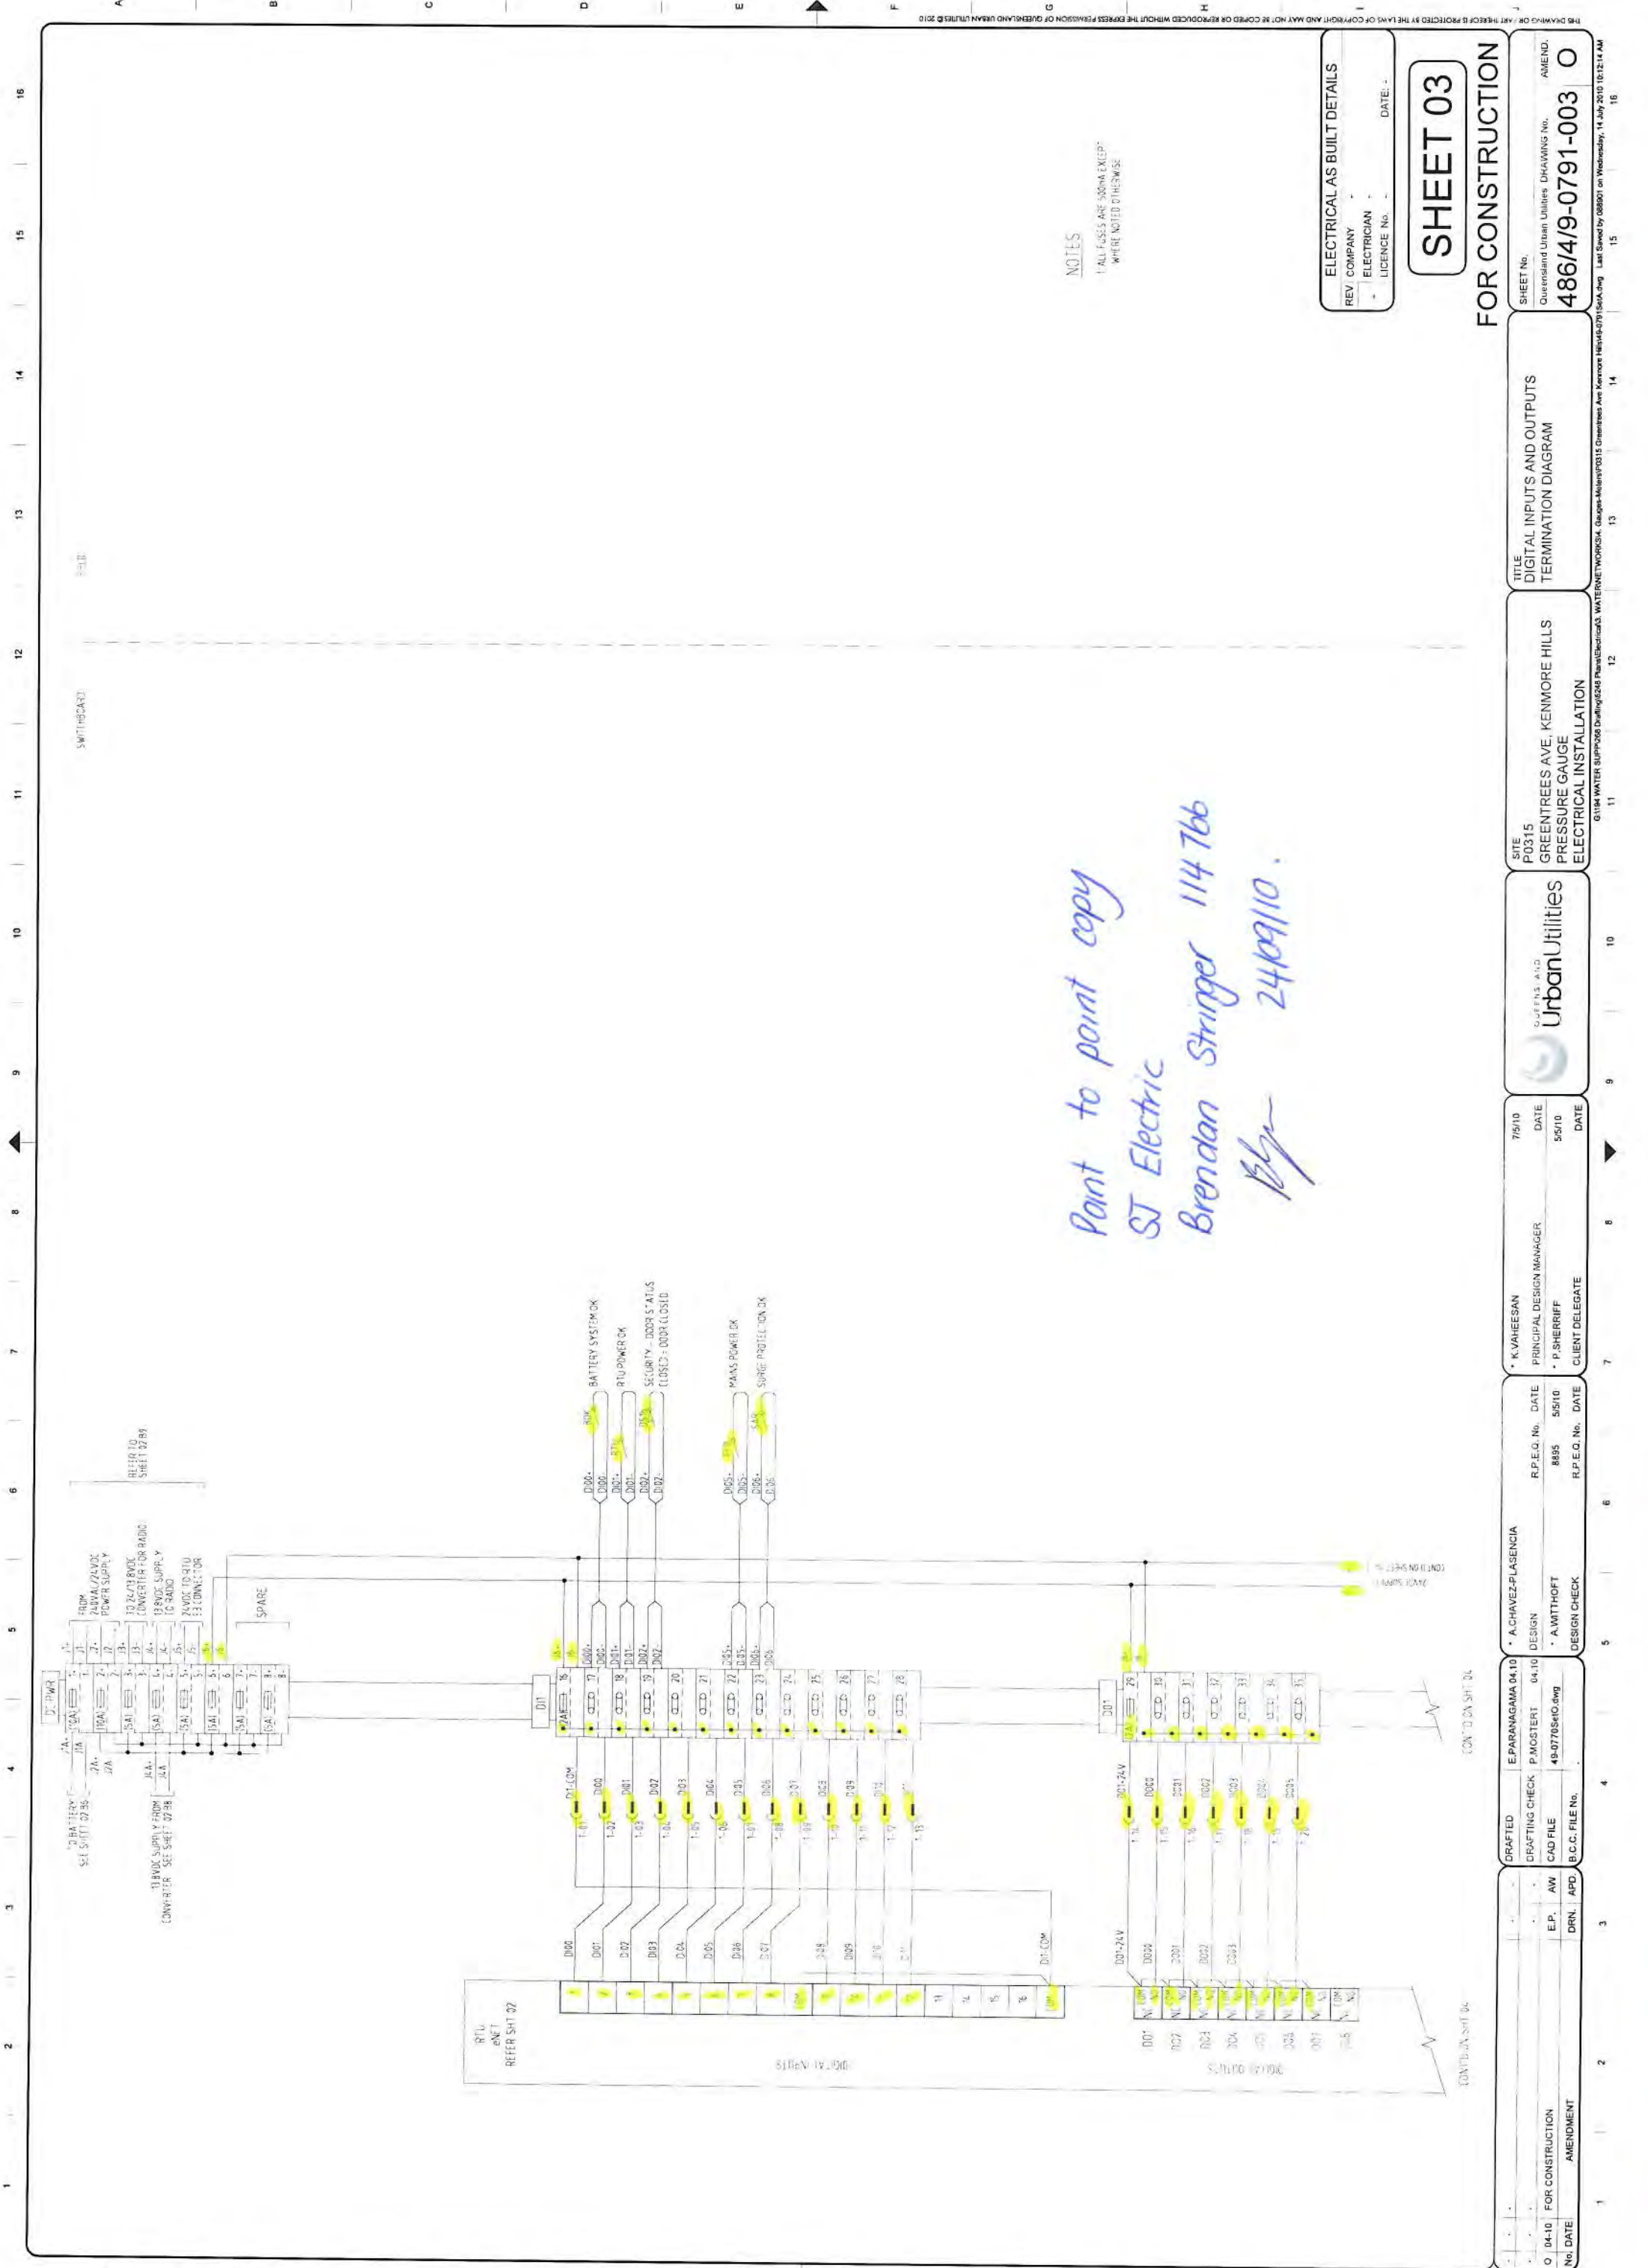


NOTES  
1. ALL FUSES ARE 500mA EXCEPT WHERE NOTED OTHERWISE

ELECTRICAL AS BUILT DETAILS			
REV	COMPANY	ELECTRICIAN	DATE
1	Queensland Urban Utilities		
2			

**SHEET 03**

**FOR CONSTRUCTION**

SHEET No.		TITLE		SITE		QUEENSLAND Urban Utilities		7/5/10		R.P.E.Q. No.		DESIGN		DRAFTED		FOR CONSTRUCTION		AMENDMENT	
486/4/9-0791-003		DIGITAL INPUTS AND OUTPUTS TERMINATION DIAGRAM		P0315 GREENTREES AVE, KENMORE HILLS PRESSURE GAUGE ELECTRICAL INSTALLATION		Urban Utilities		DATE		8895		A. MITTHOFF		E.P. AW		04-10			
AMEND.		DRAWING No.		Last Saved by: 088901 on Wednesday, 14 July 2010 (0:12:14 AM)				DATE		R.P.E.Q. No.		DESIGN		CAD FILE		04-10			
486/4/9-0791-003		DRAWING No.		Last Saved by: 088901 on Wednesday, 14 July 2010 (0:12:14 AM)				DATE		R.P.E.Q. No.		DESIGN		CAD FILE		04-10			

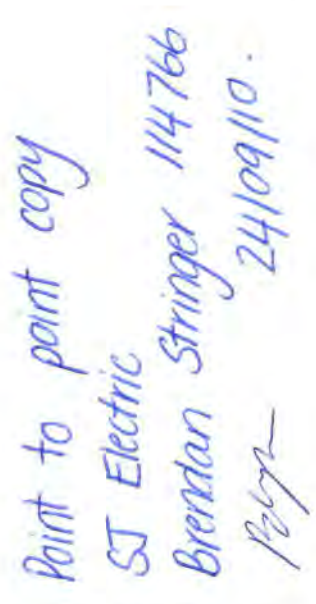

\* ALL FUSES ARE 500mA EXCEPT WHERE NOTED OTHERWISE

DATE: -

FOR CONSTRUCTION

A	06-10	MINOR REV FOR CONSTRUCTION	DPM	GA
O	04-10	FOR CONSTRUCTION	E.P.	AW
No.	DATE	AMENDMENT	DRN.	APD.

# TITLE

SITE  
P0315

01/01/17

100

DESIGN

DRAFTING CHECK	P M01STEST	04 10
----------------	------------	-------

A	06-10	MINOR REV FOR CONSTRUCTION	DPM	GA
---	-------	----------------------------	-----	----



Test copy  
ST Electric  
Brendan Stringer 114766  
Plyp- 2409110



# P0315 GREENTREES AVE, KENMORE HILLS PRESSURE GAUGE SWITCHBOARD

DRAWING VARIABLE		DRAWING LAYER	
1	Variable / Layer	Value / On or Off	
2	Site ID: 001	P0315	
3	Sheet Name: 027	GREENTREES AVE	
4	Sub Name: 031	KENMORE HILLS	
5	Pressure Gauge No: 004	P0315	
6	Pressure Gauge No: 005		
7	Pressure Gauge No: 006		
8	Pressure Gauge No: 007		
200	Pressure Gauge No: 199		

## ELECTRICAL DRAWINGS INDEX

DWG N°	TITLE	SHEET	REVISIONS
486/14/9-0791-001	ELECTRICAL DRAWING INDEX	01	A
486/14/9-0791-002	POWER DISTRIBUTION SCHEMATIC DIAGRAM	02	A
486/14/9-0791-003	DIGITAL INPUTS AND OUTPUTS TERMINATION DIAGRAM	03	A
486/14/9-0791-004	ANALOG INPUTS AND OUTPUTS TERMINATION DIAGRAM	04	A
486/14/9-0791-005	SWITCHBOARD GENERAL ARRANGEMENT	05	A
486/14/9-0791-006	SWITCHBOARD CONSTRUCTION DETAILS	06	A
486/14/9-0791-007	SWITCHBOARD EQUIPMENT LIST	07	A
486/14/9-0791-008	SWITCHBOARD CABLE SCHEDULE & LABEL SCHEDULE	08	A
486/14/9-0791-009	SWITCHBOARD SITE LAYOUT	09	A
486/14/9-0791-010	SPARE		

ELECTRICAL AS BUILT DETAILS

REV: COMPANY: ELECTRICIAN: LICENCE No: DATE: -

SHEET 01

FOR CONSTRUCTION

06/10	MINOR REV FOR CONSTRUCTION	DPM	GA	DRAFTING CHECK	E. PAPANAGAMA 04.10	7/5/10	PRINCIPAL DESIGN MANAGER	DATE	7/5/10
04/10	FOR CONSTRUCTION	E.P.	AW	CAD FILE	P. MOSTERT 49-0791SetA.dwg	5/5/10	P. SHERIFF	DATE	5/5/10
No. DATE	AMENDMENT	DRN	APP	B.C.C. FILE No.			CLIENT DELEGATE	DATE	

QUEENSLAND UrbanUtilities

SITE P0315  
GREENTREES AVE, KENMORE HILLS  
PRESSURE GAUGE  
ELECTRICAL INSTALLATION

TITLE ELECTRICAL DRAWINGS INDEX

SHEET No. 486/14/9-0791-001  
AMEND. 01

THE DRAWING OR PART THEREOF IS PROTECTED BY THE LAWS OF COPYRIGHT AND MAY NOT BE COPIED OR REPRODUCED WITHOUT THE EXPRESS PERMISSION OF QUEENSLAND URBAN UTILITIES © 2010

61194 WATER SUPPLY 028 Drafting 044 Parametric 033 WATER NETWORKS 044 Parametric 033 GreenTrees Ave Kenmore Hills 044 Parametric 033 Last Saved by 08801 on Wednesday, 14 July 2010 10:12:14 AM



16

15

14

13

12

11

10

9

8

7

6


5

4

3


2

1

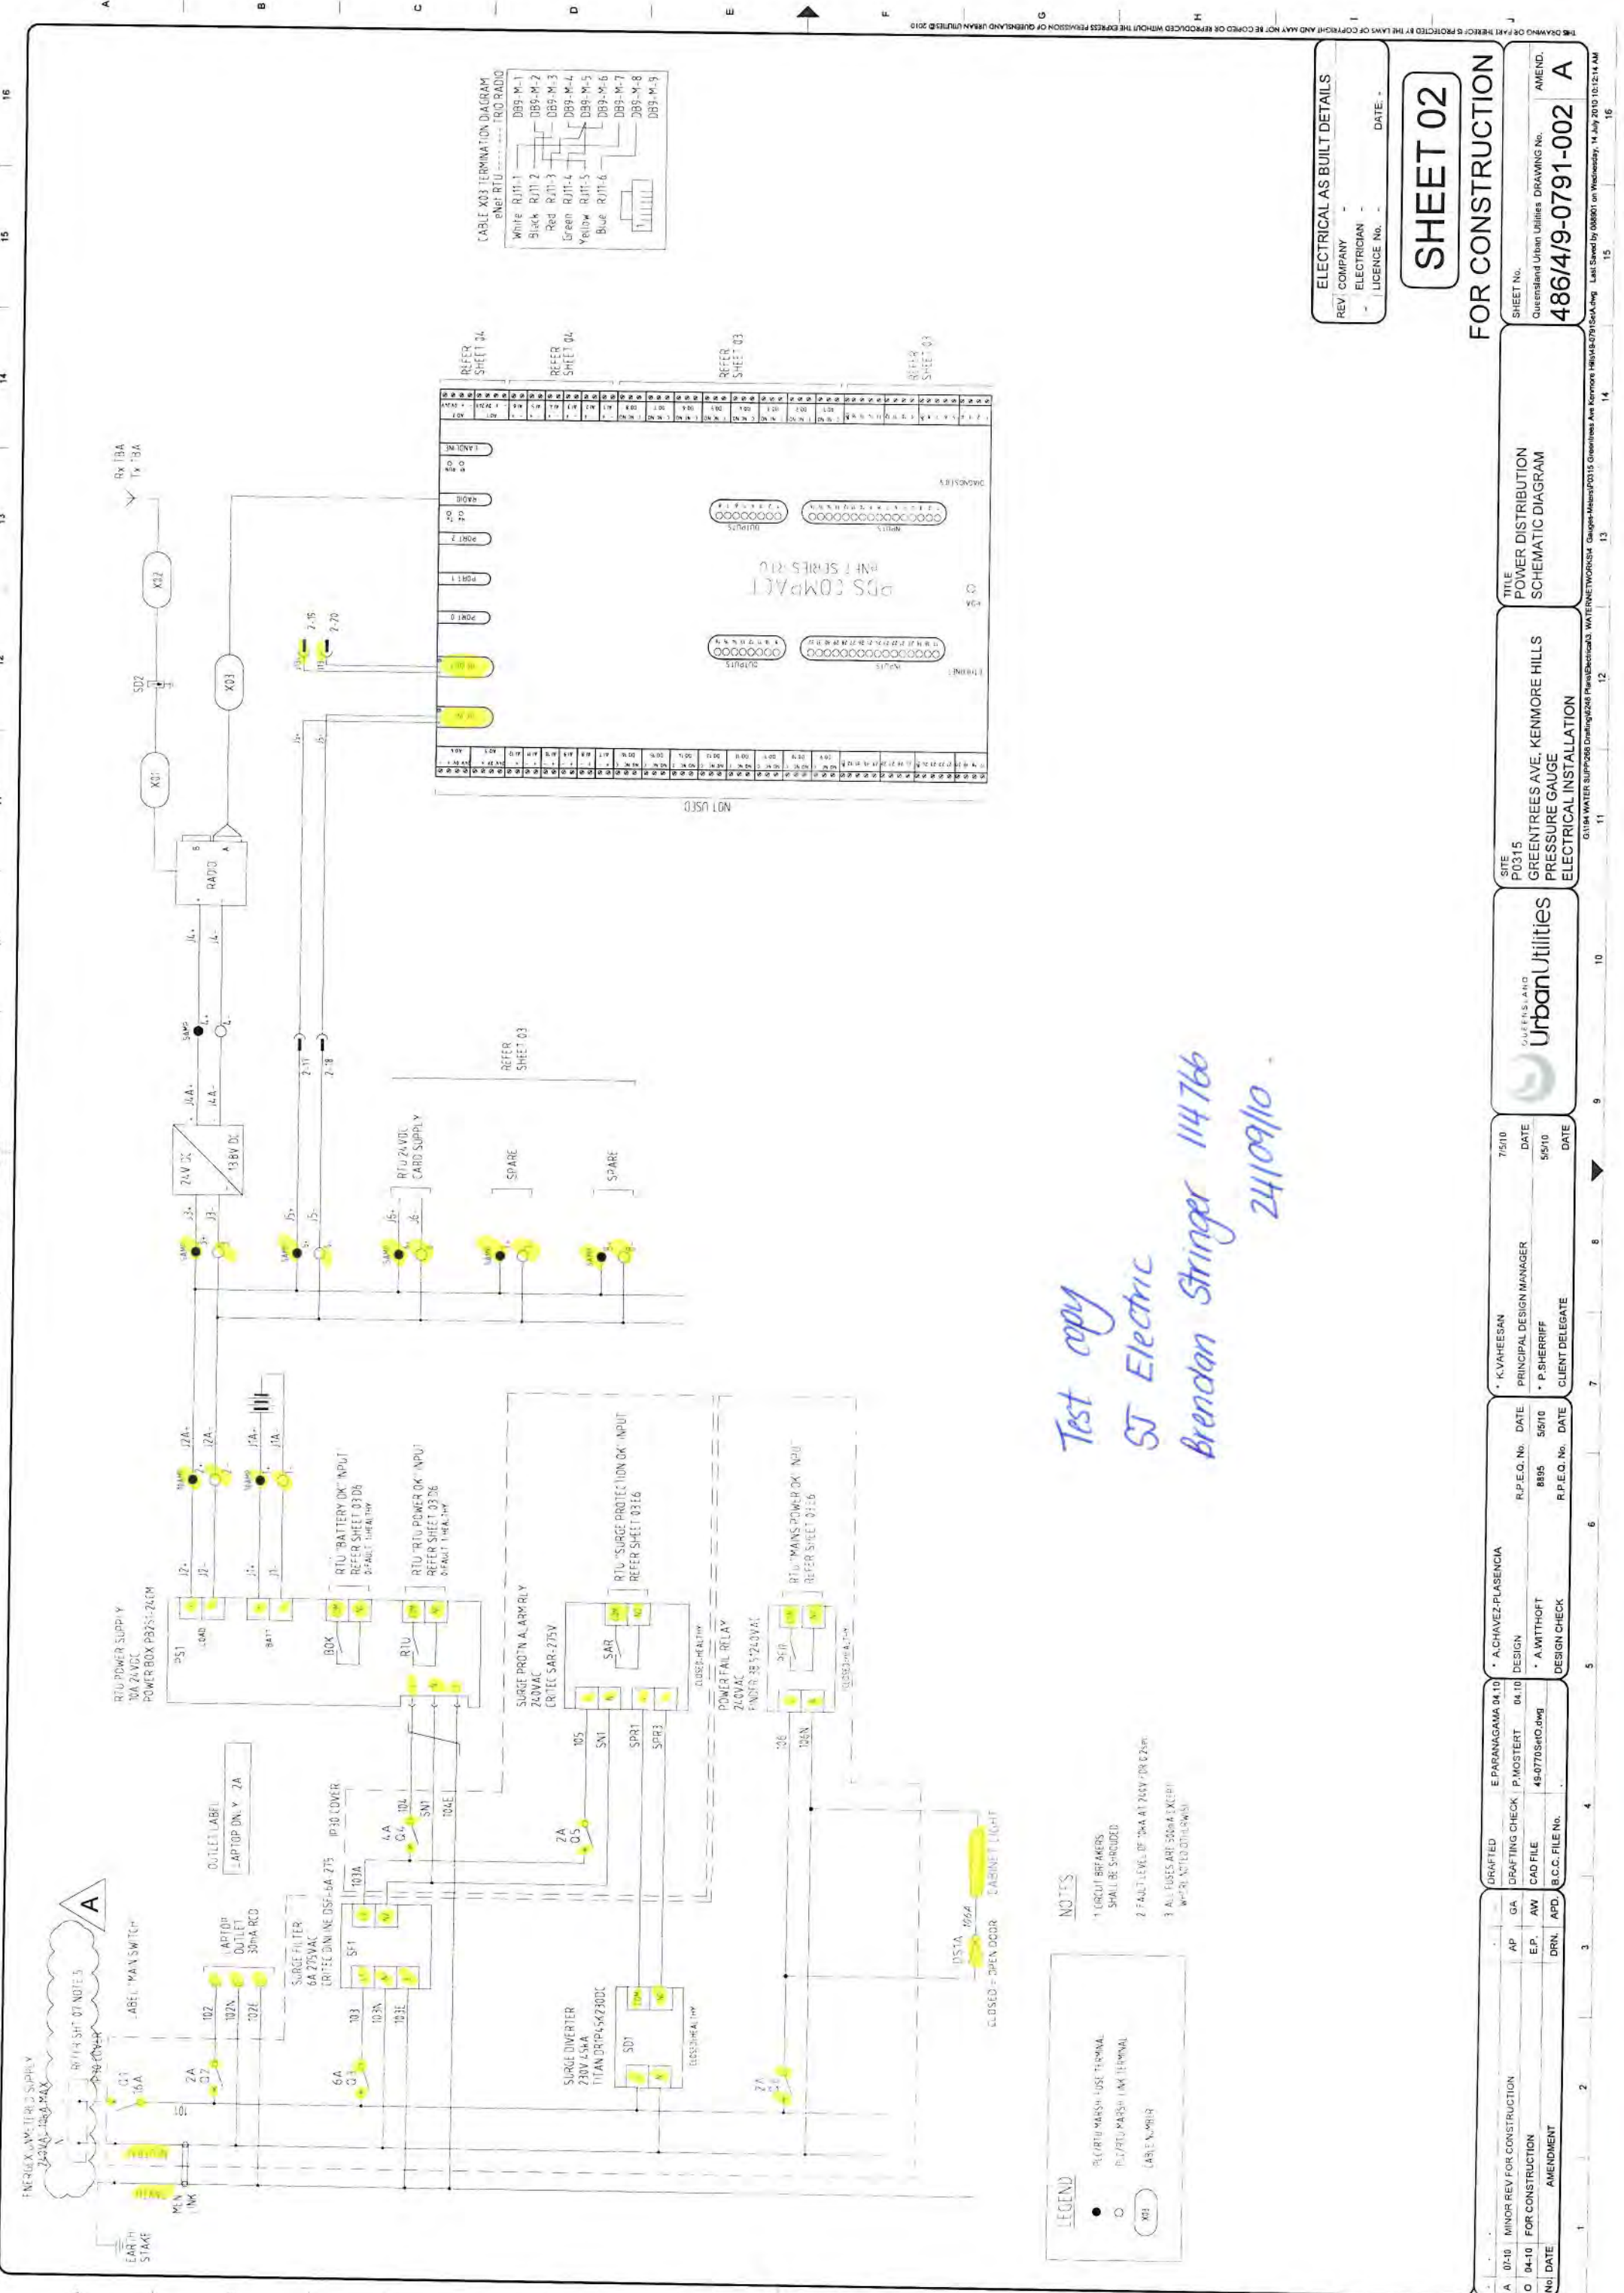

Test copy  
ST Electric  
Brendan Stringer 114766  
24109/10

- NOTES**
- 1. CIRCUIT BREAKERS SHALL BE SHROUDED
  - 2. FAULT LEVEL OF 20KA AT 765V FOR 0.25ms
  - 3. ALL FUSES ARE 500KA EXCEPT WHERE NOTED OTHERWISE

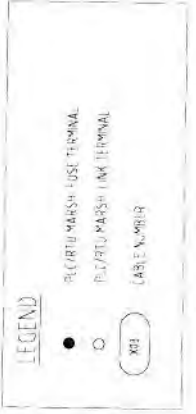

**ELECTRICAL AS BUILT DETAILS**

REV	COMPANY	ELECTRICIAN	LICENCE No.	DATE

**SHEET 02**

FOR CONSTRUCTION

DRAWING INFORMATION		DESIGN INFORMATION		CLIENT INFORMATION		DATE INFORMATION	
NO.	DATE	DESIGNER	DATE	CLIENT	DATE	DATE	DATE
04-10	FOR CONSTRUCTION	AP	GA	AP	GA	AP	GA
04-10	AMENDMENT	AP	GA	AP	GA	AP	GA

**Urban Utilities**

**POWER DISTRIBUTION SCHEMATIC DIAGRAM**

**SITE P0315 GREEN TREES AVE, KENMORE HILLS PRESSURE GAUGE ELECTRICAL INSTALLATION**

**PROJECT NO. 486/49-0791-002**

**AMEND. A**

**DATE: 14 July 2010 10:21 AM**





ALL FUSES ARE 500mA EXCEPT WHERE NOTED OTHERWISE.

DATE:

**SHEET 03**

FOR CONSTRUCTION

**TITLE**  
**DIGITAL INPUTS AND OUTPUTS**  
**TERMINATION DIAGRAM**

SITE  
P0315  
GREENTREES AVE, KENMORE HILLS  
PRESSURE GAUGE  
ELECTRICAL INSTALLATION

COPIES AND  
Urban Utilities

K. VAHEESAN 7/5/10

TEZ-PLASENCIA

DRAFTED


$$\frac{1}{1}$$

1

1

Pc



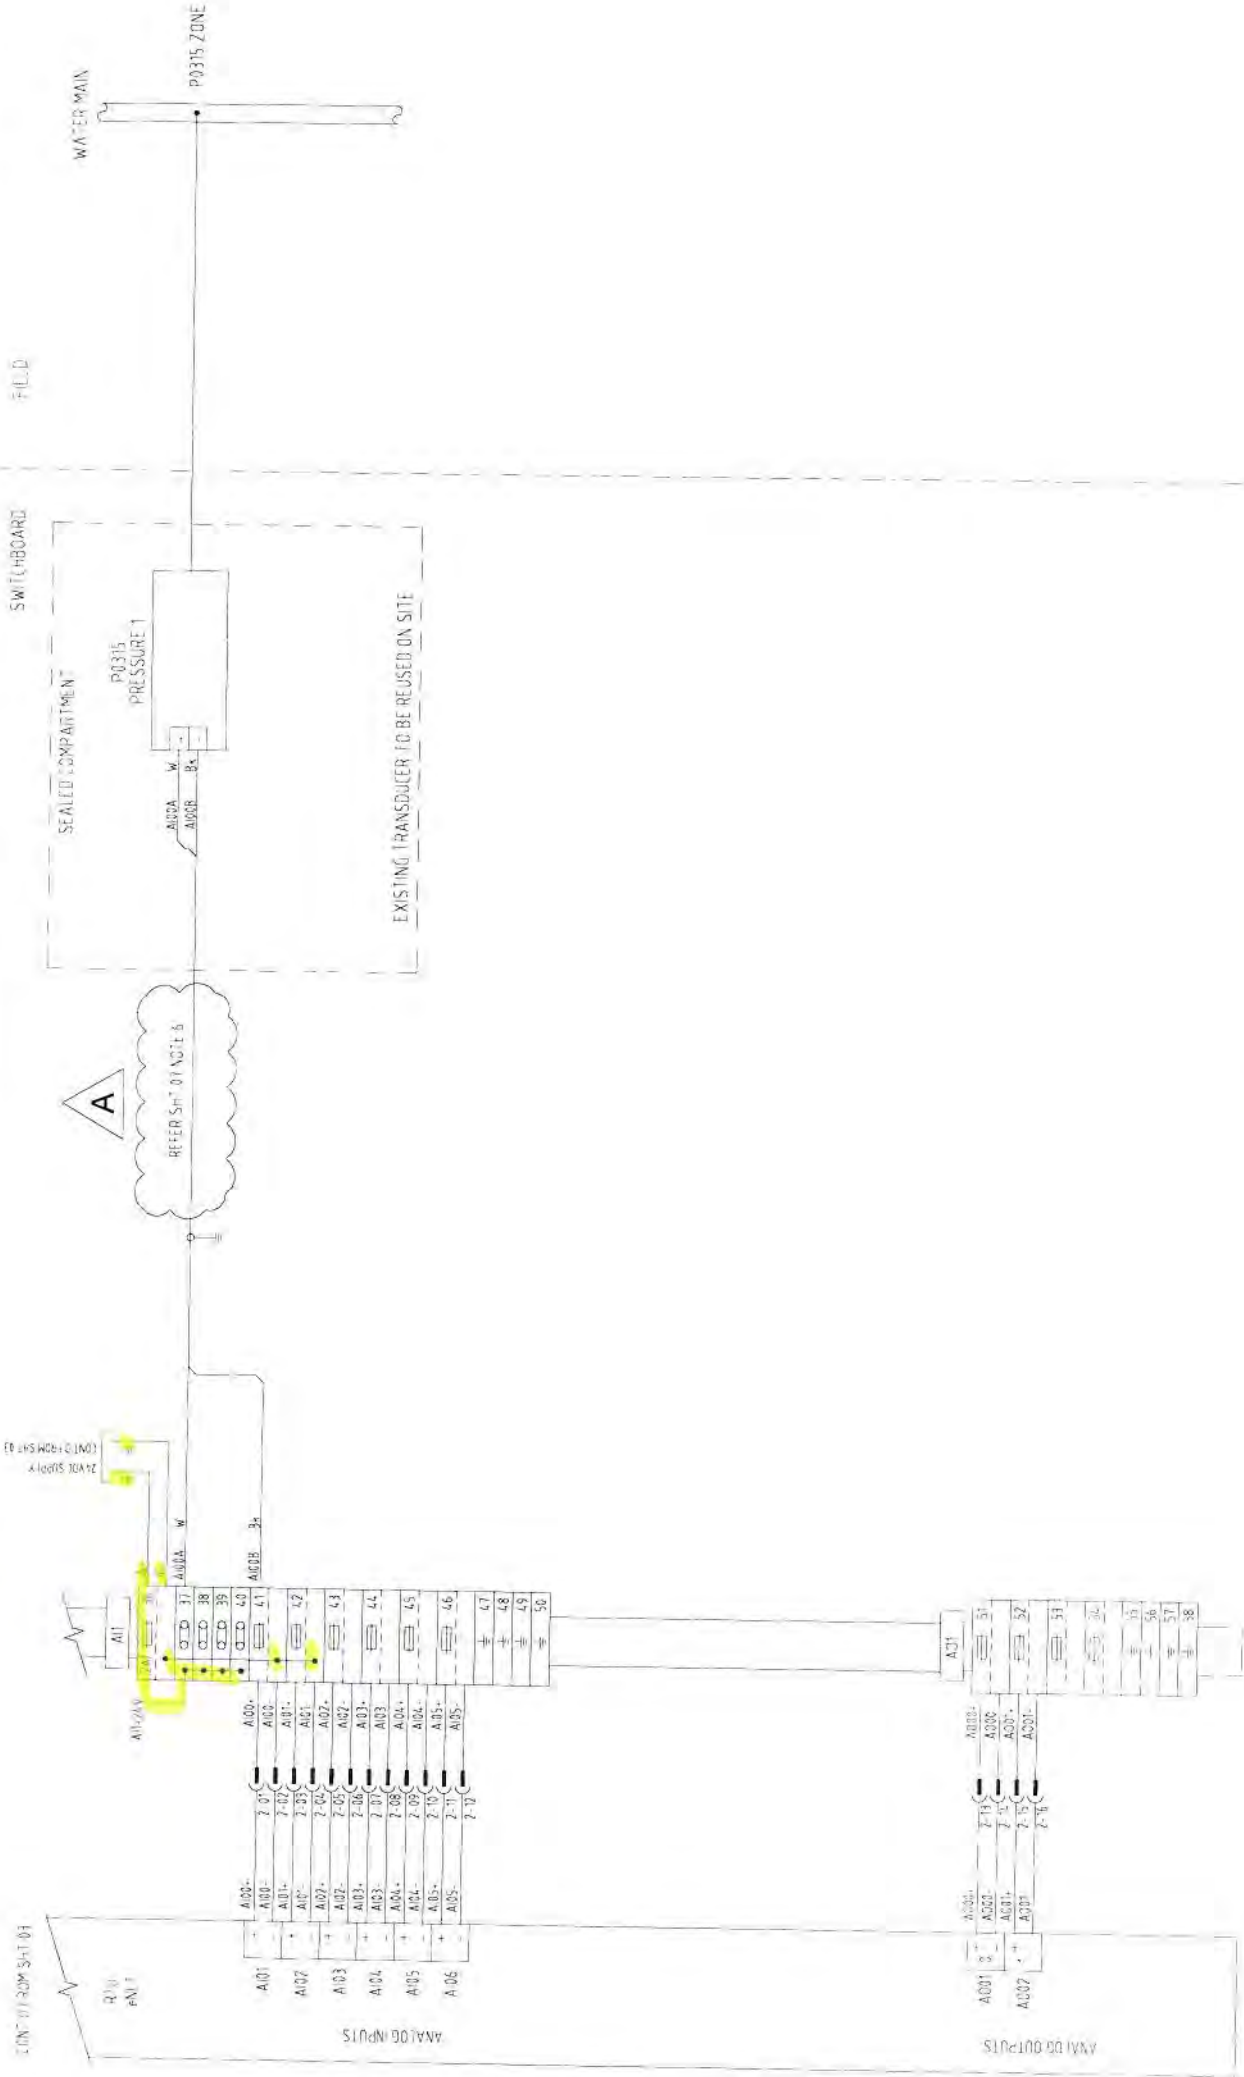

Test copy  
ST Electric  
Brendan Stringer 114766  
24/09/10

NOTES  
1. ALL FUSIBLES ARE 500mA EXCEPT WHERE NOTED OTHERWISE.

ELECTRICAL AS BUILT DETAILS			
REV	COMPANY	ELECTRICIAN	DATE
-	-	-	-

SHEET 04

FOR CONSTRUCTION

SITE P0315 GREENTREES AVE, KENMORE HILLS PRESSURE GAUGE ELECTRICAL INSTALLATION		TITLE ANALOG INPUTS AND OUTPUTS TERMINATION DIAGRAM		SHEET No. 486/4/9-0791-004 AMEND. A	
DRAFTED DRAFTING CHECK CAD FILE B.C.C. FILE No.		DESIGN R.P.E.C. No. 8895 R.P.E.C. No. 55/10		PRINCIPAL DESIGN MANAGER K. VAHEESAN CLIENT DELEGATE P. SHERIFF	
MINOR REV FOR CONSTRUCTION FOR CONSTRUCTION AMENDMENT		GA AW E.P. DRN APD		DATE DATE DATE DATE DATE	

# 5. COMPLIANCE CERTIFCATES



Ref: Test Certificate P0315

## TEST CERTIFICATE

SJ Electric (Qld) Pty. Ltd.  
19 Elliot Street.  
Albion Qld. 4010  
R.E.C. 7623

Attention: Wendy Wong

Level 2 TC Beirne Centre, 315 Brunswick Street Mall, Fortitude Valley Q 4006

Work performed for Brisbane Water at P0315 Greentrees Avenue Kenmore Hills 4069 under contract  
BW: 70103-048 (SJ Electric Job Number WT400106)

### Installation Tested / Equipment Tested

- New PRV switchboard
- New main earth
- Earth bonding to main earth link and all switchboard components.

All supporting test sheets attached.

Test Date  
26/10/10

For the electrical installation, this certificate certifies that the electrical installation to the extent it is affected by the electrical work has been tested to ensure it is electrically safe and is in accordance with the requirements of the wiring rules and the electrical safety regulation 2002. C.J. Holmes (endorsee to electrical contracting license 7623)

For the electrical equipment, this certificate certifies that the electrical equipment, to the extent it is affected by the electrical work, is electrically safe. C.J. Holmes (endorsee to electrical contracting license 7623)

Signed.

A handwritten signature in black ink, appearing to be 'CJH' or similar, written over a horizontal line.