

---

# **COMMON LOGIC PTY LTD**

ACN. 011 029 262

**Electrical Contractors**

***Contract No: BW.60095-05/06  
PS235 Pioneer St***

## ***Electrical Manual***

ISSUE NO 1  
AS BUILT  
15/11/2006

**Unit 9/58 Wecker Road, Mansfield, Queensland 4122  
Telephone (07) 3849 7449 Fax (07) 3343 5210  
JH86**

---

JH86Mj06

**COMMON LOGIC Pty Ltd**  
**Specialist Electrical Contractors**
**Electrical Manual**

Subject: Pioneer Cres SP235

Sheet: 1  
Of: 9Section  
1

Page Revision No:

Date: 17/11/06

Manual Issue No: 1 Date: 17/11/06

<b><u>1.0</u></b>	<b><u>GENERAL</u></b>	<b><u>2</u></b>
<b><u>2.0</u></b>	<b><u>OPERATIONAL DESCRIPTION</u></b>	<b><u>3</u></b>
<b>2.1</b>	<b>GENERATOR</b>	<b>3</b>
<b>2.2</b>	<b>RTU</b>	<b>3</b>
<b>2.3</b>	<b>PUMP STARTER MCC</b>	<b>3</b>
2.3.1.	MCC MAIN SWITCH	3
2.3.2.	MAINS AVAILABLE INDICATOR	4
2.3.3.	MAINS FAIL IN MCC	4
2.3.4.	GENERATOR RUNNING.	4
<b>2.4</b>	<b>ATS CUBICLE</b>	<b>4</b>
2.4.1.	GENERATOR INTERFACE	4
2.4.2.	RTU INTERFACE	4
2.4.3.	ATS AND CONTROL	5
<b><u>3.0</u></b>	<b><u>DRAWINGS</u></b>	<b><u>6</u></b>
<b><u>4.0</u></b>	<b><u>PART LIST</u></b>	<b><u>7</u></b>
<b><u>5.0</u></b>	<b><u>TEST SHEETS</u></b>	<b><u>8</u></b>
<b><u>6.0</u></b>	<b><u>TECHNICAL INFORMATION</u></b>	<b><u>9</u></b>

Authorised By: Grant Kerr

**COMMON LOGIC Pty Ltd  
Specialist Electrical Contractors****Electrical Manual**

Subject: Pioneer Cres SP235

Sheet: 2  
Of: 9Section  
1

Page Revision No:

Date: 17/11/06

Manual Issue No: 1 Date: 17/11/06

**1.0 GENERAL**

The following document describes the operation of the switchgear and relays installed into the change over switchgear cubicle.

The document does NOT describe the detailed operation of the generator PLC or the operation of the pump starters on the site.

The generator is a plug in device and can be removed from site by BW at their discretion.

Authorised By: Grant Kerr

Subject: Pioneer Cres SP235

Sheet: 3  
Of: 9Section  
2

Page Revision No:

Date: 17/11/06

Manual Issue No: 1 Date: 17/11/06

## 2.0 OPERATIONAL DESCRIPTION

There are four components to the system. These are the Generator, RTU, Pump MCC, and the Generator change over switchgear. The last component will be described within this document in detail. The remaining devices will be described in the BW manual.

### 2.1 GENERATOR

The generator and associated PLC controls all automatic aspects of the change over switchgear, in affect making the basic transfer switch into an Automatic Transfer switch (ATS). The ATS will only operate if the generator PLC is fully operational.

The operation of the ATS is NOT fail safe and will NOT return to a predetermined condition on failure of the generator PLC or associated wiring.

Mains fail timing and return to mains timing is all controlled within the generator PLC.

### 2.2 RTU

The RTU monitors several generator alarm conditions and will report these conditions to the system as required.

The RTU can remotely start and stop the generator. The remote start will initiate a change over of the station to the generator. Stopping the generator will initiate a return to mains if available.

### 2.3 PUMP STARTER MCC

The pump starter MCC automatically starts and stops the pumps on demand determined by the wet well levels.

The starter has not been modified in any way to accommodate the generator ATS with the exception of the re-routing of the sub-mains cabling.

#### 2.3.1. MCC MAIN SWITCH

The Main Switch in all cases refers to the Energex supply point of isolation.

The existing main switch in the pump starter MCC, when labelled as the "Main Switch", will isolate the incoming Energex Mains Supply.

For complete isolation of the switchboards where an automatic generator system is supplied the generator must also be isolated.

This must be carried out at the generator CB in the generator canopy as well as switching the control to the "OFF" position.

Authorised By: Grant Kerr

**COMMON LOGIC Pty Ltd**  
**Specialist Electrical Contractors**
**Electrical Manual**

Subject: Pioneer Cres SP235

Sheet: 4  
Of: 9Section  
2

Page Revision No:

Date: 17/11/06

Manual Issue No: 1 Date: 17/11/06

**2.3.2. MAINS AVAILABLE INDICATOR**

The mains available indicator mounted on the common control escutcheon is supplied by 24VDC originating from the RTU control supply.  
The signal will be "ON" when the mains are healthy.

The mains available relay does indicate availability and correct rotation after 10 seconds.

**2.3.3. MAINS FAIL IN MCC**

The mains fail relay in the MCC is the device that assures the system has the correct rotation and supply available for the pumps to operate.  
When re-connecting the generator to a site it is necessary to check the generator voltage rotation is also correct.

**2.3.4. GENERATOR RUNNING.**

The generator running indicator is supplied by 24VDC originating from the RTU control supply.  
The indicator will be "ON" when the generator is running as determined by the generator PLC. IE GRR relay is on.

**2.4 ATS CUBICLE**

The ATS cubicle comprises sections as described below.

**2.4.1. GENERATOR INTERFACE**

The generator interface is via a Clipsal 27 Pin plug and socket.  
The multicore cable is connected core 1 to pin 1 and 2-2 etc.  
The Multicore cable is labelled wire No. G01 for core 1 to pin 1 and No.G02 –Core2- Pin2 etc.  
This enables simple and quick reference to all wiring between the plug and the hardware within the ATS cubicle.  
All signals received from the generator are arranged to switch a relay powered from the generator 24VDC system.  
The exception to this is the "Generator Not On Site" signal, which wires directly to the RTU via the interface terminals.

All control signals to the Generator are via clean contacts. Both sides of the contact are issued to the generator. These contacts switch relays in the generator panel and are powered via the generator 24VDC system.

**2.4.2. RTU INTERFACE**

The RTU interface is via a hard wired loom or multicore cable and terminals.  
The Loom cable is numbered with the terminal RTU IO numbers.  
The RTU connections are different for each site and may also have different polarities for each site according to the site hardware.

Authorised By: Grant Kerr

**COMMON LOGIC Pty Ltd**  
**Specialist Electrical Contractors**
**Electrical Manual**

Subject: Pioneer Cres SP235

Sheet: 5  
Of: 9Section  
2

Page Revision No:

Date: 17/11/06

Manual Issue No: 1 Date: 17/11/06

All signals received from the RTU are arranged to switch a relay powered from the RTU 24VDC system. IE Remote Exercise Generator only.

All signals to the RTU are via clean contacts. Both sides of the contact are issued to the RTU system. These contacts switch directly into the RTU Input cards. The voltage on these signal cables is 24VDC supplied from the RTU power supply.

### 2.4.3. ATS AND CONTROL

The transfer switch is a Terasaki Basic Transfer switch.

The control of this switch is only achieved from the generator PLC. The PLC controls the relays CTSN and CTSG within the ATS panel.

Energising CTSN if the Mains Volts are available will open the Generator CB and Close the Mains CB.

Energising CTSG if the Generator Volts are available will open the Mains CB and Close the Generator CB.

If volts are not available the motors in the BTS will not operate. (IE stay in the last condition.

If the BTS does not operate the PLC will remove the transfer signal and assume a fault condition. This condition required manual operator intervention.

#### **Manual Operation:**

**If manual operation is desired then the following steps must be carried out. Please note that it is not necessary to remove any covers when manually operating the CB's.**

If the PLC is issuing an undesirable status then the operation of the CB motors must first be isolated. This is best achieved by switching the CB's QM1 and QG1 to the off position. This removes the motor charge and open close commands to the operators. If the PLC is not affecting the transfer switch these CB's may be left in the ON state.

#### **Manual Open:**

To open a CB press the trip button on the motor operator "OR" toggle the spring wind mechanism until the CB opens and the open state shows in the window.

#### **Manual Close:**

To close a CB wind the motor spring wind mechanism until the CB closes and the Closed state shows in the window.

#### **Mains Fail detection:**

The mains fail relay detects the condition of the mains and issues a mains fail start signal to the PLC.

The mains fail relay also operates the mains available indicator on the MCC common control panel.

The mains fail signal also issues a condition to the RTU to indicate mains failed when the relay is de-energised.

Authorised By: Grant Kerr

**COMMON LOGIC Pty Ltd**  
**Specialist Electrical Contractors****Electrical Manual**

Subject: Pioneer Cres SP235

Sheet: 6  
Of: 9Section  
3

Page Revision No:

Date: 17/11/06

Manual Issue No: 1 Date: 17/11/06


**3.0 DRAWINGS**

Authorised By: Grant Kerr

IF IN DOUBT, ASK.


ROOF SIDE VIEW

2 ROOF TYPE


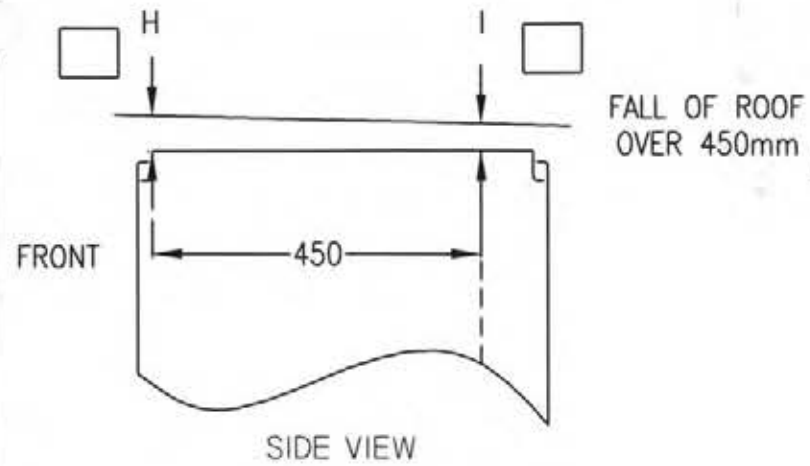


EXISTING BOARD DEPTH

MINIMUM SPACE FOR ANTENNA

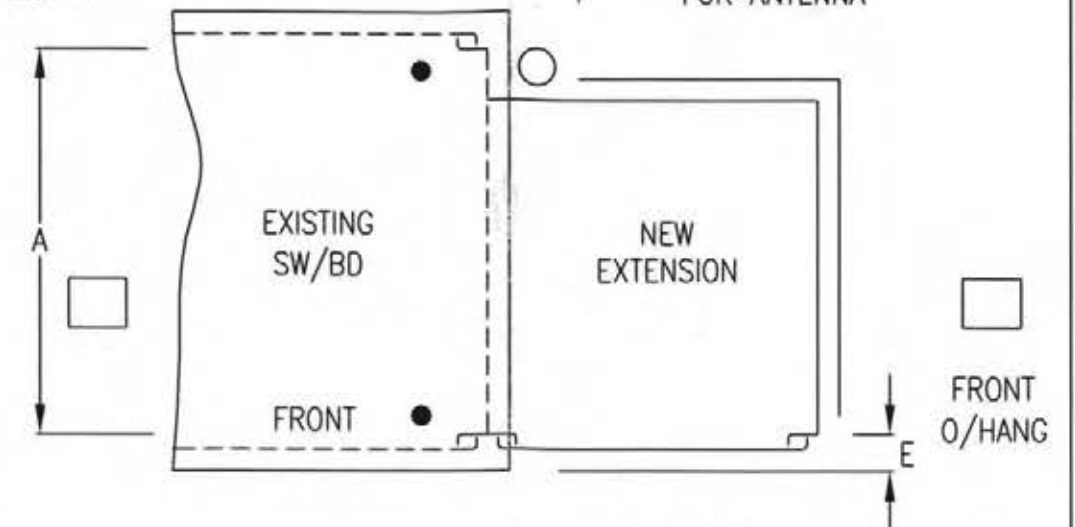

TOP VIEW

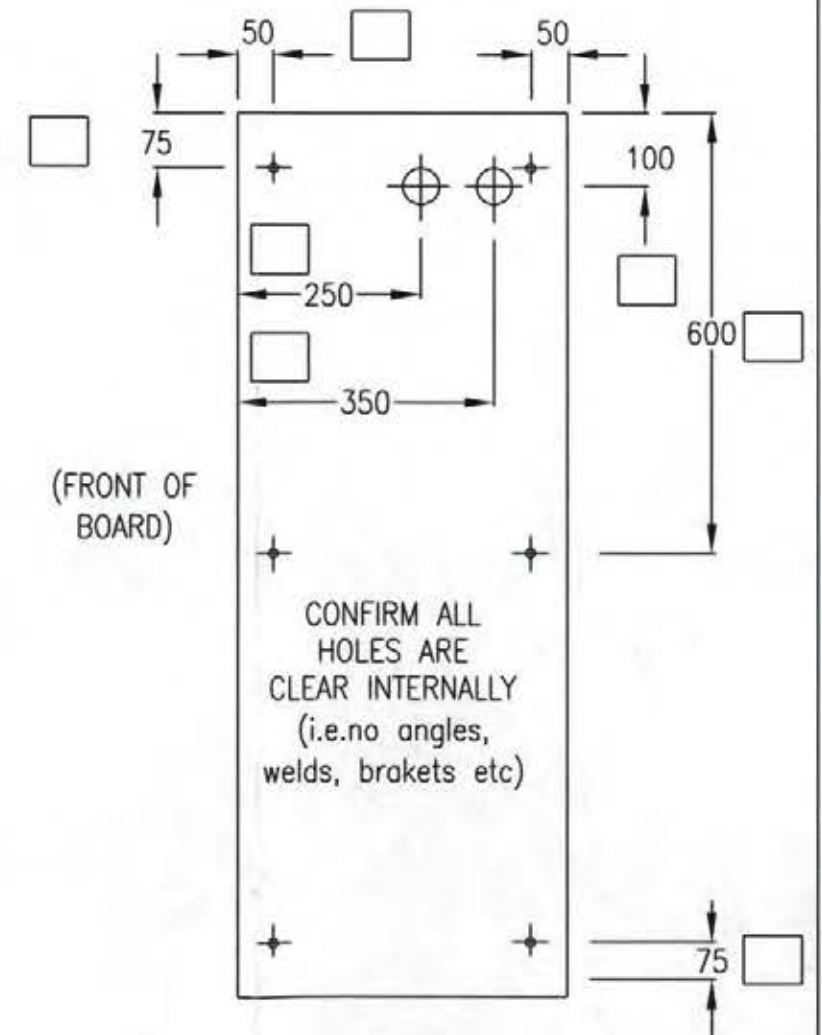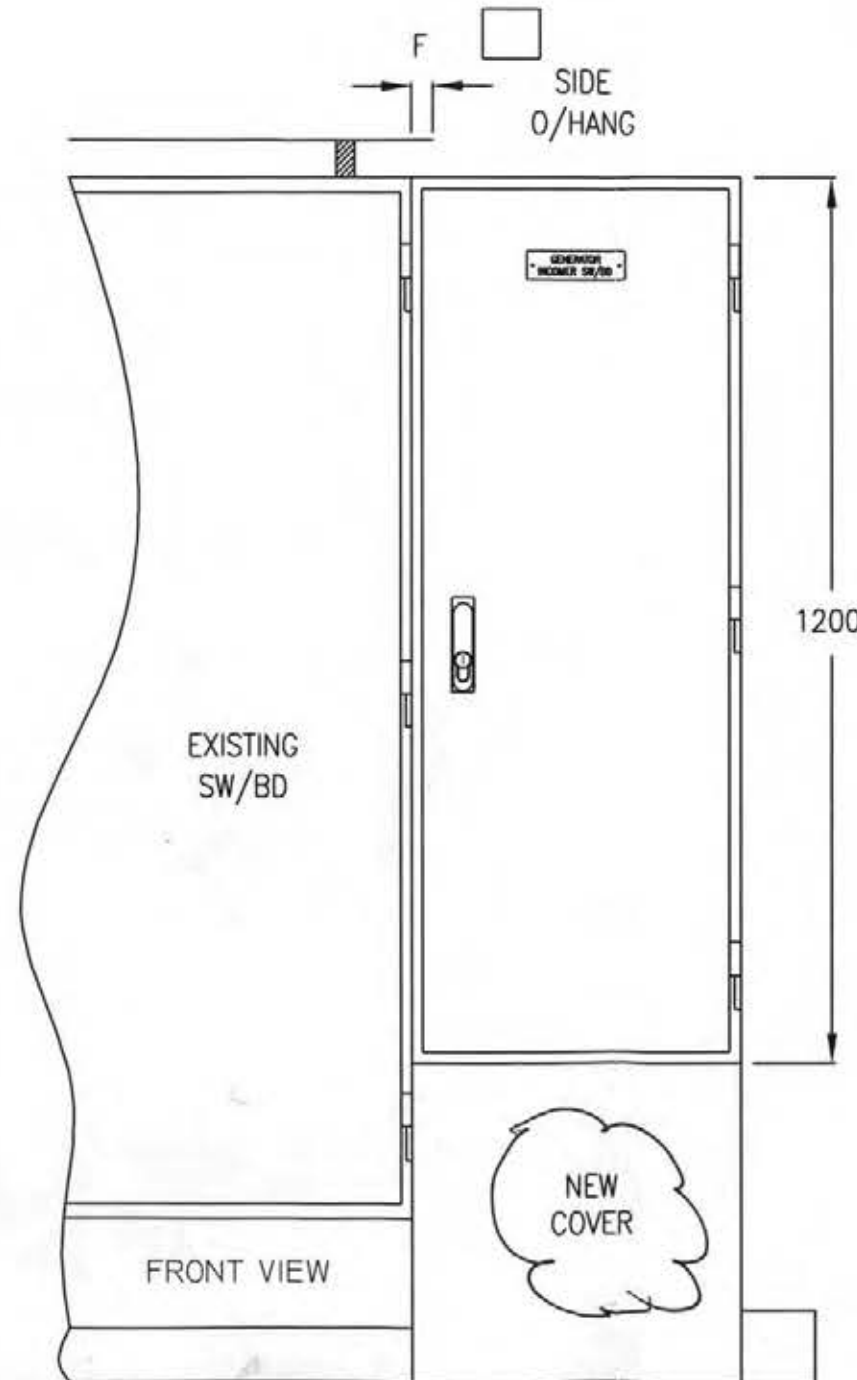TEMPLATE  
SIDE ADJACENT  
TO EXIST. SW/BDPIONEER  
BIRKIN

PAINT COLOUR

MIST GREEN

MATERIAL

ALLUMINIUM

1/9/06	B	AS MODIFIED	FWN	
2/10/03	A	ISSUED FOR APPROVAL	LWN	
			SWN	
			FTN	
			LTN	
			STN	

**COMMON LOGIC** PTY. LTD.  
P.O. BOX 2008  
Mansfield QLD. 4122  
Tele: 07 3849 7449

DATE 25/08/03  
DRAWN GCK  
SCALE NTS  
APPROVED


**BRISBANE WATER**  
RHS Mounting No Base

JH05DR01 A3 sheet 1/1 ISSUE B


AS BUILT  
JH




IF IN DOUBT, ASK.

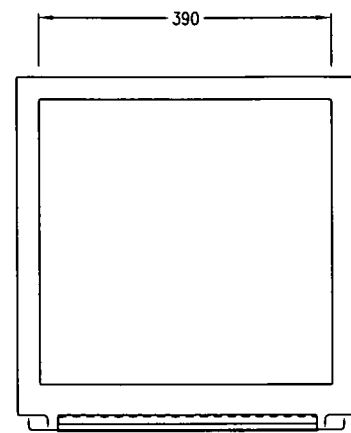


BOTTOM VIEW

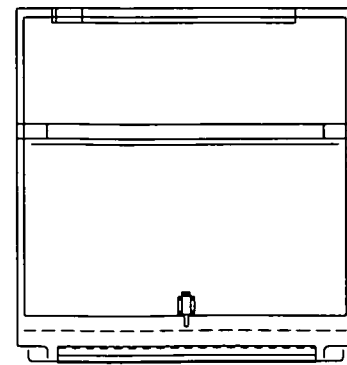


SECTION D-D

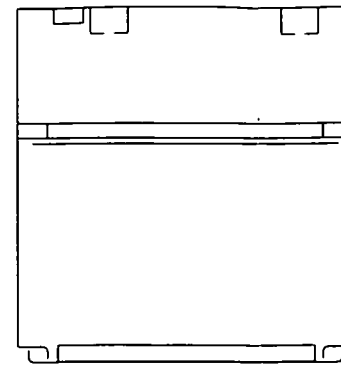

SECTION C-C

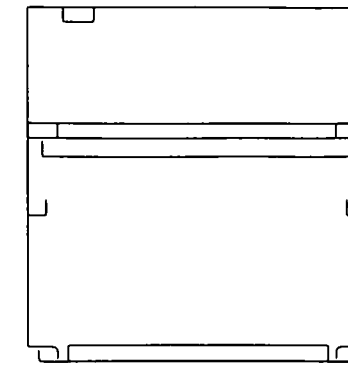


SECTION B-B

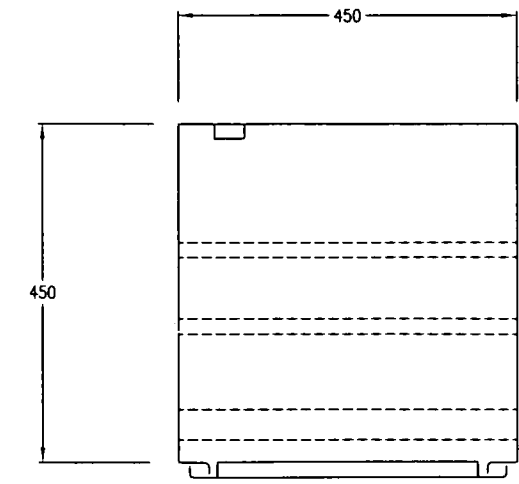

TOP VIEW

Door  
Switch  
Bracket


Light Bracket

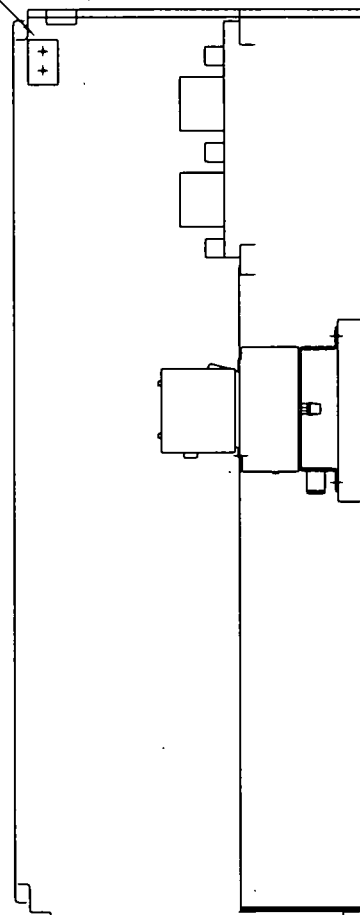




SECTION A-A

DOOR HEAT  
INSULATION

Note: Required  
only on external  
sites. Fix to door  
with studs.

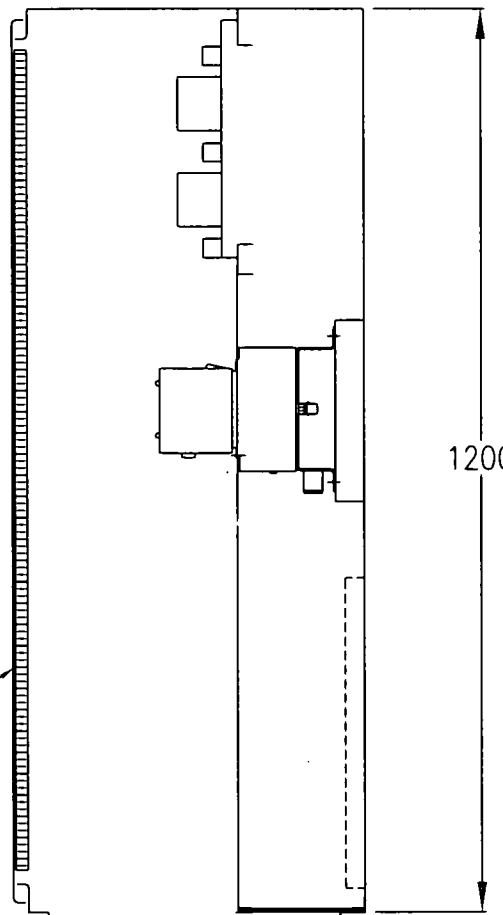

1200

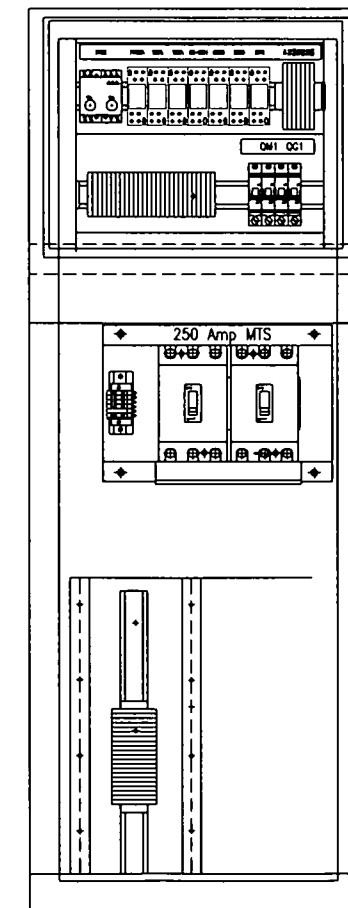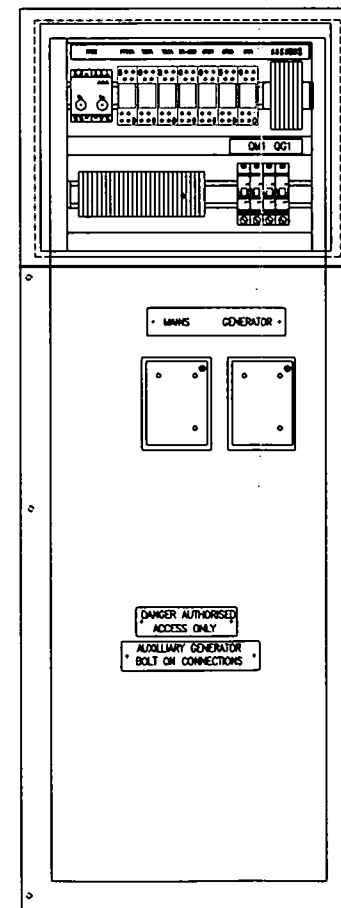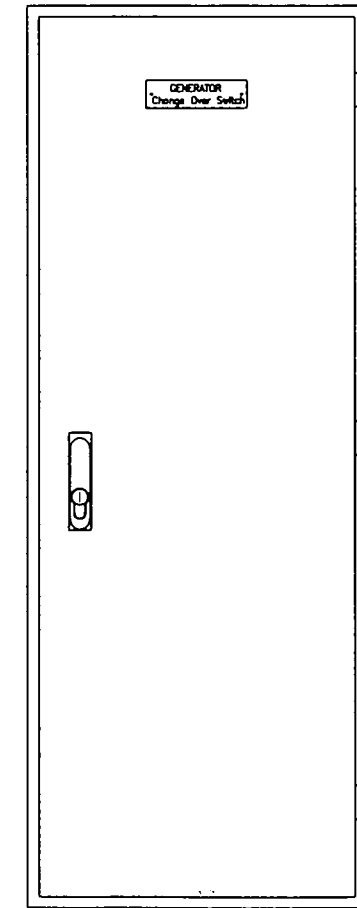FRONT VIEW  
(DOOR REMOVED)

FRONT VIEW

Door to hinge left or right  
depending on order.

			FWN	
			LWN	
			STN	
1/9/06	C	MODIFIED TO INCLUDE AUTO TRANSFER	FTN	
1/2/04	B	AS BUILT	LTN	
2/10/03	A	ISSUED FOR APPROVAL	STN	

**COMMON  
LOGIC** PTY. LTD.  
P.O. BOX 2008  
Mansfield QLD. 4122  
Tele: 07 3849 7449

DATE	25/08/03
DRAWN	GCK
SCALE	NTS
APPROVED	

BRISBANE WATER		
125 Amp Semi Permanent sites		
JH86DD01	A3 sheet 1/1	ISSUE C

AS BUILT  
AM



# SEWAGE SYSTEM IMPROVEMENT 2005

## MOTORISED TRANSFER SWITCH INSTALLATION

### SP235 - PIONEER CRESCENT, BELLBOWRIE

#### ELECTRICAL DRAWING INDEX

ELECTRICAL DRAWINGS INDEX							
DWG N°.	TITLE	ISSUE	REVISIONS				
	MOTOR OPERATED - AUTOMATIC TRANSFER SWITCH - SITE SPECIFIC INSTALLATION						
486/5/7-FD135	PIONEER CRESCENT, BELLBOWRIE - GENSET A.T.S. INSTALLATION - ELECTRICAL DRAWING INDEX	06.2006	A	B	C	D	
486/5/7-FD136	EQUIPMENT LEGEND	03.2006	A	B	C	D	
486/5/7-FD137	PUMP No.1, PUMP No.2 & INCOMER POWER SCHEMATIC WIRING DIAGRAM	03.2006	A	B	C		
486/5/7-FD138	MISCELLANEOUS LIGHT & POWER SCHEMATIC WIRING DIAGRAM	03.2006	A	B	C		
486/5/7-FD139	PUMP No.1 & PUMP No.2 CONTROL SCHEMATIC WIRING DIAGRAM	05.1998	A	B	C		
486/5/7-FD140	COMMON CONTROL, WELL LEVEL, DELIVERY.PRESSURE & SURCHARGE IMMINENT ALARM SCHEMATIC	06.2006	A	B	C	D	
486/5/7-FD141	PLC/RTU SCHEMATIC WIRING DIAGRAM	06.2006	A	B	C	D	
486/5/7-FD142	RTU TERMINATION DIAGRAM	06.2006	A	B	C	D	
486/5/7-FD143	CABLE SCHEDULE	03.2006	A	B	C		
486/5/7-FD144	SWITCHBOARD GENERAL ARRANGEMENT	03.2006	A	B	C		
486/5/7-FD145	SWITCHBOARD CONSTRUCTION NOTES	03.2006	A	B	C		
486/5/7-FD146	SWITCHBOARD SECTIONAL DETAILS	05.1998	A				
486/5/7-FD147	SWITCHBOARD SPECIFIC DETAILS	05.1998	A				
486/5/7-FD148	SWITCHBOARD LABEL LIST	05.1998	A				
486/5/7-FD149	SITE LAYOUT	03.2006	A	B	C		
486/5/7-PS000	DRAWING INDEX - ELECTRICAL INSTALLATION	05.2006	B	1	2		
486/5/7-PS003	TYPICAL MOTOR OPERATED - AUTOMATIC TRANSFER SWITCH - WIRING SCHEMATIC DIAGRAM	05.2006	B	1	2		
486/5/7-PS004	TYPICAL MOTOR OPERATED - AUTOMATIC TRANSFER SWITCH - CUBICLE ARRANGEMENT	05.2006	B	1	2		
486/5/7-PS006	TYPICAL MOTOR OPERATED - AUTOMATIC TRANSFER SWITCH - INTERCONNECTION DIAGRAM	05.2006	B	1			
486/5/7-PS007	AUTOMATIC TRANSFER SWITCH - ATS EXTENSION CUBICLE - TYPICAL CONCRETE BASE ARRANGEMENT	05.2006	B	1			

# = ISSUED FOR:- EMERGENCY GENERATOR  
TRANSFER SWITCH INSTALLATION

E	06.06	NEW BORDER, RE-DRAWN & RE-ISSUED FOR CONSTR
D	03.06	APPROVED FOR CONSTRUCTION
C	11.05	SWBD GENSET UPGRADE 2005
No	DATE	AMENDMENT

DRN.	APD.
Reference Drawings	

DRAFTED	K.M.	20/9/97
DRAFTING CHECK	A.H.	30/9/97
CAD FILE	57FD135_E	
B.C.C. FILE No.		

A.H.	20/9/97	
DESIGN	R.P.E.O. No.	DATE
DESIGN CHECK	R.P.E.O. No.	DATE

PRINCIPAL DESIGN MANAGER	DATE
CLIENT DELEGATE	DATE

PROJECT  
SUBMERSIBLE SEWAGE PUMP STATION  
SP235 - PIONEER CRES., BELLBOWRIE  
SEWAGE SYSTEM IMPROVEMENT 2005TITLE  
MOTORISED TRANSFER SWITCH  
ELECTRICAL INSTALLATION  
ELECTRICAL DRAWING INDEX

SHEET No. 18	AMEND.
BRISBANE WATER DRAWING No.	
486/5/7-FD135	E





## NOTES

ITEM No	QTY	DESCRIPTION	SUPPLIER	MANUFACTURER	CATALOGUE No	SENT TO KILPATRICK GREEN DATE	SENT TO POWER ELECTRIC DATE	CORRECTLY INSTALLED INT DATE	ITEM No	QTY	DESCRIPTION	SUPPLIER	MANUFACTURER	CATALOGUE No	SENT TO KILPATRICK GREEN DATE	SENT TO POWER ELECTRIC DATE	CORRECTLY INSTALLED INT DATE
00	3	SURGE DIVERTER	POWER ELECTRIC	CRITEC	SATKA				52	1	SURCHARGE ALARM RELAY	HUNTER WATERTECH	MULTIRODE	MTR-2			
01	1	MAIN CIRCUIT BREAKER - SHROUD	POWER ELECTRIC	TERASAKI	X512SCA/63-UXPD				53								
02	2	PUMP CIRCUIT BREAKER - SHROUD	POWER ELECTRIC	TERASAKI	XH125H/32-UXPD				54								
03	1	AUTO. MOTORISED TRANSFER SW	NHP	TERASAKI	BH1233_1 79A - 125A 1				55	1	STATION CONTROL SELECTOR SW.	POWER ELECTRIC	KRAUS & NAIMER	CAD11-A200-M0156/001			
04	1	SUB-DISTRIBUTION BOARD CFS	POWER ELECTRIC	STROMBERG	0ESA63G1				56	1	SITE ATTENTION RESET	POWER ELECTRIC	SPRECHER & SCHUH	DSP-F43LX10			
04.1	1	CFS FUSE COVER	POWER ELECTRIC	STROMBERG	0ESA2X172				57								
04.2	3	FUSE CARTRIDGE	POWER ELECTRIC	GEC	T1A 32				58								
05	1	SUB-DISTRIBUTION BOARD CHASSIS	POWER ELECTRIC	TERASAKI	ND25A18U				59	1	SITE ATTENTION ALARM	POWER ELECTRIC	SPRECHER & SCHUH	DSP-PS30L0			
06	2	AUTO-TRANSFORMER	POWER ELECTRIC	GEC GAYRAD	3AT11				60								
06.1	6	MICROTHERMS	POWER ELECTRIC	GEC GAYRAD	(INCLUDED IN TRANSFORMER)				61	1	3 PHASE OUTLET	POWER ELECTRIC	CLIPSAL	S450420LE			
07		AUTO-TRANSFORMER CONTACTORS							62	1	1 PHASE OUTLET	POWER ELECTRIC	CLIPSAL	ISV908			
07.1	2	LINE CONTACTOR - AUX.	POWER ELECTRIC	SPRECHER & SCHUH	CA3-37N-11 - CA3-P-510				63	1	NEUTRAL LINK	POWER ELECTRIC	CLIPSAL	BPW5018			
07.2	2	TRANSFORMER CONTACTOR	POWER ELECTRIC	SPRECHER & SCHUH	CA3-37N-11				64	1	EARTH LINK	POWER ELECTRIC	CLIPSAL	BPW5018			
07.3	2	STAR CONTACTOR - AUX.	POWER ELECTRIC	SPRECHER & SCHUH	CA3-12-18 - CA3-P-01				65		SWITCHBOARD TERMINALS	POWER ELECTRIC	KLIPPON				
08	2	THERMAL OVERLOADS	POWER ELECTRIC	SPRECHER & SCHUH	CTA3-17				65.1	69	FUSE/LINK TERMINALS	POWER ELECTRIC	KLIPPON	NDKS V35 (150331)			
09									65.2	22	END PLATE	POWER ELECTRIC	KLIPPON	AP (150331)			
10									65.3	16	FEED THROUGH TERMINALS	POWER ELECTRIC	KLIPPON	SAK4/35 (1044360)			
11									65.4	2	END PLATE	POWER ELECTRIC	KLIPPON	AP (111794)			
12									65.5	74	FUSE CARTRIDGE	POWER ELECTRIC	KLIPPON	FUSE 20x95mm			
13	2	PUMP INSTRUMENT CT	POWER ELECTRIC	CROMPTON INSTRUMENTS	701-9431 50/5 2 PRIMARY TURNS				65.6	9	END STOP	POWER ELECTRIC	KLIPPON	EW35 (103054)			
14	6	INSTRUMENT FUSES	POWER ELECTRIC	GEC	R520H				65.7	5	FUSE TERMINAL	POWER ELECTRIC	KLIPPON	ASKV/35 (1047454)			
14.1	6	FUSE CARTRIDGES	POWER ELECTRIC	GEC	NT2				65.8	2	DISCONNECT TERMINAL	POWER ELECTRIC	KLIPPON	SAKR/35 (117214)			
15	4	CT TEST LINKS	POWER ELECTRIC	KLIPPON	SAKT2/35 (1010592)				66	1	MAIN NEUTRAL LINK	POWER ELECTRIC	CLIPSAL	20LA6			
15.1	1	END PLATE	POWER ELECTRIC	KLIPPON	AP (1032912)				67	1	MAIN EARTH LINK	POWER ELECTRIC	CLIPSAL	20LA6			
15.2	2	SLIDE LINK 2 WAY	POWER ELECTRIC	KLIPPON	QV52 (1030730)				68	1	INSTRUMENTATION EARTH LINK	POWER ELECTRIC	CLIPSAL	BPW5018			
15.3	4	SLEEVE	POWER ELECTRIC	KLIPPON	VH19 (1031000)				69								
15.4	4	SCREW	POWER ELECTRIC	KLIPPON	BS (1033470)				70								
16	2	PUMP AMMETER	POWER ELECTRIC	CROMPTON INSTRUMENTS	243-026G 0-25/150A				71								
17	2	KILOWATT TRANSDUCER	HUNTER WATERTECH	MULTITEK	M100-WA2				72								
18	2	CURRENT TRANSDUCER	HUNTER WATERTECH	MULTITEK	M100-AL1				73	1	24VDC 3A LINEAR POWER SUPPLY	POWER ELECTRIC	POWER BOX	E 24/03 GP			
19	1	PHASE FAILURE RELAY	POWER ELECTRIC	CROMPTON INSTRUMENTS	252-PSGM				74	1	24VDC CIRCUIT BREAKER	POWER ELECTRIC	TERASAKI	DNT6-106			
20	1	PHASE FAILURE CIRCUIT BREAKER	POWER ELECTRIC	TERASAKI	DNT6-306				75	1	RTU SURGE REDUCTION FILTER	HUNTER WATERTECH	CRITEC	SFR100C-SF			
21	1	3 PHASE OUTLET CIRCUIT BREAKER	POWER ELECTRIC	TERASAKI	DNT6-320				76	1	CATHODIC PROTECTION UNIT	FREE ISSUE		FUTURE			
22	1	1 PHASE OUTLET CIRCUIT BREAKER	POWER ELECTRIC	TERASAKI	DNT6-110				77	1	BATTERY ENCLOSURE	POWER ELECTRIC	NETWORK	DWG 1101-23 DETAIL J			
23	1	1 PHASE OUTLET RCD C/B	POWER ELECTRIC	TERASAKI	DSRCH1030A				78	1	BATTERY VENT	POWER ELECTRIC	FIBOX	MB0544			
24	1	RTU LAP-TOP GPO CIRCUIT BREAKER	POWER ELECTRIC	TERASAKI	DNT6-102				79	1	RTU LAPTOP G.P.O.	POWER ELECTRIC	CLIPSAL	IS / 449 / 449A			
25	1	SW/BD FLUID CIRCUIT BREAKER	POWER ELECTRIC	TERASAKI	DNT6-106				80	2	DECONTACTOR	POWER ELECTRIC	MARECHAL	31-34013-172			
26	1	CATHODIC PROTECTION CIRCUIT BKR	POWER ELECTRIC	TERASAKI	DNT6-106				81	2	ANGLE ADAPTOR	POWER ELECTRIC	MARECHAL	31-30000-427			
27	1	24VDC POWER SUPPLY CIRCUIT BKR	POWER ELECTRIC	TERASAKI	DNT6-106				82	2	PLUG TOP	POWER ELECTRIC	MARECHAL	31-31013-172			
28	1	TRANSFORMERS CIRCUIT BREAKER	POWER ELECTRIC	TERASAKI	DNT6-106				83	1	RTU POWER FAIL RELAY	POWER ELECTRIC	IZUMI	RH2B-U-240VAC			
29	1	RTU CIRCUIT BREAKER	POWER ELECTRIC	TERASAKI	DNT6-110				84	1	RTU BATTERY DISCHARGE RELAY	POWER ELECTRIC	IZUMI	RH2B-U-12VDC			
30									85	1	RTU POWER SUPPLY 13.8VDC	HUNTER WATERTECH	POWERBOX	PSR-15			
31	4	SPARE CIRCUIT BREAKERS	POWER ELECTRIC	TERASAKI	DNT6-106				86	1	RTU 12V/24VDC CONVERTER	HUNTER WATERTECH	POWERBOX	VTA254SC12			
32	2	SW/BD DOOR MICRO SWITCHES	POWER ELECTRIC	CAMCO	SH202				87	2	BATTERY	HUNTER WATERTECH	APOLLO	H002			
33	2	SW/BD RW INTERNAL FLUID LIGHTS	POWER ELECTRIC	THORN	08000				88	1	GSM	HUNTER WATERTECH	FALCON	A20-1			
34	1	WELL LEVEL INDICATOR	POWER ELECTRIC	CROMPTON INSTRUMENTS	244-401G 4-20mA 0-100% - RED POINTER				89	4	EXPANSION BASE	HUNTER WATERTECH	SYNAX	8050B01			
35	1	PRESSURE TRANSMITTER RELAY	HUNTER WATERTECH	PLATYPUS	AP-W1227				90	1	TELEMETRY UNIT	HUNTER WATERTECH	HUNTER WATERTECH	POS500			
35.1	1	PRESSURE TRANSDUCER	HUNTER WATERTECH	PLATYPUS	PL-25GSM				91	2	DIGITAL INPUT MODULE	HUNTER WATERTECH	SYNAX	8050N116			
36	1	WELL LEVEL TRANSDUCER	HUNTER WATERTECH	VEGA	E25-B				92	1	DUMMY MODULE	HUNTER WATERTECH	SYNAX	8050N011			
36.1	1	WELL LEVEL PRESSURE SENSOR	HUNTER WATERTECH	VEGA	D77				93	2	DIGITAL OUTPUT MODULES	HUNTER WATERTECH	SYNAX	8050R108			
36.2	1	RAG REDUCTION TUBE	KILPATRICK GREEN	KILPATRICK GREEN					94	2	ANALOGUE INPUT MODULE	HUNTER WATERTECH	HUNTER WATERTECH	POS801			
37	2	PUMP CONTROL CIRCUIT BREAKER	POWER ELECTRIC	TERASAKI	DNT6-106				95								
38	2	PUMP HOURS RUN METER	POWER ELECTRIC	NATIONAL	TH639				96								
39	2	THERMISTOR RELAYS	POWER ELECTRIC	SPRECHER & SCHUH	RT3-A-240VAC				97	1	ANTENNA	HUNTER WATERTECH	R.F. INDUSTRIES	CD1625 (WH01)			
40									97.1	1	ANTENNA MAST	POWER ELECTRIC	POWER ELECTRIC				
41	2	CONTROL CIRCUIT ON RELAY	POWER ELECTRIC	IZUMI	RH2B-U-240VAC												
42	2	Tx CONTACTOR CONTROL RELAY	POWER ELECTRIC	KLIPPON	RS30 (11016.2)												
43	2	STAR CONTACTOR CONTROL RELAY	POWER ELECTRIC	KLIPPON	RS30 (11016.2)												
44	2	LINE CONTACTOR CONTROL RELAY	POWER ELECTRIC	KLIPPON	RS30 (11016.2)												
45	1	RADIO COAX. SURGE PROTECTION	HUNTER WATERTECH	POLYPHASE CORPORATION	IS-S00X-C2				98	1	MAINS AVAILABLE INDYR. (YELLOW)	NHP	SPRECHER & SCHUH	DSP-PS30L0			
46	2	PUMP STATUS INDICATOR	POWER ELECTRIC	SPRECHER & SCHUH	DSP-P430L0				99	1	GENERATOR RUNNING INDYR. (RED)	NHP	SPRECHER & SCHUH	DSP-P430L0			
47	2	PUMP START PUSH BUTTON	POWER ELECTRIC	SPRECHER & SCHUH	DSP-F33LX10												
48	2	PUMP STOP PUSH BUTTON	POWER ELECTRIC	SPRECHER & SCHUH	DSP-MTS343LX01/01												
49	2	PUMP RESET PUSH BUTTON	POWER ELECTRIC	SPRECHER & SCHUH	DSP-F43LX10												
50																	
51																	

As Billed

APPROVED FOR CONSTRUCTION

E	03.2006	APPROVED FOR CONSTRUCTION	
D	11.2005	SWBD GenSet Upgrade 2005	
C	26/10/00	CHANGED ITEMS 88 & 97	
B	8/10/98	AS BUILT	R.L.
A	13/5/98	REVISED DRAWING	A.H.
No	DATE	AMENDMENT	INITIALS

## AMENDMENT &amp; ISSUE REGISTER

MANAGER		DIRECTOR OF TECHNOLOGY SERVICES	
DATE:		DATE:	
DIRECTOR OF PLANNING & DESIGN		DIRECTOR OF WATER SUPPLY	
DATE:		DATE:	
DIRECTOR OF CONSTRUCTION		DATE:	
DESIGN	A.H.	9/9/97	ENGINEER IN CHARGE
DRAWN	K.M.	20/9/97	SUPERVISING ENGINEER
TRACED			
CHECKED	A.H.	8/10/97	A2 REDUCED
REFERENCES		COPYRIGHT©1996	
CADD FILE No.		No reproduction is permitted in whole or in part without the express consent of	
THIS DRAWING WAS PRODUCED USING AUTOCAD		BRISBANE CITY COUNCIL BRISBANE WATER	



Brisbane Water

Brisbane City ASSET MANAGEMENT PROFESSIONAL SERVICES

PROJECT  
IDTS  
PIONEER CRESCENT (SP235)  
SUBMERSIBLE SEWAGE PUMP STATION

TITLE

EQUIPMENT LEGEND

SCALE:	No. OF SHEETS
DRAWING No.	AMEND.
486/5/7-FD136	E





## NOTES

1. INCOMING & PUMP CIRCUIT BREAKERS ARE LINE SIDE SHROUDED.
2. CIRCUIT BREAKERS RATINGS TO SUIT LOAD & ENSURE TYPE 2 COORDINATION WITH CONTACTORS & OVERLOADS TO IEC 947-4-1.
3. TERMINAL NUMBER SHOWN EITHER IMMEDIATELY BELOW, RIGHT OR LEFT OF TERMINAL.
4. FUSE TERMINALS ARE TO BE FITTED WITH 100mA FUSE-LINKS UNLESS OTHERWISE SHOWN.
5. FAULT LEVEL 15.7kA.
6. CIRCUIT BREAKER SETTINGS 100%.
7. THERMAL OVERLOAD SETTINGS 15A.

APPROVED FOR CONSTRUCTION

C	03.2006	Approved for Construction	
B	11.2005	SWBD GenSet Upgrade 2005	
A	8/10/98	AS BUILT	
No	DATE	AMENDMENT	INITIALS

## AMENDMENT &amp; ISSUE REGISTER

MANAGER		DIRECTOR OF TECHNOLOGY SERVICES	
DATE:		DATE:	
DIRECTOR OF PLANNING & DESIGN	DIRECTOR OF WATER SUPPLY	DIRECTOR OF CONSTRUCTION	
DATE:	DATE:	DATE:	

DESIGN	A.H.	9/9/97	ENGINEER IN CHARGE
DRAWN	K.M.	20/9/97	SUPERVISING ENGINEER
TRACED			
CHECKED	A.H.	25/9/97	A2 REDUCED

REFERENCES	COPYRIGHT©1996
CADD FILE No.	No reproduction is permitted in whole or in part without the express consent of BRISBANE CITY COUNCIL BRISBANE WATER
THIS DRAWING WAS PRODUCED USING AUTOCAD	



PROJECT	IDTS
PIONEER CRESCENT (SP235)	
SUBMERSIBLE SEWAGE PUMP STATION	
TITLE	PUMP No. 1, PUMP No. 2 & INCOMER POWER SCHEMATIC WIRING DIAGRAM

SCALE	No. OF SHEETS
DRAWING No	WAS 1321-03
486/5/7-FD137	AMEND C

## NOTES

1. INCOMING & PUMP CIRCUIT BREAKERS ARE LINE SIDE SHROUDED.
2. CIRCUIT BREAKERS RATINGS TO SUIT LOAD & ENSURE TYPE 2 COORDINATION WITH CONTACTORS & OVERLOADS TO IEC 947-4-1.
3. TERMINAL NUMBER SHOWN EITHER IMMEDIATELY BELOW, RIGHT OR LEFT OF TERMINAL.
4. FUSE TERMINALS ARE TO BE FITTED WITH 100mA FUSE-LINKS UNLESS OTHERWISE SHOWN.

## AUTOTRANSFORMER NOTES

1. WITH PUMP OFF ALL CONTACTORS ARE OPEN.
2. UPON RECEIVING START SIGNAL, STAR & TRANSFORMER CONTACTORS CLOSE.
3. AFTER A PRE-DETERMINED DELAY THE STAR CONTACTOR OPENS & THE LINE CONTACTOR CLOSES.
4. THE TRANSFORMER CONTACTOR THEN OPENS IMMEDIATELY.
5. THE PUMP IS NOW ON LINE AT RATED VOLTAGE & SPEED.

## LEGEND:

	RELAY OR CONTACTOR COIL
	FIELD DEVICE
	R.T.U. FUSE TERMINAL
	R.T.U. LINK TERMINAL
	SWITCHBOARD TERMINAL
	CATHODIC PROTECTION TERMINAL
	RTU DIGITAL INPUT
	RTU DIGITAL OUTPUT
	RTU ANALOG INPUT
	EQUIPMENT ITEM No.

## CROSS REFERENCE TABLE

ITEM	SHEET	LINE	ITEM	SHEET	LINE	ITEM	SHEET	LINE	ITEM	SHEET	LINE	ITEM	SHEET	LINE	ITEM	SHEET	LINE
C11	1	7	C23	5	20	RP12	6	21	Thr2	6	15				INSTANT	6	22
	1	11		27			6	8		6	16				ONSTOP	6	23
	1	10		23			6	32		6	18				SPAZED	6	24
	1	18		19			6	9		6	4				SPAZED	6	25
	1	8		7			6	35		6	15				SPAZED	6	26
	1	11		14			6	19		6	16				SPAZED	6	27
	1	8		7			6	37		6	15				SPAZED	6	28
	1	11		14			6	19		6	16				SPAZED	6	29
	1	8		7			6	37		6	15				SPAZED	6	30
	1	11		14			6	19		6	16				SPAZED	6	31
	1	8		7			6	37		6	15				SPAZED	6	32
	1	11		14			6	19		6	16				SPAZED	6	33
	1	8		7			6	37		6	15				SPAZED	6	34
	1	11		14			6	19		6	16				SPAZED	6	35
	1	8		7			6	37		6	15				SPAZED	6	36
	1	11		14			6	19		6	16				SPAZED	6	37
	1	8		7			6	37		6	15				SPAZED	6	38
	1	11		14			6	19		6	16				SPAZED	6	39
	1	8		7			6	37		6	15				SPAZED	6	40
	1	11		14			6	19		6	16				SPAZED	6	41
	1	8		7			6	37		6	15				SPAZED	6	42
	1	11		14			6	19		6	16				SPAZED	6	43
	1	8		7			6	37		6	15				SPAZED	6	44
	1	11		14			6	19		6	16				SPAZED	6	45
	1	8		7			6	37		6	15				SPAZED	6	46
	1	11		14			6	19		6	16				SPAZED	6	47
	1	8		7			6	37		6	15				SPAZED	6	48
	1	11		14			6	19		6	16				SPAZED	6	49
	1	8		7			6	37		6	15				SPAZED	6	50

SUB-DISTRIBUTION BOARD ISOLATOR


32A/63A

64

CONTINUED ON

DRG No. 486/5/7-FD138

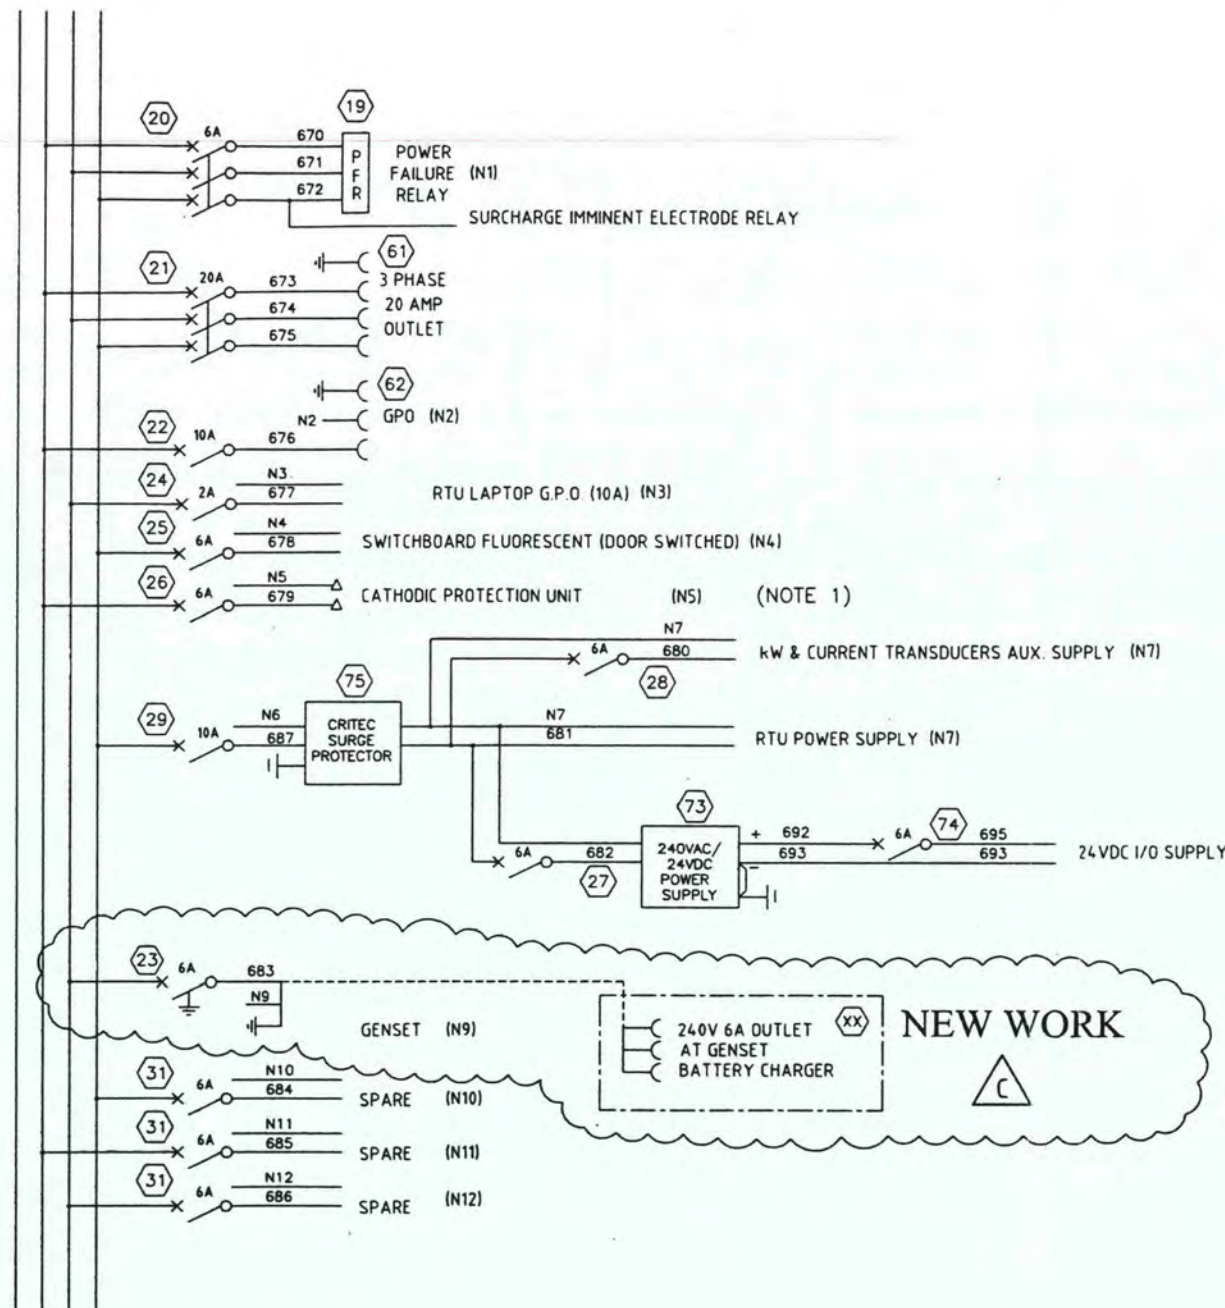

CONTINUED FROM  
SHEET 03

CROSS REFERENCE TABLE

ITEM	SHEET	LINE	ITEM	SHEET	LINE	ITEM	SHEET	LINE	ITEM	SHEET	LINE	ITEM	SHEET	LINE
C11 - COIL	6	7	C23 - 1 N/D	6	22	RP13 - COIL	6	32	TOL1 - COIL	3	13			
- 3 N/D	3	11	ICONT1 - 1 N/C	6	19	- 1 C/D	6	9	- 1 N/D	6	4			
- 1 N/D	6	16	- 1 N/D	6	16	- 1 C/D	6	16	- 1 N/C	6	6			
C12 - COIL	6	8	LCR61 - COIL	8	4	RP21 - COIL	6	35	TOL2 - COIL	3	21			
- 3 N/D	3	9	- 1 C/D	8	4	- 1 C/D	6	18	- 1 N/D	6	15			
- 1 N/D	6	11	- 1 N/D	8	4	- 1 C/D	6	18	- 1 N/C	6	16			
- 1 N/D	6	9	- 1 N/D	8	4	- 1 C/D	6	18	- 1 N/C	6	16			
C13 - COIL	6	9	PPR - COIL	5	5	RP22 - COIL	6	36	PUMP No.1	6	8			
- 3 N/D	3	13	- 1 C/D	5	5	- 1 C/D	6	19	A/TRANSFORMER	6	8			
- 1 N/D	6	12	- 1 C/D	5	5	- 1 C/D	6	19	THERMAL SWITCH	6	8			
- 1 N/C	6	8	PR1 - COIL	6	18	RP23 - COIL	6	37	PUMP No.2	6	9			
- 1 N/D	6	3	- 1 C/D	6	3	- 1 C/D	6	20	A/TRANSFORMER	6	9			
- 1 N/D	6	3	- 1 C/D	6	3	- 1 C/D	6	20	THERMAL SWITCH	6	9			
C21 - COIL	6	18	PR2 - COIL	6	21	SAC - 1 C/D	8	5	BO - COIL	10	1			
- 3 N/D	3	25	- 1 C/D	6	14	- 1 C/D	8	5	- 1 N/D	10	1			
- 1 N/D	6	21	- 1 C/D	6	14	- 1 C/D	8	5	- 1 N/D	10	1			
- 1 N/D	6	3	RP11 - COIL	6	36	THR1 - COIL	6	4	PF - COIL	10	10			
- 3 N/D	3	23	- 1 C/D	6	7	- 1 N/D	6	4	- 1 N/D	10	10			
- 1 N/D	6	22	- 1 C/D	6	7	- 1 N/D	6	4	- 1 N/D	10	10			
- 1 N/C	6	20	- 1 C/D	6	7	- 1 N/C	6	7	- 1 N/D	10	10			
C23 - COIL	6	27	RP12 - COIL	6	31	THR2 - COIL	6	11						
- 3 N/D	3	27	- 1 C/D	6	8	- 1 N/D	6	11						
- 1 N/D	6	27	- 1 C/D	6	8	- 1 N/C	6	11						

## LEGEND:

	RELAY OR CONTACTOR COIL
	FIELD DEVICE
	R.T.U. FUSE TERMINAL
	R.T.U. LINK TERMINAL
	SWITCHBOARD TERMINAL
	CATHODIC PROTECTION TERMINAL
	RTU DIGITAL INPUT
	RTU DIGITAL OUTPUT
	RTU ANALOG INPUT
	EQUIPMENT ITEM NO.

## NOTES

- CATHODIC PROTECTION - FUTURE.  
THIS UNIT TO BE SUPPLIED BY OTHERS.  
A 240VAC CABLE IS INSTALLED TO  
PROPOSED CATHODIC PROTECTION AREA  
TERMINAL STRIP FOR CONNECTION BY OTHERS
- TERMINAL NUMBER SHOWN EITHER IMMEDIATELY  
BELOW, RIGHT OR LEFT OF TERMINAL.

APPROVED FOR CONSTRUCTION

C	03/2006	Approved for Construction	
B	11/2005	SWBD GenSet Upgrade 2005	
A	8/10/98	AS BUILT	
No	DATE	AMENDMENT	INITIALS

## AMENDMENT &amp; ISSUE REGISTER

MANAGER		DIRECTOR OF TECHNOLOGY SERVICES	
DATE:		DATE:	
DIRECTOR OF PLANNING & DESIGN		DIRECTOR OF WATER SUPPLY	DIRECTOR OF CONSTRUCTION
DATE:		DATE:	DATE:
DESIGN	A.H.	9/9/97	ENGINEER IN CHARGE
DRAWN	K.M.	20/9/97	SUPERVISING ENGINEER
TRACED			
CHECKED	A.H.	25/9/97	A2 REDUCED
REFERENCES			COPYRIGHT©1996 No reproduction is permitted in whole or in part without the express consent of BRISBANE CITY COUNCIL BRISBANE WATER
CADD FILE No.			
THIS DRAWING WAS PRODUCED USING AUTOCAD			



Brisbane Water

Brisbane City ASSET MANAGEMENT  
PROFESSIONAL SERVICES


PROJECT  
IDTS  
PIONEER CRESCENT (SP235)  
SUBMERSIBLE SEWAGE PUMP STATION

TITLE  
MISCELLANEOUS LIGHT & POWER  
SCHEMATIC WIRING DIAGRAM


SCALE:	No. OF SHEETS
DRAWING No.	WAS 1321-05
486/5/7-FD138	AMEND
	C




## ELV CONTROL

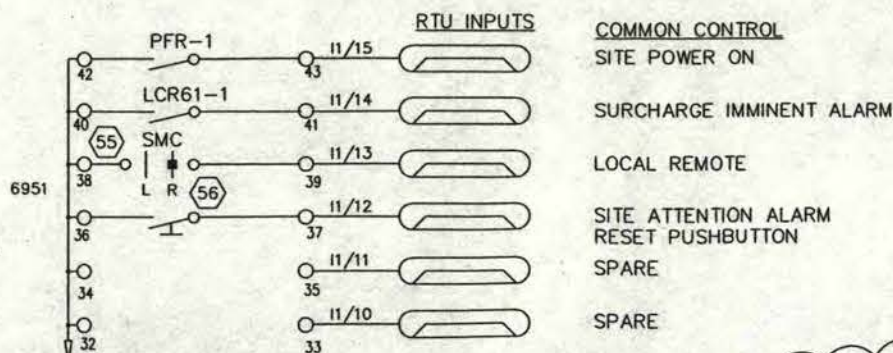


## 240V AC CONTROL

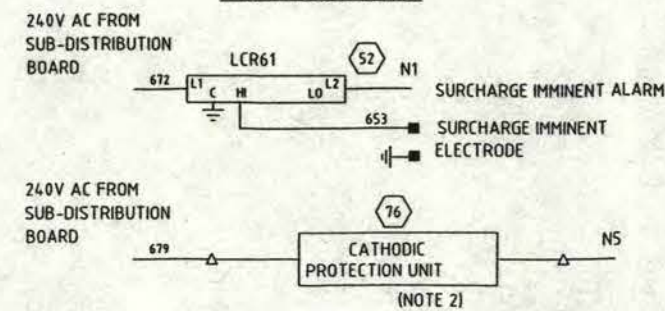



## NEW WORK

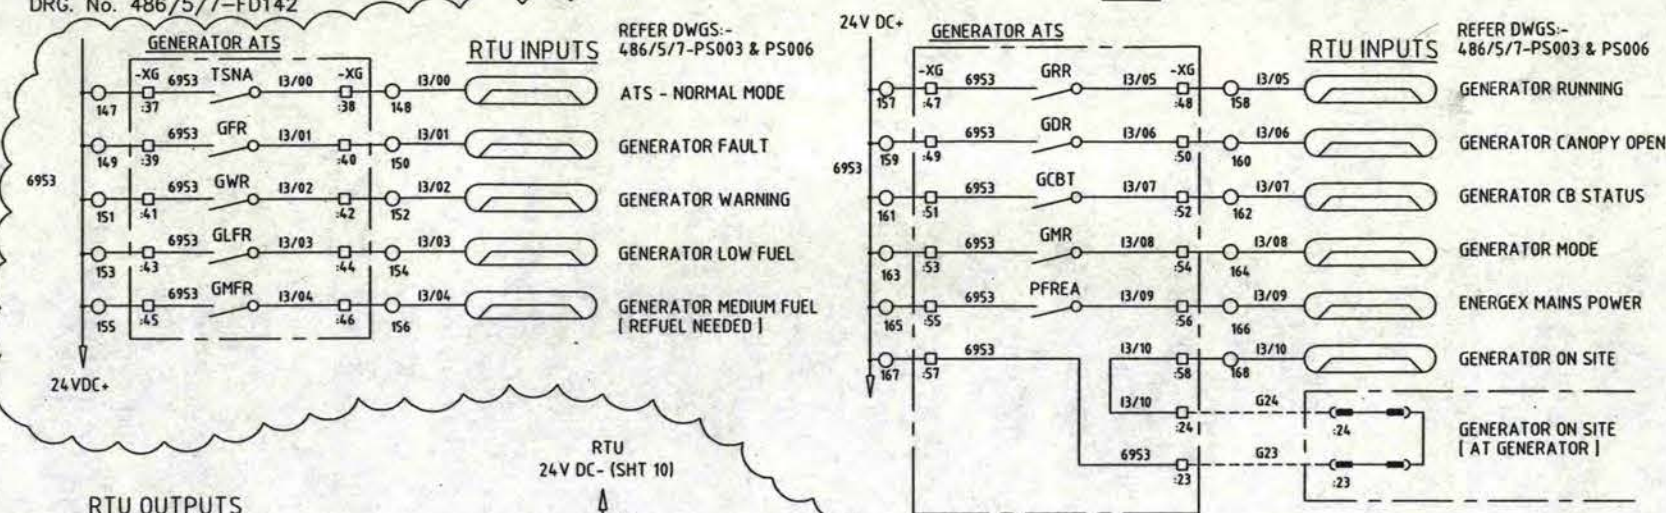

## RTU ANALOG INPUTS FOR INSTRUMENTS

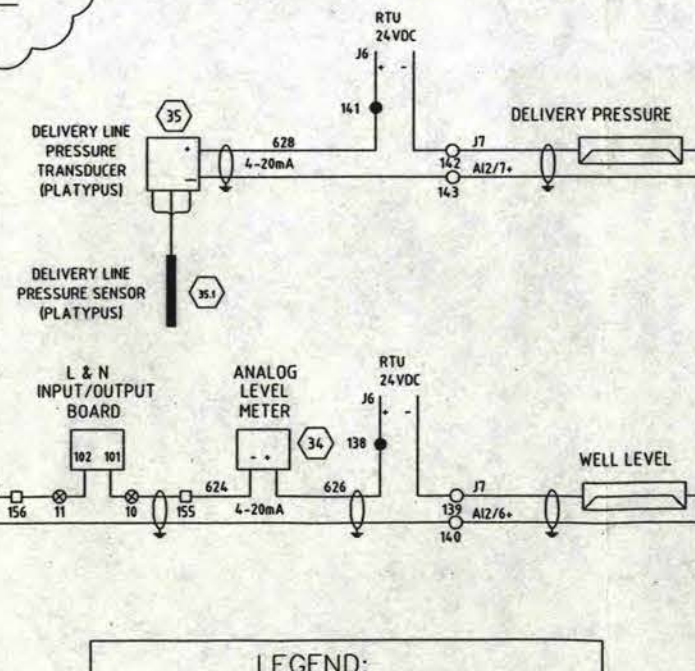


## NEW WORK

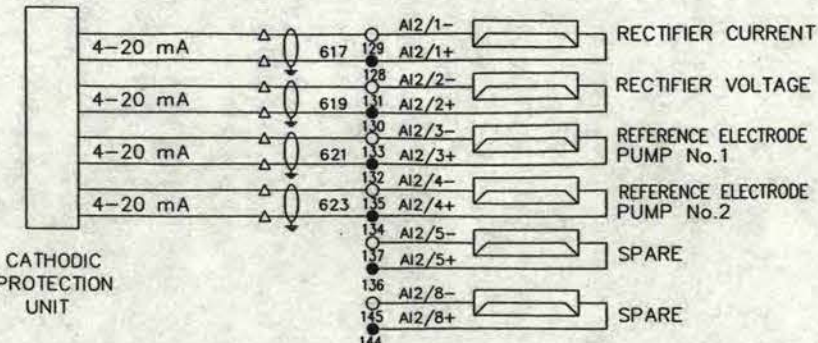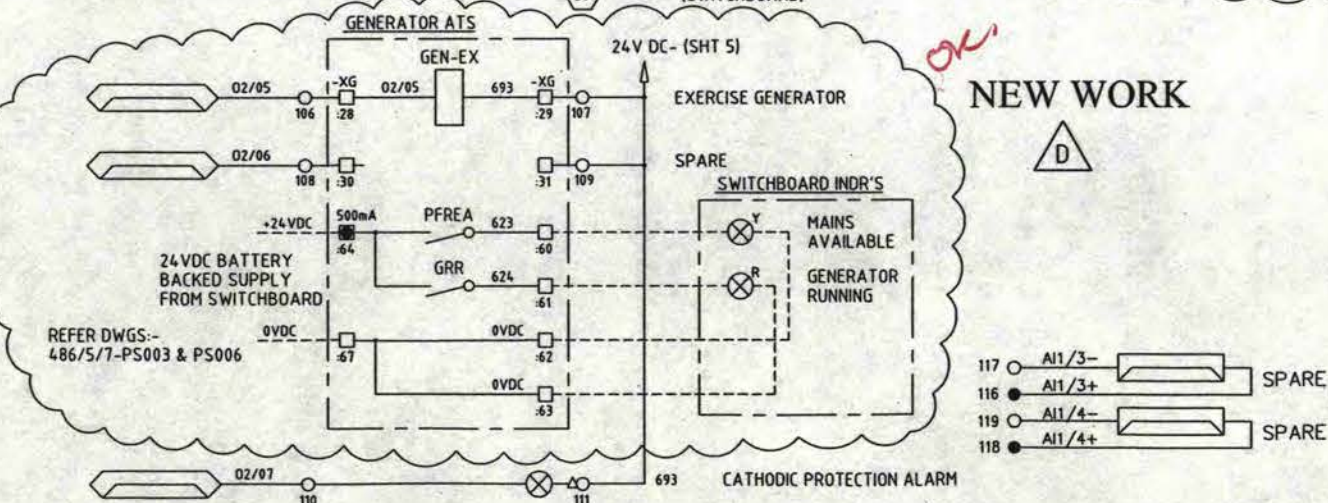

## CROSS REFERENCE TABLE

ITEM	SHEET	LINE	ITEM	SHEET	LINE	ITEM	SHEET	LINE	ITEM	SHEET	LINE
C11 - COIL	6	7	C23 - COIL	6	23	RP13 - COIL	6	32	TOL1 - COIL	3	14
- 3 N/O	3	12	ICONT1 - 1 N/C	6	16	- 1 C/O	6	9	- 1 N/O	6	4
- 1 N/O	6	10	- 1 N/O	6	16	- 1 C/O	6	10	- 1 N/C	6	4
C12 - COIL	6	8	LCR61 - COIL	8	4	RP21 - COIL	6	35	TOL2 - COIL	3	23
- 3 N/O	3	12	- 1 C/O	8	4	- 1 C/O	6	10	- 1 N/O	6	15
- 1 N/O	6	11	- 1 N/O	8	4	- 1 C/O	6	10	- 1 N/C	6	16
- 1 N/C	6	9	- 1 C/O	8	4	- 1 C/O	6	10	- 1 N/O	6	16
C13 - COIL	6	14	PFR - COIL	5	5	RP22 - COIL	6	36	PUMP No.1 A/TRANSFORMER THERMAL SWITCH	6	8
- 3 N/O	3	14	- 1 C/O	5	5	- 1 C/O	6	36	- 1 N/O	6	10
- 1 N/O	6	12	- 1 C/O	5	5	- 1 C/O	6	36	- 1 N/C	6	10
- 1 N/C	6	12	- 1 C/O	5	5	- 1 C/O	6	36	- 1 N/O	6	10
C21 - COIL	6	10	PR1 - COIL	6	10	RP23 - COIL	6	37	PUMP No.2 A/TRANSFORMER THERMAL SWITCH	6	10
- 3 N/O	3	10	- 1 C/O	6	10	- 1 C/O	6	37	- 1 N/O	6	10
- 1 N/O	6	21	- 1 C/O	6	10	- 1 C/O	6	37	- 1 N/C	6	10
- 1 N/C	6	21	- 1 C/O	6	10	- 1 C/O	6	37	- 1 N/O	6	10
C22 - COIL	6	19	PR2 - COIL	6	21	SHC - COIL	8	5	PUMP No.3 A/TRANSFORMER THERMAL SWITCH	7	8
- 3 N/O	3	19	- 1 C/O	6	21	- 1 C/O	8	5	- 1 N/O	7	8
- 1 N/O	6	22	- 1 C/O	6	21	- 1 C/O	8	5	- 1 N/C	7	8
- 1 N/C	6	22	- 1 C/O	6	21	- 1 C/O	8	5	- 1 N/O	7	8
C23 - COIL	6	29	RP11 - COIL	6	30	THR1 - COIL	6	4	BD - COIL	10	9
- 3 N/O	3	29	- 1 C/O	6	30	- 1 N/O	6	4	- 1 N/O	10	9
- 1 N/O	6	29	- 1 C/O	6	30	- 1 N/C	6	4	- 1 N/O	10	9
- 1 N/C	6	29	- 1 C/O	6	30	- 1 N/C	6	4	- 1 N/O	10	9
			RP12 - COIL	6	31	THR2 - COIL	6	15	PF - COIL	10	10
			- 1 C/O	6	31	- 1 N/O	6	15	- 1 N/O	10	10
			- 1 C/O	6	31	- 1 N/C	6	15	- 1 N/O	10	10

## LEGEND:

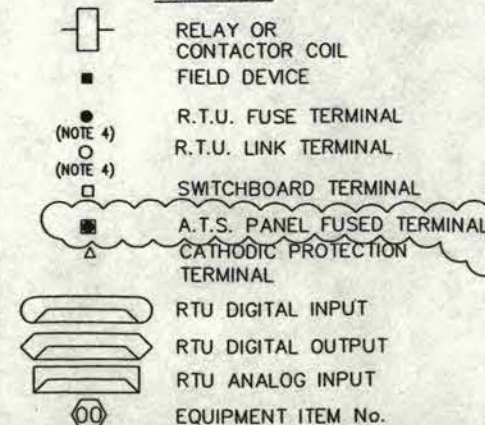

## NOTES

- ALL WIRES & CABLE CORES ARE FERRULED WITH GRAFOPLAST COMPATIBLE LABELLING. THE FOLLOWING PREFIXES ARE USED:  
MAIN PUMP No. 1 = 1  
MAIN PUMP No. 2 = 2  
COMMON WIRING = 6 (i.e. FLOW, LEVEL, PRESSURE)
- CATHODIC PROTECTION - FUTURE. THIS UNIT IS SUPPLIED BY OTHERS. RTU I/O CABLEING IS INSTALLED TO PROPOSED CATHODIC PROTECTION TERMINAL STRIP FOR CONNECTION BY OTHERS.
- ITEMS SHOWN AS DOTTED ARE FOR FUTURE ONLY.
- TERMINAL NUMBER SHOWN EITHER IMMEDIATELY BELOW, RIGHT OR LEFT OF TERMINAL.
- FUSE TERMINALS ARE TO BE FITTED WITH 100mA FUSE TERMINALS UNLESS OTHERWISE SHOWN

## APPROVED FOR CONSTRUCTION

D	06.2006	Re-Issued for Construction	<i>mf</i>
C	03.2006	Approved for Construction	M.J.L.
B	11.2005	SWBD GenSet Upgrade 2005	
A	27/5/98	AS BUILT	
No	DATE	AMENDMENT	INITIALS

## AMENDMENT &amp; ISSUE REGISTER

MANAGER		DIRECTOR OF TECHNOLOGY SERVICES	
DATE:		DATE:	
DIRECTOR OF PLANNING & DESIGN		DIRECTOR OF WATER SUPPLY	DIRECTOR OF CONSTRUCTION
DATE:		DATE:	DATE:
DESIGN	A.H.	9/9/97	ENGINEER IN CHARGE
DRAWN	K.M.	20/9/97	SUPERVISING ENGINEER
TRACED			
CHECKED	A.H.	8/10/97	A2 REDUCED
REFERENCES		COPYRIGHT©1996 No reproduction is permitted in whole or in part without the express consent of BRISBANE CITY COUNCIL BRISBANE WATER	
CADD FILE No.			
THIS DRAWING WAS PRODUCED USING AUTOCAD			



ASSET MANAGEMENT PROFESSIONAL SERVICES

PROJECT  
IDTS  
**PIONEER CRESCENT (SP235)**  
**SUBMERSIBLE SEWAGE PUMP STATION**

TITLE  
**COMMON CONTROL, WELL LEVEL, DELIVERY PRESSURE & SURCHARGE IMMINENT ALARM SCHEMATIC WIRING DIAGRAM**

SCALE:	No. OF SHEETS
DRAWING No.	WAS 1321-08
<b>486/5/7-FD140</b>	AMEND. <b>D</b>





## NOTES

1. TERMINAL NUMBER SHOWN EITHER IMMEDIATELY BELOW, RIGHT OR LEFT OF TERMINAL.

APPROVED FOR CONSTRUCTION

D	03.2006	APPROVED FOR CONSTRUCTION	<i>ref</i>
C	05.05	SWBD GenSet Upgrade 2005	
B	26/10/00	CHANGED RADIO TO GSM	
A	8/10/98	AS BUILT	R.L.
No	DATE	AMENDMENT	INITIALS

## AMENDMENT &amp; ISSUE REGISTER

MANAGER		DIRECTOR OF TECHNOLOGY SERVICES	
DATE:		DATE:	
DIRECTOR OF PLANNING & DESIGN		DIRECTOR OF WATER SUPPLY	
DATE:		DATE:	
DESIGN		ENGINEER IN CHARGE	
DRAWN		SUPERVISING ENGINEER	
TRACED			
CHECKED		A2	
REFERENCES		COPYRIGHT©1996	
CADD FILE No.		No reproduction is permitted in whole or in part without the express consent of	
THIS DRAWING WAS PRODUCED USING AUTOCAD		BRISBANE CITY COUNCIL	



Brisbane Water


Brisbane City ASSET MANAGEMENT PROFESSIONAL SERVICES

PROJECT  
IDTS  
PIONEER CRESCENT (SP235)  
SUBMERSIBLE SEWAGE PUMP STATION

TITLE  
PLC/RTU SCHEMATIC WIRING DIAGRAM

SCALE: No. OF SHEETS

DRAWING No. WAS 1321-10 AMEND  
486/5/7-FD141 D

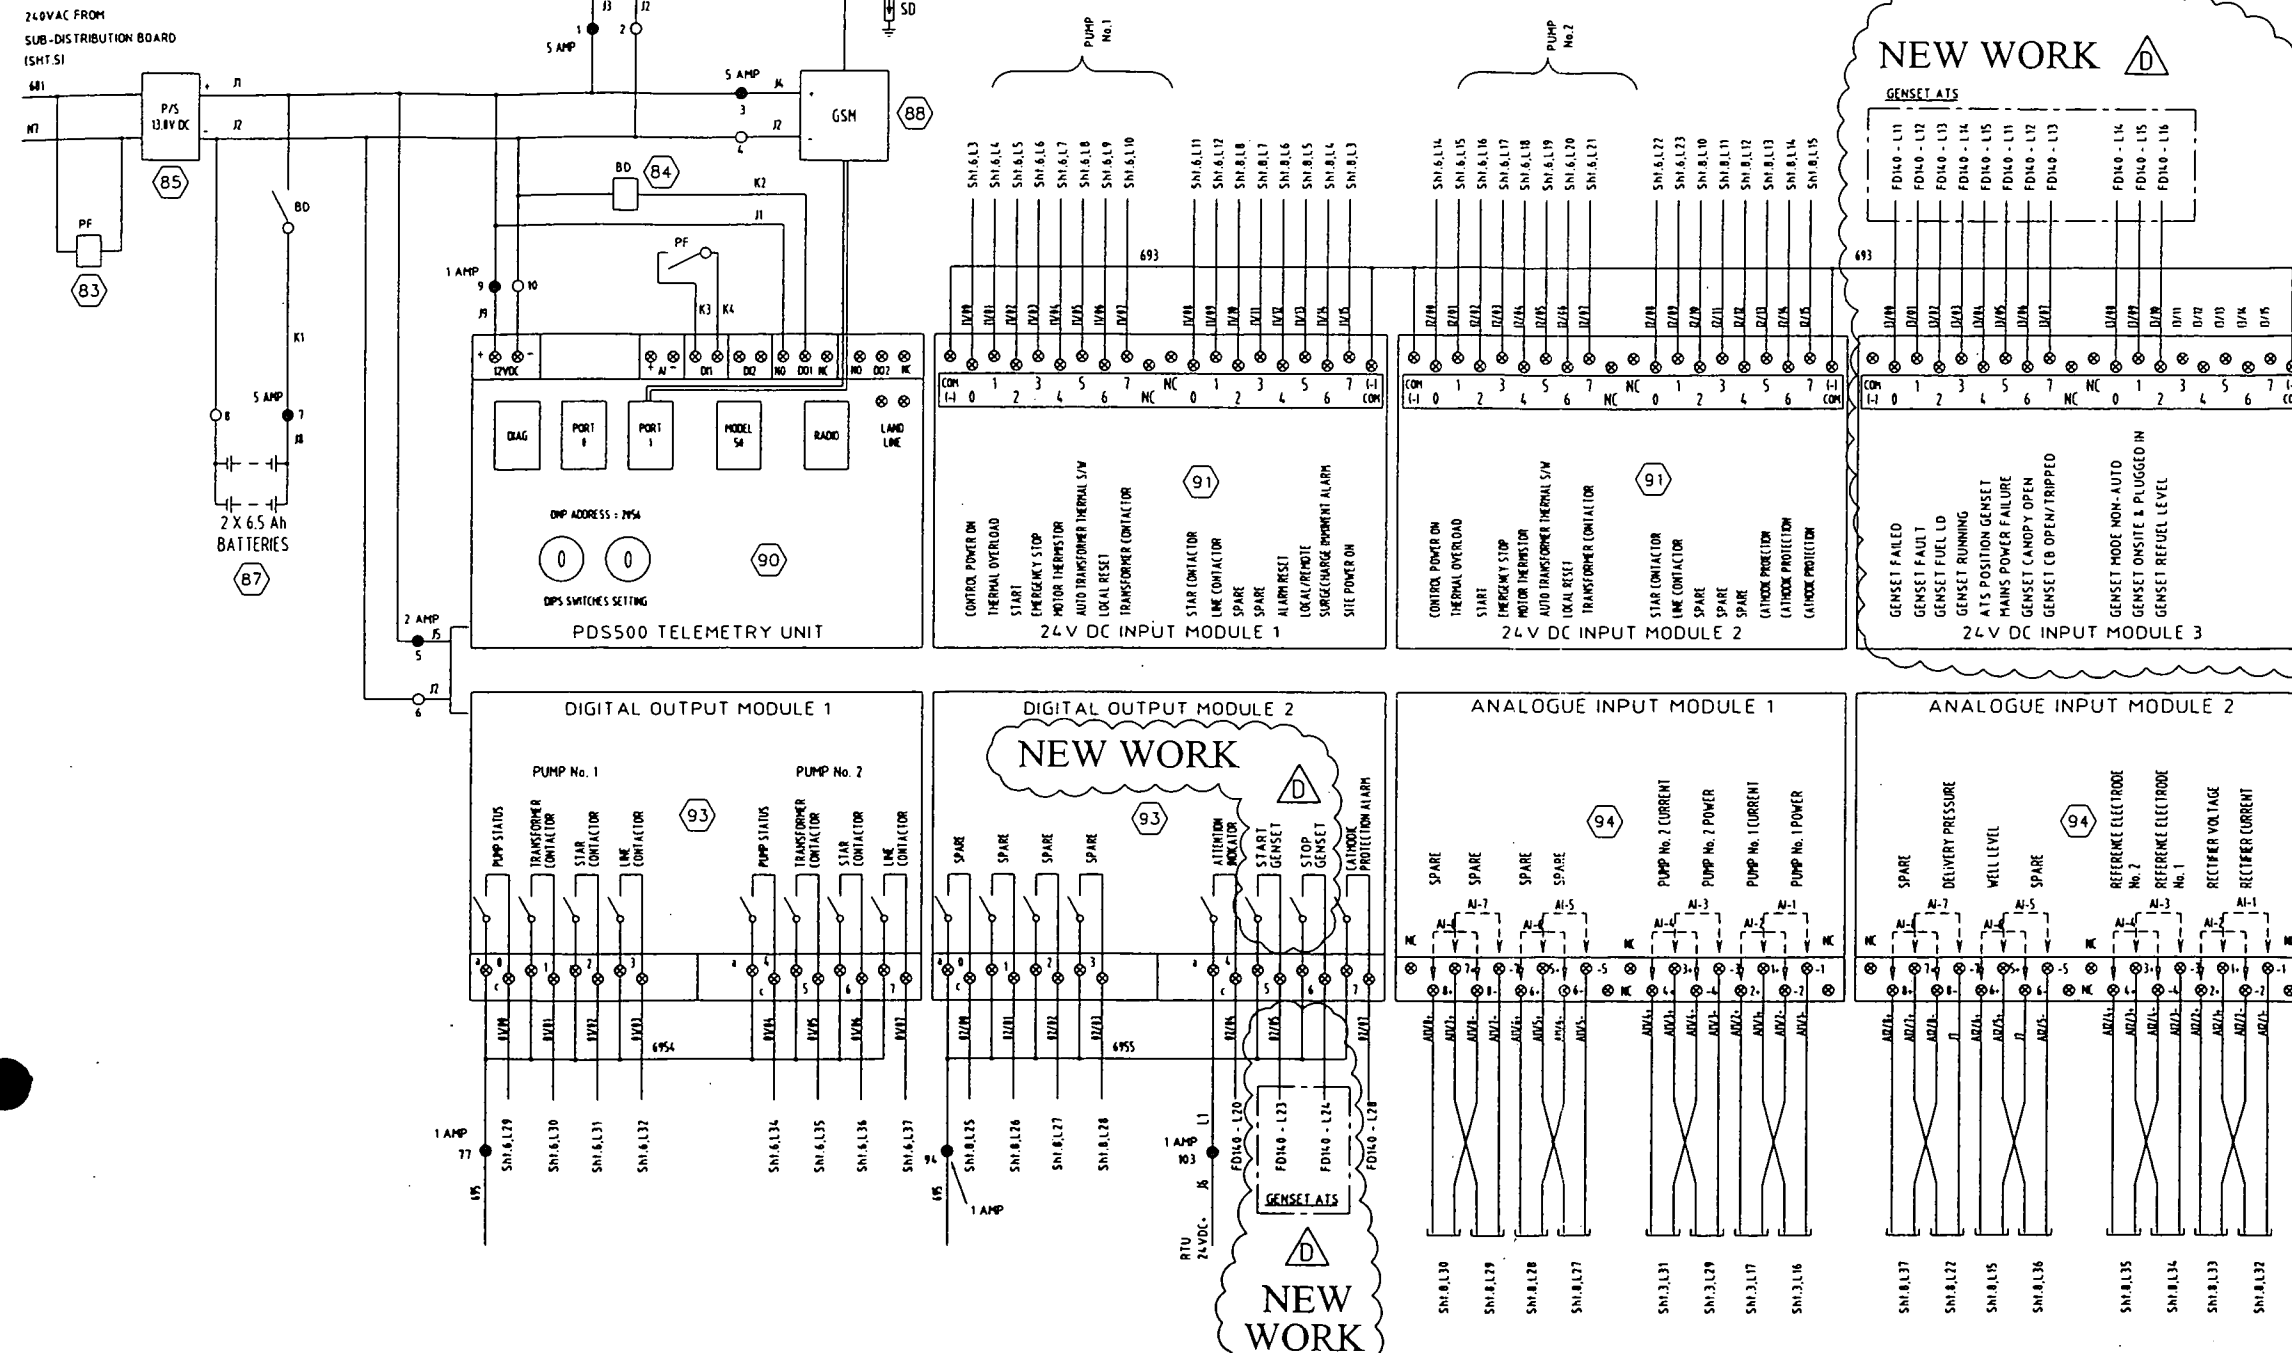

CROSS REFERENCE TABLE

ITEM	SHEET	LINE	ITEM	SHEET	LINE	ITEM	SHEET	LINE	ITEM	SHEET	LINE	ITEM	SHEET	LINE
C11	6	1	C12	6	2	RP13	6	32	TOL1	6	13			
- COIL			- COIL			- COIL			- COIL					
- 3 R/W			- 3 R/W			- 1 R/W			- 1 R/W					
- 1 R/W			- 1 R/W			- 1 R/W			- 1 R/W					
C12	6	8	LCM1	6	4	RP21	6	35	TOL2	6	21			
- COIL			- COIL			- COIL			- COIL					
- 3 R/W			- 1 C/P			- 1 C/P			- 1 R/W					
- 1 R/W			- 1 R/W			- 1 R/W			- 1 R/W					
C13	6	1	PR1	6	5	RP22	6	36	PUMP No. 1	6	8			
- COIL			- COIL			- COIL			A/TRANSFORMER					
- 3 R/W			- 1 C/P			- 1 C/P			THermal SWITCH					
- 1 R/W			- 1 C/P			- 1 C/P								
- 1 R/W			- 1 C/P			- 1 C/P								
C21	6	10	PR2	6	10	RP23	6	37	PUMP No. 2	6	10			
- COIL			- COIL			- COIL			A/TRANSFORMER					
- 3 R/W			- 1 C/P			- 1 C/P			THermal SWITCH					
- 1 R/W			- 1 C/P			- 1 C/P								
- 1 R/W			- 1 C/P			- 1 C/P								
C22	6	11	PR3	6	11	RP24	6	38	PUMP No. 3	6	11			
- COIL			- COIL			- COIL			A/TRANSFORMER					
- 3 R/W			- 1 C/P			- 1 C/P			THermal SWITCH					
- 1 R/W			- 1 C/P			- 1 C/P								
- 1 R/W			- 1 C/P			- 1 C/P								
C23	6	12	PR4	6	12	RP25	6	39	PUMP No. 4	6	12			
- COIL			- COIL			- COIL			A/TRANSFORMER					
- 3 R/W			- 1 C/P			- 1 C/P			THermal SWITCH					
- 1 R/W			- 1 C/P			- 1 C/P								

## LEGEND:

	RELAY OR CONTACTOR COIL
	FIELD DEVICE
	R.T.U. FUSE TERMINAL
	R.T.U. LINK TERMINAL
	SWITCHBOARD TERMINAL
	CATHODIC PROTECTION TERMINAL
	RTU DIGITAL INPUT
	RTU DIGITAL OUTPUT
	RTU ANALOG INPUT
	EQUIPMENT ITEM No





## NOTES

APPROVED FOR CONSTRUCTION

D	06.2006	Re-issued for Construction	<i>mf</i>
C	03.2006	Approved for Construction	M.J.L.
B	11.2005	SWBD GenSet Upgrade 2005	
A	27/5/98	AS BUILT	
No	DATE	AMENDMENT	INITIALS

## AMENDMENT &amp; ISSUE REGISTER

MANAGER		DIRECTOR OF TECHNOLOGY SERVICES	
DATE:		DATE:	
DIRECTOR OF PLANNING & DESIGN	DIRECTOR OF WATER SUPPLY	DIRECTOR OF CONSTRUCTION	
DATE:	DATE:	DATE:	

DESIGN	A.H.	9/9/97	ENGINEER IN CHARGE
DRAWN	K.M.	20/9/97	SUPERVISING ENGINEER
TRACED			
CHECKED	A.H.	25/9/97	A2 REDUCED

REFERENCES	COPYRIGHT©1996
CADD FILE No.	No reproduction is permitted in whole or in part without the express consent of
THIS DRAWING WAS PRODUCED USING AUTOCAD	BRISBANE CITY COUNCIL BRISBANE WATER




**Brisbane Water**

**ASSET MANAGEMENT PROFESSIONAL SERVICES**

PROJECT  
IDTS  
**PIONEER CRESCENT (SP235)**  
**SUBMERSIBLE SEWAGE PUMP STATION**


TITLE  
**RTU TERMINATION DIAGRAM**

SCALE:	No. OF SHEETS	
DRAWING No.	WAS 1321-15	AMEND.
486/5/7-FD142		D

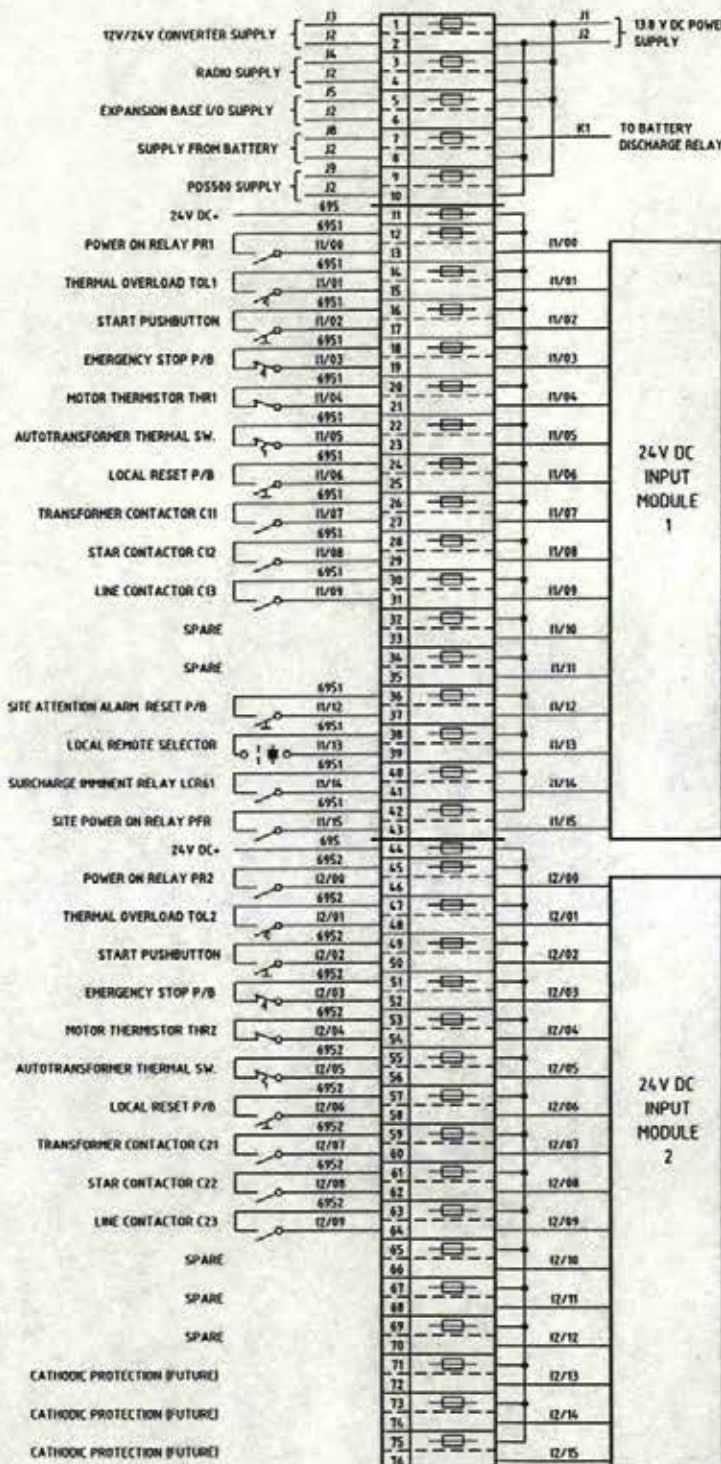RTU  
TERMINAL STRIP

24V DC INPUT MODULE 1


24V DC INPUT MODULE 2

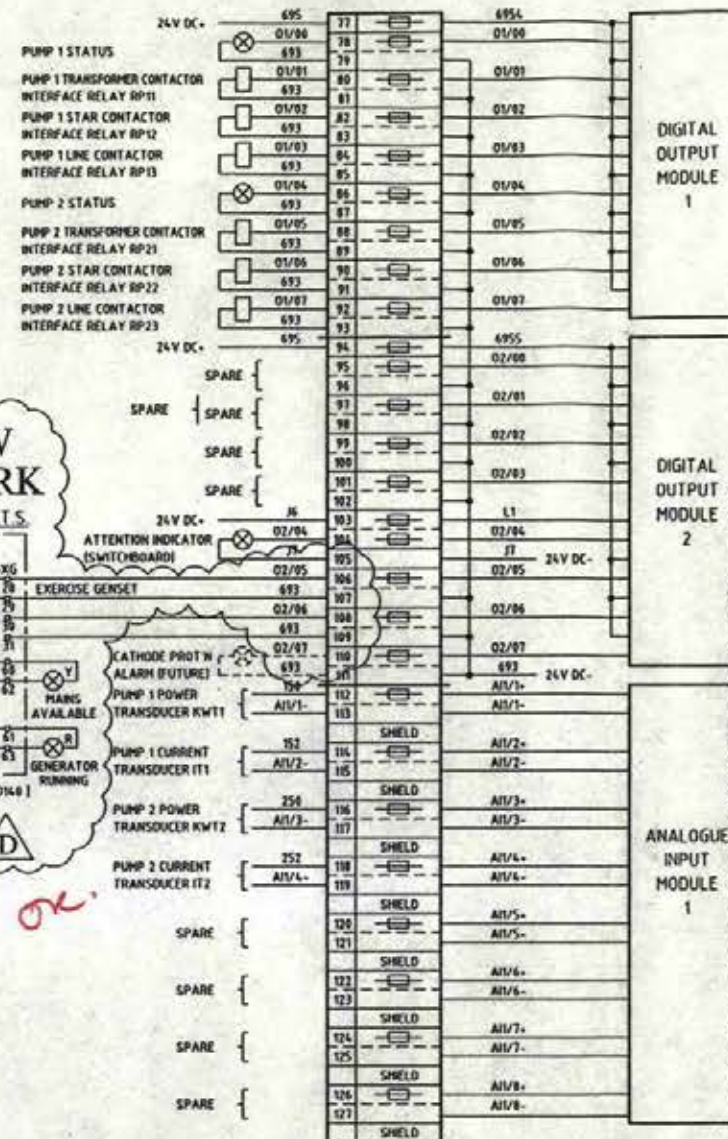RTU  
TERMINAL STRIP

DIGITAL OUTPUT MODULE 1

DIGITAL OUTPUT MODULE 2

ANALOGUE INPUT MODULE 1

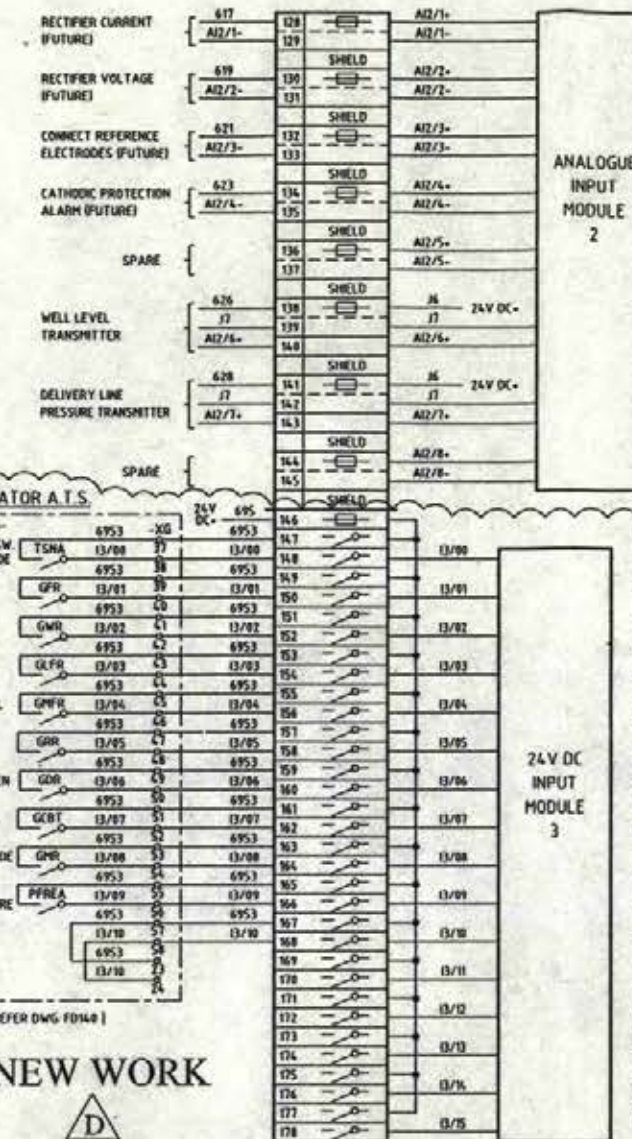RTU  
TERMINAL STRIP

ANALOGUE INPUT MODULE 2


24V DC INPUT MODULE 3







**NEW  
WORK**



**GENSET CABLES  
TO BE INSTALLED**

APPROVED FOR CONSTRUCTION

AMENDMENT & ISSUE REGISTER				
MANAGER		DIRECTOR OF TECHNOLOGY SERVICES		
DATE:		DATE:		
DIRECTOR OF PLANNING & DESIGN		DIRECTOR OF WATER SUPPLY		DIRECTOR OF CONSTRUCTION
DATE:		DATE:		DATE:
DESIGN	A.H.	9/9/97	ENGINEER IN CHARGE	
DRAWN	K.M.	20/9/97	SUPERVISING ENGINEER	
TRACED				
CHECKED	A.H.	8/10/97	A2	REDUCED

REFERENCES	COPYRIGHT©1996 No reproduction is permitted in whole or in part without the express consent of BRISBANE CITY COUNCIL BRISBANE WATER
CADD FILE No.	
THIS DRAWING WAS PRODUCED USING AUTOCAD	



PROJECT  
IDTS  
PIONEER CRESCENT (SP235)  
SUBMERSIBLE SEWAGE PUMP STATION

TITLE	
-------	--

CABLE SCHEDULE	
1	10:00 AM
2	11:00 AM
3	12:00 PM
4	1:00 PM
5	2:00 PM
6	3:00 PM
7	4:00 PM
8	5:00 PM
9	6:00 PM
10	7:00 PM
11	8:00 PM
12	9:00 PM
13	10:00 PM
14	11:00 PM
15	12:00 AM
16	1:00 AM
17	2:00 AM
18	3:00 AM
19	4:00 AM
20	5:00 AM
21	6:00 AM
22	7:00 AM
23	8:00 AM
24	9:00 AM
25	10:00 AM
26	11:00 AM
27	12:00 PM
28	1:00 PM
29	2:00 PM
30	3:00 PM
31	4:00 PM
32	5:00 PM
33	6:00 PM
34	7:00 PM
35	8:00 PM
36	9:00 PM
37	10:00 PM
38	11:00 PM
39	12:00 AM
40	1:00 AM
41	2:00 AM
42	3:00 AM
43	4:00 AM
44	5:00 AM
45	6:00 AM
46	7:00 AM
47	8:00 AM
48	9:00 AM
49	10:00 AM
50	11:00 AM
51	12:00 PM
52	1:00 PM
53	2:00 PM
54	3:00 PM
55	4:00 PM
56	5:00 PM
57	6:00 PM
58	7:00 PM
59	8:00 PM
60	9:00 PM
61	10:00 PM
62	11:00 PM
63	12:00 AM
64	1:00 AM
65	2:00 AM
66	3:00 AM
67	4:00 AM
68	5:00 AM
69	6:00 AM
70	7:00 AM
71	8:00 AM
72	9:00 AM
73	10:00 AM
74	11:00 AM
75	12:00 PM
76	1:00 PM
77	2:00 PM
78	3:00 PM
79	4:00 PM
80	5:00 PM
81	6:00 PM
82	7:00 PM
83	8:00 PM
84	9:00 PM
85	10:00 PM
86	11:00 PM
87	12:00 AM
88	1:00 AM
89	2:00 AM
90	3:00 AM
91	4:00 AM
92	5:00 AM
93	6:00 AM
94	7:00 AM
95	8:00 AM
96	9:00 AM
97	10:00 AM
98	11:00 AM
99	12:00 PM
100	1:00 PM
101	2:00 PM
102	3:00 PM
103	4:00 PM
104	5:00 PM
105	6:00 PM
106	7:00 PM
107	8:00 PM
108	9:00 PM
109	10:00 PM
110	11:00 PM
111	12:00 AM
112	1:00 AM
113	2:00 AM
114	3:00 AM
115	4:00 AM
116	5:00 AM
117	6:00 AM
118	7:00 AM
119	8:00 AM
120	9:00 AM
121	10:00 AM
122	11:00 AM
123	12:00 PM
124	1:00 PM
125	2:00 PM
126	3:00 PM
127	4:00 PM
128	5:00 PM
129	6:00 PM
130	7:00 PM
131	8:00 PM
132	9:00 PM
133	10:00 PM
134	11:00 PM
135	12:00 AM
136	1:00 AM
137	2:00 AM
138	3:00 AM
139	4:00 AM
140	5:00 AM
141	6:00 AM
142	7:00 AM
143	8:00 AM
144	9:00 AM
145	10:00 AM
146	11:00 AM
147	12:00 PM
148	1:00 PM
149	2:00 PM
150	3:00 PM
151	4:00 PM
152	5:00 PM
153	6:00 PM

SCALE:	No. OF SHEETS
--------	---------------

DRAWING No.	WAS 1321-16	AMEND.
486/5/7-FD143		C







## NOTES

APPROVED FOR CONSTRUCTION

C	03.2006	APPROVED FOR CONSTRUCTION	<i>mf</i>
B	11.2005	GENSET PROJECT REVISIONS	
A	27/5/98	AS BUILT	
No	DATE	AMENDMENT	INITIALS

## AMENDMENT &amp; ISSUE REGISTER

MANAGER	DIRECTOR OF TECHNOLOGY SERVICES		
DATE:	DATE:		
DIRECTOR OF PLANNING & DESIGN	DIRECTOR OF WATER SUPPLY	DIRECTOR OF CONSTRUCTION	
DATE:	DATE:	DATE:	

DESIGN	A.H.	9/9/97	ENGINEER IN CHARGE
DRAWN	K.M.	20/9/97	SUPERVISING ENGINEER
TRACED			
CHECKED	A.H.	8/10/97	A2 REDUCED

REFERENCES	COPYRIGHT©1996 No reproduction is permitted in whole or in part without the express consent of BRISBANE CITY COUNCIL BRISBANE WATER		
CADD FILE No.			
THIS DRAWING WAS PRODUCED USING AUTOCAD			




Brisbane City ASSET MANAGEMENT PROFESSIONAL SERVICES

PROJECT  
IDTS  
PIONEER CRESCENT (SP235)  
SUBMERSIBLE SEWAGE PUMP STATION

TITLE  
SWITCHBOARD GENERAL ARRANGEMENT

SCALE: No. OF SHEETS

DRAWING No. 486/5/7-FD144 AMEND. C

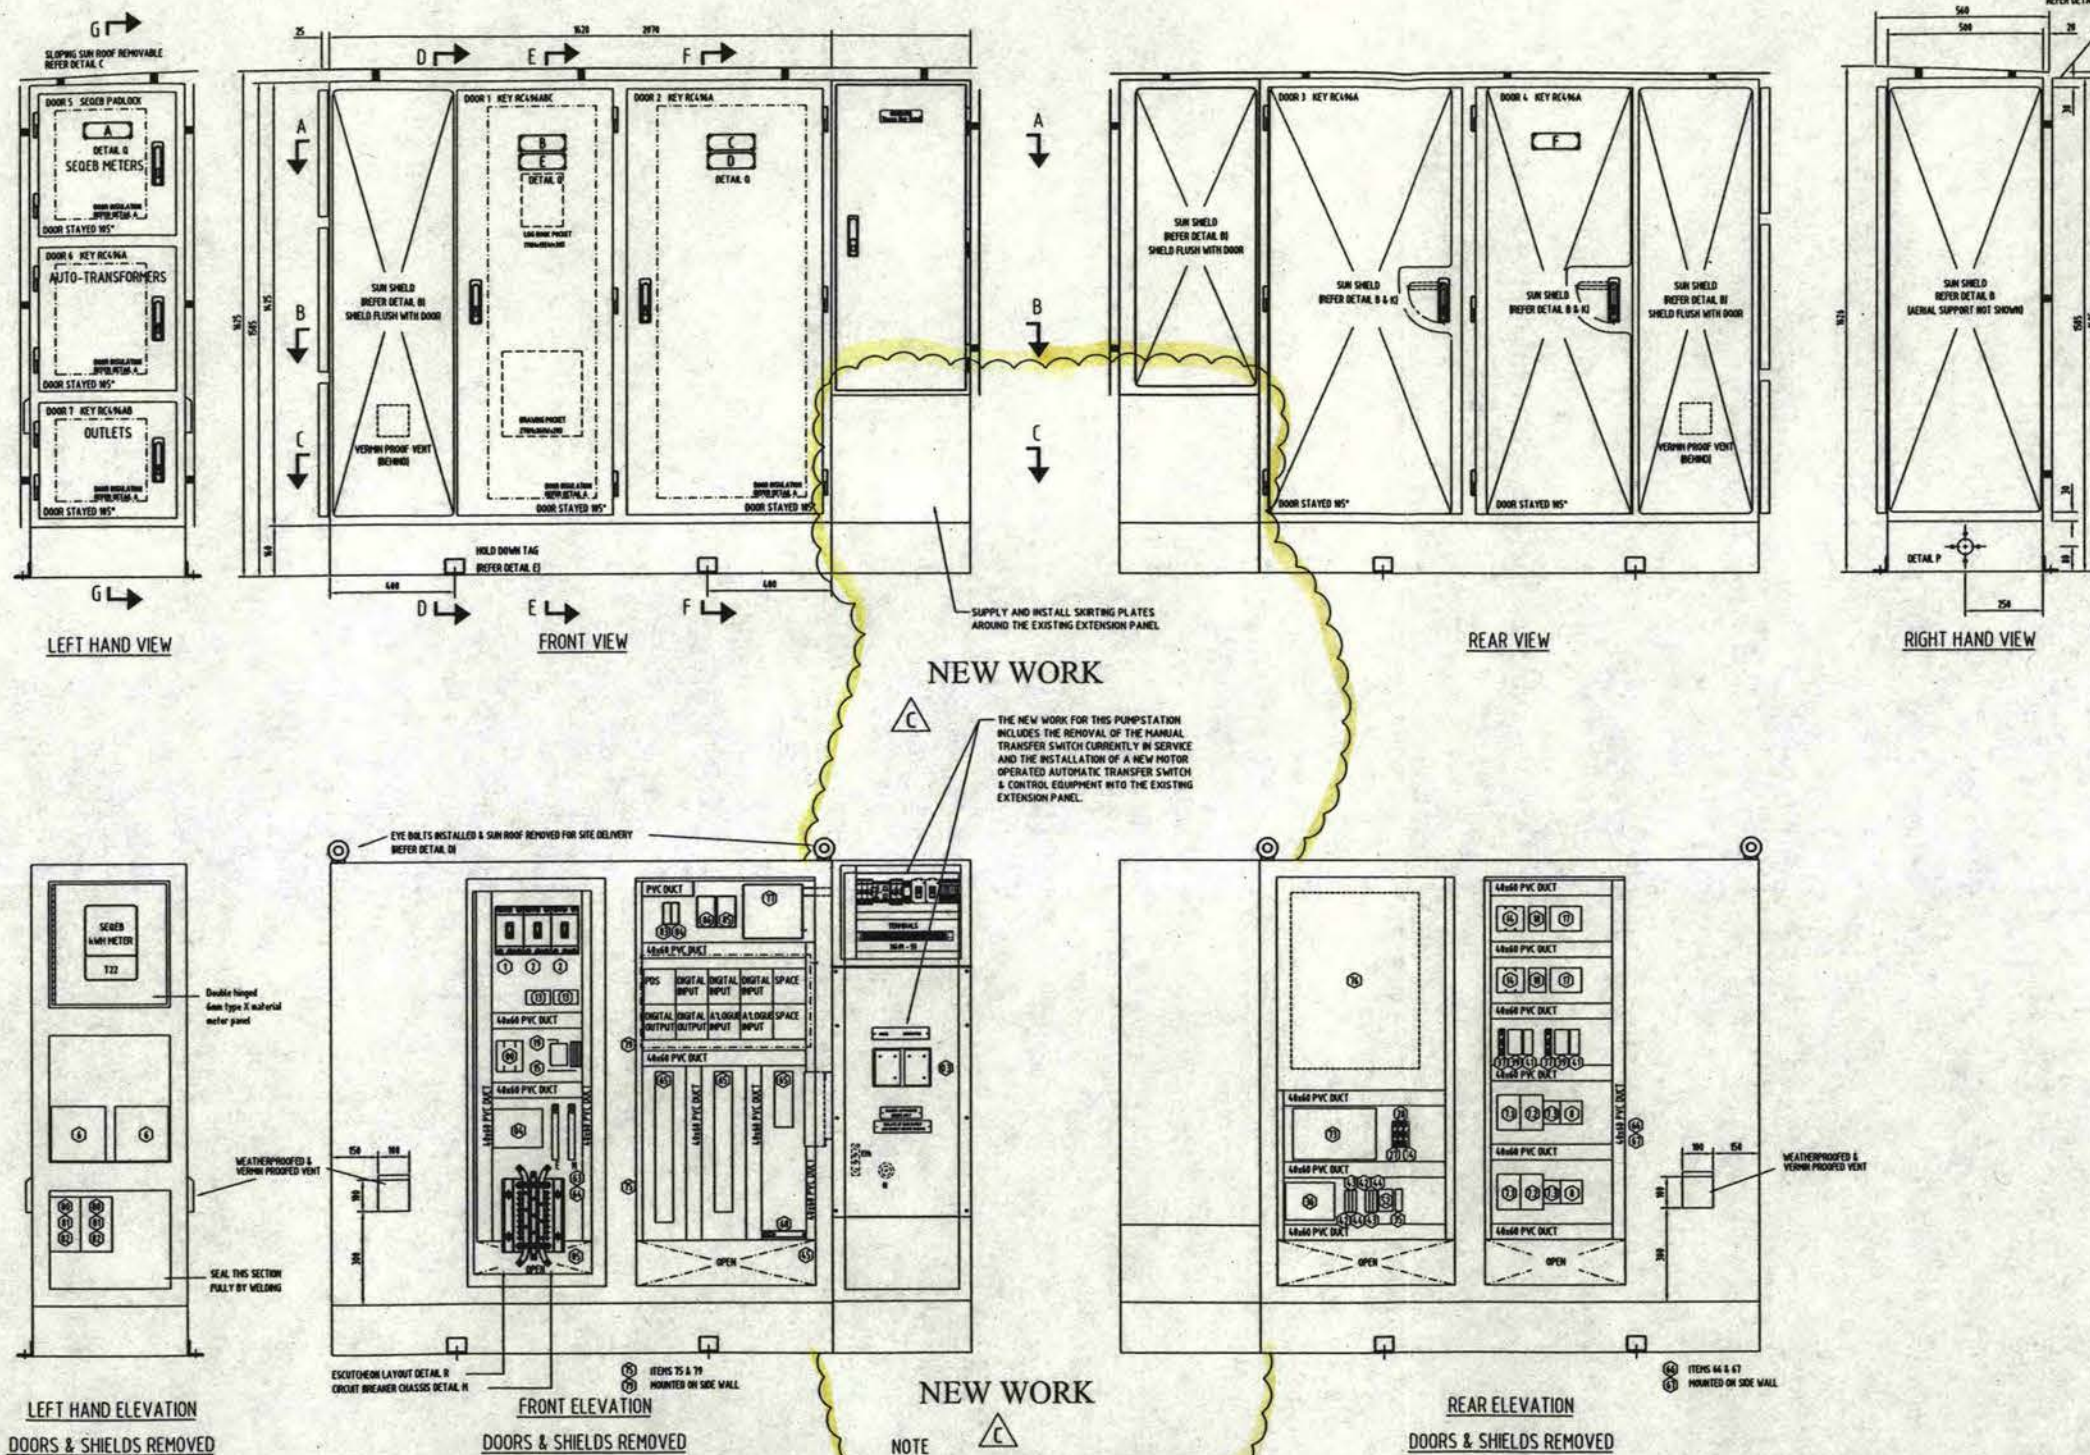

*As Drawn, Refer to C.C. Drawings  
JH86D001, JH86D001.*












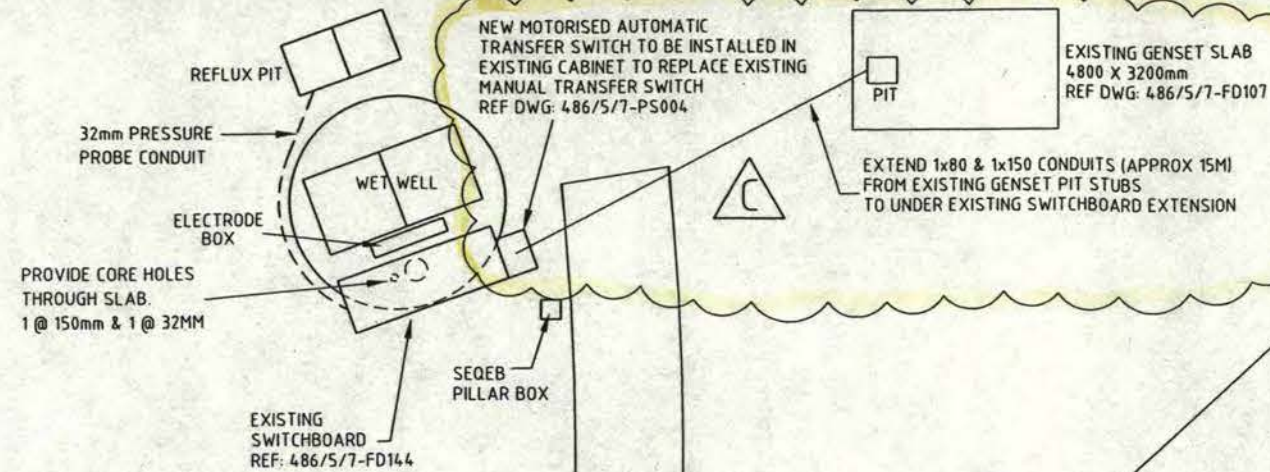

## NOTES

As Built

APPROVED FOR CONSTRUCTION

C	03.2006	APPROVED FOR CONSTRUCTION	mf
B	11.2005	2005 GENSET PROJECT	
A	27/5/98	AS BUILT	
No	DATE	AMENDMENT	INITIALS

## AMENDMENT &amp; ISSUE REGISTER

MANAGER	DIRECTOR OF TECHNOLOGY SERVICES		
DATE:	DATE:		
DIRECTOR OF PLANNING & DESIGN	DIRECTOR OF WATER SUPPLY	DIRECTOR OF CONSTRUCTION	
DATE:	DATE:	DATE:	
DESIGN	A.H.	20/10/97	ENGINEER IN CHARGE
DRAWN	K.M.	20/10/97	SUPERVISING ENGINEER
TRACED			
CHECKED	A.H.	30/10/97	A2 REDUCED

REFERENCES	COPYRIGHT©1996
CADD FILE No.	No reproduction is permitted in whole or in part without the express consent of
THIS DRAWING WAS PRODUCED USING AUTOCAD	BRISBANE CITY COUNCIL BRISBANE WATER




ASSET MANAGEMENT PROFESSIONAL SERVICES

PROJECT  
IDTS  
PIONEER CRESCENT (SP235)  
SUBMERSIBLE SEWAGE PUMP STATION

TITLE  
SITE LAYOUT

SCALE:	No. OF SHEETS
DRAWING No.	WAS 1321-30
486/5/7-FD149	AMEND. C

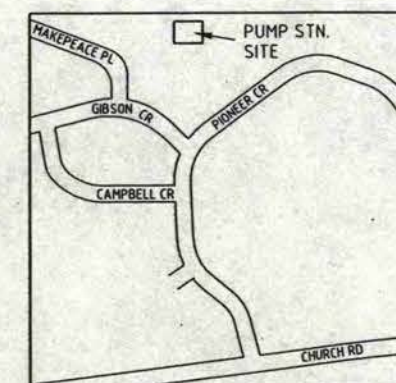


LOCALITY MAP







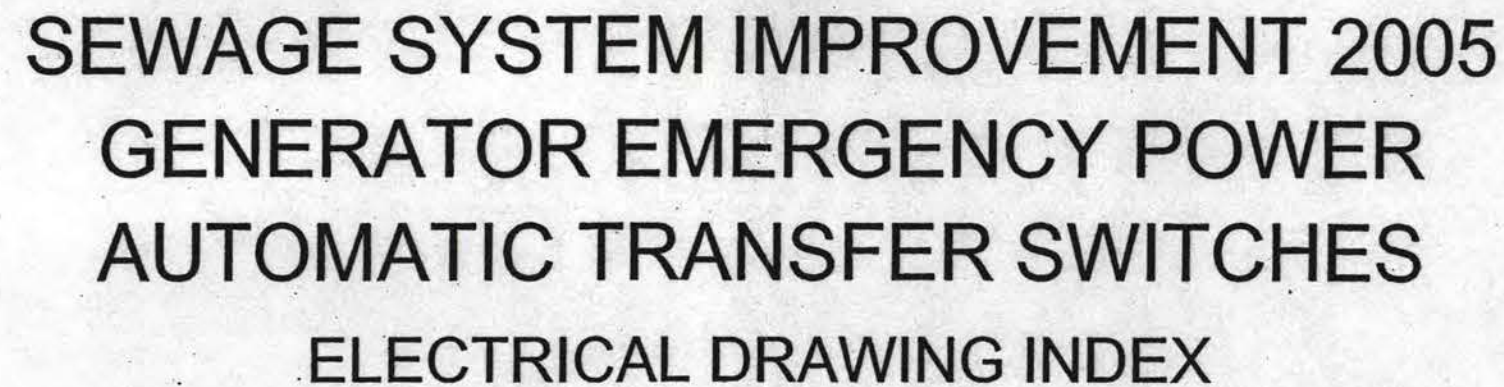

A. Buong  
FOR CONSTRUCTION

Page 30 of 80







[illegible]3







No	QTY	DESCRIPTION	SUPPLIER	MANUFACTURER	CATALOGUE No
01	1	SOLENOID AUTO TRANSFER SWITCH	NHP	AICHI	62W3FD240VAC
02	1	MAINS VOLTS DETECTION C/B	NHP	TERASAKI	DTCB6306C
03	1	MAINS VOLTS PHASE FAILURE RELAY		CROMPTON	252-PSG
04	1	GENSET VOLTS DETECTION C/B	NHP	TERASAKI	DTCB6406C
05	15	GENSET CONTROL & INDICATION RELAYS		FINDER OR IZUMI	
06	1	CONTROL SUPPLY SELECTOR RELAY		FINDER OR IZUMI	LY2 WITH BASE

SEWAGE PUMP STATION SITE:	EX. GENERAL ARGT.	EX. CONSTR. NOTES:	REMARKS
BIRKIN ROAD - BELLBOWRIE	486/5/7-FD419	486/5/7-FD420	REFER NOTES 1, 2, 5 & 6
PIONEER CRESCENT - BELLBOWRIE	486/5/7-FD144	486/5/7-FD145	REFER NOTES 1, 2, 5 & 6
WIRRIBOOT COURT - KARANA DOWNS	486/5/7-FK710	486/5/7-FK711	REFER NOTES 3 & 4

1. CUBICLE MATERIAL, CONSTRUCTION, SUN SHIELDS AND FINISH TO MATCH EXISTING SWITCHBOARDS. CONSTRUCTION TO BE VERIFIED AGAINST EXISTING REFERENCE DRG. CONSTRUCTION NOTES.
2. CHECK DIMENSIONS OF EXISTING SWITCHBOARD AND VERIFY AGAINST EXISTING GENERAL ARRANGEMENT DRAWING. ATTACH A.T.S. PANEL TO EXISTING SWITCHBOARD THROUGH SIDE WALL WITH 4-M10 BOLTS.
3. FOR WIRING DETAILS REFER DRG 486/5/7-PS003.
4. WIRRIBOOT COURT SITE:  
THIS SITE DOES NOT REQUIRE AN ADDITIONAL CUBICLE. A 250 AMP (CAT No BH2N233) A.T.S. & ASSOCIATED CONTROL EQUIPMENT SHALL BE INSTALLED WITHIN THE EXISTING SWITCHBOARD.
5. BIRKIN ROAD AND PIONEER CRESCENT SITES:  
HAVE EXISTING EXTENSION CUBICLES FINISHING WELL ABOVE GROUND, COMPLETE WITH MANUAL TRANSFER SWITCHES.
6. THE NEW WORK FOR BOTH BIRKIN ROAD AND PIONEER CRESCENT INCLUDES THE REMOVAL OF THE EXISTING MTS EQUIPMENT AND THE INSTALLATION OF A 125 AMP (CAT No BH1N233) MOTOR OPERATED AUTOMATIC TRANSFER SWITCH AND CONTROL EQUIPMENT IN THE EXISTING EXTENSION PANEL AT EACH SITE.

As Burets, Refr to C.L. Ong's  
JH8DDOI, JH8DDOI,

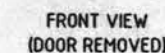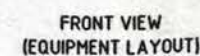

FOR CONSTRUCTION









# MAIN SWITCHBOARD [EXISTING] - EXTENSION PANEL GENERATOR A.T.S. PANEL

NOTE: T/S = TRANSFER SWITCH

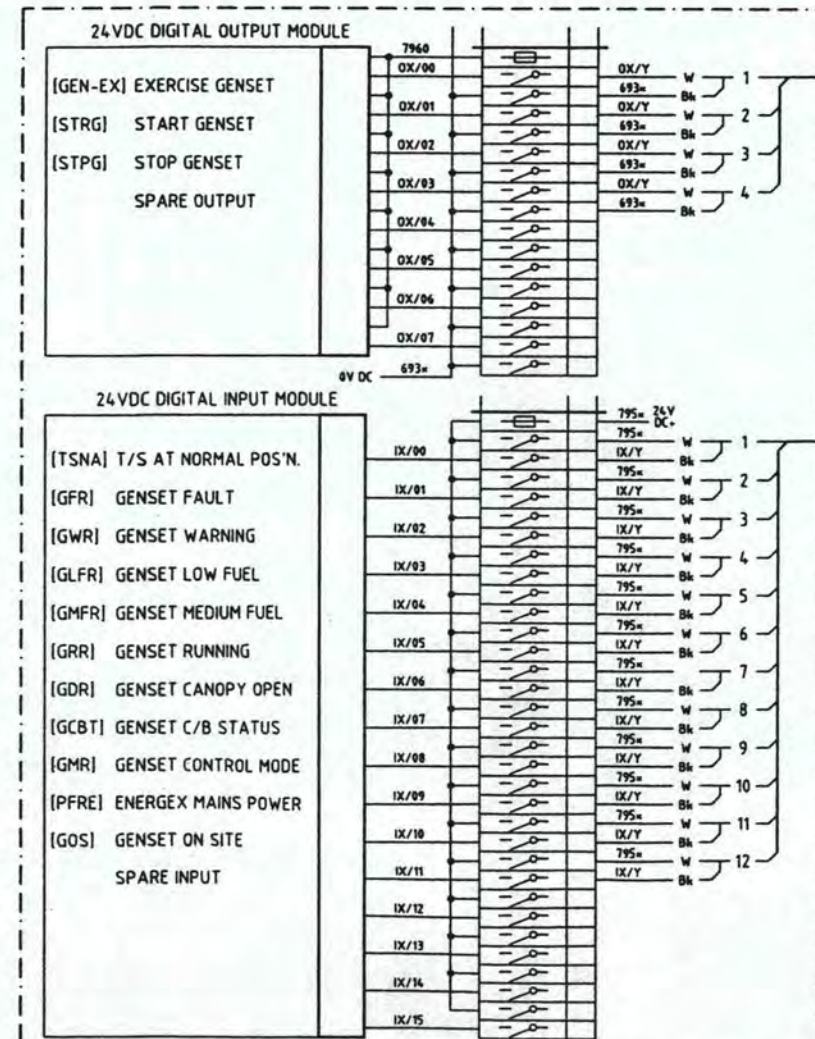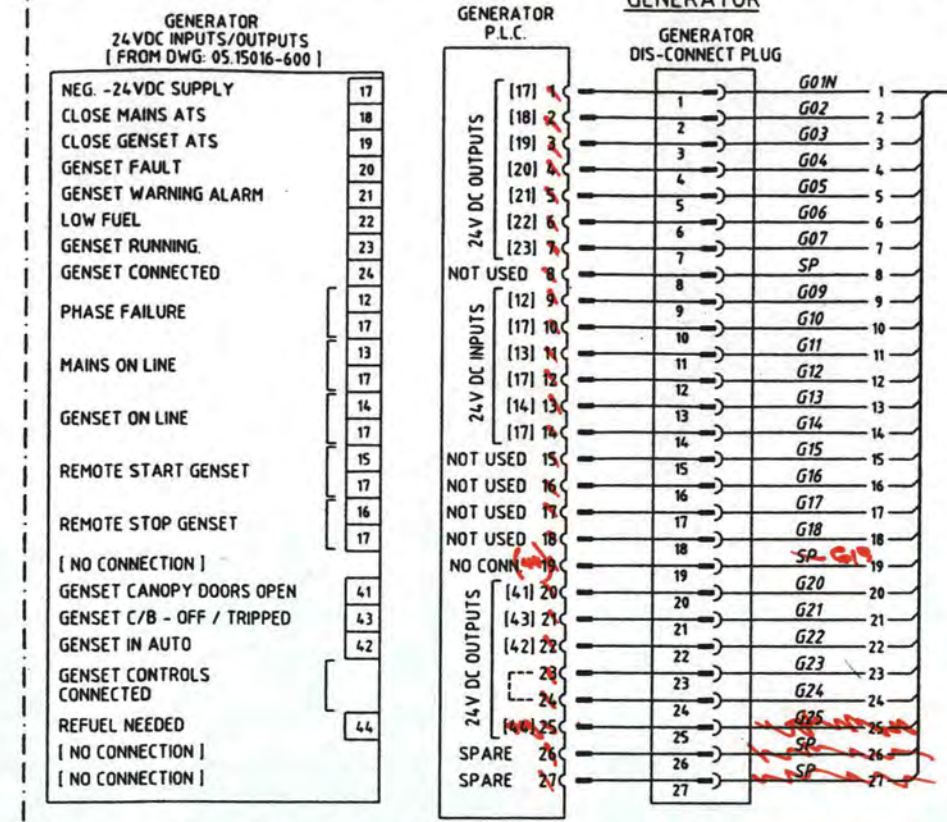


## MAIN SWITCHBOARD R.T.U. - SECTION



NOTE:- R.T.U. WIRE NUMBERING VARIES FROM SITE TO SITE. WIRE Nos: OX/Y & IX/Y AND 795x & 693x SHALL BE REPLACED BY SITE SPECIFIC WIRE NUMBERS. [REFER TO NOTE 5]

## MAIN SWITCHBOARD

### CONTROL PANEL STATUS INDICATORS

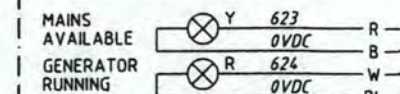

### R.T.U. SECTION - POWER SUPPLY

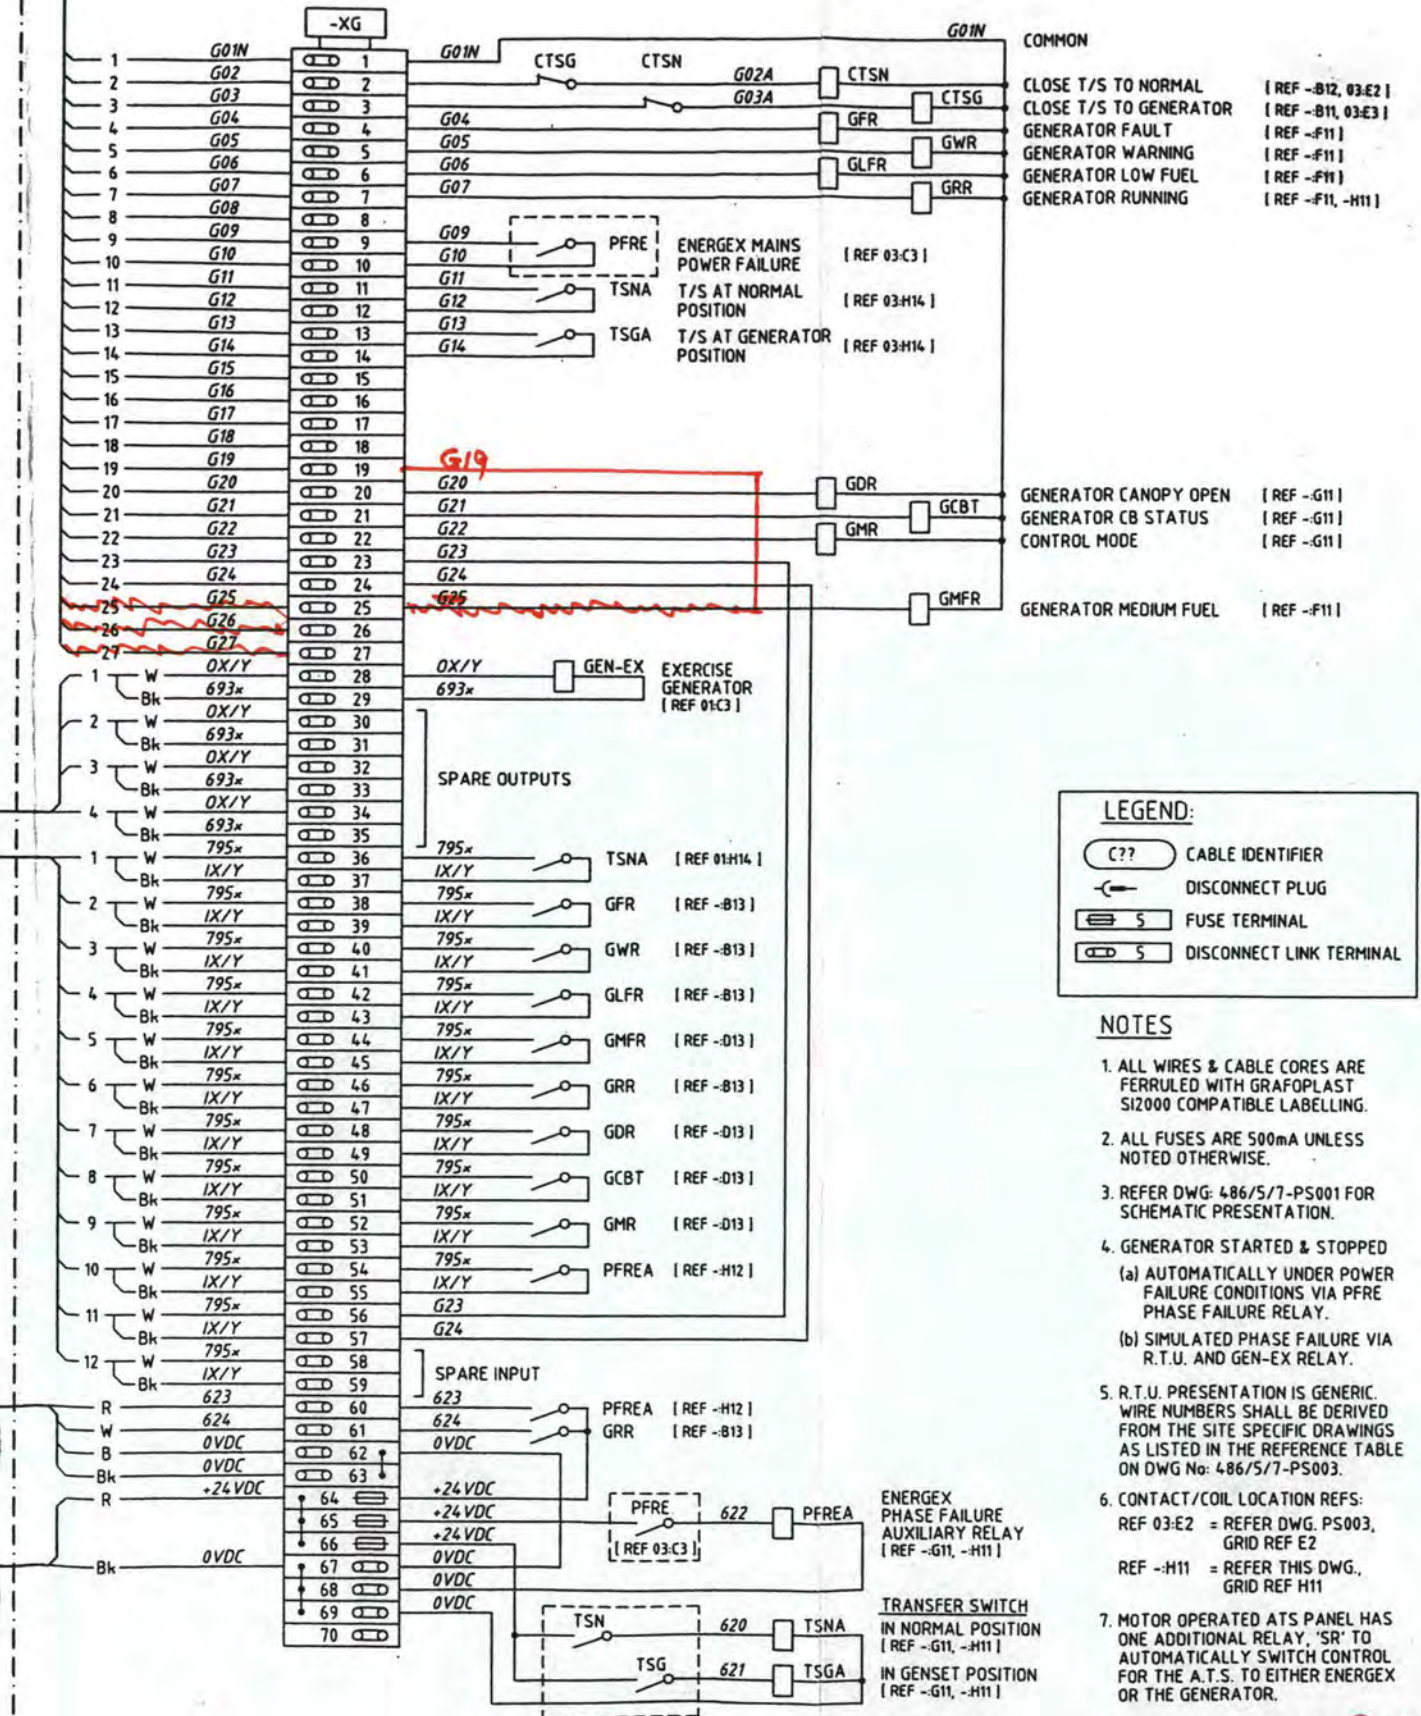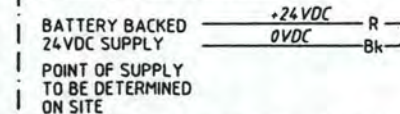

## LEGEND:

- C?? CABLE IDENTIFIER
- DISCONNECT PLUG
- FUSE TERMINAL
- DISCONNECT LINK TERMINAL

## NOTES

- ALL WIRES & CABLE CORES ARE FERRULED WITH GRAFOPLAST S12000 COMPATIBLE LABELLING.
- ALL FUSES ARE 500mA UNLESS NOTED OTHERWISE.
- REFER DWG. 486/5/7-PS001 FOR SCHEMATIC PRESENTATION.
- GENERATOR STARTED & STOPPED
  - AUTOMATICALLY UNDER POWER FAILURE CONDITIONS VIA PFRE PHASE FAILURE RELAY.
  - SIMULATED PHASE FAILURE VIA R.T.U. AND GEN-EX RELAY.
- R.T.U. PRESENTATION IS GENERIC. WIRE NUMBERS SHALL BE DERIVED FROM THE SITE SPECIFIC DRAWINGS AS LISTED IN THE REFERENCE TABLE ON DWG No. 486/5/7-PS003.
- CONTACT/COIL LOCATION REFS:
 

REF 03-E2 = REFER DWG. PS003, GRID REF E2

REF -H11 = REFER THIS DWG., GRID REF H11
- MOTOR OPERATED ATS PANEL HAS ONE ADDITIONAL RELAY, 'SR' TO AUTOMATICALLY SWITCH CONTROL FOR THE A.T.S. TO EITHER ENERGEX OR THE GENERATOR.

FOR CONSTRUCTION

1	05.06	REDRAWN. NEW BORDER. RELAY CONFIG. UPGRADED.	DRAFTED	M.J. LIGHTBODY	DESIGN	R.P.E.Q. No.	DATE	PRINCIPAL DESIGN MANAGER	DATE	PROJECT	SEWAGE SYSTEM IMPROVEMENT 2005	TITLE	TYPICAL MOTOR OPERATED AUTOMATIC TRANSFER SWITCH INTERCONNECTION DIAGRAM	SHEET No. 18	BRISBANE WATER DRAWING No.	AMEND.
0	04.06	CONSTRUCTION ISSUE.	DRAFTING CHECK		DESIGN	R.P.E.Q. No.	DATE	CLIENT DELEGATE	DATE					486/5/7-PS006		1
No	DATE	AMENDMENT	DRN.	APD.	Reference Drawings	B.C.C. FILE No.										



**COMMON LOGIC Pty Ltd**  
**Specialist Electrical Contractors****Electrical Manual**

Subject: Pioneer Cres SP235

Sheet: 7  
Of: 9Section  
4

Page Revision No:

Date: 17/11/06

Manual Issue No: 1 Date: 17/11/06

**4.0 PART LIST**

Authorised By: Grant Kerr

**Electrical Manual**

17/11/2006

<b>Supplier Name</b>	<b>Part No</b>	<b>Item Description</b>	<b>Quant</b>
ABK Electrical Wholesale	CLIWIPM27	27 CONTROL PIN W/P INSUL PLUG HI-IMPACT	1
Crompton Instruments	252-PSGW	415V NOMINAL VOLTAGE SENSING RELAY	1
NHP Electrical Engineering	96.72	2P 12AMP RELAY BASE FOR 56.32 RLY	2
NHP Electrical Engineering	2H1952BAA	2 C/OVER AUX SWITCH XS250NJA MCCB	2
NHP Electrical Engineering	38.51 24VDC	24V DC RELAY 1CO 6A	8
NHP Electrical Engineering	56.32 0074 24VDC	RELAY FPIN 2CO 12A 24VDC	2
NHP Electrical Engineering	D5PP43NL3R	KIT D5 INT LED RED IND 24VAC/DC	1
NHP Electrical Engineering	D5PP53DLO	YELLOW PILOT LIGHT ROUND MAX 130V	1
NHP Electrical Engineering	D5PP53NL3A	KIT D5 INT LED YELLOW IND 24VAC/DC	1
NHP Electrical Engineering	DSRCBH1030A	DINT MCB/RCD 1P 10A 30MA 10KA	1
NHP Electrical Engineering	DTCB6106C	DINT 6KA 1P 6A CB	1
NHP Electrical Engineering	DTCB6306C	DINT 6KA 3P 6A CB	1
NHP Electrical Engineering	UXMB0058B	XH160-XH250 MOTOR OPERATORS 240V	2
Phoenix Contact Pty Ltd	PH0441504	USLKG5 EARTH TERMINAL 4MM	2
Phoenix Contact Pty Ltd	PH3004100	UK5-HESI FUSE TERMINAL M205	4
Phoenix Contact Pty Ltd	PH3004362	UK5N 4MM FEEDTHRU TERMINAL GREY	40
Ramelec Pty Ltd	017216-0000	SAKR/35 LINK TERMINAL	32
Ramelec Pty Ltd	047456-0000	ASK1 FUSE TERMINAL	2

**COMMON LOGIC Pty Ltd**  
**Specialist Electrical Contractors****Electrical Manual**

Subject: Pioneer Cres SP235

Sheet: 8  
Of: 9Section  
5

Page Revision No:

Date: 17/11/06

Manual Issue No: 1 Date: 17/11/06

**5.0 TEST SHEETS**

Authorised By: Grant Kerr



COMMON LOGIC Pty Ltd

A.C.N. 011 029 262

ELECTRICAL CONTRACTORS LICENCE No: 9564

Job Card Number: 0444

Variation To Fixed Price Proj

Cost Plus Labour Proj.

Call Out

Service

CUSTOMER: Brisbane Water

Project No: SP235

Representative Name: RALPH BERRY

Position: SUPERINTENDENT

Date: 22/09/06

Signature on Completion:

Power Authority Forms

Pre-Start Safety Mtg.

Risk Assessment

C/L Representative Jeff Allan

Position: Electrician

Date: 22/09/06

Mobile Phone No: 0419 585 660

START	FINISH	DETAILS	Hrs.	No MEN	TOTAL	RATE	CHARGED
		TRAVEL TO SITE					
		Pioneer Crescent					
		Mounted extra ATS Panel					
		Cut in Submain to ATS					
		Connected Generator &					
		Control Cabling					
		Installed RTV fuses					
		& wiring					

PLEASE SEE ATTACHED FORM FOR ADDITIONAL

TOTAL LABOUR CHARGED:

ITEM No:	PART No:	ITEM DESCRIPTION.	No. ITEM	COST ITEM	TOTAL COST	%	CHARGED
1.		Switchboard Kit as					
2.		supplied					
3.							
4.							
5.							
6.							
7.							
8.							
9.							

PLEASE SEE ATTACHED FORM FOR ADDITIONAL

TOTAL MATERIALS:

PROGRESS CLAIM

WORKS NOT COMPLETED AND NOT TESTED

WHITE COPY -- CUSTOMER

FURTHER WORK

REQUIRED TO COMPLETE PROJECT.

YELLOW COPY -- OFFICE

PROJECT COMPLETED

NO FURTHER ACTION REQUIRED

Certify that the Electrical work listed above has been tested in accordance with the prescribed procedure and that such work complies with the requirements of the State Electricity Act.

Signature: [Signature]

ELECTRICAL LICENCE No. 40134

POLARITY TEST.

INSULATION RES. TEST.

ETH CONTINUITY TEST

FUNCTIONAL TEST

Common Logic Pty Ltd

Unit 9/58 Wecker Road, Mansfield 4122 • Ph: (07) 3849 7449 • Fax: (07) 3343 5210



LICENCE NO.  
ELECTRICIAN



COMMON LOGIC Pty Ltd  
Specialist Electrical Contractors

# Site Acceptance Tests

Subject: SAT for BW Generator Change Over Panels

Sheet: 1  
Of: 7

Section

Page Revision No: 0 Date: 29/08/06

Manual Issue No: 0 Date: 29/08/06

<b>1.0</b>	<b>SITE ACCEPTANCE TEST.....</b>	<b>2</b>
1.1	INTRODUCTION .....	2
1.2	PRODUCTION UNIT INFORMATION.....	2
1.3	SAFETY PRECAUTIONS .....	2
<b>2.0</b>	<b>ELECTRICAL EARTHING SYSTEM .....</b>	<b>3</b>
2.1	ELECTRICAL CONTINUITY AND RESISTANCE OF EARTHING SYSTEM .....	3
2.2	CONTINUITY TEST SHEET .....	3
<b>3.0</b>	<b>INSULATION RESISTANCE/ HIGH POT TEST.....</b>	<b>3</b>
3.1	INSULATION RESISTANCE TEST.....	3
3.2	LOW VOLTAGE SWITCHBOARDS INSULATION TEST .....	3
<b>4.0</b>	<b>GENERAL WIRING AND VISUAL INSPECTION.....</b>	<b>4</b>
4.1	GENERAL WIRING AND VISUAL INSPECTION .....	4
4.2	SWITCHGEAR VISUAL CHECKLIST .....	4
4.3	TERMINAL VISUAL CHECKLIST .....	5
4.4	RELAY VISUAL CHECKLIST .....	5
<b>5.0</b>	<b>CONTINUITY &amp; PRE-COMMISSIONING TEST .....</b>	<b>6</b>
5.1	CONTINUITY TEST.....	6
<b>6.0</b>	<b>COMPONENT OPERATIONAL TEST .....</b>	<b>7</b>
6.1	COMPONENT OPERATION TEST .....	7
6.2	AC CONTROL SYSTEMS .....	7

Test Carried out by..... *Grant Kerr*

Signed... *[Signature]* Date... *22/9/06*

Test witnessed by.....

Signed... Date...

Authorised By:

JH86QT01

29 August, 2006

COMMON LOGIC Pty Ltd  
Specialist Electrical Contractors

# Site Acceptance Tests

Subject: SAT for BW Generator Change Over Panels

Sheet: 2  
Of: 7

Section

Page Revision No: 0 Date: 29/08/06

Manual Issue No: 0 Date: 29/08/06

## 1.0 SITE ACCEPTANCE TEST

### 1.1 Introduction

Complete EVERY box below; if items are not applicable indicate by a N/A in the check box, any comments can be completed at the end of the checklist.


**Aim:** This Commissioning list is to be completed by the person/s who are undertaking the commissioning and testing of the switchboard in question. The commissioning list is designed to check the fundamental wiring of the switchboard.

**Scope:** This Commissioning list is designed to test the operation of the MSB and Controls only. Building wiring is subject to test by building services qualified personnel.

### Legend of Symbols

☐ Check Box,    ⊗ Setting to be recorded,    → and Action to take

### 1.2 Production Unit Information

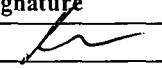Job Number	JH86	Site Name	SP235 PIONEER CRES.
	Name	Signature	Date
Testing Officer	Grant Kerr		22/09/06
Witness			


### 1.3 Safety precautions

Outlined below are some common safety procedures and First Aid Instruction.

## SAFETY FIRST

- 1) Never test live boards alone. Always inform others of your actions and intentions.
- 2) Isolate mains or REMOVE TEST PLUG and locate close to testing area under your control.
- 3) Isolate the switchboard main switch and all circuitbreakers and fuses to completely remove all possibility of switching a live conductor when not deliberately required.
- 4) Tag all Distribution as DO NOT OPERATE removing only after tested and safe.
- 5) Insure NO LIVE WIRES are exposed at any time and a CLEAR TESTING AREA and escape route at all times.
- 6) PROTECTIVE CLOTHING and eyewear should be worn at all times when working within Live board or when appropriate.

Test Carried out by..... Grant Kerr

Signed...  Date... 22/09/06

Test witnessed by.....

Signed... Date...

Authorised By:

JH86QT01

29 August, 2006



COMMON LOGIC Pty Ltd  
Specialist Electrical Contractors

# Site Acceptance Tests

Subject: SAT for BW Generator Change Over Panels

Sheet: 3  
Of: 7

Section

Page Revision No: 0 Date: 29/08/06

Manual Issue No: 0 Date: 29/08/06

## 2.0 ELECTRICAL EARTHING SYSTEM

### 2.1 Electrical continuity and resistance of earthing system

☐ Maximum resistance of the Earthing system within the switchboard is 0.5 ohms (AS/NZS 3000:2000)

☒ Test resistance of the Earthing system 4.5  $\Omega$  ohms

### 2.2 Continuity Test Sheet

ITEM	DETAIL	COMPARTMENT DESIGNATION AND TEST RESULT		
		Extension	Main Eth Bar	Generator
	Test resistance of Earthing system to compartment Answer in Ohms		—	—
1	All Earth's wired and continuous	—	—	—
2	All metal work earthed where required	—	—	—
3	Isolate Individual Earth Systems and check continuity.	—	—	—

## 3.0 INSULATION RESISTANCE/ HIGH POT TEST

### 3.1 Insulation Resistance Test

Insulation resistance of whole or part of an installation must be a minimum of 1 Meg/ohm (AS/NZS 3000:2000)

- ☒ Insulation test conducted on all internal circuits GENERATOR LEADS
- All Selector Switches, Isolators and CB's are in the off position
- All electronic equipment susceptible to high voltage damage to be isolated.

### 3.2 Low Voltage Switchboards Insulation Test

MEGGAR VOLTAGE 1000 VOLTS

INSTRUMENT DETAILS \_\_\_\_\_

ACROSS	RESULT (M.OHM)	High Pot
Join Red, White & Blue Phases and Neutral, Test to Earth	<u>&gt; 200 m<math>\Omega</math></u>	
Red Phase to White, Blue & N	<u>&gt; 200 m<math>\Omega</math></u>	
White Phase to Red, Blue and N	<u>&gt; 200 m<math>\Omega</math></u>	
Blue Phase to Red, White & N	<u>&gt; 200 m<math>\Omega</math></u>	
N to Red, White & Blue	<u>&gt; 200 m<math>\Omega</math></u>	

Test Carried out by..... Grant Kerr

Signed... [Signature] Date... 22/09/06

Test witnessed by.....

Signed... Date...

Authorised By:

JH86QT01

29 August, 2006

COMMON LOGIC Pty Ltd  
Specialist Electrical Contractors

# Site Acceptance Tests

Subject: SAT for BW Generator Change Over Panels

Sheet: 4  
Of: 7

Section

Page Revision No: 0 Date: 29/08/06

Manual Issue No: 0 Date: 29/08/06

## 4.0 GENERAL WIRING AND VISUAL INSPECTION

### 4.1 General Wiring and Visual Inspection

☐ Electrical Construction Coversheet Completed and correct.

### 4.2 Switchgear Visual Checklist

→ Carry out visual and mechanical checks to Switchgear

ITEM NO:	DETAIL	Switchboard compartments		
		Transfer switch compartment	Main switch area	Generator in general
1	Main Switch totally isolates SWBD	✓	✓	✓
	Mains transfer switch device isolates mains from load. (IE switchboard)	✓	—	—
2	Generator transfer switch operates and isolates generator from the load. And mechanical interlock works	✓	—	—
3	Cables tight and correct phase rotation. Colour match.	✓	✓	—
4	Main Switch Correct Rating/Label	✓	—	—
5	Neutral cable connected and continuous and tight.	✓	—	—

ITEM	DETAIL	COMPARTMENT DESIGNATION AND TEST RESULT	
		Switchboard extension	Existing Switchboard. Where modified.
1	All CBs operate correctly	✓	—
2	All incoming terminal numbers as per drawings	✓	✓
3	Check wire numbers to core numbers. Random selection.	✓	✓
4	All wires numbered as per drawings (random inspection)	✓	✓
5	Cables loomed and bushed correctly to all compartments.	✓	✓
6			
7			

Test Carried out by.....

*Grant Kerr*

Signed...

*[Signature]*

Date... 22/09/06

Test witnessed by.....

Signed...

Date...

Authorised By:

JH86QT01

29 August, 2006



COMMON LOGIC Pty Ltd  
Specialist Electrical Contractors

# Site Acceptance Tests

Subject: SAT for BW Generator Change Over Panels

Sheet: 5  
Of: 7

Section

Page Revision No: 0 Date: 29/08/06

Manual Issue No: 0 Date: 29/08/06

## 4.3 Terminal Visual Checklist

→ Carry out visual and mechanical checks on Site terminals

ITEM	DETAIL	COMPARTMENT AND TEST RESULT	
		Switchboard extension	Existing Board
1	All Terminals tight ( Randomly check )	✓	✓
2	Secure by End Clamps (Check All)	✓	✓
3	Labelled correctly	✓	✓
4			

## 4.4 Relay Visual Checklist

→ Carry out visual and mechanical checks on Relays

ITEM	DETAIL	COMPARTMENT AND TEST RESULT
1	Relays labelled correctly as per Dms	✓
2	All relay coils correct voltage	✓
3	Does relay require Diode fitted?	NA
4	Common Bus Link on relays fitted	✓
5	All numbering correct	✓

Test Carried out by..... *Grant Kerr*

Signed...

Date... *22/09/06*

Test witnessed by.....

Signed...

Date...

Authorised By:

JH86QT01

29 August, 2006

COMMON LOGIC Pty Ltd  
Specialist Electrical Contractors

# Site Acceptance Tests

Subject: SAT for BW Generator Change Over Panels

Sheet: 6  
Of: 7

Section

Page Revision No: 0 Date: 29/08/06

Manual Issue No: 0 Date: 29/08/06

## 5.0 CONTINUITY & PRE-COMMISSIONING TEST

### 5.1 Continuity Test

- ☒ Wiring of circuits and connections are correct to constructed wiring schematics.
- ☒ Random Continuity Test using Buzzer.
- ☒ Visual Check of all wiring.

- Open all Circuit breakers and remove all fuse links
- Bridge each interface and test each output.
- Install RTU terminal Plugs into terminals
- By bridging the relevant pins and observing the relevant RTU IO feedback all circuits will be checked.
- Test each circuit in turn with corresponding drawings

ITEM NO	Test description			
		Action	Observation	Result of test
1	Transfer to Mains	Bridge	Observe Relay GTSM	✓
2	Transfer to Gen		Observe Relay GTSG	✓
3	Generator Failed		Observe Relay GF	✓
4	Generator Fault		Observe Relay GFR	✓
5	Gen Running		Observe Relay GRUN	✓
			Check Door Indicator is on when relay is ON	✓
6	Generator Connected		Observe Relay GCONN	✓
7	Doors Opened		Observe Relay GOPEN	✓
8	CB Tripped		Observe Relay GCBT	✓
9	Not in Auto		Observe Relay GNAUTO	✓
10	Generator Not On Site		Observe Indicator	✓
11	Spare			
15	Remote Start		Observe Relay GSTART	✓
16	Remote Stop		Observe Relay GSTOP	✓
1	Mains Failed	Close QM1	Indicator ON when PFR is ON	✓
			Check Door Indicator is ON when PFR is ON	✓
2	ATS to Mains	Manual Change to Mains	Indicator ON when TXS in Mains	✓
3	ATS To Gen	Manual change to Gen	Indicator ON when TSX in GEN	✓
4	Remote Start		Indicator is on when PB is ON	NA
5	Remote Stop		Indicator is on When PB is ON	NA
6	Generator is missing		Indicator is on when PB is ON	✓

Test Carried out by..... *Grant Kerr*

Signed... *[Signature]* Date... *22/09/06*

Test witnessed by.....

Signed... Date...

Authorised By:

JH86QT01

29 August, 2006



COMMON LOGIC Pty Ltd  
Specialist Electrical Contractors

# Site Acceptance Tests

Subject: SAT for BW Generator Change Over Panels

Sheet: 7  
Of: 7

Section

Page Revision No: 0 Date: 29/08/06

Manual Issue No: 0 Date: 29/08/06

## 6.0 COMPONENT OPERATIONAL TEST

### 6.1 Component Operation Test

- ☒ Correct Operation and Voltages  
☒ All set points and parameters set to test values if required.

### 6.2 AC Control Systems

- Open all circuit breakers and remove all fuse links  
→ Test each circuit individually, replacing fuses and closing circuit breakers in turn.

#### AFTER VOLTAGE APPLIED

- Apply mains supply  
→ Carry out voltage and operational checks (ie switch operation etc)  
→ Bridge control points to check operation as per BW generator commissioning Sheet  
→ Apply generator voltage and check operation  
→ Return to normal and fail the mains  
→ Return the mains  
→ Carry out a manual transfer

ITEM NO:	DETAIL	New Extension
		Test Result
1	Mains Incoming Voltage Measured OK	OK
2	Unplug set and check alarm	OK
3	Open doors	OK
4	Trip CB	OK
5	Engine temperature/Alarm	NA
6	Turn set to Auto and Manual	OK
7	Low fuel alarm	OK
8	Fuel empty alarm	OK
9		
10	Manually initiate generator start	OK
11	Manually restore to mains	OK
12	Remote start	OK
13	Remote stop	OK
14	Mains fail Start	OK
15	Return to mains	OK
16	Mains fail and then fail generator	OK
17	Check return to to mains if gen fails	OK
18		
19		
20		

Test Carried out by..... *Graw Kerr* Signed... *[Signature]* Date... *22/09/06*

Test witnessed by..... Signed... Date...

Authorised By:

JH86QT01

29 August, 2006



# **BRISBANE WATER**

**Network Control Systems**

## **IDTS POINT COMMISSIONING SHEET AND GENERATOR SUPPLY OPERATIONAL CHECKS**

### **Pump Station Generator Connection**

**SITE TYPE & No: PIONEER CRESENT**

**Site Name. SP235**





**NOTE:** Some (or all) of the Generator associated IDTS points may be Scan Inhibited in the IDTS system. Remove the Scan Inhibit from these points before proceeding with these tests

**IDTS Point : Generator Offsite**

Action	Observation	Result
Connect the Control interface lead to the station	Confirm that GENERATOR OFFSITE alarm is returned to normal by IDTS	✓ Yes
Disconnect the Control interface lead to the station	Confirm that GENERATOR OFFSITE alarm is received by IDTS	✓ Yes
Reconnect the Control interface lead to the station		✓ Yes

**IDTS Point : Generator Unsecured**

Action	Observation	Result
Open a canopy door on the Generator	Confirm that GENERATOR UNSECURED alarm is received by IDTS	✓ Yes
Close the canopy door	Confirm that GENERATOR UNSECURED alarm return to normal is received by IDTS	✓ Yes

**IDTS Point : Generator Low\_fuel**

Action	Observation	Result
Make the Generator low fuel warning alarm active	Confirm that GENERATOR LOW_FUEL alarm is received by IDTS	✓ Yes
Deactivate the Generator low fuel warning alarm	Confirm that GENERATOR LOW_FUEL alarm return to normal is received by IDTS	✓ Yes

**IDTS Point : Generator Med\_fuel**

Action	Observation	Result
Make the Generator medium fuel warning alarm active	Confirm that GENERATOR MED_FUEL alarm is received by IDTS	✓ Yes
Deactivate the Generator medium fuel warning alarm	Confirm that GENERATOR MED_FUEL alarm return to normal is received by IDTS	✓ Yes

**IDTS Point : Generator Warning**

Action	Observation	Result
Make the Generator warning alarm active (except by low fuel)	Confirm that GENERATOR WARNING alarm is received by IDTS	✓ Yes
Deactivate the Generator warning alarm	Confirm that GENERATOR WARNING alarm return to normal is received by IDTS	✓ Yes

**IDTS Point : Generator Common\_fault**

Action	Observation	Result
Make the Generator common fault alarm active	Confirm that GENERATOR COMMON_FAULT alarm is received by IDTS	✓ Yes
Deactivate the Generator common fault alarm	Confirm that GENERATOR COMMON_FAULT alarm return to normal is received by IDTS	✓ Yes





## Brisbane Water – Network Control Systems Section

***IDTS Point : Generator Automatic***

Action	Observation	Result
Turn the generator to local mode	Confirm that GENERATOR AUTOMATIC alarm is RETURNED TO NORMAL by IDTS	✓ Yes
Return the generator to automatic mode	Confirm that GENERATOR AUTOMATIC alarm is received by IDTS	✓ Yes

***IDTS Point : Generator CB\_tripped***

Action	Observation	Result
Trip the Generator circuit breaker	Confirm that GENERATOR CB_TRIPPED alarm is received by IDTS	✓ Yes
Reset the Generator circuit breaker	Confirm that GENERATOR CB_TRIPPED alarm return to normal is received by IDTS	✓ Yes

***IDTS Point : Generator Running***

Action	Observation	Result
Start the Generator	Confirm that GENERATOR RUNNING alarm is received by IDTS	✓ Yes
Stop the Generator	Confirm that GENERATOR RUNNING alarm return to normal is received by IDTS	✓ Yes

***IDTS Control Points : Generator Exercise***

Action	Observation	Result
Confirm the Generator is available to run, but not running		
Set the IDTS control point GENERATOR START EXERCISE and send to the site	Confirm that the Generator starts and runs off-line	✓ Yes
	Confirm that GENERATOR RUNNING alarm is received by IDTS	✓ Yes
Set the IDTS control point GENERATOR STOP EXERCISE and send to the site	Confirm that the Generator stops	✓ Yes
	Confirm that GENERATOR RUNNING alarm return to normal is received by IDTS	✓ Yes

***IDTS Point : Power\_supply Energex power***

Action	Observation	Result
Turn the generator to local mode		
Fail the Energex power	Confirm that POWER_SUPPLY ENERGEX POWER alarm is received by IDTS	✓ Yes
Restore the Energex power	Confirm that POWER_SUPPLY ENERGEX POWER alarm return to normal is received by IDTS	✓ Yes





## Brisbane Water – Network Control Systems Section

**IDTS Point : ATS Energex , and Generator supply operational checks**

*NOTE: The purpose of these operational checks is;*

- To confirm the pumps are interlocked under Generator supply (where required)
- To confirm the code changes have not interfered with the operation of the Surcharge Imminent probe.

Action	Observation	Result
Ensure the Generator is in Automatic mode		
Ensure the pumps are selected for local mode		
Ensure there is enough sewage in the well for the pumps to run continuously for one minute		
Fail the Energex power to the Generator	Confirm that the Generator starts and supplies power to the station	✓ Yes
	Confirm that ATS ENERGEX alarm is received by IDTS.	✓ Yes
Generator Capacity	Confirm the Generator will run both pumps under generator supply.	✓ Yes
Site: BirkinRd.	Confirm the RTU will run a maximum of two pumps under generator supply.	NA
Restore Energex power and record the time taken for the Generator controller to return the station power to Energex supply	Time for station power to return to Energex supply	...300..... Secs
	Confirm that ATS CLOSED alarm return to normal is received by IDTS	✓ Yes
Record time taken for the Generator to stop after station power to returns to Energex supply	Time for Generator to stop after station power to returns to Energex supply	.....300..... Secs





## Brisbane Water – Network Control Systems Section

***Pump Automatic operation, and  
Surcharge Imminent operation under Generator supply***

Action	Observation	Result
Fail the Energex power to the Generator	Confirm that the Generator starts and supplies power to the station	✓ Yes
Ensure the pumps are selected for remote mode	<u>Fixed speed pump sites:</u> Confirm that the duty pump lowers the well to the Duty A stop level and stops	NA
	<u>Variable speed pump sites:</u> Confirm that the duty pump operates on variable speed control satisfactorily	✓ Yes
Ensure the well level is below the Duty A start level using pump local control as required		✓ OK
Ensure the pumps are selected for remote mode and are stopped		✓ OK
Activate the surcharge imminent probe for at least 10 sec	Confirm that WET_WELL SURCHARGE_IMMINENT alarm is received by IDTS	✓ Yes
	Confirm that all pumps (available under Generator supply) start	✓ Yes
Return the surcharge imminent probe to normal	Confirm that WET_WELL SURCHARGE_IMMINENT alarm return to normal is received by IDTS	✓ Yes
Restore Energex power indication to the Generator and allow the Generator controller to return the station power to Energex supply		✓ OK

## IDTS Points and Generator Supply

Operational Checks commissioned by .....Dan Vowles..... Date ...21/09/06.....





**COMMON LOGIC Pty Ltd**  
**Specialist Electrical Contractors**

## Electrical Manual

Subject: Pioneer Cres SP235

Sheet: 9  
Of: 9

Section  
6

Page Revision No:

Date: 17/11/06


Manual Issue No: 1 Date: 17/11/06

### **6.0 TECHNICAL INFORMATION**

Authorised By: Grant Kerr



## Catalogue No. WIPM27

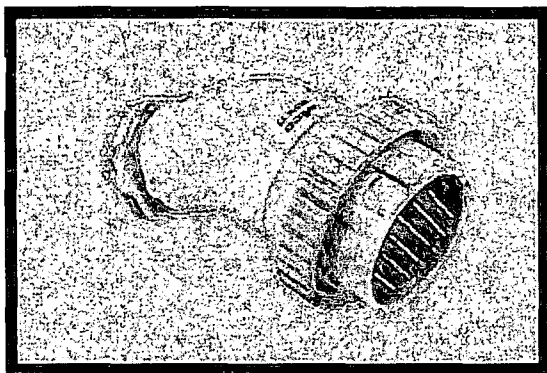

### Colour Options

☐ No colour options

☐ TR Transparent

More colour options may be available. Please check with your nearest Clipsal office.

### Description:

Low Voltage Multipin - 27 Pin Maximum. Wilco Industrial Hi-Impact Insulated Angle Plug. Wilco Industrial Hi-Impact Insulated Plugs One Piece Angle With Screw Ring - IP56

### Item Type

02 Industrial Products

### Business Area

40 Industrial Switchgear

### Product Group

403 Wilco Hi-Impact Industrial Switchgear

### Item Group

40303 Plugs & Extension Sockets

### Brochures Available:

*A Specifiers guide to Clipsal Industrial*

*A Specifiers guide to Clipsal Industrial*

*A Specifiers guide to Clipsal Industrial*

**tyco**

Electronics

Energy Division

**INSTALLATION INSTRUCTIONS****Page 1 of 2**

Ref: IW250PMSH – Rev 6 – Sept 02

**Models Covered**

252-RMM	252-PMT	252-PSF	252-PSG
253-PH3	252-PMM	252-PMT	

**Introduction****Thermistor Trip Relay (252-PMM & 252-PMT)**

The trip inputs are monitored within settable limits. In the event of the input moving outside these limits, the unit will initiate a trip signal via a double pole changeover relay. An illuminated green LED indicates when the thermistor temperature is within normal working limits. The unit is designed such that the alarm relay is energised when normal temperatures are reached.

Model 252-PMM has the facility for manual resetting, so that the trip condition remains after normal operating temperature is reached, until manual intervention occurs.

**Phase Balance Relay (252-PSF & 252-PSG)**

Trip inputs are monitored within settable limits. In the event of the input moving outside these limits, the unit will initiate a trip signal via a double pole changeover relay. An illuminated red LED indicates that the supply is within limits.

**Speed Sensing Relay (253-PH3)**

Trip inputs are monitored within settable limits. In the event of the input moving outside these limits, the unit will initiate a trip signal. The illuminated red LED's indicates that the single pole output relays are in an energised state and at normal running speed all three relays should be energised. Units are factory adjusted for normal running speed = 0.75mA output. The meter adjust pot on the product front is used for this requirement, which also ensures the trip levels are set to the calibrated values. Terminal 8 is connected to terminal 5 internally. Terminals 15 and 16 give a 0/1mA signal proportional to speed.

No.1 Relay energises on rising speed

No.2 Relay energises on rising speed

No.3 Relay de-energises on rising speed

This product is designed for use only with magnetic coil inductive sensors.

**Warning**

- During normal operation, voltages hazardous to life may be present at some of the terminals of this unit. Installation and servicing should be performed only by qualified, properly trained personnel abiding by local regulations. Ensure all supplies are de-energised before attempting connection or other procedures.
- It is recommended adjustments be made with the supplies de-energised, but if this is not possible, then extreme caution should be exercised.
- Terminals should not be user accessible after installation and external installation provisions must be sufficient to prevent hazards under fault conditions.
- This unit is not intended to function as part of a system providing the sole means of fault protection - good engineering practice dictates that any critical function be protected by at least two independent and diverse means.

Never open circuit the secondary winding of an energised current transformer.

**Protector Trip Relays****DIN Rail & Wall Mounted 250 Series****Thermistor Trip, Speed Sensing &****Phase Angle Installation**

The Protector should be installed in a dry position, not in direct sunlight and where the ambient temperature is reasonably stable and will not be outside the range 0 to 60 degrees Celsius. Mounting will normally be on a vertical surface but other positions will not affect the operation. Vibration should be kept to a minimum. The Protectors are designed for mounting on a 35mm rail to DIN 46277. Alternatively they may be screw fixed; a special adaptor is supplied to mount 252 types.

To mount a protector on a DIN rail, the top edge of the cutout on the back is hooked over one edge of the rail and the bottom edge carrying the release clip clicked into place. Check that the unit is firmly fixed. Removal or repositioning may be achieved by levering down the release clip and lifting the unit up and off the rail.

Connection diagrams should be carefully followed to ensure correct polarity and phase rotation where applicable.

External voltage transformers may be used on 252-PSF and 252-PSG to extend the range.

**252-PMM, 252-PMT & 253-PH3**

Pick up, input and output leads should be kept separate from any other wiring.

**Setting Controls (252-PSF, 252-PSG)**

These products have two calibration facilities that can be set to suit operating requirements and they are factory calibrated as follows:-

- % unbalance set points  
Voltages of and below 380 volts L-L are calibrated to 1.0% class index of rated voltage. Voltages above 380 volts L-L are calibrated to 1.5% class index of rated voltage.
- Time Delay  
For all voltage ranges 10% maximum delay.
- Voltage Withstand  
Continuous overload = 1.35 x rated voltage

**Setting Up (all other models)**

The calibration marks around the controls are provided as a guide if the installer does not have access to accurate equipment. The maximum error of the calibration marks is typically 10% of the span of the control concerned.

**Maintenance**

The unit should be inspected to normal standards for this class of equipment. For example remove accumulations of dust and check all connections for tightness and corrosion. In the unlikely event of a repair being necessary it is recommended that the unit be returned to the factory or to the nearest Crompton Instruments Service Centre.

**Electromagnetic Compatibility**

This unit has been designed to provide protection against EM (electro-magnetic) interference in line with requirements of EU and other regulations. Precautions necessary to provide proper operation of this and adjacent equipment will be installation dependent and so the following can only be general guidance:-

- Avoid routing wiring to this unit alongside cables and products that are, or could be, a source of interference.







## INSTALLATION INSTRUCTIONS

### Protector Trip Relays DIN Rail & Wall Mounted 250 Series Thermistor Trip, Speed Sensing & Phase Angle




- The auxiliary supply to the unit should not be subject to excessive interference. In some cases, a supply line filter may be required.
- To protect the product against incorrect operation or permanent damage, surge transients must be controlled. It is good EMC practice to suppress differential surges to 2kV or less at the source. The unit has been designed to automatically recover from typical transients, however in extreme circumstances it may be necessary to temporarily disconnect the auxiliary supply for a period of greater than 5 seconds to restore correct operation.

- Screened communication and small signal leads are recommended and may be required. These and other connecting leads may require the fitting of RF suppression components, such as ferrite absorbers, line filters etc., if RF fields cause problems.




It is good practice to install sensitive electronic instruments that are performing critical functions in EMC enclosures that protect against electrical interference causing a disturbance in function.

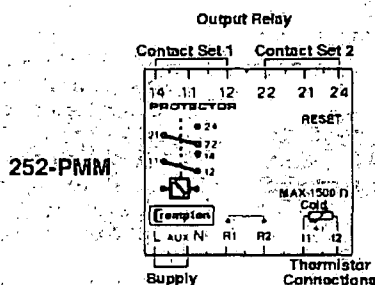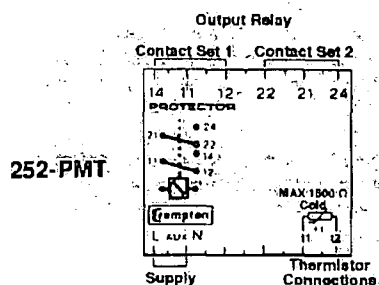




252-PMM can operate in either an automatic or a manual reset mode. For automatic the reset link R1-R2 is to be disconnected. For manual the reset link R1-R2 must be inserted.

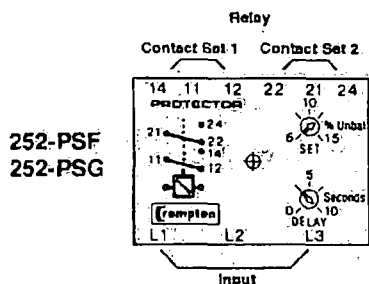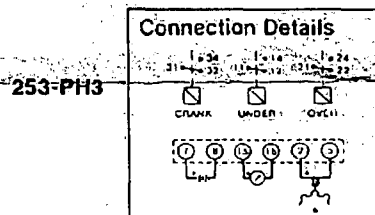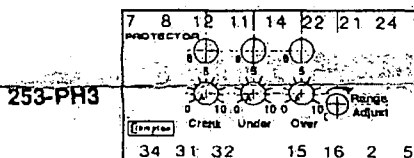

#### Model 252

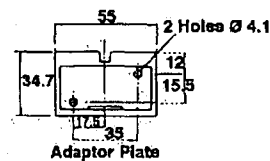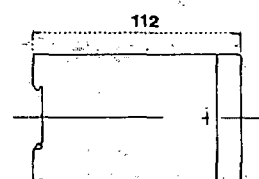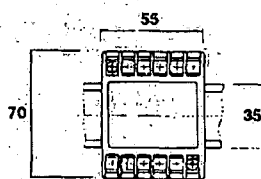

#### Model 253

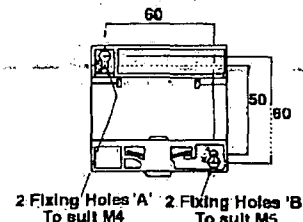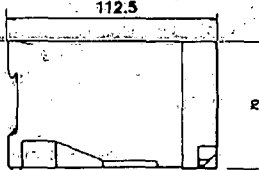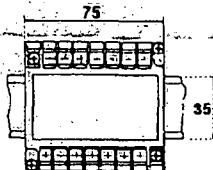

The information contained in these installation instructions is for use only by installers trained to make electrical power installations and is intended to describe the correct method of installation for this product. However, Tyco Electronics has no control over the field conditions, which influence product installation. It is the user's responsibility to determine the suitability of the installation method in the user's field conditions. Tyco Electronics' only obligations are those in Tyco Electronics' standard Conditions of Sale for this product and in no case will Tyco Electronics be liable for any other incidental, indirect or consequential damages arising from the use or misuse of the products. Crompton is a trade mark.




#### Tyco Electronics UK Limited

##### Crompton Instruments

Freebournes Road, Witham, Essex, CM8 3AH, UK

Phone: +44 1376 509 509 Fax: +44 1376 509 511

<http://energy.tycoelectronics.com>

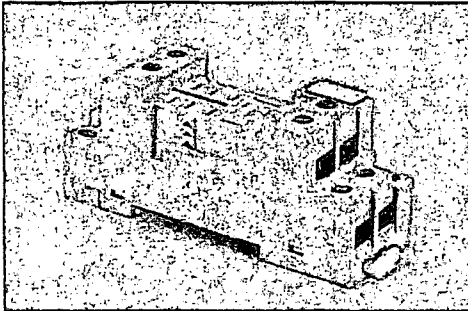

Representative Image Only

Catalogue Number: 96.72

Description: SKT FOR 56.32 RLY + LED MOD

List Price: Refer to our eCatalogue

Unit Of Measure: EA

Price Schedule: B2

All prices are exclusive of GST

#### Relays / Accessories

**Brand:** Finder

**Accessory type:** Plug-in base


#### Features

- DIN rail mounting socket with open terminals, to suit miniature power relays, flat pin 2 C/O (8 pin), eg 56.32.
- This socket also accepts the 99 series LED modules.

#### Benefits

- The 96.72 series sockets are designed for DIN rail mounting, with the added benefit of incorporating an LED indicator in the same socket as the relay.
- Provides a space saving relay / indicator combination.
- Relay retaining clips also available.



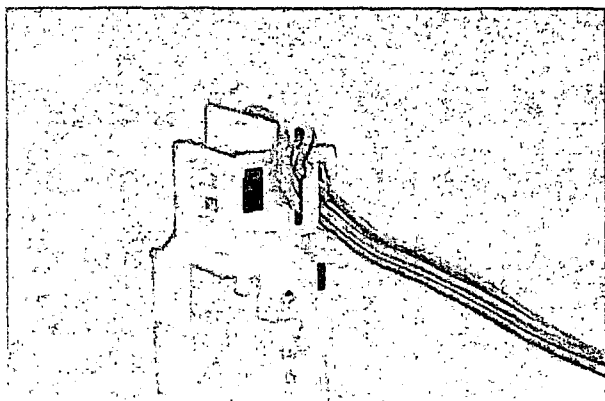

Catalogue Number:

**2H1952BAA**

Description:

**SW AUX 2C RH X2**

List Price \$ (Not including GST):

**0**

Unit of Measure:

**EA**

Price Schedule:

**T2**

## Circuit breakers-Moulded Case (MCCB)

### Accessories-Alarm and auxiliary switches

#### Frame size

250A

#### Position

Right hand

#### Features


- Auxiliary switch 2 circuit (2C) RH to suit Tembreak X250 series circuit breakers.
- Factory fitted - internally mounted (right hand side) signalling device.

#### Benefits

- Auxiliary switch electrically indicates on / off status of the breaker.
- The auxiliary switch is mounted within the breaker and as such does not take up any extra pole space.

#### Ordering Information

- This is a factory fitted accessory.

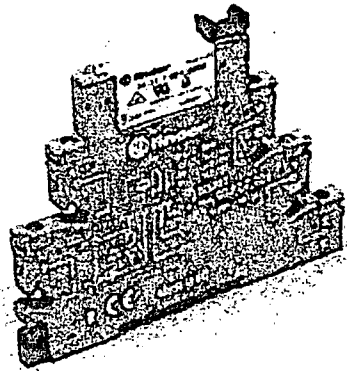

Catalogue Number:

**38.51 24VDC**

Description:

**PLEASE ORDER 385124VACDC**

List Price \$ (Not including GST):

**46.55**

Unit of Measure:

**EA**

Price Schedule:

**B2**

## Relays Interface Module

### Relays Interface Module

**Contact arrangement**

1 C/O 6A AC1 250VAC

**Voltage**

24V DC

**Number of pins**

3


**Features**

- Miniature Din rail mounting type Relay interface module
- Supply voltage: 24V DC
- 1 C/O contact, 6A, 250V AC 1

**Benefits**

- Compact Din mount presentation
- Low coil consumption



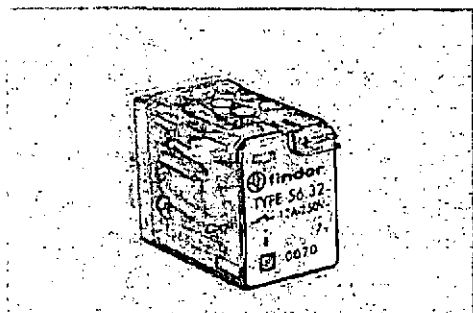

Representative Image Only

**Catalogue Number:** 56.32.0074 24VDC

**Description:** RLY W/PB+LED+FLG FPIN 2CO 12A

**List Price:** Refer to our eCatalogue

**Unit Of Measure:** EA

**Price Schedule:** B2

All prices are exclusive of GST

#### Relays-plug-in type / Flat pin

**Brand:** Finder

**Contact arrangement:** 2 C/O

**Voltage:** 24V.DC

**Number of pins:** 8

#### Features


- 24VDC, 12A.
- 2 C/O contacts.
- Flat pins.

#### Benefits

- Lockable test button.
- Mechanical flag indicator and LED.

document created: 17 Nov 2006

Page 1 of 1

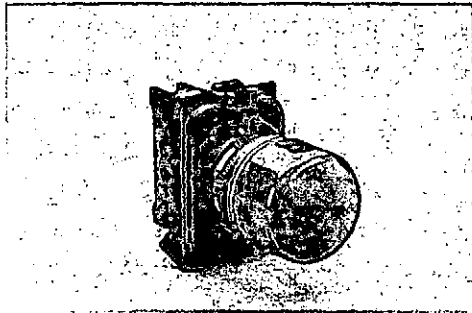**sprecher +  
schuh**

Representative Image Only

Catalogue Number: D5P-P43NL3R

Description: KIT D5 INT LED RED IND 24VAC

List Price:  Refer to our eCatalogue

Unit Of Measure: EA

Price Schedule: A2

All prices are exclusive of GST

**Pushbutton Products / Pilot Light and Buzzer****Brand:** Sprecher + Schuh**Mounting Size:** 22.5mm**Specification:** Complete**Shape:** Round**Style / Frame:** Standard**Colour:** Red**Lamp Block:** Full Voltage**Features**


- Part of the vast D5 range of matching 22.5 mm. control and signalling units providing IP 66 front protection.
- Assembled round plastic pilot light fitted with coupling plate and clip-on LED.
- Easy to mount.
- Wide range of legends available to complete the assembly.
- Individually packaged component.

**Benefits**

- The D5 range combines aesthetic appeal with robust flexibility to suit heavy-duty industrial control applications.
- Readily visible.
- Pre-assembly saves time.
- When fixing pilot light it will hold in place without a notched panel hole.
- Saves time and allows fitting by one person only.
- Simplified ordering and spares holding.

©2006 NHP E.C.O.E

[www.nhp.com.au](http://www.nhp.com.au)**NHP**

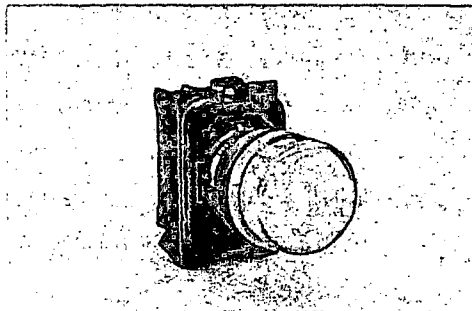Representative Image Only

Catalogue Number: D5P-P53NL3A

Description: KIT D5 INT LED YLW IND 24VAC

List Price:  Refer to our eCatalogue

Unit Of Measure: EA

Price Schedule: A2

All prices are exclusive of GST

### Pushbutton Products / Pilot Light and Buzzer

**Brand:** Sprecher + Schuh**Mounting Size:** 22.5mm**Specification:** Complete**Shape:** Round**Style / Frame:** Standard**Colour:** Yellow**Lamp Block:** Full Voltage


### Features

- Part of the vast D5 range of matching 22.5 mm. control and signalling units providing IP 66 front protection.
- Assembled round plastic pilot light fitted with coupling plate and clip-on LED.
- Easy to mount.
- Wide range of legends available to complete the assembly.
- Individually packaged component.

### Benefits

- The D5 range combines aesthetic appeal with robust flexibility to suit heavy-duty industrial control applications.
- Readily visible.
- Pre-assembly saves time.
- When fixing pilot light it will hold in place without a notched panel hole.
- Saves time and allows fitting by one person only.
- Simplified ordering and spares holding.



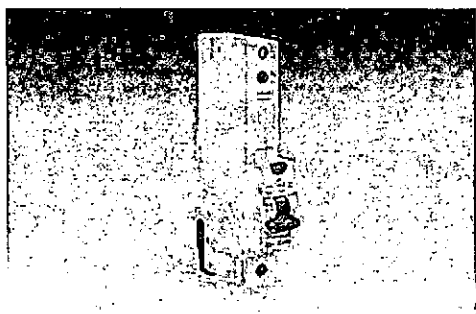

Representative Image Only

Catalogue Number: DSRCBH1030A

Description: MCB/RCD 1P 10A 30mA 10KA DIN-T

List Price: Refer to our eCatalogue

Unit Of Measure: EA

Price Schedule: T3

All prices are exclusive of GST

### Circuit breakers - Earth Leakage / ELCB Din


**Brand:** Terasaki  
**Current rating:** 10A  
**Number of poles:** 1P + N  
**Modules:** 1 (18)  
**Trip sensitivity:** 30mA  
**Voltage:** 240V AC

### Features

- Short circuit protection 10kA.
- 50kA and 65kA fuse back up.
- Sensitivities 10mA and 30mA.
- 6A, 10A, 16A, 20A, 25A, 32A & 40A Current ratings.
- Type A RCD.
- On and Off indication with colour coding.
- Handle can be sealed and locked in "on" or "off" position.
- IP20 finger protection.
- Wide range of accessories.
- Information clearly labeled on front of RCD.
- Flexible 1.2m long neutral pigtail.

### Benefits

- Space saving, same width Din-T MCB.
- Can be directly retrofitted replacing a Din-T MCB.
- High level of short circuit protection.
- Wide range of current settings.
- Approved for use in Australia and New Zealand.
- Conforms to international standards.
- Terminals clearly labeled for easy connection.

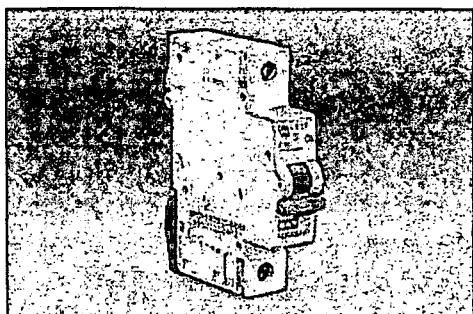

Representative Image Only

Catalogue Number: DTCB6106C

Description: MCB 6KA 1P 6A C CURVE DIN

List Price: Refer to our eCatalogue

Unit Of Measure: EA

Price Schedule: T1

All prices are exclusive of GST

**Circuit breakers-miniature / MCB DIN 6 kA**


**Brand:** Terasaki  
**Current rating:** 6A  
**Number of poles:** 1 Pole  
**Curve type:** C Curve

**Features**

- 6kA, 10kA & 15kA short circuit breaking capacities available.
- 50kA and 65kA fuse backup.
- On and Off indication with colour coding.
- Handle can be sealed and locked in "on" or "off" position.
- High speed operation and rapid arc quenching.
- Consistant line and load terminal height for Din-T 6, 10 & 15 MCB's.
- IP20 finger protection.
- 35mm<sup>2</sup> capacity terminals.
- Wide range of accessories.
- Conformity to Australian and International standards.
- Versatility in mounting, distribution boards, switchgear panels and consumer units.
- High selectivity figures.
- Information clearly labeled on front of breaker.

**Benefits**

- Eliminates confusion regarding the operating state of the MCB.
- Increased protection as contacts open through overload or short circuit even when handle is sealed in the "on" position.
- Saves cost, allows for a fuseless system and confines power outages to the effected circuit preventing wide spread loss of power.
- Can fit larger cables.
- Provides greater flexiblity of use.
- Security on conformity.
- Special data very accessible.

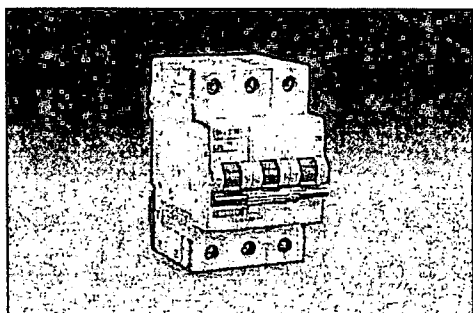

Representative Image Only

Catalogue Number: DTCB6306C

Description: MCB 6KA 3P 6A C CURVE DIN

List Price: Refer to our eCatalogue

Unit Of Measure: EA

Price Schedule: T1

All prices are exclusive of GST

### Circuit breakers-miniature / MCB DIN 6 kA

**Brand:** Terasaki

**Current rating:** 6A

**Number of poles:** 3 Pole

**Curve type:** C Curve


### Features

- 6kA, 10kA & 15kA short circuit breaking capacities available
- 50kA and 65kA fuse backup
- On and Off indication with colour coding
- Handle can be sealed and locked in "on" or "off" position
- High speed operation and rapid arc quenching
- Consistent line and load terminal height for Din-T 6, 10 & 15 MCB's
- IP20 finger protection
- 35mm<sup>2</sup> capacity terminals
- Wide range of accessories
- Conformity to Australian and International standards
- Versatility in mounting, distribution boards, switchgear panels and consumer units
- High selectivity figures
- Information clearly labeled on front of breaker

### Benefits

- Eliminates confusion regarding the operating state of the MCB
- Increased protection as contacts open through overload or short circuit even when handle is sealed in the "on" position
- Saves cost, allows for a fuseless system and confines power outages to the effected circuit preventing wide spread loss of power
- Can fit larger cables
- Provides greater flexibility of use
- Security on conformity
- Special data very accessible



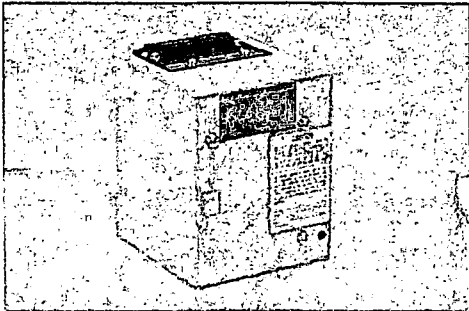

Representative Image Only

Catalogue Number: UXMB0058B

Description: MOTOR XMB 240VA X2

List Price: Refer to our eCatalogue

Unit Of Measure: EA

Price Schedule: T2

All prices are exclusive of GST

#### Circuit breakers-Moulded Case (MCCB) / Accessories-Remote operators

**Brand:** Terasaki  
**Voltage:** 240V AC  
**Frame size:** 250A

#### Features

- Motor operator 240V AC to suit Tembreak X250 series circuit breakers.
- The UXMB motor operator is a factory fitted item.

#### Benefits

- Motor operator, for remote switching / operation of circuit breaker / circuit breaker functions.




## Universal Ground Terminal Block USLKG

Article description	USLKG 5
Order No.	0441504 USLKG 5 0441517 USLKG 5-1
EC Prototype certificate no.	KEMA 99ATEX4487U

Assembly on mounting rails NS 32 acc. to EN 60715-G 32  
NS 35 acc. to EN 60715-TH 35  
Assembly instructions See page 2

Temperature range of use -40 °C to +90 °C

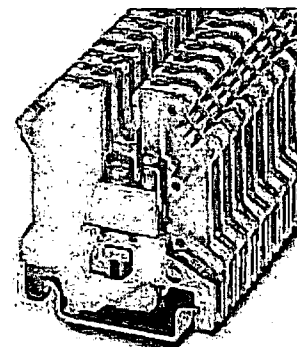

## Technical data according to EN 50019 (Increased Safety "e")

### Connection capacity

Rated cross section	4 mm <sup>2</sup>	AWG 12
Max. conductor cross section	4 mm <sup>2</sup>	AWG 12
Connectable conductor cross sections	0.2 - 4 mm <sup>2</sup> rigid and flexible	AWG 24 - 12

### Explosion protection data


Max. operating voltage	550 V on NS 32 750 V on NS 35	Mounted in rows with UK 5 N
------------------------	----------------------------------	-----------------------------

### Data of insulation material

Description	PA 6.6	
Creep resistance acc. to IEC 60112 / material group	CTI 600 / I	

**Important assembly instructions – increased safety "e"**

When adding other series and sizes of terminal blocks and using additional accessories, the required air and creepage distances have to be observed.

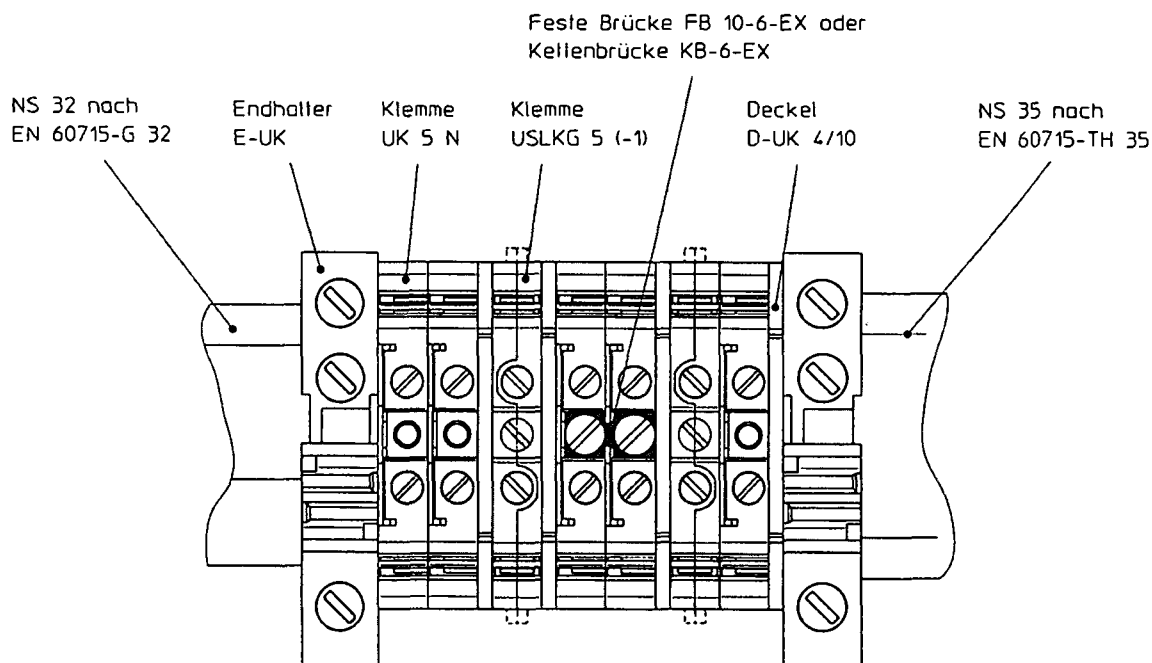

Phoenix Contact GmbH & Co. KG  
 Flachsmarktstrasse 8  
 D-32825 Blomberg, Germany  
 Germany

+49 – (0) 52 35 – 3-00  
 +49 – (0) 52 35 – 3-4 12 00  
[www.phoenixcontact.com](http://www.phoenixcontact.com)

15.07.02  
 Rev. 00  
 Technical modifications reserved

**PHOENIX  
CONTACT**

Page 2 of 2




UK 5-HESI



Please note that the data given here has been taken from the online catalog. For comprehensive information and data, please refer to the user documentation at <http://www.download.phoenixcontact.com>. The General Terms and Conditions of Use apply to Internet downloads.

### ► Extract from the online catalog

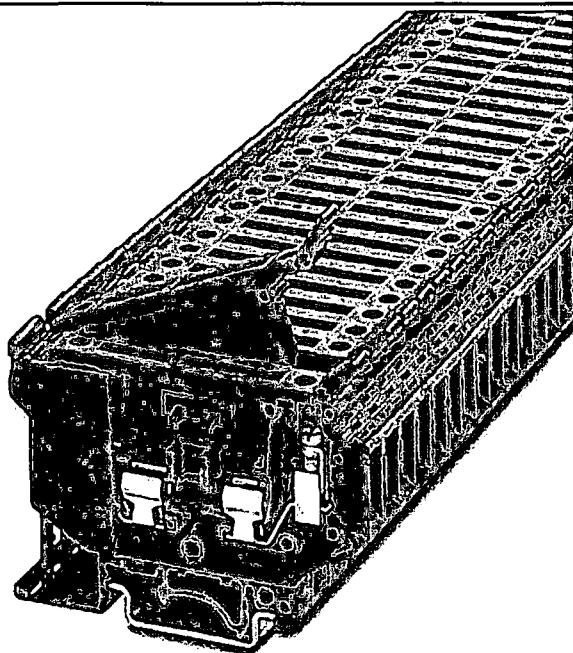

Fuse terminal block for cartridge fuse insert, cross section: 0.2 - 4 mm<sup>2</sup>, AWG: 26 - 10, width: 8.2 mm, color: black

Order No.	3004100
Ord designation	UK 5-HESI
EAN	4017918090623
Pack	50 Pcs.
Customs tariff	85363010
Weight/Piece	0,018509 KG
Catalog page information	Page 266 (CL-2005)

### ► Product notes

WEEE/RoHS-compliant since: 01/01/2003




**IMPORTANT :** This date is valid for Customers in Germany only. Date Format is MM/DD/YYYY. Please contact your local in-country Phoenix Contact location or designated business partner for a Logistics Compliant date in your area. In order to guarantee delivery of RoHS-Compliant product, please purchase Phoenix Contact parts from authorized Phoenix Contact representatives and distributors.



## Feed-Through Modular Terminal Block

Article description	UK 5 N
Order No.	3004362
EC Prototype certificate no.	KEMA 98ATEX1651U
Identification	0344 Ⓢ II 2 GD EEx e II KEMA 98ATEX1651U
Assembly on mounting rails	NS 32 acc. to EN 60715-G 32 NS 35 acc. to EN 60715-TH 35
Assembly instructions	See page 2
Temperature range of use	-40 °C to +80 °C

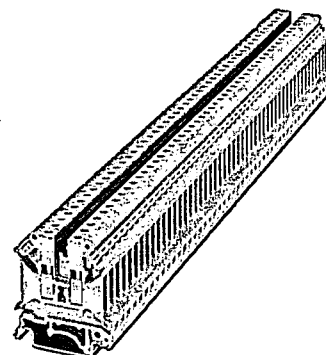

### Technical data according to EN 50019 / EN 50020

Max. operating voltage	Increased safety "e" Intrinsic safety "i"	750 V 60 V	550 V on NS 32
Nominal current	30 A		
Max. load current	38 A		
<b>Connection capacity</b>			
Rated cross section	4 mm <sup>2</sup>		AWG 12
Max. conductor cross section	6 mm <sup>2</sup>		AWG 10
Connectable conductor cross sections	0.2 – 6 mm <sup>2</sup> V		AWG 24 – 10

### Multi-conductor connection (two conductors with same cross section)

Rigid / flexible	0.2 – 1.5 mm <sup>2</sup> V	AWG 24 – 16
------------------	-----------------------------	-------------

### Data of insulation material

Description	PA 6.6	
Creep resistance acc. to IEC 60112 / material group	CTI 600 / I	


Accessories	Description	Order No.	
Cover	D-UK 4/10	3003020	
Cover	D-UK 16	3006027	
Partition plate	ATP-UK	3003224	
Fixed bridge	FBI 10-6-EX	0203519	Max. 37 A acc. to EN 50019
Chain bridge	KBI-6-EX	0711849	Max. 37 A acc. to EN 50019
Bridge rail	FB 150	0201595	Max. 27 A acc. to EN 50019

### Important assembly instructions – increased safety "e"

When adding other series and sizes of terminal blocks and using additional accessories, the required air and creepage distances have to be observed.

If fixed bridges and chain bridges are used, a cover is necessary between bridges which make direct contact, as well as at the beginning and end of each bridge, in order to maintain the insulation distances.


If the fixed bridges are used for creating bridging between non-adjacent terminals, the max. working voltage is reduced to 175 V.

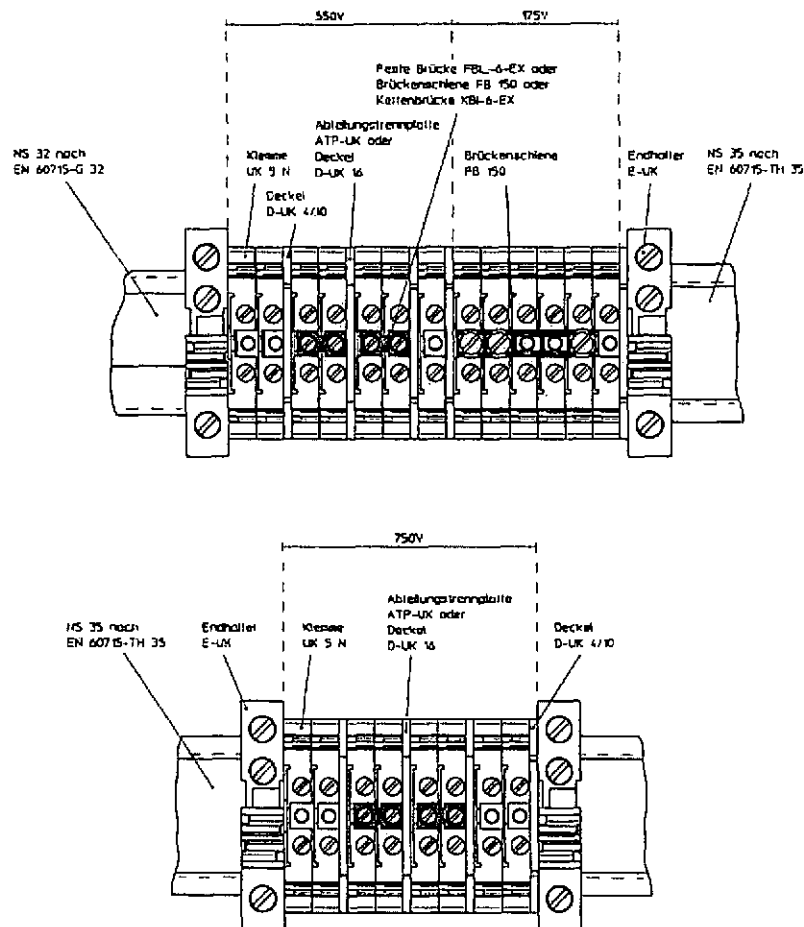

Phoenix Contact GmbH & Co. KG  
 Flachmarktstrasse 8  
 D-32825 Blomberg, Germany  
 Germany

+49 – (0) 52 35 – 3-00  
 +49 – (0) 52 35 – 3-4 12 00  
[www.phoenixcontact.com](http://www.phoenixcontact.com)

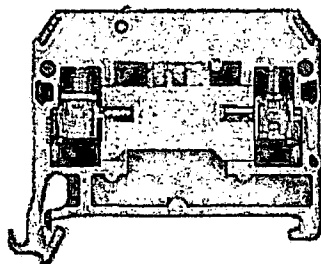

**General ordering data**

<b>Order No.</b>	0172160000
<b>Short text for material</b>	SAKR/35
<b>EAN</b>	4008190030445
<b>Qty</b>	100

**Product notes**

<b>Note, ordering data</b>	SAKR/35 2 StB order No. 0183360000
<b>Note, technical data</b>	Tightening torque for the test sockets 0.5 -0.7 Nm

**Additional technical data**

<b>Type of connection</b>	screwed
<b>No. of identical terminals</b>	1
<b>Version</b>	Disconnect terminal
<b>Type of mouting</b>	clipped
<b>UL 94 flammability rating of insulation material</b>	V2
<b>Installation advice</b>	TS 35
<b>Colour of insulating material</b>	beige
<b>Insulating material</b>	PA 66
<b>Open sides</b>	right
<b>Operating temperature range</b>	- 50 °C, + 100 °C
<b>Connection direction</b>	on side
<b>Product range</b>	SAK Series
<b>No. of levels</b>	1
<b>Levels cross-connected internally</b>	No
<b>No. of terminal strips per level</b>	2
<b>End plate required</b>	Yes

**CSA rating data**

<b>Max. cross-section (CSA)</b>	AWG 12
<b>Min. cross-section (CSA)</b>	AWG 22
<b>Voltage CSA</b>	300 V
<b>CSA current</b>	10 A

**Conductors for clamping (rated connection)**

<b>Stripping length</b>	8 mm
<b>Type of connection</b>	Screw connection

<b>No. of connections</b>	2
<b>Torque level with DMS electric screwdriver</b>	2
<b>Tightening torque range</b>	0.5...1.0 Nm
<b>Solid, max.</b>	4 mm <sup>2</sup>
<b>Flexible, max.</b>	4 mm <sup>2</sup>
<b>flexible w. ferrule AEH, max. DIN 46228-1</b>	2.5 mm <sup>2</sup>
<b>flexible w. ferrule AEH, min. DIN 46228-1</b>	0.5 mm <sup>2</sup>
<b>Clamping range, max.</b>	4 mm <sup>2</sup>
<b>Clamping range, min.</b>	0.13 mm <sup>2</sup>
<b>Clamping screw</b>	M 3
<b>Blade size</b>	0.6 x 3.5 mm
<b>Gauge to IEC 60947-1</b>	A3
<b>AWG conductor size, max.</b>	3.31 mm <sup>2</sup>
<b>AWG conductor size, max.</b>	AWG 12
<b>Stranded, max.</b>	4 mm <sup>2</sup>
<b>Stranded, min.</b>	1.5 mm <sup>2</sup>
<b>AWG conductor size, min.</b>	0.13 mm <sup>2</sup>
<b>AWG conductor size, min.</b>	AWG 26
<b>Connection direction</b>	on side
<b>Flexible, min.</b>	0.5 mm <sup>2</sup>
<b>2nd type of connection</b>	screwed
<b>Solid, min.</b>	0.5 mm <sup>2</sup>
<b>Twin wire-end ferrule, min.</b>	0.50 mm <sup>2</sup>
<b>Zwilling-AEH, max.</b>	1.50 mm <sup>2</sup>

**Dimensions**

<b>Width</b>	6.5 mm
<b>Height of lowest version</b>	40.5 mm
<b>Length</b>	42 mm
<b>TS 32 offset</b>	4 mm

**Disconnect terminals**


<b>Torque level with DMS electric screwdriver</b>	2
<b>Slitting</b>	pivoting
<b>Integral test socket</b>	No

**EN 60079-7 rating data**

<b>Current Ex e</b>	10 A
---------------------	------

**Rating data**

<b>Rated cross-section</b>	4 mm <sup>2</sup>
<b>Rated voltage</b>	400 V
<b>Rated impulse withstand voltage</b>	6 kV
<b>Rated current</b>	10 A

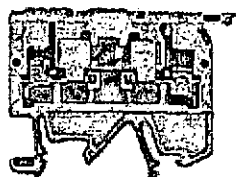**General ordering data**

<b>Order No.</b>	0474560000
<b>Short text for material</b>	ASK 1/EN
<b>EAN</b>	4008190020880
<b>Qty</b>	100

**Product notes**

<b>Note, technical data</b>	The rated cross-section is reduced to max. 2.5 mm <sup>2</sup> when using cross-connection bridges.
-----------------------------	-----------------------------------------------------------------------------------------------------

**Additional technical data**

<b>Type of connection</b>	screwed
<b>No. of identical terminals</b>	1
<b>Version</b>	Fuse terminal
<b>Type of mounting</b>	clipped
<b>UL 94 flammability rating of insulation material</b>	V2
<b>Installation advice</b>	TS 35 + TS 32
<b>Colour of insulating material</b>	beige
<b>Insulating material</b>	PA 66
<b>Open sides</b>	right
<b>Operating temperature range</b>	- 50 °C, + 100 °C
<b>Connection direction</b>	on side
<b>Product range</b>	SAK Series
<b>No. of levels</b>	1
<b>Levels cross-connected internally</b>	No
<b>No. of terminal strips per level</b>	2
<b>End plate required</b>	Yes

**CSA rating data**

<b>Max. cross-section (CSA)</b>	AWG 12
<b>Min. cross-section (CSA)</b>	AWG 26
<b>Voltage CSA</b>	300 V
<b>CSA current</b>	6.3 A

**Conductors for clamping (rated connection)**

<b>Stripping length</b>	9 mm
<b>Type of connection</b>	Screw connection
<b>No. of connections</b>	2
<b>Torque level with DMS electric screwdriver</b>	2



<b>Tightening torque range</b>	0.6...0.8 Nm
<b>Solid, max.</b>	4 mm <sup>2</sup>
<b>Flexible, max.</b>	4 mm <sup>2</sup>
<b>flexible w. ferrule AEH, max. DIN 46228-1</b>	4 mm <sup>2</sup>
<b>Flexible, max., ferrule with plastic collar (DIN 46228 pt 4)</b>	2.5 mm <sup>2</sup>
<b>flexible w. ferrule AEH, min. DIN 46228-1</b>	0.5 mm <sup>2</sup>
<b>Flexible, min., ferrule with plastic collar (DIN 46228 pt 4)</b>	0.5 mm <sup>2</sup>
<b>Clamping range, max.</b>	4 mm <sup>2</sup>
<b>Clamping range, min.</b>	0.13 mm <sup>2</sup>
<b>Clamping screw</b>	M 3
<b>Blade size</b>	0.6 x 3.5 mm
<b>Gauge to IEC 60947-1</b>	A3
<b>AWG conductor size, max.</b>	3.31 mm <sup>2</sup>
<b>AWG conductor size, max.</b>	AWG 12
<b>Stranded, max.</b>	4 mm <sup>2</sup>
<b>Stranded, min.</b>	0.5 mm <sup>2</sup>
<b>AWG conductor size, min.</b>	0.13 mm <sup>2</sup>
<b>AWG conductor size, min.</b>	AWG 26
<b>Connection direction</b>	on side
<b>Flexible, min.</b>	0.5 mm <sup>2</sup>
<b>2nd type of connection</b>	screwed
<b>Solid, min.</b>	0.5 mm <sup>2</sup>
<b>Twin wire-end ferrule, min.</b>	0.50 mm <sup>2</sup>
<b>Zwillings-AEH, max.</b>	1.50 mm <sup>2</sup>
<b>Dimensions</b>	
<b>Width</b>	8 mm
<b>Height of lowest version</b>	34 mm
<b>Length</b>	58 mm
<b>TS 32 offset</b>	11 mm
<b>TS 35 offset</b>	9 mm
<b>Disconnect terminals</b>	
<b>Torque level with DMS electric screwdriver</b>	2
<b>Display element</b>	
<b>Type of voltage for indicator</b>	AC/DC
<b>Operating voltage for indicator, max.</b>	500 V
<b>Fuse terminals</b>	
<b>Display</b>	without LED
<b>Operating voltage, max.</b>	500
<b>Fuse holder (cartridge holder)</b>	detachable