



BRISBANE CITY COUNCIL

Sewage Pump Station SP117

Saltash St

Contract : BW 70103-037

Job Number : WT400089

ELECTRICAL INSTALLATION

OPERATIONS and MAINTENANCE MANUAL

VOLUME 2

INSTALLATION BY:

**SJ Electric (Qld) Pty Ltd
19 Elliot Street
Albion Qld 4010**

Telephone: 07 3256 1522 Fax: 07 3256 1533

INDEX

| SECTION | Sewage Pump Station – SP117 Saltash St |
|-----------------|---|
| Volume 1 | GENERAL |
| 1. | 1..1 General Workplace Health & Safety 1..2 Project Overview 1..3 Plant Maintenance 1..4 Electrical Control System 1..5 Control & Monitoring System |
| Volume 1 | MANUFACTURER'S TECHNICAL DATA |
| 2. | 2.1 Terasaki XS 400 Circuit Breakers. 2.2 Sprecher and Schuh CA-7 Contactors. 2.3 Critec TDS –180-4S-277 Surge Diverter 2.4 Critec TDF-10A-240V Surge Filter. 2.5 Critec DAR-275V Alarm Relay 2.6 Crompton Phase Failure Relay. 2.7 Multitrode MTR Level Relay 2.8 Trio DR900-06A02-D0 Radio. 2.9 Polyphaser IS-50NX Impulse Suppressor. 2.10 Powerbox Radio/DC converter. 2.11 Powerbox Modem/DC converter. 2.12 Multitrode Level Probe 2.13 Emotron Soft Starter MSF 2.0 2.14 Vega Delivery Pressure Transmitter 2.15 Endress & Hauser Wet Well Level Transmitter |
| Volume 2 | DRAWINGS |
| 3. | |
| Volume 2 | INSPECTION & TEST RESULTS |
| 4. | |
| Volume 2 | COMPLIANCE CERTIFICATES |
| 5. | |

3. DRAWINGS



**4. INSPECTION &
TEST RESULTS**



**4. INSPECTION &
TEST RESULTS**

SP117 Saltash St Carseldine SPS Electrical Installation Volume 2 OM Manual



SSM089

FIXED SPEED SEWAGE PUMP STATION

SWITCHBOARD CHANGEOVER COMMISSIONING PLAN

| | |
|--------------------|----------------------|
| Site ID and Name | SP117 Saltash Street |
| Commissioning Date | 22/06/2010 |

In Attendance

| Name | Role During Commissioning | Company |
|---------------|---------------------------|--------------|
| John Clayton | Commissioning Manager | QUU Projects |
| Peter Cross - | P. Manager | SJ Electric |
| | | SJ Electric |
| | | SJ Electric |
| | | |

Doc Id: 006142

Active Date: 2 November 2007

Brisbane Water Confidential

Printed: 16/06/2010

Owner: John Clayton

Version 1.00

Note: Printed copies of this document should be verified for currency against the published electronic copy.

1 INTRODUCTION

This document is the standard testing procedure for a switchboard change over at a sewage pumping station. The procedure ensures that for a two pump sewage pump station, at least one pump will be operational at all times. The basic cut-over procedure is as follows:

1. Install temporary pumping system (pump controller and generator).
2. Disconnect sewage Pump #2 from existing switchboard and connect to temporary pumping system.

PUMP #1 IS NOW RUNNING THE STATION FROM EXISTING SWITCHBOARD

3. Fully commission Pump #2 on the temporary pumping system.

PUMP #2 IS NOW RUNNING THE STATION FROM TEMPORARY PUMPING SYSTEM

4. Disconnect Pump #1, consumer mains, on site generator and all field instrumentation from the existing switchboard.
5. Install new switchboard and connect to consumer mains.
6. Connect Pump #1 to the new switchboard and test in "emergency pumping" mode (via the "Emergency Start" switch).

PUMP #2 IS STILL RUNNING THE STATION FROM THE TEMPORARY PUMPING SYSTEM AND PUMP #1 CAN BE RUN UNDER "EMERGENCY PUMPING" MODE FROM NEW SWITCHBOARD.

7. Connect all field instrumentation.
8. Fully commission Pump #1 on the new switchboard to operate in "Local" and "Remote" modes.

PUMP #1 IS NOW RUNNING THE STATION FROM NEW SWITCHBOARD

9. Connect Pump #2 to the new switchboard and fully commission on the new switchboard to operate in all modes.
10. Complete the Site Acceptance Test (SAT) including all pump, RTU and SCADA testing.

NOTE: This testing procedure will only be acceptable on sites that do NOT need two pumps to run during the cut over procedure.

(Confirm the current running conditions of the existing switchboard before commencing).

For sites that require two pumps to run simultaneously under dry weather conditions during the proposed cut over period, a site-specific cut over procedure must be developed to incorporate adequate flow control measures (ie tankers or temporary pumps).

2 PRE - CHANGE OVER WORKS CHECKLIST

The following checklist is to be completed and signed by the electrical contractor.

2.1 SWITCHBOARD FACTORY ACCEPTANCE TEST

| Contractor Task | Completed |
|---|-----------|
| FAT has been completed as per BW FAT Document and all defects that were identified have been rectified. | 18/6/10 |

2.2 CONCRETE SLAB EXTENSION

| Contractor Task | Result |
|---|--|
| Confirm the concrete slab extension is complete including all necessary conduits. | OK <input checked="" type="checkbox"/> NA <input type="checkbox"/> |

2.3 SUPPLY AUTHORITY

| Contractor Task | Outcome |
|---|--|
| The relevant supply authority has been organised to install the metering into the New Switchboard. N/A ✓ | Company _____ Booked for / / @ _____ (time) Ref # _____ |

2.4 NEW RADIO ANTENNA MAST LOCATION

| Contractor Task | Result |
|---|---|
| Check the location of the antenna mast and ensure that the new position will not be directly below electrical transmission lines. | Location OK <input checked="" type="checkbox"/> Antenna dir. _____ ° |

2.5 DISCHARGE MAINS PRESSURE TRANSDUCER

| Contractor Task | Completed |
|--|--|
| Install delivery pressure transducer on the discharge rising main. Transducer is calibrated to the specified range (as per spec). Calibration sheet to be supplied with AS BUILT drawings. 0kPa to _____ kPa | Installed OK <input type="checkbox"/> Range 0(m) to _____ (m) |

2.6 TEMPORARY GENERATOR SIZE

| Contractor Task | Completed |
|--|--|
| Note the kW of each pump. 406 kW | Pump #1 406 kW Pump #2 406 kW |
| Determine the type of generator and size of pump starter required. Confirm generator starting battery is in good condition, (have a contingency plan) ✓ OK | Genset Size _____ kVA Date Booked / / Delivery Date 22/6/10 Delivery Time _____ |

Electrical Contactor's Supervisor

Name: ...Peter Crust

Date: 22/6/10

Signature: _____

QUU Commissioning Manager

Name: ...John Clayton

Date: 22/6/10

Signature: _____

Doc Id: 006142

Active Date: 2 November 2007

Brisbane Water Confidential

Printed: 16/06/2010

Owner: John Clayton

Note: Printed copies of this document should be verified for currency against the published electronic copy.

The following sequence of works that must be carried out in order. One pump must be operational at all times. After each phase has been completed, the commissioning manager will record the results and instruct the commissioning team to commence work on the next phase.

3.1.1 Register with Control Room

3.1.2 Existing Switchboard Parameters

3.1.3 Prepare and Install Temporary Pump Controller and Generator

Electrical Contactor's Supervisor

BW Commissioning Manager

Name: Peter Crust

Date: 7/2/6/10

Name: **John Clayton.**

Date: 22/0/00

Signature:

Signature: [Signature]

Doc Id: 006142

Active Date: 2 November 2007

Brisbane Water Confidential

Printed: 16/06/2010

Owner: Alex Witthoft

Note: Printed copies of this document should be verified for currency against the published electronic copy.

3.2 STEP 2 - CONNECT PUMP #2 TO TEMPORARY PUMPING SYSTEM

| Contractor Task | Outcome |
|--|---|
| On the existing switchboard, Isolate sewage pump (Pump #2) as per BW Isolation Tag and Lock Out procedure. (Unplug from Decontactor). | OK <input checked="" type="checkbox"/> |
| Disconnect Pump #2 from the existing switchboard and remove the power and control cables from the switchboard. | OK <input checked="" type="checkbox"/> |
| Connect Pump #2 power and control cables to the temporary pump controller . | OK <input checked="" type="checkbox"/> |
| Electrically test Pump #2 to temporary pump controller connections. | OK <input type="checkbox"/> |
| Switch the existing switchboard to "Local" and stop Pump #1. | OK <input checked="" type="checkbox"/> |
| Manual Test of Temporary Pumping System: (Confirm Pump Direction) Manually start the submersible pump and closely monitor wet well level to confirm that the level is dropping. When confirmed, stop pump. | OK <input checked="" type="checkbox"/> |
| Auto Test of Temporary Pumping System: (Confirm Pump Cycle) Allow the temporary pumping system to complete one full start and stop cycle automatically to confirm complete system is functioning correctly. This is a HOLD point. Do not proceed until the temporary pump is confirmed to be controlling the wet well level. | OK <input checked="" type="checkbox"/> TIME: <u>2.00</u> |

3.3 STEP 3 - DISCONNECT EXISTING SWITCHBOARD AND REMOVE**3.3.1 Contact Control Room****3.3.2 Disconnect Pump #1 and Remove Existing Switchboard**

| Contractor Task | Outcome |
|---|--|
| On the existing switchboard, Isolate sewage pump (Pump #1) as per BW Isolation Tag and Lock Out procedure. (Unplug from Decontactor). | OK <input checked="" type="checkbox"/> |
| Disconnect Pump #1 from the existing switchboard and remove the power and control cables from the switchboard and place near the temporary system so as to enable a quick changeover for Pump #2 if required. | OK <input checked="" type="checkbox"/> |
| Isolate main incomer at the switchboard. Ensure all secondary sources of power (ie on site Generator) are also isolated. Confirm there is no load. | OK <input checked="" type="checkbox"/> |
| Remove primary 3-phase fuses from power pole. Lock fuses in lockout box as per BW Isolation and Lock Out procedure. Fuse Size 20 amps | OK <input checked="" type="checkbox"/> |
| Disconnect mains cable from the switchboard. | OK <input checked="" type="checkbox"/> |
| Disconnect all other control and communication cables and remove | OK <input checked="" type="checkbox"/> |
| Remove the existing switchboard away from job site. | OK <input checked="" type="checkbox"/> |

Electrical Contactor's Supervisor

Name: Peter Crust

Date: 22/6/10Signature: [Signature]

BW Commissioning Manager

Name: John Clayton

Date: 22/6/10Signature: [Signature]

Doc Id: 006142

Active Date: 2 November 2007

Brisbane Water Confidential

Printed: 16/06/2010

Owner: Alex Witthoft

Note: Printed copies of this document should be verified for currency against the published electronic copy.

3.4 STEP 4 - INSTALL NEW SWITCHBOARD

3.4.1 Install new switchboard (For Sites with Option F Only)

| Contractor Task | Outcome |
|--|--|
| Install and connect the required (new or existing) mains and earth as per the contract. Install mains cable within the switchboard in steelflex conduit | New <input checked="" type="checkbox"/> Existing <input type="checkbox"/> |
| Record the cable insulation resistance of the 3 phases | A <u>1200</u> Megohm B <u>1200</u> Megohm. C <u>1200</u> Megohm |
| Record earth resistance | _____ ohms |
| Point to point phase continuity | R to L1 OK <input checked="" type="checkbox"/> W to L2 OK <input checked="" type="checkbox"/> B to L3 OK <input checked="" type="checkbox"/> |

3.4.2 Install Supply Authority Metering

| Task | Outcome |
|--|--|
| Install the direct connected kWhr Meter or Energex to connect CT metered metering as per 2.3 | OK <input checked="" type="checkbox"/> |

3.4.3 Energise New Switchboard


| Contractor Task | Outcome |
|---|---|
| Retrieve mains 3-phase pole fuses from lock out box as per BW Isolation and Lock Out procedure. | OK <input checked="" type="checkbox"/> |
| Ensure new switchboard main incomer is turned "Off". | OK <input checked="" type="checkbox"/> |
| Install the 3-phase pole fuses. Check MEN connection. | OK <input checked="" type="checkbox"/> OK <input type="checkbox"/> |
| Turn on mains switch | OK <input checked="" type="checkbox"/> |
| Check 3 phase voltages | AB <u>415</u> V BC <u>415</u> V CA <u>415</u> V |
| Check phase rotation and ensure it is the same as determined earlier. | OK <input checked="" type="checkbox"/> |
| Confirm that a corrosion inhibitors has been positioned in the switchboard | OK <input checked="" type="checkbox"/> |

Electrical Contactor's Supervisor

Name: Peter Crust

Date: 22/6/10Signature: 

BW Commissioning Manager

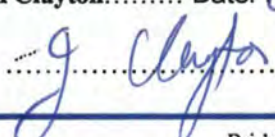Name: John Clayton Date: 22/8/10Signature: 

Doc Id: 006142

Active Date: 2 November 2007

Brisbane Water Confidential

Printed: 16/06/2010

Owner: Alex Witthoft

Note: Printed copies of this document should be verified for currency against the published electronic copy.

3.5 STEP 5 - CONNECT PUMP #1 TO NEW SWITCHBOARD

| Contractor Task | Outcome |
|--|---|
| At the beginning of this procedure, Pump #2 is operating under the control of the temporary switchboard running from the Generator. | OK <input checked="" type="checkbox"/> |
| Isolate submersible Pump #1 and Pump #2 at the new switchboard, as per BW Isolation and Lock Out procedure. | OK <input checked="" type="checkbox"/> |
| Via the MERACHAL plug in sockets provided on the switchboard reconnect the power and control cables for Pump #1 only (the pump that is not connected to the generator set) If VFD connection is direct connect. | OK <input checked="" type="checkbox"/> |
| Before beginning the next step ensure that the well level is between 'Start' and 'Stop' level and Pump #2 is not running. Isolate Pump #2 to prevent it from running during the next test | OK <input checked="" type="checkbox"/> |
| De-isolate this now connected Pump #1. Check the rotation by starting the pump via the local "Emergency Start" switch. Monitor pump / wet level operating parameters. | OK <input checked="" type="checkbox"/> |
| Check the 3 phase motor current and compare with original readings. PUMP #1 Can now be run in an emergency under the control of the new switchboard. When checking is complete - Isolate Pump #1 | A <u>7.2</u> Amps B <u>7.2</u> Amps C <u>7.2</u> Amps |
| De-isolate Pump #2 so that the station is again under the control of the temporary switchboard. | OK <input checked="" type="checkbox"/> |

3.6 STEP 6 - CONNECT FIELD INSTRUMENTATION TO NEW SWITCHBOARD

3.6.1 Field Devices

| Contractor Task | Outcome |
|--|--|
| Install and connect the hydrostatic level probe to the transmitter Do not tighten shroud cable compression gland | OK <input type="checkbox"/> 0 to <u>6</u> Mtrs |
| Connect the delivery pressure probe to the transmitter | OK <input type="checkbox"/> 0 to <u> </u> Mtrs |
| Install and connect the Multitrode LR3 wet well high level relay Probe | OK <input type="checkbox"/> at <u> </u> Mtrs |
| Install and connect the Multitrode SIR surcharge imminent level relay Probe | OK <input type="checkbox"/> at <u> </u> Mtrs |
| Connect the moisture in oil sensor for each pump (sites with option A only) | OK <input type="checkbox"/> N/A <input checked="" type="checkbox"/> |
| Connect the moisture in stator for each pump (sites with option B1 only) | OK <input type="checkbox"/> N/A <input checked="" type="checkbox"/> |
| Connect the motor bearing temperature for each pump (sites with option B2 only) | OK <input type="checkbox"/> N/A <input checked="" type="checkbox"/> |
| Connect the reflux valve micro switch for each pump (sites with option C only) | OK <input type="checkbox"/> N/A <input checked="" type="checkbox"/> |
| Connect the upstream manhole surcharge imminent probe (sites with option D only) | OK <input type="checkbox"/> N/A <input checked="" type="checkbox"/> |
| Connect the Multitrode LR2 sump pump start/ stop probes (sites with option E only) | OK <input checked="" type="checkbox"/> N/A <input checked="" type="checkbox"/> |
| Connect the Multitrode LR4 Dry well high/trip probes (sites with option E only) High = 50 mm off the floor, Drip 200 mm below the first flood exposed equipment | OK <input type="checkbox"/> N/A <input checked="" type="checkbox"/> |
| Connect the sump pump (sites with option E only) | OK <input type="checkbox"/> N/A <input checked="" type="checkbox"/> |
| Connect the generator IO cables (sites with option F only) | OK <input type="checkbox"/> N/A <input checked="" type="checkbox"/> |
| Connect the thermistors for each pump (sites with option I only) | OK <input checked="" type="checkbox"/> N/A <input type="checkbox"/> |

Electrical Contactor's Supervisor

Name: Peter Crust

Date: 22/6/10Signature: 

BW Commissioning Manager

Name: John Clayton

Date: 22/6/10Signature: 

Doc Id: 006142

Active Date: 2 November 2007

Brisbane Water Confidential

Printed: 16/06/2010

Owner: Alex Witthoft

Note: Printed copies of this document should be verified for currency against the published electronic copy.

3.6.2 Install Generator Mains (For Sites with Permanent Generators)

| Contractor Task | Outcome |
|--|---|
| Record insulation resistance of the 3-phases | A <u>120</u> Megohm B <u>120</u> Megohm. C <u>120</u> Megohm |
| Record earth resistance | _____ ohms |
| Point to point phase continuity | R to L1 OK <input type="checkbox"/> W to L2 OK <input type="checkbox"/> B to L3 OK <input type="checkbox"/> |

3.6.3 Radio Antenna Installation

| BW Programmer Task | Outcome |
|---|--|
| Install new mast with Antenna, orientate antenna to the position determined in section 3.1.2 connect coaxial cable plugs. | OK <input checked="" type="checkbox"/> |

3.6.4 Telemetry and SCADA Communications Checks

| BW Programmer Task | Outcome |
|--|--|
| Brisbane Water programmer must complete the following procedures From the SSM086 Standard Fixed Speed Sewage Pumping Station (S.A.T.) <u>Section 1: Setup and Pre-Commissioning Checks</u> | OK <input checked="" type="checkbox"/> |

3.7 STEP 7 - COMMISSIONING PUMP #1

| BW Programmer & Contractor Task | Outcome |
|--|--|
| Before doing the next step ensure that the well level is between 'Start' and 'Stop' level and Pump #2 is not running. Isolate Pump #2 to prevent it from running during the next test. | OK <input checked="" type="checkbox"/> |
| At this stage the Brisbane Water Programmer must complete the following procedures From the SSM086 Standard Fixed Speed Sewage Pumping Station (S.A.T.) <u>Section2 : On Site Commissioning Procedure (Pump #1 Only)</u> | OK <input checked="" type="checkbox"/> |
| Once Pump #1 has been commissioned, leave the new switchboard in control of the site operating under "Remote" control. | OK <input checked="" type="checkbox"/> |

Electrical Contactor's Supervisor

Name: Peter Crust

Date: 22/6/10

Signature: _____

BW Commissioning Manager

Name: John Clayton

Date: 22/6/10

Signature: _____

Doc Id: 006142

Active Date: 2 November 2007

Brisbane Water Confidential

Printed: 16/06/2010

Owner: Alex Witthoft

Note: Printed copies of this document should be verified for currency against the published electronic copy.

3.8 STEP 8 - CONNECT PUMP #2 AND COMMISSION

3.8.1 Connect Pump #2 to New Switchboard

| Contractor Task | Outcome |
|--|--|
| At the beginning of this procedure, Pump #1 is operating under the control of the new switchboard running from the supply authority. | OK <input checked="" type="checkbox"/> |
| Shut down the generator and disconnect Pump #2 from the temporary switchboard | OK <input checked="" type="checkbox"/> |
| Ensure Pump #2 circuit breaker at the new switchboard is still isolated and locked out as per BW Isolation and Lock Out procedure. | OK <input checked="" type="checkbox"/> |
| Via the MERACHAL plug in sockets provided on the switchboard, connect the power and control cables for Pump #2. | OK <input checked="" type="checkbox"/> |
| De-isolate this now connected submersible pump. Check the rotation of this submersible pump by bumping the pump On / Off via the local "Emergency Start" switch. | OK <input checked="" type="checkbox"/> |
| Check the 3-phase motor current and compare with original results. | A <u>7</u> Amps |
| PUMP #2 Can now be run in an emergency under the control of the new switchboard. | B <u>7</u> Amps |
| | C <u>7</u> Amps |

3.8.2 Commissioning of Pump #2

| BW Programmer & Contractor Task | Outcome |
|--|--|
| Before beginning the next step ensure that the well level is between "Start and Stop" level and Pump #1 is not running. (Station under the control of the new board) Isolate Pump #1 to prevent it from running during the next test. | OK <input checked="" type="checkbox"/> |
| Brisbane Water Programmer must complete the following procedures From the SSM086 Standard Fixed Speed Sewage Pumping Station (S.A.T.) <u>Section2: On Site Commissioning Procedure – (Pump #2 Only)</u> | OK <input checked="" type="checkbox"/> |
| Once Pump #2 has been commissioned, de-isolate Pump #1 and leave that new switchboard in control of the site operating under remote control with both pumps able to run | OK <input checked="" type="checkbox"/> |

Electrical Contactor's Supervisor

Name: Peter Crust

Date: 22/6/10Signature: 

BW Commissioning Manager

Name: John Clayton

Date: 22/6/10Signature: 

Doc Id: 006142

Active Date: 2 November 2007

Brisbane Water Confidential

Printed: 16/06/2010

Owner: Alex Witthoft

Note: Printed copies of this document should be verified for currency against the published electronic copy.

3.9 STEP 9 - COMPLETE TESTING

3.9.1 Site Acceptance Testing (S.A.T) – Remaining Tests

| BW Programmer & Contractor Task | Outcome |
|---|--|
| Once pump 2 has been commissioned Complete any remaining procedures in Section 2 from the SSM086 Standard Fixed Speed Sewage Pumping Station (S.A.T.) | OK <input checked="" type="checkbox"/> |
| Check operation of SIR for 20 sec. with probe to prove probe operation and operation of 2 pumps | OK <input checked="" type="checkbox"/> |
| Check operation LR3 with probe to prove RTU and probe | OK <input checked="" type="checkbox"/> |
| Seal conduits with denso and grout under switchboard. | OK <input checked="" type="checkbox"/> |
| Check Energex Phase Fail Input. | OK <input checked="" type="checkbox"/> |
| Confirm automatic control of pumps. | OK <input checked="" type="checkbox"/> |
| Check Parameter 203 of Soft Starter is a positive value | OK <input checked="" type="checkbox"/> |
| Confirm correct operation of all door locks | OK <input checked="" type="checkbox"/> |
| Confirm Operation & Maintenance Manual left on site. | OK <input checked="" type="checkbox"/> |

3.9.2 SCADA Testing

| BW Programmer & Contractor Task | Outcome |
|--|--|
| The Brisbane Water Programmer must complete the following procedures with the assistance from the Commissioning Engineer and SCADA Commissioning Engineer in the Control Room. From the SSM086 Standard Fixed Speed Sewage Pumping Station (S.A.T.) Section3 : SCADA Commissioning Procedure | OK <input checked="" type="checkbox"/> |

3.9.3 Preliminary Work Completion by Electrical Contractors

| Contractor Task | Outcome |
|--|--|
| Leave the site clean and tidy and hazard free. | OK <input checked="" type="checkbox"/> |
| Confirm with BW that the job is complete and their staff can leave. | OK <input checked="" type="checkbox"/> |
| Confirm with BW that BW staff will lock up the site on completion of the switchboard change over work. | OK <input checked="" type="checkbox"/> |
| Note: If there is a problem with finishing the work due to unforeseen circumstance refer to the Risk Analysis attached. | OK <input checked="" type="checkbox"/> |

3.9.4 Register Control Room

| BW Programmer & Contractor Task | Outcome |
|---|--|
| Commissioning Engineer to call the Control Room Operator (CRO) and inform him that the site works is complete and that the site is now fully in "Remote" control and that all alarms are to be acted on as per the alarm instructions. C.R.O. to confirm that the site is healthy and that there are no alarms active. Record the C.R.O.'s name and Officer Code and record the time of the call. | Name: _____ CRO: _____ TIME: <u>1600</u> |

BW Commissioning Manager

Name:.....John Clayton..... Date: 22/6/10Signature: J. Clayton

Doc Id: 006142

Active Date: 09/Aug/2007

Brisbane Water Confidential

Printed: 16/06/2010

Owner: Alex Witthoft

Note: Printed copies of this document should be verified for currency against the published electronic copy.

4 POST CHANGE OVER CHECKLIST

4.1 DELIVERABLES FROM RTU PROGRAMMER

| BW Programmer | Date Completed |
|---|----------------|
| Within 7 days of the change over the following must be completed and signed off by the BW Programmer0 Complete Section 4: Post Commissioning from the SSM086 Standard Fixed Speed Sewage Pumping Station (S.A.T.) | / / |
| The BW Programmer will ensure that the Control Room Acceptance (CRA) form is signed by the Manager of the Control Room Officers. The form is to be handed to the Contracts Manager (CM). | / / |

4.2 DELIVERABLES FROM ELECTRICAL CONTRACTOR

| Contractor Task | Date Completed |
|--|----------------|
| All documentation required under the contract is to be provided with the time specified (AS BUILT's, Electrical Certificates etc). | / / |

4.3 DELIVERABLES FROM COMMISSIONING MANAGER

| Commissioning Manager | Date Completed |
|--|-----------------------------|
| All documentation is handed to the Project Manager to that the new switchboard asset can be capitalised and handed over to the customer. | |
| Factory Acceptance Test Sheet – Completed & signed off. | OK <input type="checkbox"/> |
| Electrical Inspection Sheet – Completed & signed off. | OK <input type="checkbox"/> |
| Site Acceptance Test Sheet – Completed & signed off. | OK <input type="checkbox"/> |
| Commissioning Plan – Completed & signed off. | OK <input type="checkbox"/> |
| Control Room Acceptance Form – Completed & signed off | OK <input type="checkbox"/> |
| As built Drawings have been updated, drafted and taken to site along with the Site Specific Functional Specification, | / / |

4.4 SUGGESTIONS FOR IMPROVEMENT

| Suggestion | Recommended By |
|------------|----------------|
| | |
| | |
| | |

BW Commissioning Manager

Name:.....John Clayton..... Date:

Signature:

Doc Id: 006142

Active Date: 09/Aug/2007

Brisbane Water Confidential

Printed: 16/06/2010

Owner: Alex Witthoft

Note: Printed copies of this document should be verified for currency against the published electronic copy.

№ 10477

CUSTOMER NAME: BRISBANE WATER

SWITCHBOARD ID: SP117

DATE: 22-6-2010

CUSTOMERS ADDRESS: SLATASH STAVUT

...JOB No.: 67405089

[illegible]

TEST EQUIPMENT: MIRROR METER

SERIAL NO: 5103060 0000000 359

TEST DUE DATE: 12-10-2010 12-10-20

NAME: Martin Cooper

LIC NO: 112 578 0

SIGNATURE: _____

SJ Electric Pty Ltd

Ref: SJQF 502

Inspection and Test Check List

Date: 19 July 2007

| | | | |
|-------------------------------|---------------|------------------------------|--|
| Project: Brisbane Water SP117 | | | |
| Contractor / Order No. | | SJ Electric Job No. BT430022 | |
| ITC No. 003 | Date: 17/6/10 | Corresponding ITP No. 001 | |

General Data

| | |
|---|-------------------------------------|
| Built By: Brendan Stringer, Thomas Chan | Test Equipment: Megger / Multimeter |
| Location: Workshop | Type: Kyoritsu / Fluke |
| Drg rev No. | Serial No. 5149622 / 10620027 |

Check List (Tick () acceptable items only, note deviations under "REMARKS") (If not applicable mark as N/A)

| Switch Board and Control Panels Construction Check List | | | | |
|---|--|-------------|---------|--------------|
| Item | Activity Description | Hold Points | Checked | By (Initial) |
| Busbar | | | | |
| 1 | Correct size busbar to rated current load to meet AS 2067 | | () | |
| 2 | Appearance is good i.e. Straight & level | | () | |
| 3 | Correct phase identification | | () | |
| 4 | Correct hole sizes for joins and terminations | | () | |
| 5 | All clearances have been meet | | () | |
| 6 | Correct busbar support material has been used | | () | |
| 7 | Busbar supports are at the correct distances apart | | () | |
| 8 | Correct tensioning & blue spotted at all joins & terminations | | () | |
| 9 | Correct hole format in joining cubicle | | () | |
| 10 | Sufficient clearances for terminating cable | | () | |
| 11 | Heat shrink attached to flags for terminations | | () | |
| 12 | All joins are dressed flat & polished | | () | |
| 13 | Busbar is insulated at supports | | () | |
| Cabling | | | | |
| 15 | Correct size for demand of circuit | | () | |
| 16 | Correct phase colouring | | () | |
| 17 | Correct termination & insulated | | () | |
| 18 | Correct numbering | | () | |
| 19 | Correctly formed and neat | | () | |
| 20 | Correctly supported | | () | |
| 21 | All cable entry holes are insulated | | () | |
| 22 | Check cable tray is mounted correctly & all sharp surfaces are removed | | () | |
| 23 | All cable ties are neatly trimmed | | () | |
| 24 | All cable clear from busbar's | | () | |
| 25 | Check all analog inputs and outputs are shielded | | () | |
| 26 | All shielded cables have been earthed | | () | |

Remarks/Remedial Action Required Hold Points:

Remedial Actions Completed ☐

Signature:

Date:

Checked By: Brendan Stringer

Signature: 

Approved By: Renee Wardrop

Electrical Licence No. 114766

Signature: 

Date: 17/6/10



All the above signatories certify that the Electrical switchboard work listed has been checked and tested in accordance with the prescribed procedure and that such work complies in every respect with the requirements of the Electricity Act, AS3000 2007 and AS3008.1.1 1998

SJ Electric Pty Ltd

Ref: SJQF 502

Inspection and Test Check List

Date: 19 July 2007
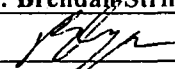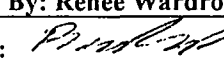
| Switch Board and Control Panels Construction Check List (SJQF 502) | | | | |
|---|--|---|---------|---------------|
| Item | Activity Description | Hold Points | Checked | By (Initial) |
| Switchgear | | | | |
| 1 | Check all main switches & circuit breakers are the correct <ul style="list-style-type: none"> • current rating • ka rating. • trip settings • correct to cabling • to labels. • shunt trips • inter locks | | (✓) | |
| 2 | Check the fixings | | (✓) | |
| 3 | Check the number of poles | | (✓) | |
| 4 | Check correct operation | | (✓) | |
| 5 | Correct mechanism | | (✓) | |
| Control Switches | | | | |
| 6 | Check correct number of positions | | (✓) | |
| 7 | Check correct size | | (✓) | |
| 8 | Check correct to labels | | (✓) | |
| 9 | Check mountings | | (✓) | |
| Contactors | | | | |
| 10 | Check for correct model no | | (✓) | |
| 11 | Check for correct current rating to control | | (✓) | |
| 12 | Correct auxiliary contacts | | (✓) | |
| 13 | Correct phasing | | (✓) | |
| 14 | Correct coil size | | (✓) | |
| 15 | Check that it is accessible | | (✓) | |
| 16 | Check it has correct overloads | | (✓) | |
| 17 | Correct labelling | | (✓) | |
| Relays and Timers | | | | |
| 18 | Check correct rated voltage | | (✓) | |
| 19 | Correct contacts | | (✓) | |
| 20 | Correct variances | | (✓) | |
| 21 | Dip switches in required position | | (✓) | |
| 22 | Timers set to correct settings | | (✓) | |
| 23 | Correct operation | | (✓) | |
| 24 | Correct auxiliaries | | (✓) | |
| Transformers and Power Supplies | | | | |
| 25 | Check for correct voltage ratings | | (✓) | |
| 26 | Check for correct current ratings | | (✓) | |
| 27 | Check cabling is correct (no crossed voltage) | | (✓) | |
| 28 | Check the secondary has been earthed when applicable | | (✓) | |
| 29 | Check correct labelling | | (✓) | |
| 30 | Check mountings | | (✓) | |
| 31 | Check for clearance around for heat extraction | | (✓) | |
| Remarks/Remedial Action Required: | | | | |
| Remedial Actions Completed <input type="checkbox"/> Signature: _____ Date: _____ | | | | |
| Checked By: Brendan Stringer | | | | |
| Signature:  | | Approved By: Renee Wardrop | | |
| Electrical Licence No. 114766 | | Signature:  | | Date: 17/6/10 |
| All the above signatories certify that the Electrical switchboard work listed has been checked and tested in accordance with the prescribed procedure and that such work complies in every respect with the requirements of the Electricity Act 2002, AS3000 2007 and AS3008.1 1998 | | | | |

SJ Electric Pty Ltd

Ref: SJQF 502

Inspection and Test Check List

Date: 19 July 2007



| Switch Board and Control Panels Construction Check List (SJQF 502) | | | | |
|---|---|---------------------------------|---------|---------------|
| Item | Activity Description | Hold Points | Checked | By (Initial) |
| Fuses | | | | |
| 1 | Check that the cartridge is correct size | | (S) | |
| 2 | Correct mountings | | (S) | |
| 3 | Correct labelling | | (S) | |
| 4 | Check that line side conductors are SDI and < 500mm | | (S) | |
| 5 | Current Transformers | | (S) | |
| 6 | Correct ratio & size | | (S) | |
| 7 | Correct direction of feed | | (S) | |
| 8 | Correct earthing | | (S) | |
| 9 | Correct cabling | | (S) | |
| Voltage / Current Monitoring Equipment | | | | |
| 10 | Correct voltage / current range on meter to the installation | | (S) | |
| 11 | Correct to ratio on Cts | | (S) | |
| 12 | Voltmeter terminations are insulated | | (S) | |
| 13 | Check that all meters are preset to zero | | (S) | |
| 14 | Correct indication labels applied | | (S) | |
| Indication Equipment | | | | |
| 15 | Correct colour | | (S) | |
| 16 | Correct voltage size with matching lamp attached | | (S) | |
| 17 | Correct operation eg. Push to test | | (S) | |
| 18 | Correct labelling | | (S) | |
| Terminal Blocks | | | | |
| 19 | Correct size to cable | | (S) | |
| 20 | Correct colour coding | | (S) | |
| 21 | Correct numbering | | (S) | |
| 22 | Correctly mounted with lock ends | | (S) | |
| 23 | Correct labels | | (S) | |
| Neutral Links | | | | |
| 24 | Check that they are accessible | | (S) | |
| 25 | Correct labelling | | (S) | |
| 26 | Correct numbers stamped to match circuit identification | | (S) | |
| 27 | Correct cabling to circuit identification | | (S) | |
| 28 | Check that all neutral links & bar are insulated from the switchboard frame | | (S) | |
| Earthing | | | | |
| 29 | Check that all main earth bar is correct size | | (S) | |
| 30 | Check that the main earth is continuous | | (S) | |
| 31 | Correctly labelled | | (S) | |
| 32 | Continuous for CT wiring | | (S) | |
| 33 | Check that all doors with equipment mount are electrically earth | | (S) | |
| 34 | Check all frames are earthed | | (S) | |
| Remarks/Remedial Action Required: | | | | |
| Remedial Actions Completed <input type="checkbox"/> Signature: Date: | | | | |
| Checked By: Brendan Stringer | | | | |
| Signature: <i>B Stringer</i> | | Approved By: Renee Wardrop | | |
| Electrical Licence No. 114766 | | Signature: <i>Renee Wardrop</i> | | Date: 17/6/10 |
| All the above signatories certify that the Electrical switchboard work listed has been checked and tested in accordance with the prescribed procedure and that such work complies in every respect with the requirements of the Electricity Act 2002, AS3000 2007 and AS3008.1 1998 | | | | |

SJ Electric Pty Ltd

Ref: SJQF 502

Inspection and Test Check List

Date: 19 July 2007

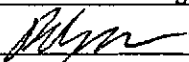
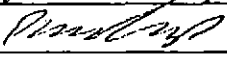
| Switch Board and Control Panels Construction Check List (SJQF 502) | | | | |
|---|--|---|--------------------|---------------------|
| Item | Activity Description | Hold Points | Result | By (Initial) |
| Earthing Resistance & Continuity Test (Note all readings should be < .5 ohms) | | | | |
| 1 | Make sure the MEN connection is removed | | | |
| 2 | Attach lead to main earth connection point than test with other lead between | | | |
| 3 | The frame of each section | | < .1Ω | |
| 4 | The doors | | < .1Ω | |
| 5 | All mounting bolts to all equipment | | < .1Ω | |
| 6 | All brackets | | < .1Ω | |
| 7 | All earth links | | < .1Ω | |
| 8 | All bolts & threads for the mounting of escutcheon | | < .1Ω | |
| 9 | All gland plates | | < .1Ω | |
| 10 | All cable trays | | < .1Ω | |
| 11 | All earth connection | | < .1Ω | |
| 12 | Earth secondary of transformers and power supplies where applicable | | < .1Ω | |
| 13 | Earth surge diverters | | < .1Ω | |
| 14 | Current transformers | | < .1Ω | |
| Insulation Test | | Hold Points | Test Result | By (Initial) |
| 1 | Make sure all control fuses and earths are removed from all electronic equipment before this test is carried out | | (✓) | |
| 2 | Set insulation tester (meggar) to 500 volts before proceeding | | (✓) | |
| 3 | Test between: | | | |
| | • Red - White | | 1200MΩ | |
| | • Red - Blue | | 1200MΩ | |
| | • Red - Earth | | 1200MΩ | |
| | • Red - Neutral | | 1200MΩ | |
| | • White - Blue | | 1200MΩ | |
| | • White - Earth | | 1200MΩ | |
| | • White - Neutral | | 1200MΩ | |
| | • Blue - Earth | | 1200MΩ | |
| | • Blue - Neutral | | 1200MΩ | |
| 4 | If all readings are clear the insulation tester is to be set at 1000 volts then proceed with the following | | (✓) | |
| 5 | Test between: | | | |
| | • Red - White | | 1200MΩ | |
| | • Red - Blue | | 1200MΩ | |
| | • White - Blue | | 1200MΩ | |
| Remarks/Remedial Action Required: | | | | |
| Remedial Actions Completed <input type="checkbox"/> Signature: _____ Date: _____ | | | | |
| Checked By: Brendan Stringer | | | | |
| Signature:  | | Approved By: Renee Wardrop | | |
| Electrical Licence No. 114766 | | Signature:  | | Date: 17/6/10 |
| All the above signatories certify that the Electrical switchboard work listed has been checked and tested in accordance with the prescribed procedure and that such work complies in every respect with the requirements of the Electricity Act 2002, AS3000 2007 and AS3008.1 1998 | | | | |

SJ Electric Pty Ltd

Inspection and Test Check List

Ref: SJQF 502

Date: 19 July 2007

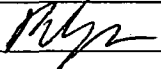
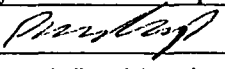
| Switch Board and Control Panels Construction Check List (SJQF 502) | | | | |
|---|--|---|--------------------|---------------------|
| Item | Activity Description | Hold Points | Checked | By (Initial) |
| 2.5 KV Test This test is used to prove all busbar construction | | | | |
| 1 | Make sure all control fuses and earths are removed from all electronic equipment before this test is carried out | | () | |
| 2 | All the following tests must be set at a 1 minute time period, result should be 0 Amps | | () | |
| | | Hold Points | Test Result | By (Initial) |
| 3 | Test between: | | | |
| | • Red - White | | | |
| | • Red - Blue | | | |
| | • Red - Earth | | | |
| | • Red - Neutral | | | |
| | • White - Blue | | | |
| | • White - Earth | | | |
| | • White - Neutral | | | |
| | • Blue - Earth | | | |
| | • Blue - Neutral | | | |
| Supply Authority section | | | | |
| 1 | Check supply authority main isolator lockable in the on position | | (✓) | |
| 2 | Check all doors before the Ct's. Or meters are lockable | | (✓) | |
| 3 | Check where the neutral link is located for the site connection if metres are remotely mounted | | (✓) | |
| 4 | Check where the earth link is located for the site connection if meters are remotely mounted | | (✓) | |
| 5 | Check double insulated cable for POT fuses are less than 800 mm | | (✓) | |
| 6 | Check double insulated cable are taken on line side of Ct.s | | (→) | |
| 7 | Check metre wiring is in building wire and correct size | | (→) | |
| 8 | Check if Ct meter wiring is in steel conduit when closer than 100mm to other conductors | | (→) | |
| 9 | Check there is no equipment connected before on the line side of meters or Ct.s (i.e., surge diverters) | | (→) | |
| 10 | Check list may vary if switch board is going interstate. Alter where applicable | | (→) | |
| Remarks/Remedial Action Required: | | | | |
| Remedial Actions Completed <input type="checkbox"/> Signature: Date: | | | | |
| Checked By: Brendan Stringer | | | | |
| Signature:  | | Approved By: Renee Wardrop | | |
| Electrical Licence No. 114766 | | Signature:  | | Date: 17/6/10 |
| All the above signatories certify that the Electrical switchboard work listed has been checked and tested in accordance with the prescribed procedure and that such work complies in every respect with the requirements of the Electricity Act 2002, AS3000 2007 and AS3008.1 1998 | | | | |

SJ Electric Pty Ltd

Ref: SJQF 502

Inspection and Test Check List

Date: 19 July 2007
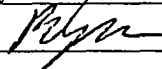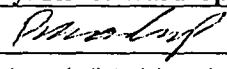
| Switch Board and Control Panels Construction Check List (SJQF 502) | | | | |
|---|--|---|-------------|---------------|
| Item | Activity Description | Hold Points | Checked | By (Initial) |
| Functional Test | | | | |
| Prior to connection of supply all inspection and test check lists must be completed | | Hold Points | Checked | By (Initial) |
| 1 | Point to point test on all cables as per schematic and single line drgs. (Leave spot for drawing. No's and Rev No's | | (✓) | |
| 2 | Check all Cts are not open circuit | | | |
| Connect supply (personal protection equipment must be used) | | Hold Points | Test Result | By (Initial) |
| 3 | Check polarity of connection | 415✓ | (✓) | |
| | • Red - White | | | |
| | • Red - Blue | 415✓ | (✓) | |
| | • Red - Earth | 240✓ | (✓) | |
| | • Red - Neutral | 240✓ | (✓) | |
| | • White - Blue | 415✓ | (✓) | |
| | • White - Earth | 240✓ | (✓) | |
| | • White - Neutral | 240✓ | (✓) | |
| | • Blue - Earth | 240✓ | (✓) | |
| | • Blue - Neutral | 240 | | |
| | | Hold Points | Checked | By (Initial) |
| 4 | Correct voltage / current range on meter to the installation | | (✓) | |
| 5 | Check functional operation of switchboard following specific construction issue drawings (leave spot for drawing No's and Rev No's | | (✓) | |
| 6 | Check operation of all RCD's < .03s | | (✓) | |
| Pre delivery check list | | | | |
| 1 | Check all punch list items are complete | | (✓) | |
| 2 | Check if Compliance label is mounted and correct | | (✓) | |
| 3 | Check if heat shrinks is supplied when necessary | | (✓) | |
| 4 | Check all load bolts are supplied | | (✓) | |
| 5 | Check if m.e.n is mounted after testing | | (✓) | |
| 6 | All drawings have been as built red lined and supplied and signed for to drafting office | | (✓) | |
| | Received by drafting Office (Sign) | | (✓) | |
| 7 | Photos have been taken of every section and given to manager | | (✓) | |
| 8 | Test reports have been photo copied and placed in the client folder and SJ Electric folder | | (✓) | |
| 9 | As built drawings received back from drafting office , verify Rev No. | | (✓) | |
| | Received by Work shop (Sign) | | (✓) | |
| 10 | Manuals placed in client folder | | (✓) | |
| 11 | Switch Board wrapped with delivery details supplied | | (✓) | |
| 12 | As built drawings placed in client folder. (Latest revision () Copy of red lined marked Drawing () | | | |
| Remarks/Remedial Action Required: | | | | |
| Remedial Actions Completed <input type="checkbox"/> Signature: Date: | | | | |
| Checked By: Brendan Stringer | | | | |
| Signature:  | | Approved By: Renee Wardrop | | |
| Electrical Licence No. 114766 | | Signature:  | | Date: 17/6/10 |
| All the above signatories certify that the Electrical switchboard work listed has been checked and tested in accordance with the prescribed procedure and that such work complies in every respect with the requirements of the Electricity Act 2002, AS3000 2007 and AS3008.1 1998 | | | | |

J Electric (Qld) Pty. Ltd.

FACTORY ACCEPTANCE TEST SHEET 1:

Project:
Client:
Job No.
Equipment:
Section:
Drawing:

Pump Station SP 117
QLD Urban Utilities
6740022
SP 117 Switchboard
Incomer
446/5/7-0130 Sheet 1

| | Process Operation | Reference/ Acceptance Criteria | Passed | |
|----|--|---|--------|---------|
| 1. | Ensure Insulation test as per QA3CH-15 have been completed | SJ QA3CH-15 AS 3000 Insulation resistance greater than 1 megohm ph to earth Hi pot test 2.5 kv ph-eth for 1 minute | ✓ | 17/6/10 |
| 2. | Ensure Checks 1 to 11 as per QA3CH-020 have been completed | SJ QA3CH-020 Point to Point check of schematics. Visual Check of wiring. | ✓ | 17/6/10 |
| 3. | Check Manual Transfer Switch is functioning by confirming power to the line and then load sides of the switches when energized and de-energized. | Drawing _____ | ✓ | 17/6/10 |
| 4. | Check operation of Energex Power On phase failure relay PFRE and correct signal is being received by RTU | Drawing _____ Remove one phase from relay sensing circuit to simulate loss of power. | ✓ | 17/6/10 |
| 5. | Check operation of Station Power On phase failure relay PFRS and correct signal is being received by RTU | Drawing _____ Remove one phase from relay sensing circuit to simulate loss of power. | ✓ | 17/6/10 |

Electric (Qld) Pty. Ltd.

| | | |
|--------------------|---------------|-------------|
| Tests Completed By | Witnessed By | Accepted By |
| Brendan Smyth | Renee Wardrop | |
| Date 17/6/10 | Date 17/6/10 | Date |
| Comments: | | |
| | | |
| | | |
| | | |
| Instruments Used: | | |
| | | |
| | | |

I Electric (Qld) Pty. Ltd.

FACTORY ACCEPTANCE TEST SHEET 2:

Project:

Client:

Job No.

Equipment:

Section:

Drawing:

Pump Station SP

QLD Urban Utilities

SP Switchboard

DB

Sheet 1

| | Process Operation | Reference/ Acceptance Criteria | Passed | Date |
|----|--|--|--------|---------|
| 1. | Ensure Insulation test as per QA3CH-15 have been completed | SJ QA3CH-15 AS 3000 Insulation resistance greater than 1 megohm ph to earth Hi pot test 2.5 kv ph-eth for 1 minute | ✓ | 17/6/10 |
| 2. | Ensure Checks 1 to 11 as per QA3CH-020 have been completed | SJ QA3CH-020 Point to Point check of schematics. Visual Check of wiring. | ✓ | 17/6/10 |
| 3. | Check voltage is available on line side of circuit breaker Q9 | Drawing _____ 415 vac ph to ph. 240 vac ph to n 240 vac ph to e | ✓ | 17/6/10 |
| 4. | Ensure all distribution circuit breakers are "OFF" and operate circuit breaker Q9 and confirm voltage is available to distribution chassis. | Drawing _____ 415 vac ph to ph. 240 vac ph to n 240 vac ph to e | ✓ | 17/6/10 |
| 5. | Ensure Station Mains Power Failure Relay Circuit Breaker Q10 is "OFF" and close circuit breaker for PFRS Relay supply. | Drawing _____ | ✓ | 17/6/10 |
| 6. | Confirm voltage is available to line side of Station Mains Power Failure Relay Circuit Breaker. Close circuit breaker and confirm voltage is available to Line side of PFRS Relay. | Drawing _____ 415 vac ph to ph. 240 vac ph to n 240 vac ph to e | ✓ | 17/6/10 |
| 7. | Repeat Step 6 above for circuit breaker Q11, Q12, Q13, Q14, Q16, Q17, Q19, Q20 and Q21 | Drawing _____ 415 vac ph to ph (Where applicable). 240 vac ph to n 240 vac ph to e | ✓ | 17/6/10 |

Electric (Qld) Pty. Ltd.

| | | | |
|----|---|---|---------|
| 8. | Check operation of the following RCD's and note tripping times: <ul style="list-style-type: none"> • Q11 17ms • Q12 28ms • Q13 27ms • Q19 27ms • Q21 27ms <p style="text-align: center;">PASS</p> | Drawing <u>496/5/7-0196</u> Tripping Time: | 17/6/10 |
|----|---|---|---------|

| | | |
|--------------------|---------------|-------------|
| Tests Completed By | Witnessed By | Accepted By |
| Brenton Givrym | Renee Wardrop | |
| Date 17/6/10 | Date 17/6/10 | Date |
| Comments: | | |
| | | |
| | | |
| | | |
| Instruments Used: | | |
| | | |
| | | |

Electric (Qld) Pty. Ltd.

FACTORY ACCEPTANCE TEST SHEET 3:

Project:
Client:
Job No.
Equipment:
Section:
Drawing:

Pump Station SP 117
QLD Urban Utilities
SP Switchboard
RTU Connection
 Sheets 1 & 6

| | Process Operation | Reference/ Acceptance Criteria | Passed | Date |
|----|--|---|--------|---------|
| 1. | Ensure Insulation test as per QA3CH-15 have been completed | SJ QA3CH-15 AS 3000 Insulation resistance greater than 1 megohm ph to earth Hi pot test 2.5 kv ph-eth for 1 minute | | 17/6/10 |
| 2. | Ensure Checks 1 to 11 as per QA3CH-020 have been completed | SJ QA3CH-020 Point to Point check of schematics. Visual Check of wiring. | | 17/6/10 |
| 3. | Ensure Laptop GPO, circuit breaker Q13 is "OFF" and operate RTU circuit breaker Q30 on DB Chassis and ensure: RTU Power Supplies are operating correctly. | Drawing <u> </u> Sheet 1 240 vac ph to n on power supply input. 24 vdc on power supply output | | 17/6/10 |
| 4. | Close Laptop GPO Circuit Breaker and: Check GPO polarity. Check GPO switch is functioning. Check operation of RCD device. | Drawing <u> </u> Sheet 1 | | 17/6/10 |
| 7. | Confirm operation of door switches. | Drawing <u> </u> Sheet 1 & 6 | | 17/6/10 |

J Electric (Qld) Pty. Ltd.

| | | |
|---------------------------|----------------------|--------------------|
| Tests Completed By | Witnessed By | Accepted By |
| <i>Benton Smith</i> | <i>Renee Wardrop</i> | |
| Date 17/6/10 | Date 17/6/10 | Date |
| Comments: | | |
| | | |
| | | |
| | | |
| Instruments Used: | | |
| | | |
| | | |

Electric (Qld) Pty. Ltd.

FACTORY ACCEPTANCE TEST SHEET 4:

Project:
Client:
Job No.
Equipment:
Section:
Drawing:

Pump Station SP 117
QLD Urban Utilities

SP Switchboard
Pump 1

Sheet 2

| | Process Operation | Reference/ Acceptance Criteria | Passed | Date |
|----|---|---|--------|---------|
| 1. | Ensure Insulation test as per QA3CH-15 have been completed | SJ QA3CH-15 AS 3000 Insulation resistance greater than 1 megohm ph to earth Hi pot test 2.5 kv ph-eth for 1 minute | ✓ | 17/6/10 |
| 2. | Ensure Checks 1 to 11 as per QA3CH-020 have been completed | SJ QA3CH-020 Point to Point check of schematics. Visual Check of wiring. | / | 17/6/10 |
| 3. | Check voltage is available on line side of motor circuit breaker Q4. | 415 vac ph to ph | / | 17/6/10 |
| 4. | Ensure control circuit breaker Q4-1 is "OFF" and emergency stop is operated, close circuit breaker Q4 and confirm voltage is available on line side of circuit breaker Q4. | 415 vac ph to ph | / | 17/6/10 |
| 5. | Check voltage is available on line side of control circuit breaker Q4-1, close circuit breaker and ensure: <ul style="list-style-type: none"> 1K2 Control Supply Relay is operating correctly. | 240 vac ph to n | / | 17/6/10 |
| 6. | Release emergency stop and confirm operation of isolating contactor 1K1 and confirm voltage is available to VSD. | 415 vac ph to ph | / | 17/6/10 |
| | | | | |

| | | |
|---|--------------------------------------|-------------|
| Tests Completed By <i>Brentlin Starnes</i> | Witnessed By <i>Renee Wardrop</i> | Accepted By |
| Date <i>17/6/10</i> | Date <i>17/6/10</i> | Date |
| Comments: | | |
| | | |
| | | |
| | | |
| Instruments Used: | | |
| | | |
| | | |

Electric (Qld) Pty. Ltd.

FACTORY ACCEPTANCE TEST SHEET 5:

Project:
Client:
Job No.
Equipment:
Section:
Drawing:

Pump Station SP 117
QLD Urban Utilities
SP Switchboard
Pump 2
 Sheet 3

| | Process Operation | Reference/ Acceptance Criteria | Passed | Date |
|----|--|---|--------|---------|
| 1. | Ensure Insulation test as per QA3CH-15 have been completed | SJ QA3CH-15 AS 3000 Insulation resistance greater than 1 megohm ph to earth Hi pot test 2.5 kv ph-eth for 1 minute | ✓ | 17/6/10 |
| 2. | Ensure Checks 1 to 11 as per QA3CH-020 have been completed | SJ QA3CH-020 Point to Point check of schematics. Visual Check of wiring. | ✓ | 17/6/10 |
| 3. | Check voltage is available on line side of motor circuit breaker Q5. | 415 vac ph to ph | ✓ | 17/6/10 |
| 4. | Ensure control circuit breaker Q5-1 is "OFF" and emergency stop is operated, close circuit breaker Q5 and confirm voltage is available on line side of circuit breaker Q5. | 415 vac ph to ph | ✓ | 17/6/10 |
| 5. | Check voltage is available on line side of control circuit breaker Q5-1, close circuit breaker and ensure: • 2K2 Control Supply Relay is operating correctly. | 240 vac ph to n | ✓ | 17/6/10 |
| 6. | Release emergency stop and confirm operation of isolating contactor 2K1 and confirm voltage is available to VSD. | 415 vac ph to ph | ✓ | 17/6/10 |
| | | | | |

| | | |
|---|--------------------------------------|-------------|
| Tests Completed By <i>Brendan Smay</i> | Witnessed By <i>Renee Wardrop</i> | Accepted By |
| Date <i>17/6/10</i> | Date <i>17/6/10</i> | Date |
| Comments: | | |
| | | |
| | | |
| | | |
| Instruments Used: | | |
| | | |
| | | |

Sewage Pump Station SP117**Saltash St****Electrical Drawing List 2****Factory Test**

| Sheet No. | Drawing No. | Title |
|-----------|------------------|--|
| 00 | 486/5/7-0103-000 | Site Cover Sheet |
| 01 | 486/5/7-0103-001 | Power Distribution Schematic Diagram |
| 02 | 486/5/7-0103-002 | Pump 01 Schematic Diagram |
| 03 | 486/5/7-0103-003 | Pump 02 Schematic Diagram |
| 04 | 486/5/7-0103-004 | [RESERVED] Sump Pump Schematic Diagram |
| 05 | 486/5/7-0103-005 | [RESERVED] Generator Control Schematic Diagram |
| 06 | 486/5/7-0103-006 | Common Controls Schematic Diagram |
| 07 | 486/5/7-0103-007 | Common RTU I/O Schematic Diagram |
| 08 | 486/5/7-0103-008 | RTU Power Distribution Schematic Diagram |
| 09 | 486/5/7-0103-009 | RTU Digital Inputs Termination Diagram |
| 10 | 486/5/7-0103-010 | RTU Digital Inputs Termination Diagram |
| 11 | 486/5/7-0103-011 | RTU Digital Outputs Termination Diagram |
| 12 | 486/5/7-0103-012 | RTU Analogs & Miscellaneous Termination Diagram |
| 13 | 486/5/7-0103-013 | [RESERVED] Common Controls Termination Diagram |
| 14 | 486/5/7-0103-014 | Equipment List |
| 15 | 486/5/7-0103-015 | Cable Schedule |
| 16 | 486/5/7-0103-016 | Switchboard Label Schedule |
| 17 | 486/5/7-0103-017 | Switchboard Construction Details |
| 18 | 486/5/7-0103-018 | Switchboard Construction Details |
| 19 | 486/5/7-0103-019 | Level Probes and Pressure Transmitter Installation Details |
| 20 | 486/5/7-0103-020 | [RESERVED] Cathodic Protection Unit |
| 21 | 486/5/7-0103-021 | [RESERVED] Field Disconnection Box |
| 22 | 486/5/7-0103-022 | Switchboard General Arrangement Elevations - Double Sided |
| 23 | 486/5/7-0103-023 | Switchboard General Arrangement Sections - Double Sided |
| 24 | 486/5/7-0103-024 | Slab & Conduit Details |
| 25 | 486/5/7-0103-025 | Slab & Conduit Details |
| 26 | 486/5/7-0103-026 | Slab & Conduit Details |

SS Electric 7623
Brendan Stringer 114766
17/6/10 Blyn



QUEENSLAND
UrbanUtilities

ABN 72 002 765 795

Test copy

SP117 SALTASH STREET SEWAGE PUMPING STATION SITE COVER SHEET

| ELECTRICAL DRAWINGS INDEX | | | | | |
|---------------------------|--|-------|-----------|---|--|
| DWG N° | TITLE | SHEET | REVISIONS | | |
| 486/5/7-0180-000 | SITE COVER SHEET | 00 | 0 | A | |
| 486/5/7-0180-001 | POWER DISTRIBUTION SCHEMATIC DIAGRAM | 01 | 0 | A | |
| 486/5/7-0180-002 | PUMP 01 SCHEMATIC DIAGRAM | 02 | 0 | A | |
| 486/5/7-0180-003 | PUMP 02 SCHEMATIC DIAGRAM | 03 | 0 | A | |
| 486/5/7-0180-004 | RESERVED (SUMP PUMP) | 04 | | | |
| 486/5/7-0180-005 | RESERVED (GENERATOR CONTROL) | 05 | | | |
| 486/5/7-0180-006 | COMMON CONTROLS SCHEMATIC DIAGRAM | 06 | 0 | A | |
| 486/5/7-0180-007 | COMMON RTU I/O SCHEMATIC DIAGRAM | 07 | 0 | A | |
| 486/5/7-0180-008 | RTU POWER DISTRIBUTION SCHEMATIC DIAGRAM | 08 | 0 | A | |
| 486/5/7-0180-009 | RTU DIGITAL INPUTS TERMINATION DIAGRAM | 09 | 0 | A | |
| 486/5/7-0180-010 | RTU DIGITAL INPUTS TERMINATION DIAGRAM | 10 | 0 | A | |
| 486/5/7-0180-011 | RTU DIGITAL OUTPUTS TERMINATION DIAGRAM | 11 | 0 | A | |
| 486/5/7-0180-012 | RTU ANALOGS & MISCELLANEOUS TERMINATION DIAGRAM | 12 | 0 | A | |
| 486/5/7-0180-013 | RESERVED (COMMON CONTROLS TERMINATION DIAGRAM) | 13 | | | |
| 486/5/7-0180-014 | EQUIPMENT LIST | 14 | 0 | A | |
| 486/5/7-0180-015 | CABLE SCHEDULE | 15 | 0 | A | |
| 486/5/7-0180-016 | SWITCHBOARD LABEL SCHEDULE | 16 | 0 | A | |
| 486/5/7-0180-017 | SWITCHBOARD CONSTRUCTION DETAILS | 17 | 0 | A | |
| 486/5/7-0180-018 | SWITCHBOARD CONSTRUCTION DETAILS | 18 | 0 | A | |
| 486/5/7-0180-019 | LEVEL PROBES AND PRESSURE TRANSMITTER INSTALLATION DETAILS | 19 | 0 | A | |
| 486/5/7-0180-020 | RESERVED (CATHODIC PROTECTION UNIT) | 20 | | | |
| 486/5/7-0180-021 | RESERVED (FIELD DISCONNECTION BOX) | 21 | | | |
| 486/5/7-0180-022 | SWITCHBOARD GENERAL ARRANGEMENT ELEVATIONS - DOUBLE SIDED | 22 | 0 | A | |
| 486/5/7-0180-023 | SWITCHBOARD GENERAL ARRANGEMENT SECTIONS - DOUBLE SIDED | 23 | 0 | A | |
| 486/5/7-0180-024 | RESERVED (GENERATOR EXTERNAL CONNECTION BOX) | 24 | | | |
| 486/5/7-0180-025 | SLAB & CONDUIT DETAILS - SHEET 1 of 3 | 25 | 0 | A | |
| 486/5/7-0180-026 | SLAB & CONDUIT DETAILS - SHEET 2 of 3 | 26 | 0 | A | |
| 486/5/7-0180-027 | SLAB & CONDUIT DETAILS - SHEET 3 of 3 | 27 | 0 | A | |

| STANDARD VARIABLES | |
|--|----------------------------|
| DESCRIPTION | VALUES |
| CT METERING ISOLATOR | NOT APPLICABLE |
| NORMAL SUPPLY MAIN SWITCH | 125A S250PE/125 |
| GENERATOR SUPPLY MAIN SWITCH | 125A S250PE/125 |
| PUMP1 CIRCUIT BREAKER | 20A S125GJ/20 |
| PUMP2 CIRCUIT BREAKER | 20A S125GJ/20 |
| DRY WELL SUMP PUMP CIRCUIT BREAKER | NOT APPLICABLE |
| PUMP SOFT STARTER SIZE | MSF-017 Max 7.5kW |
| PUMP RATING | 4.6kW 10.5A |
| PUMP LINE CONTACTOR | CA7-9 |
| PUMP BYPASS CONTACTOR | CA7-9 |
| SUMP PUMP RATING | NOT APPLICABLE |
| SUMP PUMP CONTACTOR & TOL | NOT APPLICABLE |
| PUMP SOCKET OUTLET + INCLINE SLEEVE | DS1 311A013972 + 51BA058 |
| PUMP INLET PLUG + HANDLE | DS1 311A013972 + 311A013 |
| WET WELL LEVEL TRANSMITTER | FHX21AA22.HLG.D.11AP0PS 4m |
| EMERGENCY STORAGE WELL LEVEL TRANSMITTER | NOT APPLICABLE |
| DELIVERY PRESSURE TRANSMITTER | BR74XXGGIEHA2X 25m |
| WET WELL ULTRASONIC LEVEL SENSOR | NOT APPLICABLE |
| FLOWMETER RANGE | NOT APPLICABLE |
| RADIO | DR900-06A02-D0 |
| EMERGENCY PUMPING TIME | 360sec |
| No of SINGLE POINT PROBES | 2 |
| INCOMING MAINS SUPPLY CABLE | 16mm ² |
| MAIN EARTHING CABLE | 6mm ² |
| INCOMING GENERATOR SUPPLY CABLE | NOT APPLICABLE |
| SOFT STARTER 3 PHASE SUPPLY | 4mm ² |

| STANDARD DESIGN OPTIONS | | |
|-------------------------|--|---|
| OPTION | DESCRIPTION | FITTED |
| A | INDIVIDUAL PUMP MOISTURE IN OIL (MIO) SENSOR AND FAULT RELAY | <input checked="" type="checkbox"/> NO |
| B | INDIVIDUAL PUMP MOTOR AUX PROTECTION SENSORS AND FAULT RELAYS | <input checked="" type="checkbox"/> NO |
| C | INDIVIDUAL PUMP REFLEX VALVE MICROSWITCH | <input checked="" type="checkbox"/> NO |
| D | STATION MANHOLE SURCHARGE IMMINENT | <input checked="" type="checkbox"/> NO |
| E | STATION DRY WELL SUMP PUMP AND LEVEL INDICATION SENSORS AND RELAYS | <input checked="" type="checkbox"/> NO |
| F | STATION PERMANENT GENERATOR - ATS AND CONTROL CONNECTIONS | <input checked="" type="checkbox"/> NO |
| G | STATION EMERGENCY STORAGE LEVEL SENSOR | <input checked="" type="checkbox"/> NO |
| H | STATION DELIVERY FLOWMETER | <input checked="" type="checkbox"/> NO |
| I | BACKUP COMMUNICATION - GSM | <input checked="" type="checkbox"/> YES |
| J | PUMP CONNECTION (Via De-contactors) | <input checked="" type="checkbox"/> YES |
| K | CATHODIC PROTECTION | <input checked="" type="checkbox"/> NO |
| L | MOTOR THERMISTORS (Via De-contactors) | <input checked="" type="checkbox"/> YES |
| M | ODOUR CONTROL | <input checked="" type="checkbox"/> NO |
| N | CURRENT TRANSFORMER (CT) METERING | <input checked="" type="checkbox"/> NO |
| O | PUMPS ELECTRICAL INTERLOCK | <input checked="" type="checkbox"/> NO |
| P | WET WELL WASHER | <input checked="" type="checkbox"/> NO |
| Q | AUX PIT SUMP PUMP AND LEVEL PROBE | <input checked="" type="checkbox"/> NO |
| R | TELEMETRY RADIO | <input checked="" type="checkbox"/> YES |
| S | WET WELL ULTRASONIC LEVEL SENSOR | <input checked="" type="checkbox"/> NO |
| T | DOUBLE SIDED SWITCHBOARD PLINTH EXTENSION FITTED | <input checked="" type="checkbox"/> YES |
| U | DELIVERY PRESSURE TRANSMITTER | <input checked="" type="checkbox"/> YES |
| V | CHEMICAL DOSING | <input checked="" type="checkbox"/> NO |


Sheet 00

FOR CONSTRUCTION

| | | | | | | | | | | | | | | | |
|-------|-------------------------|------|------|-----------------|--------------|-------------------------------|-------------------|-------------------------------|----------|--|--|---------------------------|------------------|--|--------|
| 04.10 | ISSUED FOR CONSTRUCTION | P.H. | A.W. | DRAFTING CHECK | A.WITTHOFT | Original Signed by G.ANDERSON | 09-04-10 | Original Signed by K.VAHEESAN | 13-04-10 | QUEENSLAND UrbanUtilities A DIVISION OF THE BRISBANE CITY COUNCIL | SITE SP117 SALTASH STREET SEWAGE PUMP STATION | TITLE SITE COVER SHEET | SHEET No. 0 | Queensland Urban Utilities DRAWING No. | AMEND. |
| 04.10 | ISSUED FOR TENDER | P.H. | A.W. | CAD FILE | 07-0180aet_A | Original signed by A.WITTHOFT | 8895 09-04-10 | Original Signed by P.BHERRIFF | 12-04-10 | | | | 486/5/7-0180-000 | | A |
| DATE | AMENDMENT | DRN. | APD. | B.O.C. FILE No. | | DESIGN CHECK | R.P.E.Q. No. DATE | CLIENT DELEGATE | DATE | | | | | | |

NOTES

1. INCOMING GENSET, MAIN, PUMP & DIST. BOARD CIRCUIT BREAKERS SHALL BE LINE SIDE SHROUDED.
2. CIRCUIT BREAKER RATINGS TO SUIT FAULT LEVEL & LOAD. ENSURE MIN TYPE 1 CO-ORDINATION WITH CONTACTORS & OVERLOADS TO IEC 947-4-1.
3. ALL WIRES & CABLE CORES ARE FERRULED WITH GRAFOPLAST SIZ000 COMPATIBLE LABELLING.
4. ADD POINT OF SUPPLY
5. ADD ACTUAL FAULT LEVEL
6. CABLING TO GENERATOR CONNECTION SOCKET AND AUXILIARY SUPPLY SOCKET TO BE DOUBLE INSULATED CABLING TO BE FULLY SEALED TO OTHER COMPARTMENT

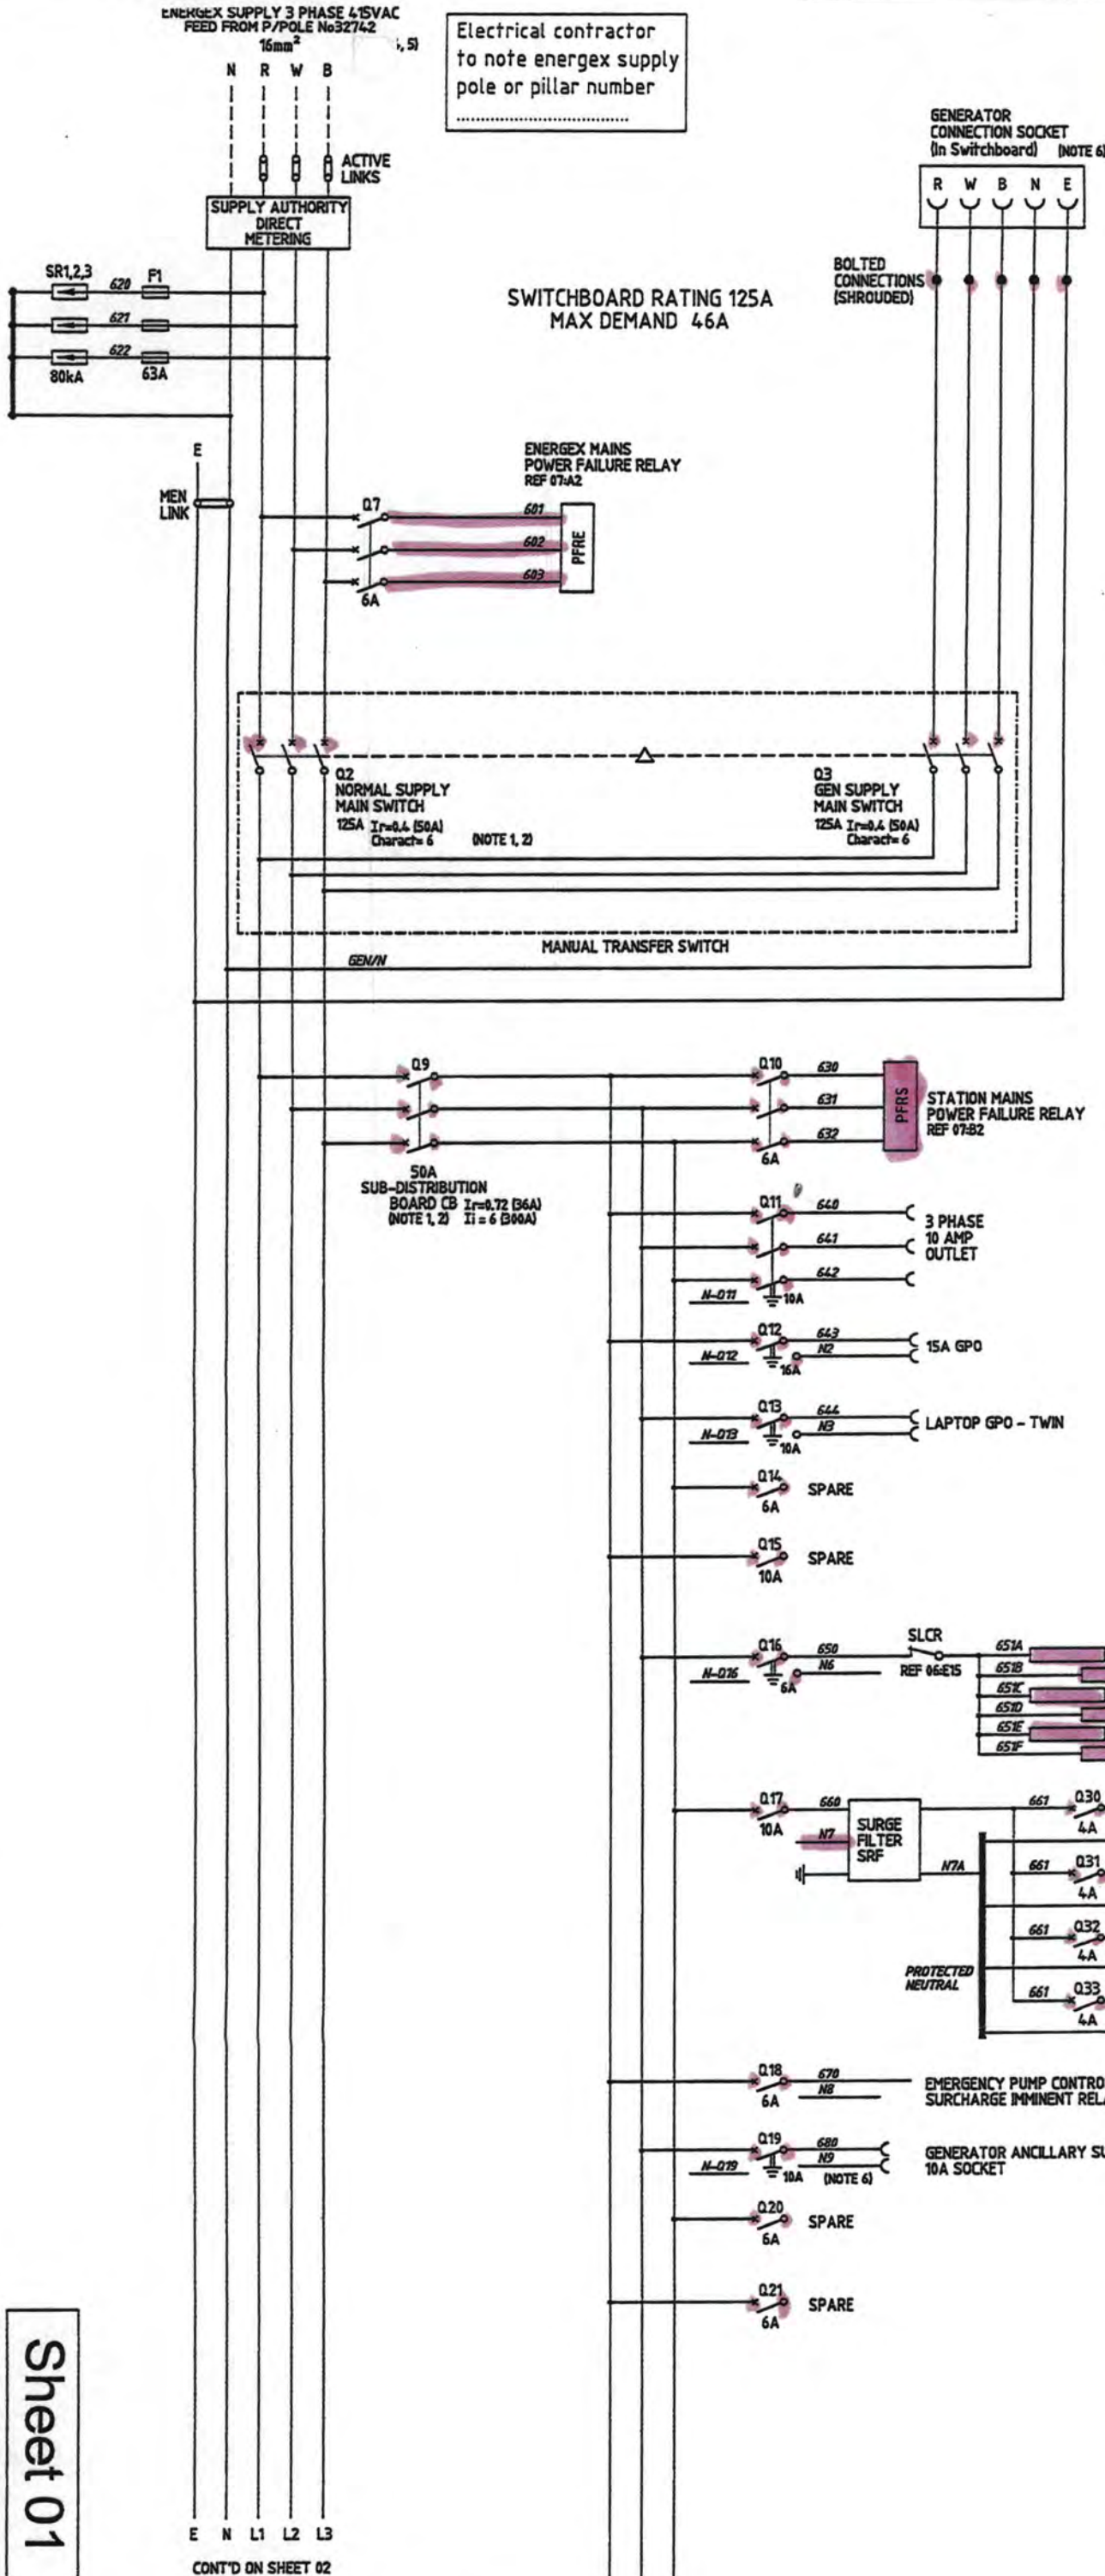

Sheet 01

FOR CONSTRUCTION

SP117
SALTASH STREET
SEWAGE PUMP STATION

POWER DISTRIBUTION
SCHEMATIC DIAGRAM

SP117
SALTASH STREET
SEWAGE PUMP STATION

Urban Utilities
A DIVISION OF THE QUEENSLAND GOVT


Original Signed by K. VANDERBEEK
13-04-10
DATE

Original Signed by G. ANDERSON
09-04-10
DATE


Original Signed by A. WITTHOFT
07-01-08
DATE

Original Signed by A. WITTHOFT
07-01-08
DATE


by Brendan Shinger 114766

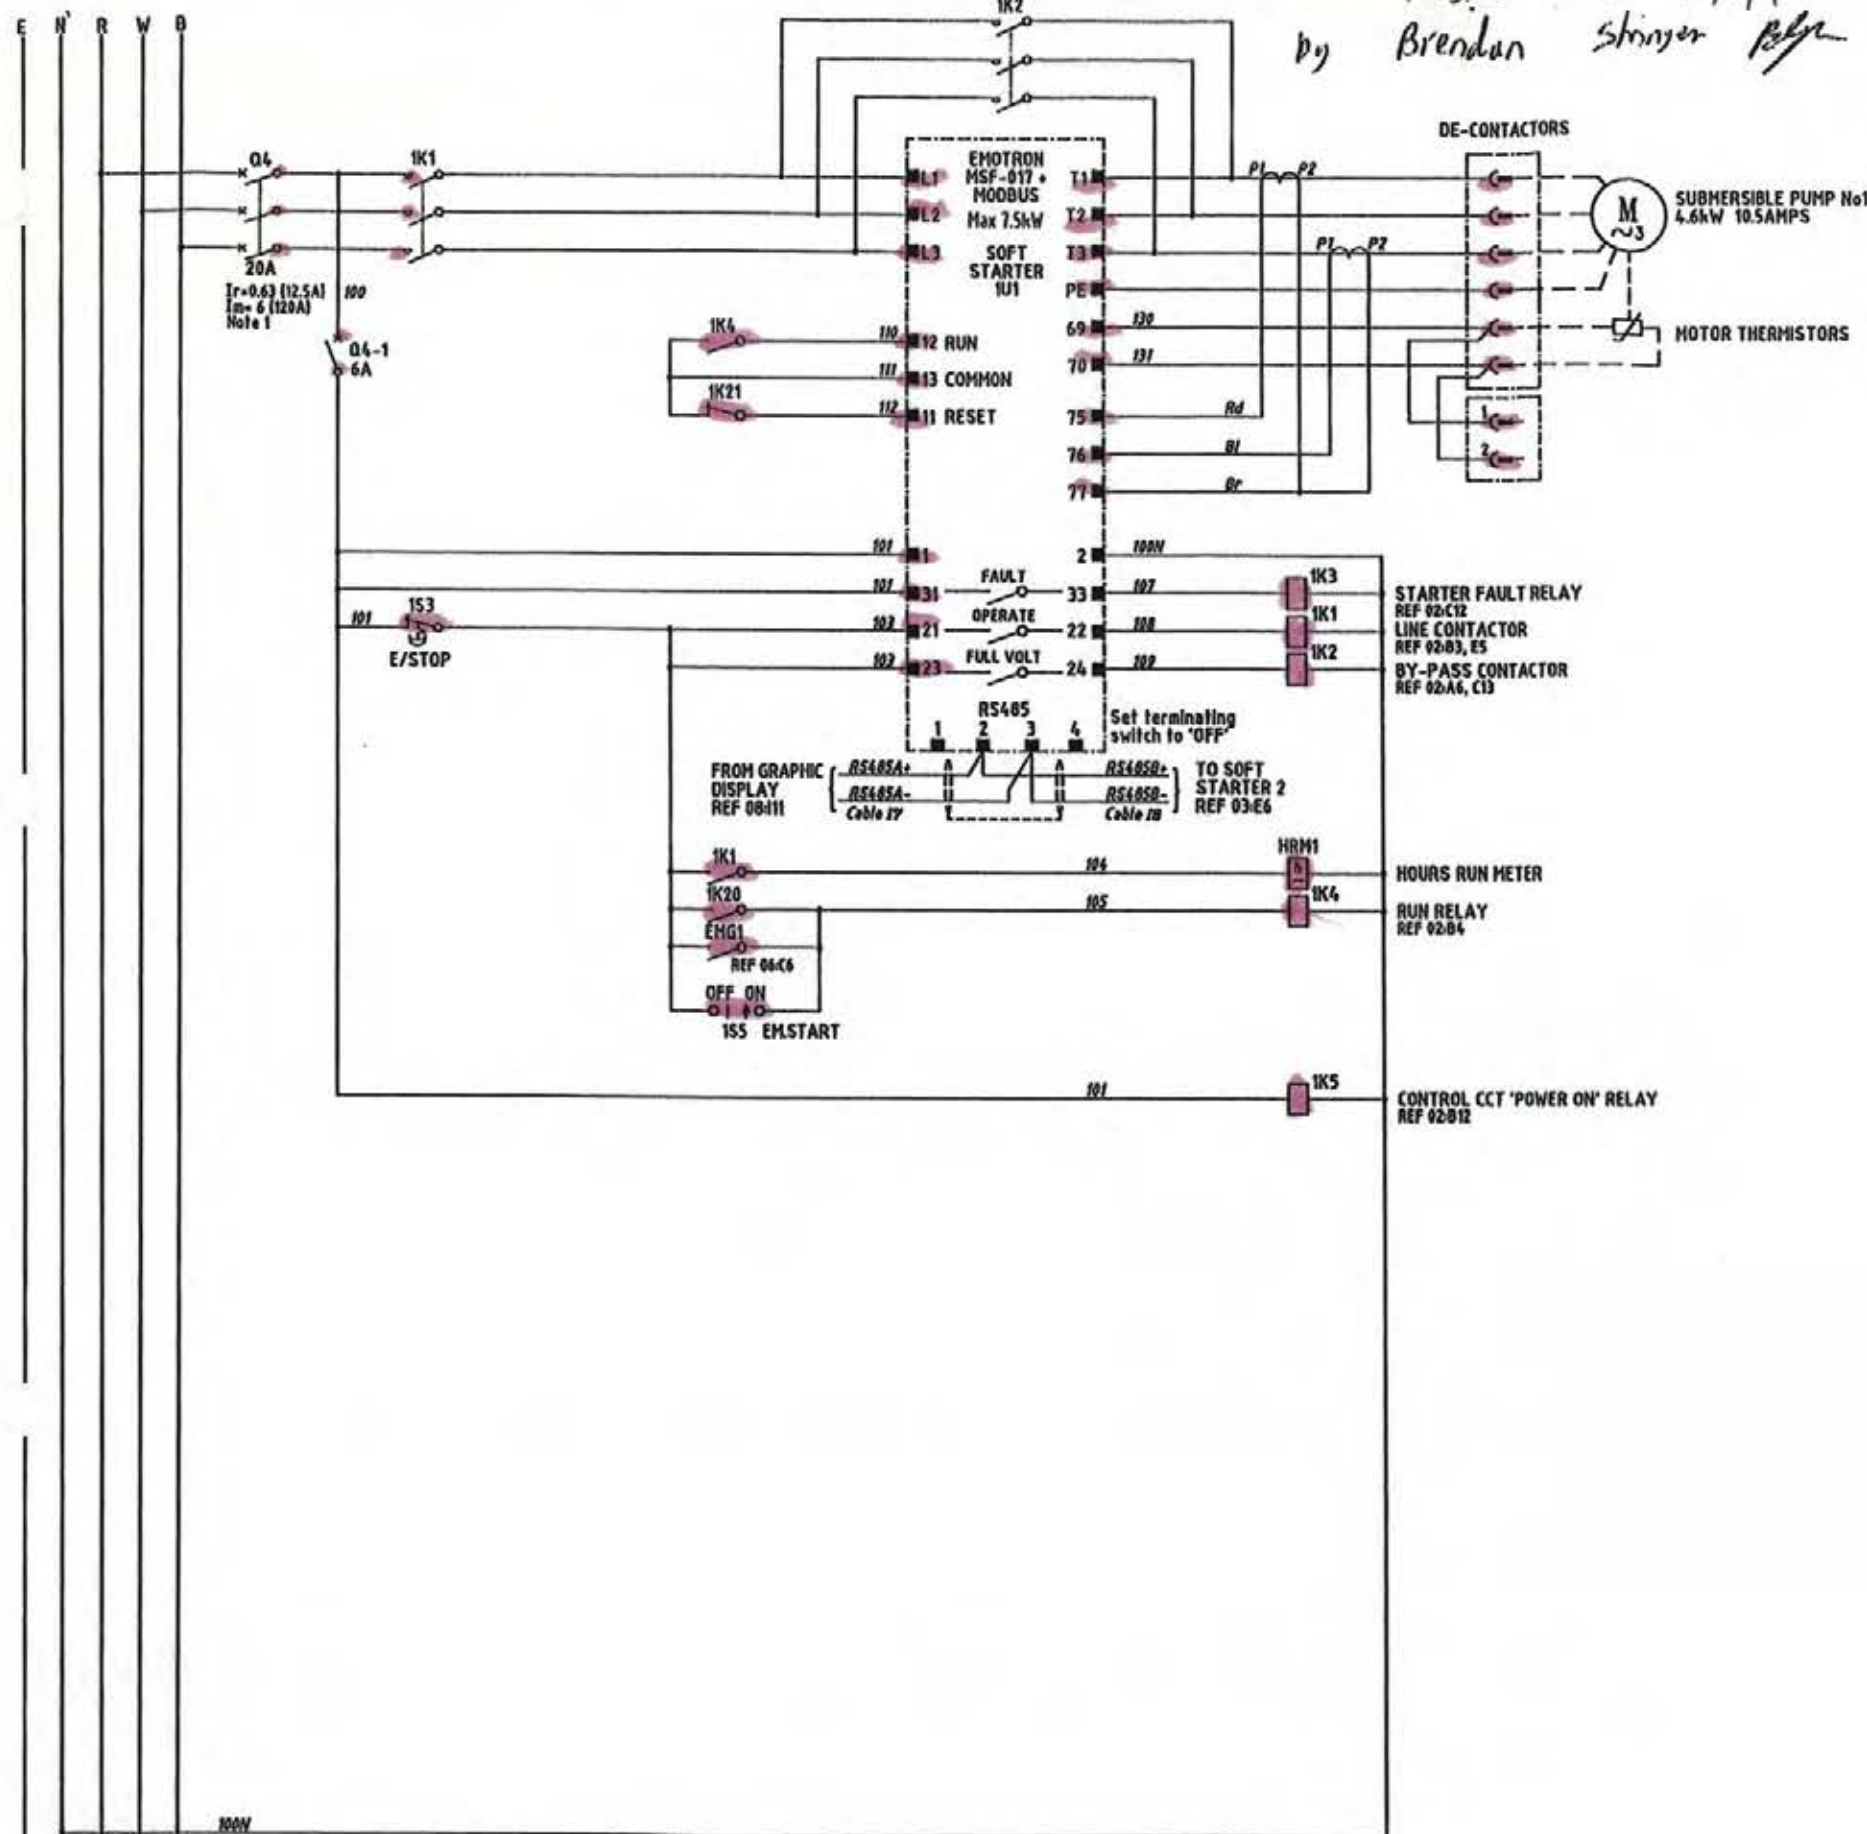

RTU DIGITAL INPUTS

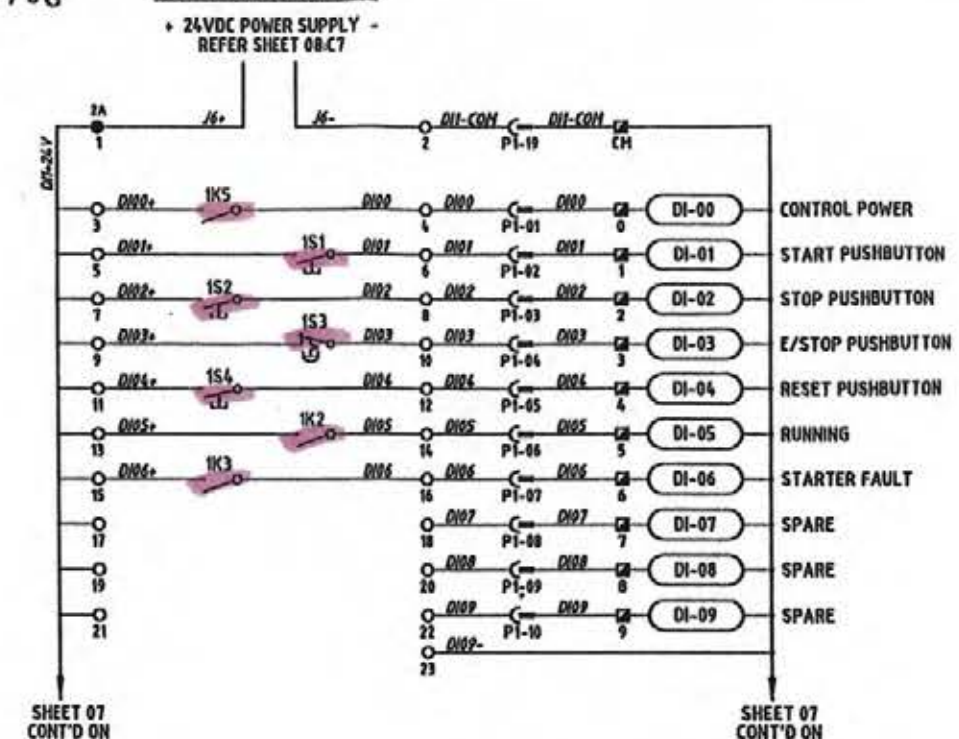

RTU DIGITAL OUTPUTS

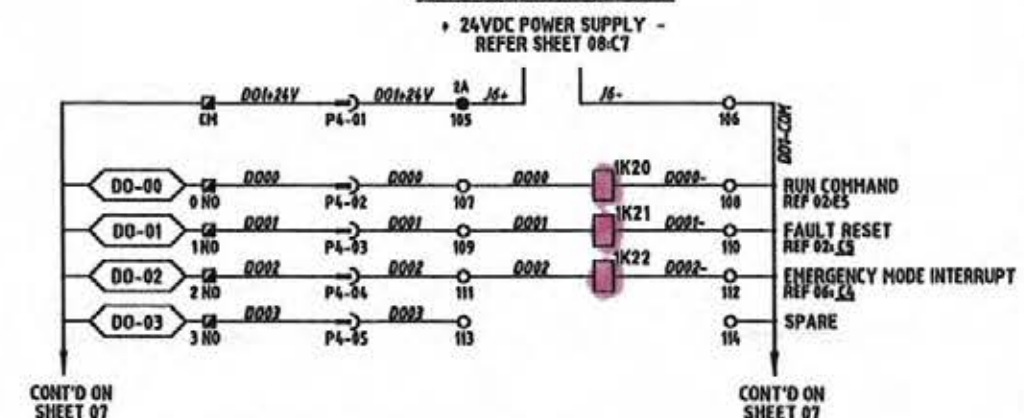

LEGEND:


- ▲ SWITCHBOARD POWER TERMINAL
- ⊗ SWITCHBOARD CONTROL TERMINAL
- SWITCHBOARD GENERATOR TERM.
- ⊗ FIELD TERMINAL
- ⊗ PLC TERMINAL
- ⊗ RTU TERMINAL
- ⊗ SS TERMINAL
- PLC/RTU MARSH FUSE TERMINAL
- PLC/RTU MARSH LNK TERMINAL
- 10 RTU → DISCONNECT PLUG
- DI-02 RTU DIGITAL INPUT
- DO-02 RTU DIGITAL OUTPUT
- AI-02 RTU ANALOGUE INPUT
- AO-02 RTU ANALOGUE OUTPUT


NOTES

1. INCOMING GENSET, MAIN, PUMP & DIST. BOARD CIRCUIT BREAKERS SHALL BE LINE SIDE SHROUDED.
2. CIRCUIT BREAKER RATINGS TO SUIT FAULT LEVEL & LOAD ENSURE MIN TYPE 1 CO-ORDINATION WITH CONTACTORS & OVERLOADS TO IEC 947-4-1.
3. ALL WIRES & CABLE CORES ARE FERRULED WITH GRAFOPLAST S12000 COMPATIBLE LABELLING.
4. FAULT LEVEL OF 20kA AT 415V FOR 0.2sec.


Sheet 02

FOR CONSTRUCTION


| | | | | | | | | | | | |
|-------------------------|-----------|-----------------|--------------|-------------------------------|-------------------|------------------------------|----------|---|--|--|---|
| ISSUED FOR CONSTRUCTION | P.H. A.W. | DRAFTING CHECK | P.HAGUE | Original Signed by GANDERSON | 09-04-10 | Original Signed by KVAHEESAN | 13-04-10 |  QUEENSLAND UrbanUtilities A DIVISION OF THE BREBME CITY COUNCIL | SITE SP117 SALTASH STREET SEWAGE PUMP STATION | TITLE PUMP No1 SCHEMATIC DIAGRAM | SHEET No. 2 Queensland Urban Utilities DRAWING No. 486/5/7-0180-002 AMEND. A |
| SUBMITTED FOR TENDER | P.H. A.W. | CAD FILE | A.WITTHOFT | Original signed by A.WITTHOFT | 8895 09-04-10 | Original Signed by P.SHERIFF | 12-04-10 | | | | |
| AMENDMENT | DRN. APD. | B.C.G. FILE No. | 07-0180set_A | DESIGN CHECK | R.P.E.O. No. DATE | CLIENT DELEGATE | DATE | | | | |
| | | | | | | | | | | | |

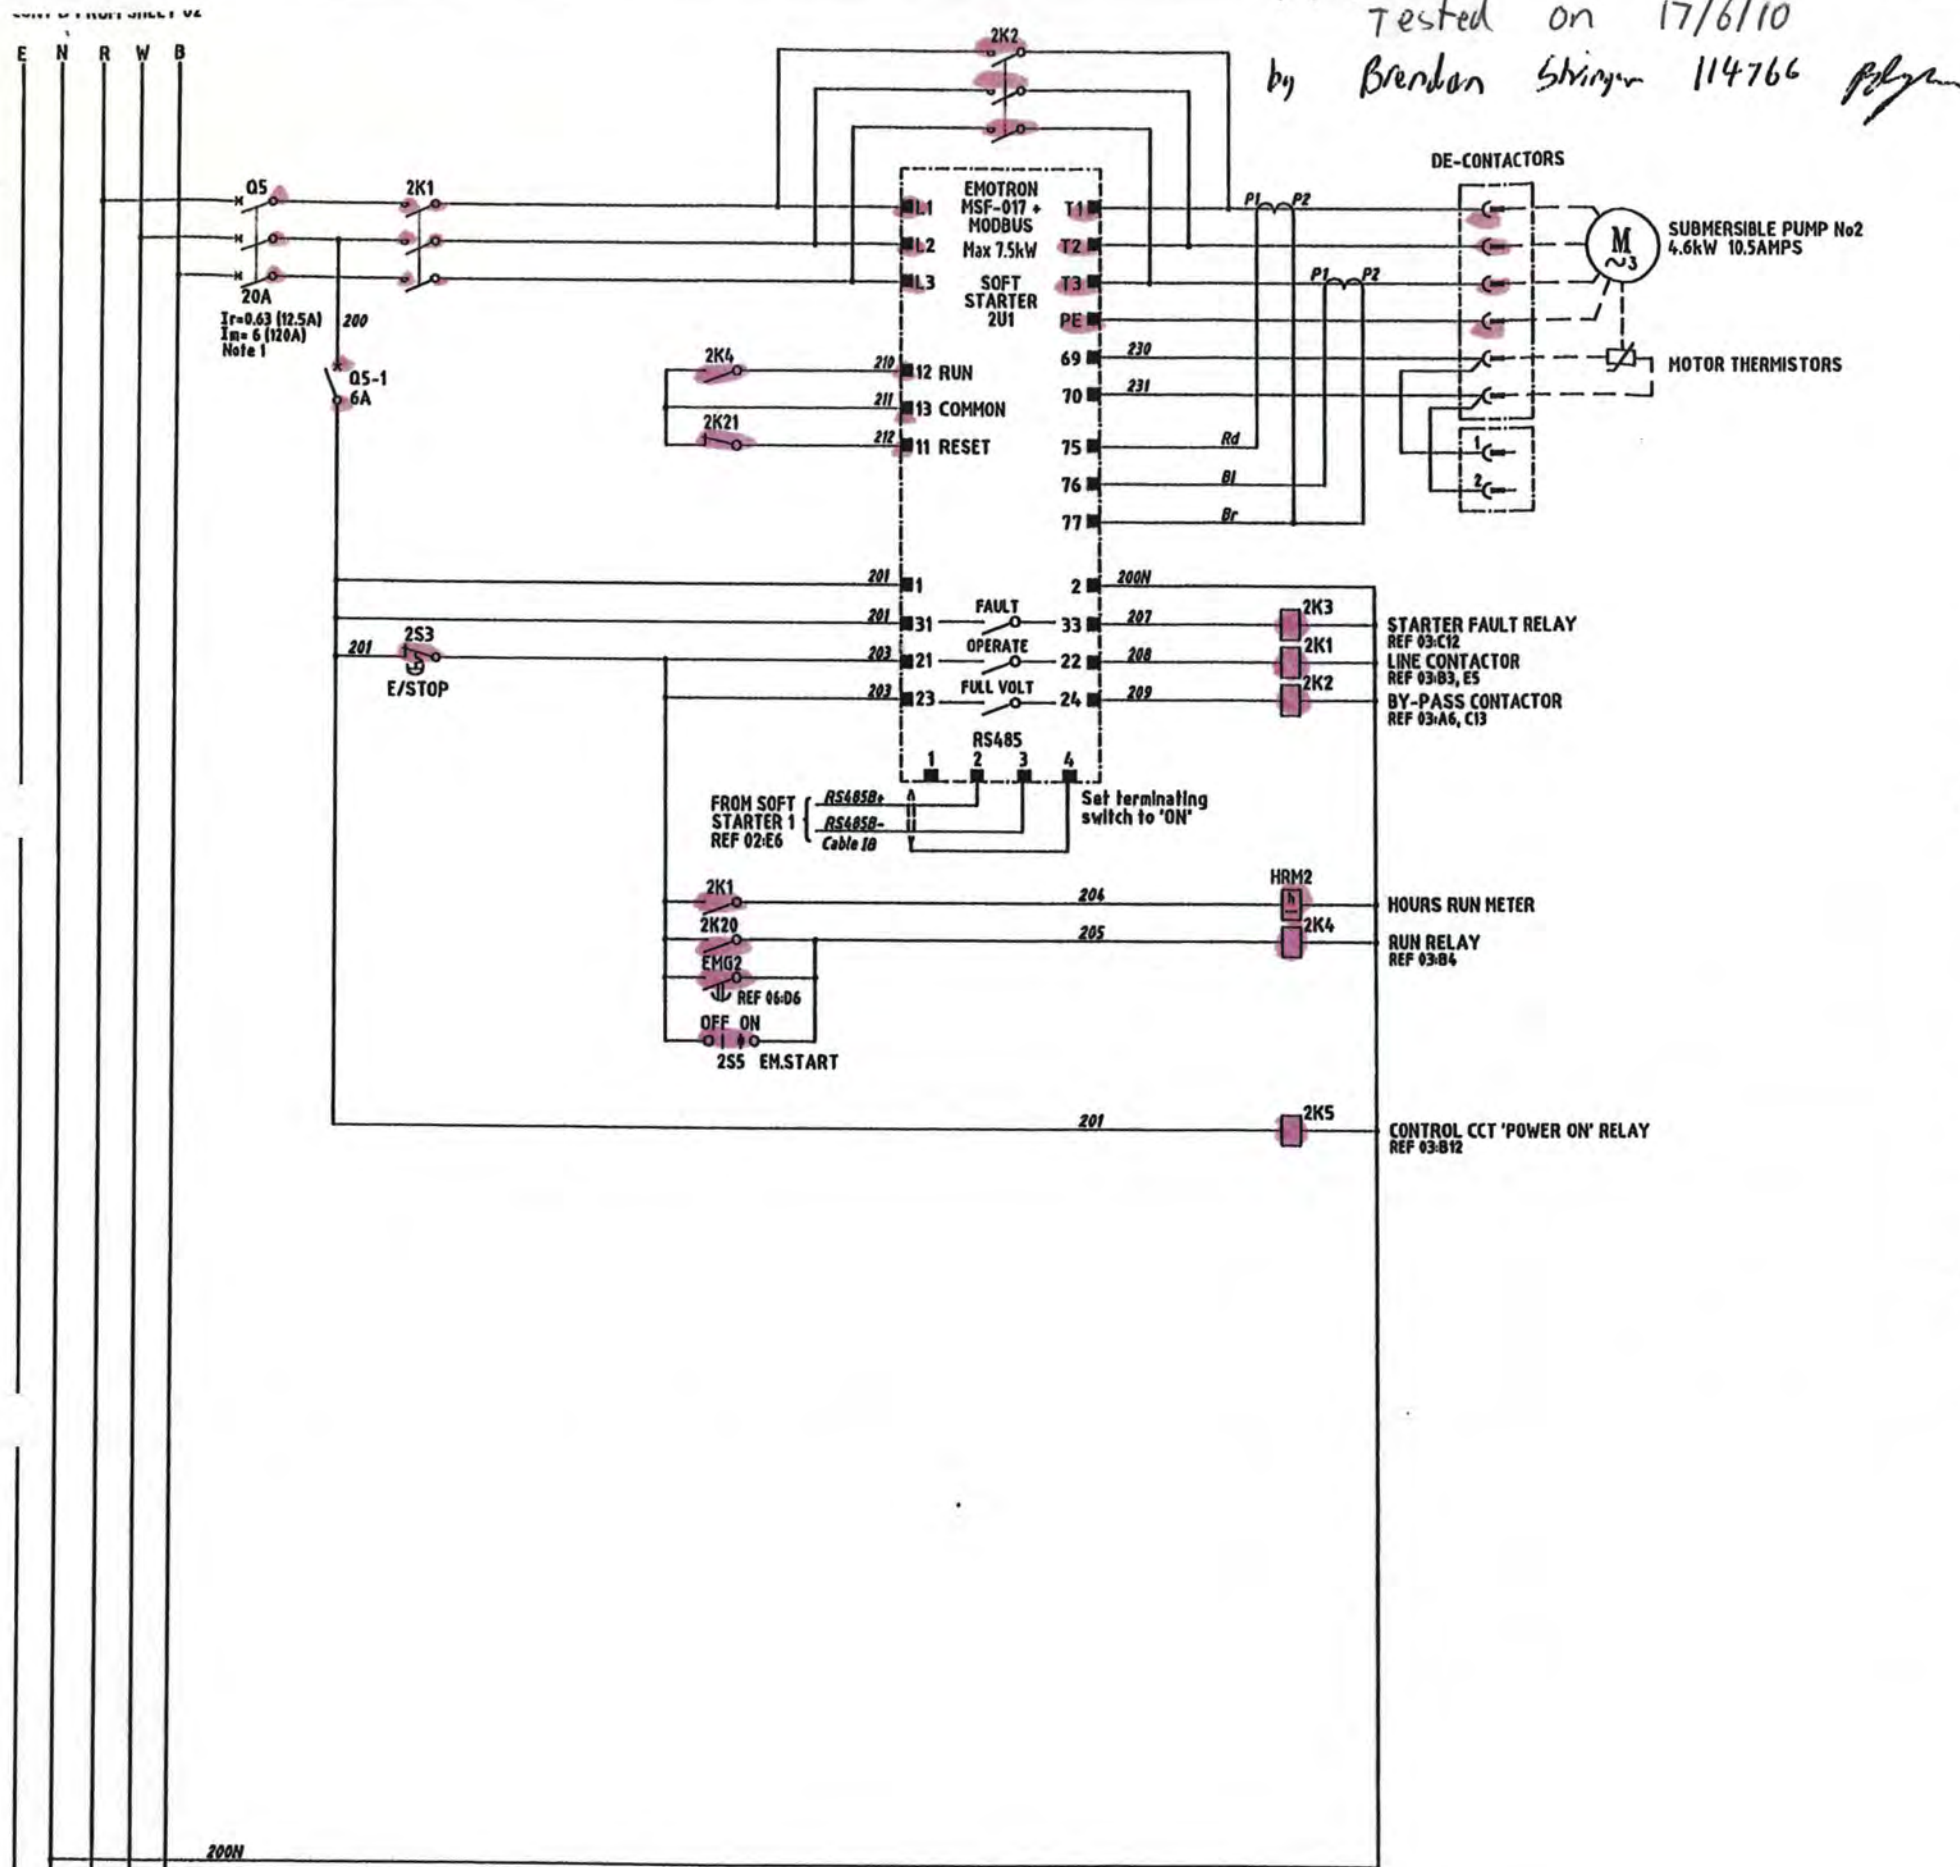

RTU DIGITAL INPUTS

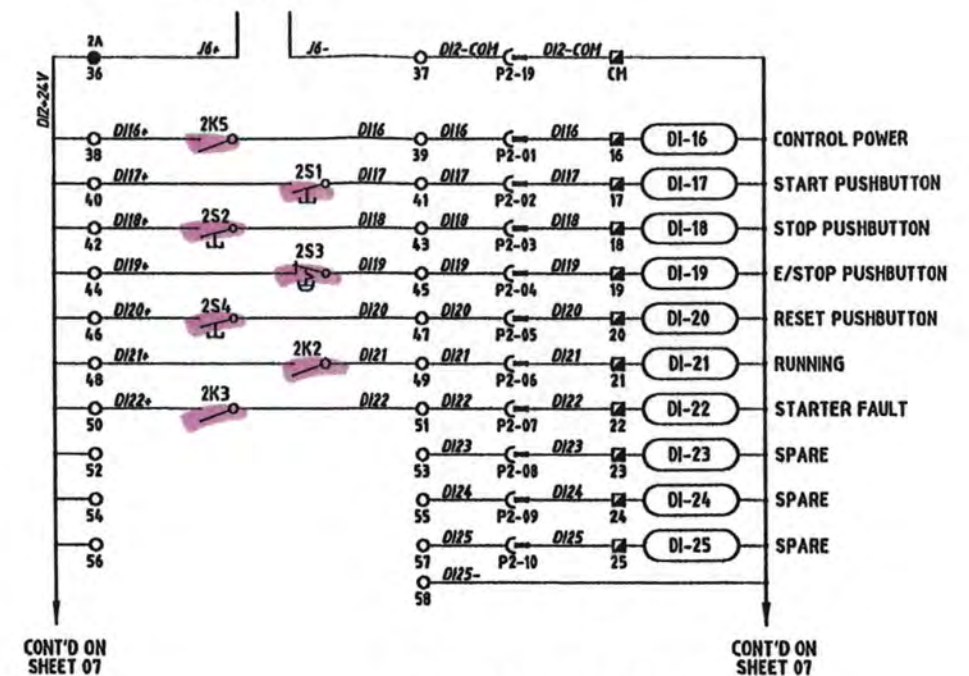+ 24VDC POWER SUPPLY -
REFER SHEET 08:C7

RTU DIGITAL OUTPUTS

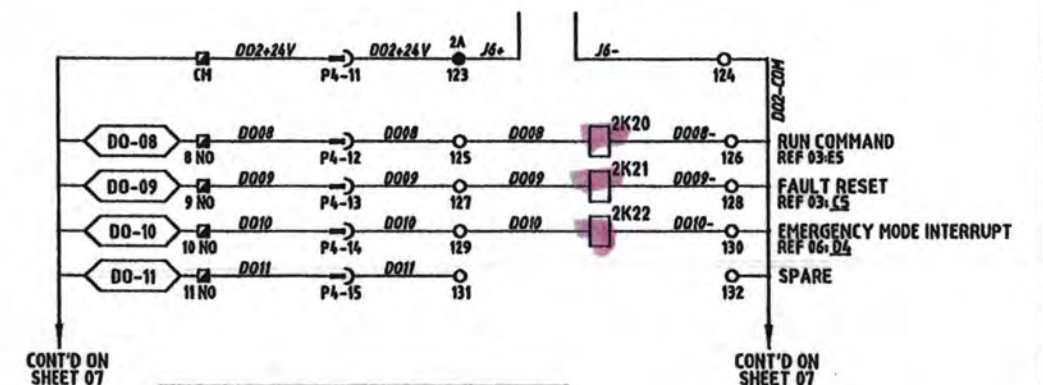+ 24VDC POWER SUPPLY -
REFER SHEET 08:C7

LEGEND:

- ▲ SWITCHBOARD POWER TERMINAL
- SWITCHBOARD CONTROL TERMINAL
- SWITCHBOARD GENERATOR TERM.
- ✕ FIELD TERMINAL
- PLC TERMINAL
- RTU TERMINAL
- SS TERMINAL
- PLC/RTU MARSH. FUSE TERMINAL
- PLC/RTU MARSH. LINK TERMINAL
- TO RTU → DISCONNECT PLUG
- DI-02 RTU DIGITAL INPUT
- DO-02 RTU DIGITAL OUTPUT
- AI-02 RTU ANALOGUE INPUT
- AO-02 RTU ANALOGUE OUTPUT

NOTES

1. INCOMING GENSET, MAIN, PUMP & DIST. BOARD CIRCUIT BREAKERS SHALL BE LINE SIDE SHROUDED.
2. CIRCUIT BREAKER RATINGS TO SUIT FAULT LEVEL & LOAD ENSURE MIN TYPE 1 CO-ORDINATION WITH CONTACTORS & OVERLOADS TO IEC 947-4-1.
3. ALL WIRES & CABLE CORES ARE FERRULED WITH GRAFOPLAST S12000 COMPATIBLE LABELLING.
4. FAULT LEVEL OF 20kA AT 415V FOR 0.2sec.




Sheet 03

FOR CONSTRUCTION

| | | | | | | | | | | | | |
|-------------------------|------|------|-----------------|--------------|-------------------------------|-------------------|-------------------------------|----------|---|---|---|--|
| ISSUED FOR CONSTRUCTION | P.H. | A.W. | DRAFTING CHECK | P.HAGUE | Original Signed by G.ANDERSON | 09-04-10 | Original Signed by K.VAHEESAN | 13-04-10 | A DIVISION OF THE BRISBANE CITY COUNCIL | SITE SP117 SALTASH STREET SEWAGE PUMP STATION | TITLE PUMP No2 SCHEMATIC DIAGRAM | SHEET No. 3 Queensland Urban Utilities DRAWING No. 486/5/7-0180-003 AMEND. A |
| ISSUED FOR TENDER | P.H. | A.W. | CAD FILE | A.WITTHOFT | DESIGN | R.P.E.Q. No. DATE | PRINCIPAL DESIGN MANAGER | DATE | | | | |
| AMENDMENT | DRN. | APD. | S.C.O. FILE No. | 67-0180set_A | Original signed by A.WITTHOFT | 8895 09-04-10 | Original Signed by P.SHERIFF | 12-04-10 | | | | |
| | | | | | DESIGN CHECK | R.P.E.Q. No. DATE | CLIENT DELEGATE | DATE | | | | |


by Brendan Stanger 114766

EMERGENCY PUMPING MODE (240VAC)

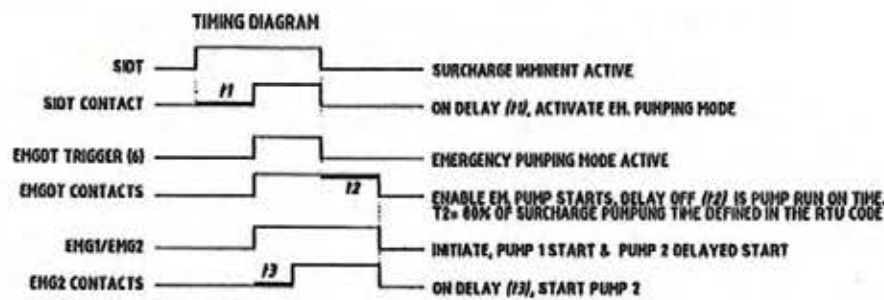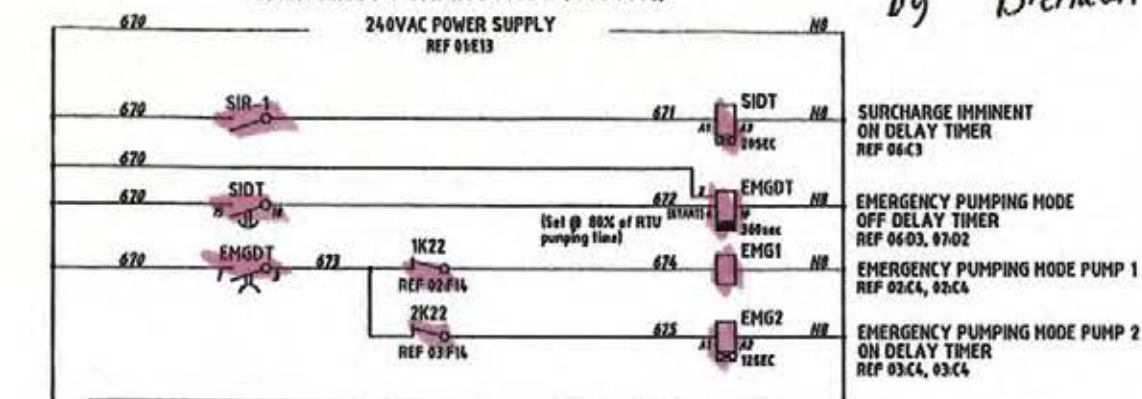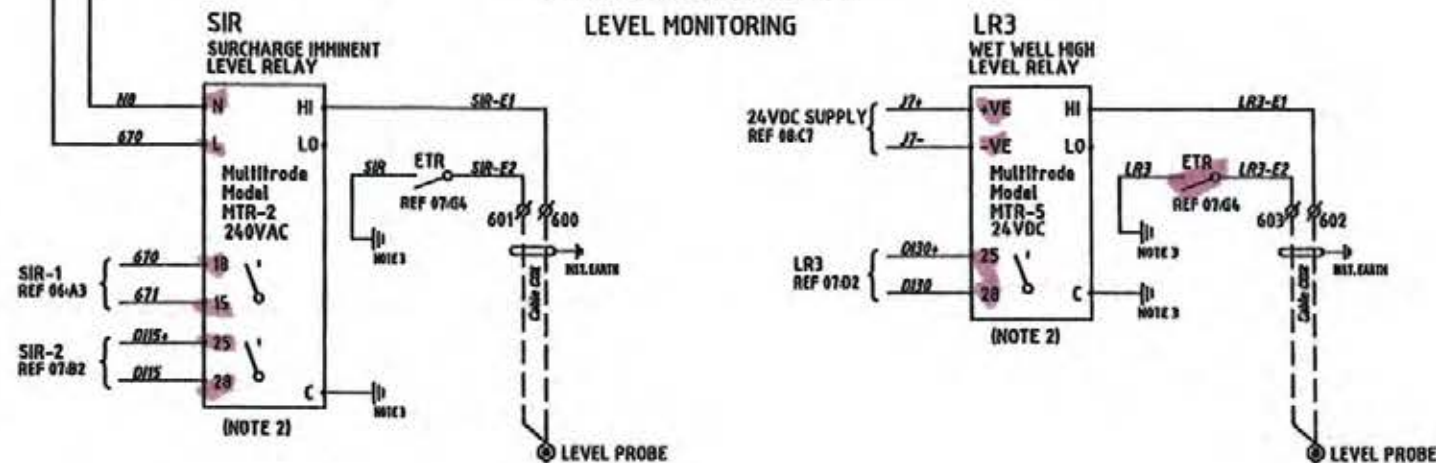COMMON CONTROL SECTION
LEVEL MONITORING

COMMON CONTROL SECTION

SWITCHBOARD INTERNAL LIGHTING

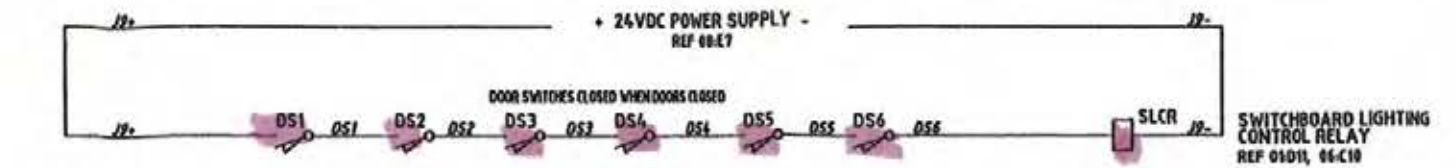


RTU DIGITAL INPUTS



ATS SECTION

SURGE DIVERSERS

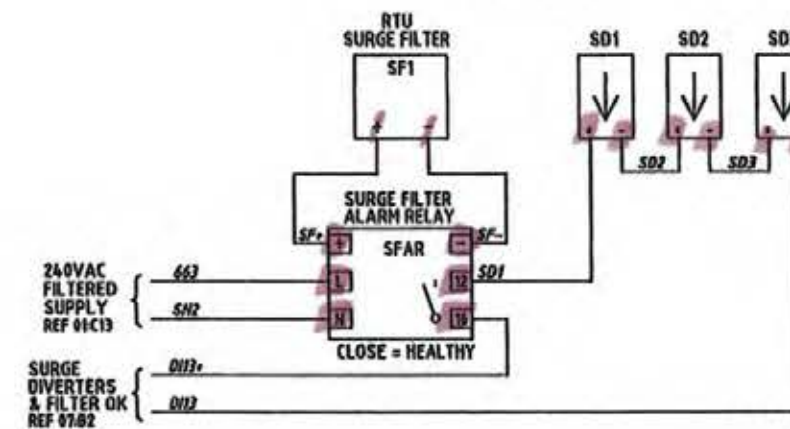

LEGEND:

- A SWITCHBOARD POWER TERMINAL
- SWITCHBOARD CONTROL TERMINAL
- SWITCHBOARD GENERATOR TERM.
- ⊗ FIELD TERMINAL
- PLC TERMINAL
- RTU TERMINAL
- SS TERMINAL
- PLC/RTU MARSH. FUSE TERMINAL
- PLC/RTU MARSH. LINK TERMINAL
- TO RTU → DISCONNECT PLUG
- DI-02 RTU DIGITAL INPUT
- DO-02 RTU DIGITAL OUTPUT
- AI-02 RTU ANALOGUE INPUT
- AO-02 RTU ANALOGUE OUTPUT

NOTES



- ALL WIRES & CABLE CORES ARE FERRULED WITH GRAFOPLAST SIZ2000 COMPATIBLE LABELLING.
- SET DIPSWITCH TO 'DISCHARGE' MODE.
- RUN SEPARATE DEDICATED EARTH CONDUCTOR TO EARTH BAR.

Sheet 06

FOR CONSTRUCTION


| | | | | | | | | | | | | | |
|-------|-------------------------|------|------|-----------------|-------------|-------------------------------|-------------------|-------------------------------|----------|--|---|--|--|
| 04.10 | ISSUED FOR CONSTRUCTION | P.H. | A.W. | DRAFTED | P.HAGUE | Original Signed by G.ANDERSON | 09-04-10 | Original Signed by K.VAHEESAN | 13-04-10 | | SITE SP117 SALTASH STREET SEWAGE PUMP STATION | TITLE COMMON CONTROLS SCHEMATIC DIAGRAM | SHEET No. 8 Queensland Urban Utilities DRAWING No. 486/5/7-0180-006 AMEHD, A |
| 04.10 | ISSUED FOR TENDER | P.H. | A.W. | DRAFTING CHECK | A.WITTHOFT | Original Signed by A.WITTHOFT | 09-04-10 | Original Signed by P.SHERROFF | 13-04-10 | | | | |
| DATE | AMENDMENT | DRN. | APD. | B.O.D. FILE No. | 67-0180-006 | DESIGN CHECK | R.P.E.O. No. DATE | CLIENT DELEGATE | DATE | | | | |

RTU DIGITAL INPUTS

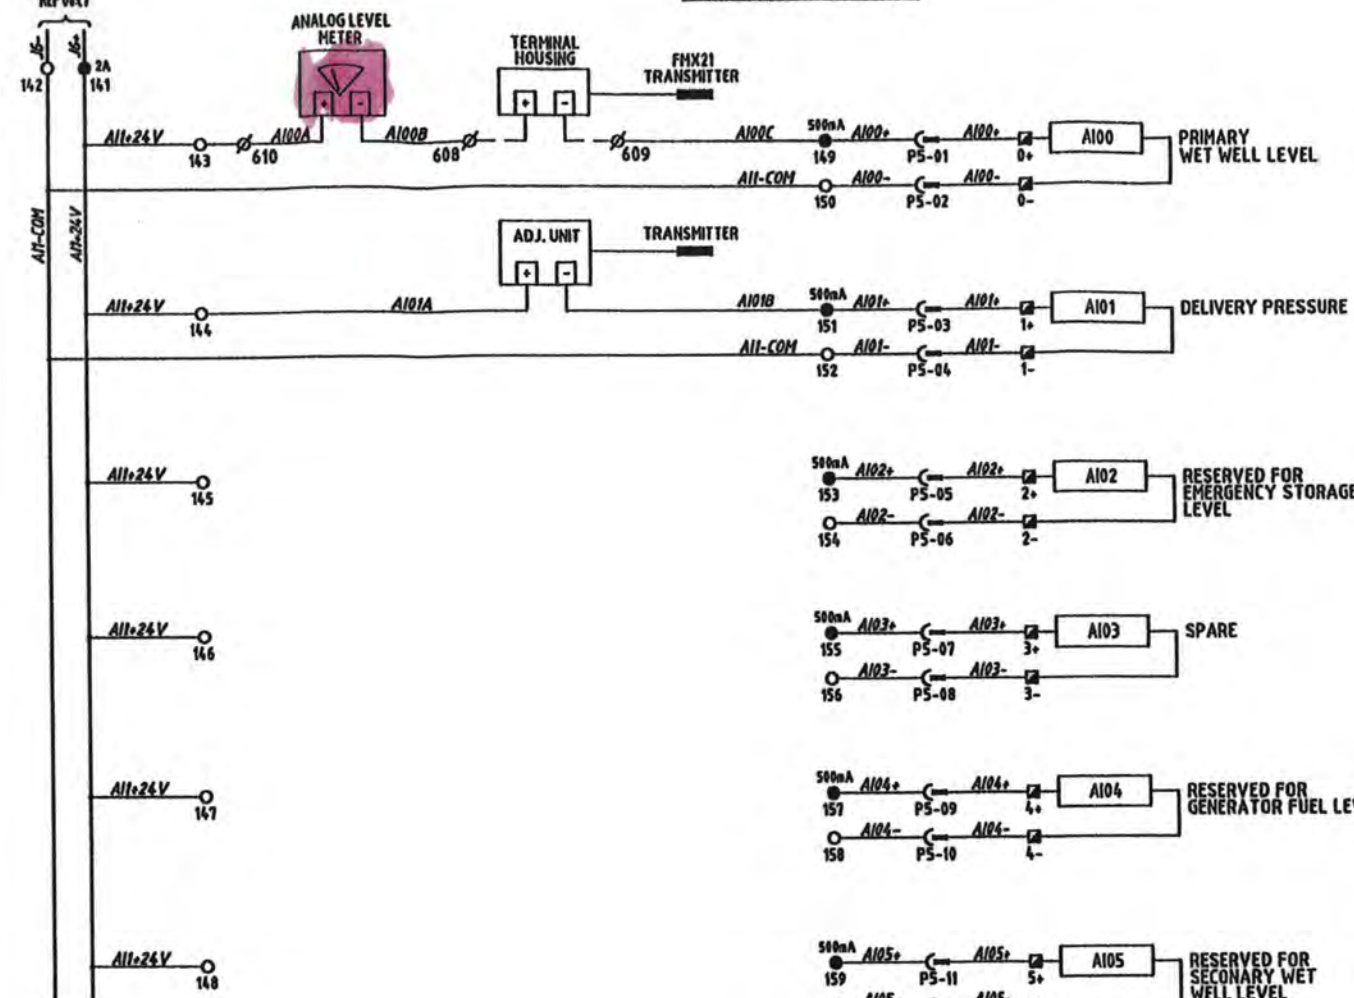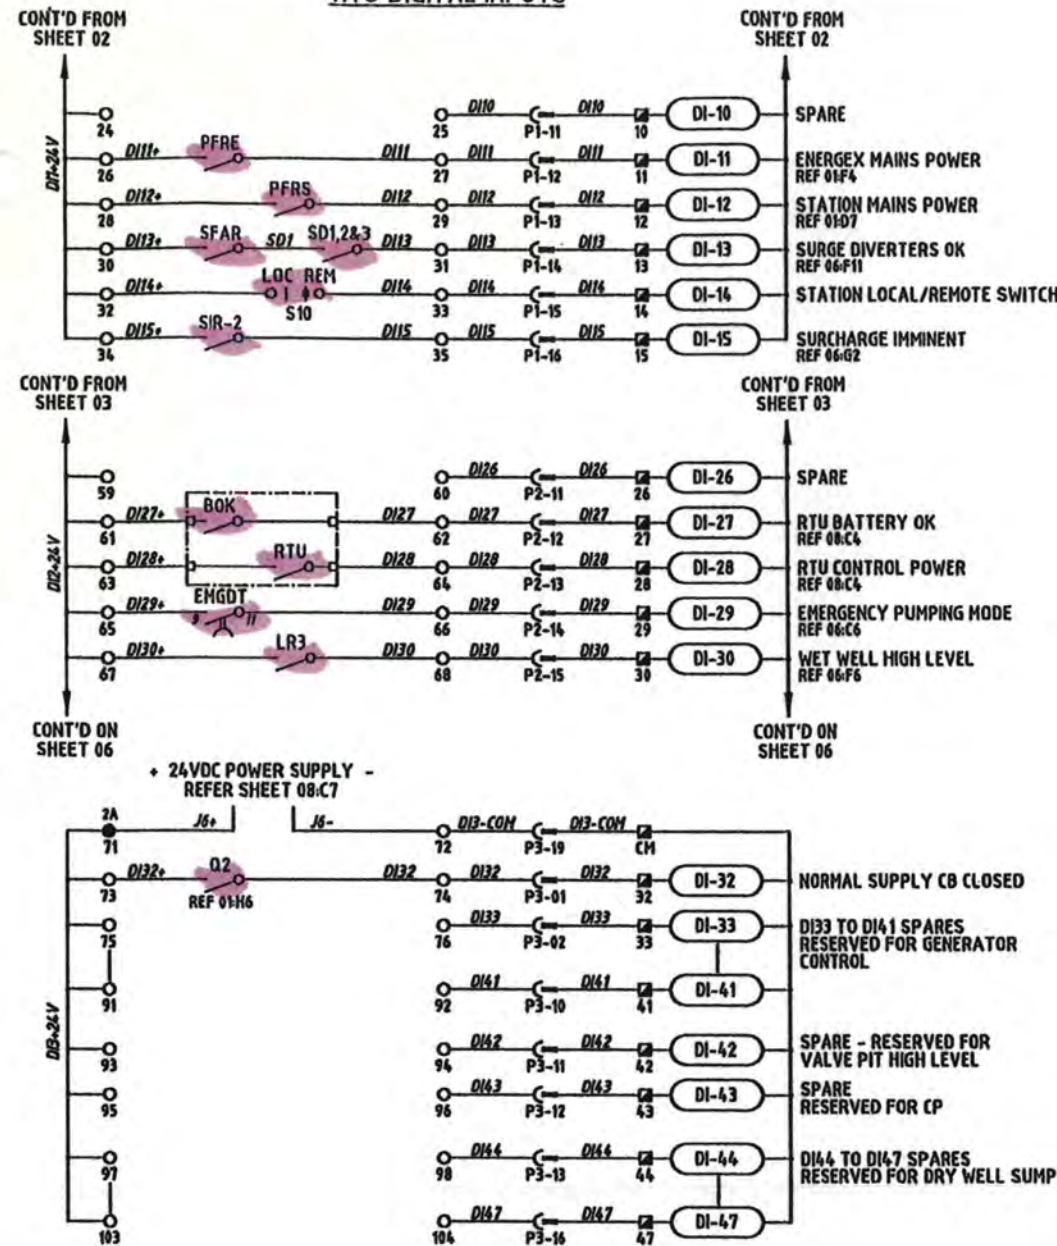


Tested on the 17/6/10 by
Brendan Stringer Rly
114766

RTU DIGITAL OUTPUTS

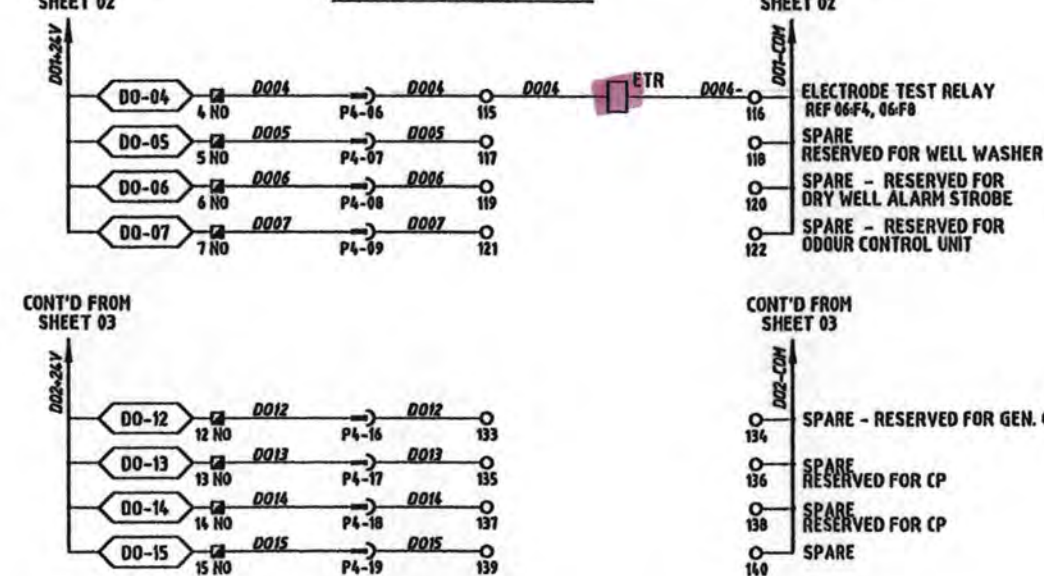

RTU ANALOG OUTPUTS

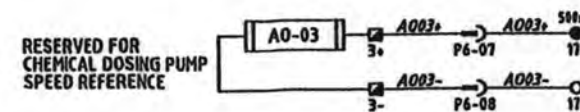

NOTES

1. ALL WIRES & CABLE CORES ARE FERRULED WITH GRAFOPLAST S12000 COMPATIBLE LABELLING.

LEGEND:

- ▲ SWITCHBOARD POWER TERMINAL
- SWITCHBOARD CONTROL TERMINAL
- SWITCHBOARD GENERATOR TERM.
- ⊗ FIELD TERMINAL
- PLC TERMINAL
- RTU TERMINAL
- SS TERMINAL
- PLC/RTU MARSH. FUSE TERMINAL
- PLC/RTU MARSH. LINK TERMINAL
- TO RTU → DISCONNECT PLUG
- DI-02 RTU DIGITAL INPUT
- DO-02 RTU DIGITAL OUTPUT
- AI-02 RTU ANALOGUE INPUT
- AO-02 RTU ANALOGUE OUTPUT

Sheet 07

FOR CONSTRUCTION

SHEET No. 7
Queensland Urban Utilities DRAWING No. 486/5/7-0180-007
AMEND. A

| | | | | | | | | | |
|-------|----------------------|------|------|-----------------|-------------|-------------------------------|-------------------|-------------------------------|----------|
| 04.10 | UED FOR CONSTRUCTION | P.H. | A.W. | DRAFTING CHECK | A.WITTHOFT | Original Signed by G.ANDERSON | 09-04-10 | Original Signed by K.VAHEESAN | 13-04-10 |
| 04.10 | UED FOR TENDER | P.H. | A.W. | CAD FILE | 87-0180-007 | Original signed by A.WITTHOFT | 8895 09-04-10 | Original Signed by P.SHERRIFF | 12-04-10 |
| DATE | AMENDMENT | DRN. | APD. | B.O.C. FILE No. | | DESIGN CHECK | R.P.E.O. No. DATE | CLIENT DELEGATE | DATE |







SITE SP117
SALTASH STREET
SEWAGE PUMP STATION

TITLE COMMON RTU I/O
SCHEMATIC DIAGRAM

Q3184 WATER SUPPLY 2008 Drafting 03/08/08 Rev 01/08/08 2. BOWEN/AGE/NETWORKS/SP117 Saltash Sewage Pump Station For Construction 07-0180-007.dwg Last Saved by 078548 on 04/04/2010 16:18:10 AM

test on the 17/6/10 by
Brendan Strainy Plyn 114766

PUMP 2
REFER SHEET 03

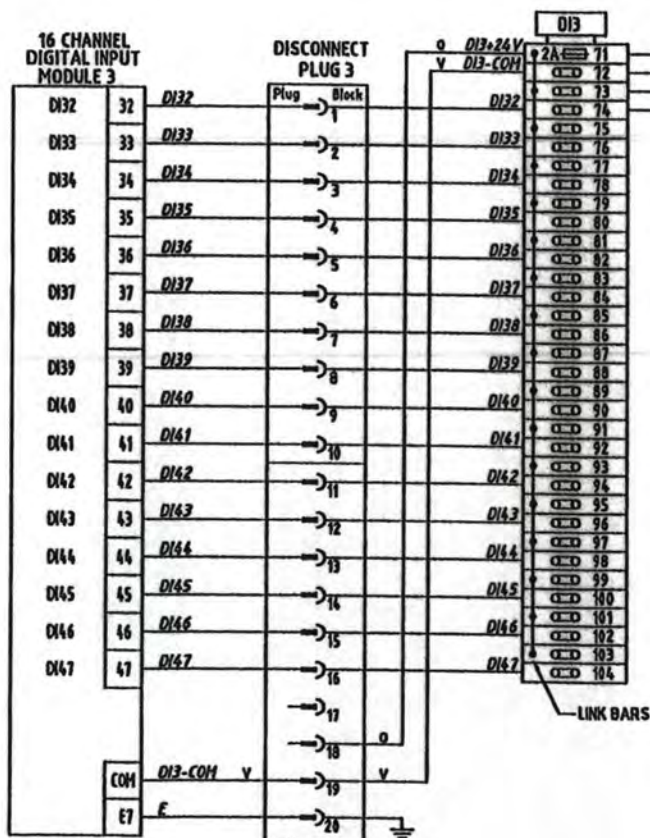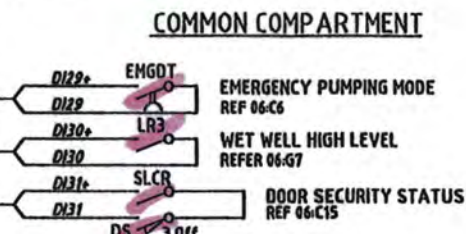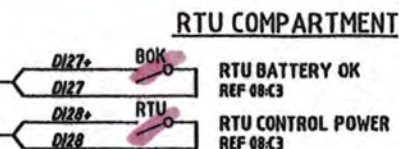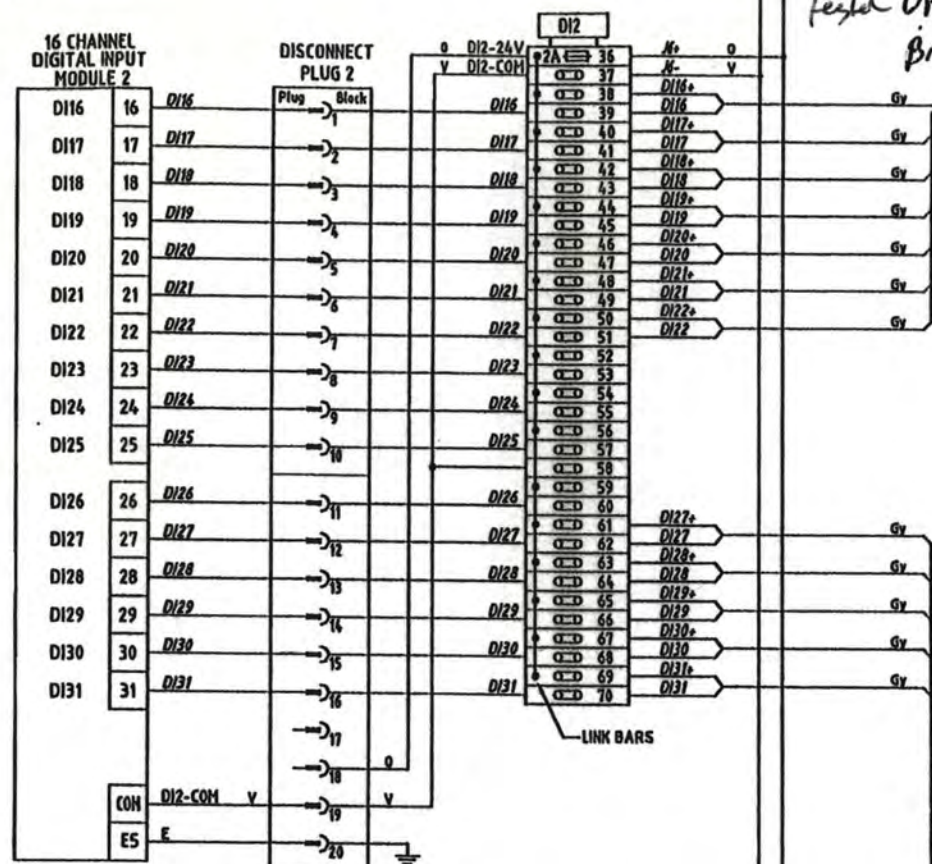

- LEGEND:**
- C77 CABLE IDENTIFIER
 - TO RTU → DISCONNECT PLUG
 - ⊞ FUSE TERMINAL
 - ⊞ DISCONNECT LINK TERMINAL

- NOTES**
- ALL WIRES & CABLE CORES ARE FERRULED WITH GRAFOPLAST S12000 COMPATIBLE LABELLING.
 - ALL FUSES ARE 500mA EXCEPT WHERE NOTED OTHERWISE.

Sheet 10

FOR CONSTRUCTION


| | | | | | | | | | |
|-------------------------------|-------------------------------------|--------------------|---|--|--|--|---|--|---|
| 04.10 ISSUED FOR CONSTRUCTION | P.H. A.W. DRAFTING CHECK | P.H. A.W. CAD FILE | Original Signed by GANDERSON 09-04-10 R.P.E.Q. No. DATE | Original Signed by K.VAHEEBAN 13-04-10 PRINCIPAL DESIGN MANAGER DATE | Original Signed by P.SHERIFF 12-04-10 CLIENT DELEGATE DATE | UrbanUtilities A DIVISION OF THE BRISBANE CITY COUNCIL | SITE SP117 SALTASH STREET SEWAGE PUMP STATION | TITLE RTU DIGITAL INPUTS TERMINATION DIAGRAM | SHEET No. 10 Queensland Urban Utilities DRAWING No. 486/5/7-0180-010 AMEND. A |
| 04.10 ISSUED FOR TENDER | P.H. A.W. DRN. APD. B.C.C. FILE No. | P.H. A.W. CAD FILE | Original signed by AMITHOFT 8895 09-04-10 R.P.E.Q. No. DATE | Original signed by P.SHERIFF 12-04-10 CLIENT DELEGATE DATE | | | | | |

RTU COMPARTMENT


MITS RTU
MD3311 EA

SWITCHBOARD



FIELD

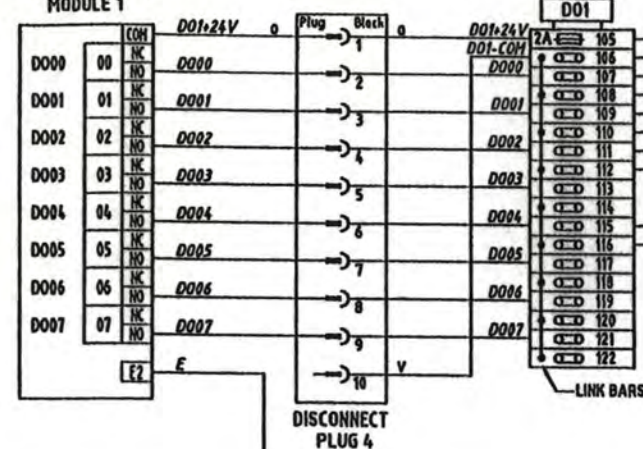8 CHANNEL
DIGITAL OUTPUT
MODULE 1


STARTER COMPARTMENT

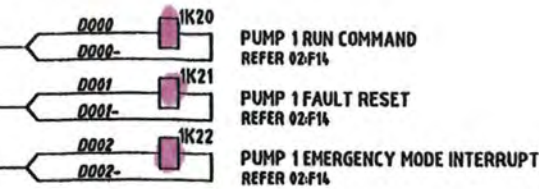

COMMON COMPARTMENT

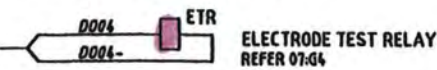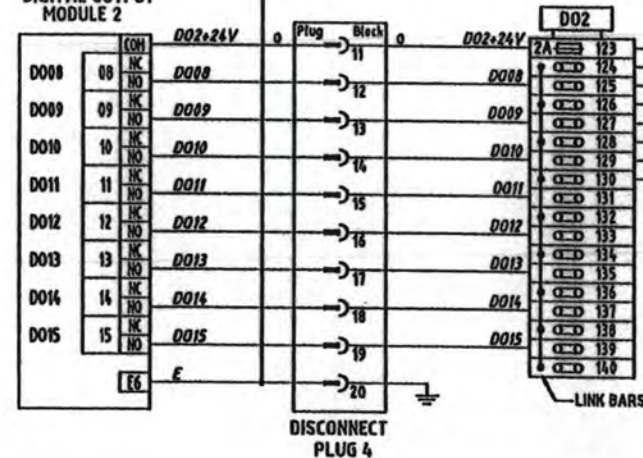8 CHANNEL
DIGITAL OUTPUT
MODULE 2

STARTER COMPARTMENT

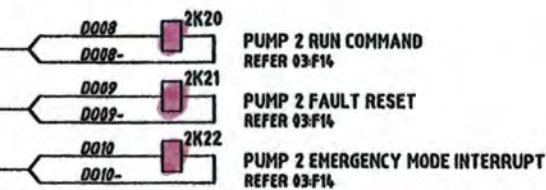

LEGEND:

| | |
|--|------------------------------|
| | CABLE IDENTIFIER |
| | DISCONNECT PLUG |
| | SWITCHBOARD CONTROL TERMINAL |
| | FUSE TERMINAL |
| | DISCONNECT LINK TERMINAL |

NOTES

1. ALL WIRES & CABLE CORES ARE FERRULED WITH GRAFOPLAST SIZ000 COMPATIBLE LABELLING.
2. ALL FUSES ARE 500mA EXCEPT WHERE NOTED OTHERWISE.


Sheet 11

FOR CONSTRUCTION

| | | | | | | | | | | | | | |
|--------------------------|-------------------------|------|------|-----------------|------------|-------------------------------|------------------|-------------------------------|----------|---|---|--|--|
| 04.10 | ISSUED FOR CONSTRUCTION | P.H. | A.W. | DRAFTING CHECK | P.HAGUE | Original Signed by G.ANDERSON | 09-04-10 | Original Signed by K.VAHEESAN | 13-04-10 | A DIVISION OF THE BRISBANE CITY COUNCIL | SITE SP117 SALTASH STREET SEWAGE PUMP STATION | TITLE RTU DIGITAL OUTPUTS TERMINATION DIAGRAM | SHEET No. 11 Queensland Urban Utilities DRAWING No. 486/5/7-0180-011 AMEND. A |
| 04 | ISSUED FOR TENDER | P.H. | A.W. | CAD FILE | 67-0180aet | Original signed by A.WITHOFT | 0895 09-04-10 | Original Signed by P.SHERIFF | 12-04-10 | | | | |
| 01 | AMENDMENT | DRN. | APD. | B.C.C. FILE No. | | DESIGN CHECK | R.P.E.Q.No. DATE | CLIENT DELEGATE | DATE | | | | |
| 1910PLATE 5A-3P-SS Ver10 | | | | | | | | | | | | | |

RTU COMPARTMENT

MITS RTU
MD3311 EA

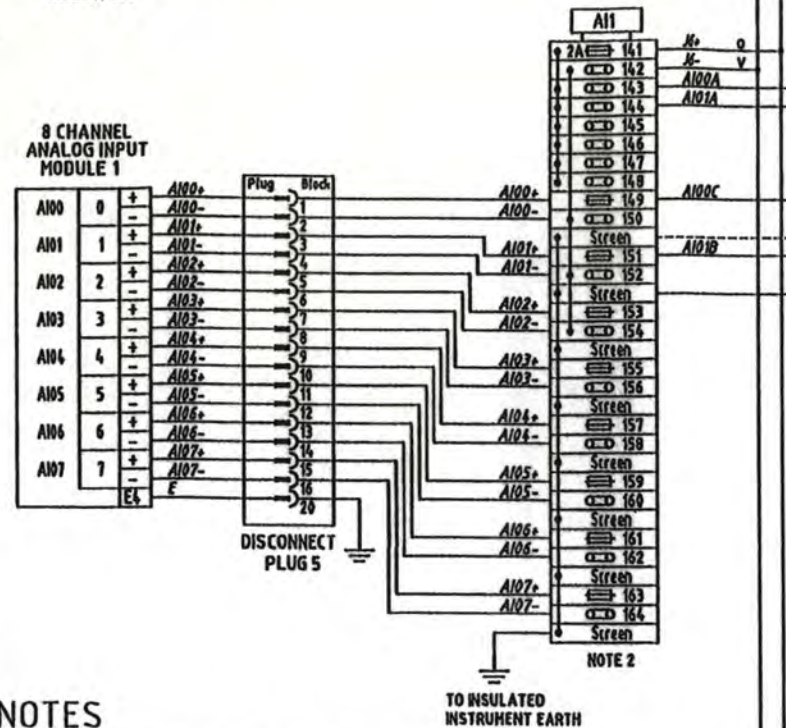

NOTES

1. ALL WIRES & CABLE CORES ARE FERRULED WITH GRAFOPLAST S12000 COMPATIBLE LABELLING.
2. ALL FUSES ARE 500mA EXCEPT WHERE NOTED OTHERWISE.

tested on 17/6/10 by
Brendan Stringer 114766
Blyn

COMMON COMPARTMENT



ANALOG LEVEL METER

AI00A
AI00B
AI00C
AI00A

AI01A
AI01B
AI01C
AI01A

AI02A
AI02B
AI02C
AI02A

AI03A
AI03B
AI03C
AI03A

AI04A
AI04B
AI04C
AI04A

AI05A
AI05B
AI05C
AI05A

AI06A
AI06B
AI06C
AI06A

AI07A
AI07B
AI07C
AI07A

AI08A
AI08B
AI08C
AI08A

AI09A
AI09B
AI09C
AI09A

AI10A
AI10B
AI10C
AI10A

AI11A
AI11B
AI11C
AI11A

AI12A
AI12B
AI12C
AI12A

AI13A
AI13B
AI13C
AI13A

AI14A
AI14B
AI14C
AI14A

AI15A
AI15B
AI15C
AI15A

AI16A
AI16B
AI16C
AI16A

AI17A
AI17B
AI17C
AI17A

AI18A
AI18B
AI18C
AI18A

AI19A
AI19B
AI19C
AI19A

AI20A
AI20B
AI20C
AI20A

AI21A
AI21B
AI21C
AI21A

AI22A
AI22B
AI22C
AI22A

AI23A
AI23B
AI23C
AI23A

AI24A
AI24B
AI24C
AI24A

AI25A
AI25B
AI25C
AI25A

AI26A
AI26B
AI26C
AI26A

AI27A
AI27B
AI27C
AI27A

AI28A
AI28B
AI28C
AI28A

AI29A
AI29B
AI29C
AI29A

AI30A
AI30B
AI30C
AI30A

AI31A
AI31B
AI31C
AI31A

AI32A
AI32B
AI32C
AI32A

AI33A
AI33B
AI33C
AI33A

AI34A
AI34B
AI34C
AI34A

AI35A
AI35B
AI35C
AI35A

AI36A
AI36B
AI36C
AI36A

AI37A
AI37B
AI37C
AI37A

AI38A
AI38B
AI38C
AI38A

AI39A
AI39B
AI39C
AI39A

AI40A
AI40B
AI40C
AI40A

AI41A
AI41B
AI41C
AI41A

AI42A
AI42B
AI42C
AI42A

AI43A
AI43B
AI43C
AI43A

AI44A
AI44B
AI44C
AI44A

AI45A
AI45B
AI45C
AI45A

AI46A
AI46B
AI46C
AI46A

AI47A
AI47B
AI47C
AI47A

AI48A
AI48B
AI48C
AI48A

AI49A
AI49B
AI49C
AI49A

AI50A
AI50B
AI50C
AI50A

AI51A
AI51B
AI51C
AI51A

AI52A
AI52B
AI52C
AI52A

AI53A
AI53B
AI53C
AI53A

AI54A
AI54B
AI54C
AI54A

AI55A
AI55B
AI55C
AI55A

AI56A
AI56B
AI56C
AI56A

AI57A
AI57B
AI57C
AI57A

AI58A
AI58B
AI58C
AI58A

AI59A
AI59B
AI59C
AI59A

AI60A
AI60B
AI60C
AI60A

AI61A
AI61B
AI61C
AI61A

AI62A
AI62B
AI62C
AI62A

AI63A
AI63B
AI63C
AI63A

AI64A
AI64B
AI64C
AI64A

AI65A
AI65B
AI65C
AI65A

AI66A
AI66B
AI66C
AI66A

AI67A
AI67B
AI67C
AI67A

AI68A
AI68B
AI68C
AI68A

AI69A
AI69B
AI69C
AI69A

AI70A
AI70B
AI70C
AI70A

AI71A
AI71B
AI71C
AI71A

AI72A
AI72B
AI72C
AI72A

AI73A
AI73B
AI73C
AI73A

AI74A
AI74B
AI74C
AI74A

AI75A
AI75B
AI75C
AI75A

AI76A
AI76B
AI76C
AI76A

AI77A
AI77B
AI77C
AI77A

AI78A
AI78B
AI78C
AI78A

AI79A
AI79B
AI79C
AI79A

AI80A
AI80B
AI80C
AI80A

AI81A
AI81B
AI81C
AI81A

AI82A
AI82B
AI82C
AI82A

AI83A
AI83B
AI83C
AI83A

AI84A
AI84B
AI84C
AI84A

AI85A
AI85B
AI85C
AI85A

AI86A
AI86B
AI86C
AI86A

AI87A
AI87B
AI87C
AI87A

AI88A
AI88B
AI88C
AI88A

AI89A
AI89B
AI89C
AI89A

AI90A
AI90B
AI90C
AI90A

AI91A
AI91B
AI91C
AI91A

AI92A
AI92B
AI92C
AI92A

AI93A
AI93B
AI93C
AI93A

AI94A
AI94B
AI94C
AI94A

AI95A
AI95B
AI95C
AI95A

AI96A
AI96B
AI96C
AI96A

AI97A
AI97B
AI97C
AI97A

AI98A
AI98B
AI98C
AI98A

AI99A
AI99B
AI99C
AI99A

AI100A
AI100B
AI100C
AI100A

AI101A
AI101B
AI101C
AI101A

AI102A
AI102B
AI102C
AI102A

AI103A
AI103B
AI103C
AI103A

AI104A
AI104B
AI104C
AI104A

AI105A
AI105B
AI105C
AI105A

AI106A
AI106B
AI106C
AI106A

AI107A
AI107B
AI107C
AI107A

AI108A
AI108B
AI108C
AI108A

AI109A
AI109B
AI109C
AI109A

AI110A
AI110B
AI110C
AI110A

AI111A
AI111B
AI111C
AI111A

AI112A
AI112B
AI112C
AI112A

AI113A
AI113B
AI113C
AI113A

AI114A
AI114B
AI114C
AI114A

AI115A
AI115B
AI115C
AI115A

AI116A
AI116B
AI116C
AI116A

AI117A
AI117B
AI117C
AI117A

AI118A
AI118B
AI118C
AI118A

AI119A
AI119B
AI119C
AI119A

AI120A
AI120B
AI120C
AI120A

AI121A
AI121B
AI121C
AI121A

AI122A
AI122B
AI122C
AI122A

AI123A
AI123B
AI123C
AI123A

AI124A
AI124B
AI124C
AI124A

AI125A
AI125B
AI125C
AI125A

AI126A
AI126B
AI126C
AI126A

AI127A
AI127B
AI127C
AI127A

AI128A
AI128B
AI128C
AI128A

AI129A
AI129B
AI129C
AI129A

AI130A
AI130B
AI130C
AI130A

AI131A
AI131B
AI131C
AI131A

AI132A
AI132B
AI132C
AI132A

AI133A
AI133B
AI133C
AI133A

AI134A
AI134B
AI134C
AI134A

AI135A
AI135B
AI135C
AI135A

AI136A
AI136B
AI136C
AI136A

AI137A
AI137B
AI137C
AI137A

AI138A
AI138B
AI138C
AI138A

AI139A
AI139B
AI139C
AI139A

AI140A
AI140B
AI140C
AI140A

AI141A
AI141B
AI141C
AI141A

AI142A
AI142B
AI142C
AI142A

AI143A
AI143B
AI143C
AI143A

AI144A
AI144B
AI144C
AI144A

AI145A
AI145B
AI145C
AI145A

AI146A
AI146B
AI146C
AI146A

AI147A
AI147B
AI147C
AI147A

AI148A
AI148B
AI148C
AI148A

AI149A
AI149B
AI149C
AI149A

AI150A
AI150B
AI150C
AI150A

AI151A
AI151B
AI151C
AI151A

AI152A
AI152B
AI152C
AI152A

AI153A
AI153B
AI153C
AI153A

AI154A
AI154B
AI154C
AI154A

AI155A
AI155B
AI155C
AI155A

AI156A
AI156B
AI156C
AI156A

AI157A
AI157B
AI157C
AI157A

AI158A
AI158B
AI158C
AI158A

AI159A
AI159B
AI159C
AI159A

AI160A
AI160B
AI160C
AI160A

AI161A
AI161B
AI161C
AI161A

AI162A
AI162B
AI162C
AI162A

AI163A
AI163B
AI163C
AI163A

AI164A
AI164B
AI164C
AI164A

AI165A
AI165B
AI165C
AI165A

AI166A
AI166B
AI166C
AI166A

AI167A
AI167B
AI167C
AI167A

AI168A
AI168B
AI168C
AI168A

AI169A
AI169B
AI169C
AI169A

AI170A
AI170B
AI170C
AI170A

AI171A
AI171B
AI171C
AI171A

AI172A
AI172B
AI172C
AI172A

AI173A
AI173B
AI173C
AI173A

AI174A
AI174B
AI174C
AI174A

AI175A
AI175B
AI175C
AI175A

AI176A
AI176B
AI176C
AI176A

AI177A
AI177B
AI177C
AI177A

AI178A
AI178B
AI178C
AI178A

AI179A
AI179B
AI179C
AI179A

AI180A
AI180B
AI180C
AI180A

AI181A
AI181B
AI181C
AI181A

AI182A
AI182B
AI182C
AI182A

AI183A
AI183B
AI183C
AI183A

AI184A
AI184B
AI184C
AI184A

SJ Electric 7623
Brendan Stringer 114766
17/6/10 Blyn



QUEENSLAND
UrbanUtilities

ABN 72 002 765 795

point to point copy

SP117 SALTASH STREET SEWAGE PUMPING STATION SITE COVER SHEET

| ELECTRICAL DRAWINGS INDEX | | | | | | |
|---------------------------|--|-------|-----------|---|--|--|
| DWG N° | TITLE | SHEET | REVISIONS | | | |
| 486/5/7-0180-000 | SITE COVER SHEET | 00 | 0 | A | | |
| 486/5/7-0180-001 | POWER DISTRIBUTION SCHEMATIC DIAGRAM | 01 | 0 | A | | |
| 486/5/7-0180-002 | PUMP 01 SCHEMATIC DIAGRAM | 02 | 0 | A | | |
| 486/5/7-0180-003 | PUMP 02 SCHEMATIC DIAGRAM | 03 | 0 | A | | |
| 486/5/7-0180-004 | RESERVED (SUMP PUMP) | 04 | | | | |
| 486/5/7-0180-005 | RESERVED (GENERATOR CONTROL) | 05 | | | | |
| 486/5/7-0180-006 | COMMON CONTROLS SCHEMATIC DIAGRAM | 06 | 0 | A | | |
| 486/5/7-0180-007 | COMMON RTU I/O SCHEMATIC DIAGRAM | 07 | 0 | A | | |
| 486/5/7-0180-008 | RTU POWER DISTRIBUTION SCHEMATIC DIAGRAM | 08 | 0 | A | | |
| 486/5/7-0180-009 | RTU DIGITAL INPUTS TERMINATION DIAGRAM | 09 | 0 | A | | |
| 486/5/7-0180-010 | RTU DIGITAL INPUTS TERMINATION DIAGRAM | 10 | 0 | A | | |
| 486/5/7-0180-011 | RTU DIGITAL OUTPUTS TERMINATION DIAGRAM | 11 | 0 | A | | |
| 486/5/7-0180-012 | RTU ANALOGS & MISCELLANEOUS TERMINATION DIAGRAM | 12 | 0 | A | | |
| 486/5/7-0180-013 | RESERVED (COMMON CONTROLS TERMINATION DIAGRAM) | 13 | | | | |
| 6/5/7-0180-014 | EQUIPMENT LIST | 14 | 0 | A | | |
| 6/5/7-0180-015 | CABLE SCHEDULE | 15 | 0 | A | | |
| 486/5/7-0180-016 | SWITCHBOARD LABEL SCHEDULE | 16 | 0 | A | | |
| 486/5/7-0180-017 | SWITCHBOARD CONSTRUCTION DETAILS | 17 | 0 | A | | |
| 486/5/7-0180-018 | SWITCHBOARD CONSTRUCTION DETAILS | 18 | 0 | A | | |
| 486/5/7-0180-019 | LEVEL PROBES AND PRESSURE TRANSMITTER INSTALLATION DETAILS | 19 | 0 | A | | |
| 486/5/7-0180-020 | RESERVED (CATHODIC PROTECTION UNIT) | 20 | | | | |
| 486/5/7-0180-021 | RESERVED (FIELD DISCONNECTION BOX) | 21 | | | | |
| 486/5/7-0180-022 | SWITCHBOARD GENERAL ARRANGEMENT ELEVATIONS - DOUBLE SIDED | 22 | 0 | A | | |
| 486/5/7-0180-023 | SWITCHBOARD GENERAL ARRANGEMENT SECTIONS - DOUBLE SIDED | 23 | 0 | A | | |
| 486/5/7-0180-024 | RESERVED (GENERATOR INTERNAL CONNECTION BOX) | 24 | | | | |
| 486/5/7-0180-025 | SLAB & CONDUIT DETAILS - SHEET 1 of 3 | 25 | 0 | A | | |
| 486/5/7-0180-026 | SLAB & CONDUIT DETAILS - SHEET 2 of 3 | 26 | 0 | A | | |
| 486/5/7-0180-027 | SLAB & CONDUIT DETAILS - SHEET 3 of 3 | 27 | 0 | A | | |


| STANDARD VARIABLES | |
|--|--------------------------|
| DESCRIPTION | VALUES |
| CT METERING ISOLATOR | NOT APPLICABLE |
| NORMAL SUPPLY MAIN SWITCH | 125A S250PE/125 |
| GENERATOR SUPPLY MAIN SWITCH | 125A S250PE/125 |
| PUMP1 CIRCUIT BREAKER | 20A S125G1/20 |
| PUMP2 CIRCUIT BREAKER | 20A S125G1/20 |
| DRY WELL SUMP PUMP CIRCUIT BREAKER | NOT APPLICABLE |
| PUMP SOFT STARTER SIZE | HSF-017 • Max 7.5kW |
| PUMP RATING | 4.6kW 10.5A |
| PUMP LINE CONTACTOR | CA7-9 |
| PUMP BYPASS CONTACTOR | CA7-9 |
| SUMP PUMP RATING | NOT APPLICABLE |
| SUMP PUMP CONTACTOR & TOL | NOT APPLICABLE |
| PUMP SOCKET OUTLET + INCLINE SLEEVE | DS1 311A013972 + 518A058 |
| PUMP INLET PLUG + HANDLE | DS1 311B013972 + 311A013 |
| WET WELL LEVEL TRANSMITTER | FMX21AA22.HGD.HAPOPS 4m |
| EMERGENCY STORAGE WELL LEVEL TRANSMITTER | NOT APPLICABLE |
| DELIVERY PRESSURE TRANSMITTER | BR74XXGGIEHA2X 25m |
| WET WELL ULTRASONIC LEVEL SENSOR | NOT APPLICABLE |
| FLOWMETER RANGE | NOT APPLICABLE |
| RADIO | DR900-06A02-D0 |
| EMERGENCY PUMPING TIME | 360sec |
| No of SINGLE POINT PROBES | 2 |
| INCOMING MAINS SUPPLY CABLE | 16mm ² |
| MAIN EARTHING CABLE | 6mm ² |
| INCOMING GENERATOR SUPPLY CABLE | NOT APPLICABLE |
| SOFT STARTER 3 PHASE SUPPLY | 4mm ² |

| STANDARD DESIGN OPTIONS | | |
|-------------------------|--|---|
| OPTION | DESCRIPTION | FITTED |
| A | INDIVIDUAL PUMP MOISTURE IN OIL (MIO) SENSOR AND FAULT RELAY | <input checked="" type="checkbox"/> NO |
| B | INDIVIDUAL PUMP MOTOR AUX PROTECTION SENSORS AND FAULT RELAYS | <input checked="" type="checkbox"/> NO |
| C | INDIVIDUAL PUMP REFLUX VALVE MICROSWITCH | <input checked="" type="checkbox"/> NO |
| D | STATION MANHOLE SURCHARGE IMMINENT | <input checked="" type="checkbox"/> NO |
| E | STATION DRY WELL SUMP PUMP AND LEVEL INDICATION SENSORS AND RELAYS | <input checked="" type="checkbox"/> NO |
| F | STATION PERMANENT GENERATOR - ATS AND CONTROL CONNECTIONS | <input checked="" type="checkbox"/> NO |
| G | STATION EMERGENCY STORAGE LEVEL SENSOR | <input checked="" type="checkbox"/> NO |
| H | STATION DELIVERY FLOWMETER | <input checked="" type="checkbox"/> NO |
| I | BACKUP COMMUNICATION - GSM | <input checked="" type="checkbox"/> YES |
| J | PUMP CONNECTION (Via De-contactors) | <input checked="" type="checkbox"/> YES |
| K | CATHODIC PROTECTION | <input checked="" type="checkbox"/> NO |
| L | MOTOR THERMISTORS (Via De-contactors) | <input checked="" type="checkbox"/> YES |
| M | ODOUR CONTROL | <input checked="" type="checkbox"/> NO |
| N | CURRENT TRANSFORMER (CT) METERING | <input checked="" type="checkbox"/> NO |
| O | PUMPS ELECTRICAL INTERLOCK | <input checked="" type="checkbox"/> NO |
| P | WET WELL WASHER | <input checked="" type="checkbox"/> NO |
| Q | AUX PIT SUMP PUMP AND LEVEL PROBE | <input checked="" type="checkbox"/> NO |
| R | TELEMETRY RADIO | <input checked="" type="checkbox"/> YES |
| S | WET WELL ULTRASONIC LEVEL SENSOR | <input checked="" type="checkbox"/> NO |
| T | DOUBLE SIDED SWITCHBOARD PLINTH EXTENSION FITTED | <input checked="" type="checkbox"/> YES |
| U | DELIVERY PRESSURE TRANSMITTER | <input checked="" type="checkbox"/> YES |
| V | CHEMICAL DOSING | <input checked="" type="checkbox"/> NO |

Sheet 00

FOR CONSTRUCTION

| | | | | | | | | | | | | | | |
|----|-------------------------|-----------|------|----------------|-----------------|-------------------------------|--------------|-------------------------------|----------|--|---|----------------------------------|--|--------------------|
| A | ISSUED FOR CONSTRUCTION | P.H. | A.W. | DRAFTING CHECK | A.WITTHOFT | Original signed by GANDERSON | 09-04-10 | Original signed by K.VAHEERAN | 13-04-10 | | SITE SP117 SALTASH STREET SEWAGE PUMP STATION | TITLE SITE COVER SHEET | SHEET No. 0 Queensland Urban Utilities DRAWING No. 486/5/7-0180-000 | AMEND. A |
| | ISSUED FOR TENDER | P.H. | A.W. | CAD FILE | 67-0160set_A | Original signed by A.WITTHOFT | 09-04-10 | Original signed by P.HERRIFF | 12-04-10 | | | | | |
| No | DATE | AMENDMENT | DRN. | APD. | U.O.O. FILE No. | DESIGN CHECK | R.P.E.Q. No. | DATE | DATE | | | | | |

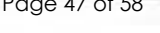


CONT'D FROM SHEET 01

E N R W B

100N


CONT'D ON SHEET 03

Point to point tested on 17/6/10
by Brendan Stringer Ref 114766

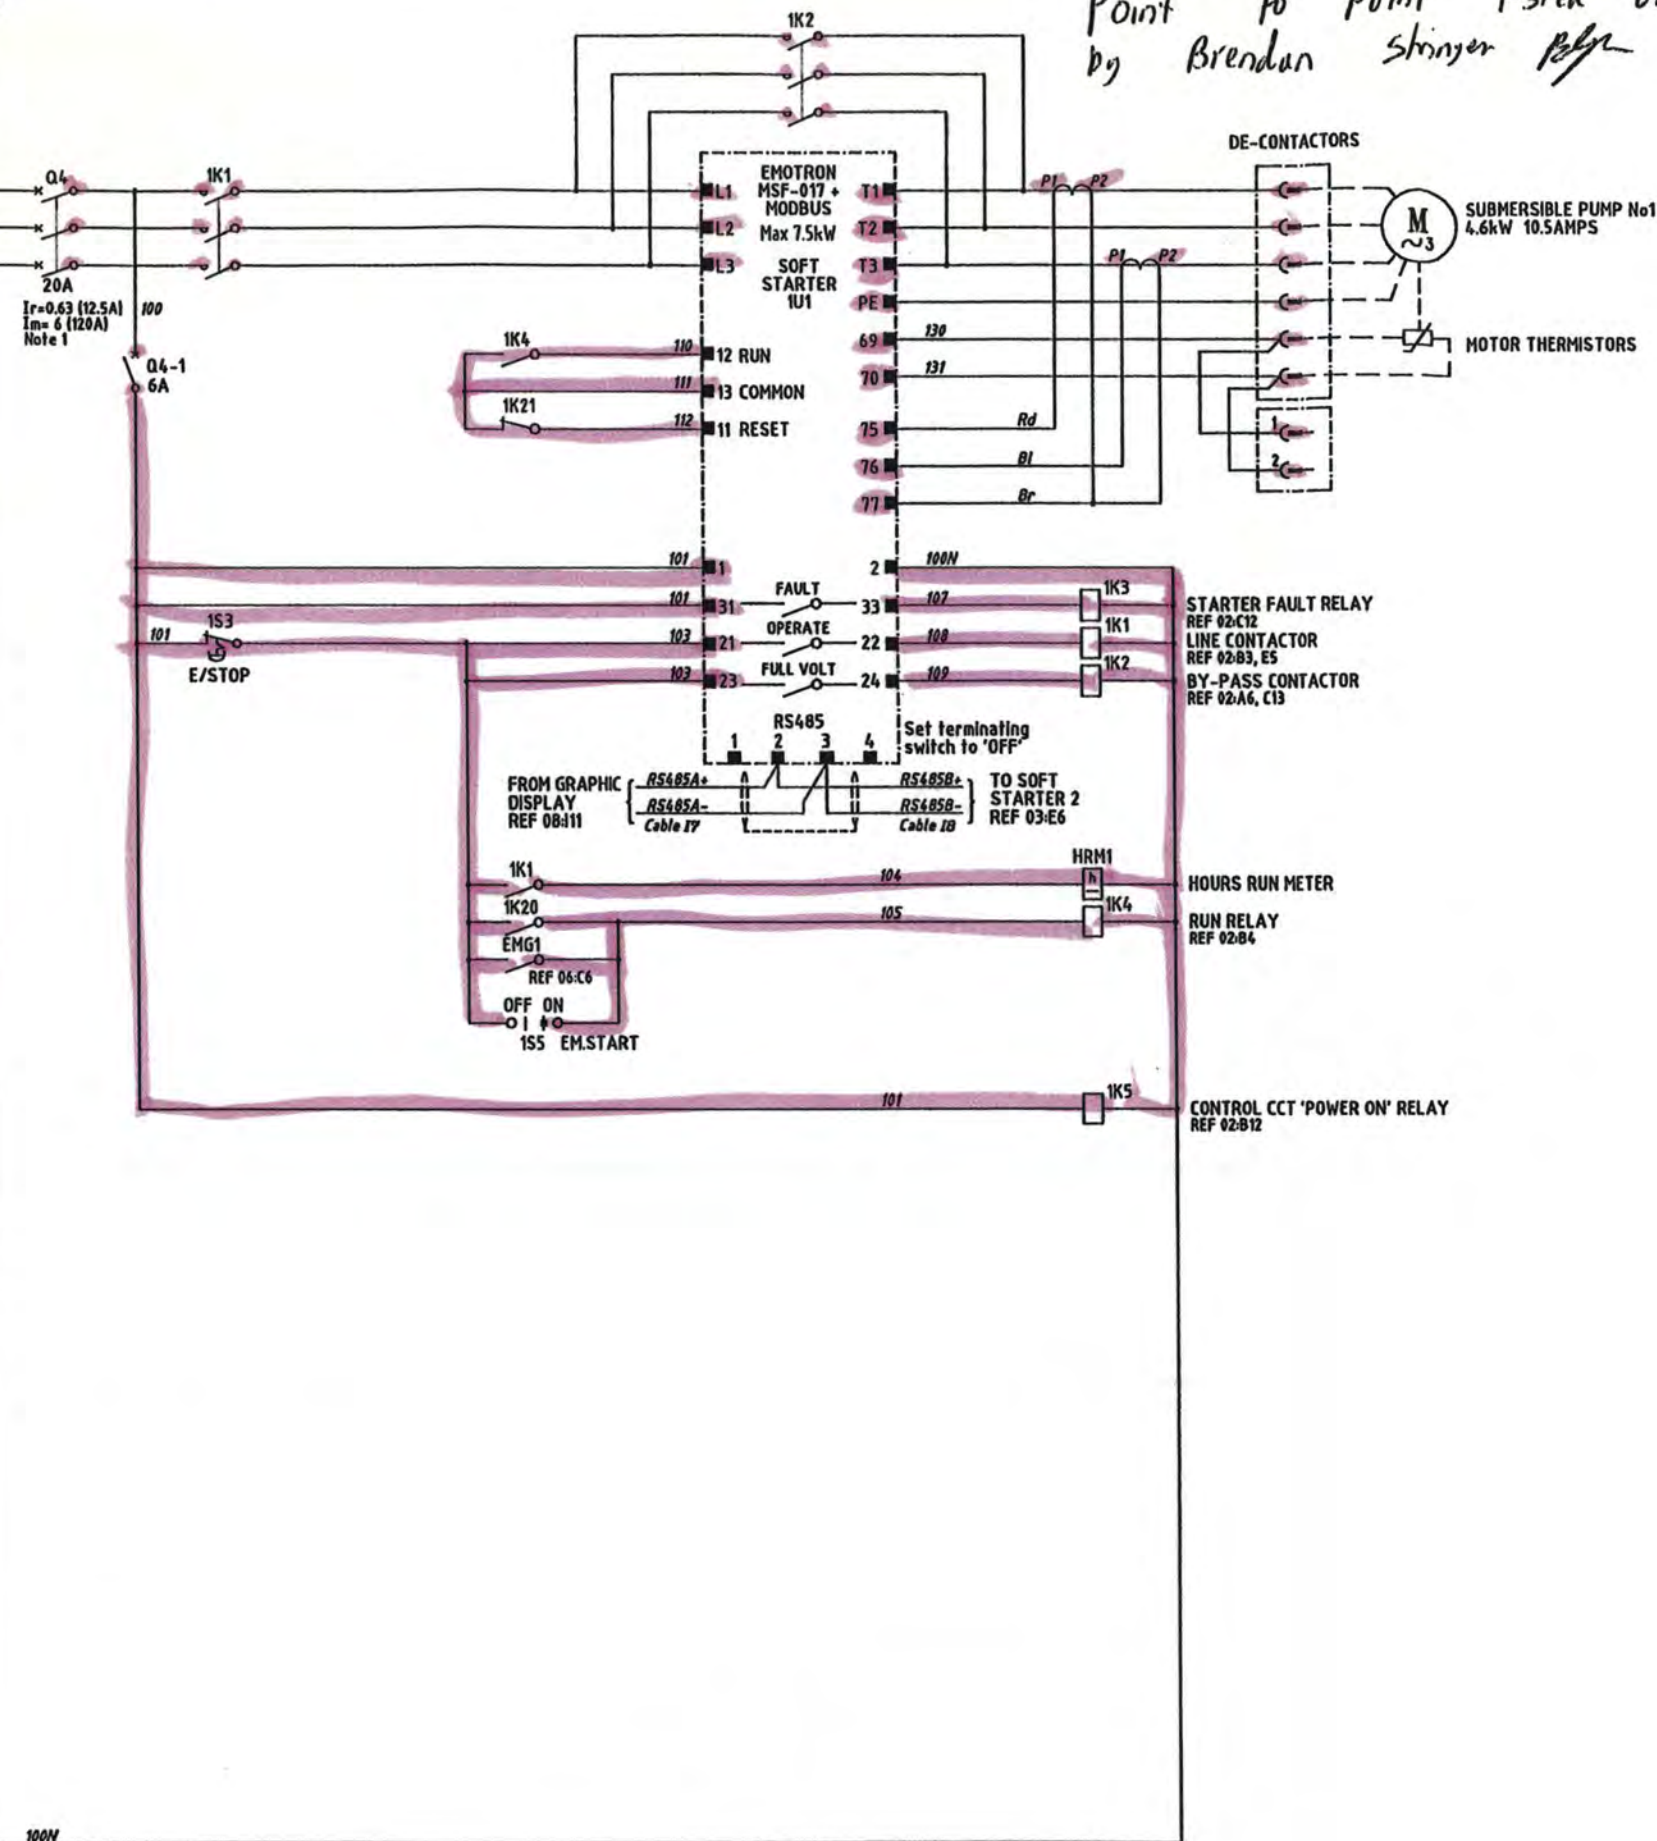


RTU DIGITAL INPUTS

+ 24VDC POWER SUPPLY - REFER SHEET 08C7

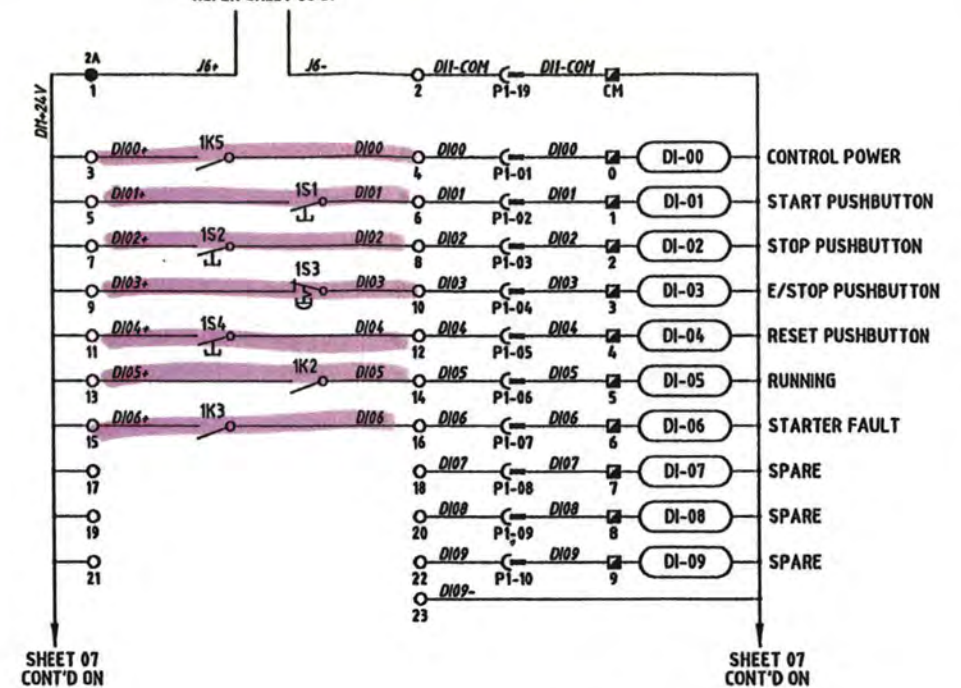

RTU DIGITAL OUTPUTS

+ 24VDC POWER SUPPLY - REFER SHEET 08C7

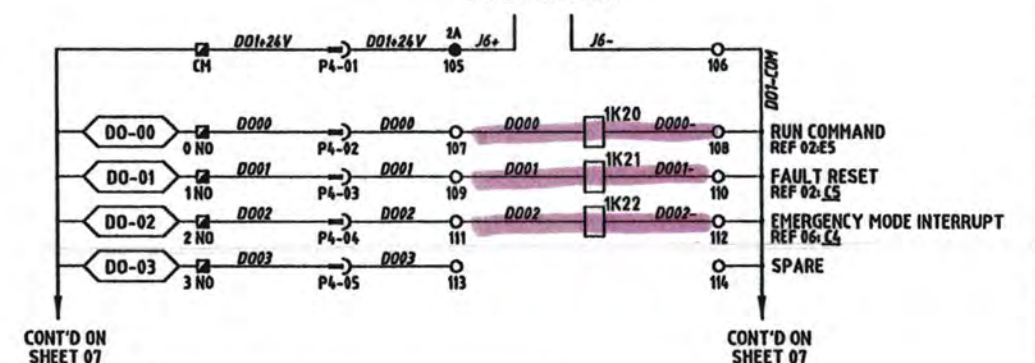

LEGEND:

- ▲ SWITCHBOARD POWER TERMINAL
- ◊ SWITCHBOARD CONTROL TERMINAL
- SWITCHBOARD GENERATOR TERM.
- ✕ FIELD TERMINAL
- PLC TERMINAL
- ▣ RTU TERMINAL
- SS TERMINAL
- PLC/RTU MARSH. FUSE TERMINAL
- PLC/RTU MARSH. LINK TERMINAL
- TO RTU → DISCONNECT PLUG
- DI-02 RTU DIGITAL INPUT
- DO-02 RTU DIGITAL OUTPUT
- AI-02 RTU ANALOGUE INPUT
- AO-02 RTU ANALOGUE OUTPUT

NOTES

1. INCOMING GENSET, MAIN, PUMP & DIST. BOARD CIRCUIT BREAKERS SHALL BE LINE SIDE SHROUDED.
2. CIRCUIT BREAKER RATINGS TO SUIT FAULT LEVEL & LOAD ENSURE MIN TYPE 1 CO-ORDINATION WITH CONTACTORS & OVERLOADS TO IEC 947-4-1.
3. ALL WIRES & CABLE CORES ARE FERRULED WITH GRAFOPLAST S12000 COMPATIBLE LABELLING.
4. FAULT LEVEL OF 20kA AT 415V FOR 0.2sec.


Sheet 02

FOR CONSTRUCTION


| | | | | | | | |
|---|---|--|---|---|---|--|--|
| ISSUED FOR CONSTRUCTION ISSUED FOR TENDER No DATE AMENDMENT | P.H. A.W. DRAFTING CHECK P.H. A.W. CAD FILE DRN. APD. B.C.C. FILE No. | DRAFTED P.HAGUE Original Signed by G.ANDERSON 09-04-10 DESIGN Original signed by A.WITTHOFT 0895 09-04-10 DESIGN CHECK R.P.E.Q. No. DATE | Original Signed by K.VAHEESAN 13-04-10 PRINCIPAL DESIGN MANAGER Original Signed by P.S.HERRIFF 12-04-10 CLIENT DELEGATE R.P.E.Q. No. DATE | A DIVISION OF THE BRISBANE CITY COUNCIL | SITE SP117 SALTASH STREET SEWAGE PUMP STATION | TITLE PUMP No1 SCHEMATIC DIAGRAM | SHEET No. 2 Queensland Urban Utilities DRAWING No. 486/5/7-0180-002 AMEND. A |
|---|---|--|---|---|---|--|--|

CONT'D FROM SHEET 02


E N R W B

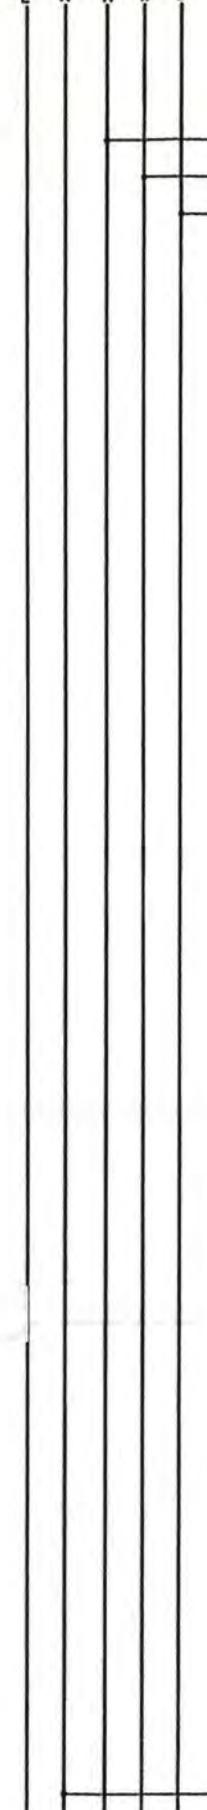

RTU DIGITAL INPUTS

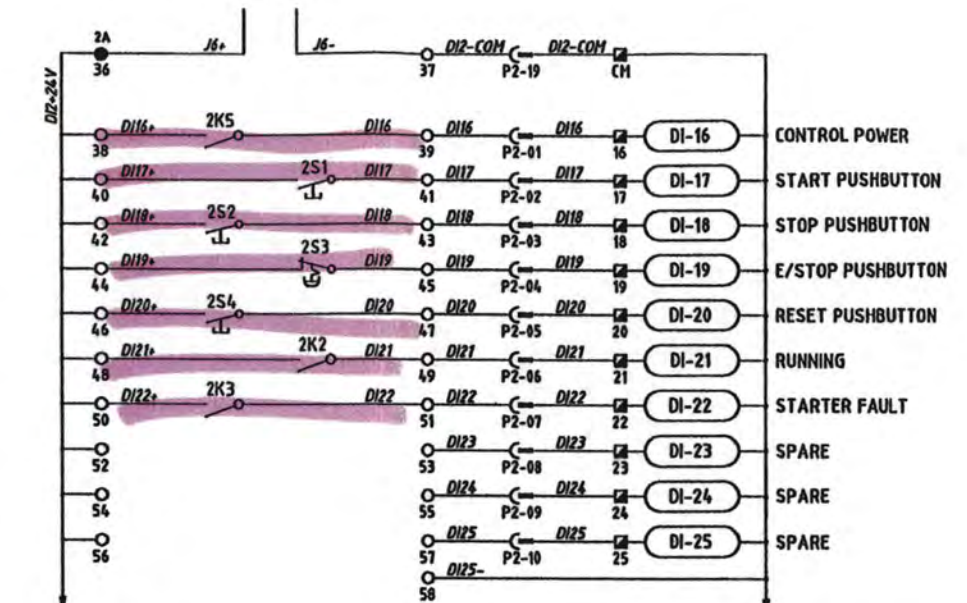+ 24VDC POWER SUPPLY -
REFER SHEET 08:C7

RTU DIGITAL OUTPUTS

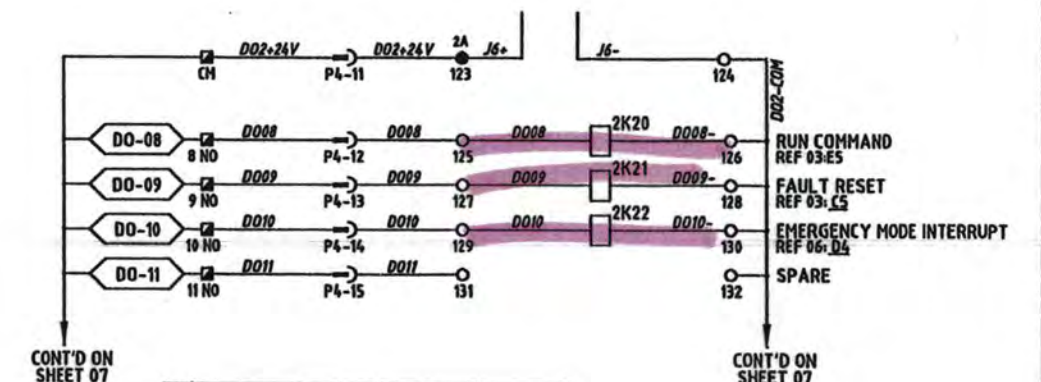+ 24VDC POWER SUPPLY -
REFER SHEET 08:C7

LEGEND:

- ▲ SWITCHBOARD POWER TERMINAL
- ◊ SWITCHBOARD CONTROL TERMINAL
- SWITCHBOARD GENERATOR TERM.
- ✕ FIELD TERMINAL
- PLC TERMINAL
- ▣ RTU TERMINAL
- SS TERMINAL
- PLC/RTU MARSH. FUSE TERMINAL
- PLC/RTU MARSH. LINK TERMINAL
- TO RTU → DISCONNECT PLUG
- DI-02 RTU DIGITAL INPUT
- DO-02 RTU DIGITAL OUTPUT
- AI-02 RTU ANALOGUE INPUT
- AO-02 RTU ANALOGUE OUTPUT

NOTES

1. INCOMING GENSET, MAIN, PUMP & DIST. BOARD CIRCUIT BREAKERS SHALL BE LINE SIDE SHROUDED.
2. CIRCUIT BREAKER RATINGS TO SUIT FAULT LEVEL & LOAD ENSURE MIN TYPE 1 CO-ORDINATION WITH CONTACTORS & OVERLOADS TO IEC 947-4-1.
3. ALL WIRES & CABLE CORES ARE FERRULED WITH GRAFOPLAST SI2000 COMPATIBLE LABELLING.
4. FAULT LEVEL OF 20kA AT 415V FOR 0.2sec.

Sheet 03

FOR CONSTRUCTION

| | | | | | | | | | |
|-------------------------|--|------|------|-----------------|--------------|-------------------------------|------------------|-------------------------------|----------|
| ISSUED FOR CONSTRUCTION | | P.H. | A.W. | DRAFTING CHECK | P.HAGUE | Original Signed by G.ANDERSON | 09-04-10 | Original Signed by K.VAHEESAN | 13-04-10 |
| ISSUED FOR TENDER | | P.H. | A.W. | CAD FILE | A.WITTHOFT | DESIGN | R.P.E.Q.No. DATE | PRINCIPAL DESIGN MANAGER | DATE |
| AMENDMENT | | DRN. | APD. | B.C.C. FILE No. | 67-0180set_A | Original signed by A.WITTHOFT | 8895 09-04-10 | Original Signed by P.SHERIFF | 12-04-10 |
| | | | | | | DESIGN CHECK | R.P.E.Q.No. DATE | CLIENT DELEGATE | DATE |




SITE
SP117
SALTASH STREET
SEWAGE PUMP STATION

TITLE
PUMP No2
SCHEMATIC DIAGRAM


SHEET No. 3
Queensland Urban Utilities DRAWING No.
486/57-0180-003
AMEND.
A

COMMON CONTROL SECTION

EMERGENCY PUMPING MODE (240VAC)

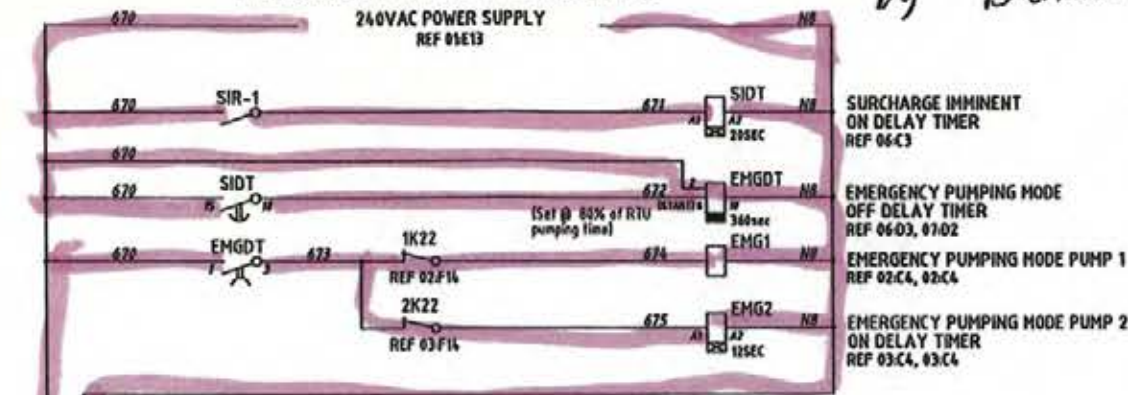
240VAC POWER SUPPLY
REF 01E13


TIMING DIAGRAM

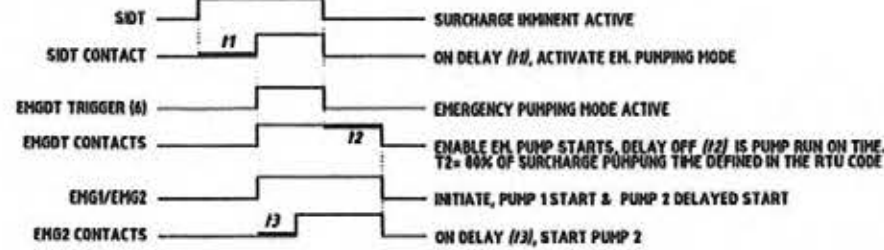


COMMON CONTROL SECTION

LEVEL MONITORING

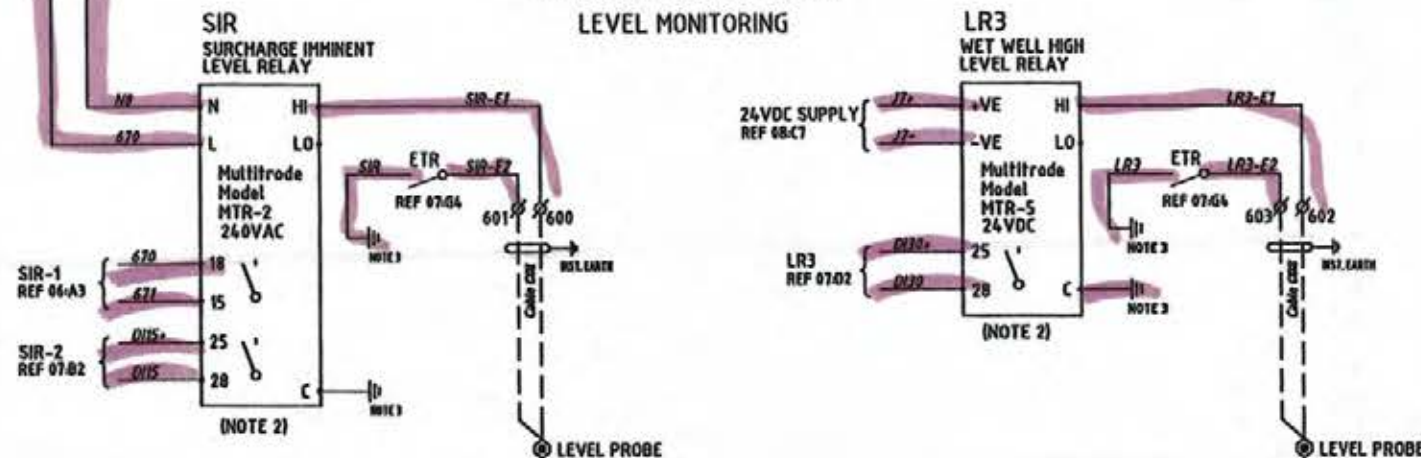


Point to point tested on 17/6/10
by Brendan Stinger Blyn 114766

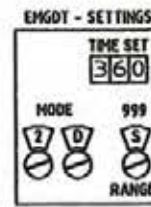


COMMON CONTROL SECTION

SWITCHBOARD INTERNAL LIGHTING

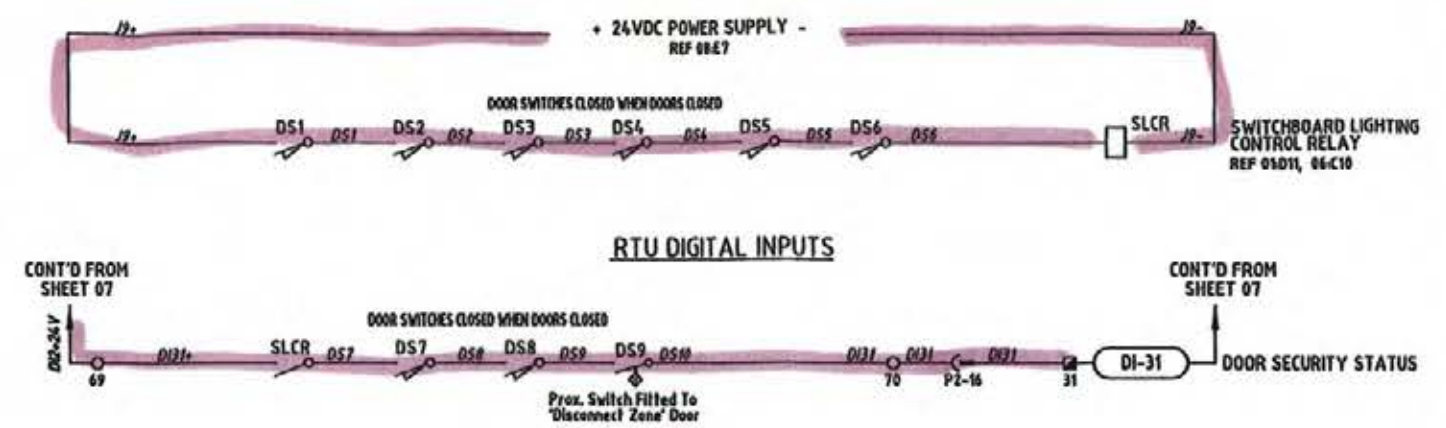


RTU DIGITAL INPUTS

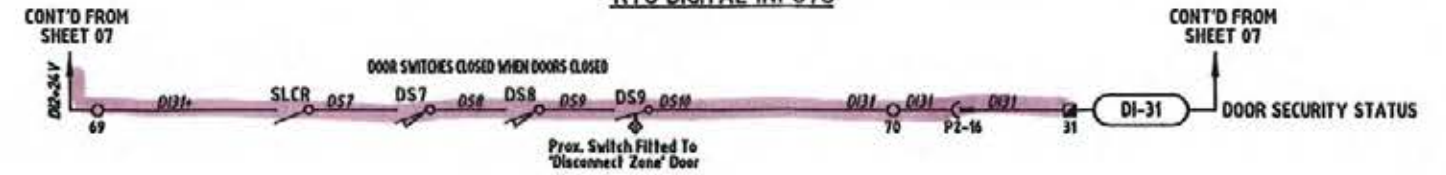

ATS SECTION

SURGE DIVERSERS

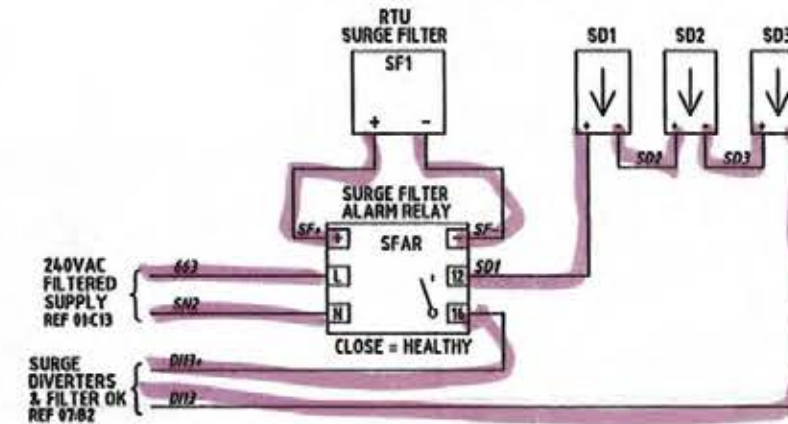

LEGEND:

- ▲ SWITCHBOARD POWER TERMINAL
- ⊗ SWITCHBOARD CONTROL TERMINAL
- SWITCHBOARD GENERATOR TERM.
- ✕ FIELD TERMINAL
- Ⓜ PLC TERMINAL
- Ⓜ RTU TERMINAL
- SS TERMINAL
- PLC/RTU MARSH. FUSE TERMINAL
- PLC/RTU MARSH. LINK TERMINAL
- 10-RTU → DISCONNECT PLUG
- DI-RTU RTU DIGITAL INPUT
- DO-RTU RTU DIGITAL OUTPUT
- AI-RTU RTU ANALOGUE INPUT
- AO-RTU RTU ANALOGUE OUTPUT

NOTES

- ALL WIRES & CABLE CORES ARE FERRULED WITH GRAFOPLAST SIZ000 COMPATIBLE LABELLING.
- SET DIPSWITCH TO 'DISCHARGE' MODE.
- RUN SEPARATE DEDICATED EARTH CONDUCTOR TO EARTH BAR.

Sheet 06

FOR CONSTRUCTION

| NO. | REVISION | DATE | BY | CHKD | APPD | DESCRIPTION |
|-----|-------------------------|----------|------|------|------|-----------------|
| 1 | ISSUED FOR CONSTRUCTION | 09-04-10 | P.H. | A.W. | P.H. | DRAFTING CHECK |
| 2 | ISSUED FOR TENDER | 09-04-10 | P.H. | A.W. | P.H. | CAD FILE |
| 3 | AMENDMENT | 09-04-10 | P.H. | A.W. | P.H. | B.C.D. FILE No. |
| 4 | | 09-04-10 | P.H. | A.W. | P.H. | DESIGN CHECK |
| 5 | | 09-04-10 | P.H. | A.W. | P.H. | DESIGN CHECK |



SITE
SP117
SALTASH STREET
SEWAGE PUMP STATION


TITLE
COMMON CONTROLS
SCHEMATIC DIAGRAM

SHEET No. 6
Queensland Urban Utilities DRAWING No.
486/57-0180-006
AMEND. A

RTU DIGITAL INPUTS

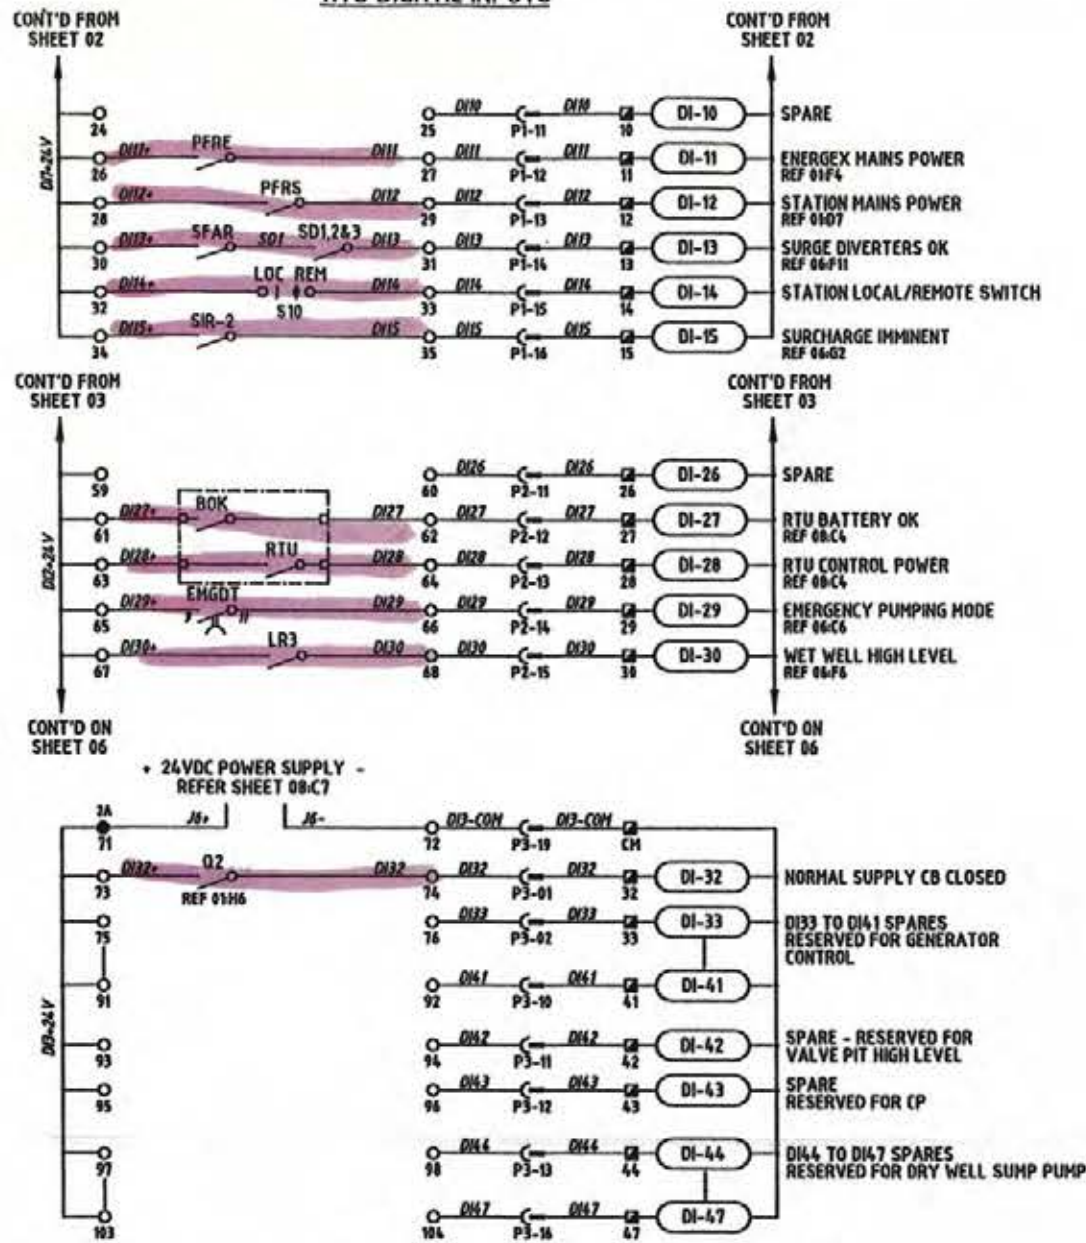

RTU ANALOG INPUTS

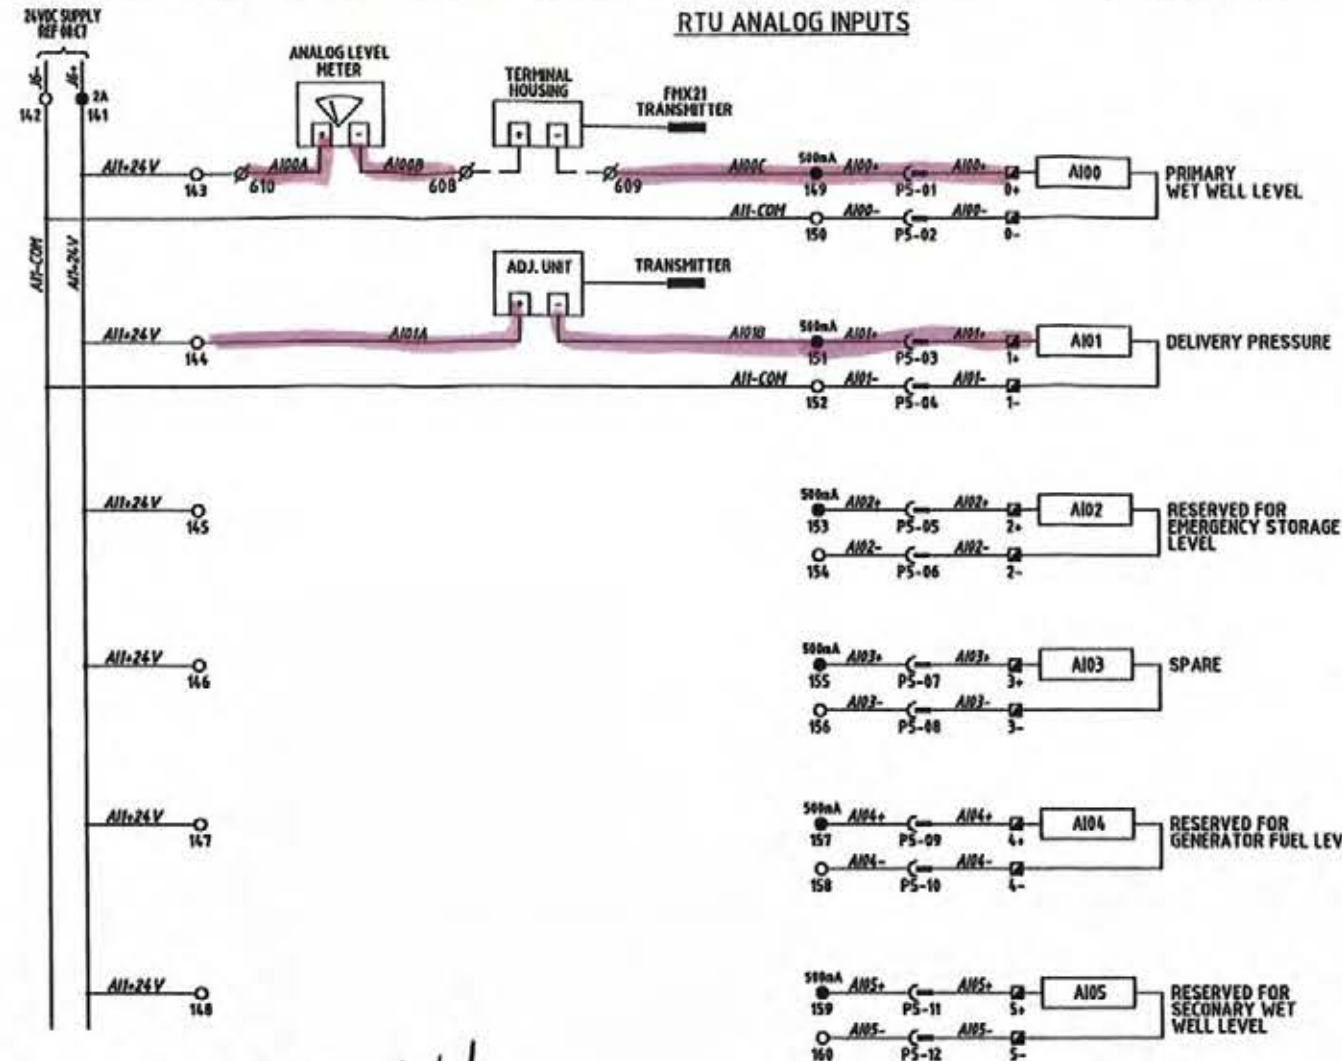

Point to point tested
on the 17/6/10 by
Brendan Stringer Rly
114766


NOTES

1. ALL WIRES & CABLE CORES ARE FERRULED WITH GRAFOPLAST SIZE000 COMPATIBLE LABELLING.

LEGEND:

- ▲ SWITCHBOARD POWER TERMINAL
- SWITCHBOARD CONTROL TERMINAL
- SWITCHBOARD GENERATOR TERM.
- ⊗ FIELD TERMINAL
- PLC TERMINAL
- RTU TERMINAL
- SS TERMINAL
- PLC/RTU MARSH. FUSE TERMINAL
- PLC/RTU MARSH. LINK TERMINAL
- TO RTU → DISCONNECT PLUG
- DI-02 RTU DIGITAL INPUT
- DO-02 RTU DIGITAL OUTPUT
- AI-02 RTU ANALOGUE INPUT
- AO-02 RTU ANALOGUE OUTPUT

RTU ANALOG OUTPUTS

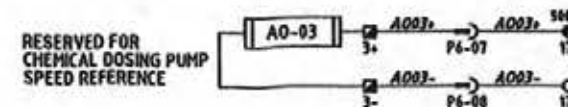

Sheet 07


FOR CONSTRUCTION

| | | | | | | | | | | | | | |
|-------------------------|--|------|------|-----------------|-------------|-------------------------------|--------------|-------------------------------|----------|--|--|---|--|
| ISSUED FOR CONSTRUCTION | | P.H. | A.W. | DRAFTING CHECK | A.WITTHOFT | Original Signed by G.ANDERSON | 09-04-10 | Original Signed by K.VAHEESAN | 13-04-10 | | SITE SP117 SALTASH STREET SEWAGE PUMP STATION | TITLE COMMON RTU I/O SCHEMATIC DIAGRAM | SHEET No. 7 Queensland Urban Utilities DRAWING No. 486/5/7-0180-007 AMEND. A |
| ISSUED FOR TENDER | | P.H. | A.W. | CAD FILE | 07-0180-007 | Original signed by A.WITTHOFT | 09-04-10 | Original Signed by P.SHERIFF | 12-04-10 | | | | |
| AMENDMENT | | DRN | APD | B.C.C. FILE No. | | DESIGN CHECK | R.P.E.Q. No. | CLIENT DELEGATE | DATE | | | | |

RTU COMPARTMENT

MITS RTU
MD3311 EA

RTU POWER SUPPLIES

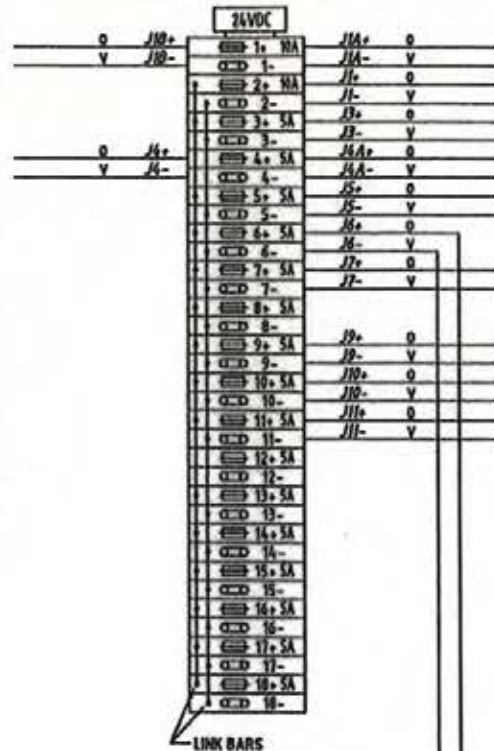REFER
SHEET 08REFER
SHEET 08

Point to point tested on the
17/6/10 by Brendan Stringer
114766 Plyn


SWITCHBOARD

FIELD

STARTER COMPARTMENT

PUMP 1

REFER SHEET 02

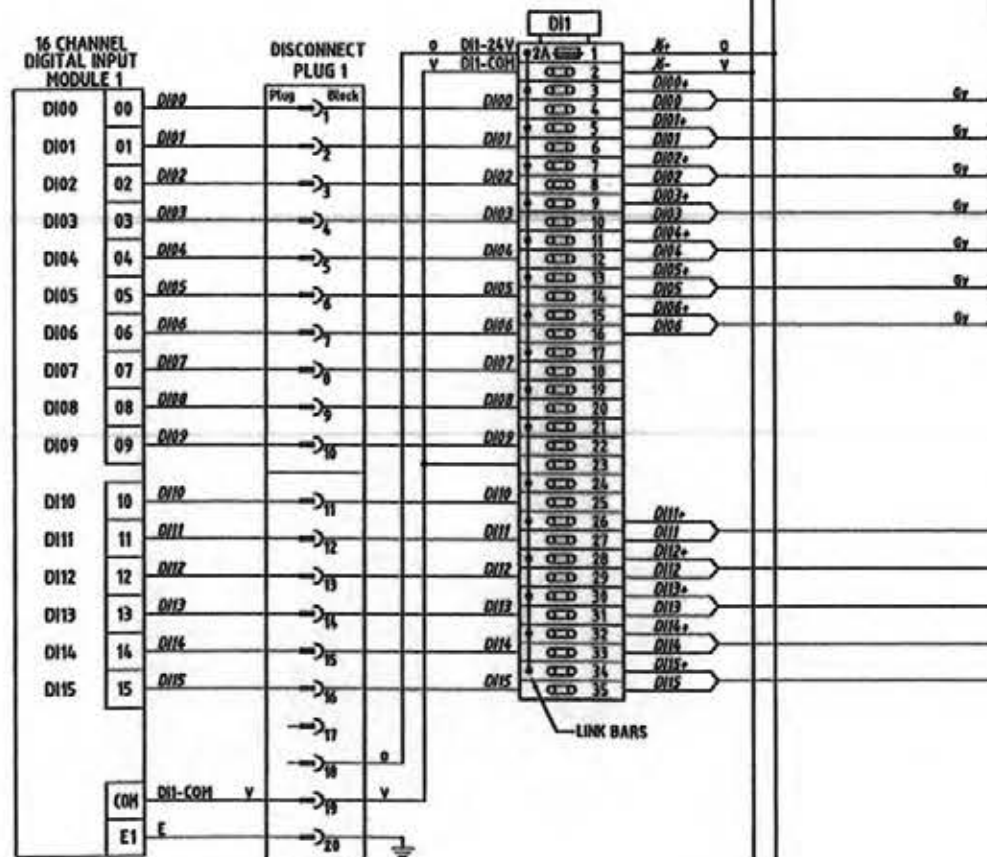16 CHANNEL
DIGITAL INPUT
MODULE 1DISCONNECT
PLUG 1CONT ON
SHEET 10


COMMON COMPARTMENT




ATS COMPARTMENT



STARTER COMPARTMENT

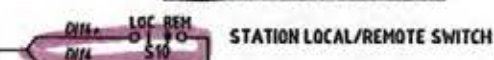

COMMON COMPARTMENT

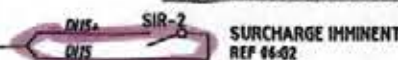

LEGEND:

- C77 CABLE IDENTIFIER
- TO RTU DISCONNECT PLUG
- FUSE TERMINAL
- DISCONNECT LINK TERMINAL

NOTES

1. ALL WIRES & CABLE CORES ARE FERRULED WITH GRAFOPLAST SIZ000 COMPATIBLE LABELLING.
2. ALL FUSES ARE 500mA EXCEPT WHERE NOTED OTHERWISE.

Sheet 09

FOR CONSTRUCTION

| | | | | | | | | | | | | | | |
|-------------------------|--|------|------|-----------------|--------------|-------------------------------|------------------|-------------------------------|----------|--|--|---|---|---------------------------|
| ISSUED FOR CONSTRUCTION | | P.H. | A.W. | DRAFTED | P.HAGUE | Original Signed by G.ANDERSON | 09-04-10 | Original Signed by K.VAHEESAN | 13-04-10 | | SITE SP117 SALTASH STREET SEWAGE PUMP STATION | TITLE RTU DIGITAL INPUTS TERMINATION DIAGRAM | SHEET No. 9 Queensland Urban Utilities DRAWING No. 486/5/7-0180-009 | AMEND. A |
| ISSUED FOR TENDER | | P.H. | A.W. | DRAFTING CHECK | A.WITTHOFT | DESIGN | R.P.E.O.No. DATE | PRINCIPAL DESIGN MANAGER | DATE | | | | | |
| AMENDMENT | | DRN. | APD. | B.C.C. FILE No. | 07-0180set A | DESIGN CHECK | R.P.E.O.No. DATE | CLIENT DELEGATE | DATE | | | | | |

RTU COMPARTMENT

MITS RTU
MD3311 EA



STARTER COMPARTMENT

SWITCHBOARD


FIELD

Point to Point tested
On the 17/6/10 by
Brendan Stringer Plyn 114766


PUMP 2
REFER SHEET 03

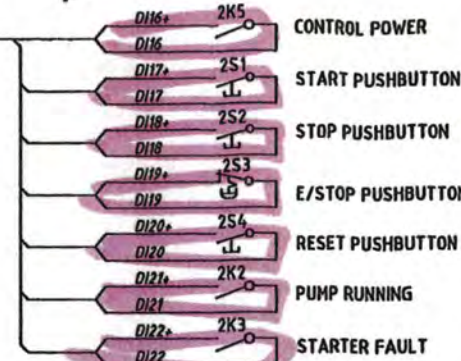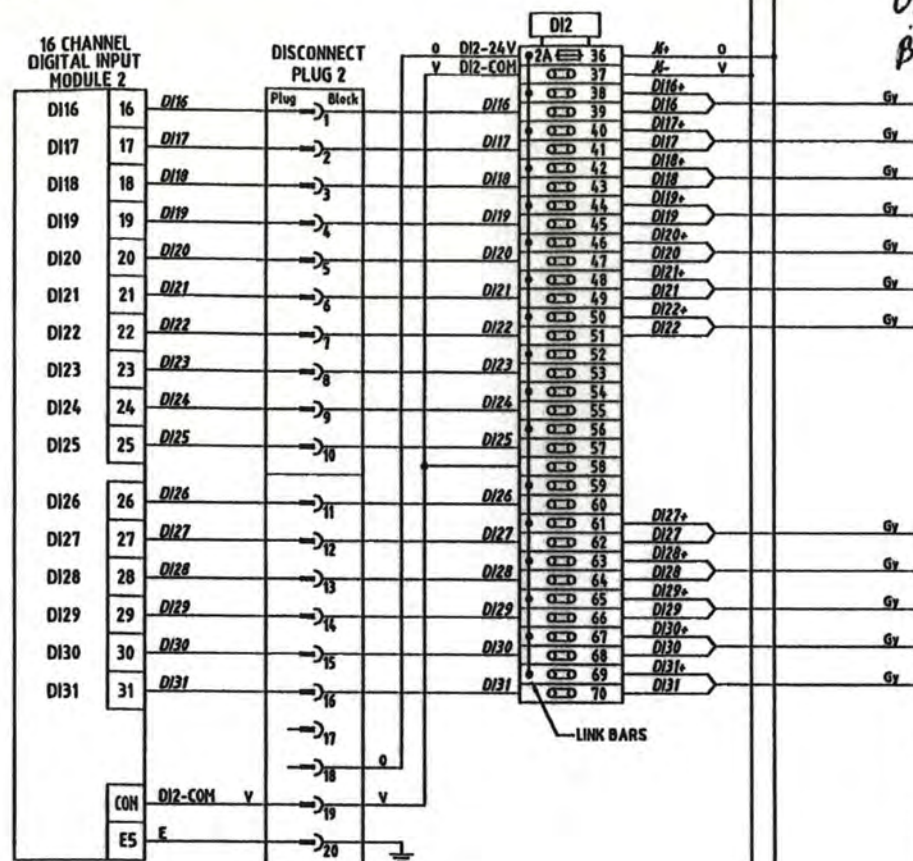

RTU COMPARTMENT

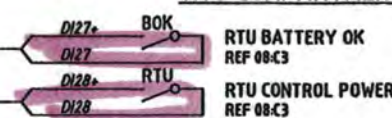

COMMON COMPARTMENT

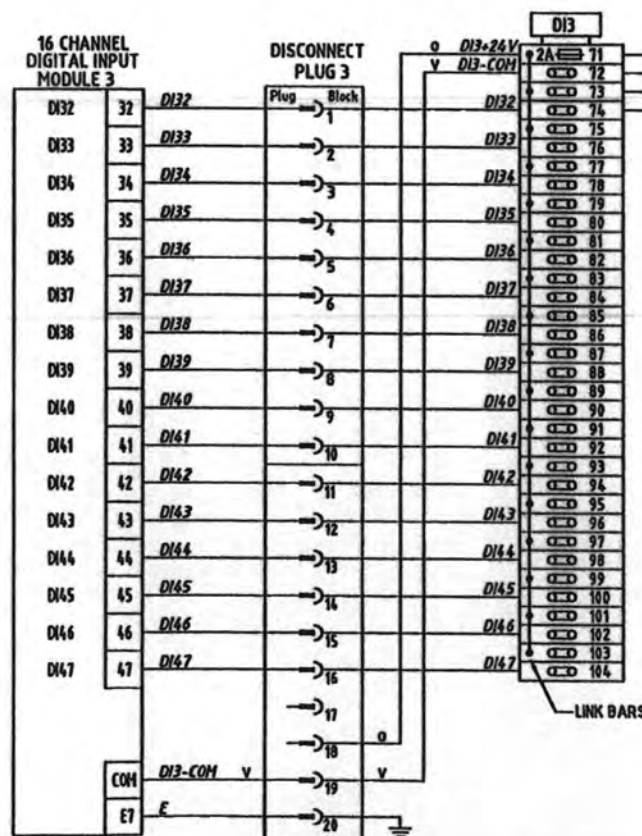

NOTES

1. ALL WIRES & CABLE CORES ARE FERRULED WITH GRAFOPLAST SIZ000 COMPATIBLE LABELLING.
2. ALL FUSES ARE 500mA EXCEPT WHERE NOTED OTHERWISE.

LEGEND:

- C?? CABLE IDENTIFIER
- TO RTU -> DISCONNECT PLUG
- FUSE TERMINAL
- DISCONNECT LINK TERMINAL

Sheet 10

FOR CONSTRUCTION

| | | | | | | | | | |
|-------------------------|--|------|------|-----------------|--------------|-------------------------------|------------------|-------------------------------|----------|
| ISSUED FOR CONSTRUCTION | | P.H. | A.W. | DRAFTING CHECK | A.WITTHOFT | Original Signed by GANDERSON | 09-04-10 | Original Signed by K.VAHEESAN | 13-04-10 |
| ISSUED FOR TENDER | | P.H. | A.W. | CAD FILE | 57-0180set A | DESIGN | R.P.E.Q.No. DATE | PRINCIPAL DESIGN MANAGER | DATE |
| AMENDMENT | | DRN. | APD. | B.C.C. FILE No. | | Original signed by A.WITTHOFT | 8895 09-04-10 | Original Signed by P.SHERIFF | 12-04-10 |
| | | | | | | DESIGN CHECK | R.P.E.Q.No. DATE | CLIENT DELEGATE | DATE |




SITE
SP117
SALTASH STREET
SEWAGE PUMP STATION

TITLE
RTU DIGITAL INPUTS
TERMINATION DIAGRAM

SHEET No. 10
Queensland Urban Utilities DRAWING No.
486/5/7-0180-010
AMEND.
A

RTU COMPARTMENT

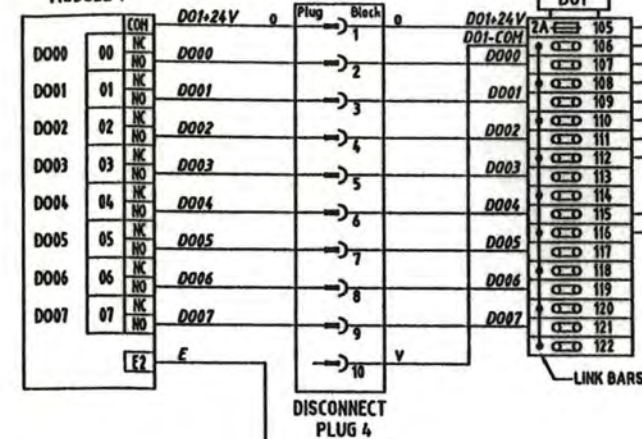
MITS RTU
MD3311 EA8 CHANNEL
DIGITAL OUTPUT
MODULE 1DISCONNECT
PLUG 4CONT ON
SHEET 10

Point to Point tested
on the 17/6/10 by
Brendan Stringer 114766
BJS


SWITCHBOARD

FIELD


STARTER COMPARTMENT

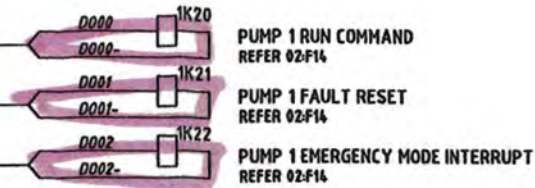

COMMON COMPARTMENT

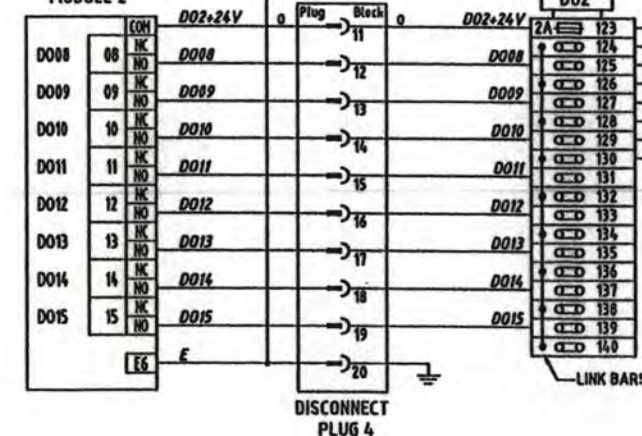8 CHANNEL
DIGITAL OUTPUT
MODULE 2DISCONNECT
PLUG 4CONT ON
SHEET 12

STARTER COMPARTMENT

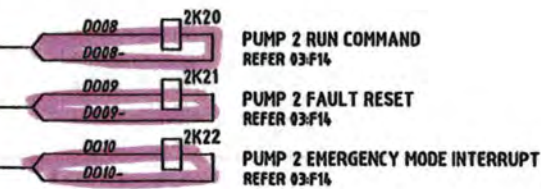

LEGEND:

- C77 CABLE IDENTIFIER
- TO RTU → DISCONNECT PLUG
- ⊗ SWITCHBOARD CONTROL TERMINAL
- ⊗ FUSE TERMINAL
- ⊗ DISCONNECT LINK TERMINAL

NOTES

1. ALL WIRES & CABLE CORES ARE FERRULED WITH GRAFOPLAST S12000 COMPATIBLE LABELLING.
2. ALL FUSES ARE 500mA EXCEPT WHERE NOTED OTHERWISE.

Sheet 11

FOR CONSTRUCTION

| | | | | | | | | | |
|-------------------------|--|------|------|-----------------|--------------|-------------------------------|-------------------|-------------------------------|----------|
| ISSUED FOR CONSTRUCTION | | P.H. | A.W. | DRAFTING CHECK | P.HAGUE | Original Signed by G.ANDERSON | 09-04-10 | Original Signed by K.VAHEESAN | 13-04-10 |
| ISSUED FOR TENDER | | P.H. | A.W. | CAD FILE | A.WITTHOFT | DESIGN | R.P.E.Q. No. DATE | PRINCIPAL DESIGN MANAGER | DATE |
| AMENDMENT | | DRN. | APD. | B.C.C. FILE No. | 57-0180aet_A | Original signed by A.WITTHOFT | 8895 09-04-10 | Original Signed by P.SHERRIFF | 12-04-10 |
| | | | | | | DESIGN CHECK | R.P.E.Q. No. DATE | CLIENT DELEGATE | DATE |



SITE
SP117
SALTASH STREET
SEWAGE PUMP STATION

TITLE
RTU DIGITAL OUTPUTS
TERMINATION DIAGRAM

SHEET No. 11
Queensland Urban Utilities DRAWING No.
486/5/7-0180-011
AMEND. A





Ref: Test Certificate P117.doc

TEST CERTIFICATE

SJ Electric (Qld) Pty. Ltd.
19 Elliot Street.
Albion Qld. 4010
R.E.C. 7623

Attention: Wendy Wong

Level 2 TC Beime Centre, 315 Brunswick Street Mall, Fortitude Valley Q 4006

Work performed for Brisbane Water at SP117 Saltash St Virginia 4014 under contract BW: 70103-037
(SJ Electric Job Number WT400089)

Installation Tested / Equipment Tested

- New Sewage pump station switchboard
- New main earth
- Earth bonding to main earth link and all switchboard components.

All supporting test sheets attached.

Test Date
22/06/10

For the electrical installation, this certificate certifies that the electrical installation to the extent it is affected by the electrical work has been tested to ensure it is electrically safe and is in accordance with the requirements of the wiring rules and the electrical safety regulation 2002. C.J. Holmes (endorsee to electrical contracting license 7623)

For the electrical equipment, this certificate certifies that the electrical equipment, to the extent it is affected by the electrical work, is electrically safe. C.J. Holmes (endorsee to electrical contracting license 7623)

Signed.

A handwritten signature in blue ink, appearing to be 'CJ' or similar, written over a horizontal line.